
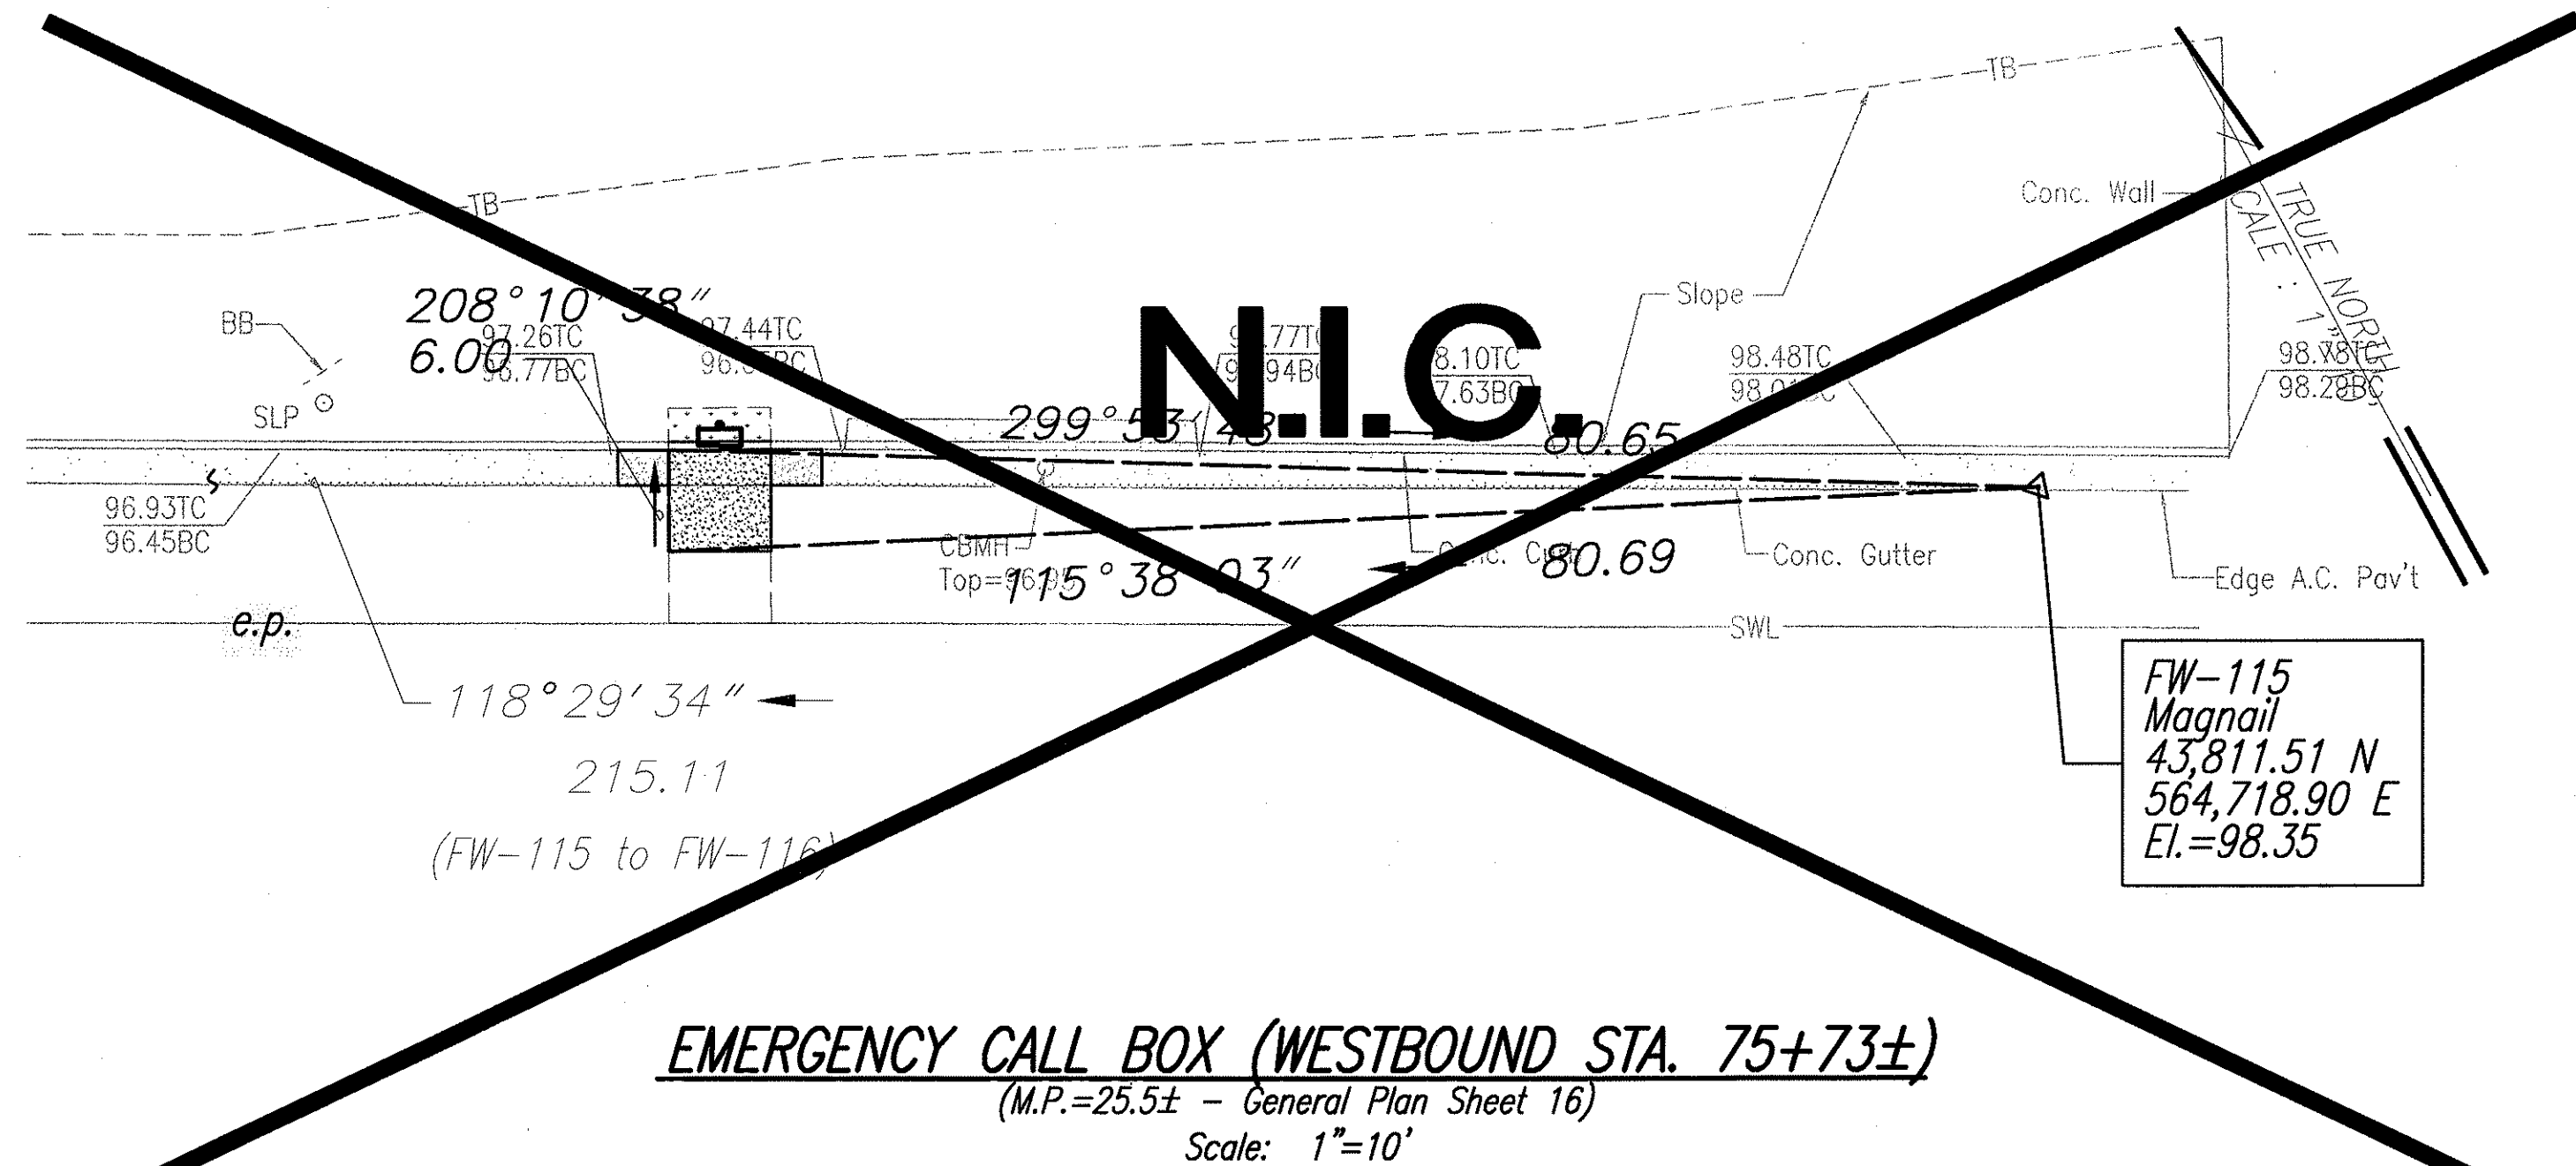
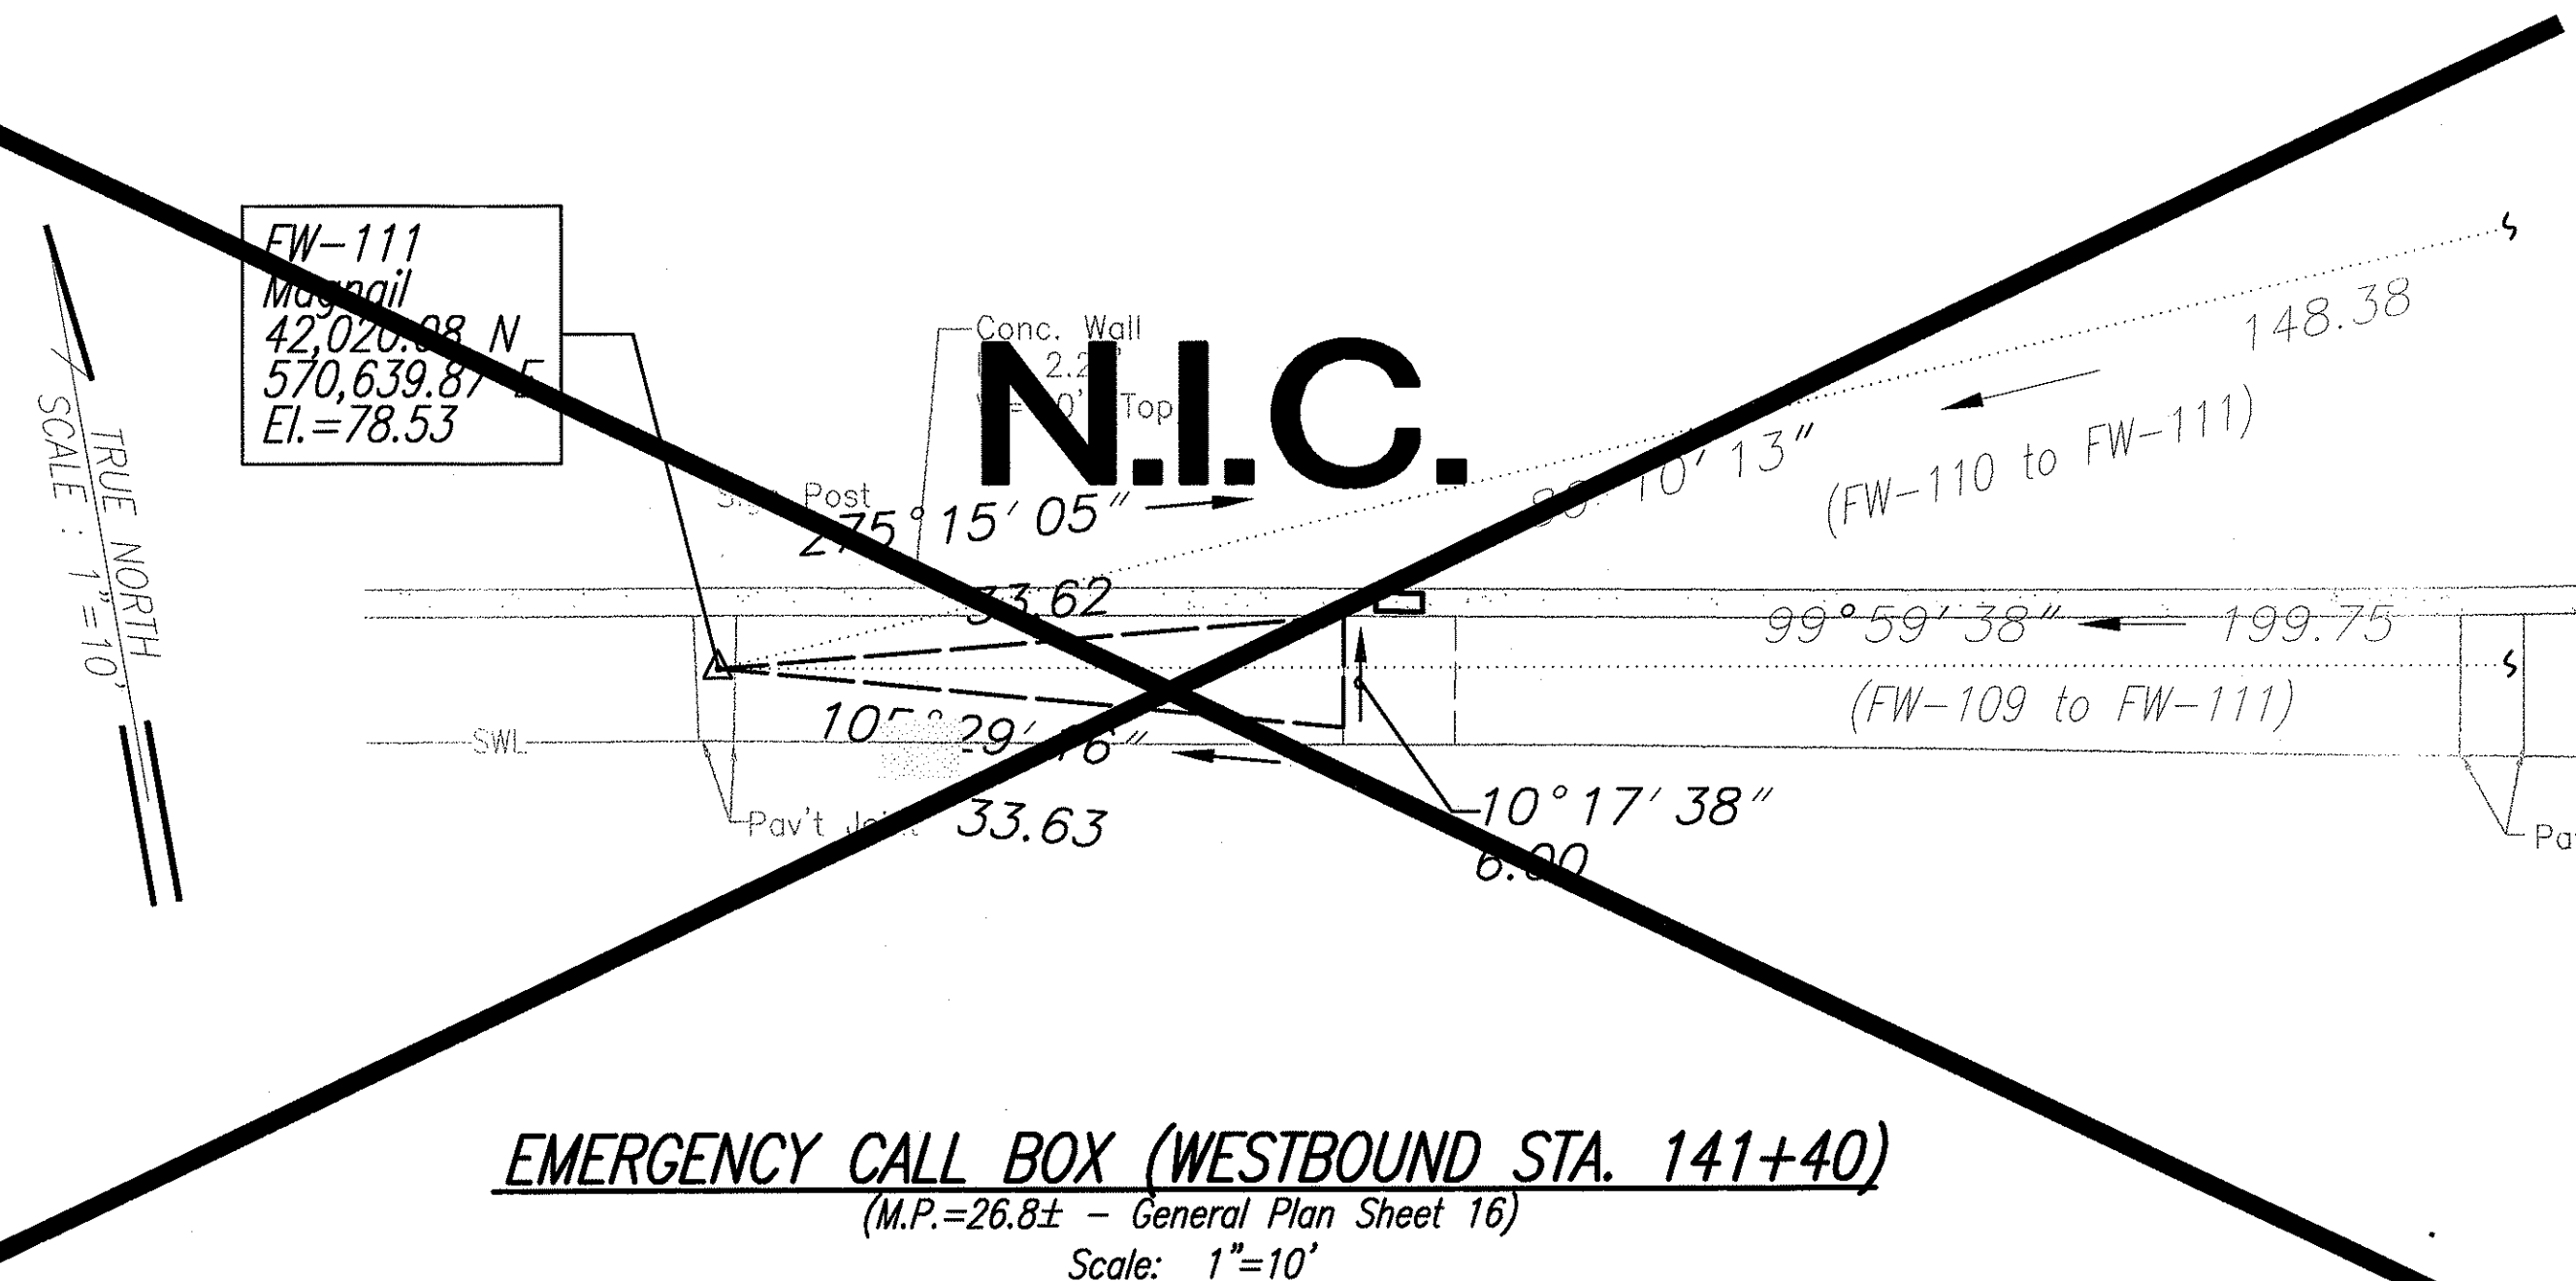
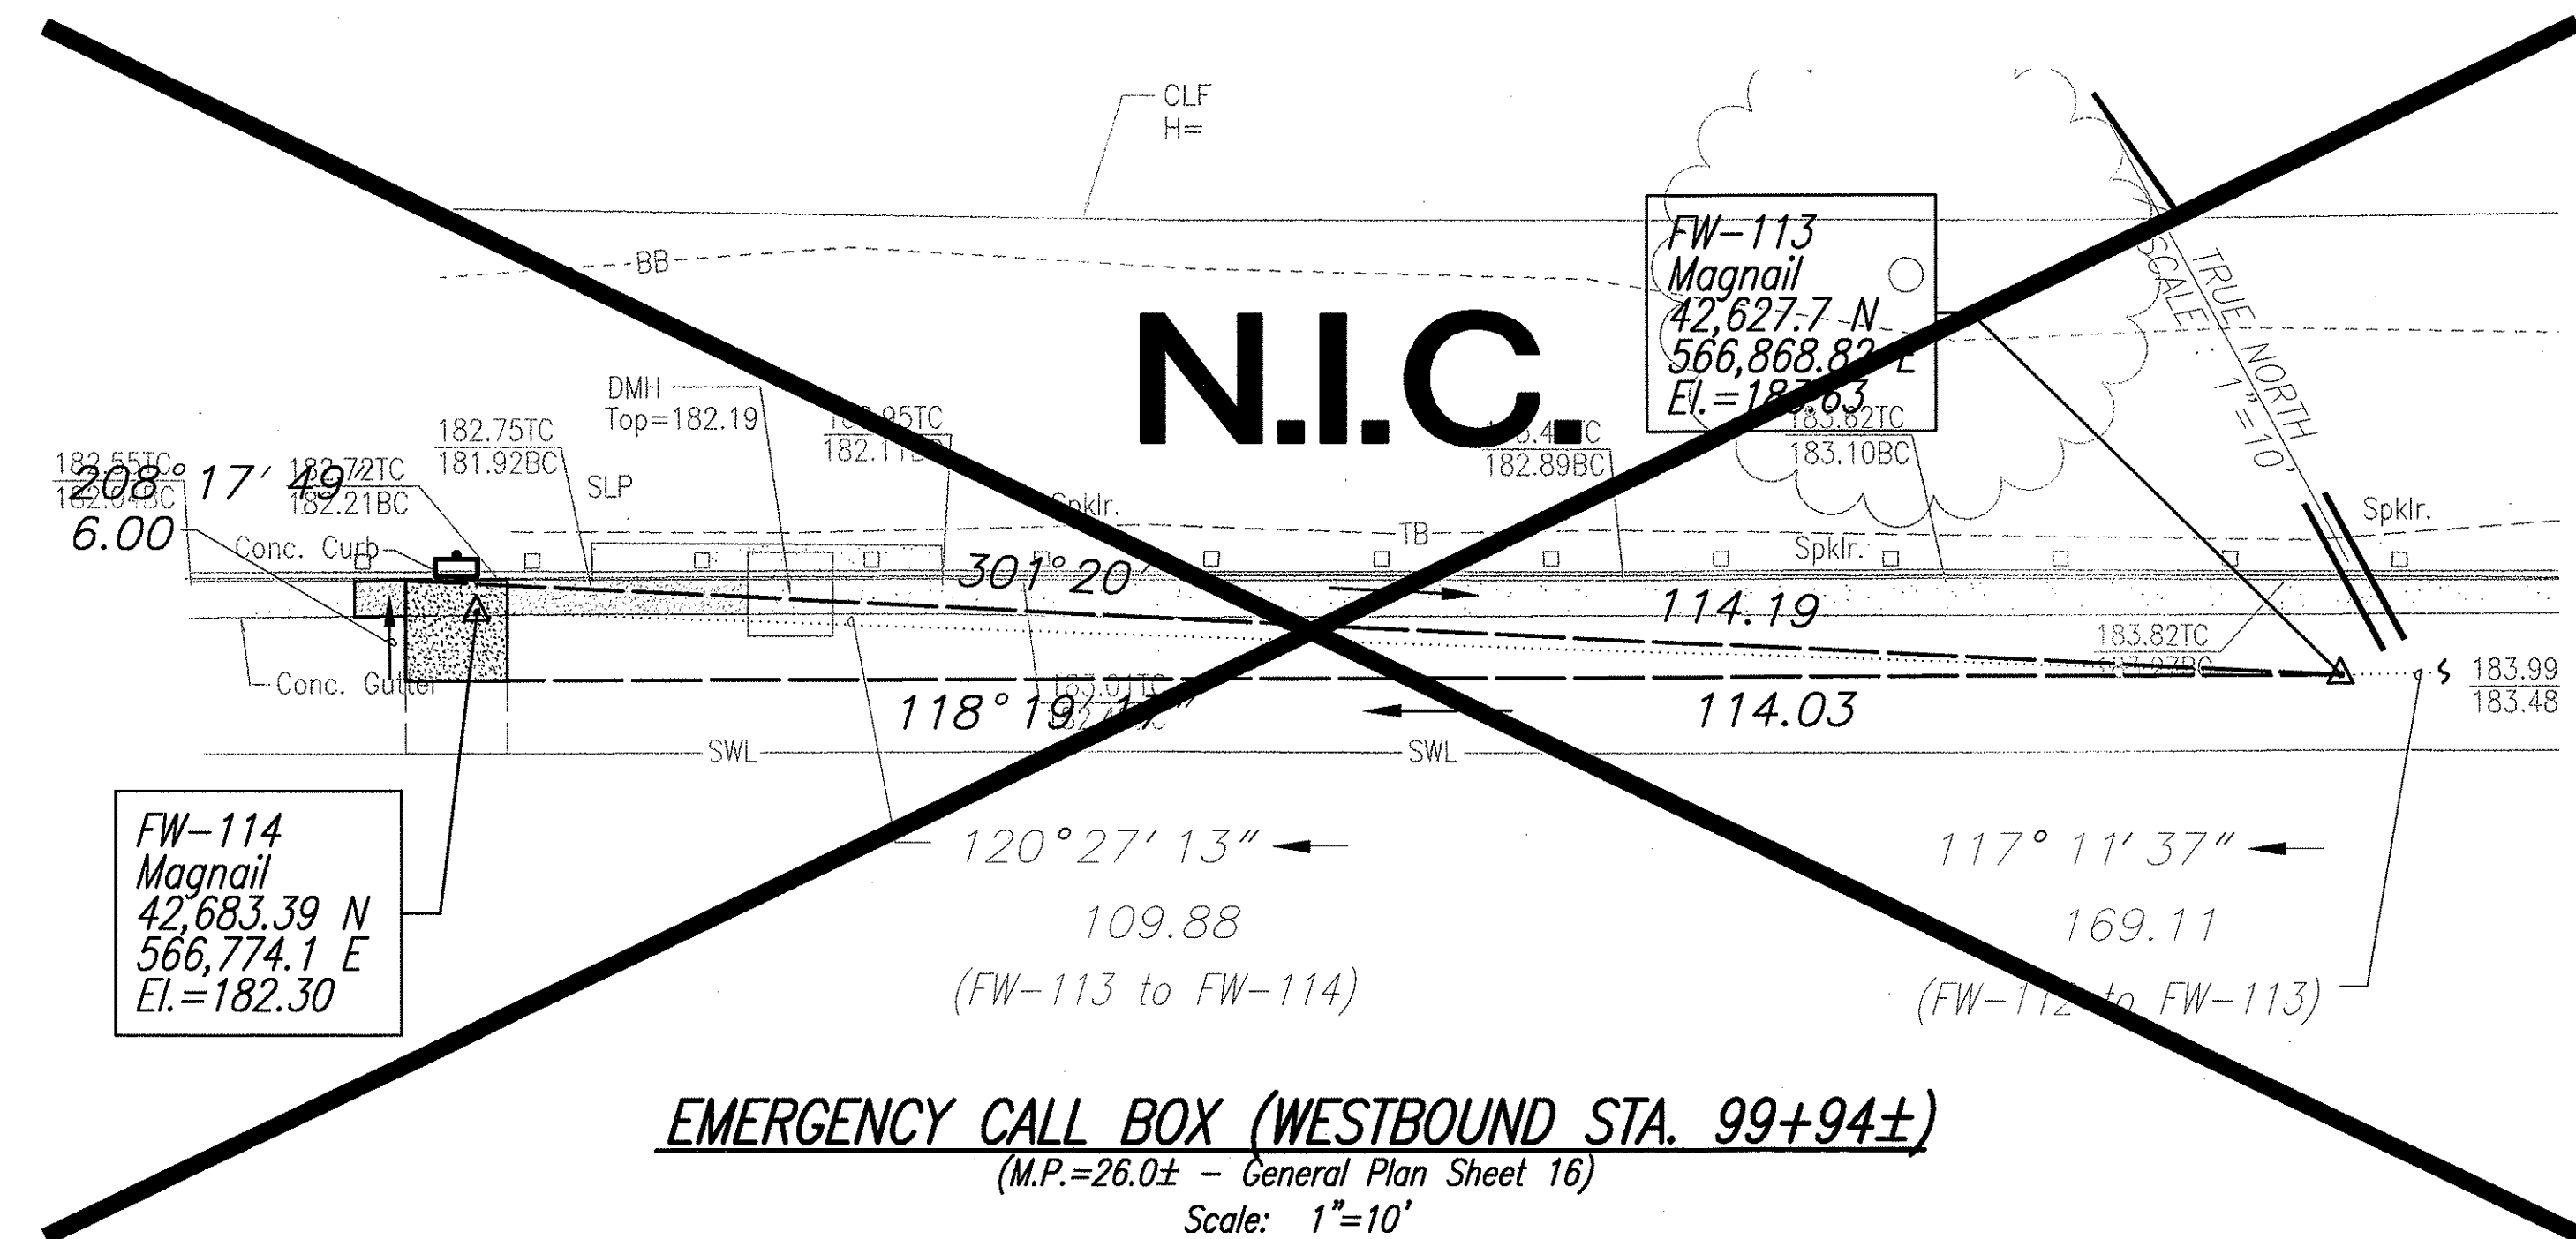



FED. ROAD DIST. NO.	STATE	FED. AID. PROJ. NO.	FISCAL YEAR	SHEET NO.	TOTAL SHEETS
HAWAII	HAW.	NH-300(86)R	2004	38	45

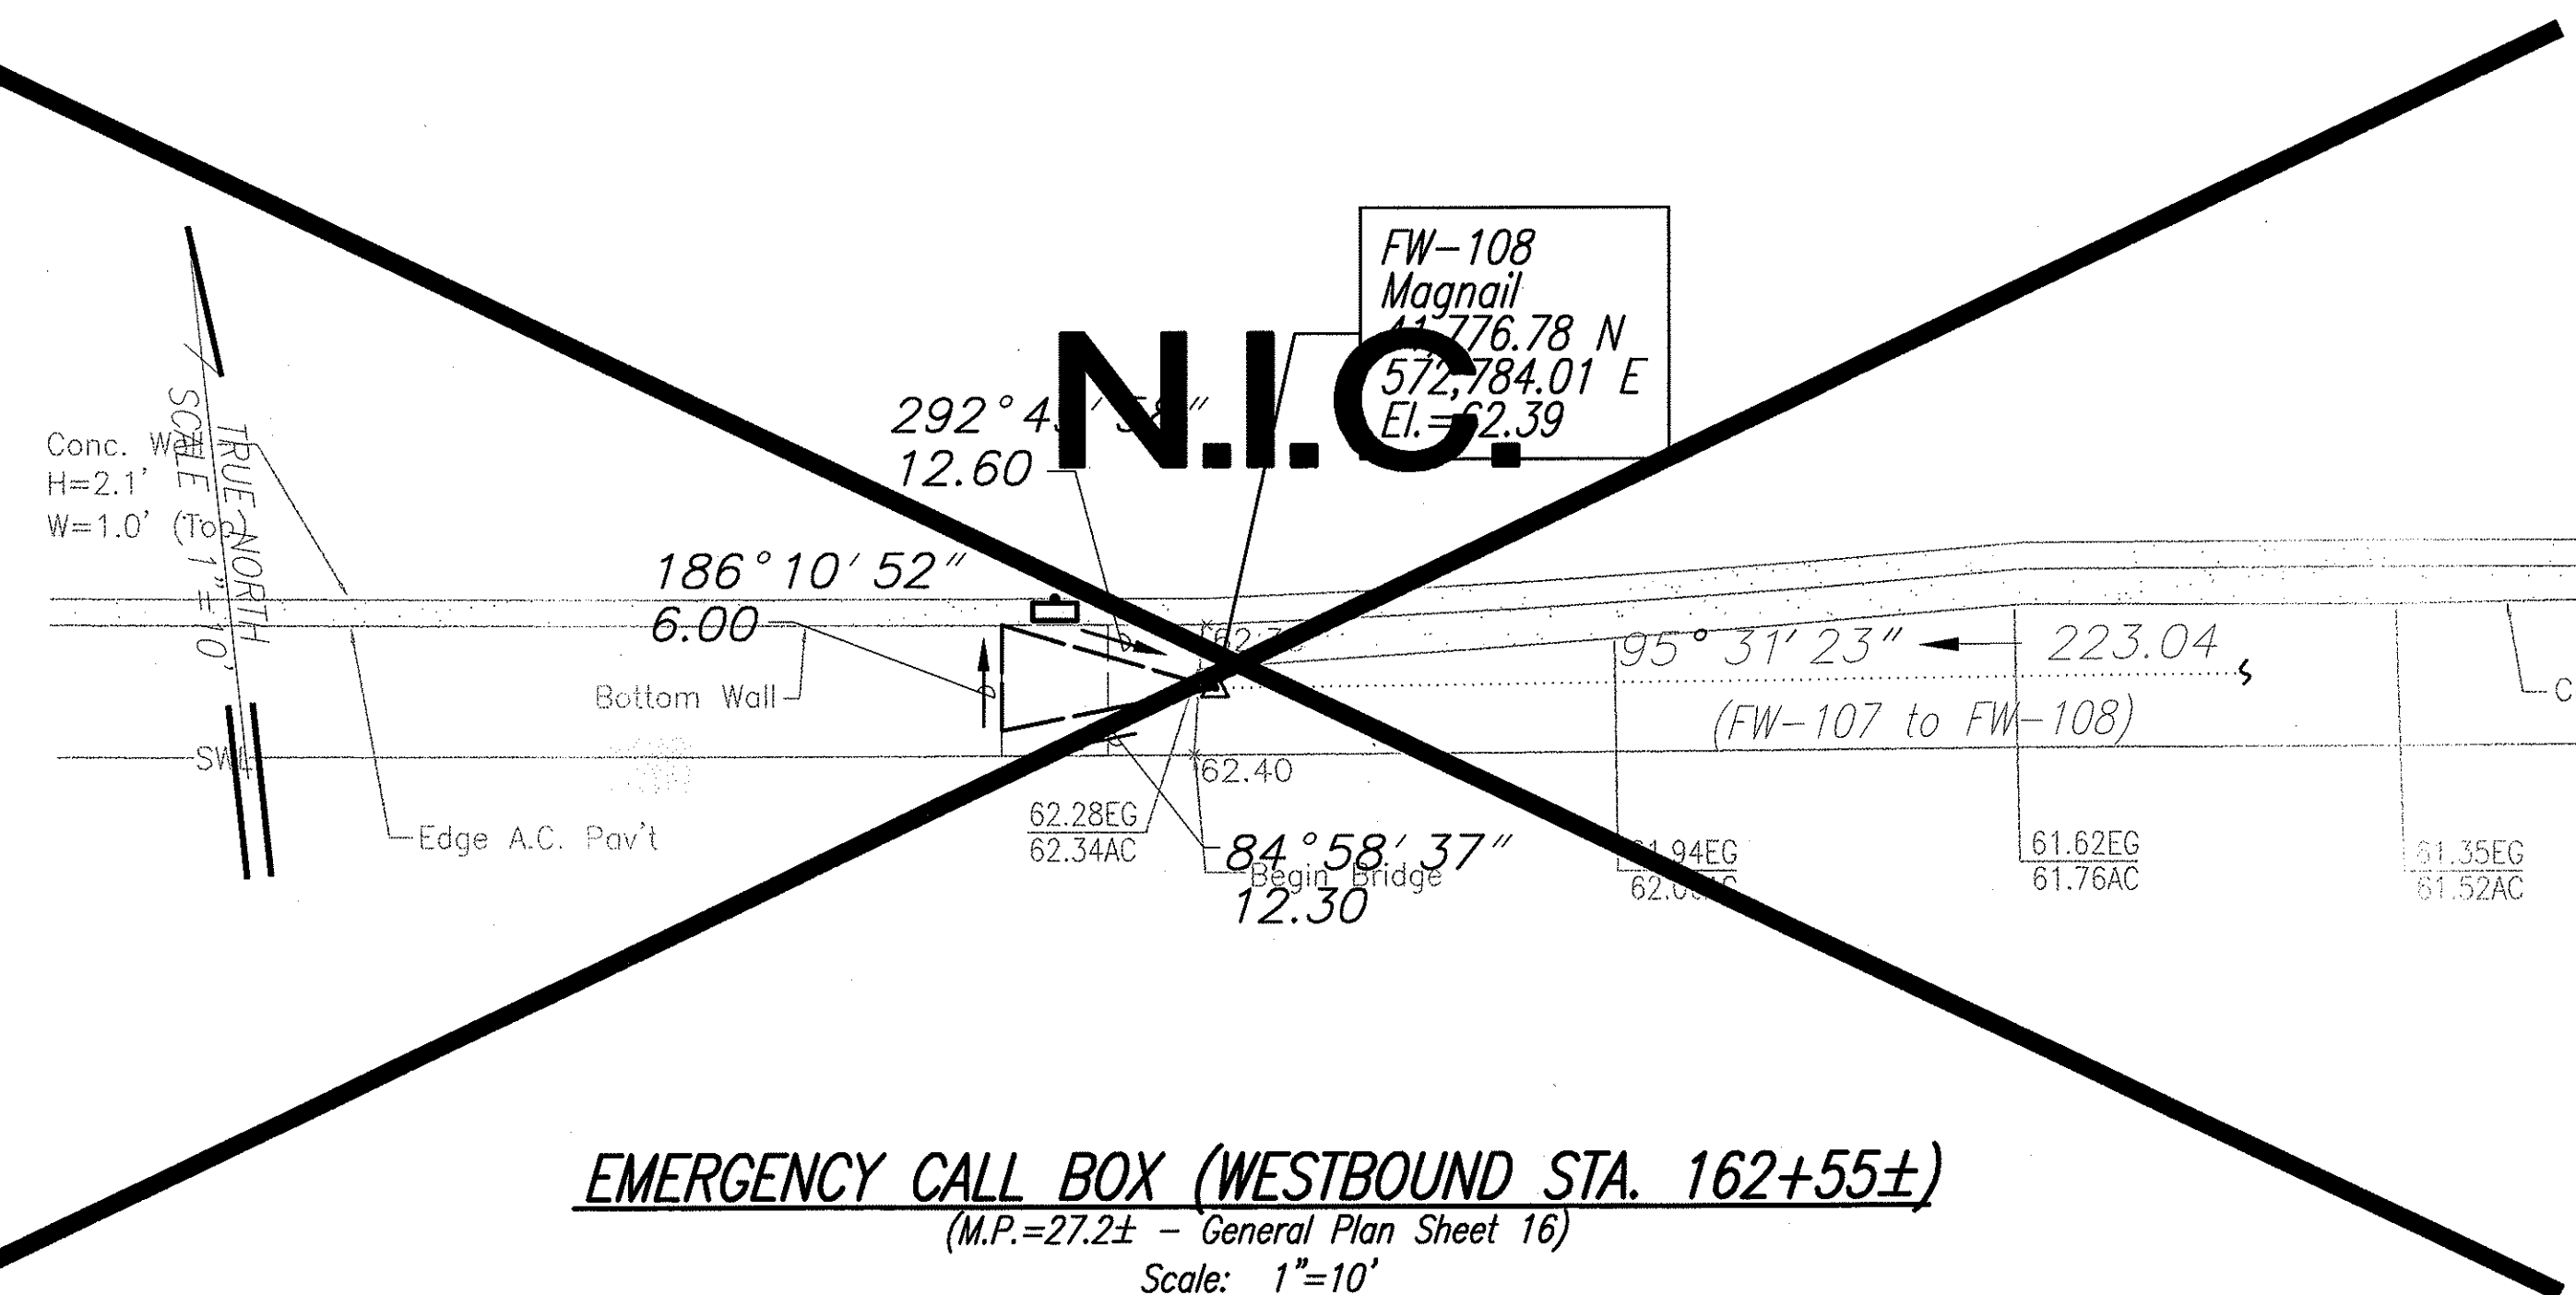

SURVEY PLOTTED BY	DATE
DRAWN BY	
DESIGNED BY	
QUANTITIES BY	
CHECKED BY	
ORIGINAL PLAN	
NOTE BOOK	
No.	

Note:
Coordinates and azimuths
referenced to State Plane
Coordinate System Hawaii Zone 3,
Nad 1927.

Graphic Scale:

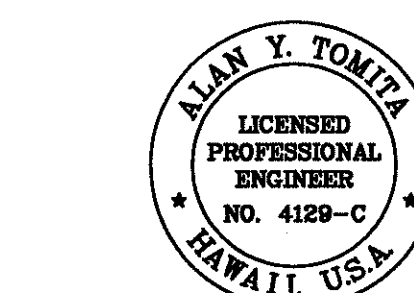

THIS WORK WAS PREPARED BY ME
OR UNDER MY SUPERVISION.

Alan Y. Tomita

STATE OF HAWAII
DEPARTMENT OF TRANSPORTATION
HIGHWAYS DIVISION


**INTERSTATE ROUTE H-1
PAD TIEDOWN-WESTBOUND**

**INTERSTATE ROUTE H-1
EMERGENCY TELEPHONE ACCESSIBLE ROUTES**
F.A. Project No. NH-300(86)R


Scale: As Shown Date: September 2003

SHEET No. 1 OF 7 SHEETS


FED. ROAD DIST. NO.	STATE	FED. AID. PROJ. NO.	FISCAL YEAR	SHEET NO.	TOTAL SHEETS
HAWAII	HAW.	NH-300(86)R	2004	39	45

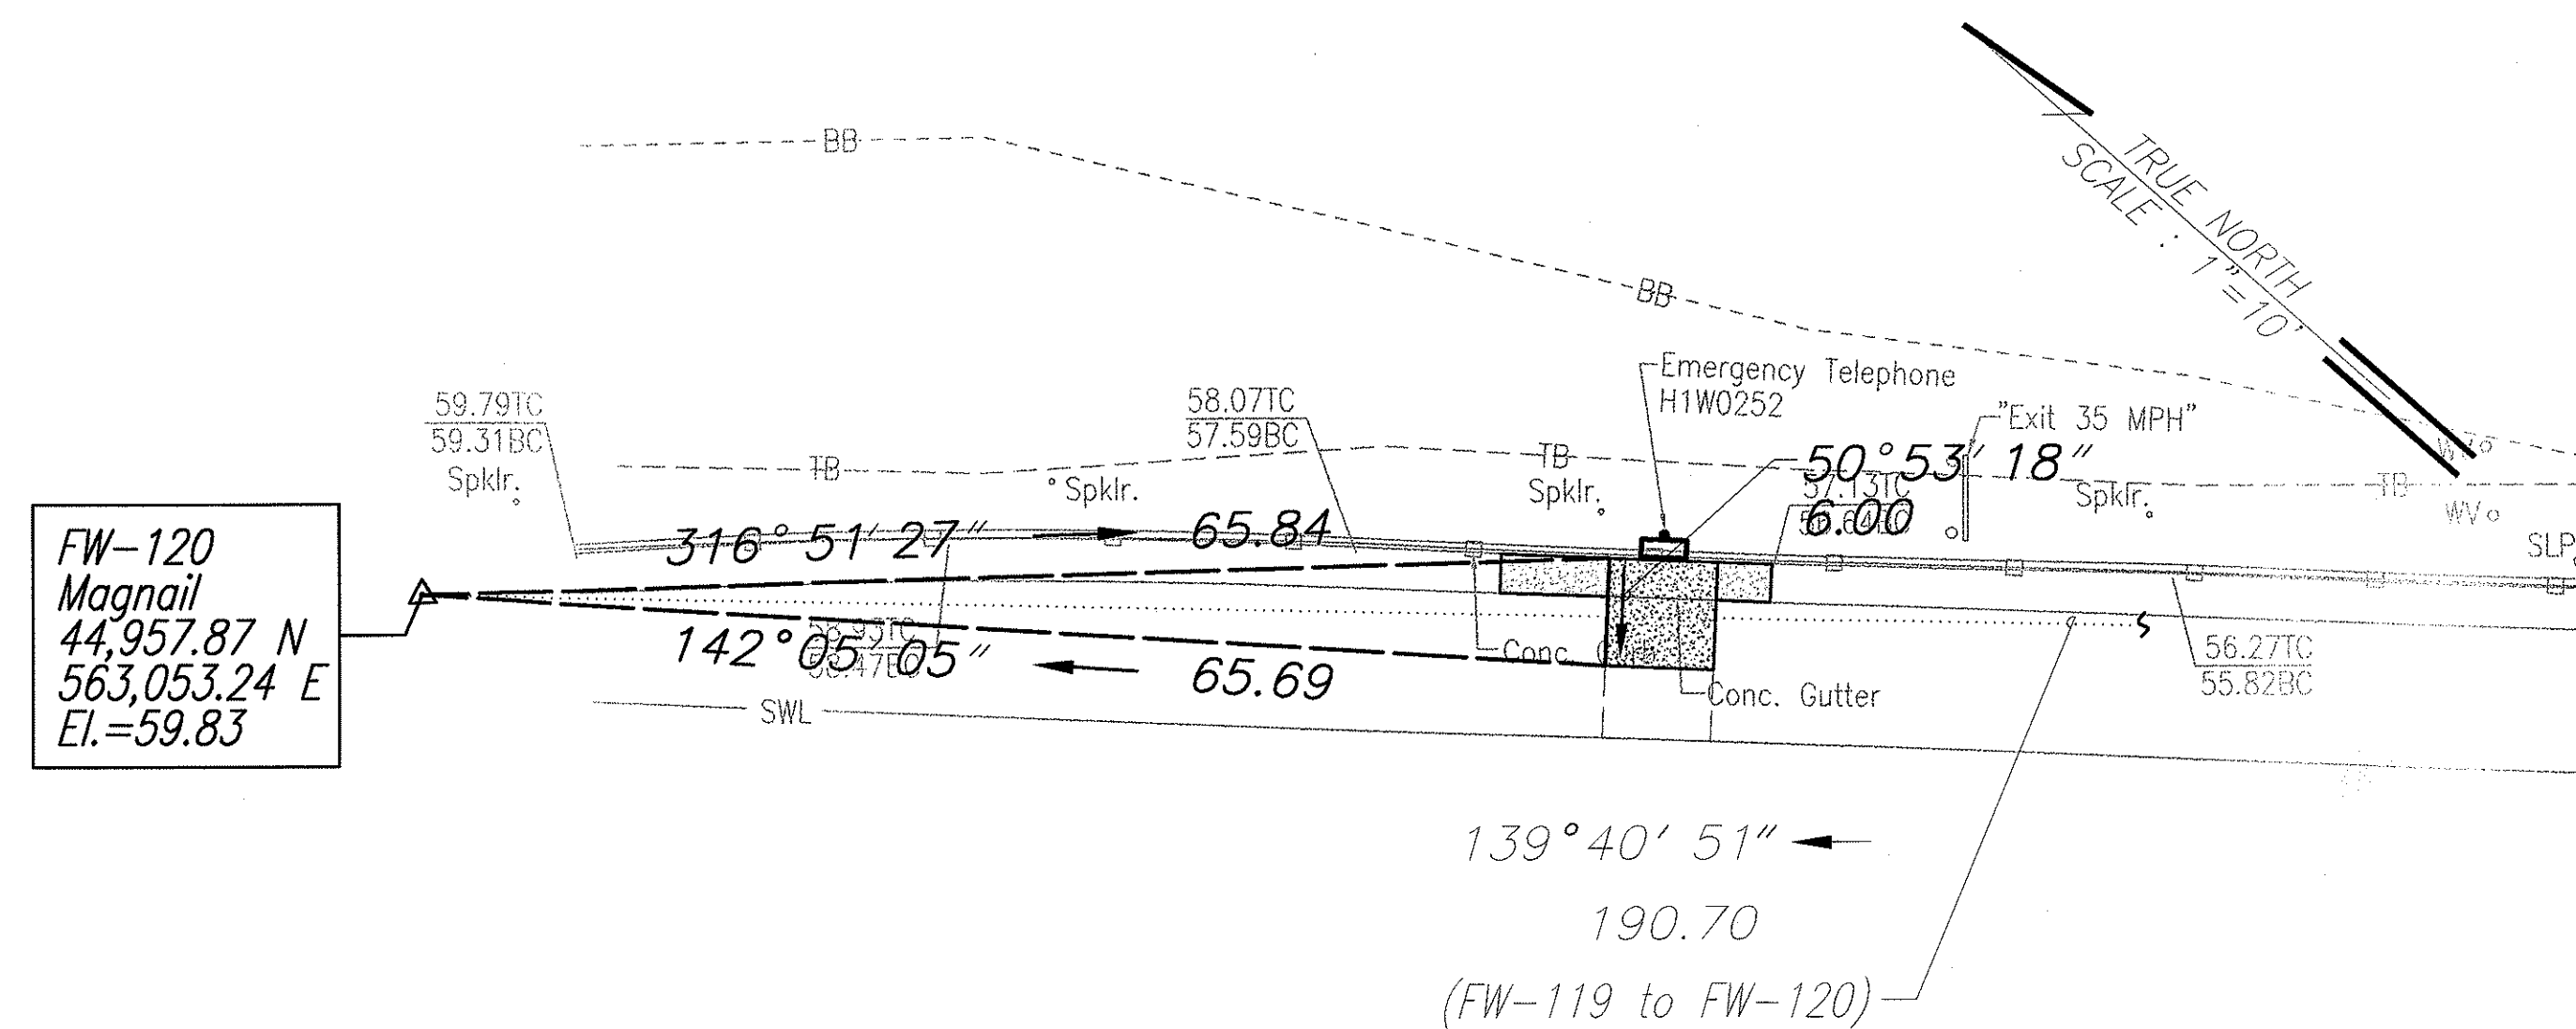


EMERGENCY CALL BOX (WESTBOUND STA. 56+52±)
(M.P.=25.2± - General Plan Sheet 15)
Scale: 1"=10'

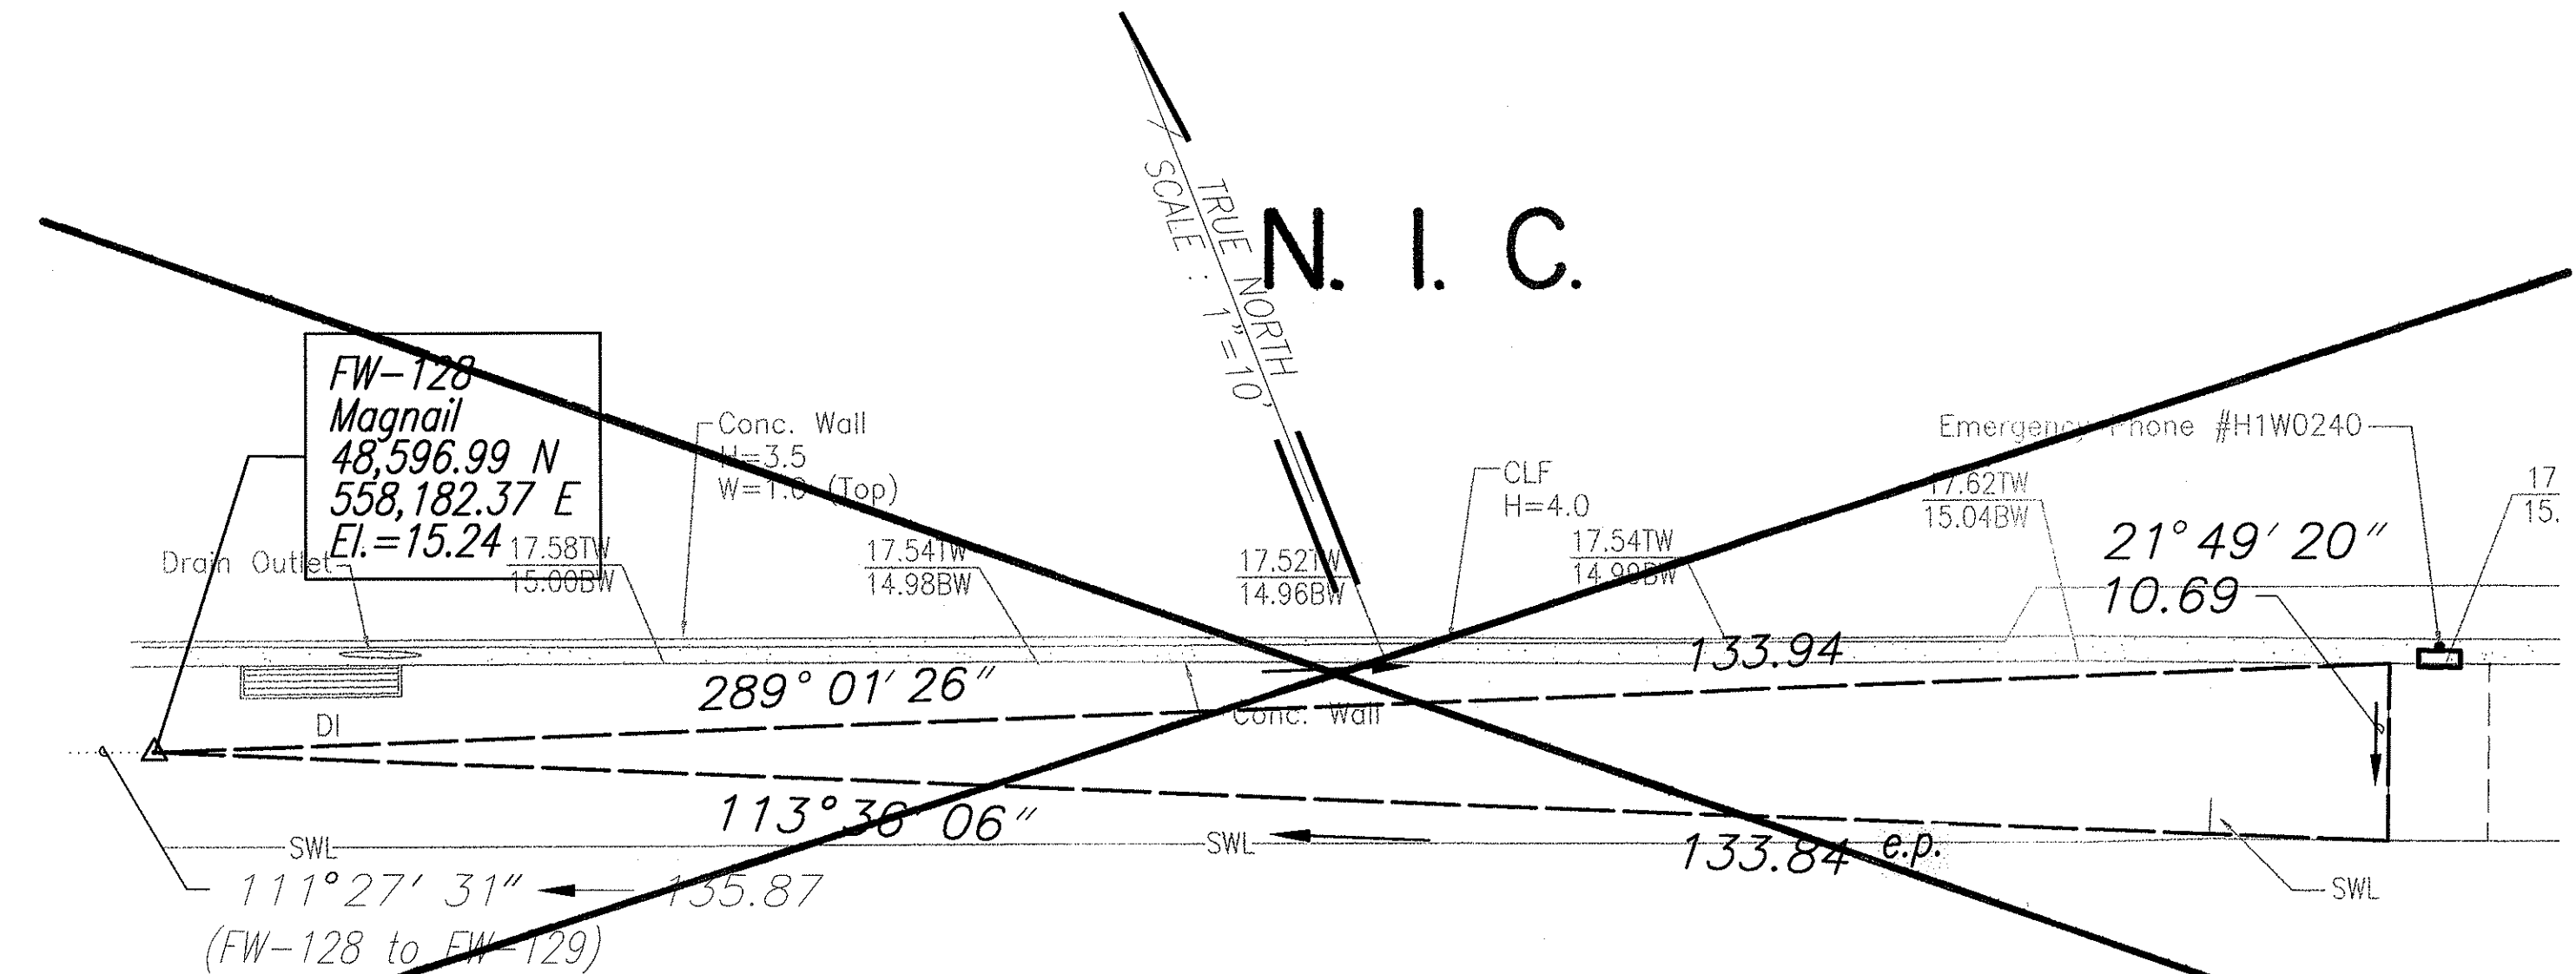

EMERGENCY CALL BOX (WESTBOUND STA. 275+79±)
(M.P.=24.0± - General Plan Sheet 15)
Scale: 1"=10'

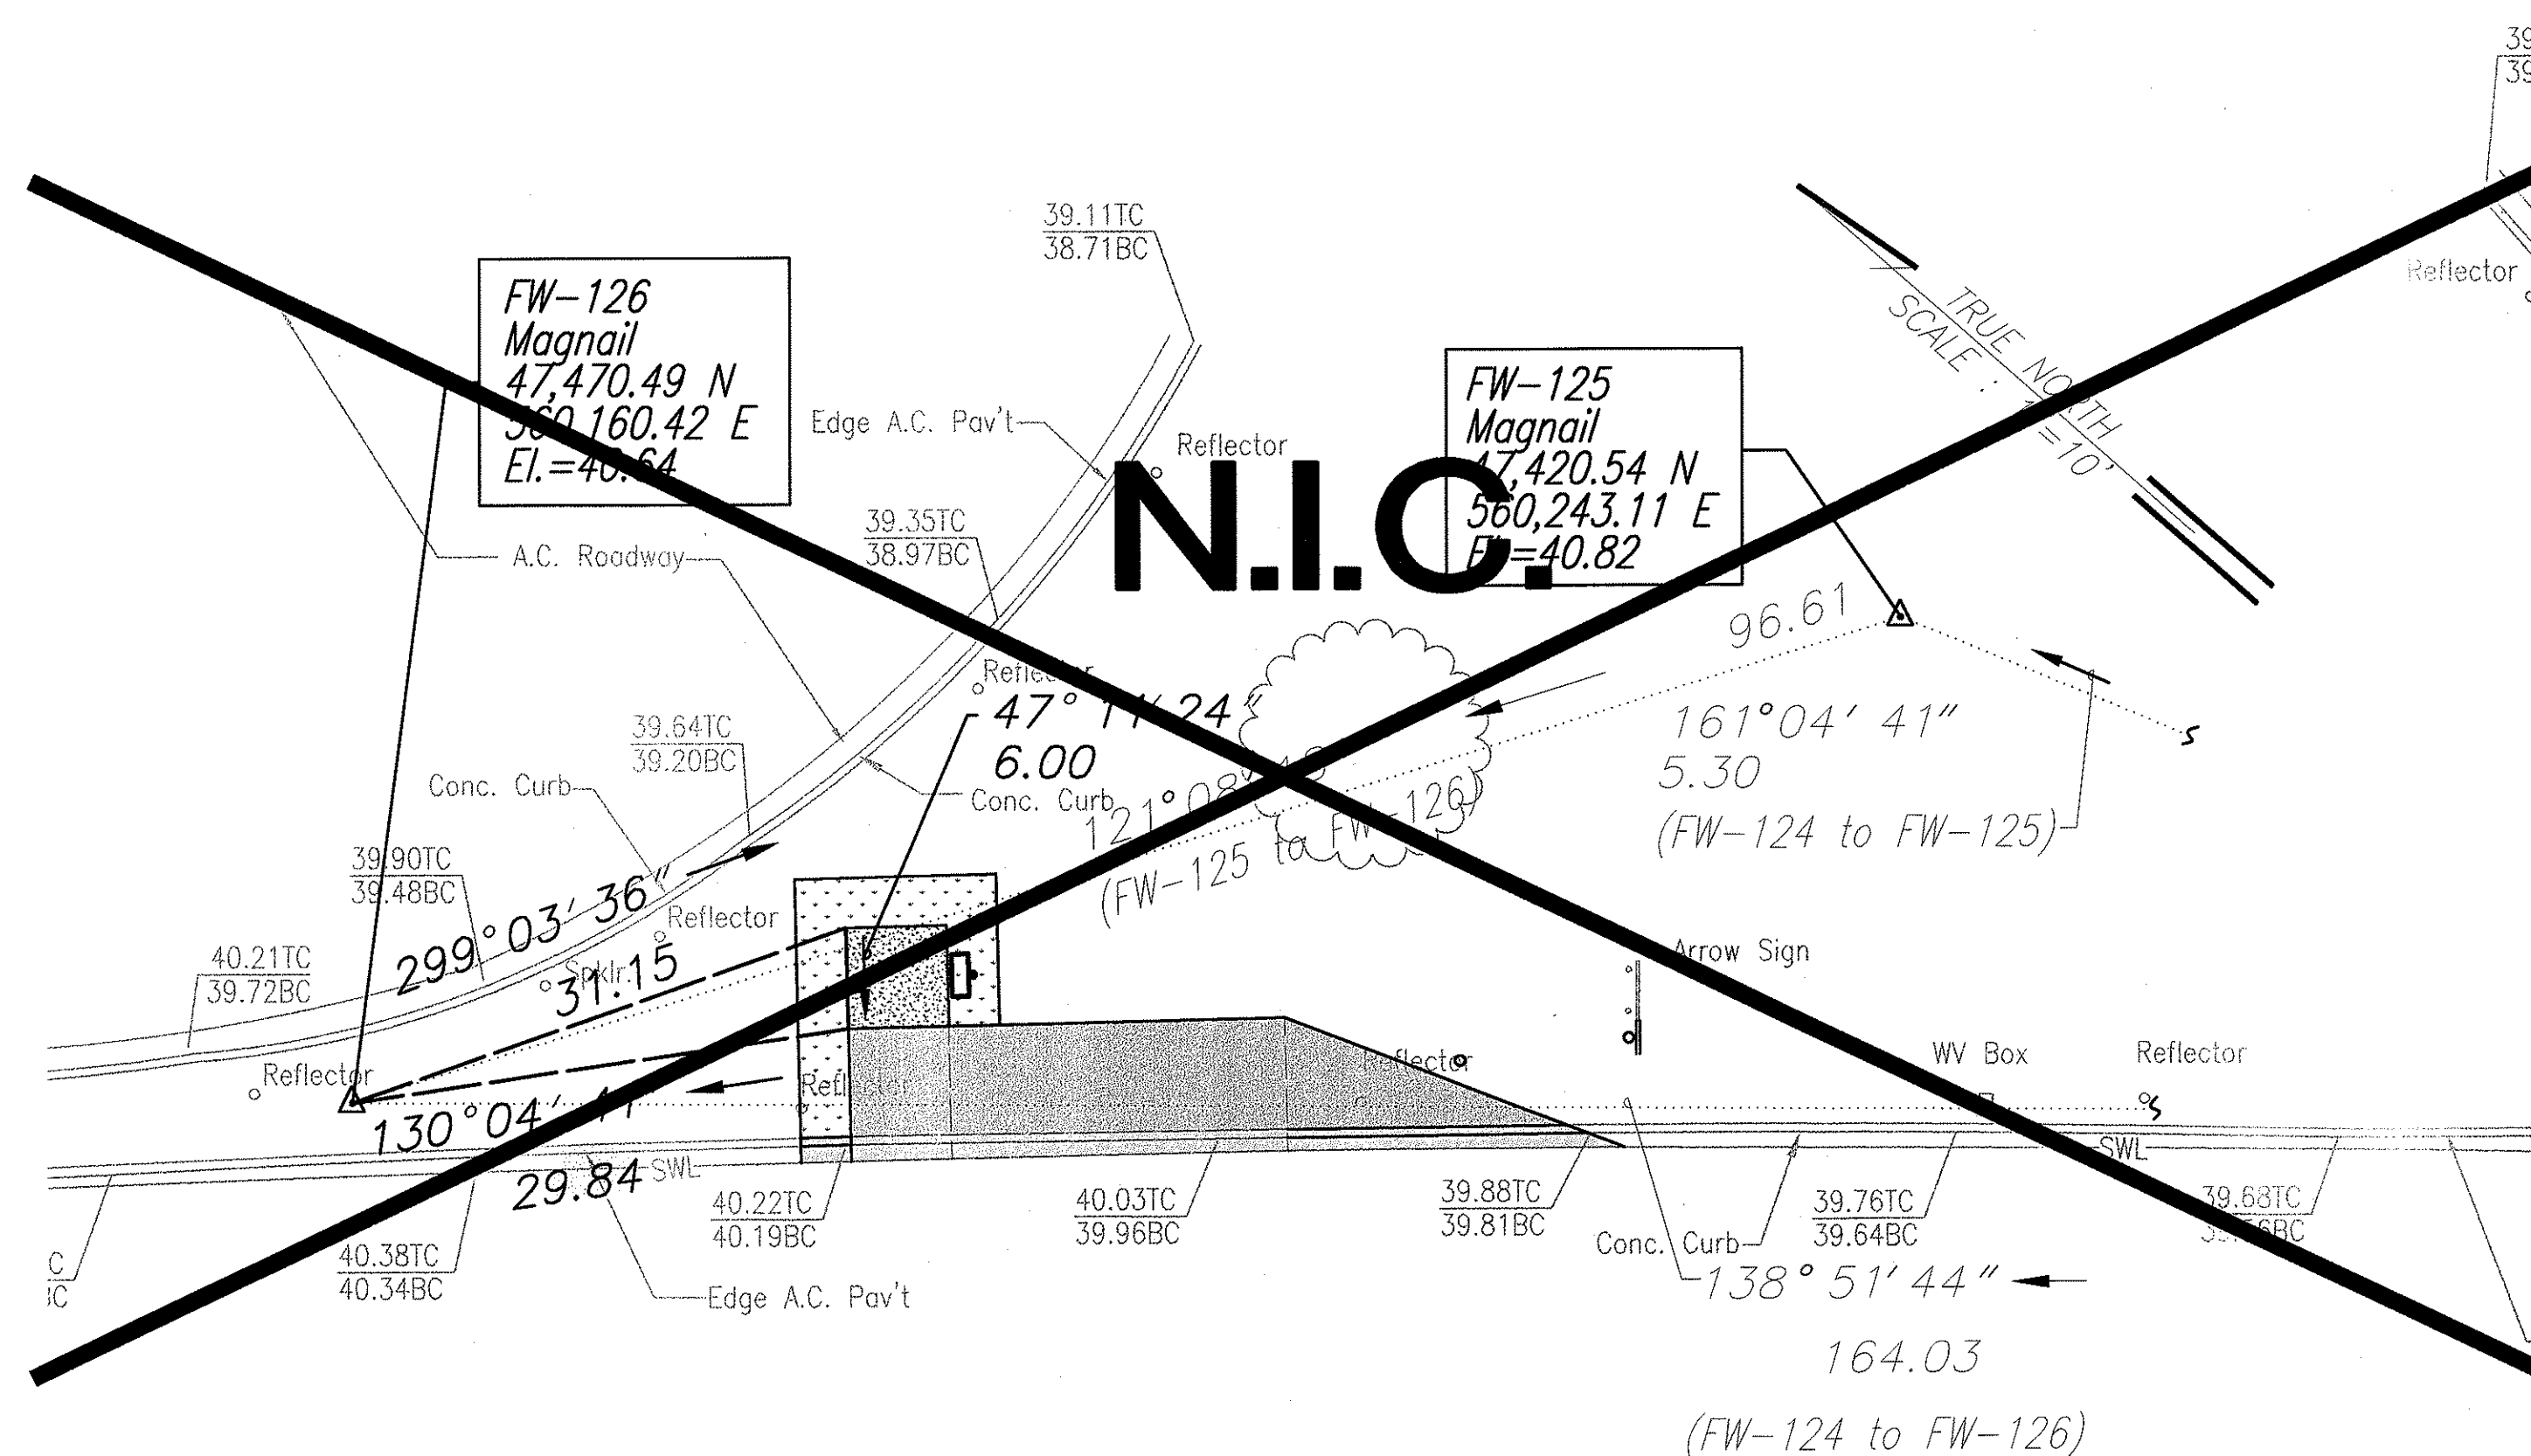



EMERGENCY CALL BOX (WESTBOUND STA. 17+48±)
(M.P.=24.4± - General Plan Sheet 15)
Scale: 1"=10'

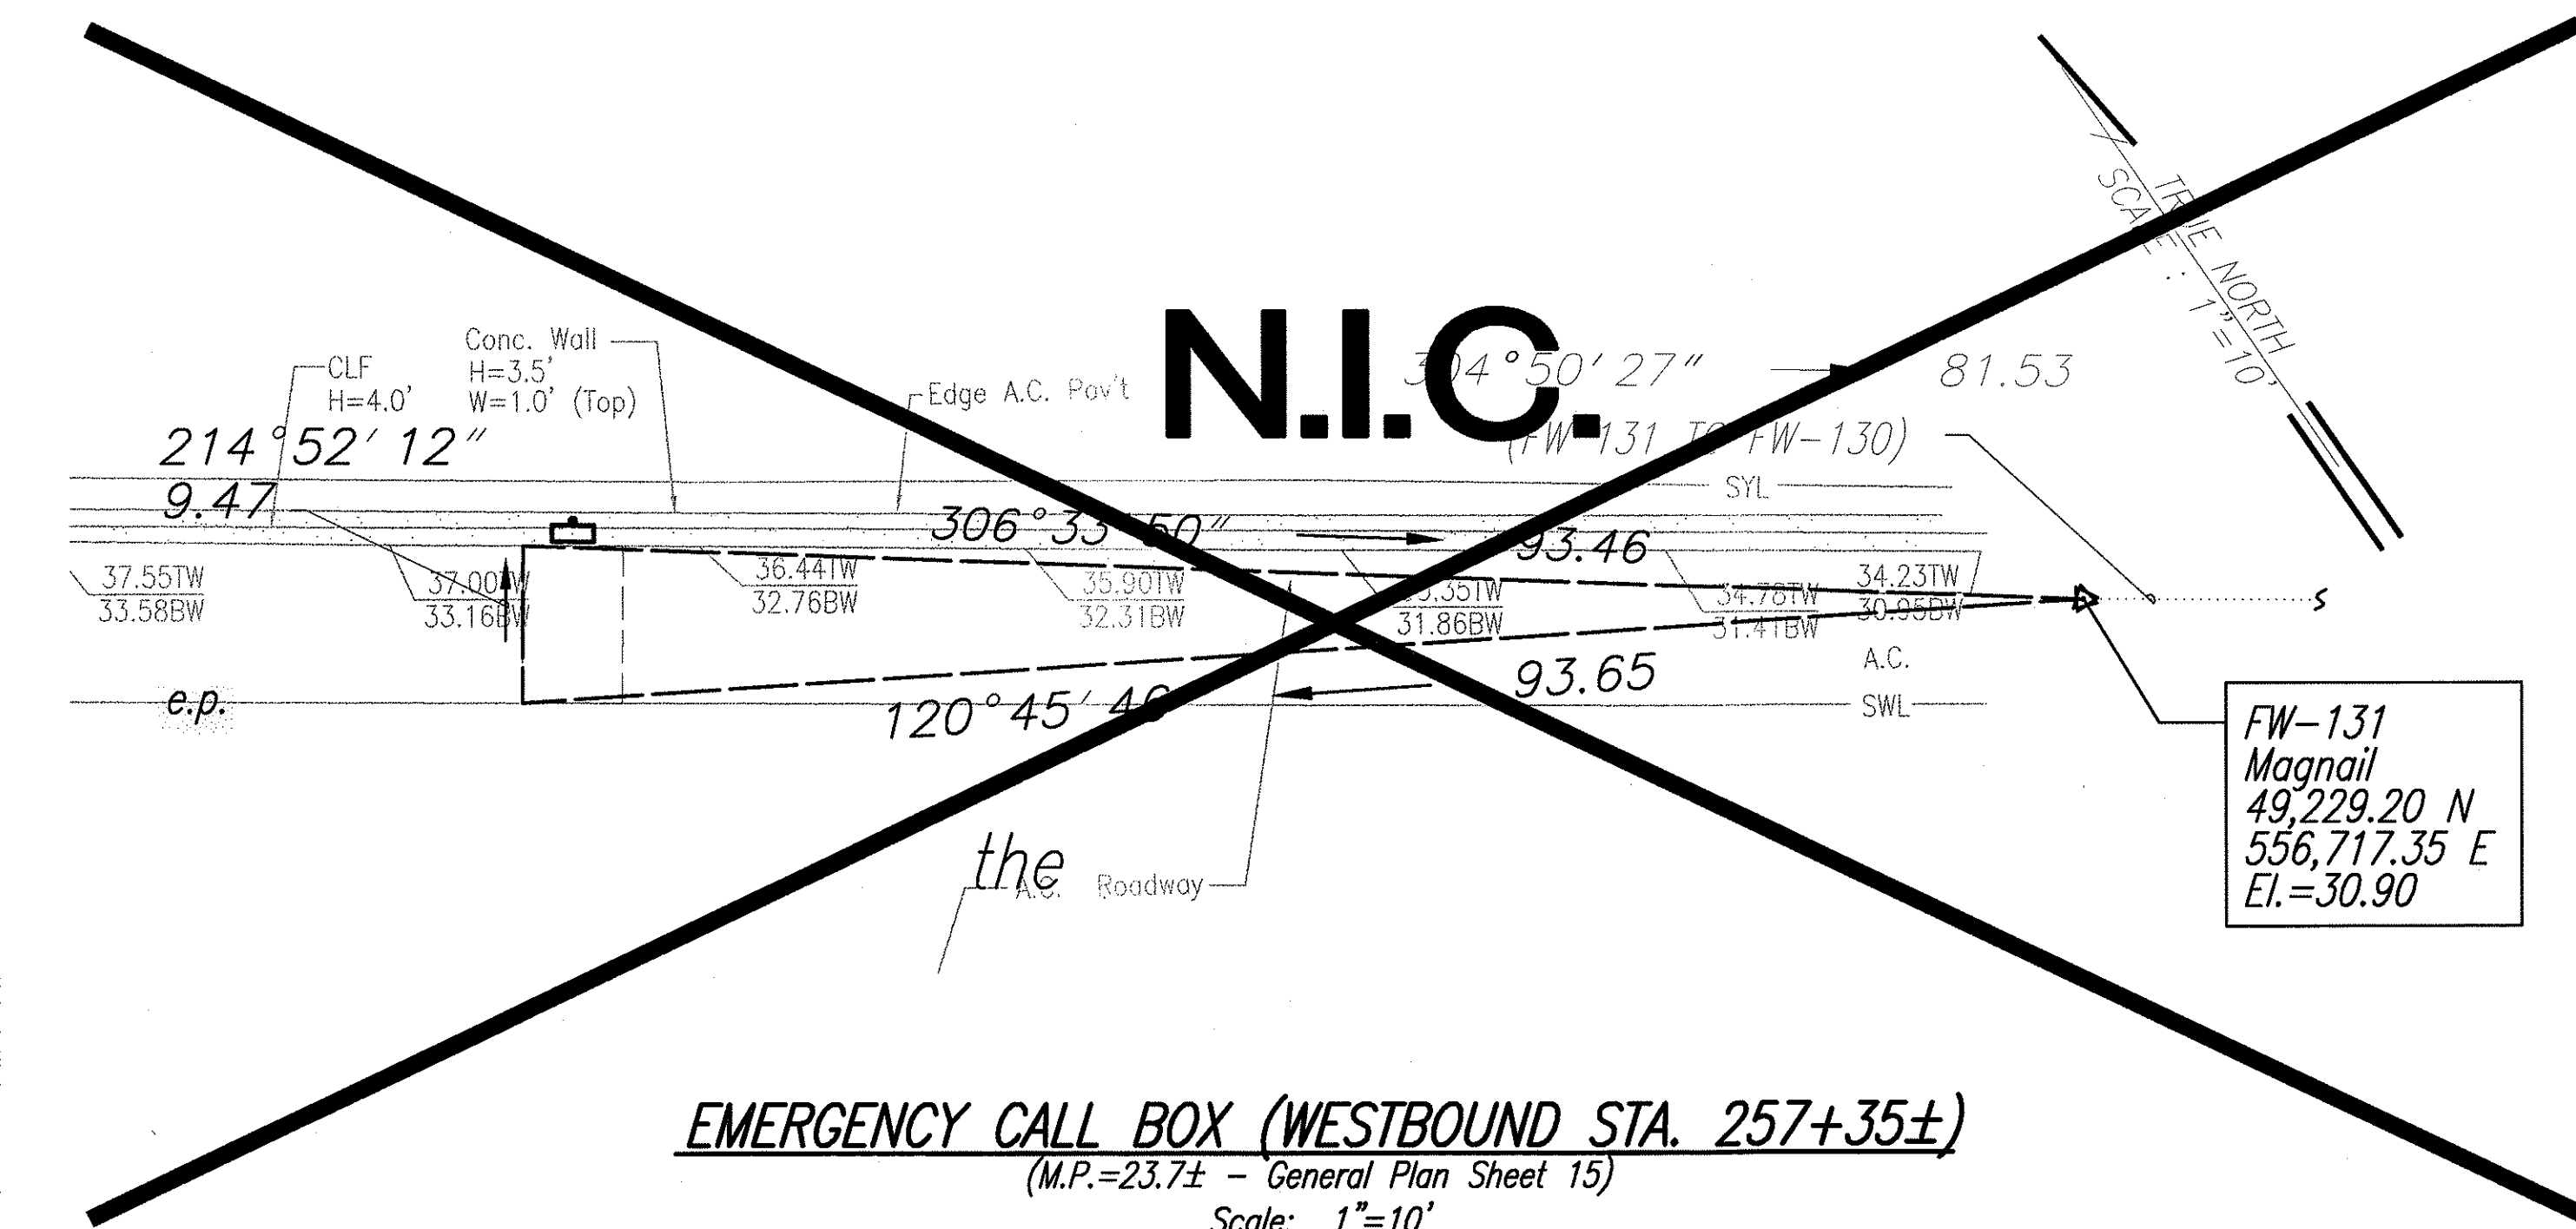

EMERGENCY CALL BOX (WESTBOUND STA. 257+35±)
(M.P.=23.7± - General Plan Sheet 15)
Scale: 1"=10'

SURVEY PLOTTED BY	DATE
DRAWN BY	
TRACED BY	
QUANTITIES BY	
CHECKED BY	
ORIGINAL PLAN	
NOTE BOOK	
No.	

Note:
Coordinates and azimuths
referenced to State Plane
Coordinate System Hawaii Zone 3,
Nad 1927.

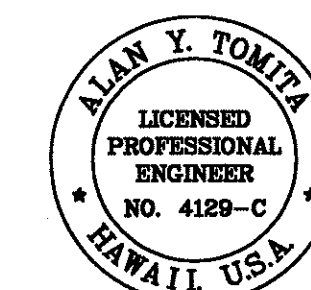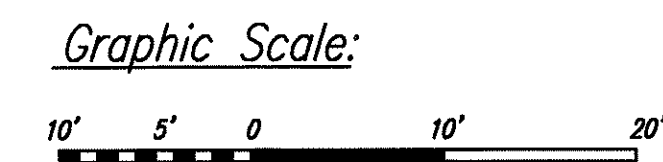

THIS WORK WAS PREPARED BY ME
OR UNDER MY SUPERVISION.

Alan Y. Tomita

STATE OF HAWAII
DEPARTMENT OF TRANSPORTATION
HIGHWAYS DIVISION





**INTERSTATE ROUTE H-1
PAD TIEDOWN-WESTBOUND**

**INTERSTATE ROUTE H-1
EMERGENCY TELEPHONE ACCESSIBLE ROUTES**
E.A. Project No. NH-300(86)R

Scale: As Shown Date: September 2003

SHEET No. 2 OF 7 SHEETS


FED. ROAD DIST. NO.	STATE	FED. AID. PROJ. NO.	FISCAL YEAR	SHEET NO.	TOTAL SHEETS
HAWAII	HAW.	NH-300(86)R	2004	40	45

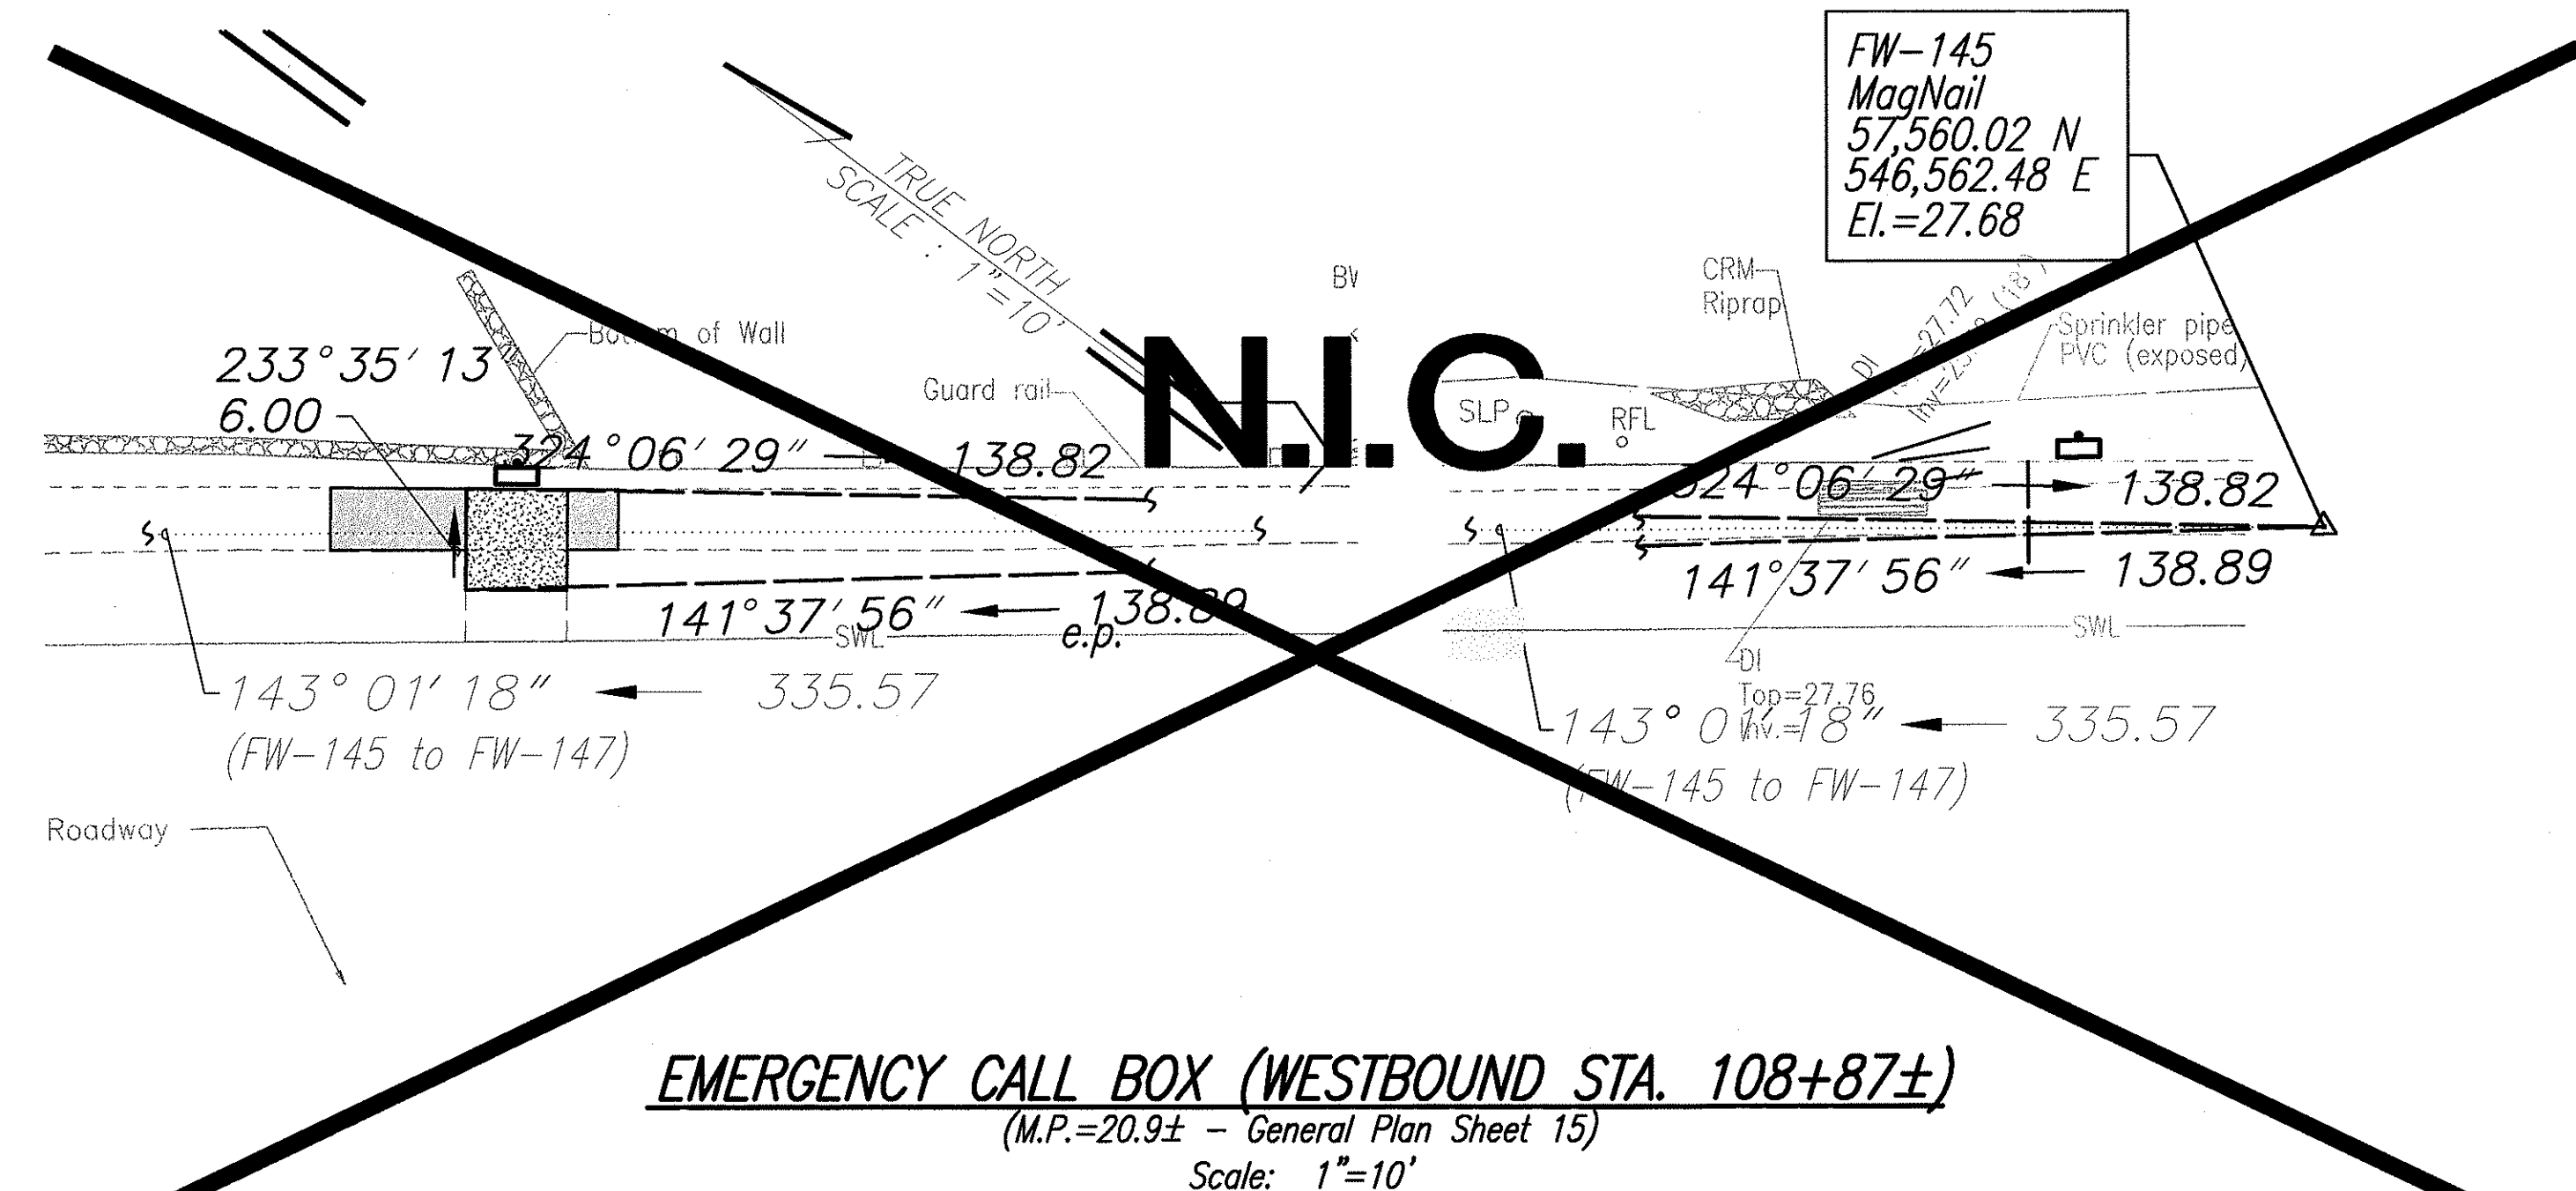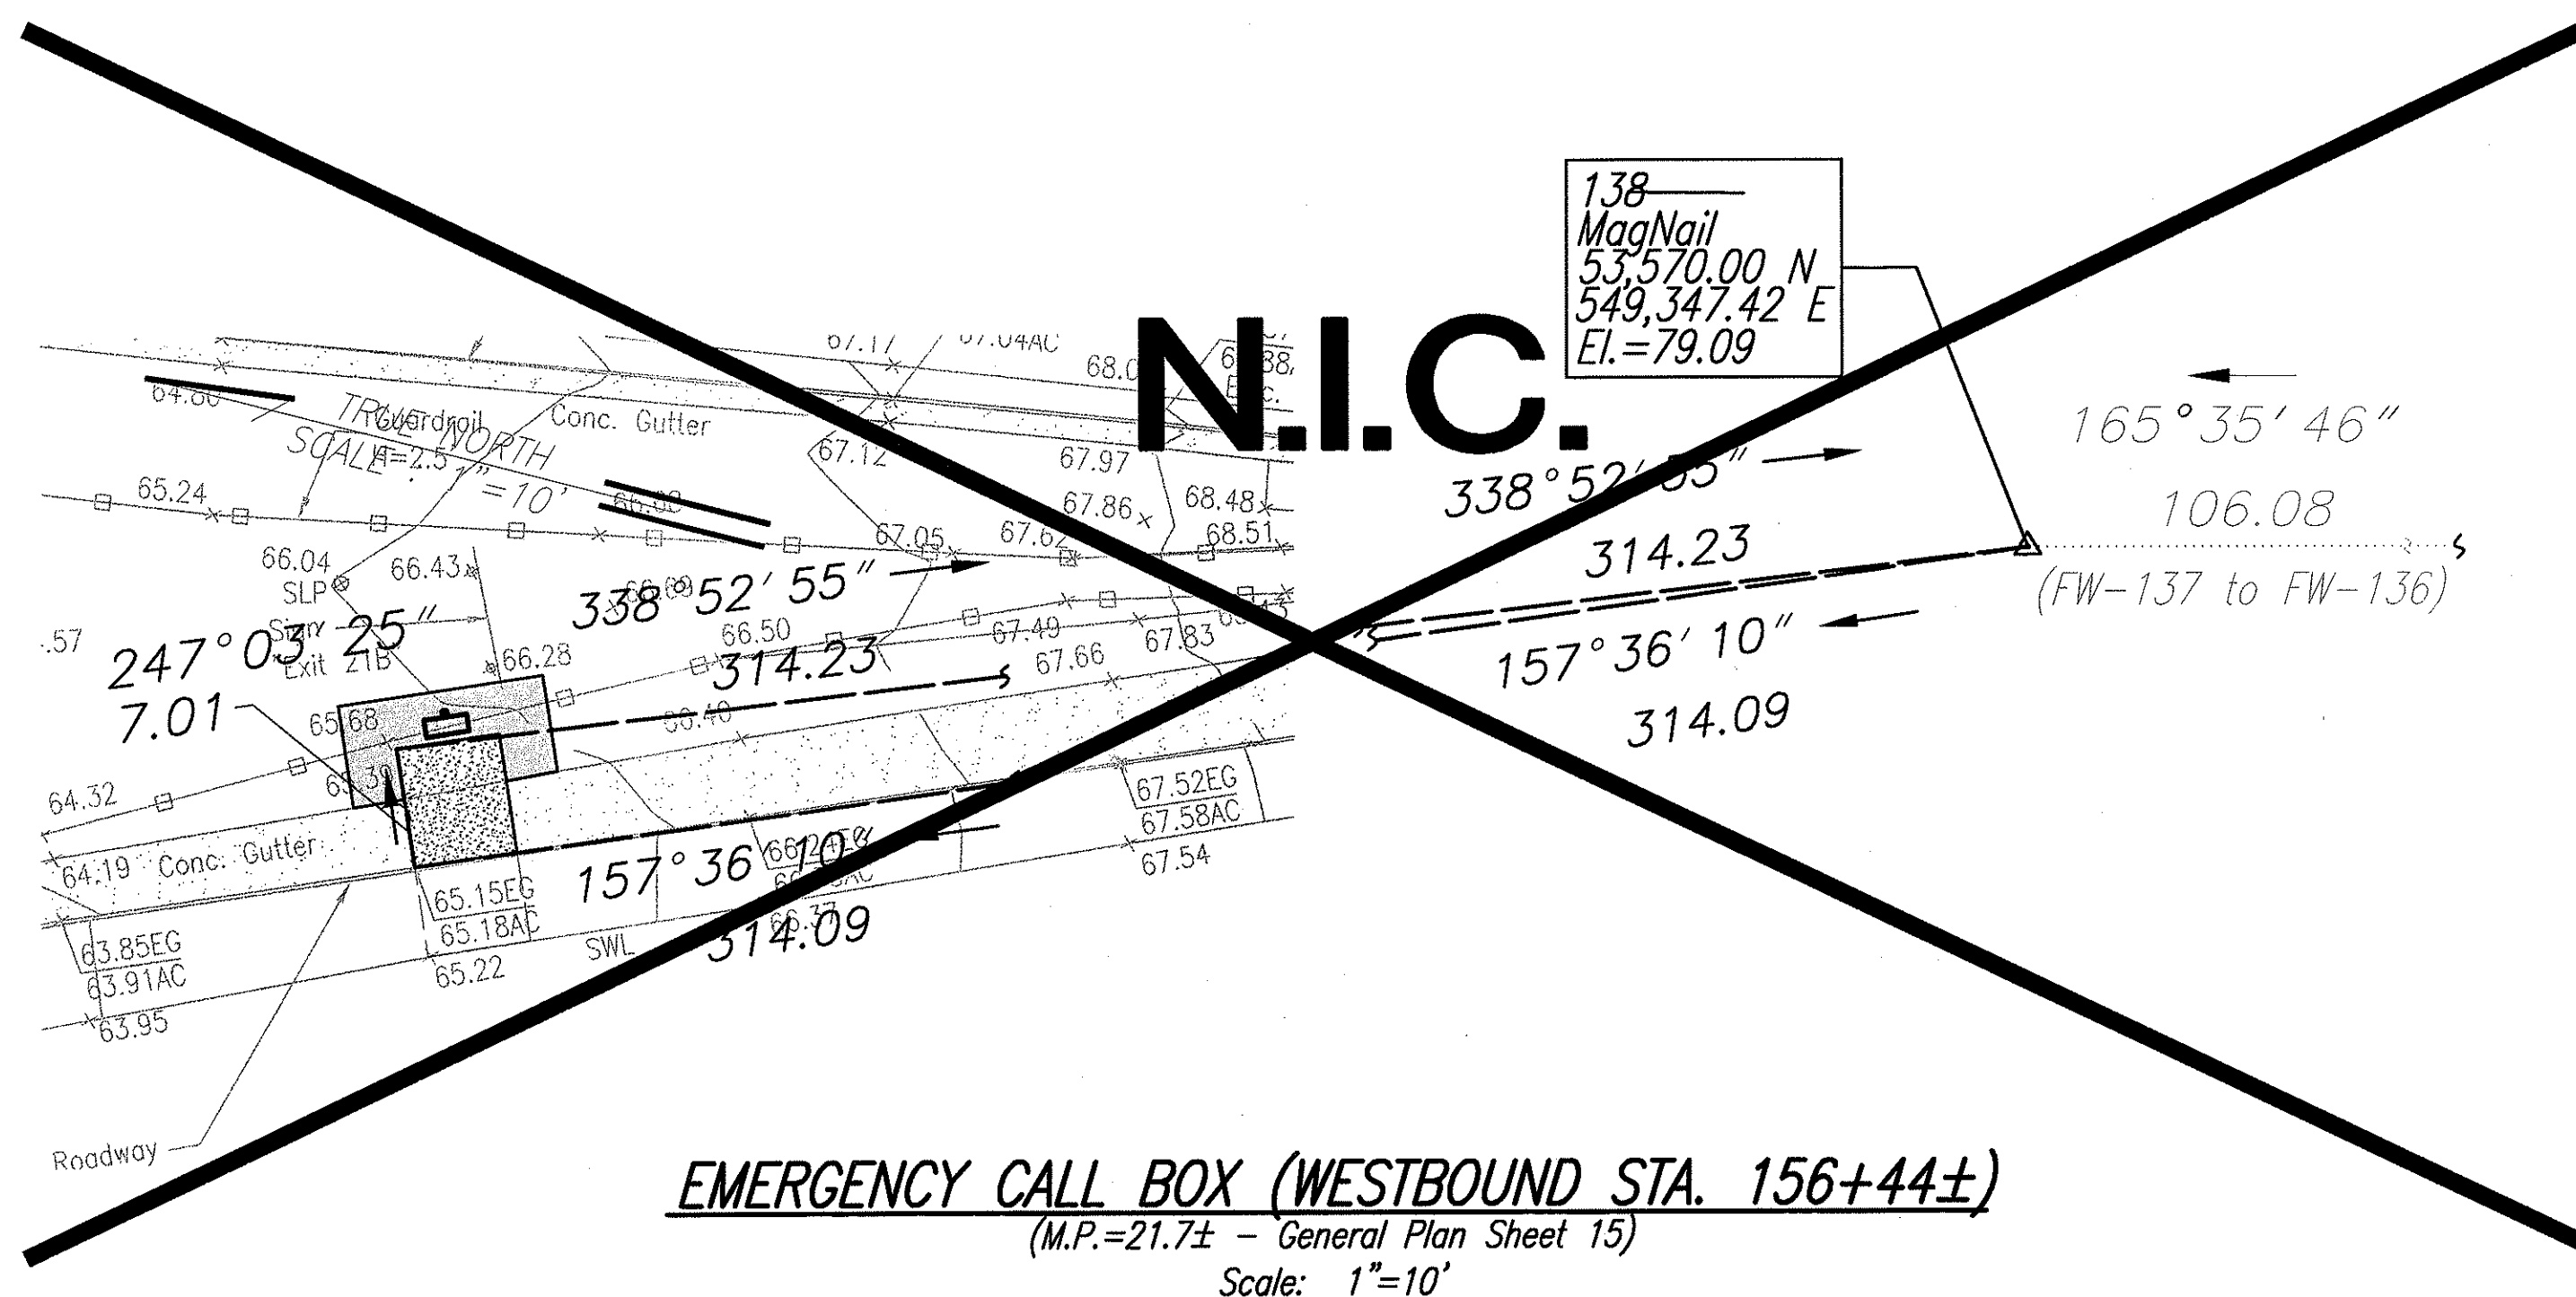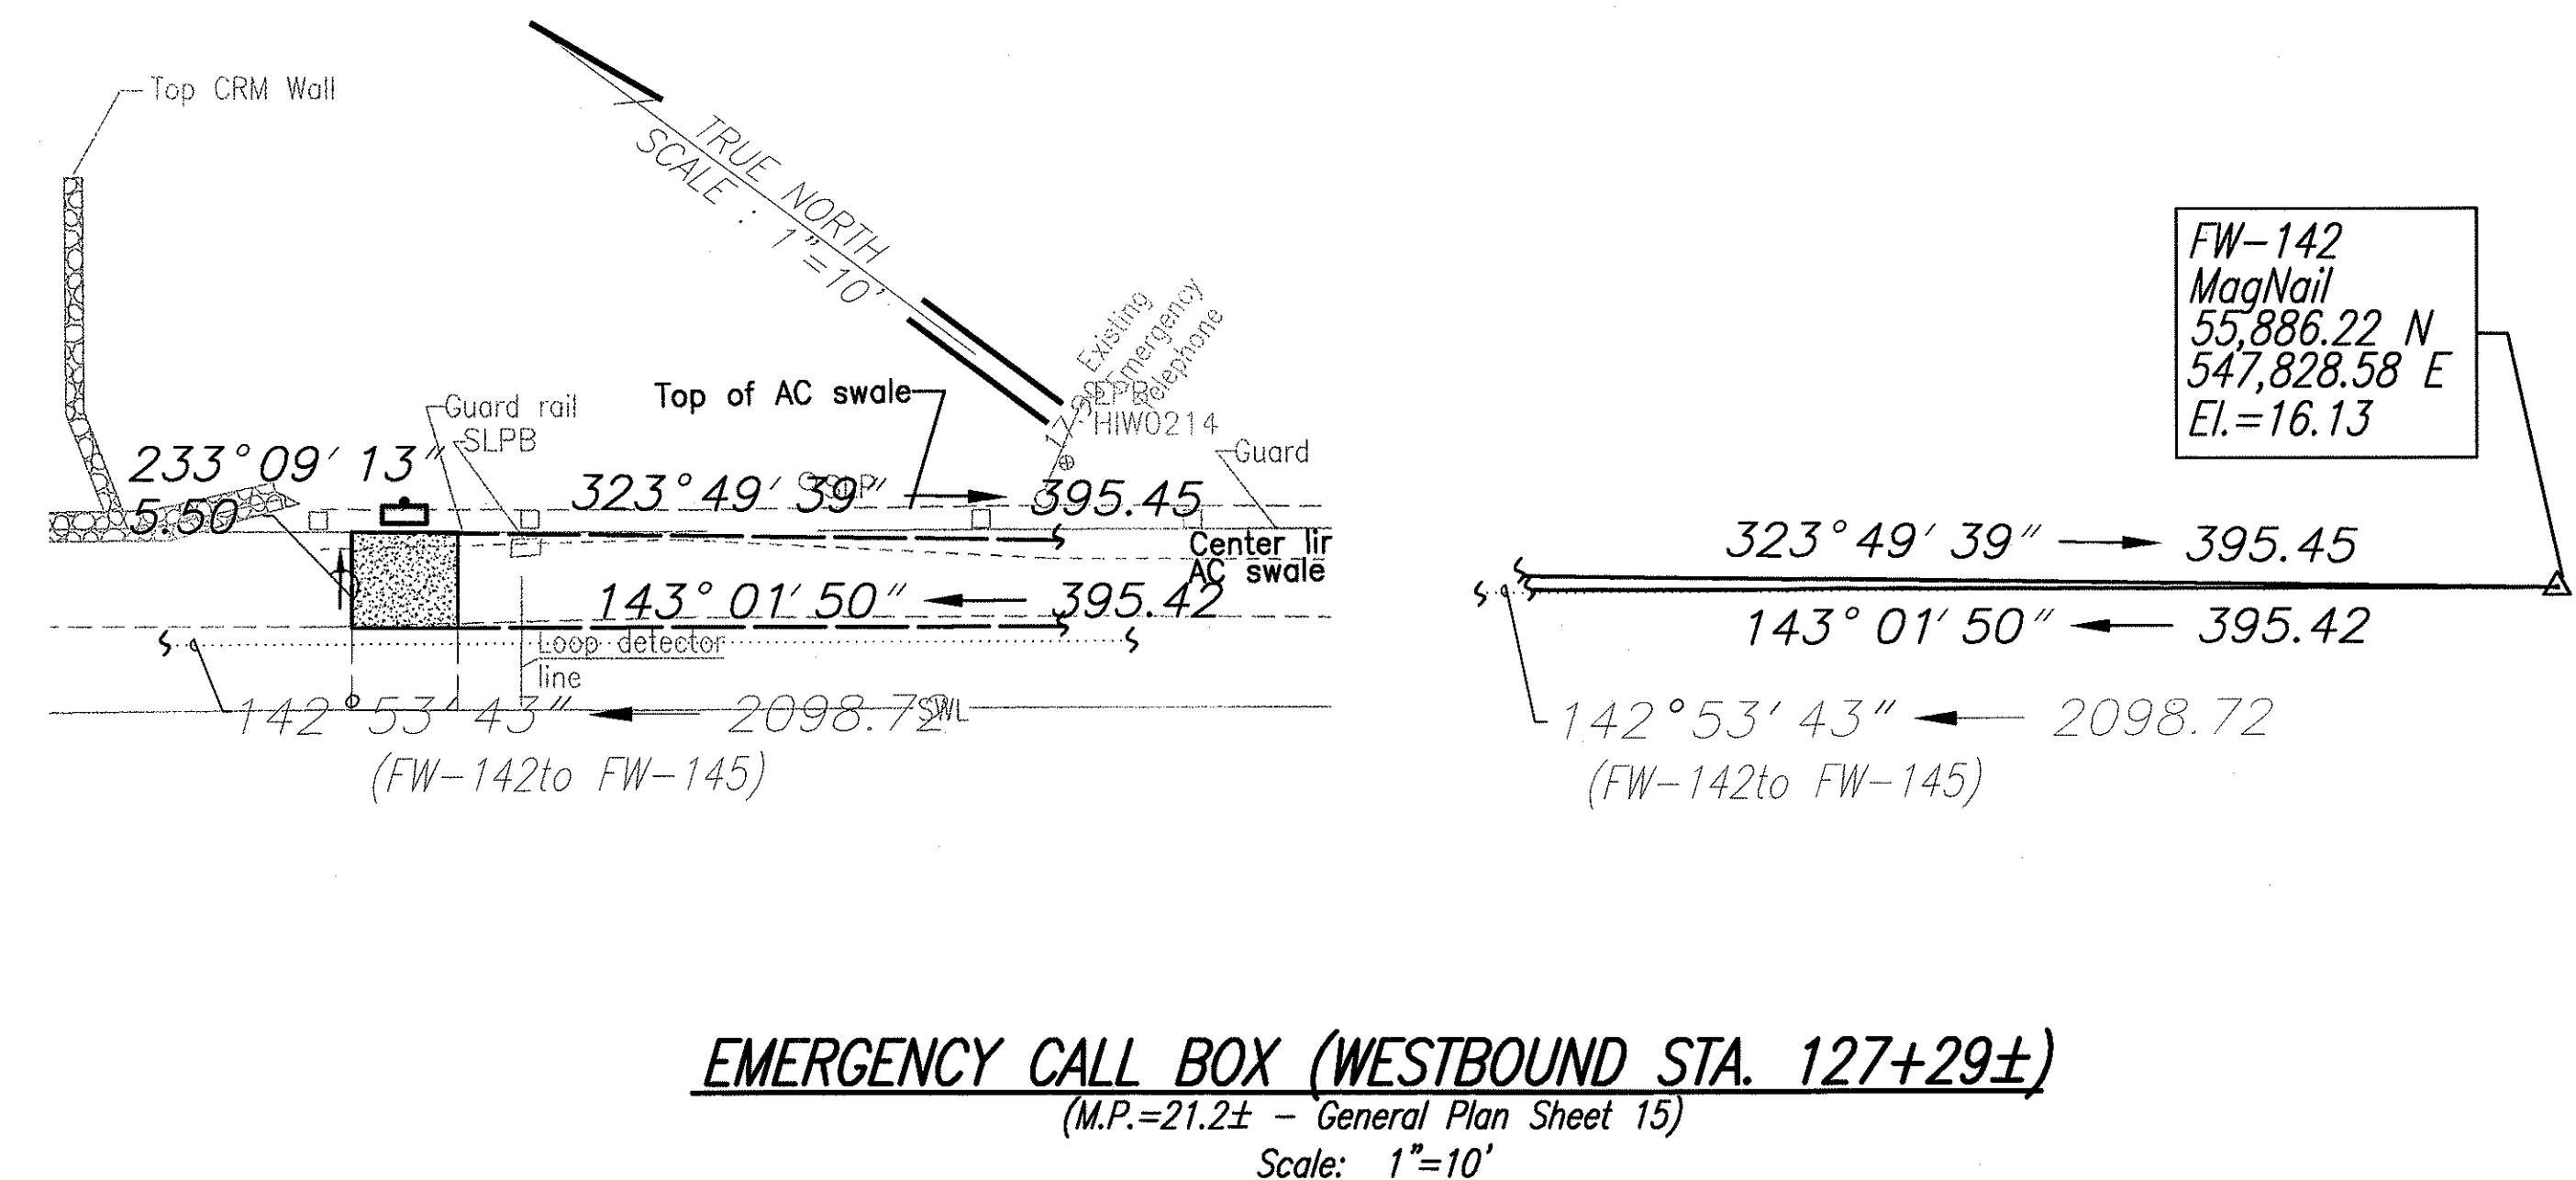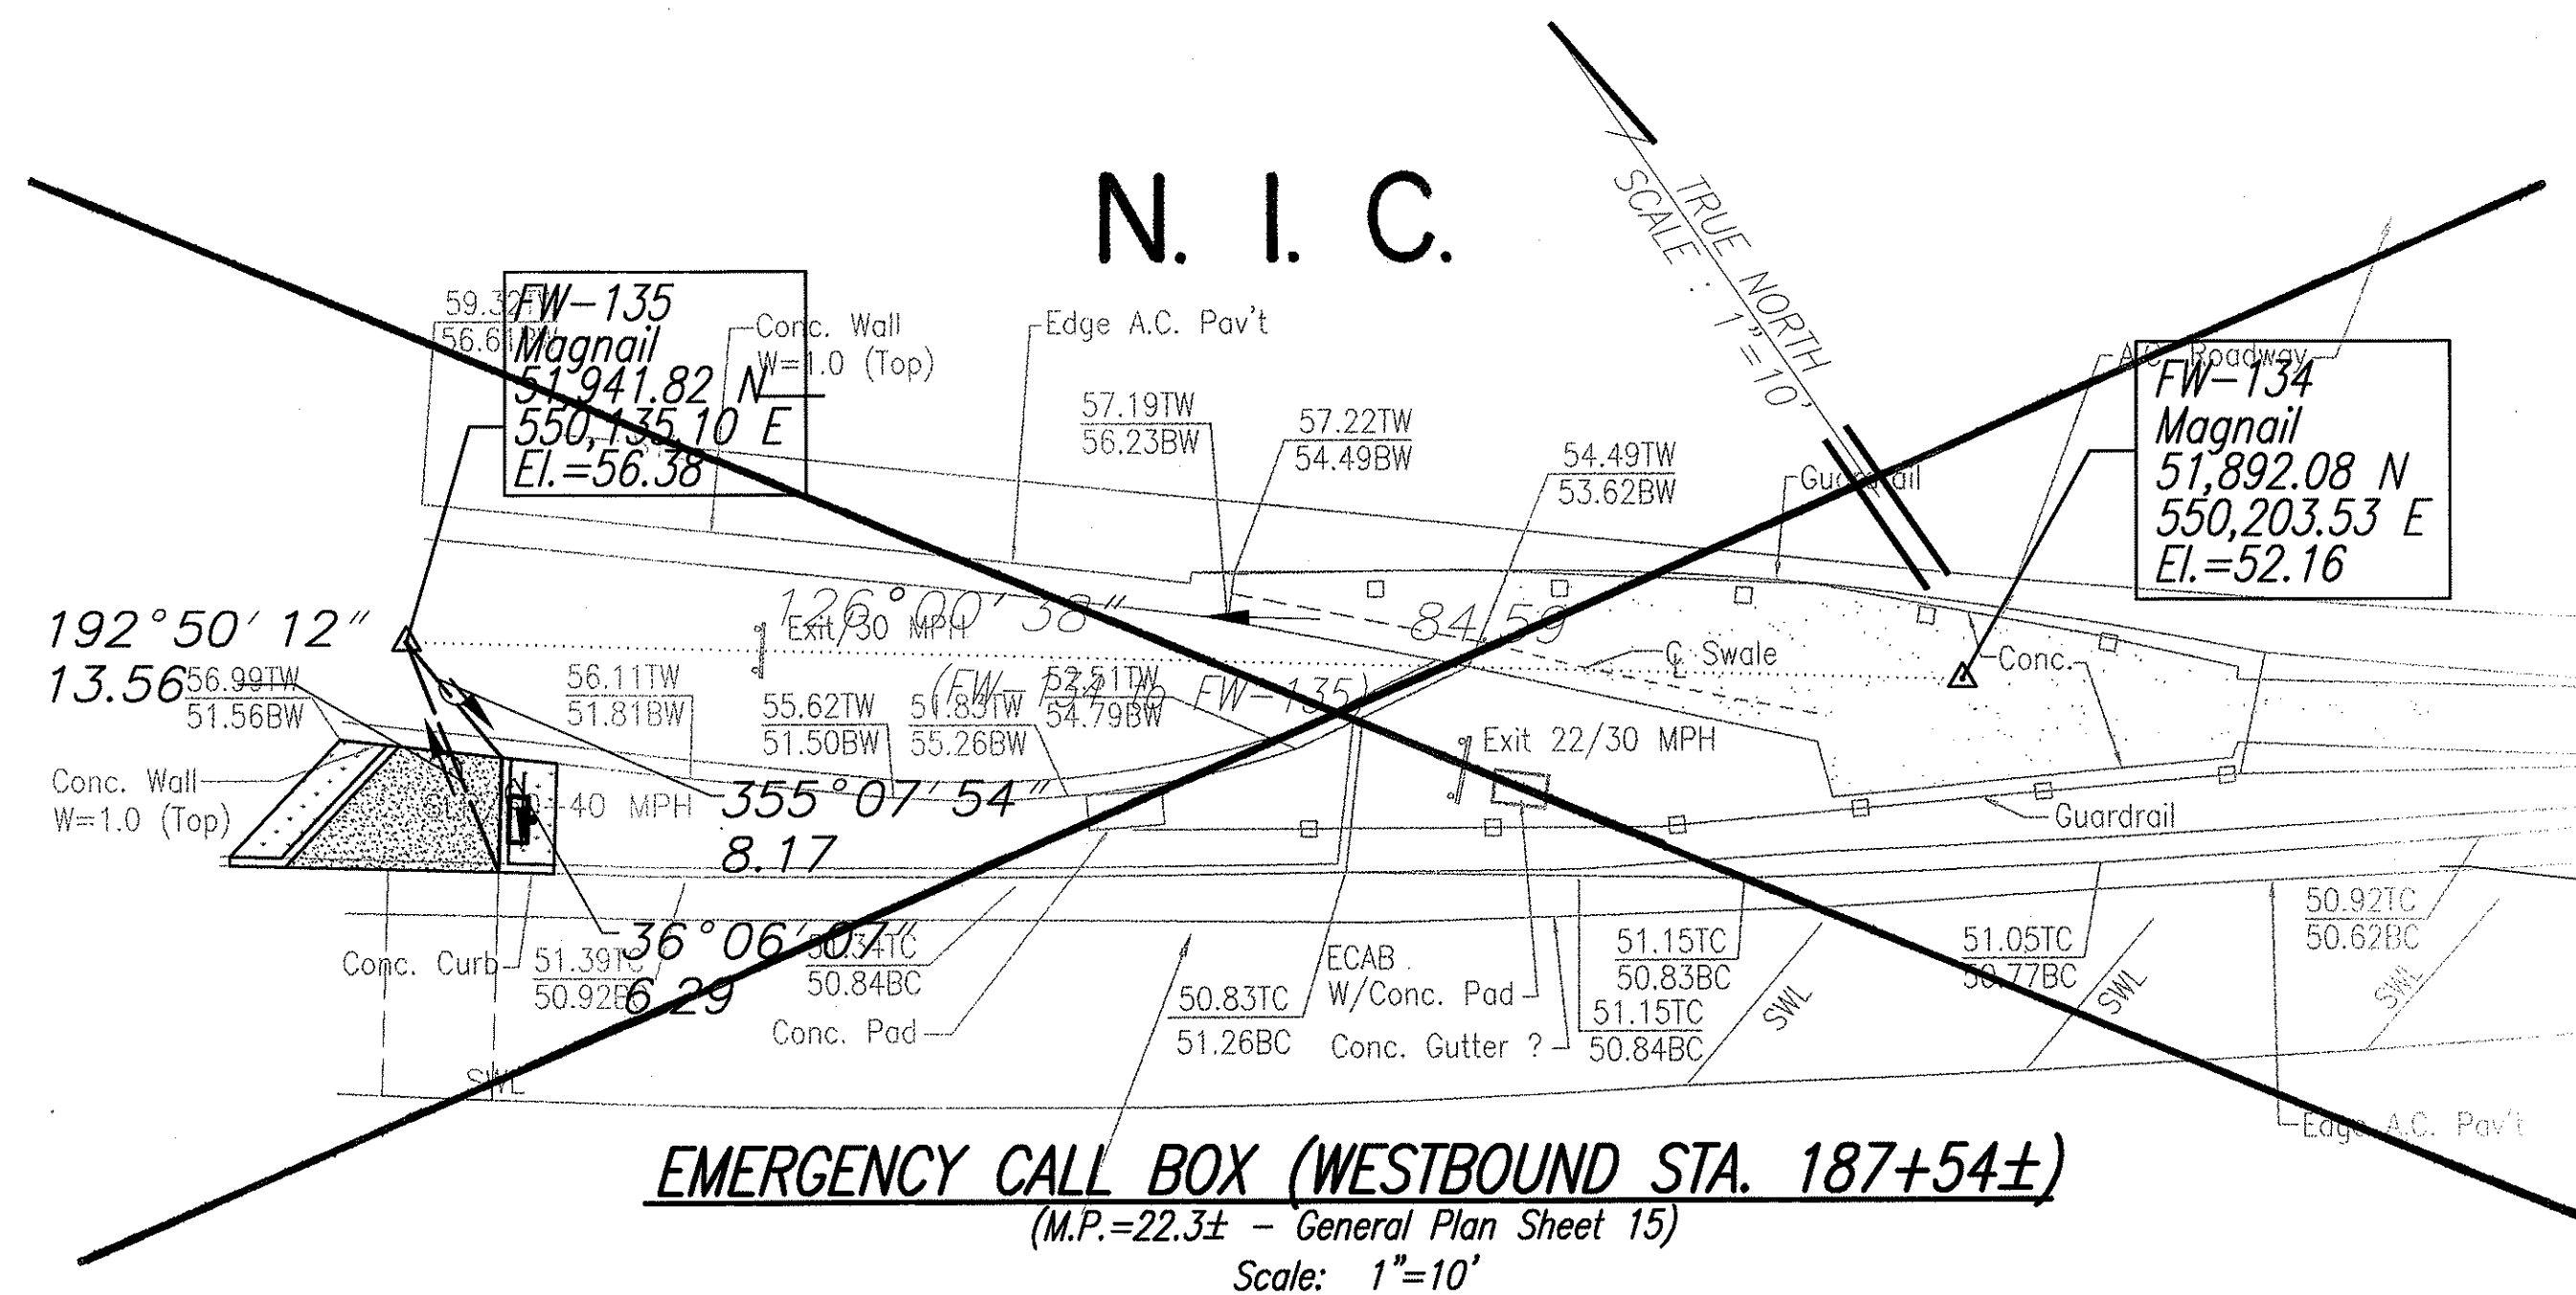

SURVEY PLOTTED BY	DATE
DRAWN BY	
TRACED BY	
QUANTITIES BY	
CHECKED BY	
ORIGINAL PLAN	
NOTE BOOK	
No.	

Note:
Coordinates and azimuths
referenced to State Plane
Coordinate System Hawaii Zone 3,
Nad 1927.

Graphic Scale:

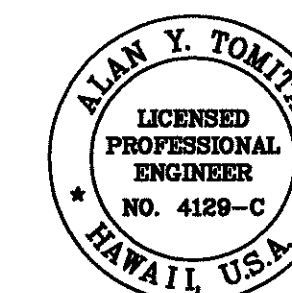

THIS WORK WAS PREPARED BY ME
OR UNDER MY SUPERVISION.

Alan Y. Tomita

STATE OF HAWAII
DEPARTMENT OF TRANSPORTATION
HIGHWAYS DIVISION

**INTERSTATE ROUTE H-1
PAD TIEDOWN-WESTBOUND**


**INTERSTATE ROUTE H-1
EMERGENCY TELEPHONE ACCESSIBLE ROUTES**
E.A. Project No. NH-300(86)R

Scale: As Shown Date: September 2003

SHEET No. 3 OF 7 SHEETS


FED. ROAD DIST. NO.	STATE	FED. AID. PROJ. NO.	FISCAL YEAR	SHEET NO.	TOTAL SHEETS
HAWAII	HAW.	NH-300(86)R	2004	41	45

FW-150
MagNail
59,683.02 N
543,956.89 E
El.=13.99

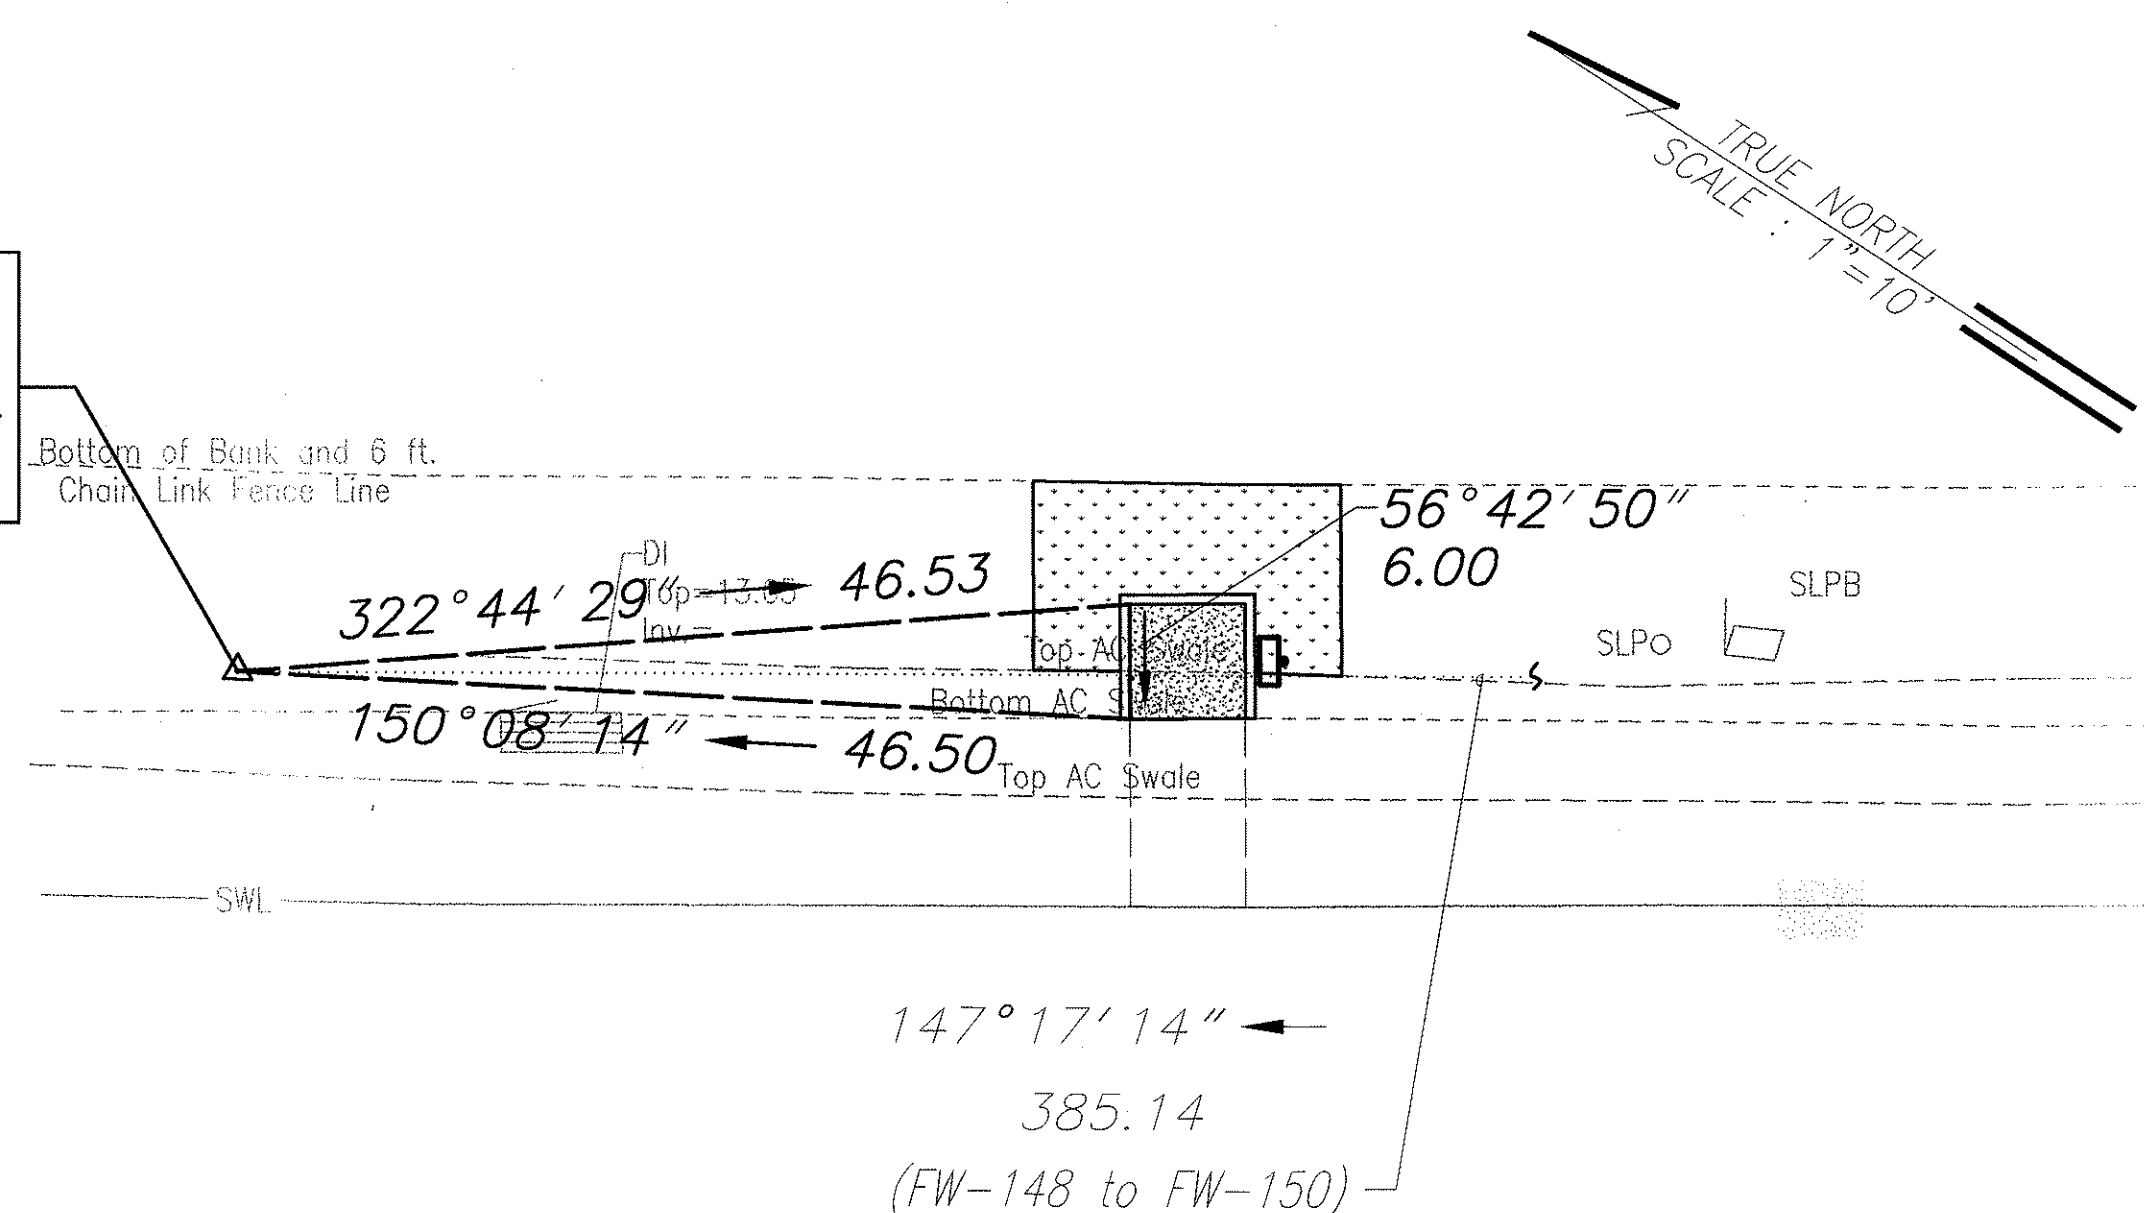


EMERGENCY CALL BOX (WESTBOUND STA. 75+48±)
(M.P.=20.2± - General Plan Sheet 15)
Scale: 1"=10'

FW-153
MagNail
61,840.26 N
542,151.39 E
El.=62.01

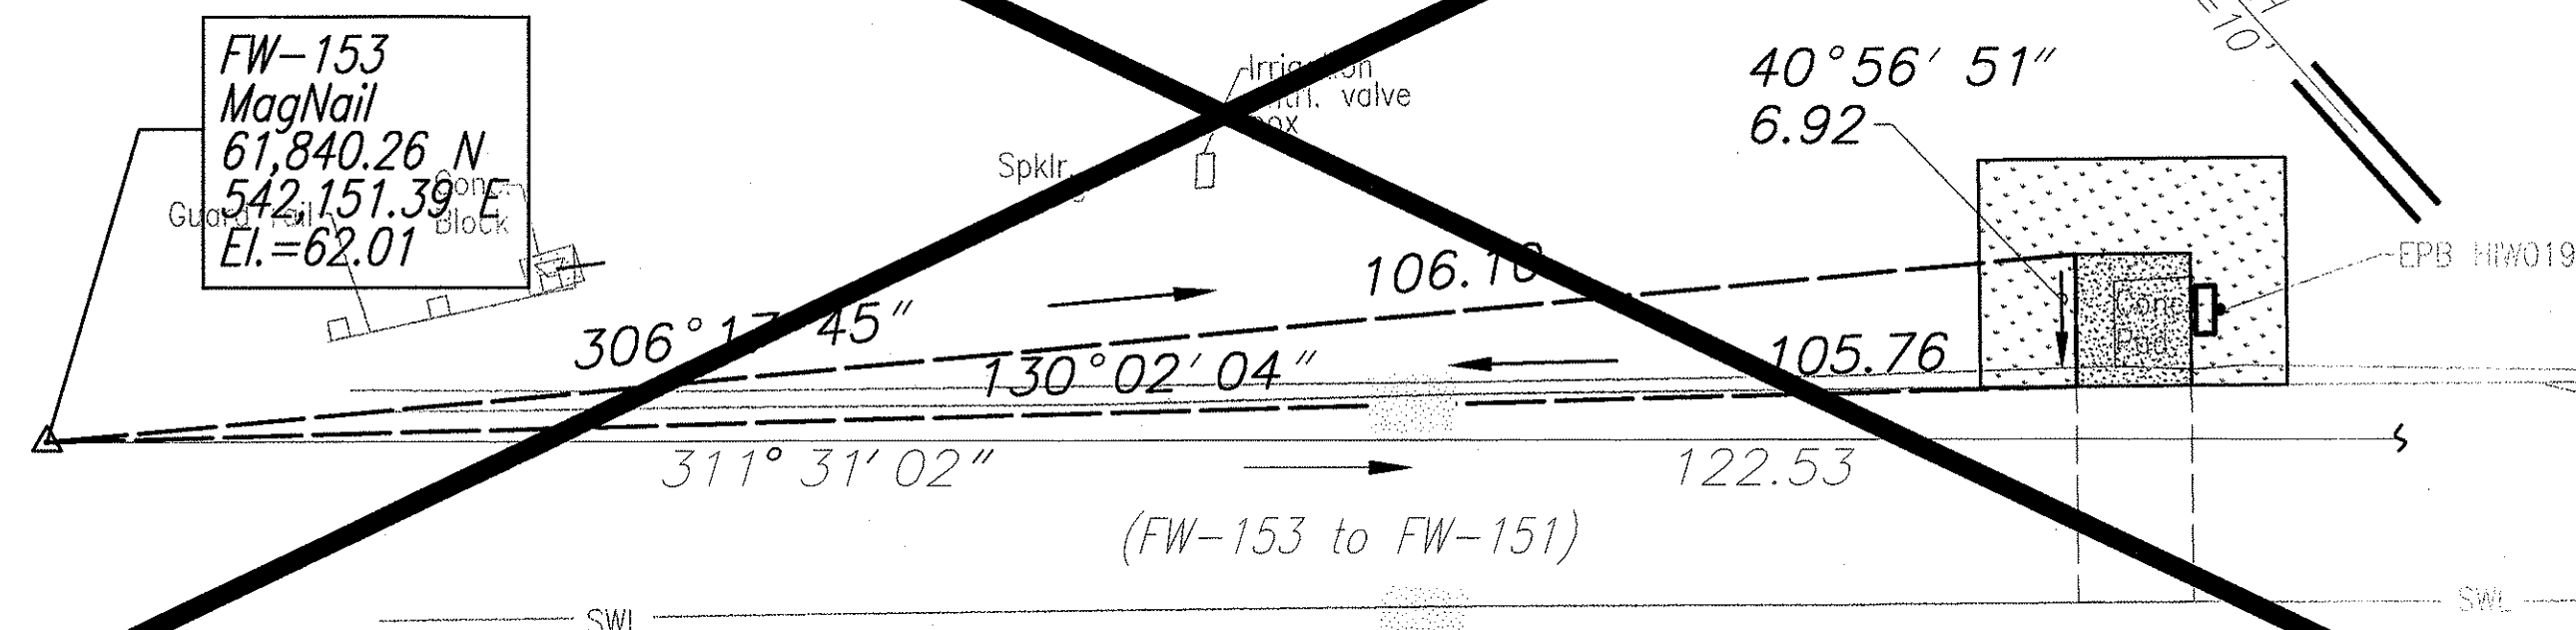


EMERGENCY CALL BOX (WESTBOUND STA. 47+94±)
(M.P.=19.7± - General Plan Sheet 14)
Scale: 1"=10'

FW-156
MagNail
62,925.55 N
537,753.35 E
Elev.=28.38

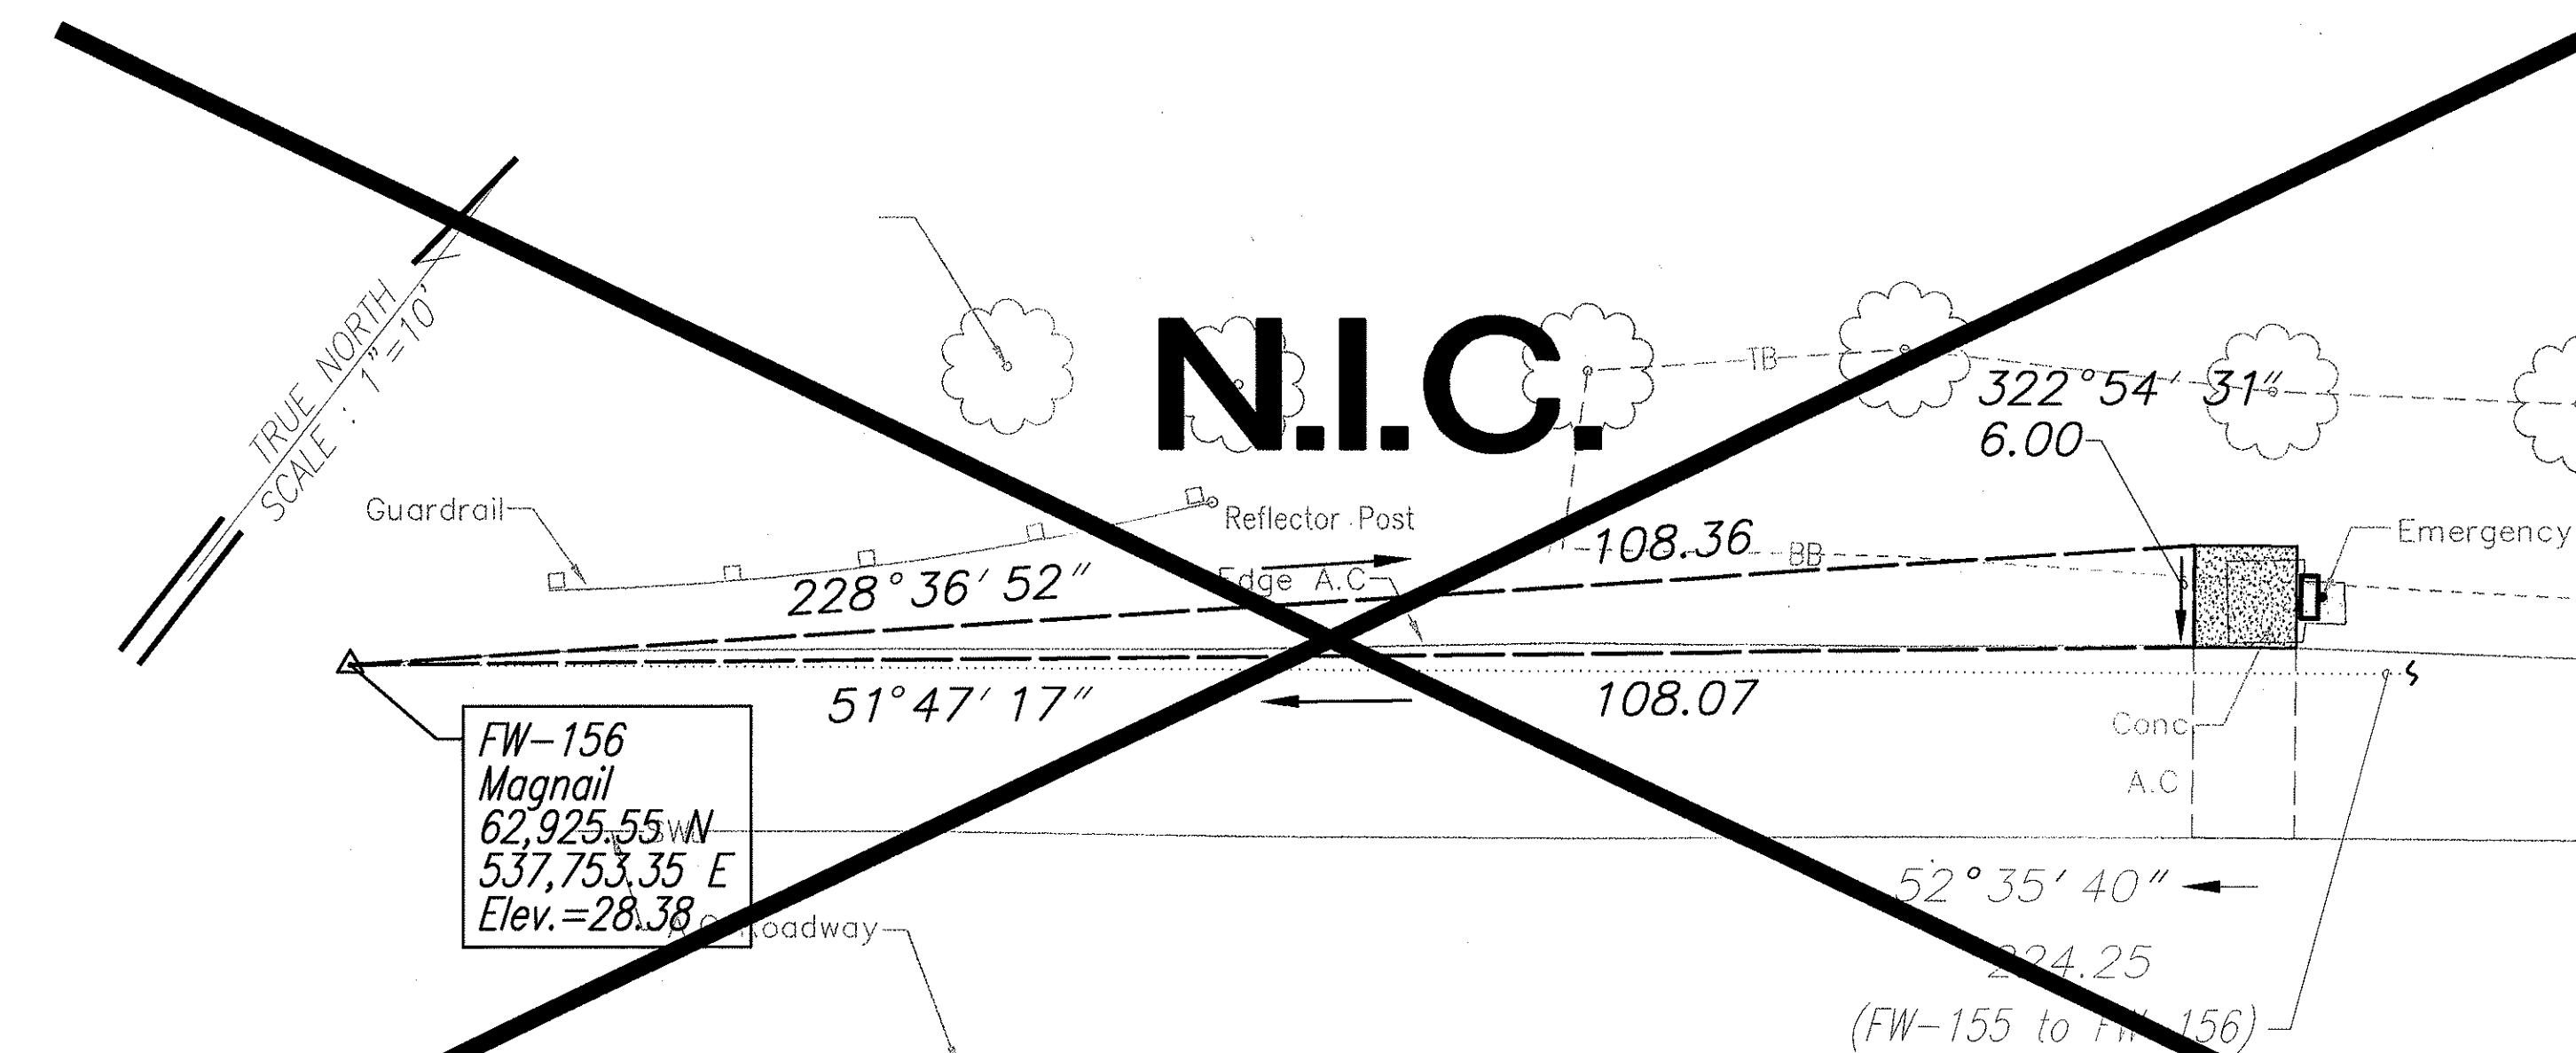

EMERGENCY CALL BOX (WESTBOUND STA. 267+22±)
(M.P.=18.8± - General Plan Sheet 14)
Scale: 1"=10'


FW-157
MagNail
62,112.72 N
535,735.89 E
Elev.=44.74

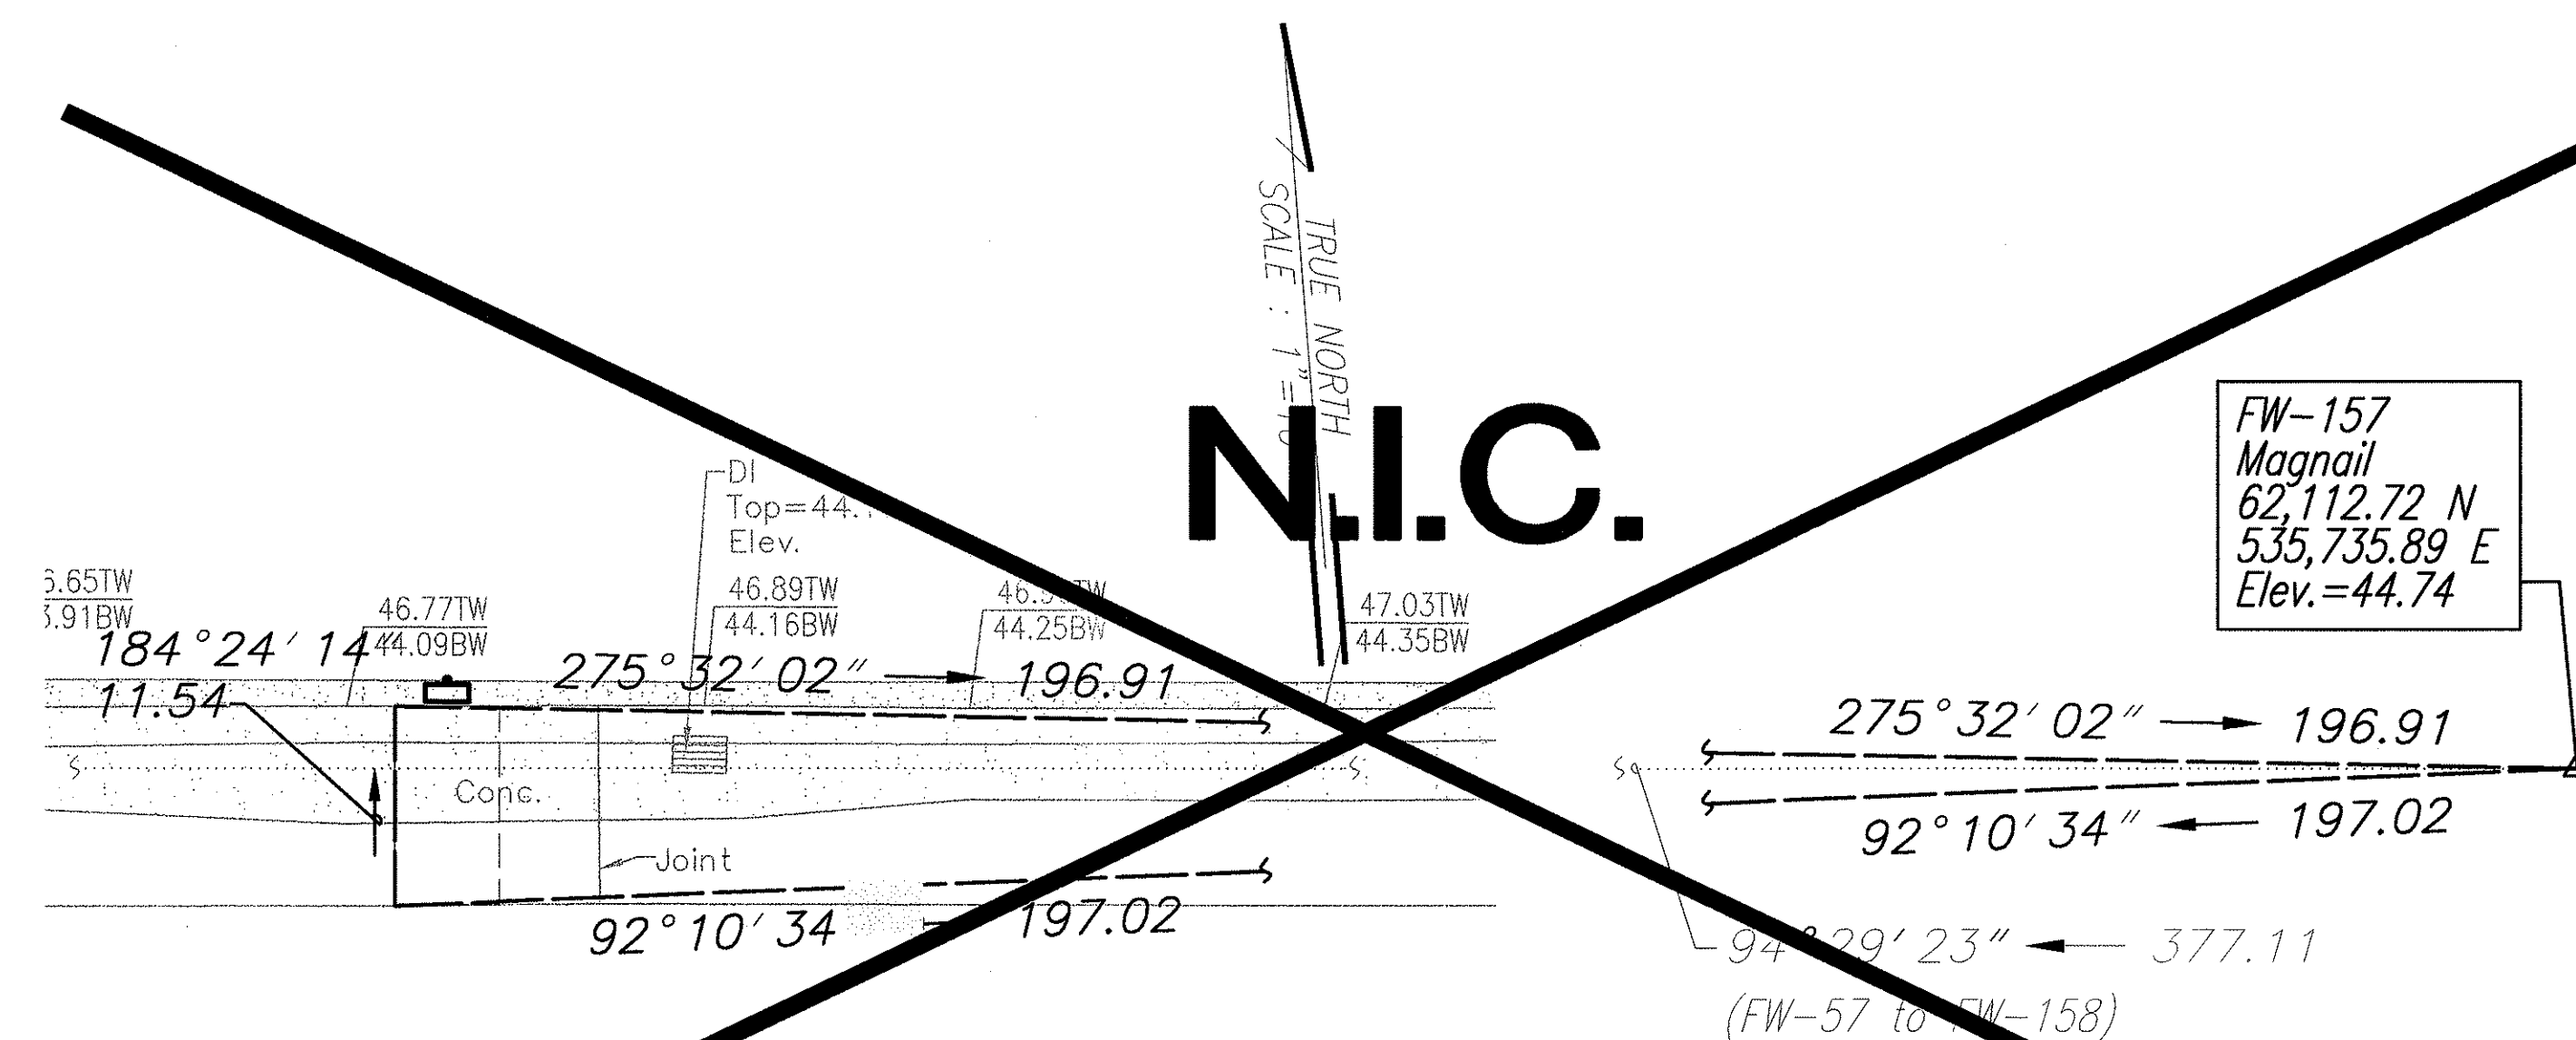

EMERGENCY CALL BOX (WESTBOUND STA. 241+44±)
(M.P.=18.3± - General Plan Sheet 14)
Scale: 1"=10'

Note:
Coordinates and azimuths
referenced to State Plane
Coordinate System Hawaii Zone 3,
Nad 1927.

Graphic Scale:
10' 5' 0' 10' 20'

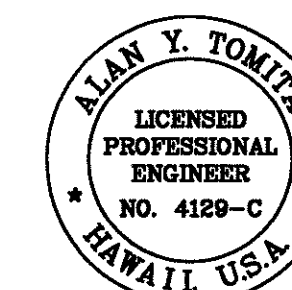

THIS WORK WAS PREPARED BY ME
OR UNDER MY SUPERVISION.

Alan Y. Tomita

STATE OF HAWAII
DEPARTMENT OF TRANSPORTATION
HIGHWAYS DIVISION

**INTERSTATE ROUTE H-1
PAD TIEDOWN-WESTBOUND**

**INTERSTATE ROUTE H-1
EMERGENCY TELEPHONE ACCESSIBLE ROUTES**
F.A. Project No. NH-300(86)R





Scale: As Shown Date: September 2003

SHEET No. 4 OF 7 SHEETS

SURVEY PLOTTED BY	DATE
DRAWN BY	
DESIGNED BY	
QUANTITIES BY	
CHECKED BY	
ORIGINAL PLAN	
NOTE BOOK	
No.	



P:\Projects\04-Hwy\Emergency Call Box\Drawings\RE-DESIGN\H-1\ECB-H-TES.dwg September 11, 2003 11:40AM RianCJ

FED. ROAD DIST. NO.	STATE	FED. AID. PROJ. NO.	FISCAL YEAR	SHEET NO.	TOTAL SHEETS
HAWAII	HAW.	NH-300(86)R	2004	42	45

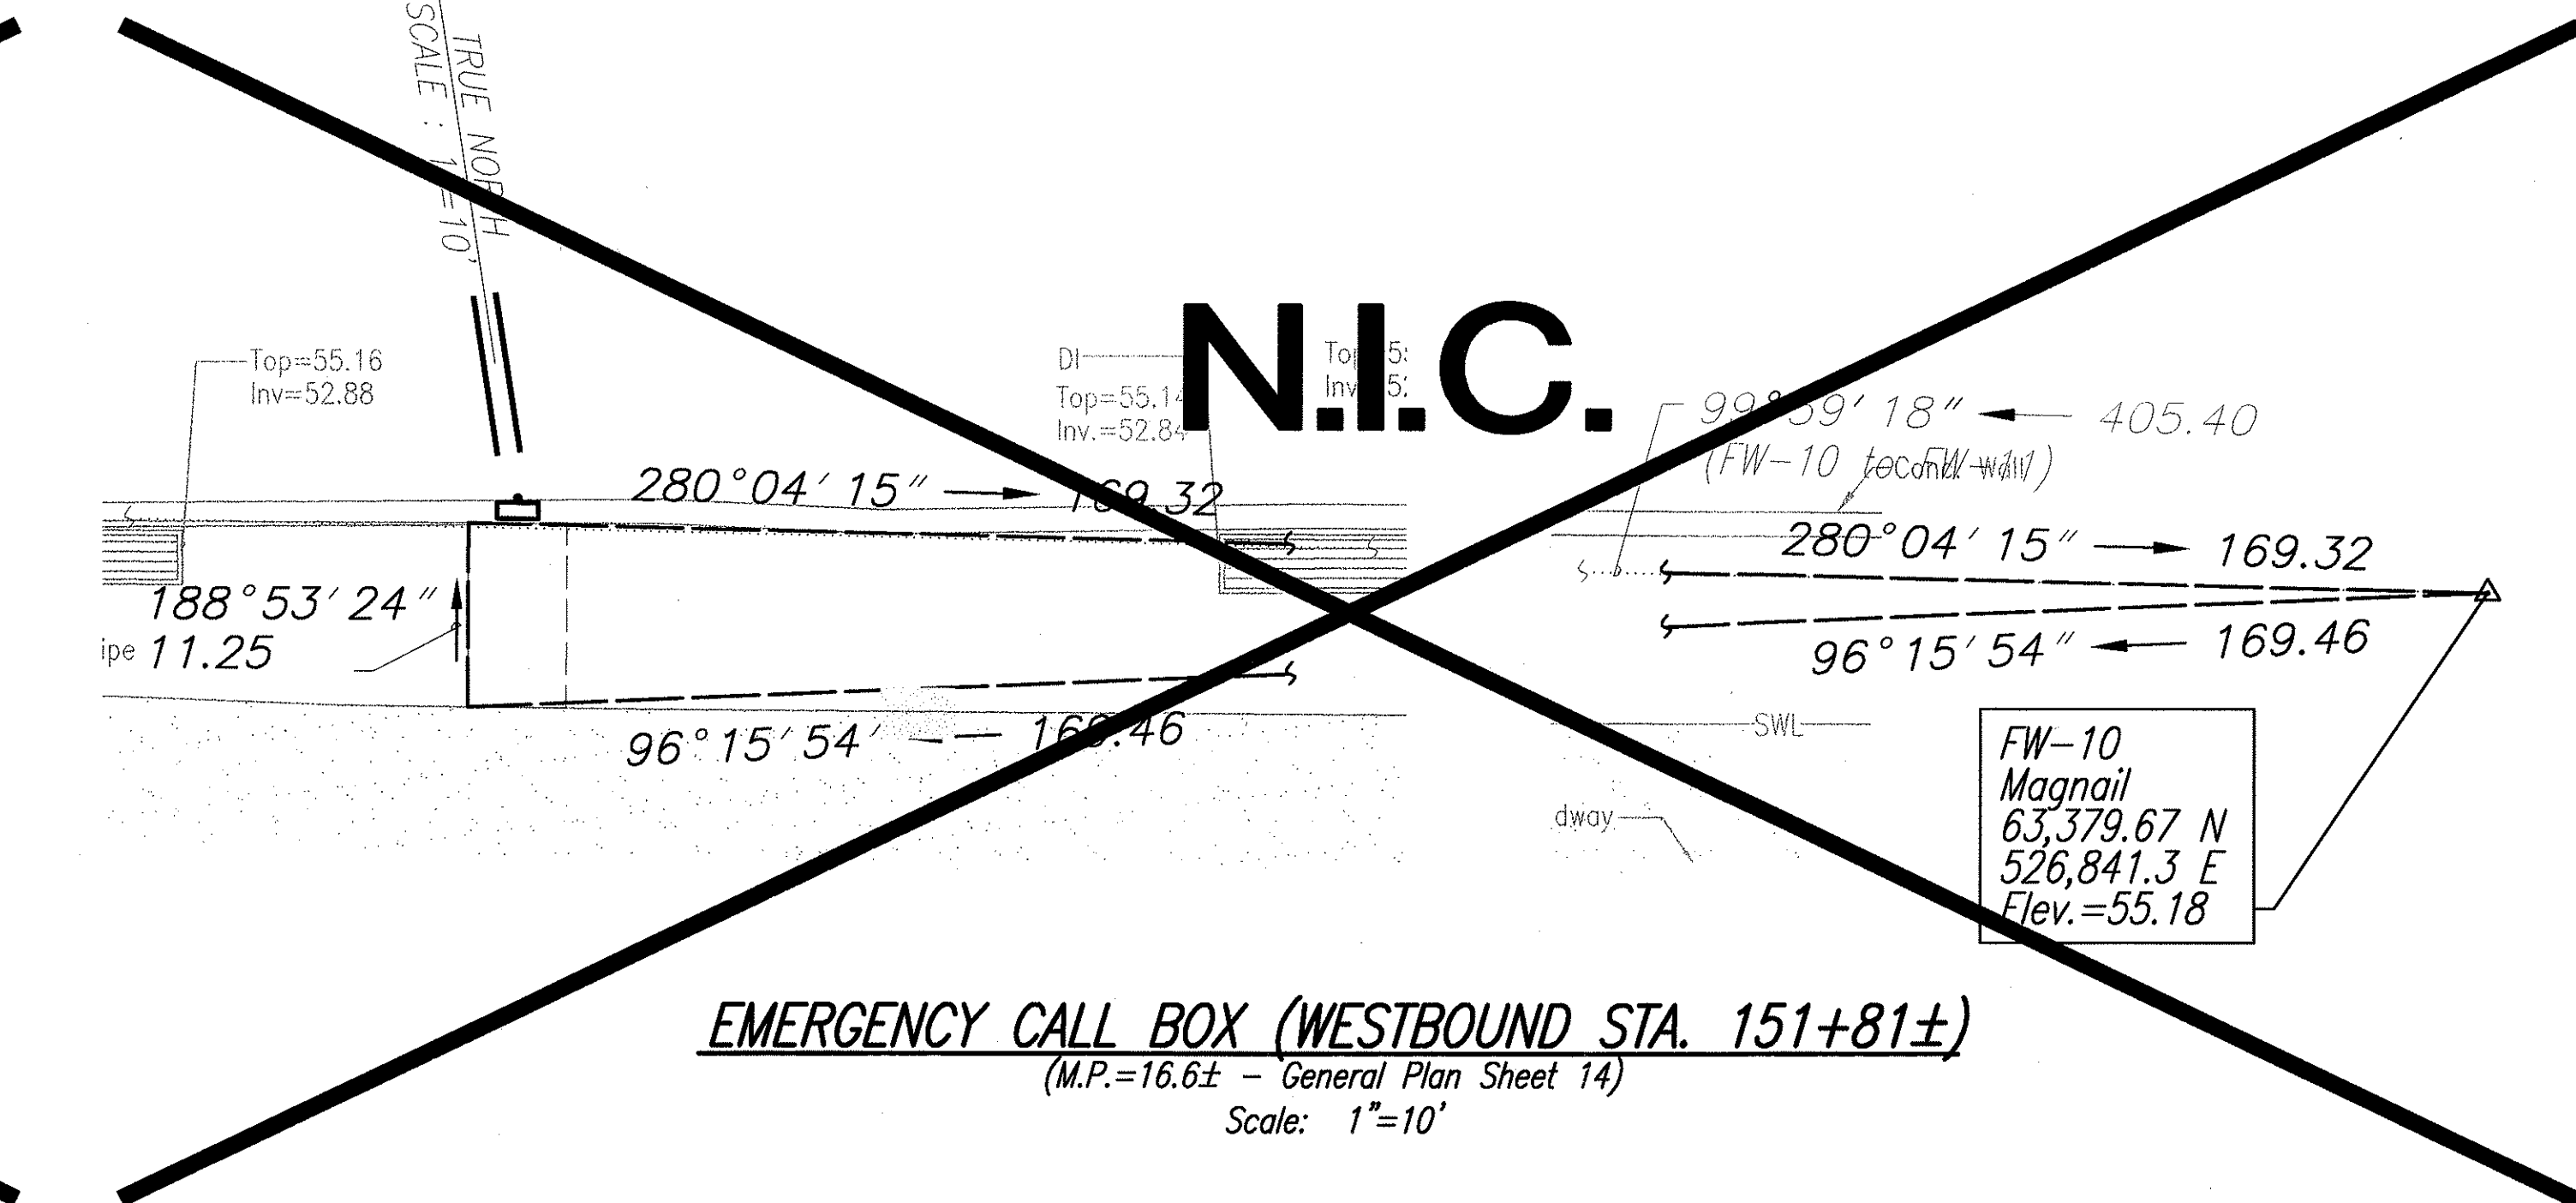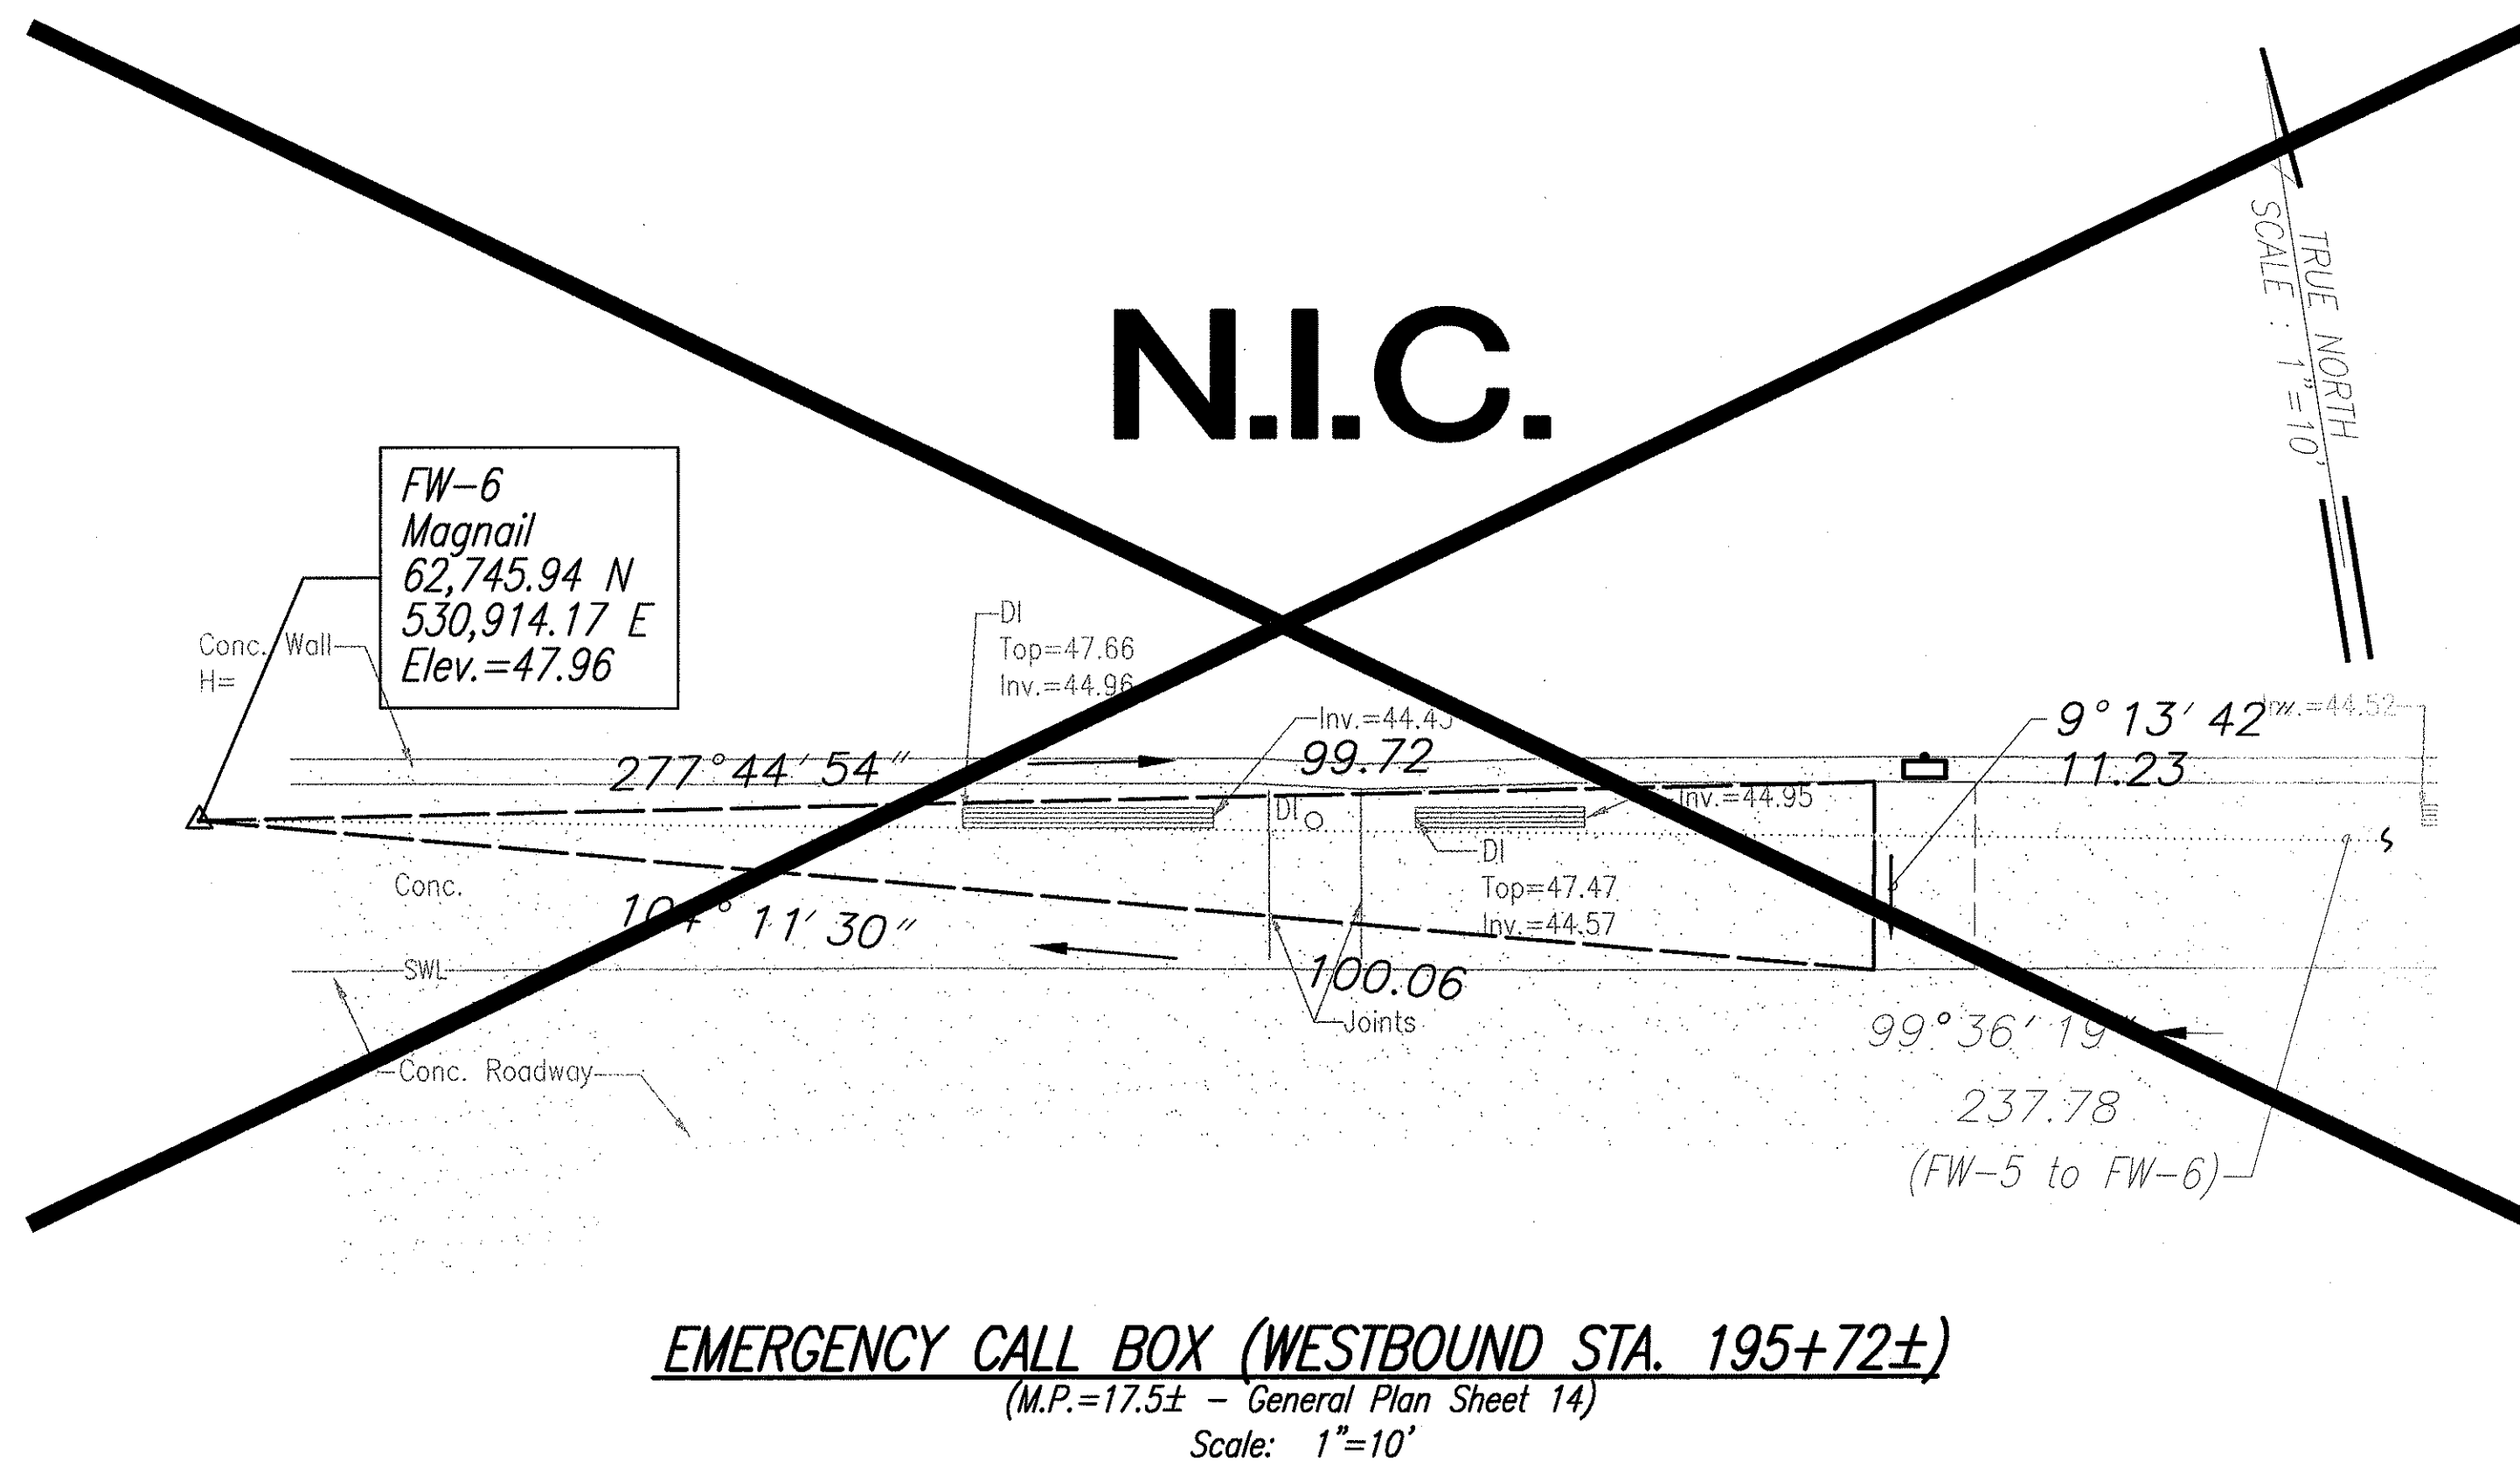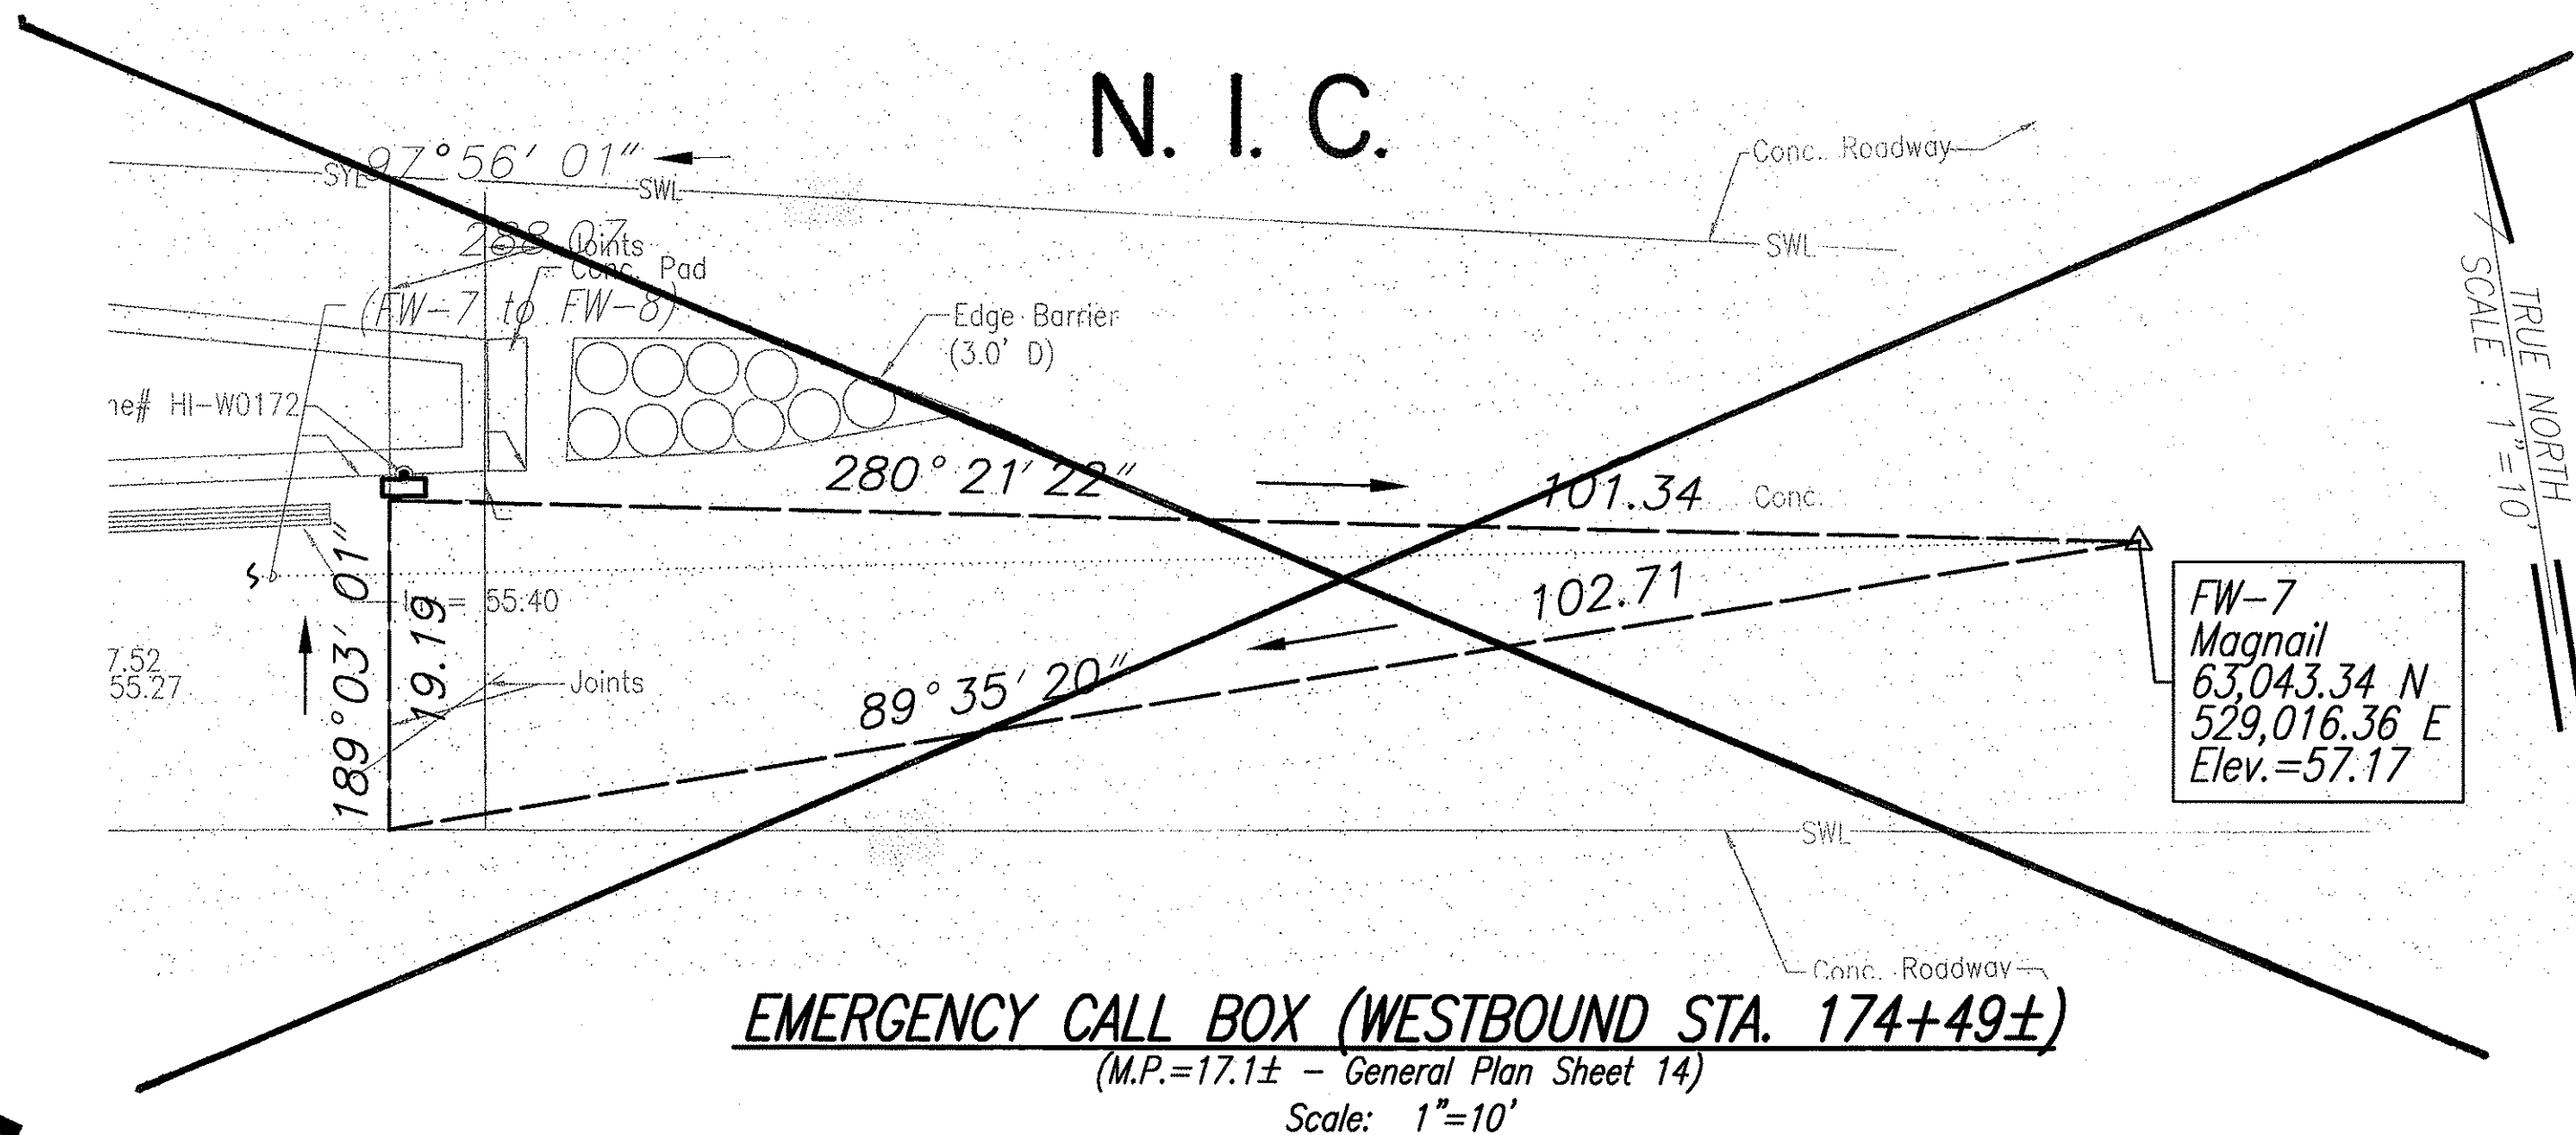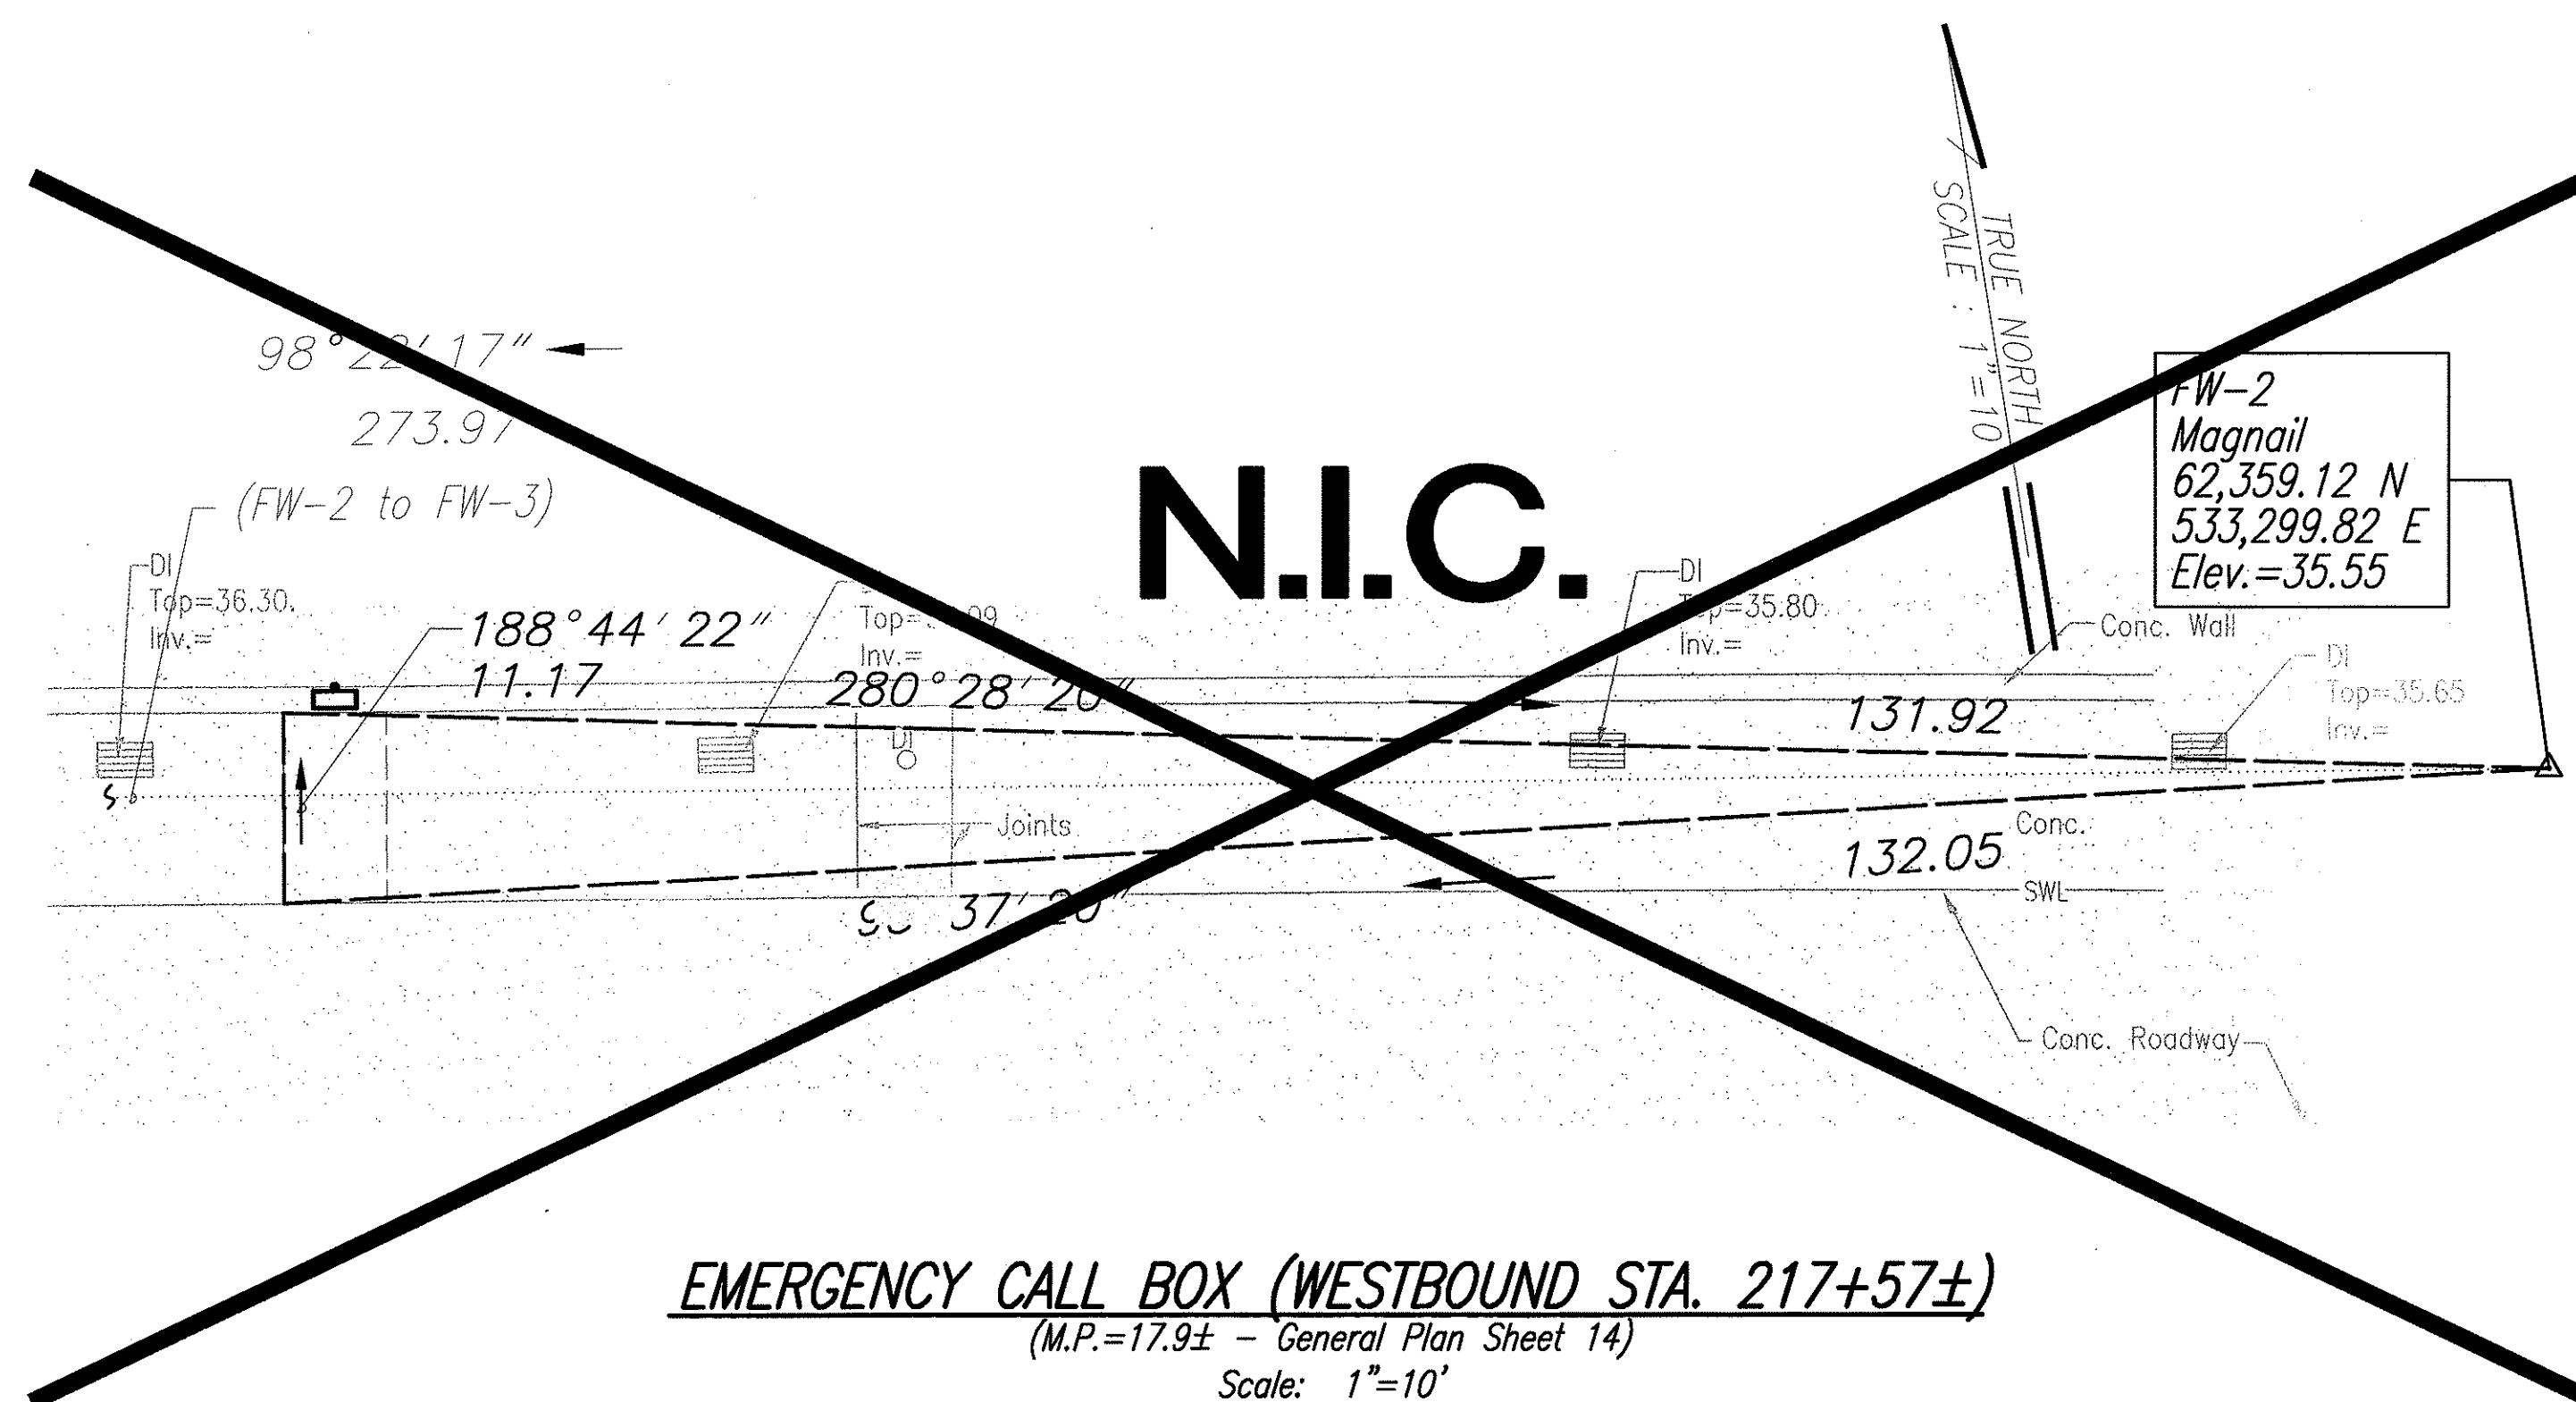

ORIGINAL PLAN	DATE
DRAWN BY	
DESIGNED BY	
QUANTITIES BY	
CHECKED BY	
No.	

Note:
Coordinates and azimuths
referenced to State Plane
Coordinate System Hawaii Zone 3,
Nad 1927.

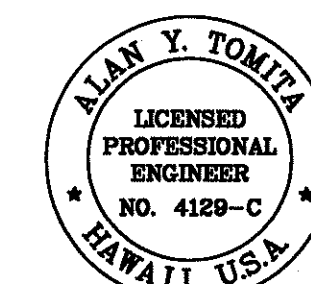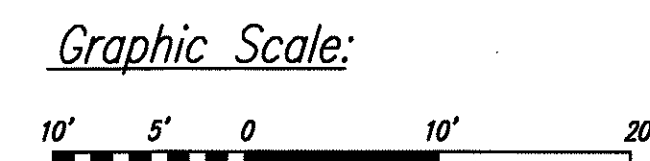

THIS WORK WAS PREPARED BY ME
OR UNDER MY SUPERVISION.

Alan Y. Tomita

STATE OF HAWAII
DEPARTMENT OF TRANSPORTATION
HIGHWAYS DIVISION


**INTERSTATE ROUTE H-1
PAD TIEDOWN-WESTBOUND**

**INTERSTATE ROUTE H-1
EMERGENCY TELEPHONE ACCESSIBLE ROUTES**
F.A. Project No. NH-300(86)R

Scale: As Shown Date: September 2003

SHEET No. 5 OF 7 SHEETS


FED. ROAD DIST. NO.	STATE	FED. AID. PROJ. NO.	FISCAL YEAR	SHEET NO.	TOTAL SHEETS
HAWAII	HAW.	NH-300(86)R	2004	44	45

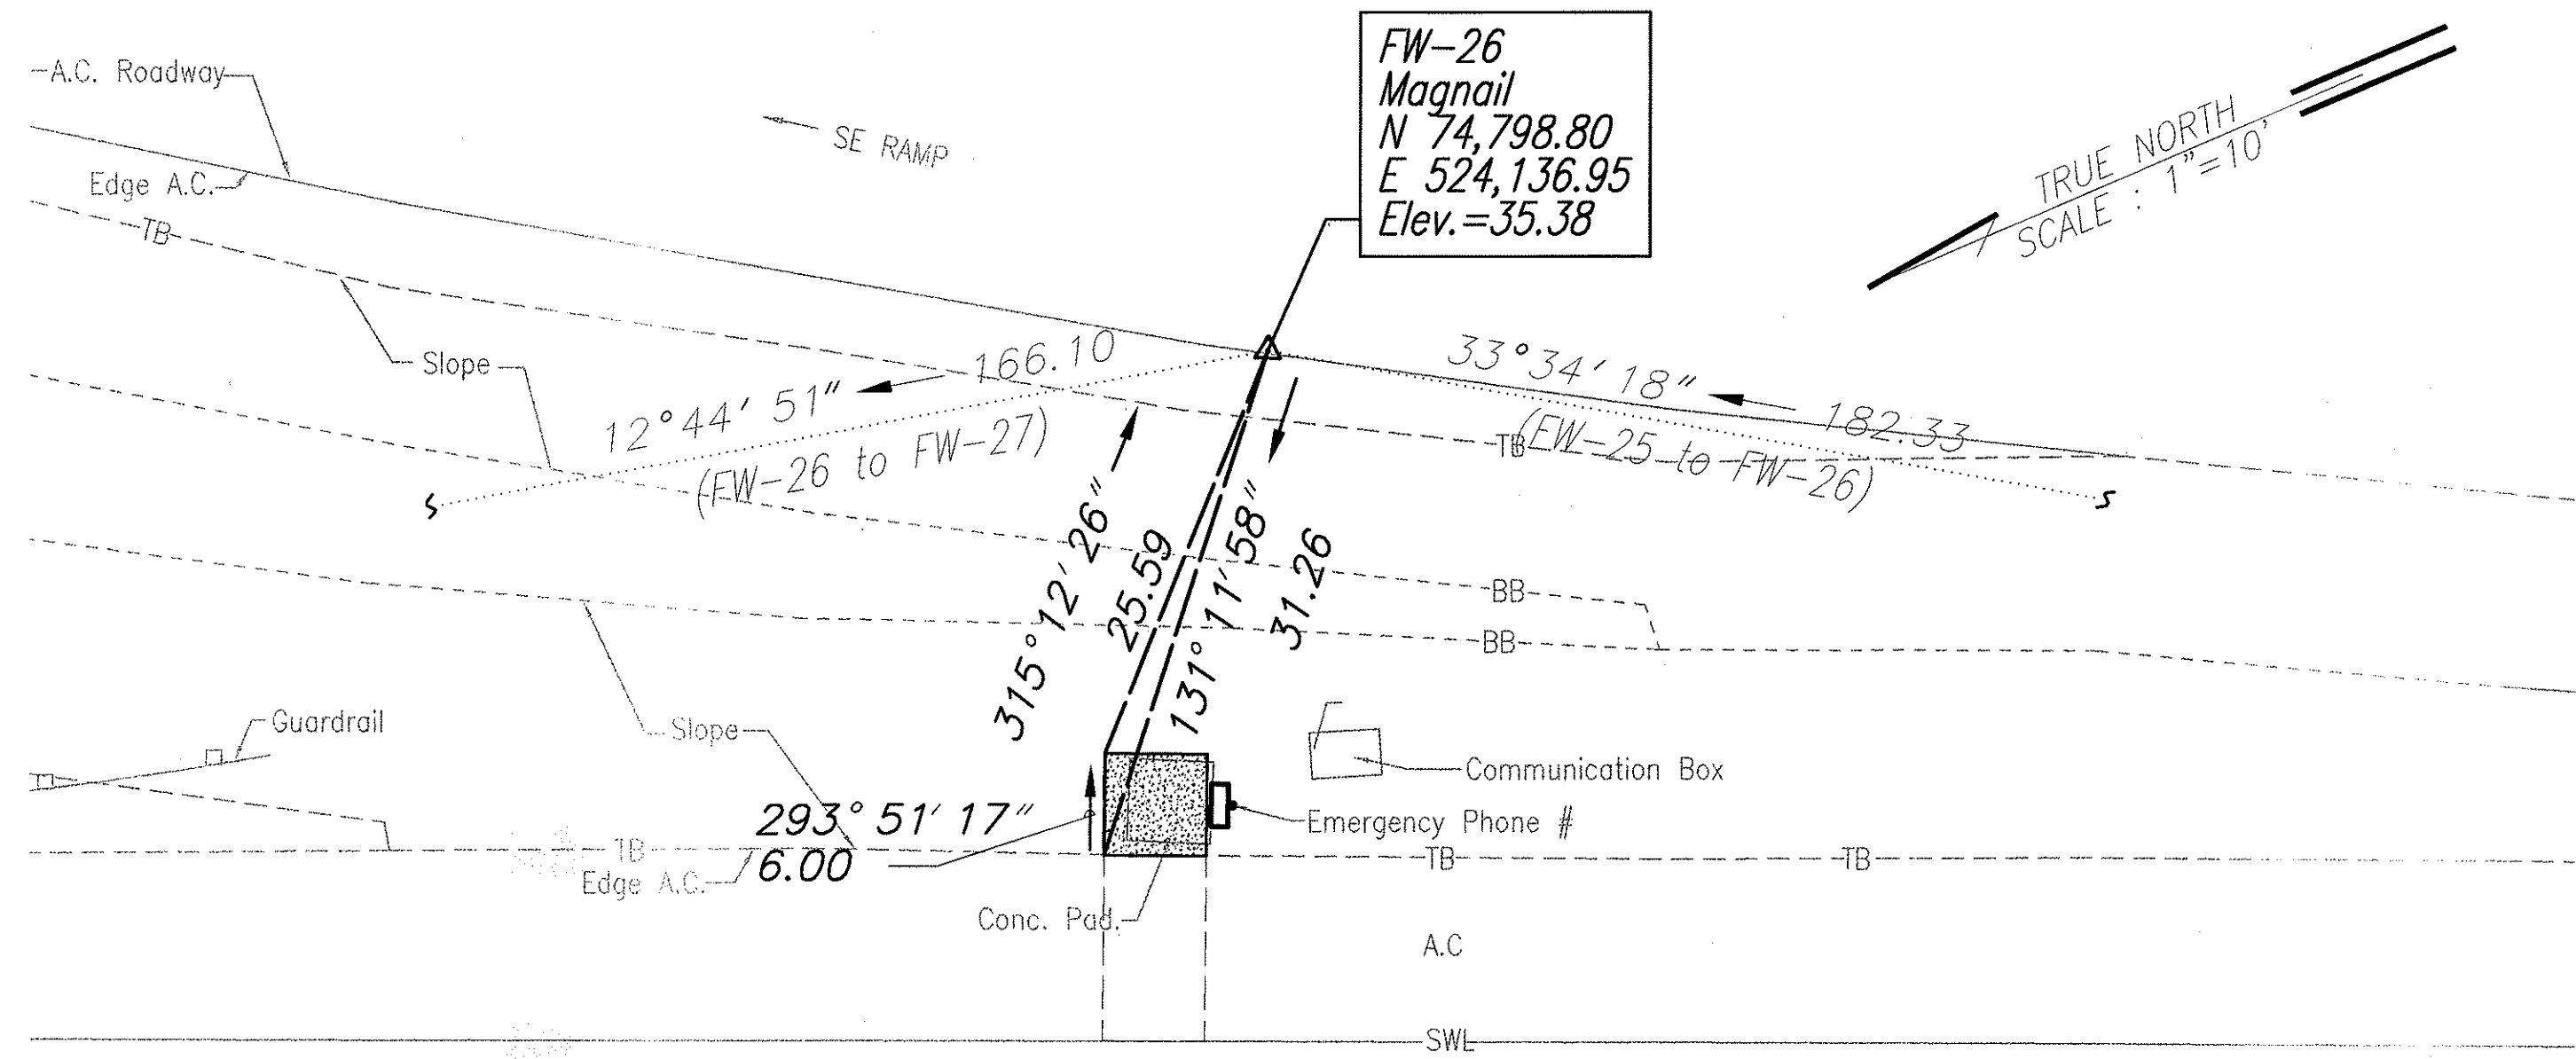

EMERGENCY CALL BOX (WESTBOUND STA. 234+41±)
(M.P.=13.7± - General Plan Sheet 13)
Scale: 1"=10'

ORIGINAL PLAN	SURVEY PLOTTED BY	DATE
NOTE BOOK	DRAWN BY	" "
No.	DESIGNED BY	" "
	QUANTITIES BY	" "
	CHECKED BY	" "

Note:
Coordinates and azimuths
referenced to State Plane
Coordinate System Hawaii Zone 3,
Nad 1927.

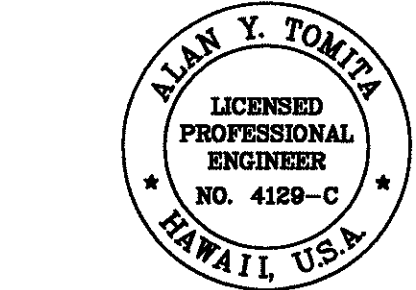

THIS WORK WAS PREPARED BY ME
OR UNDER MY SUPERVISION.

Alan Y. Tomita

STATE OF HAWAII
DEPARTMENT OF TRANSPORTATION
HIGHWAYS DIVISION

**INTERSTATE ROUTE H-1
PAD TIEDOWN-WESTBOUND**

**INTERSTATE ROUTE H-1
EMERGENCY TELEPHONE ACCESSIBLE ROUTES**
F.A. Project No. NH-300(86)R

Scale: As Shown Date: September 2003

SHEET No. 7 OF 7 SHEETS