



FED. ROAD DIST. NO.	STATE	FED. AID. PROJ. NO.	FISCAL YEAR	SHEET NO.	TOTAL SHEETS
HAWAII	HAW.	NH-300(86)R	2004	8	45

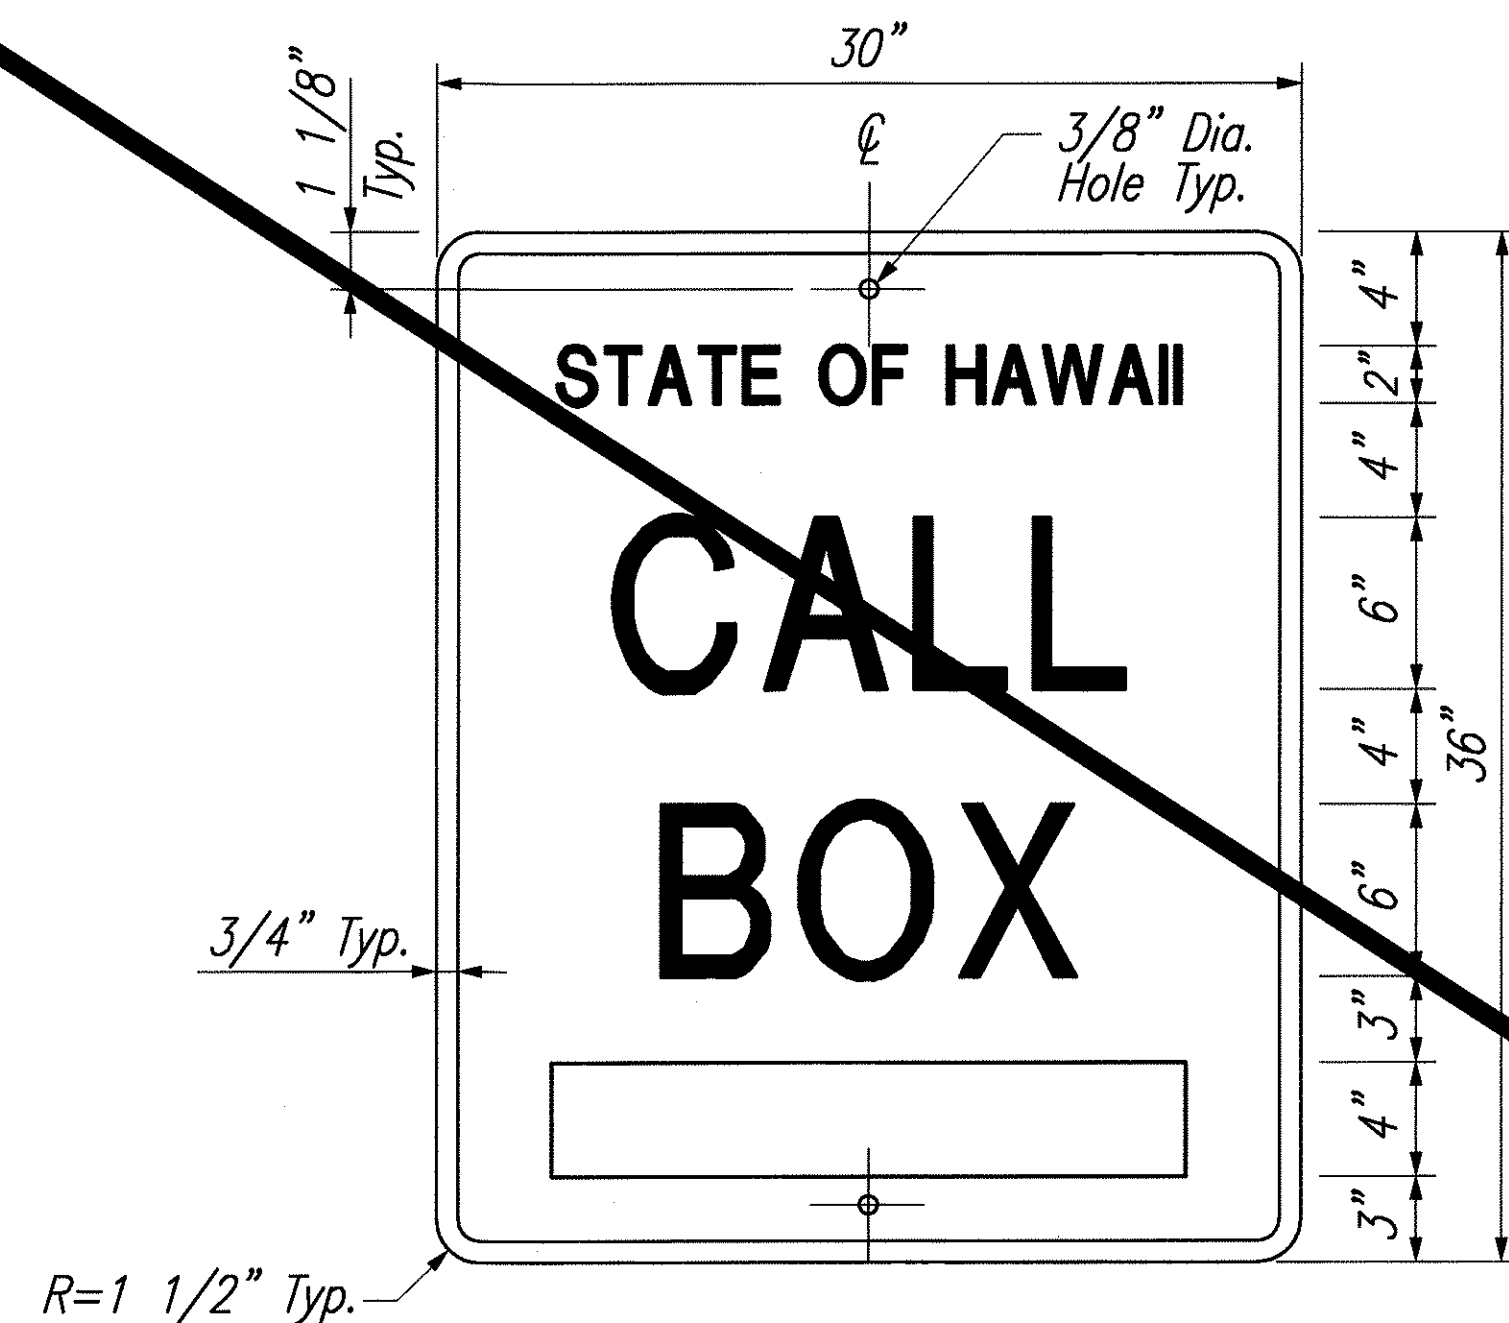

CALL BOX IDENTIFICATION SIGN
Not to Scale


- NOTES:
- All lines of lettering shall be centered and shall be the following lettering size and series:
Line No. 1 - 2" SERIES C
Line No. 2 - 6" SERIES E
Line No. 3 - 6" SERIES E
 - Call Box Identification Numbers shall be 4" SERIES D letters centered in the bottom position of the sign.
 - All signs shall have white border and legend on a blue background.
 - Modify hole locations to accommodate the 2' offset from edge of shoulder.

N.I.C.

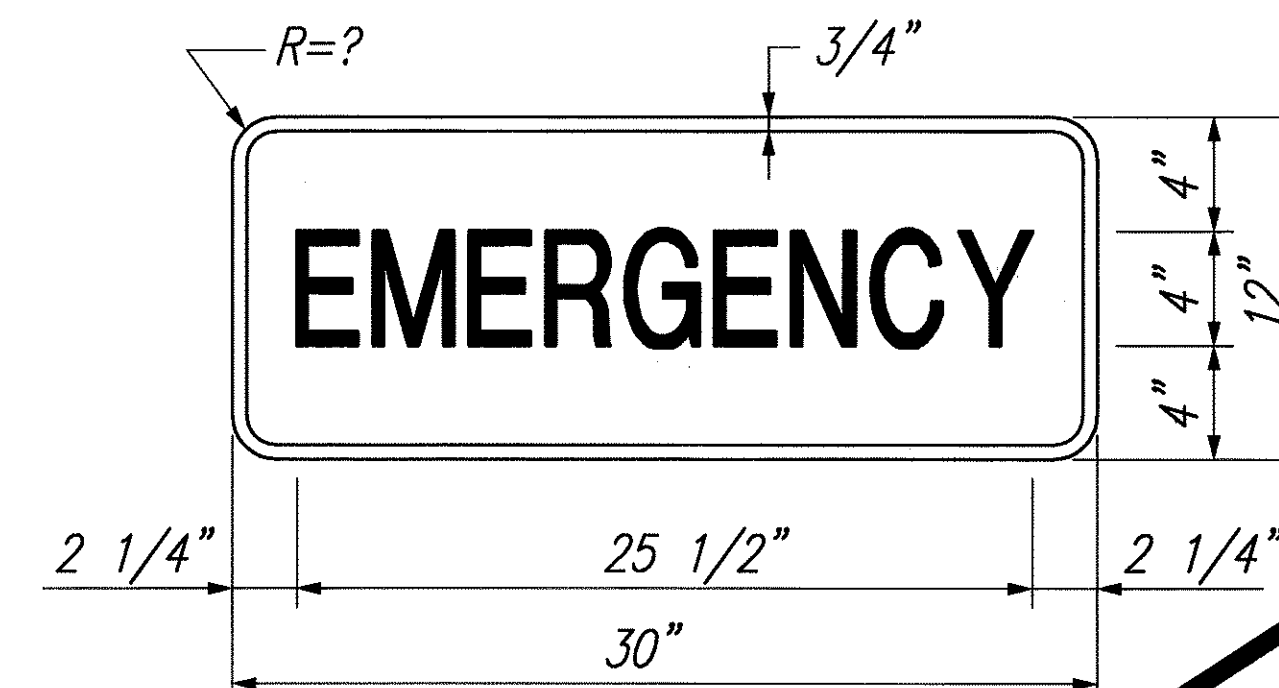

- NOTES:
- Lettering shall be centered and shall be 4" SERIES C letters.
 - All signs shall have white border and legend on a blue background.


EMERGENCY SIGN
Not to Scale

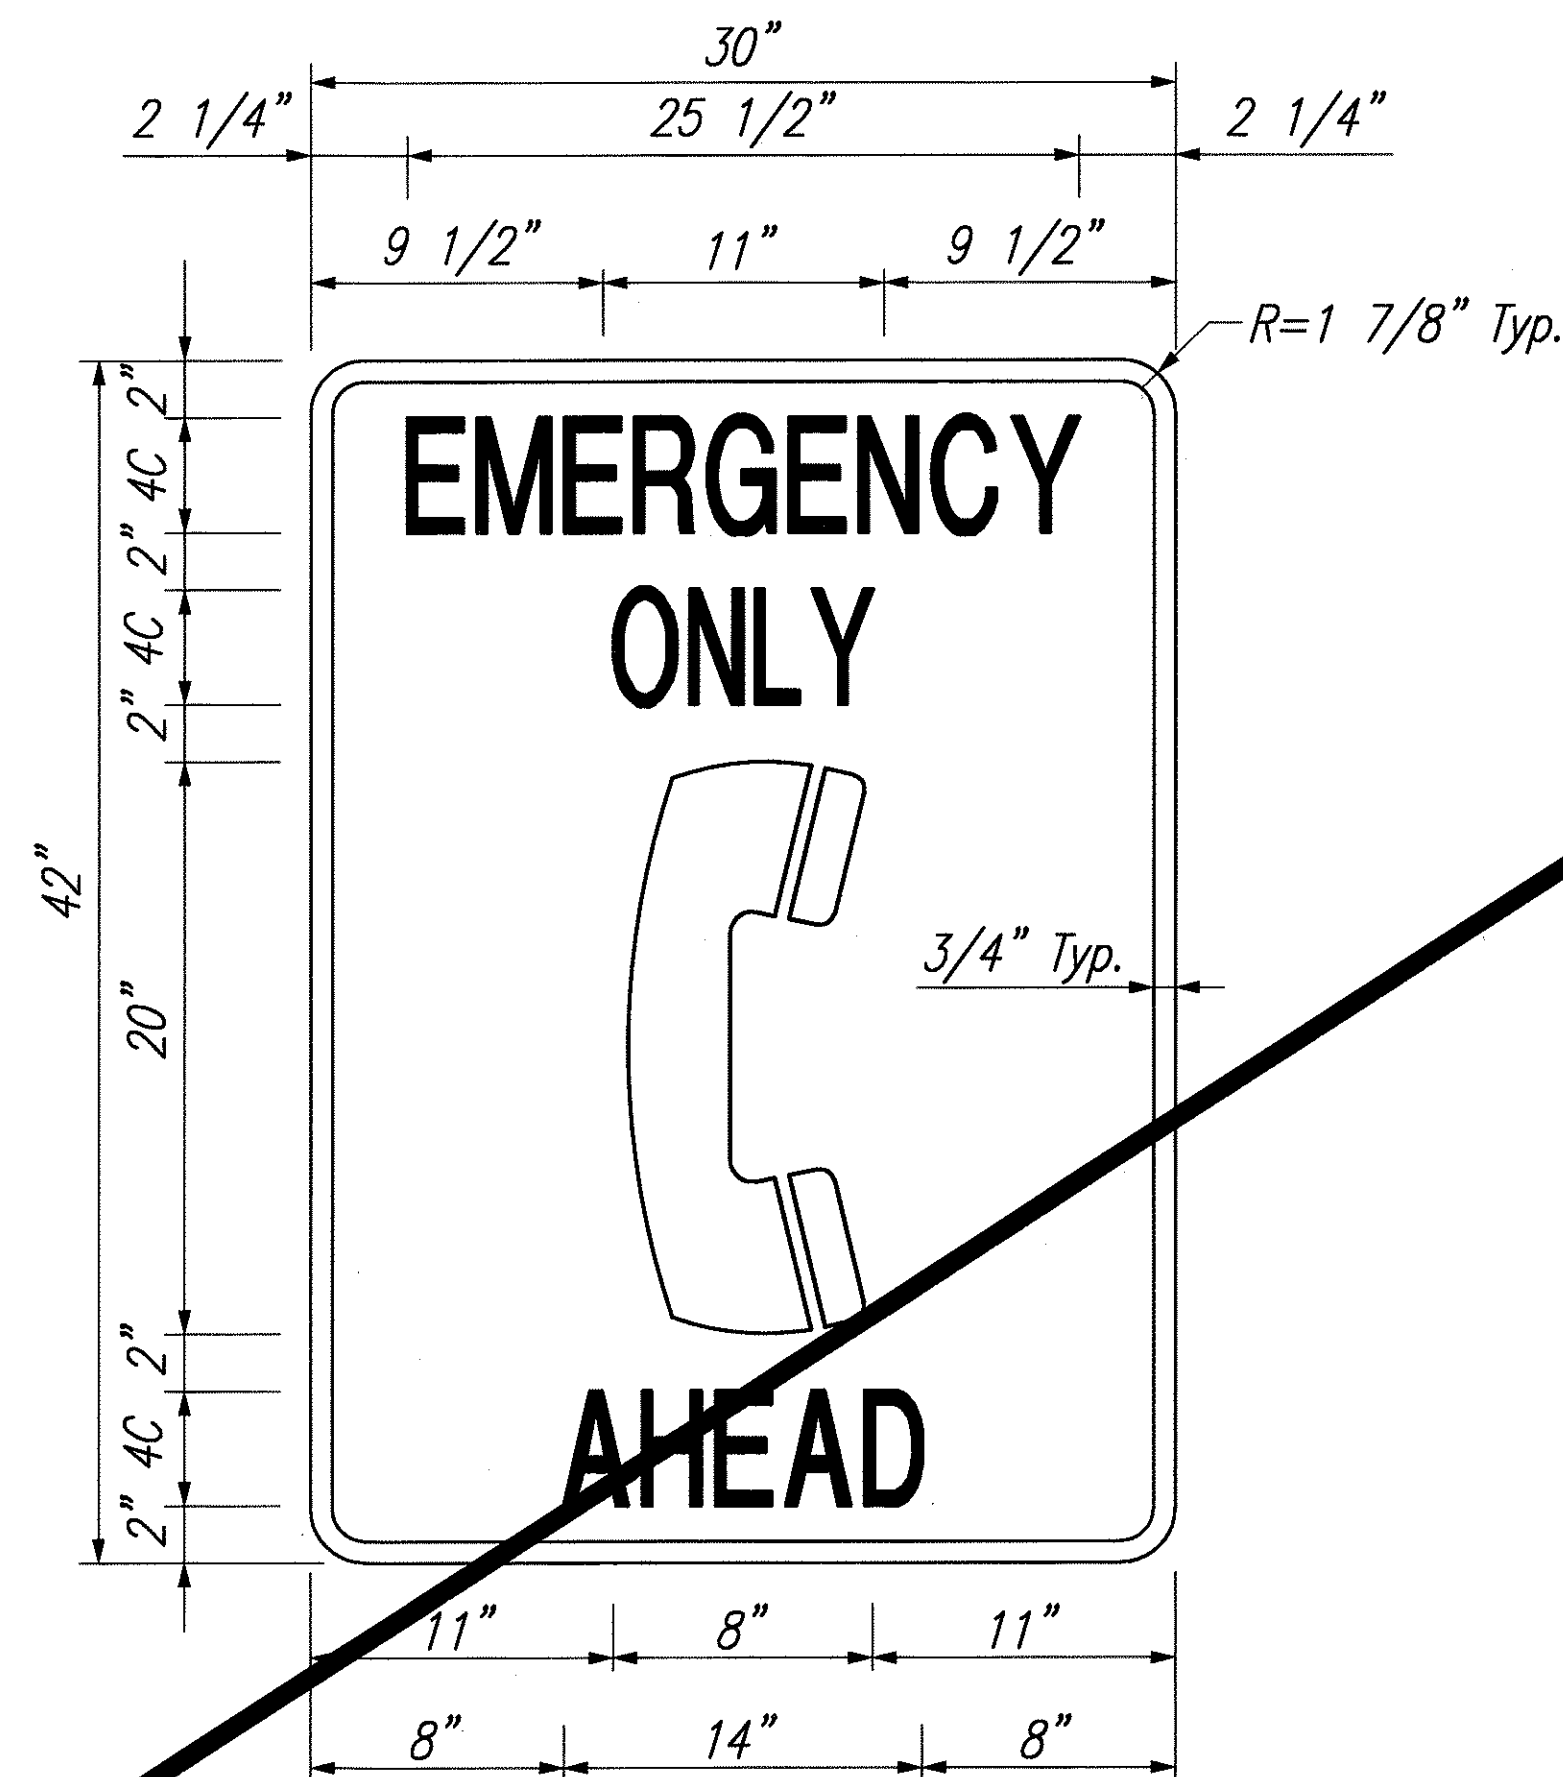

D9-1b (Modified) 36" x 42"
Not to Scale

- NOTES:
- Lettering shall be centered and shall be 4" SERIES C letters.
 - All signs shall have white border and legend on a blue background.

ORIGINAL PLAN	SURVEY PLOTTED BY	DATE
NOTE BOOK	DRAWN BY	
No.	DESIGNED BY	
	QUANTITIES BY	
	CHECKED BY	

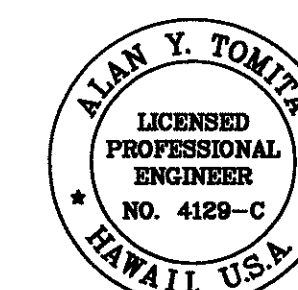

THIS WORK WAS PREPARED BY ME
OR UNDER MY SUPERVISION.

Alan Y. Tomita

STATE OF HAWAII
DEPARTMENT OF TRANSPORTATION
HIGHWAYS DIVISION

SIGN DETAILS

INTERSTATE ROUTE H-1
EMERGENCY TELEPHONE ACCESSIBLE ROUTES
F.A. Project No. NH-300(86)R

Scale: As Shown Date: September 2003

SHEET No. 1 OF 1 SHEETS