
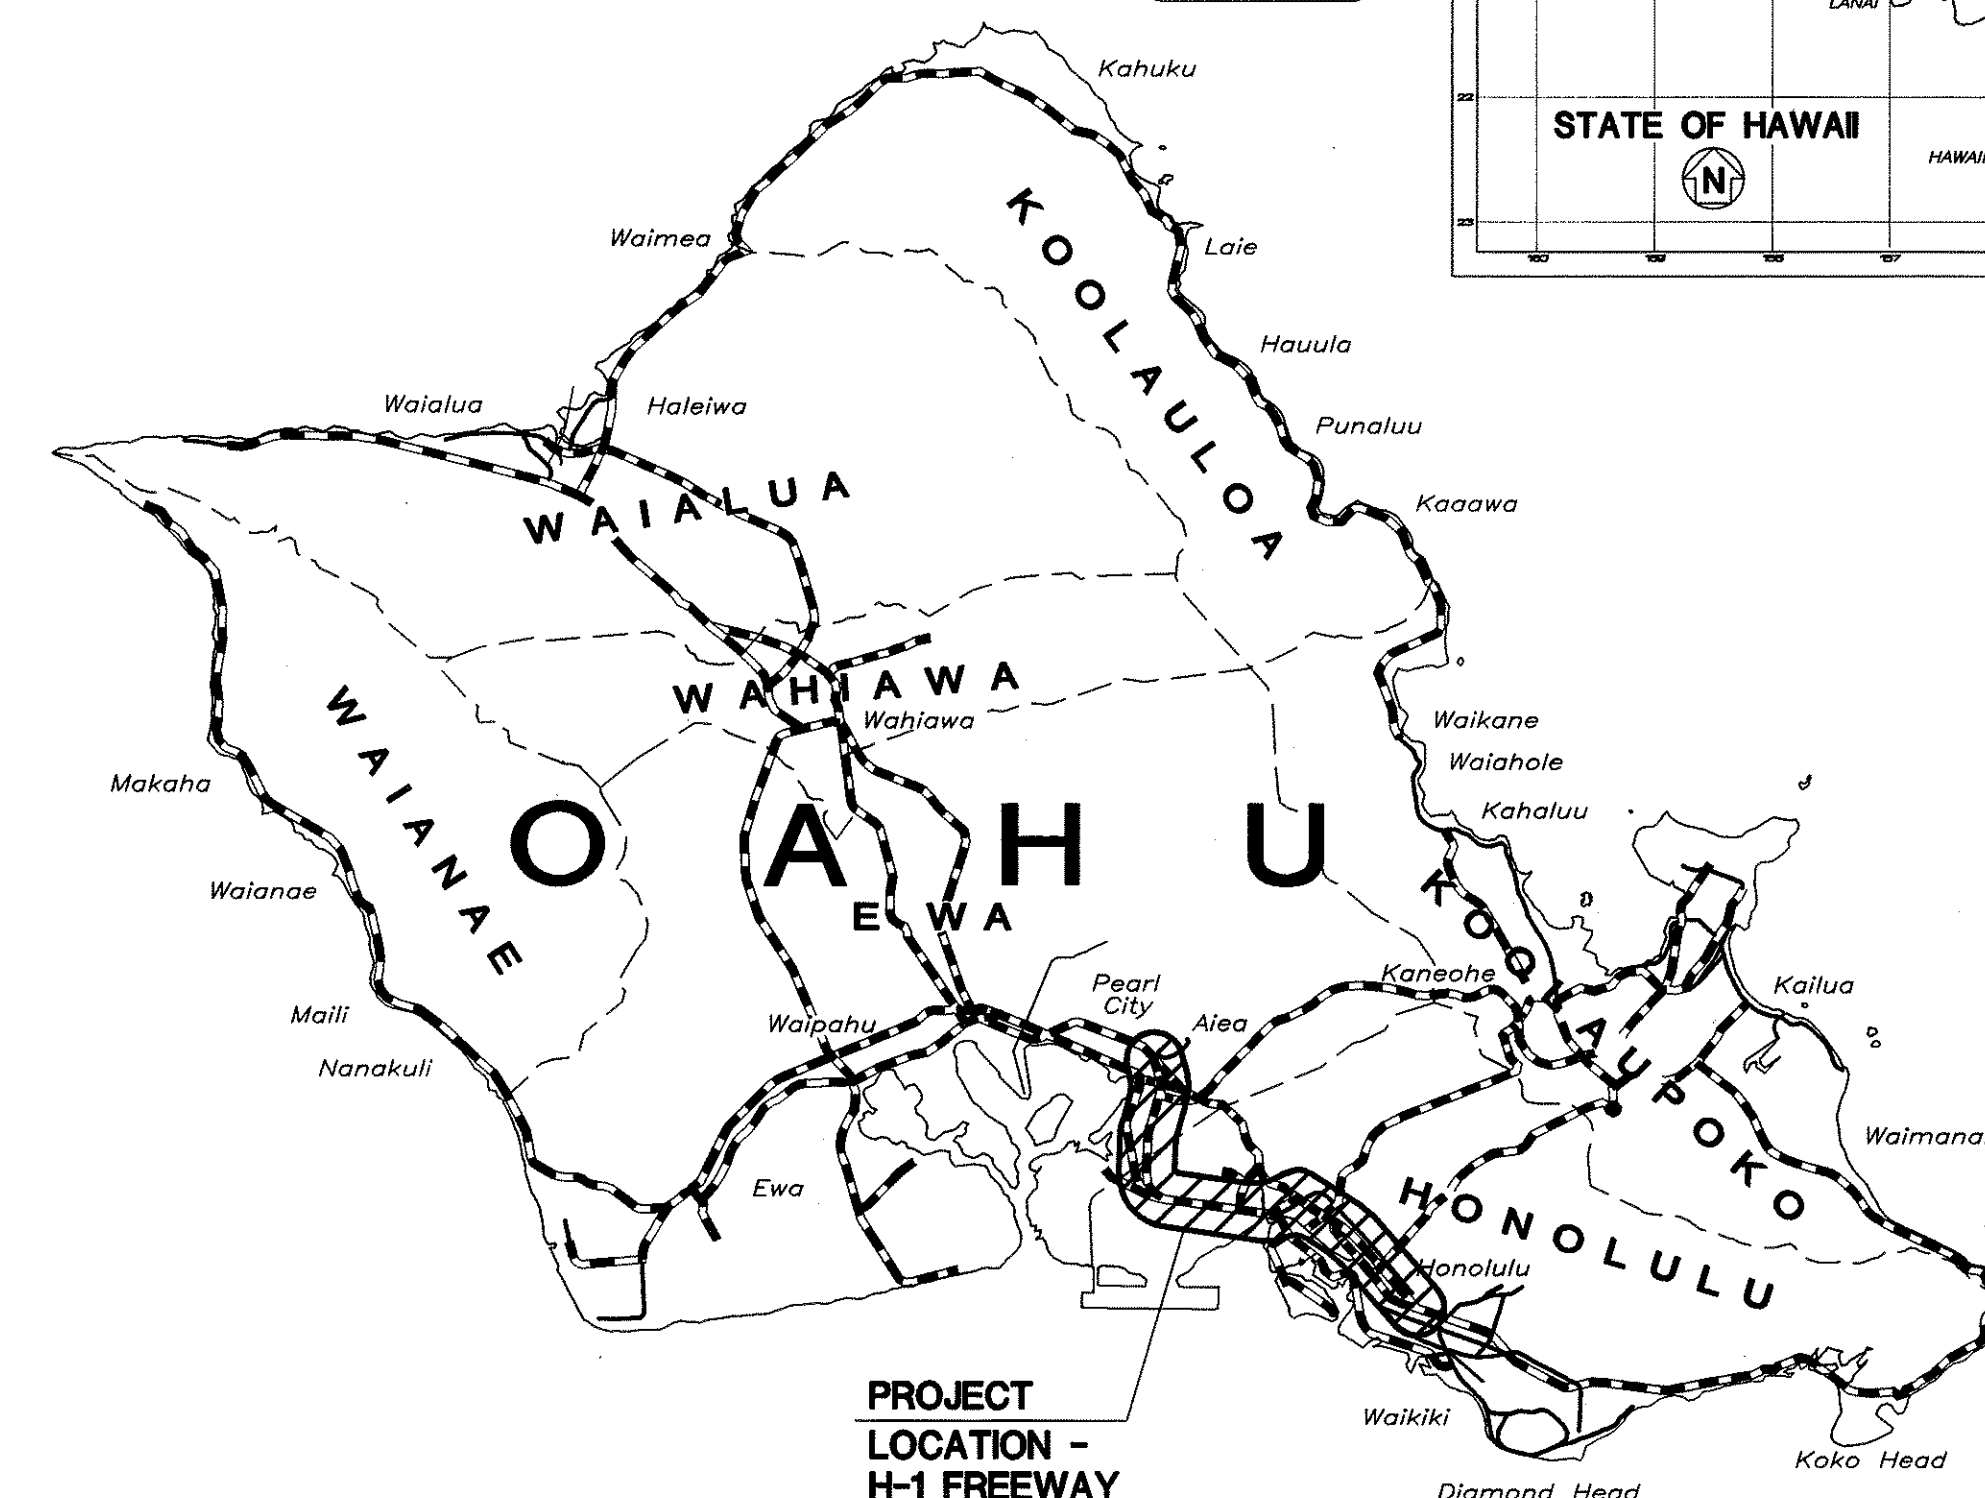
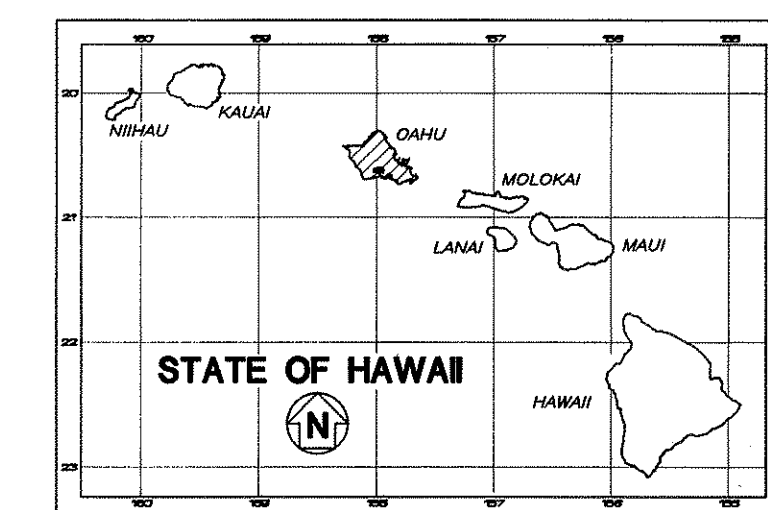


INDEX TO DRAWINGS	
SHEET NO.	DESCRIPTION
1	TITLE SHEET
2-3	LAYOUT PLANS
4	STANDARD PLANS SUMMARY
5-7	GENERAL NOTES, LEGEND & STANDARD INSTALLATIONS DETAILS
8	SIGN DETAILS
9-10	MISCELLANEOUS DETAILS
11	INSTALLATION SCHEDULE
12	WATER POLL. & EROSION CONTR. NOTES
INTERSTATE ROUTE H-1	
13-16	GENERAL PLANS
17-23	GRADING PLANS-EASTBOUND
24-30	GRADING PLANS-WESTBOUND
31-37	LOCAL TRAVERSE-EASTBOUND
38-44	LOCAL TRAVERSE-WESTBOUND
45	CONSTRUCTION SIGNS: FREEWAY WORK ZONE

STATE OF HAWAII
DEPARTMENT OF TRANSPORTATION
HIGHWAYS DIVISION
HONOLULU, HAWAII
"AS-BUILT"
PLANS FOR
INTERSTATE ROUTE H-1
EMERGENCY TELEPHONE ACCESSIBLE ROUTES
OAHU, HAWAII

FEDERAL AID PROJECT NO. NH-300(86)R
DISTRICTS OF HONOLULU & EWA
ISLAND OF OAHU


FED. ROAD DIST. NO.	STATE	FED. AID PROJ. NO.	FISCAL YEAR	SHEET NO.	TOTAL SHEETS
HAWAII	HAW.	NH-300(86)R	2004	1	45

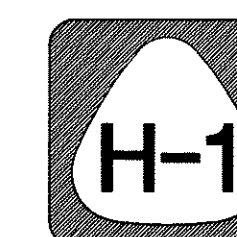

PROJECT
LOCATION -
H-1 FREEWAY



SCALE IN MILES

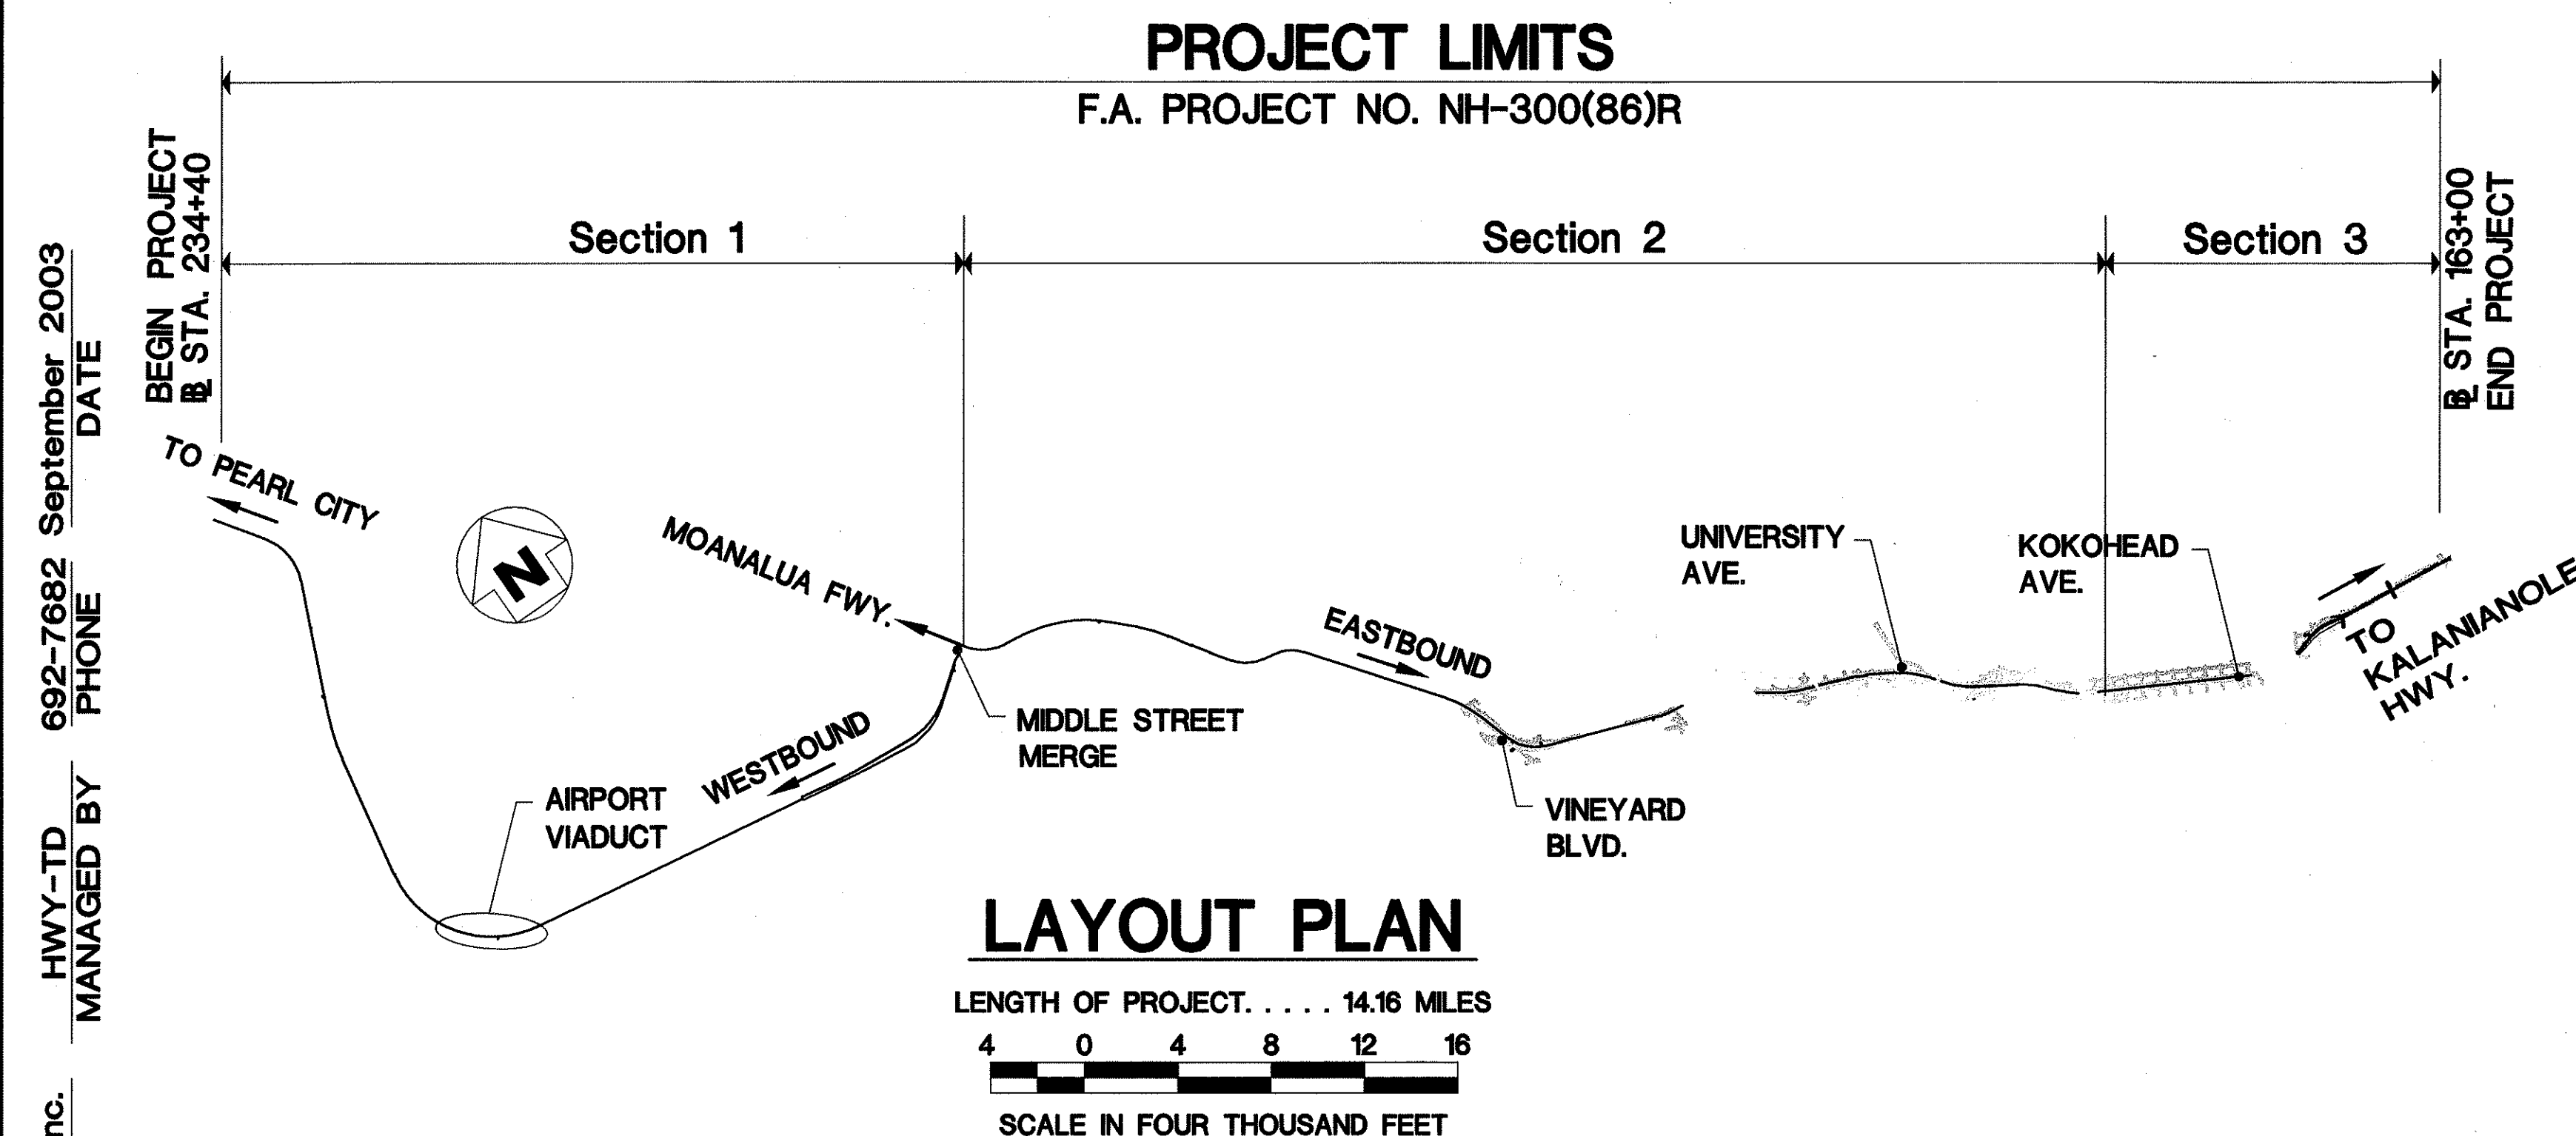

CHANGES MADE DURING CONSTRUCTION HAVE BEEN INCORPORATED ON THESE PLANS. ANY CHANGES IN THE ORIGINAL CONTRACT DOCUMENTS, SPECIFICATIONS, OR OTHER DOCUMENTS, SHALL BE SUBJECT TO THE DISCRETION OF THE ENGINEER.

Signature 7/2/07
RESIDENT ENGINEER

----- FEDERAL AID PROJECTS PREVIOUSLY CONSTRUCTED OR UNDER CONSTRUCTION

MILE POST 13.00 TO MILE POST 27.16

DESIGN DESIGNATION

Data Section	Section 1	Section 2	Section 3
ADT (2003)	108,400	154,700	77,000
ADT (2023)	123,700	176,500	87,800
DHV	10,500	11,500	7,000
K _{AM}	8.5	6.5	8.0
D _{AM}	75/25	55/45	75/25
T _{AM}	3.0	2.0	2.0
K _{PM}	8.0	6.5	7.5
D _{PM}	60/40	55/45	65/35
T _{PM}	3.0	2.0	1.0
T ₂₄	3.5	2.0	1.5

Section 1: M.P. 13.00 to Kahauiki Interchange (East End)
Section 2: Kahauiki Interchange (East End) to Offramp to 6th Ave
Section 3: Offramp to 6th Ave to Ainakoa Ave

DEPARTMENT OF TRANSPORTATION
STATE OF HAWAII
APPROVED:
Signature 10/22/04
for DIR. OF TRANSPORTATION DATE

M & E Pacific, Inc.
DESIGNED BY
HWY-TD
MANAGED BY
692-7682 September 2003
DATE
PHONE