

| INDEX TO DRAWINGS |                                                                                                                                                      |
|-------------------|------------------------------------------------------------------------------------------------------------------------------------------------------|
| SHEET NO.         | DESCRIPTION                                                                                                                                          |
| 1                 | TITLE SHEET                                                                                                                                          |
| 2 - 4             | NOTES                                                                                                                                                |
| 5 - 6             | STATE ROADMAPS                                                                                                                                       |
| SCHEDULES         |                                                                                                                                                      |
| 7                 | RTE 61 PALI-KALANIANA'OLE-KAILUA                                                                                                                     |
| 8                 | RTE 63 KALIHI - LIKELIKE                                                                                                                             |
| 9                 | RTE 64 SAND ISLAND ACCESS,<br>RTE 65 KANEHOE BAY-MOKAPU SADDLE-MOKAPU                                                                                |
| 10                | RTE 72 KALANIANA'OLE                                                                                                                                 |
| 11                | RTE 76 FORT WEAVER<br>RTE 78 MOANALUA<br>RTE 80 KAMEHAMEHA                                                                                           |
| 12                | RTE 83 JOE P. LEONG-KAMEHAMEHA-KAHEKILI                                                                                                              |
| 13                | RTE 83 KAHEKILI-LIKELIKE-KAMEHAMEHA                                                                                                                  |
| 14 - 15           | RTE 92 NIMITZ-ALA MOANA                                                                                                                              |
| 16                | RTE 93 FARRINGTON                                                                                                                                    |
| 17                | RTE 95 KALAELOA<br>RTE 98 VINEYARD                                                                                                                   |
| 18 - 19           | RTE 99 KAMEHAMEHA-KAMANANUI-WILIKINA                                                                                                                 |
| 20                | RTE 750 KUNIA<br>RTE 901 FORT BARRETT,<br>RTE 7101 & 7110 FARRINGTON                                                                                 |
| 21                | RTE 7241 KAHUAPAANI<br>RTE 7310 PUULOA<br>RTE 7345 JARRETT WHITE<br>RTE 7350 BOUGAINVILLE,<br>RTE 7413 LILIHA<br>RTE 7415 MIDDLE<br>RTE 7601 WAIALAE |
| 22 - 23           | INTERSTATE RTE H-1                                                                                                                                   |
| 24                | INTERSTATE RTE H-2<br>H201                                                                                                                           |
| 25 - 26           | INTERSTATE RTE H-3                                                                                                                                   |

STATE OF HAWAII

## DEPARTMENT OF TRANSPORTATION

HIGHWAYS DIVISION

HONOLULU, HAWAII

"AS-BUILT"

PLANS FOR

## TRAFFIC SIGNAL MODERNIZATION

LED (LIGHT EMITTING DIODE) SIGNAL RETROFIT, PHASE 2



AT VARIOUS LOCATIONS ON OAHU

FEDERAL AID PROJECT NO. CMAQ-0300(108)

DISTRICTS OF HONOLULU, EWA, WAIANAE, WAHIAWA AND WAIALUA

ISLAND OF OAHU

| FED. ROAD DIST. NO. | STATE | FED. AID PROJ. NO. | FISCAL YEAR | SHEET NO. | TOTAL SHEETS |
|---------------------|-------|--------------------|-------------|-----------|--------------|
| HAWAII              | HAW.  | CMAQ-0300(108)     | 2008        | 1         | 26           |

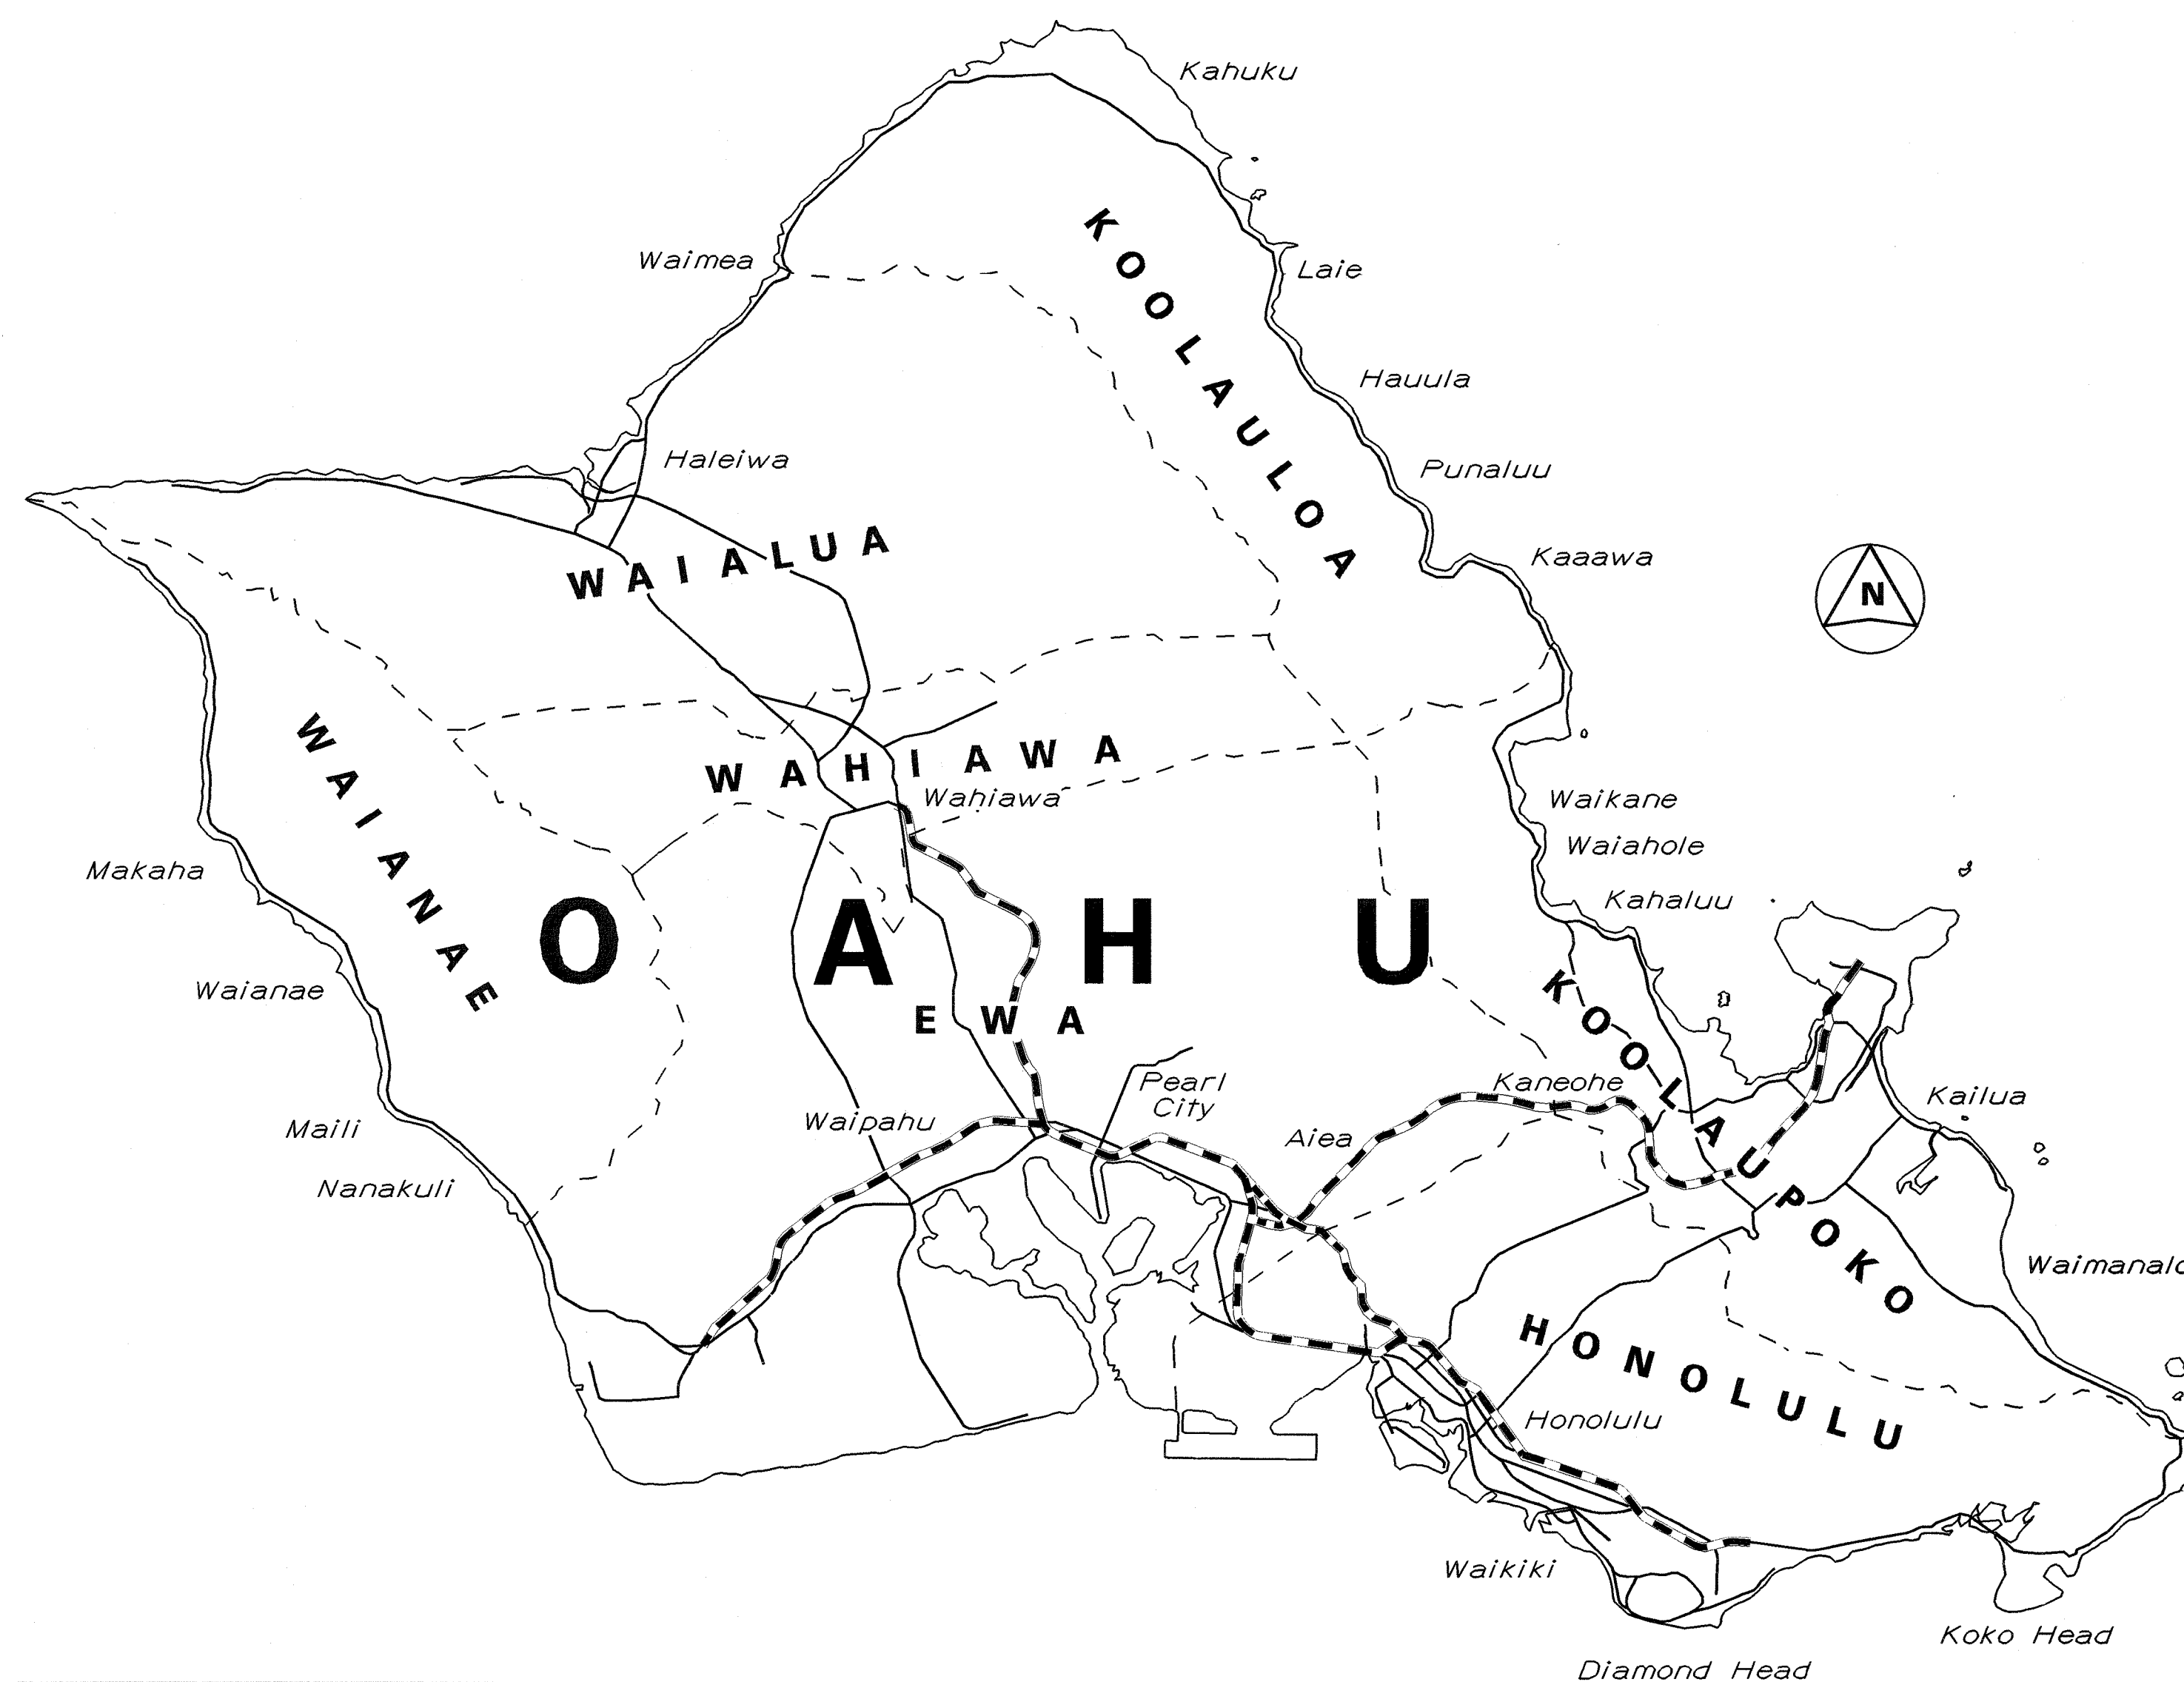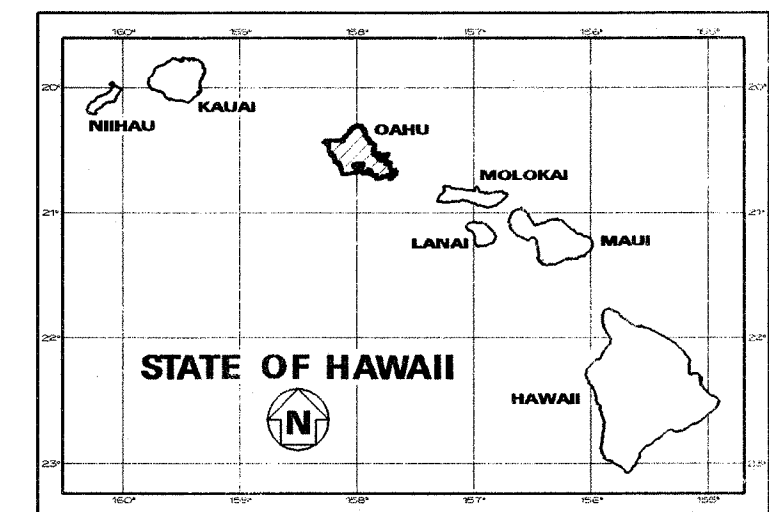

SCALE IN MILES

CHANGES MADE DURING CONSTRUCTION HAVE BEEN INCORPORATED ON THESE PLANS EXCEPT CHANGES IN THE ORIGINAL THEORETICAL QUANTITIES. FOR ACTUAL QUANTITIES, REFER TO PROJECT LEDGER AND/OR COMPUTATION BOOK.

RESIDENT ENGINEER  
DATE

DEPARTMENT OF TRANSPORTATION  
STATE OF HAWAII

APPROVED:

DIR. OF TRANSPORTATION  
DATE

HWY-T  
DESIGNED BY

HWY-TD  
P. S. & E. BY

692-7680  
PHONE

MAY 2007  
DATE