


FED. ROAD DIST. NO.	STATE	FEDERAL AID PROJ. NO.	FISCAL YEAR	SHEET NO.	TOTAL SHEETS
HAWAII	HAW.	CMAQ-0300(92)	2004	150	187

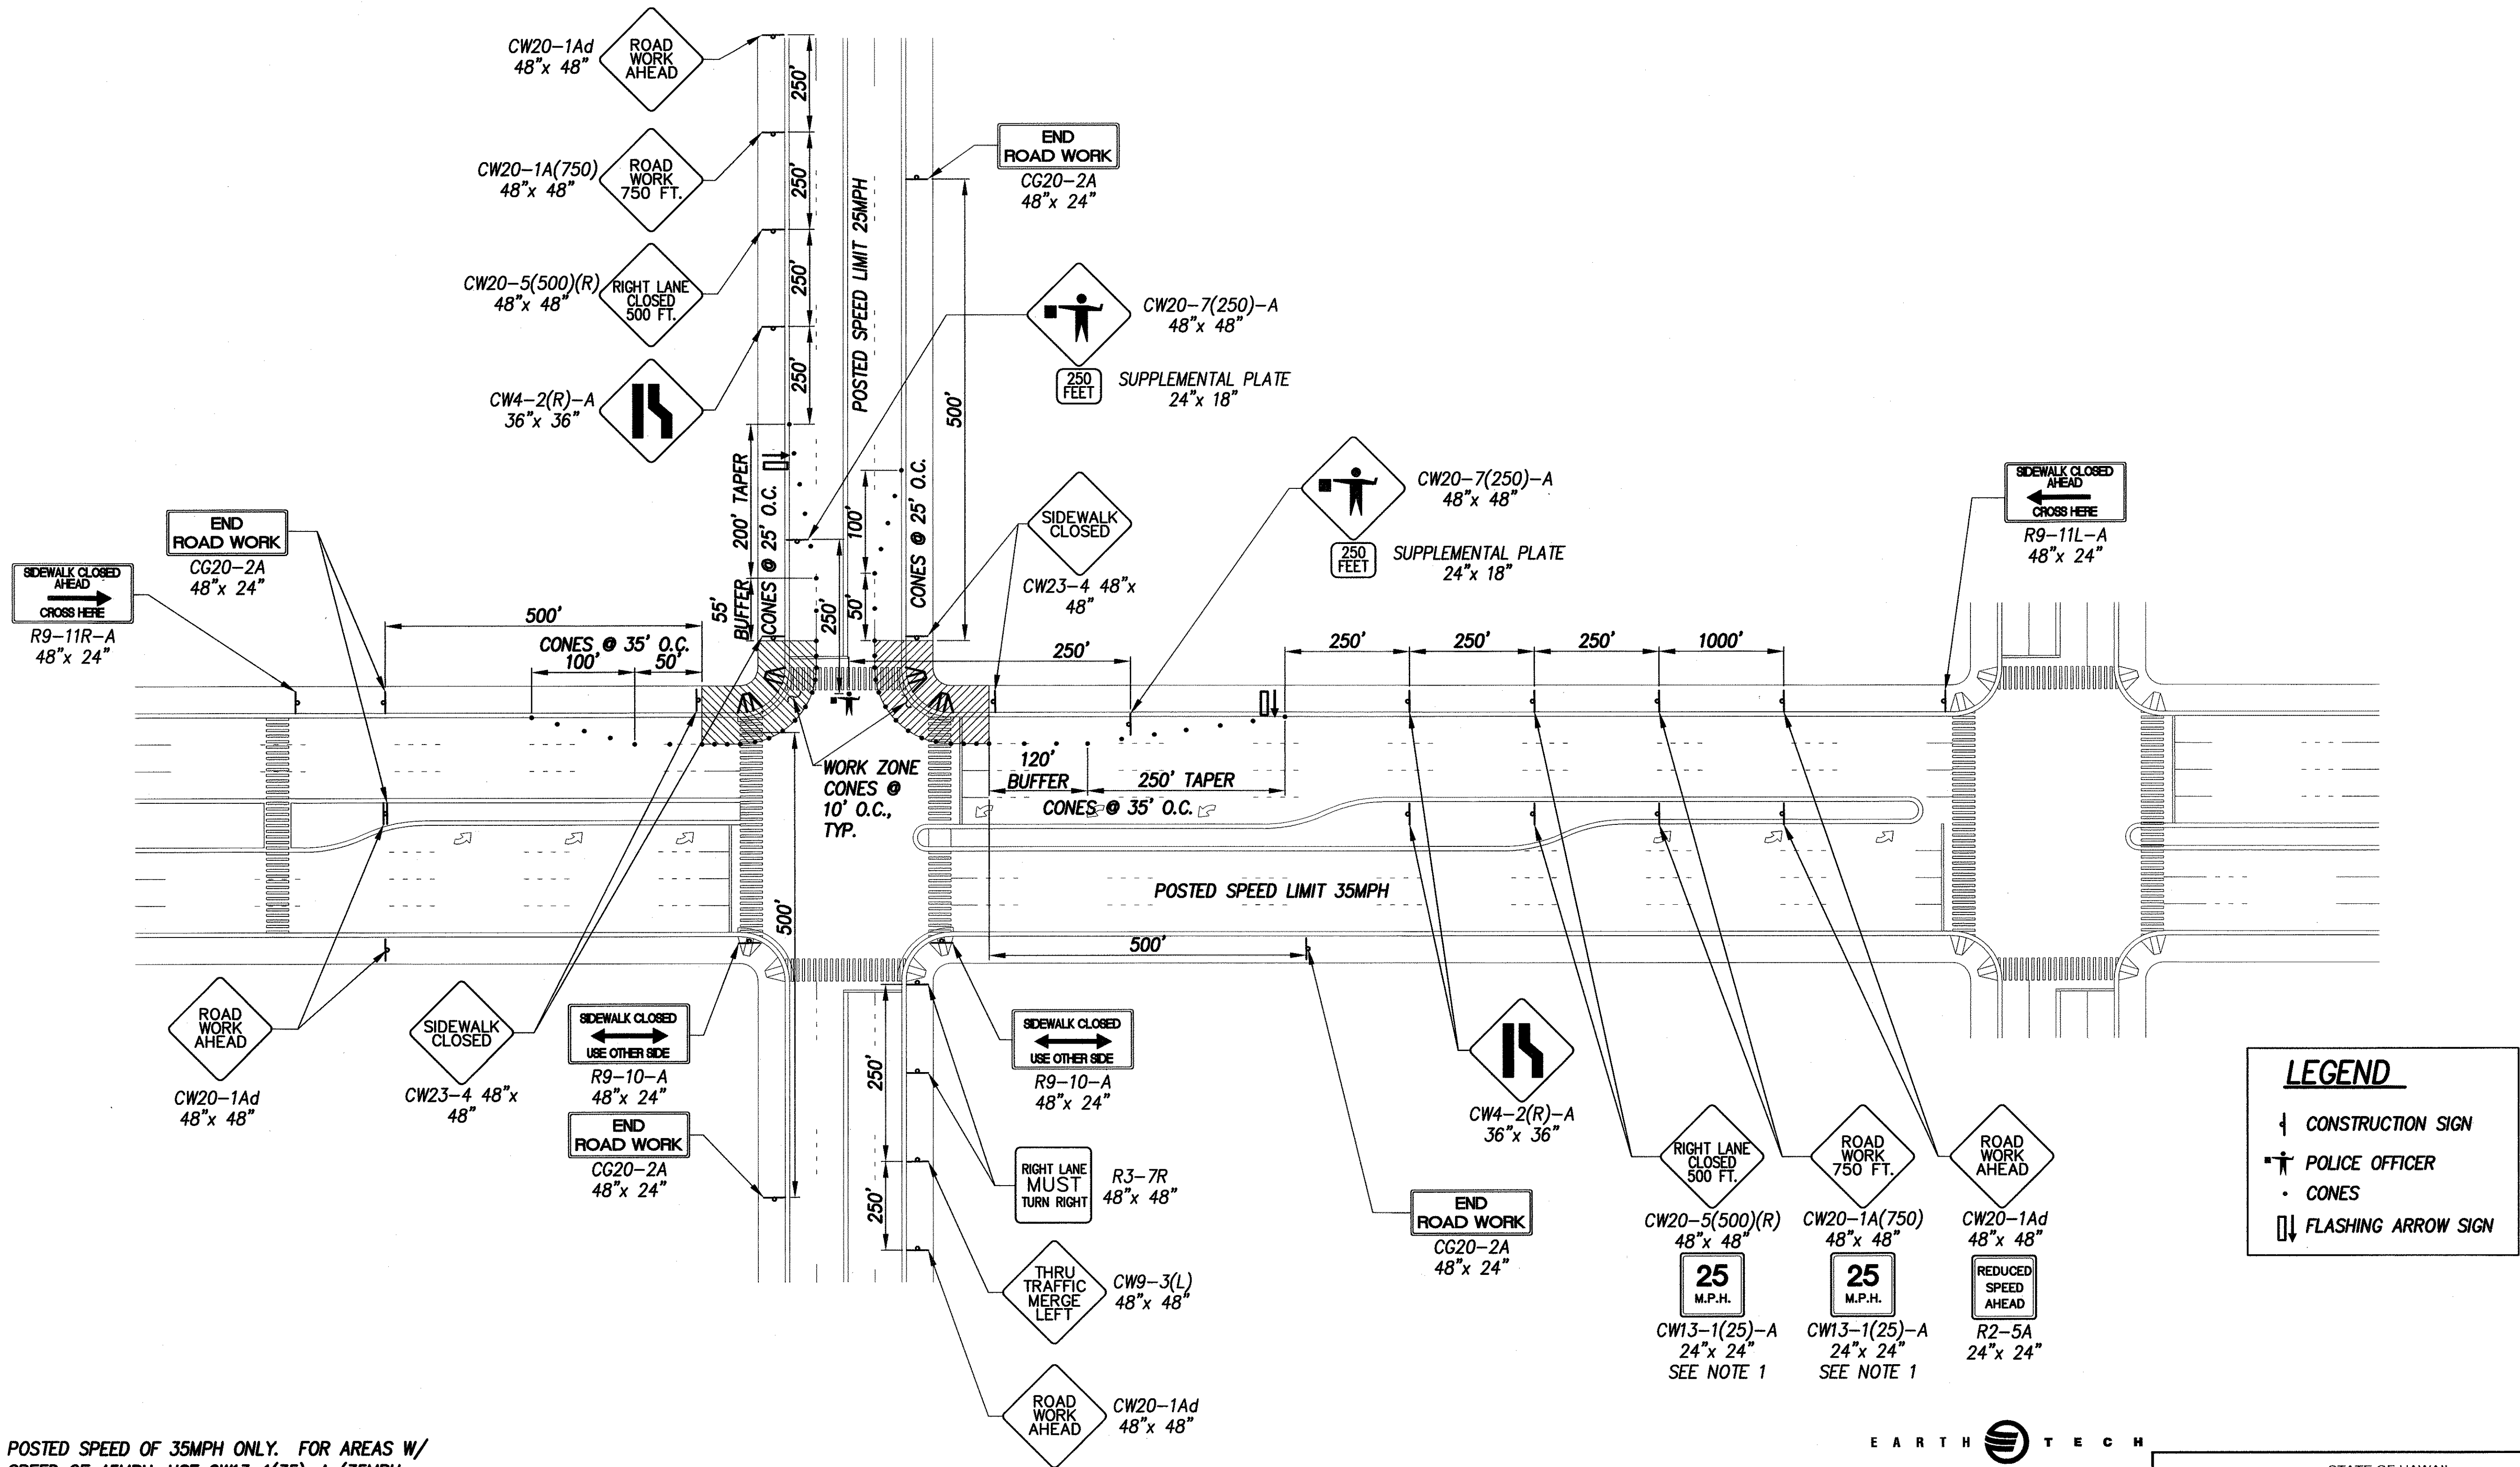


- NOTES:
1. FOR POSTED SPEED OF 35MPH ONLY. FOR AREAS W/ POSTED SPEED OF 45MPH, USE CW13-1(35)-A (35MPH CONSTRUCTION ZONE SPEED LIMIT)
 2. SIGN SPACING, TAPER AND BUFFER LENGTHS SHALL BE IN ACCORDANCE TO EITHER THE STD. SPEC. SECTION 645, STATE OF HAWAII DEPT. OF TRANSPORTATION, HIGHWAYS DIVISION OR THE MANUAL ON UNIFORM TRAFFIC CONTROL DEVICES (MUTCD), 2000 ED. THE CONTRACTOR SHALL APPLY THE STRICTER OF THE TWO.

TRAFFIC CONTROL PLAN - CROSS INTERSECTION, DIVIDED HWY. - PHASE 1
SCALE: NTS

EARTH TECH

A Tyco Infrastructure Services Company
841 Bishop Street, Suite 500
Honolulu, HI 96813

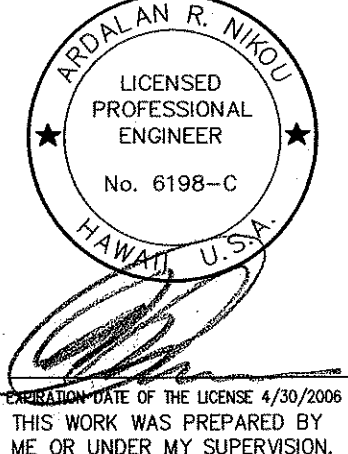


STATE OF HAWAII
DEPARTMENT OF TRANSPORTATION
HIGHWAYS DIVISION

TYPICAL TRAFFIC CONTROL PLAN - 1
Pedestrian Facilities & ADA Compliance at Various Locations on Oahu, Unit 1
Fed. Aid Proj. No. CMAQ-0300(92)

Scale: As Noted Date: August 2004
SHEET No. C-149 OF 154 SHEETS

FED. ROAD DIST. NO.	STATE	FEDERAL AID PROJ. NO.	FISCAL YEAR	SHEET NO.	TOTAL SHEETS
HAWAII	HAW.	CMAQ-0300(92)	2004	153	187

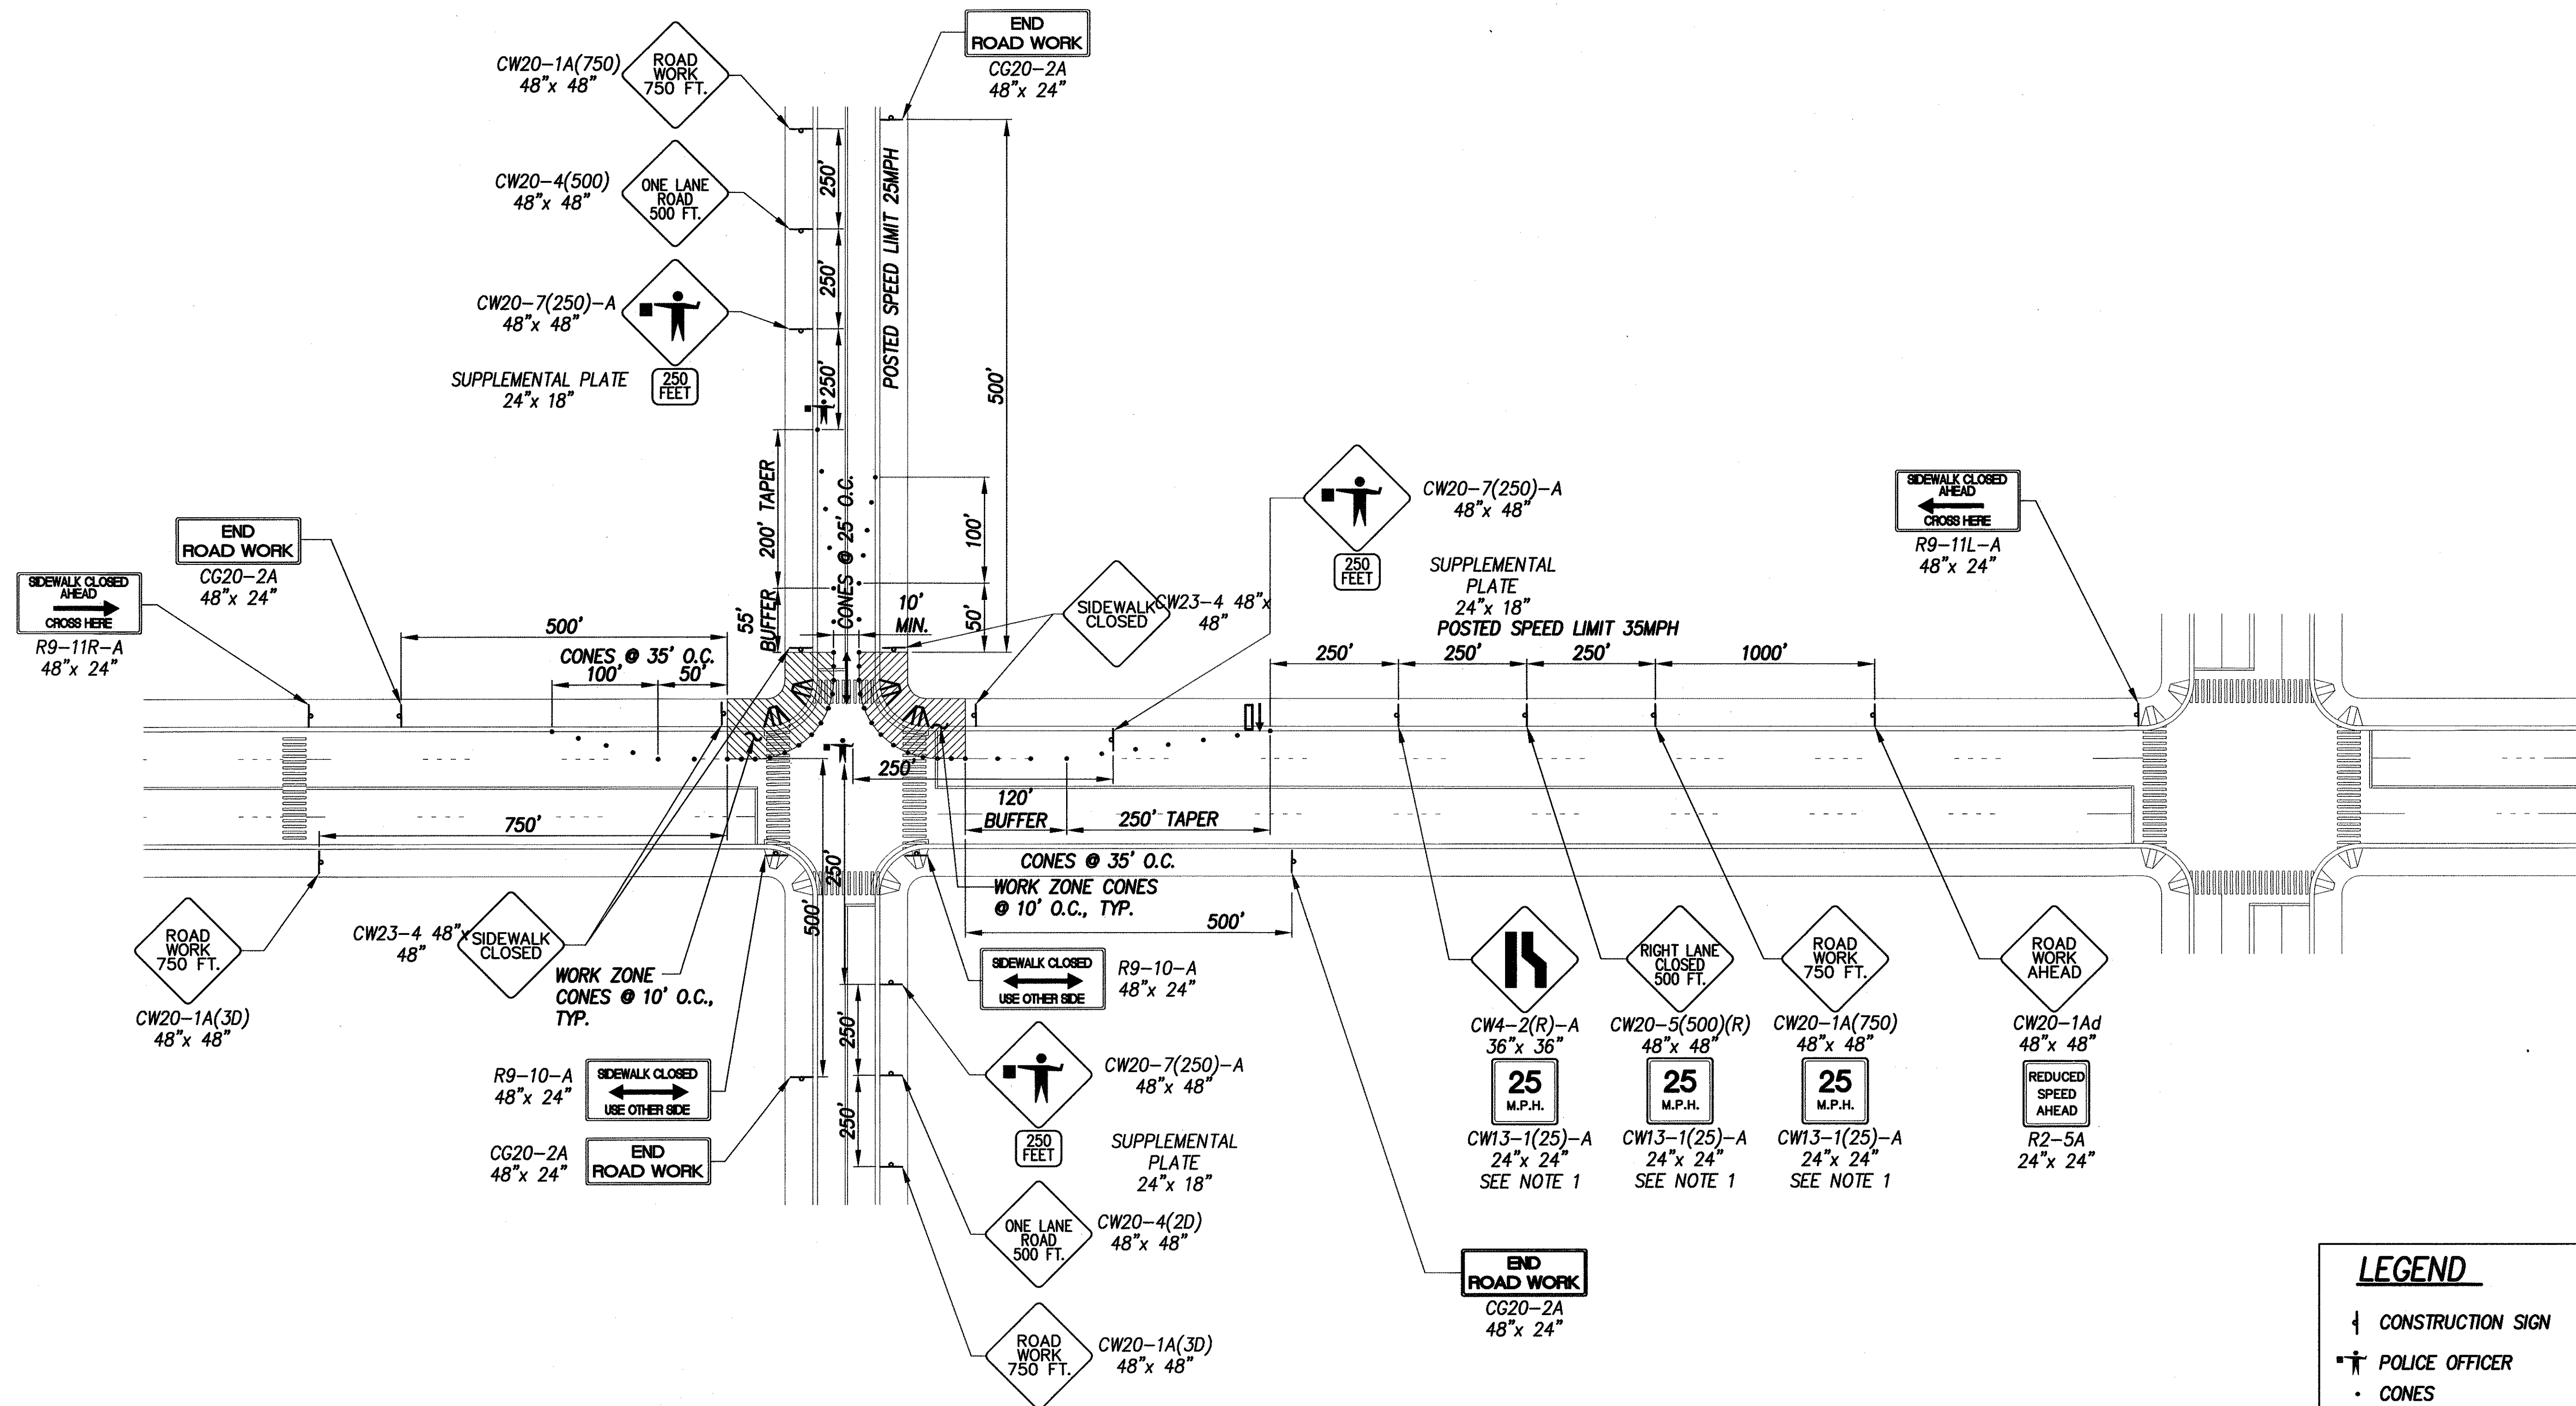

ORIGINAL PLAN	SURVEY PLOTTED BY	DATE
NOTE BOOK	DRAWN BY	
	DESIGNED BY	
	CHECKED BY	
	NO.	


U:\Work\Units\151\151-000\151-000-001\151-000-001.dwg 08/22/04 8:22 AM roadhwy\151-000-001.dwg

NOTES:

- FOR POSTED SPEED OF 35MPH ONLY. FOR AREAS W/ POSTED SPEED OF 45MPH, USE CW13-1(35)-A (35MPH CONSTRUCTION ZONE SPEED LIMIT)
- SIGN SPACING, TAPER AND BUFFER LENGTHS SHALL BE IN ACCORDANCE TO EITHER THE STD. SPEC. SECTION 645, STATE OF HAWAII DEPT. OF TRANSPORTATION, HIGHWAYS DIVISION OR THE MANUAL ON UNIFORM TRAFFIC CONTROL DEVICES (MUTCD), 2003 ED. THE CONTRACTOR SHALL APPLY THE STRICTER OF THE TWO.

EARTH TECH

A Tyco Infrastructure Services Company
 841 Bishop Street, Suite 500
 Honolulu, HI 96813

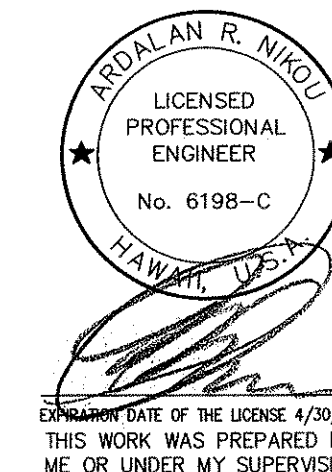

EXPIRATION DATE OF THE LICENSE 4/30/2006
 THIS WORK WAS PREPARED BY ME OR UNDER MY SUPERVISION.

STATE OF HAWAII
 DEPARTMENT OF TRANSPORTATION
 HIGHWAYS DIVISION


TYPICAL TRAFFIC CONTROL PLAN – 4

*Pedestrian Facilities & ADA Compliance
 at Various Locations on Oahu, Unit 1
 Fed. Aid Proj. No. CMAQ-0300(92)*

Scale: As Noted Date: August 2004


SHEET No. C-152 OF 154 SHEETS

FED. ROAD DIST. NO.	STATE	FED. AID PROJ. NO.	FISCAL YEAR	SHEET NO.	TOTAL SHEETS
HAWAII	HAW.	CMAQ-0300(92)	2004	155 S-1	187

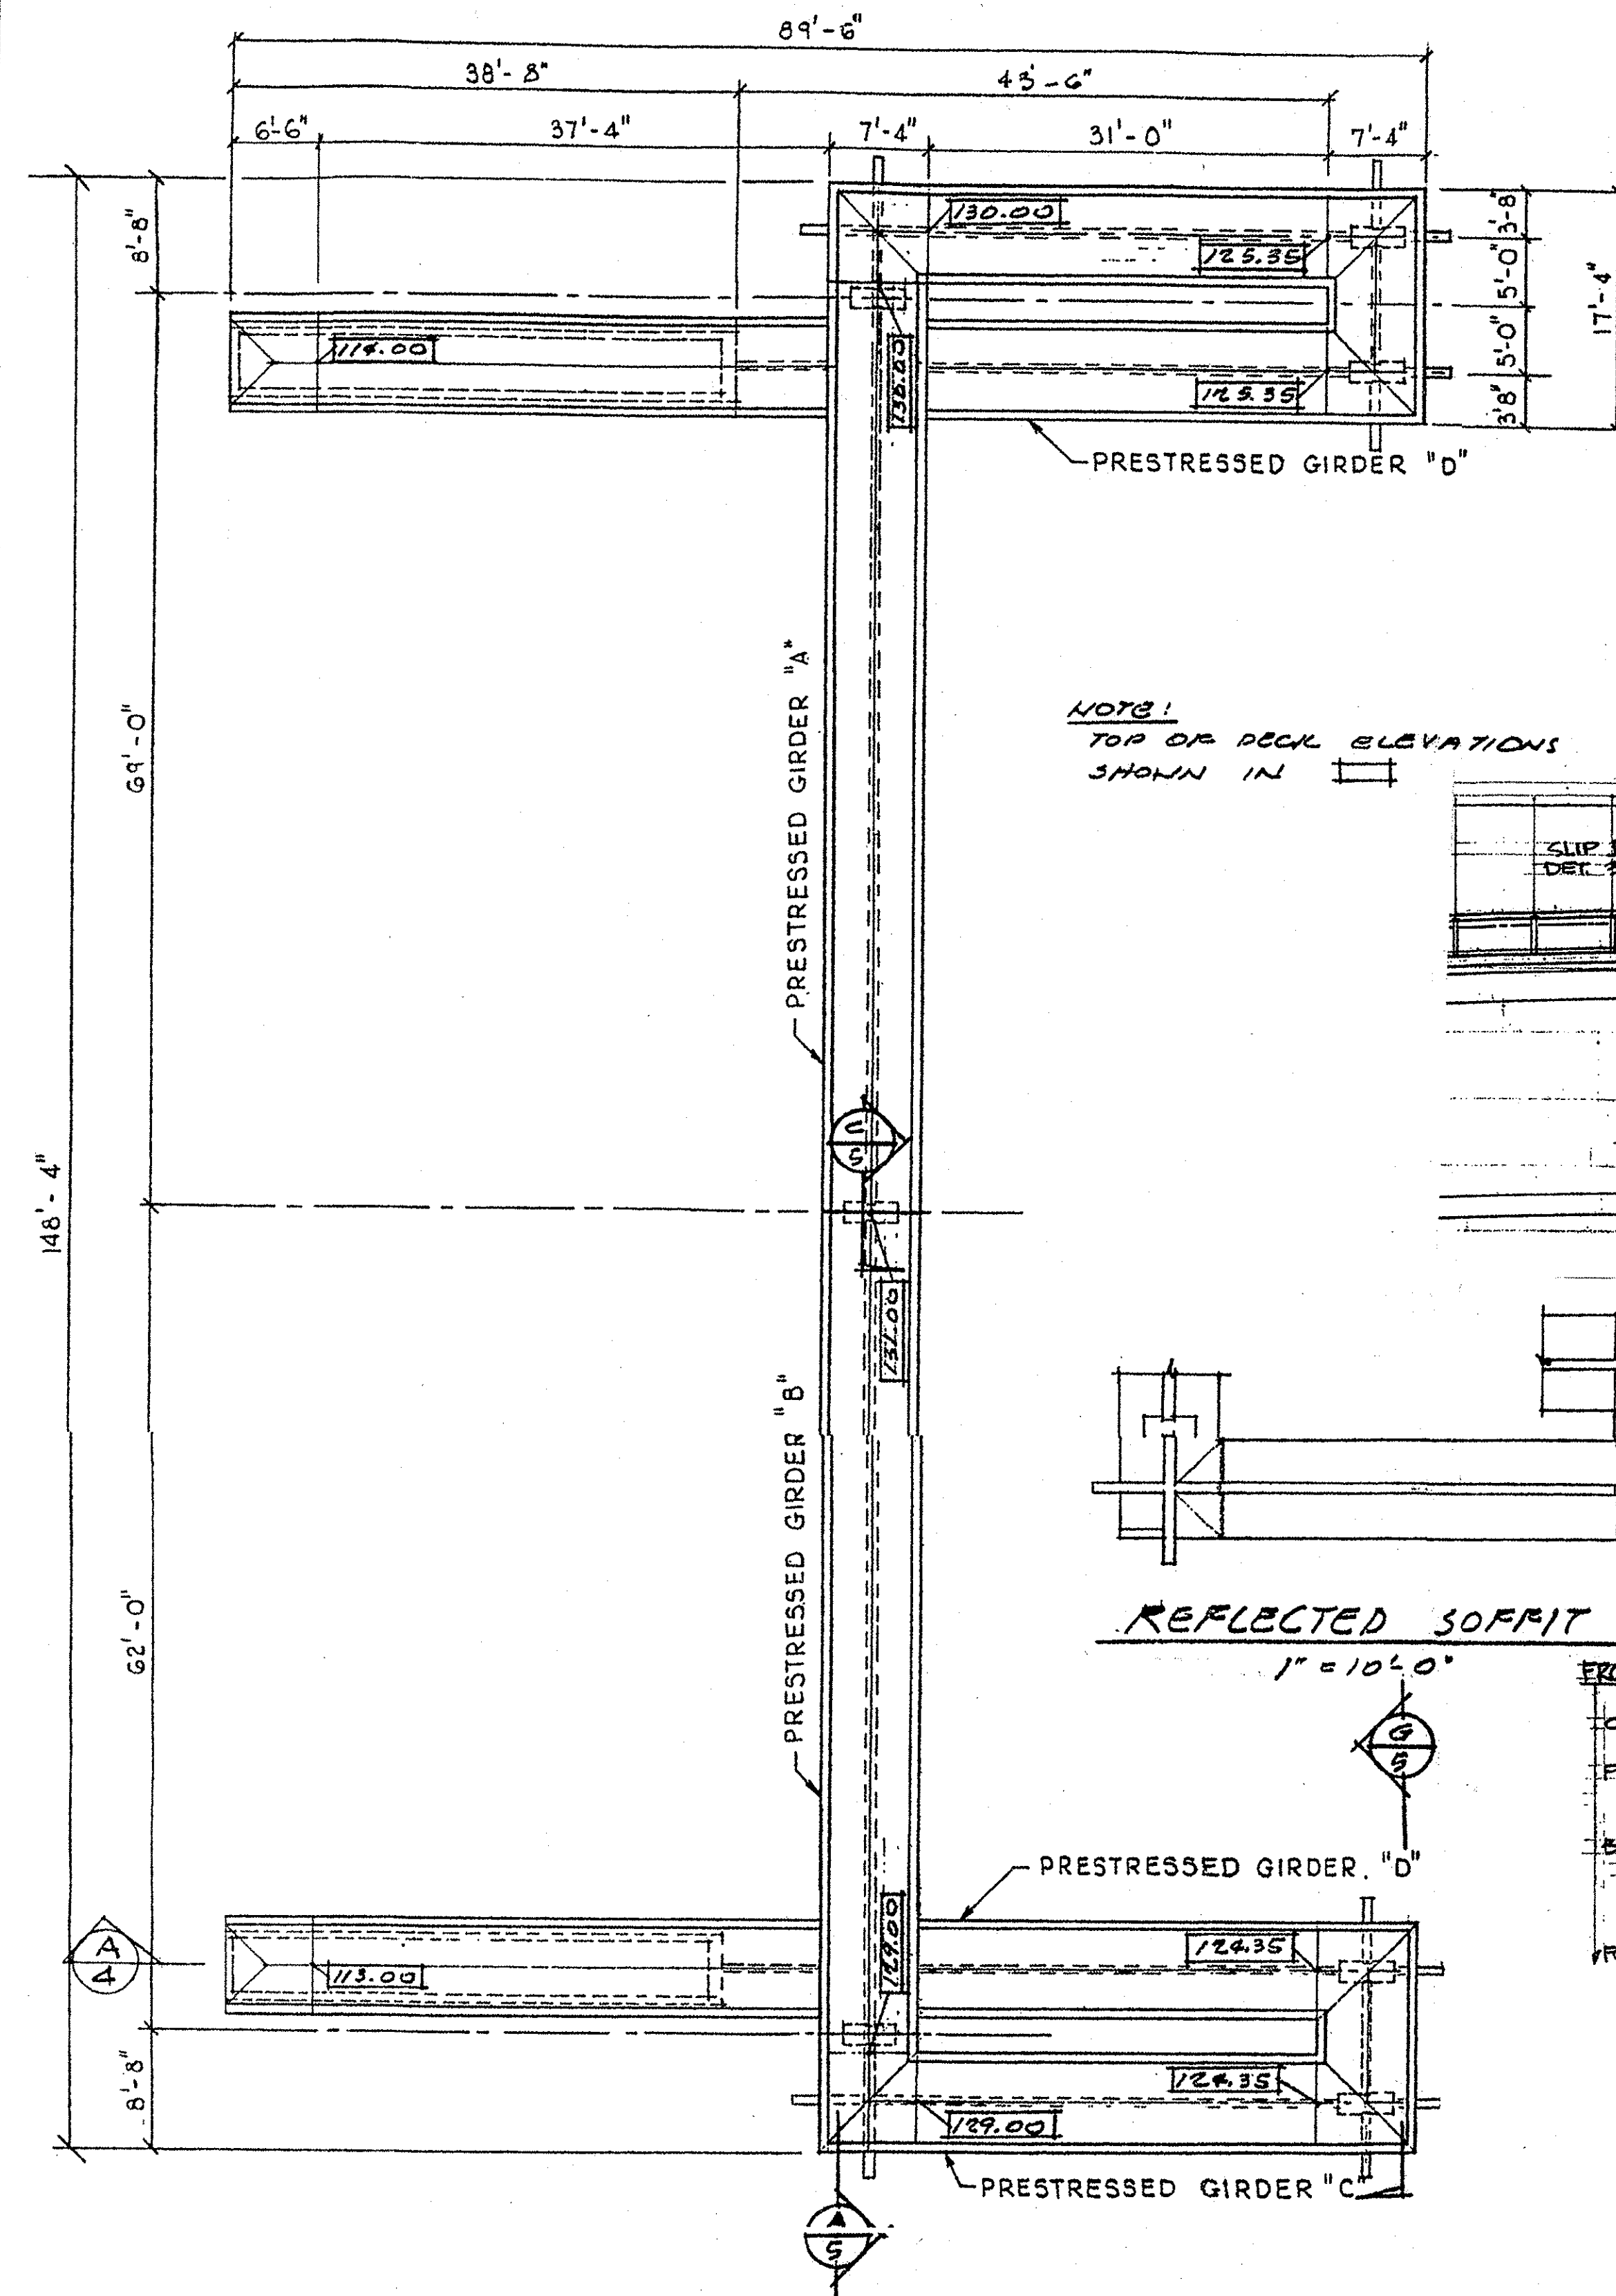


**SITE PLAN - LIKELIKE HWY. AT ANOI ROAD
PEDESTRIAN OVERPASS**
SCALE: 1"=10'

NOTE:
TOP OF DECK ELEVATIONS
SHOWN IN

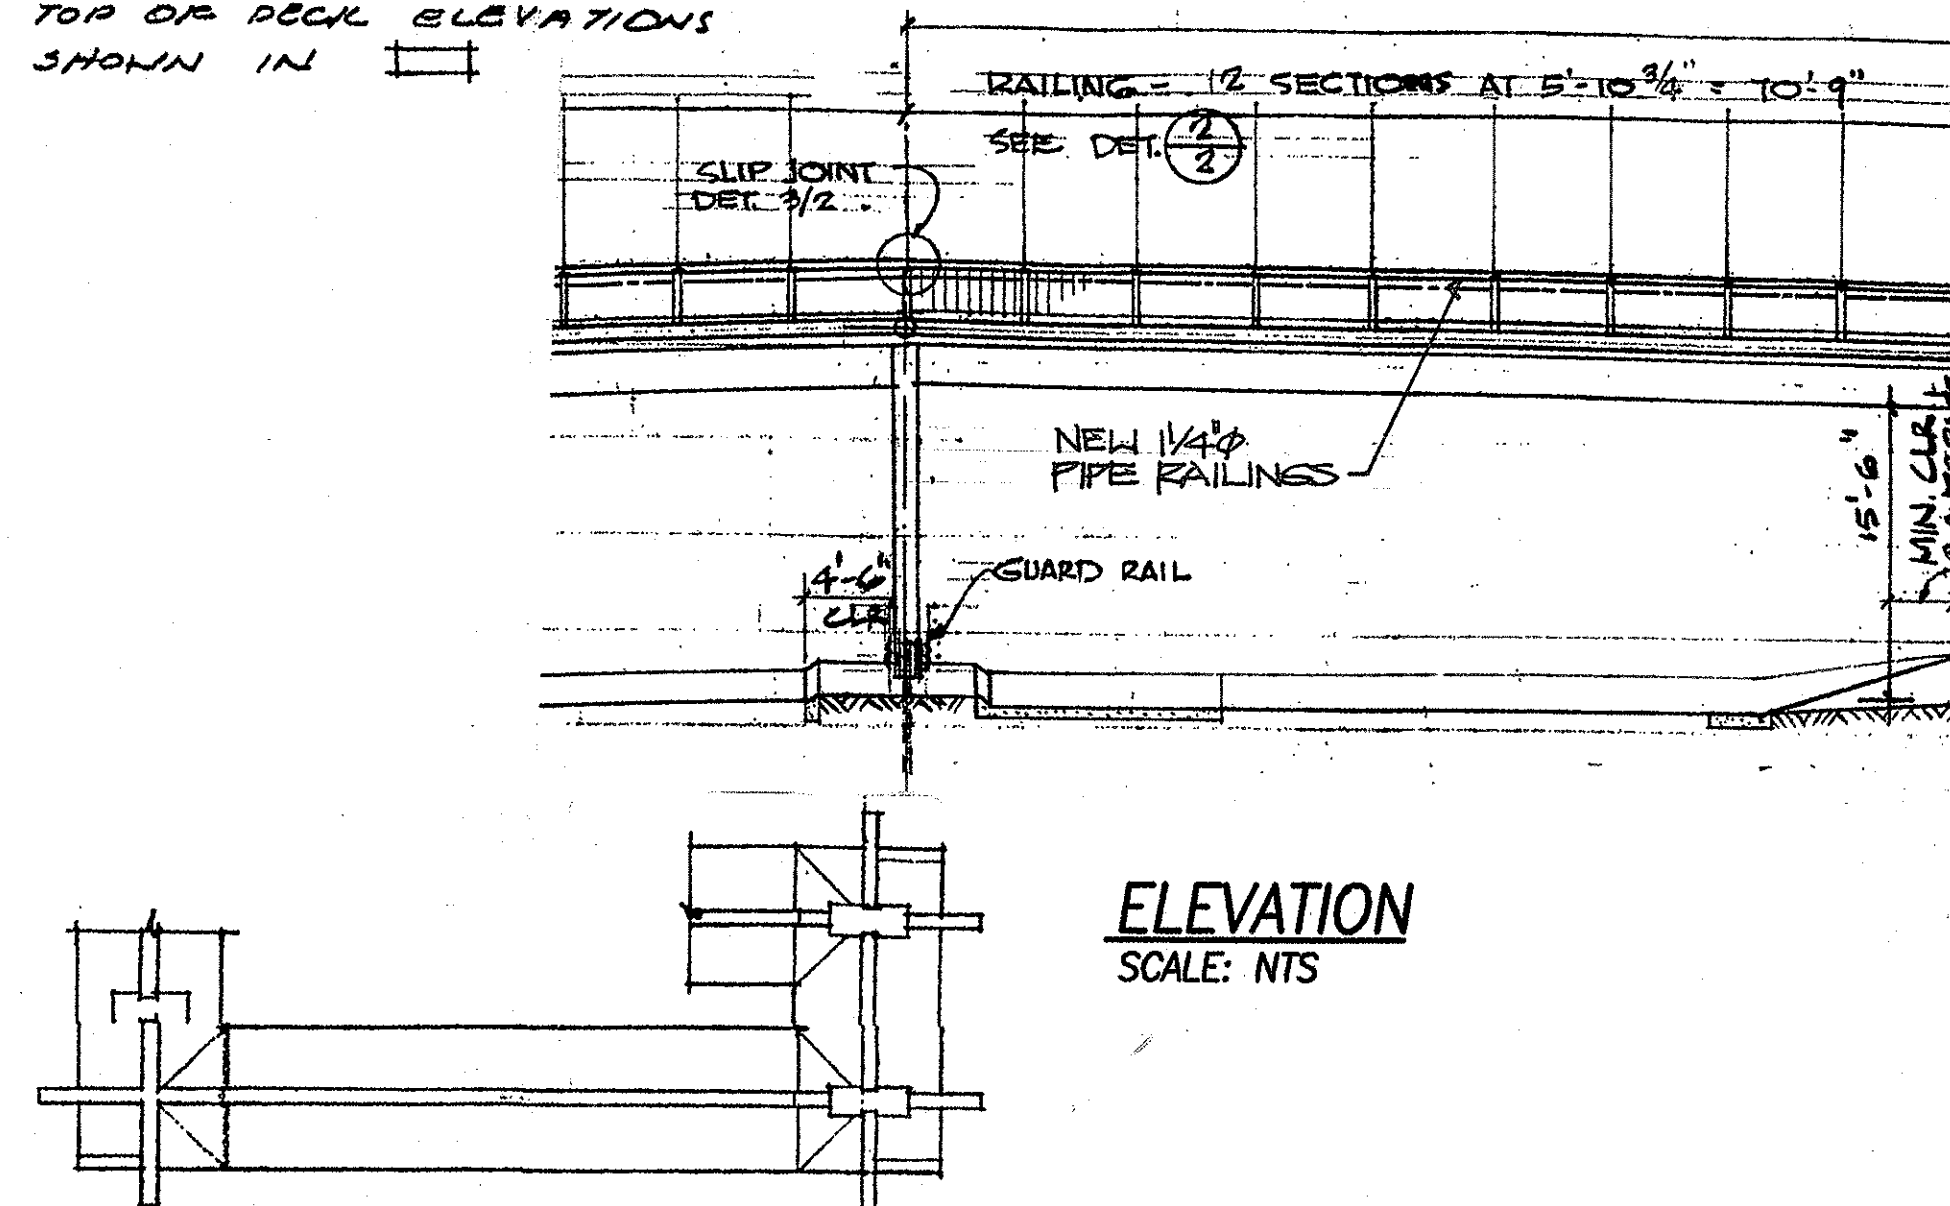


ELEVATION
SCALE: NTS


REFLECTED SOFFIT PLAN
1"=10'-0"

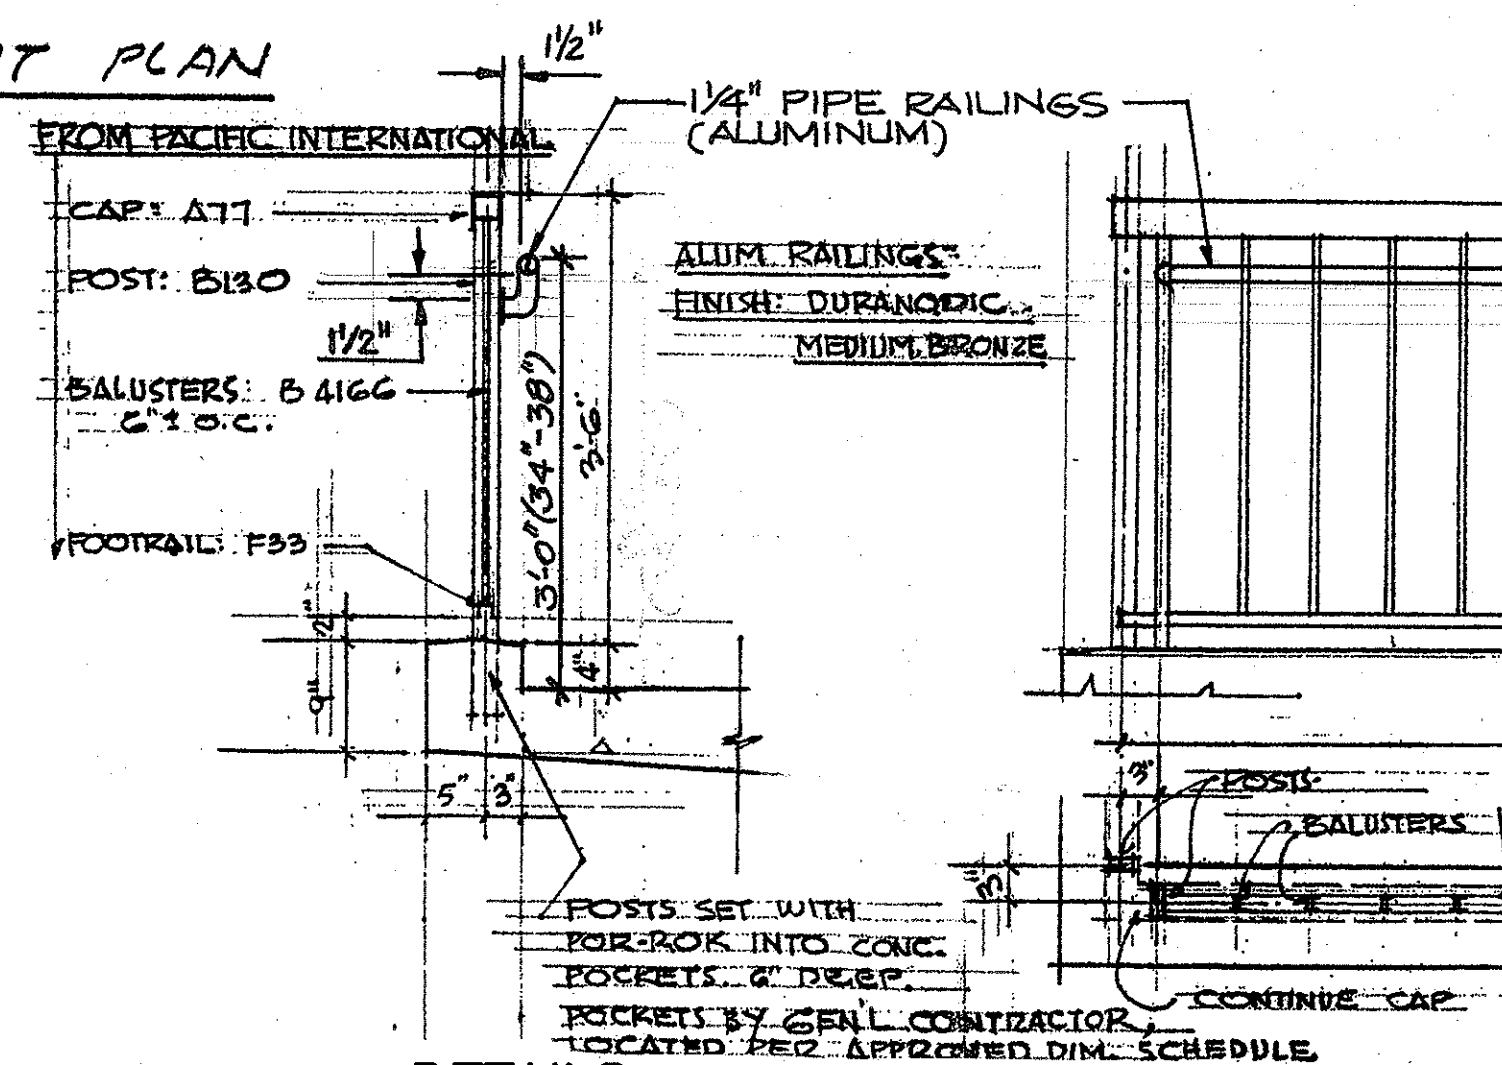

DETAILS
SCALE: NTS

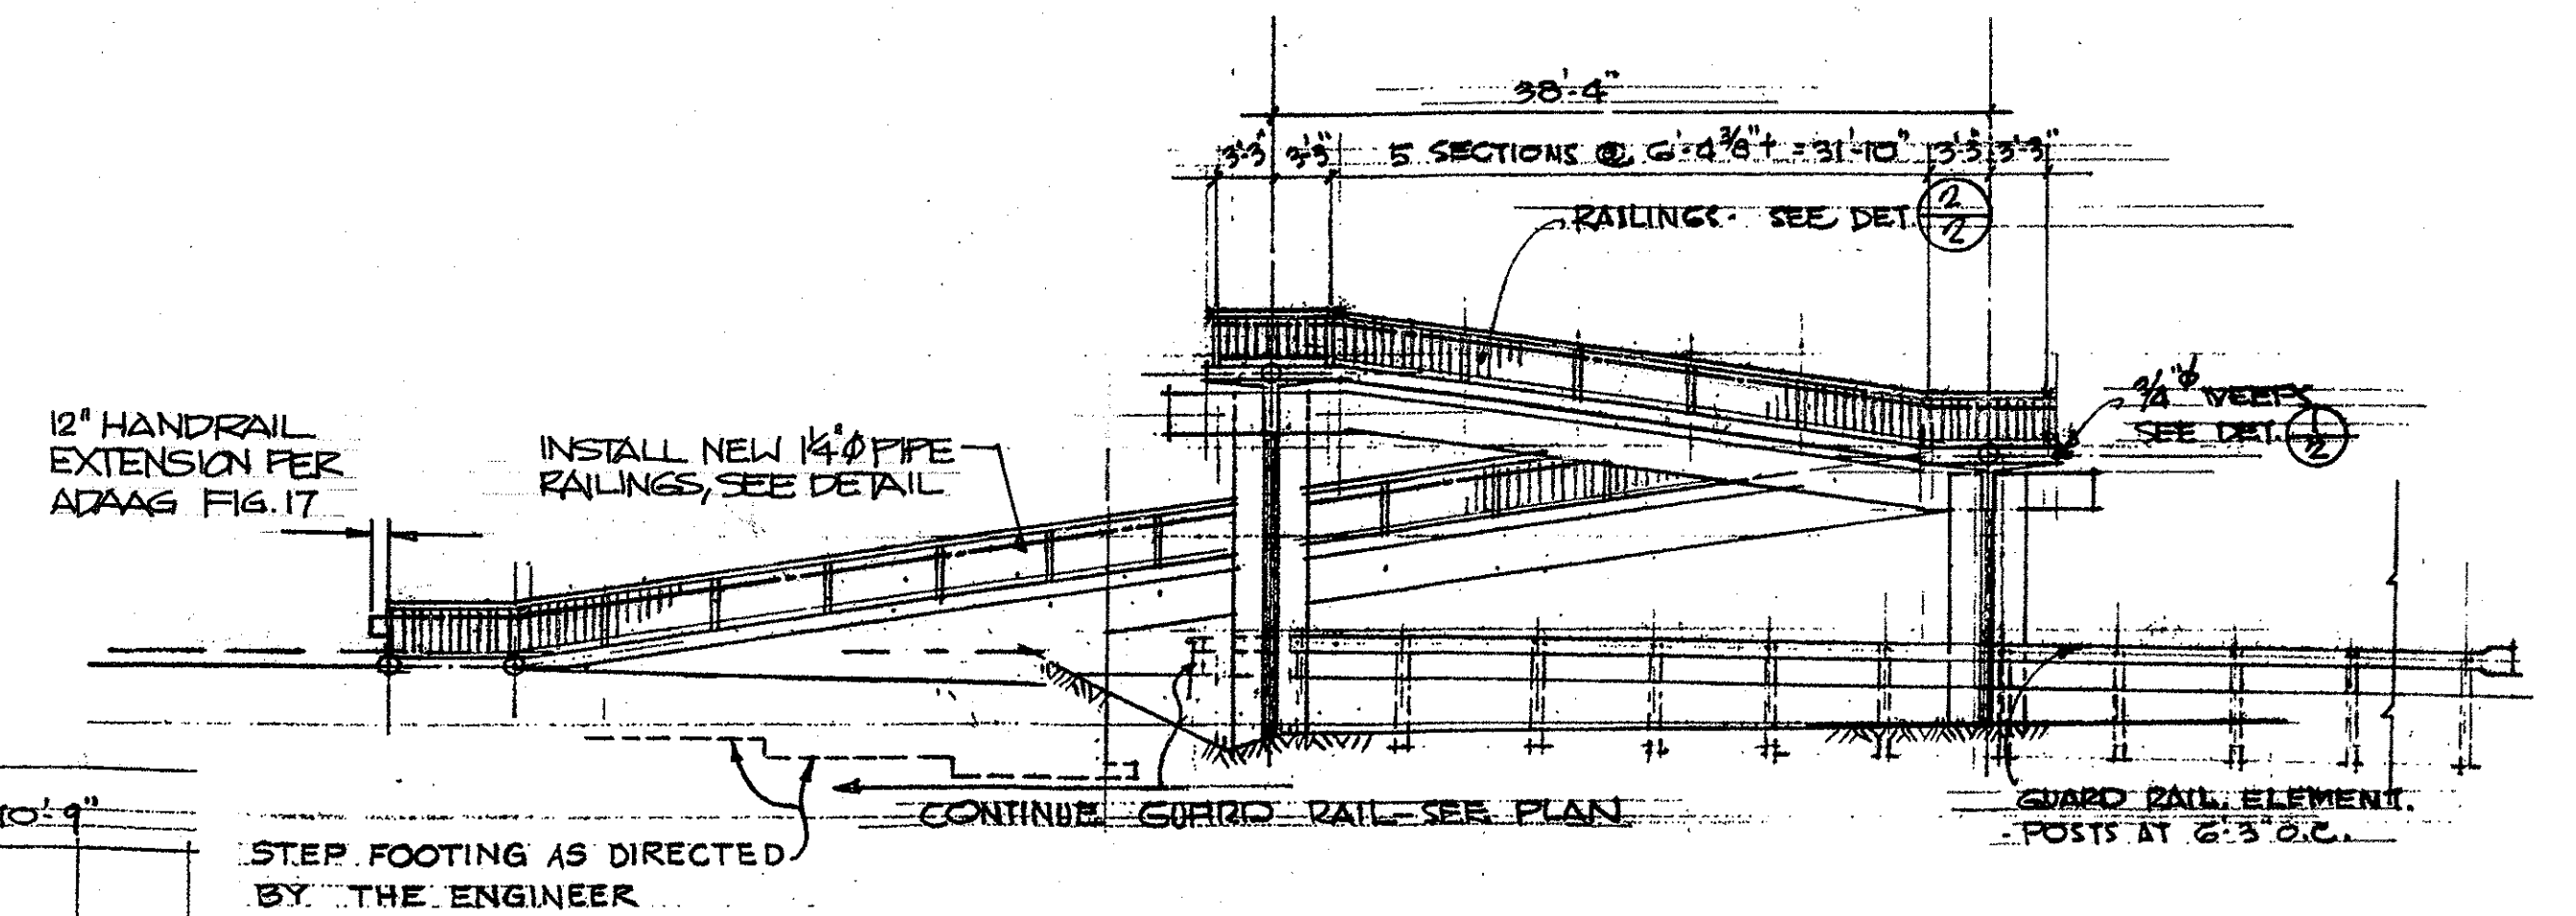

KAILUA ELEVATION
SCALE: 1"=10'

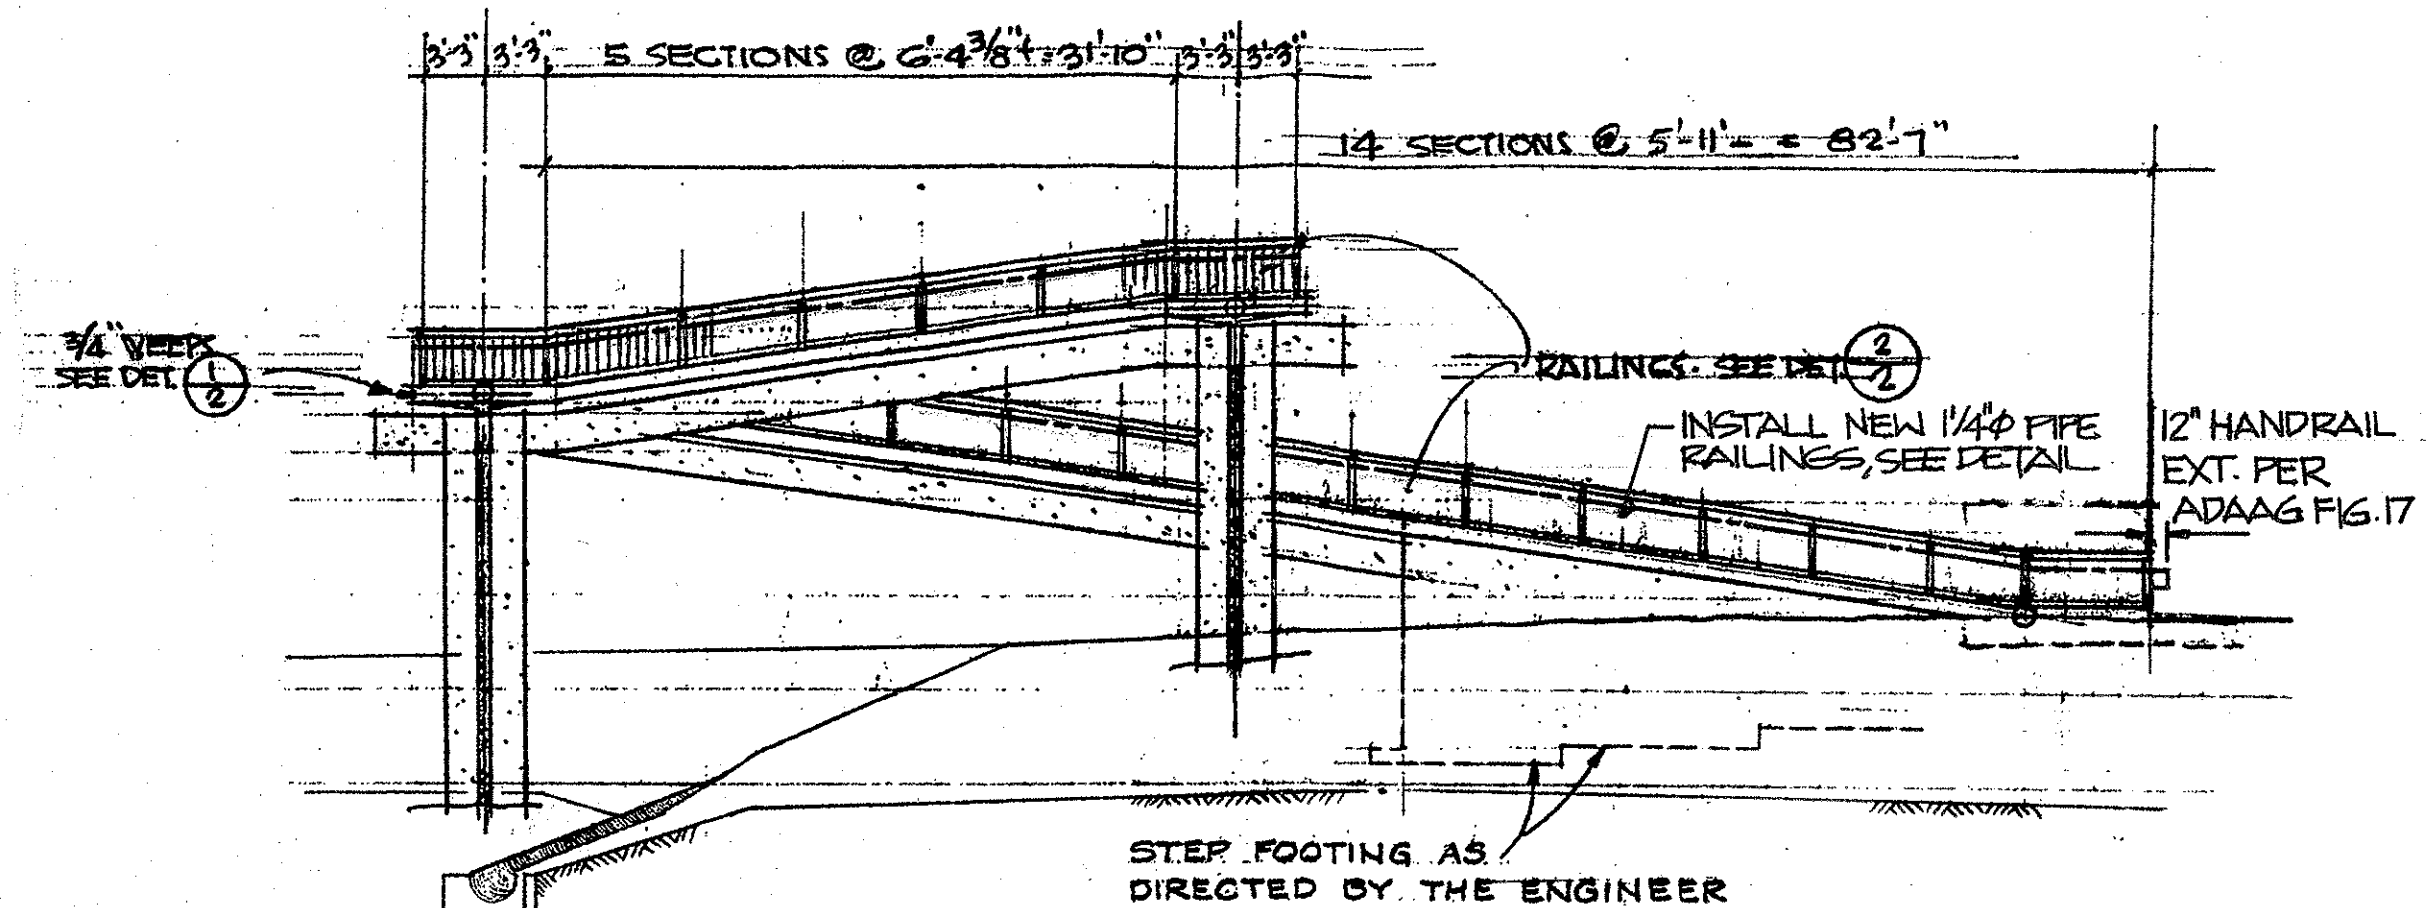

KANEOHE ELEVATION
SCALE: 1"=10'

DESIGNED BY	DATE
CHECKED BY	
NOTED BY	
QUANTITIES BY	
CHECKED BY	
NO.	

THIS WORK WAS PREPARED BY ME OR UNDER MY SUPERVISION AND CONSTRUCTION OF THIS PROJECT WILL BE UNDER MY OBSERVATION.


SIGNATURE _____ April 30, 2006
LIC. EXP. DATE _____
"OBSERVATION OF CONSTRUCTION" IS DEFINED IN CHAPTER 18-115, HAWAII ADMINISTRATIVE RULES ENTITLED "PROFESSIONAL ENGINEERS, ARCHITECTS, SURVEYORS AND LANDSCAPE ARCHITECTS".

STATE OF HAWAII
DEPARTMENT OF TRANSPORTATION
HIGHWAYS DIVISION
SITE PLAN
LIKELIKE HWY. AT ANOI ROAD
Pedestrian Facilities & ADA Compliance
at Various Locations on Oahu, Unit 1
Fed. Aid Proj. No. CMAQ-0300(92)
Scale: AS SHOWN Date: August 2004
SHEET No.C-155 OF 154 SHEETS


"AS-BUILT"

155S-1


FED. ROAD DIST. NO.	STATE	FED. AID PROJ. NO.	FISCAL YEAR	SHEET NO.	TOTAL SHEETS
HAWAII	HAW.	CMAQ-0300(92)	2004	155 S-2	187

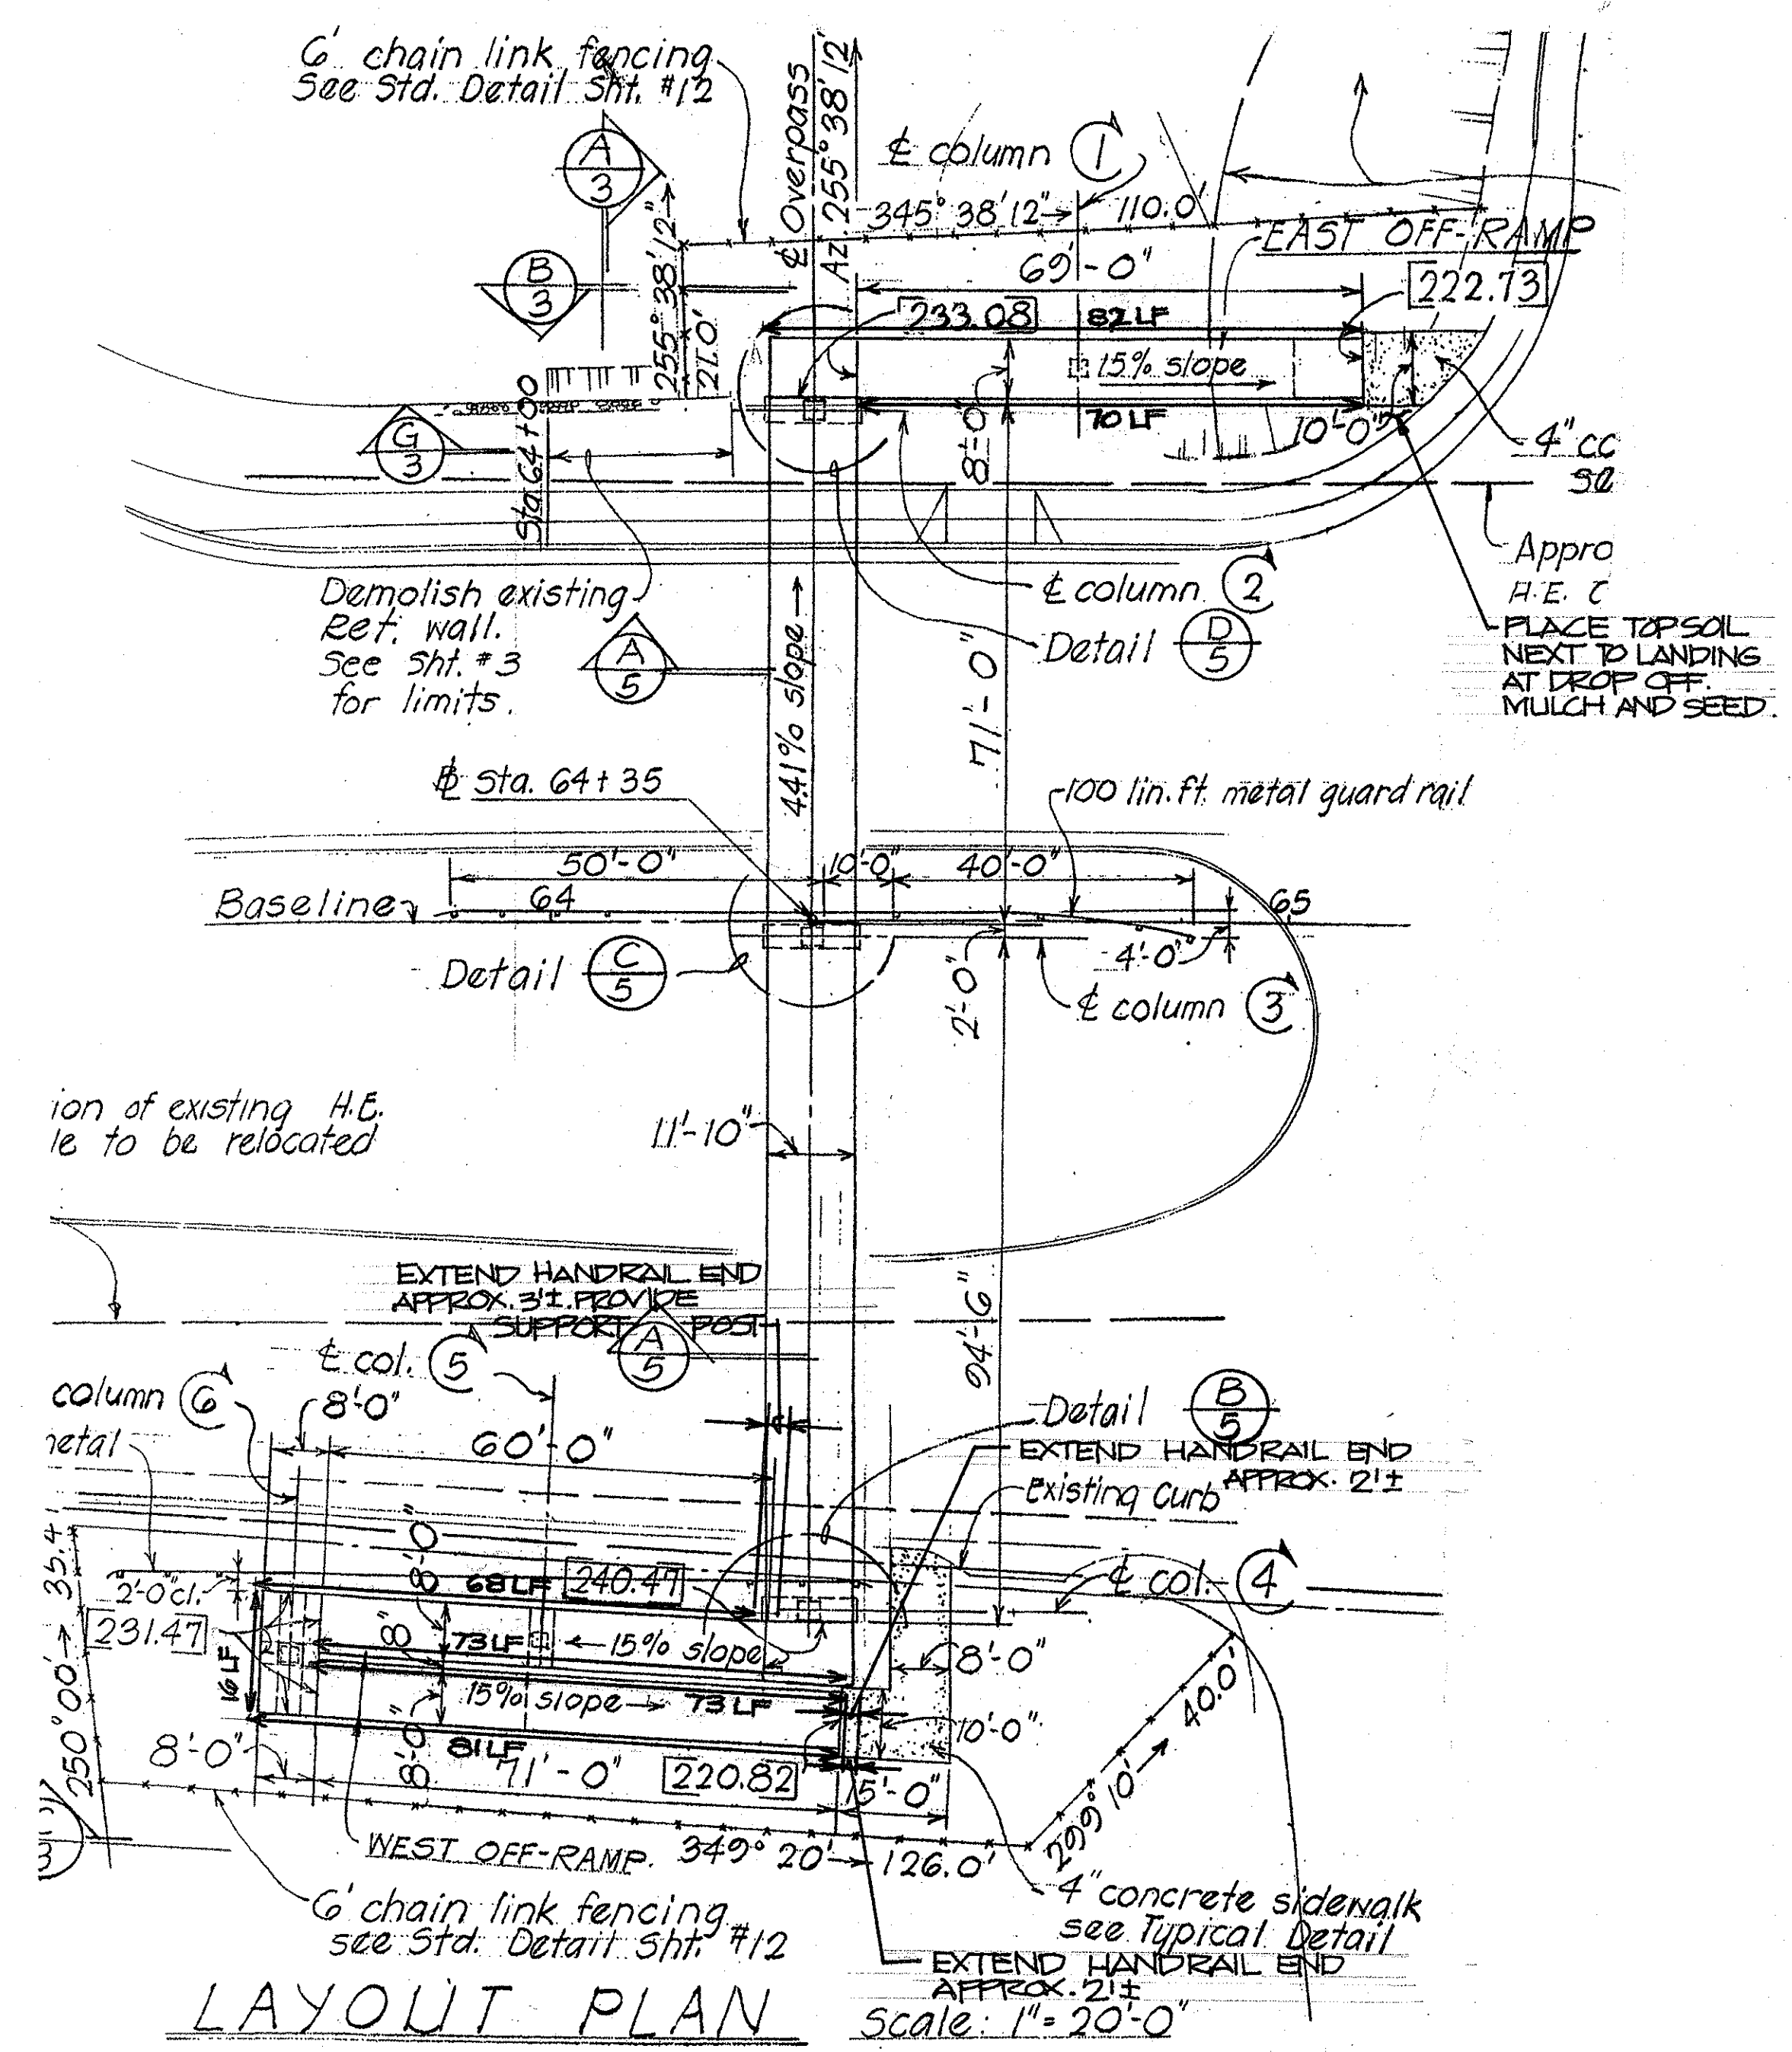


LAYOUT PLAN Scale: 1"=20'-0"

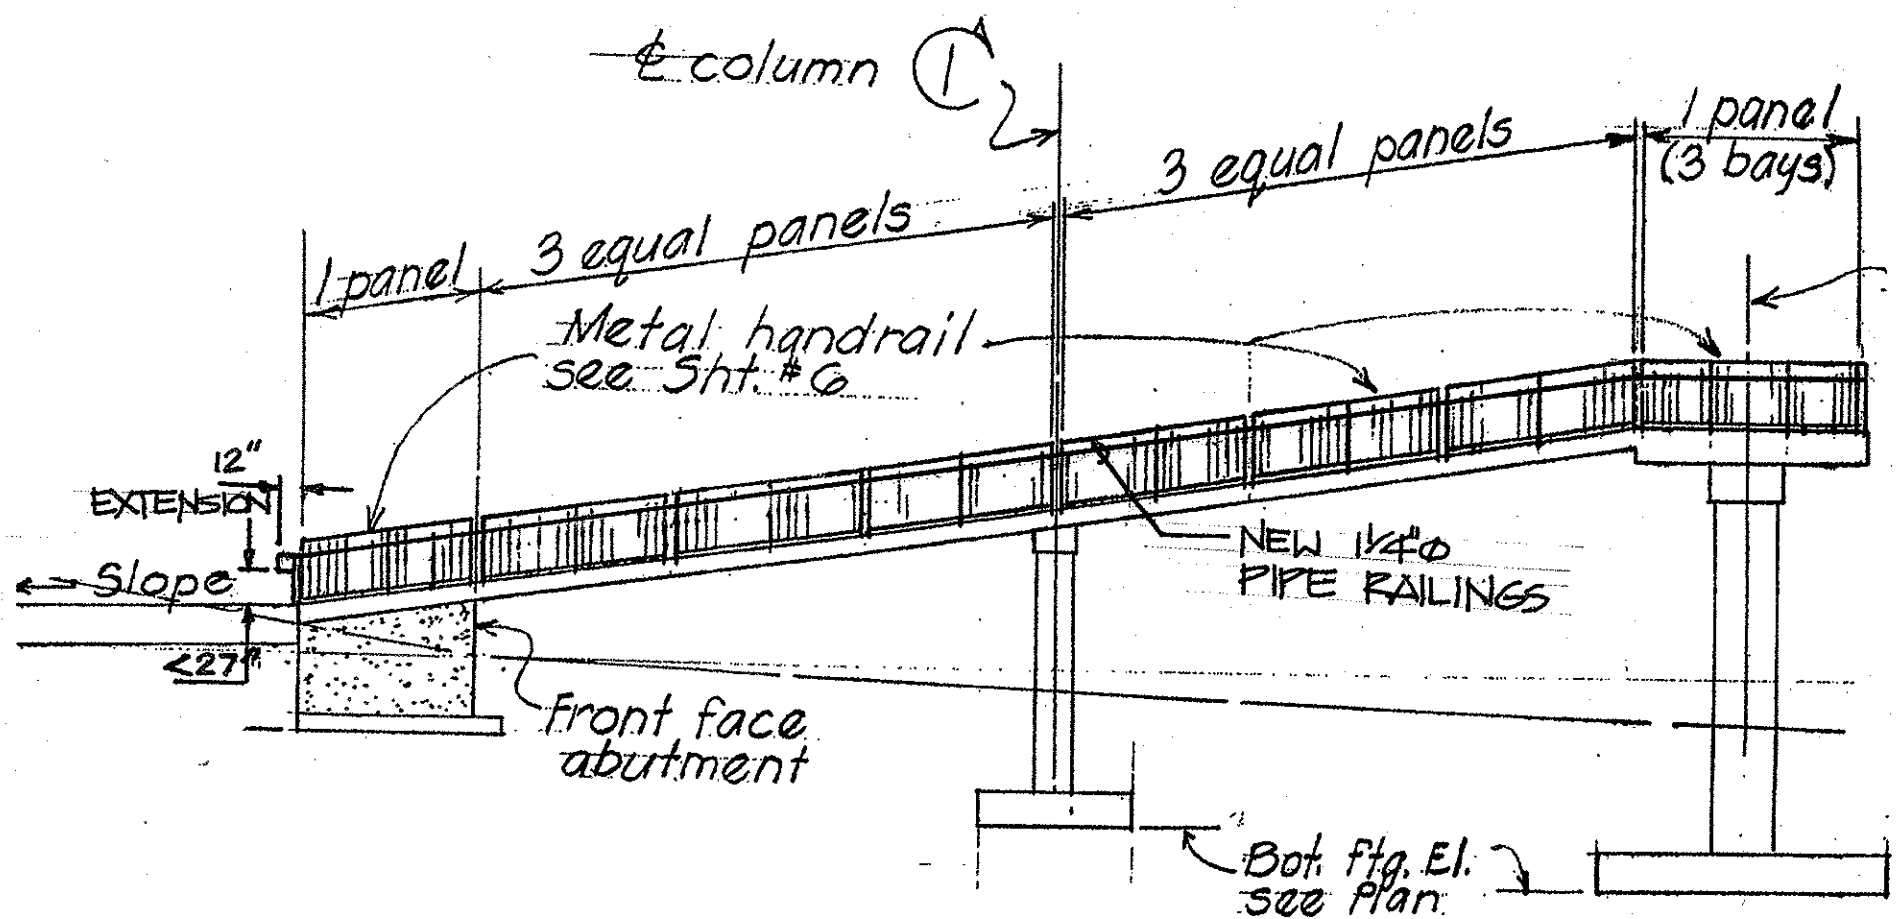

ELEVATION (B) Scale: 1"=10'-0"

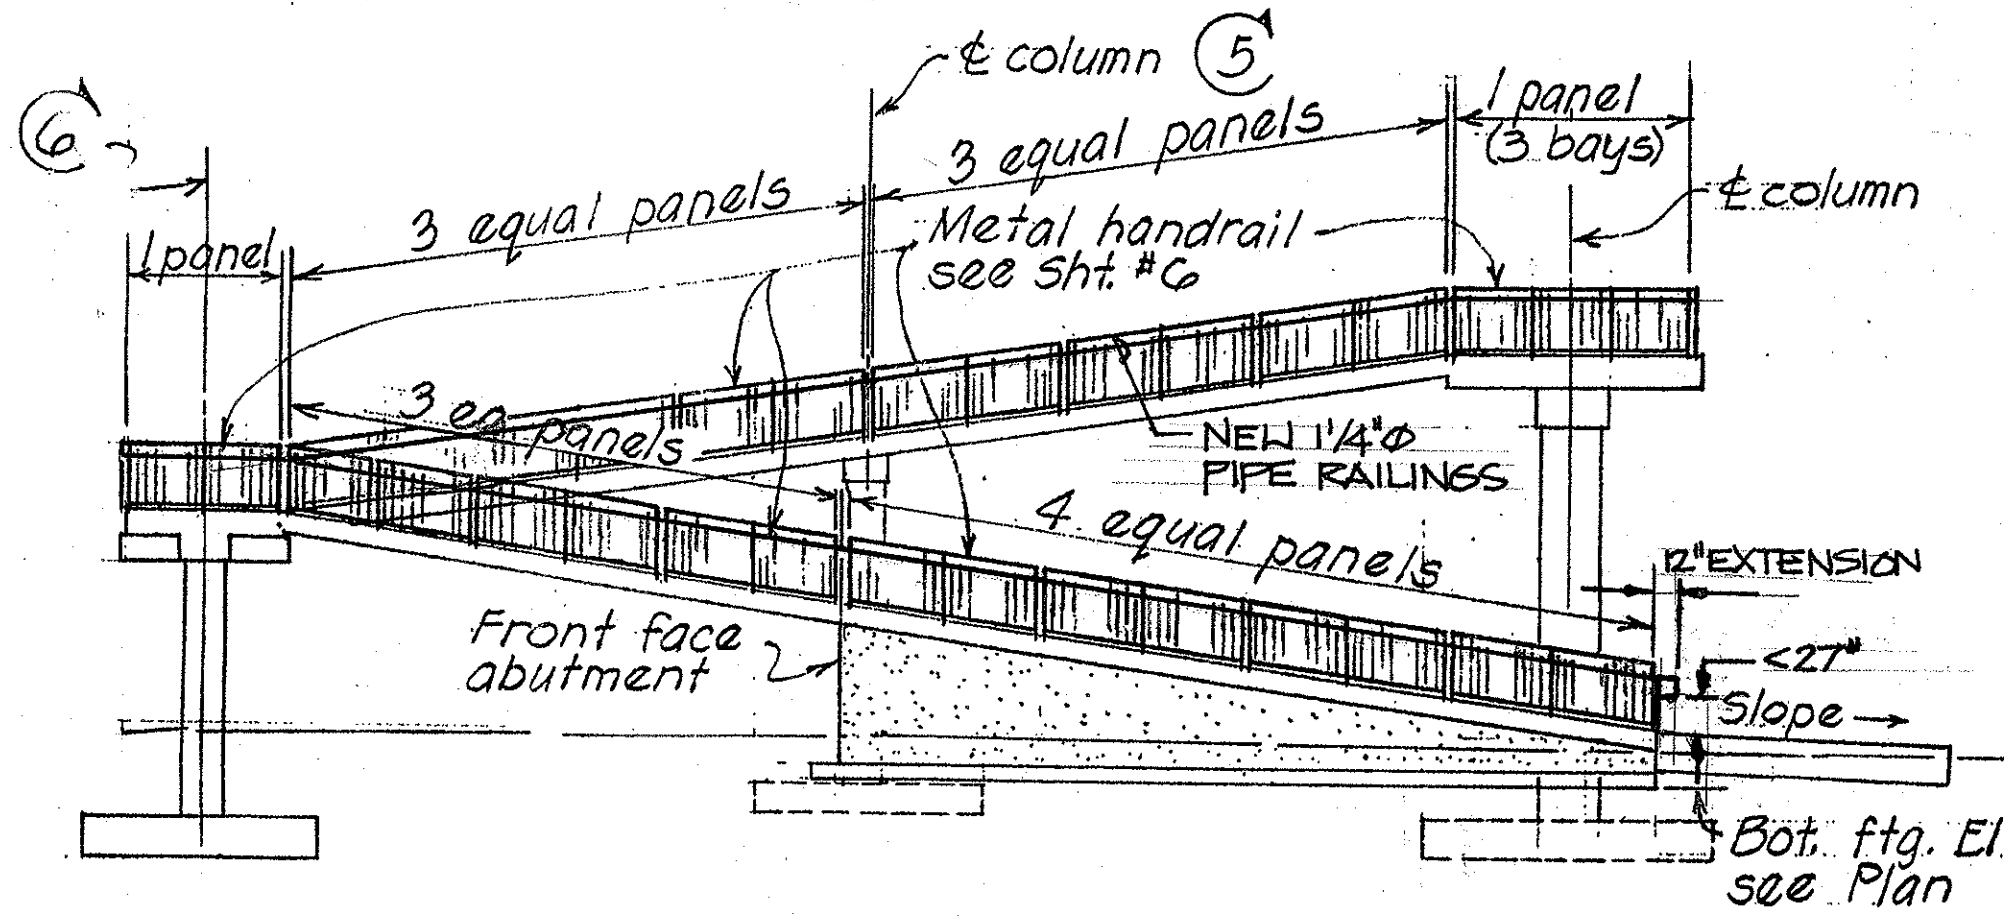

ELEVATION (C) Scale: 1"=10'-0"

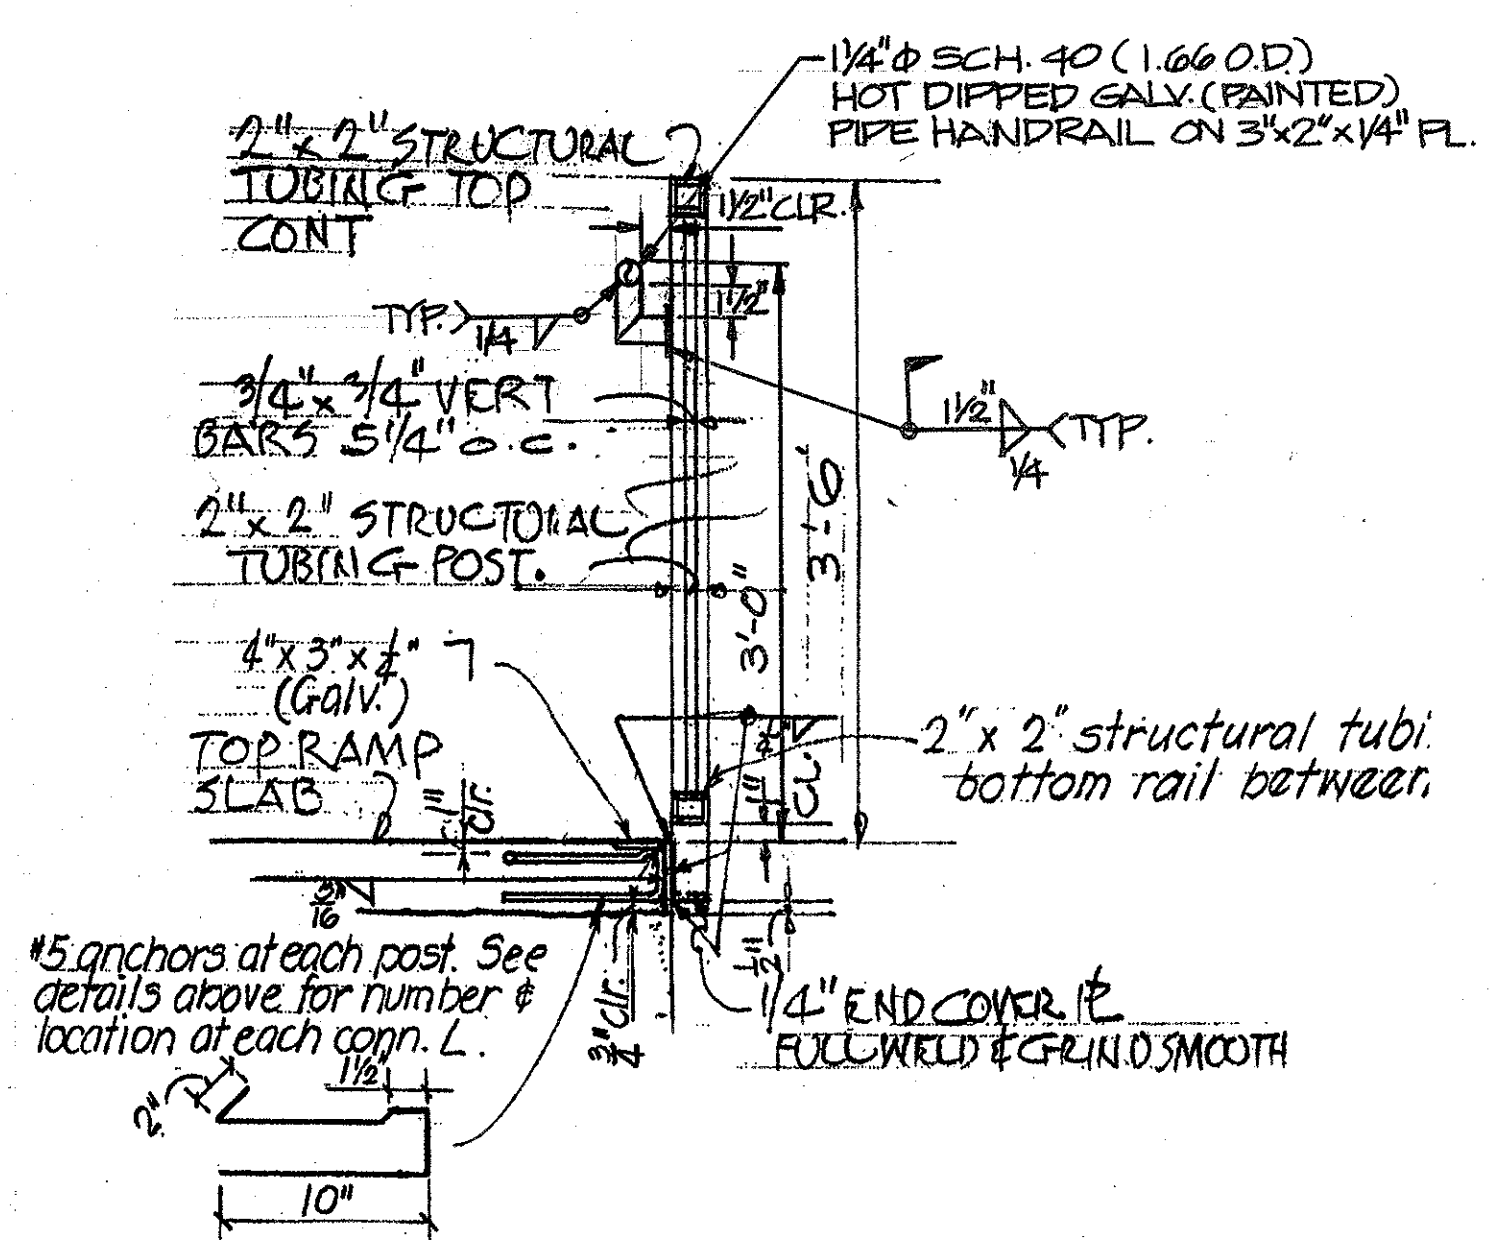

TYPICAL SECTION

ORIGINAL PLAN	DATE
DRAWN BY	
NOTED BY	
CHECKED BY	

SITE PLAN - KAMEHAMEHA HWY. BET. PUAHUULA PL. AND KUU HOME PL.
PEDSTRIAN OVERPASS
SCALE: AS SHOWN

THIS WORK WAS PREPARED BY ME OR UNDER MY SUPERVISION AND CONSTRUCTION OF THIS PROJECT WILL BE UNDER MY OBSERVATION.
SIGNATURE _____ DATE April 30, 2006
LIC. EXP. DATE _____
"OBSERVATION OF CONSTRUCTION" IS DEFINED IN CHAPTER 16-115, HAWAII ADMINISTRATIVE RULES ENTITLED "PROFESSIONAL ENGINEERS, ARCHITECTS, SURVEYORS AND LANDSCAPE ARCHITECTS."

STATE OF HAWAII
DEPARTMENT OF TRANSPORTATION
HIGHWAYS DIVISION
SITE PLAN
KAM. HWY. BET. PUAHUULA PL. & KUU HOME PL.
Pedestrian Facilities & ADA Compliance
at Various Locations on Oahu, Unit 1
Fed. Aid Proj. No. CMAQ-0300(92)
Scale: AS SHOWN
Date: August 2004
SHEET No.C-156 OF 154 SHEETS

155S-2

"AS-BUILT"

