INDEX TO DRAWINGS
DESCRIPTION
TITLE SHEET
DETAILED INDEX
STANDARD PLANS SUMMARY
NOTES
LOCATION PLANS
DETAILS
CIVIL PLANS (1)234567
TYPICAL TRAFFIC CONTROL PLANS
ELECTRICAL PLANS
ALA MOANA BLVD. & ALA MOANA
MALL INTERSECTION (DIAMOND HEAD)
CIVIL PLANS


Plan Sht. Nos. 0 C.O. 36, 2 C.O. 61 S-1, 3 C.O. 78, 4 C.O. 79, 5 C.O. 117, 6 121 S-1, and 7 121 S-2 are supplementary sheets to this project, added during Addendum & "AS-BUILT" posting.

TOTAL SHEET COUNT after Addendum 8 "AS-BUILT" posting is 178 sheets.


STATE OF HAWAII


DEPARTMENT OF TRANSPORTATION

HIGHWAYS DIVISION HONOLULU, HAWAII "AS-BUILT"

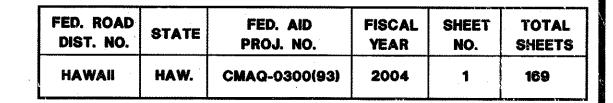



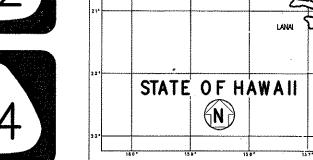

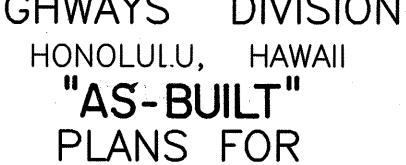

PEDESTRIAN FACILITIES AND ADA COMPLIANCE AT VARIOUS LOCATIONS ON OAHU, UNIT 2 FEDERAL AID PROJECT NO. CMAQ-0300(93)

DISTRICT OF HONOLULU ISLAND OF OAHU

PROJECTS SITES

- 1 Nimitz Hwy.; Route 92 Mile Post 1.00 TO Mile Post 6.50
- 2 Ala Moana Blvd.; Route 92 Mile Post <u>6.50</u> TO Mile Post <u>8.84</u>
- 3 Sand Island Access Road and Sand Island Parkway; Route 64 Mile Post <u>0.35</u> TO Mile Post <u>2.49</u>

400 Waimea 7 C Kaaawa Waikane Waiahole Makaha 7 1 Kahaluu Waianae Maili Nanakuli Waimanalo HONOLULU Ewa LSand Island Koko Head Diamond Head

FEDERAL AID INTERSTATE PROJECTS PREVIOUSLY CONSTRUCTED OR UNDER CONSTRUCTION

CHANGES MADE DURING CONSTRUCTION HAVE BEEN INCORPORATED ON THESE PLANS EXCEPT CHANGES IN THE ORIGINAL THEORETICAL QUANTITIES. FOR ACTUAL QUANTITIES, REFER TO PROJECT LEDGER AND / OR COMPUTATION BOOK.


RESIDENT ENGINEER

11-08-2007 DATE

DEPARTMENT OF TRANSPORTATION STATE OF HAWAII APPROVED:

When Man 7-30-04 **✓DIR. OF TRANSPORTATION**

117

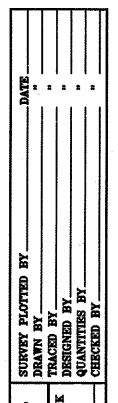

TOWILL (