
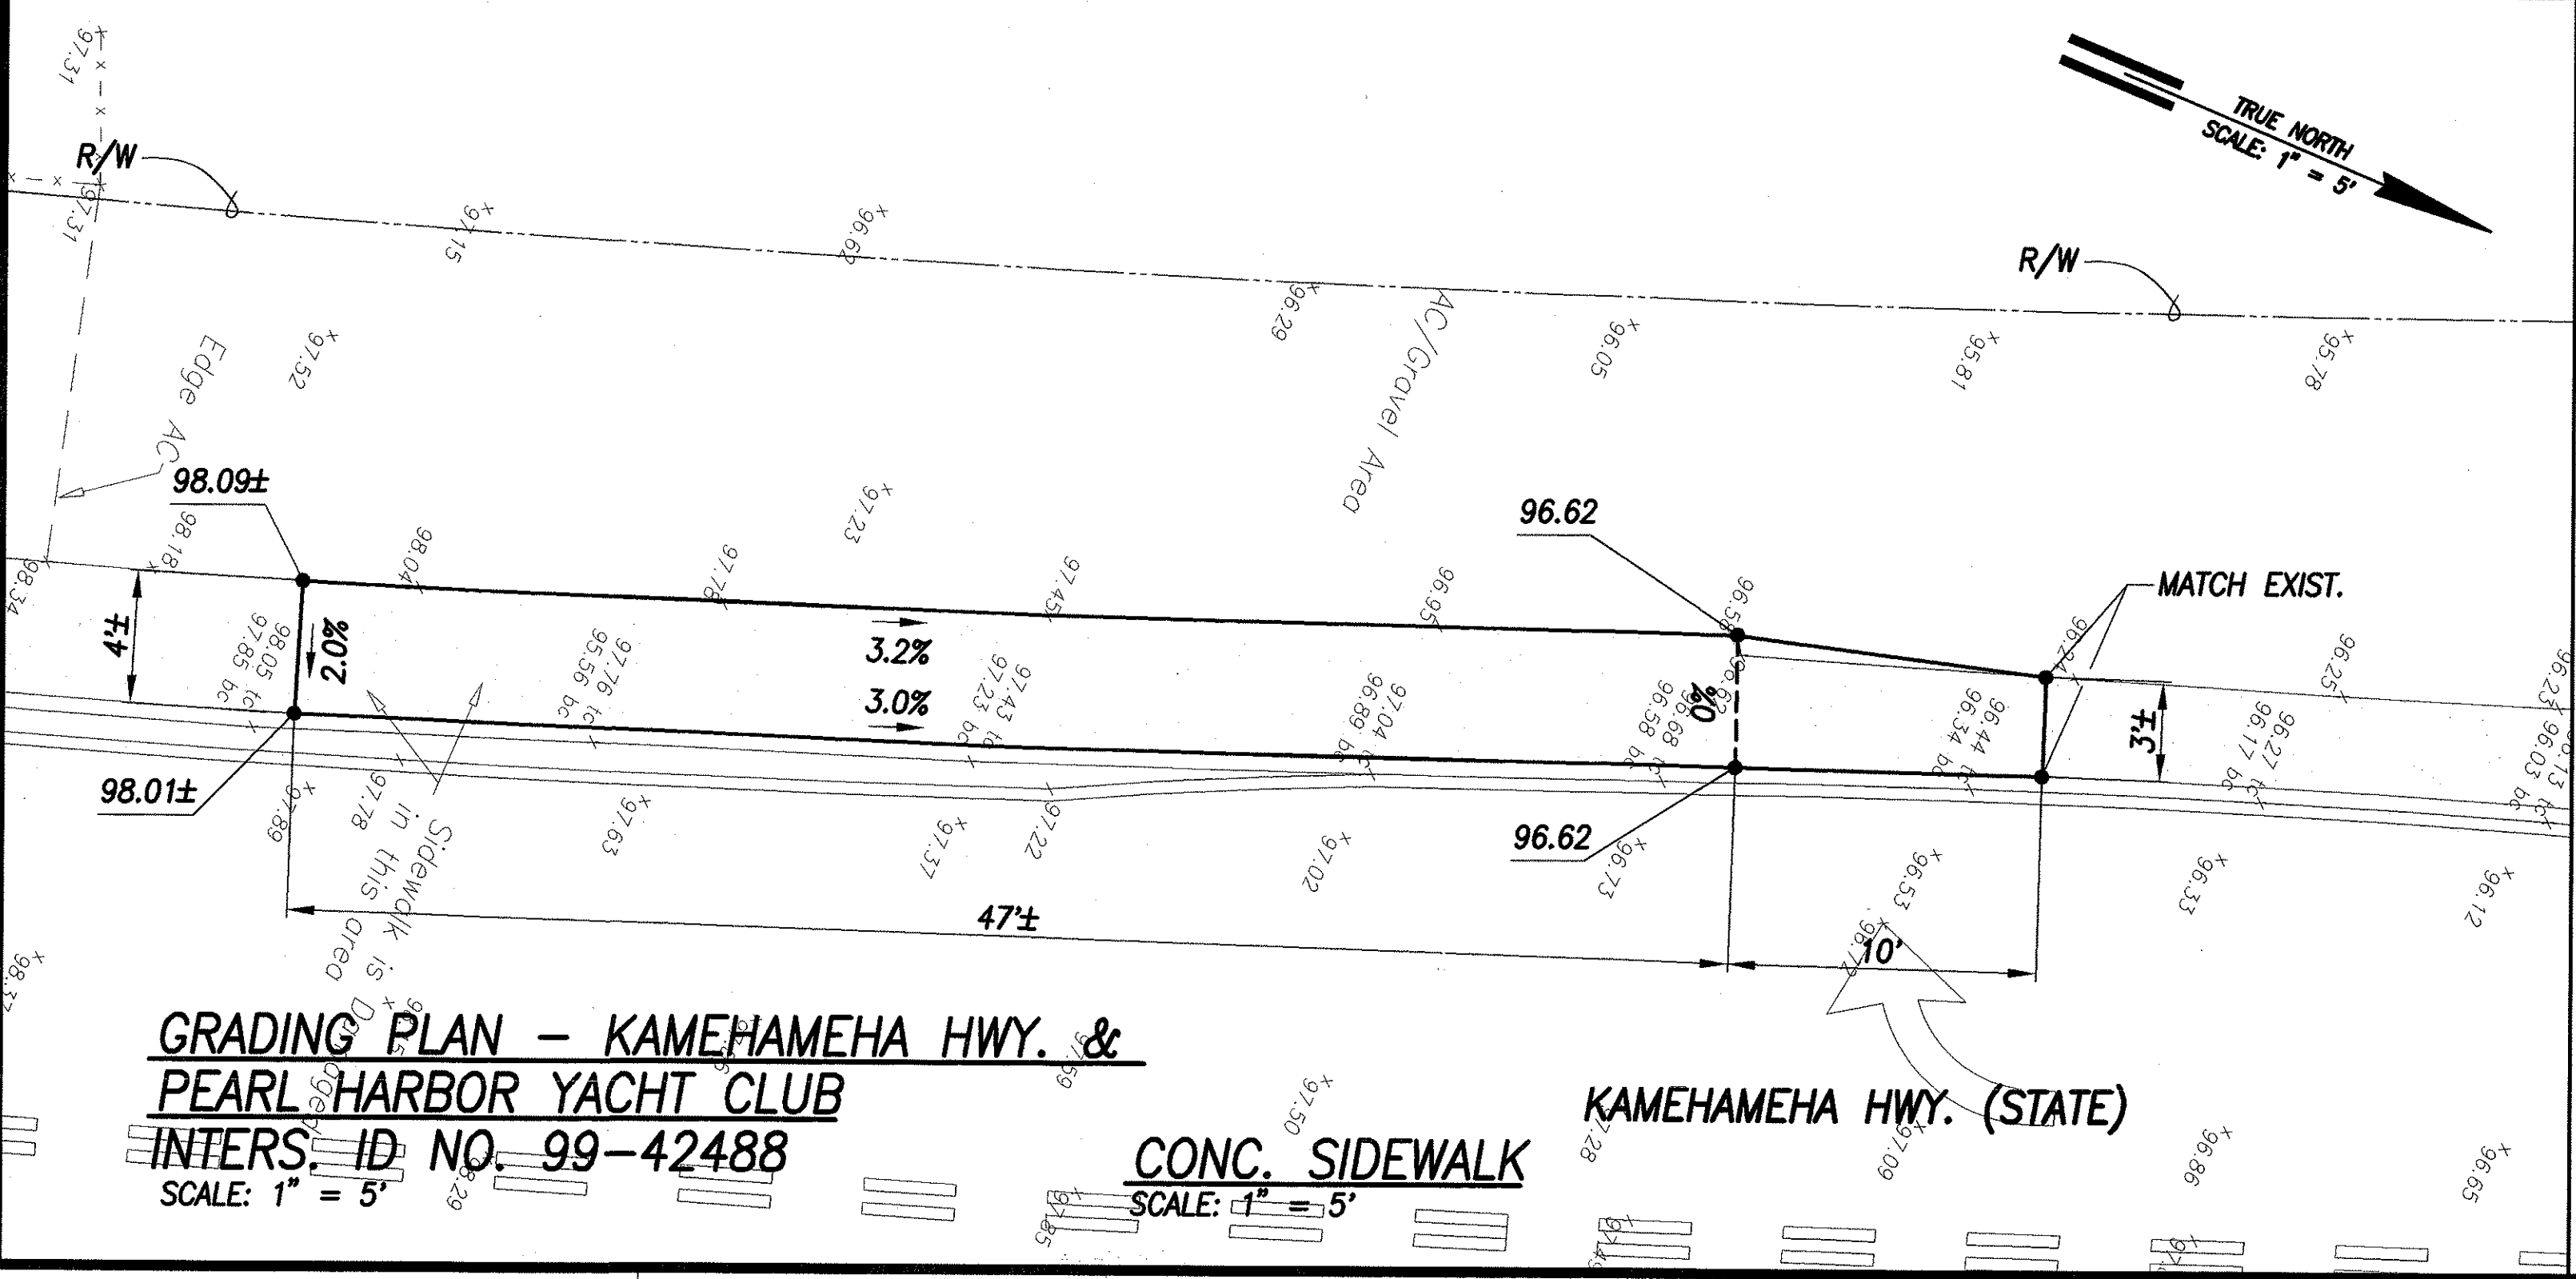



FED. ROAD DIST. NO.	STATE	FED. AID PROJ. NO.	FISCAL YEAR	SHEET NO.	TOTAL SHEETS
HAWAII	HAW.	CMAQ-0300(96)	2004	32	153

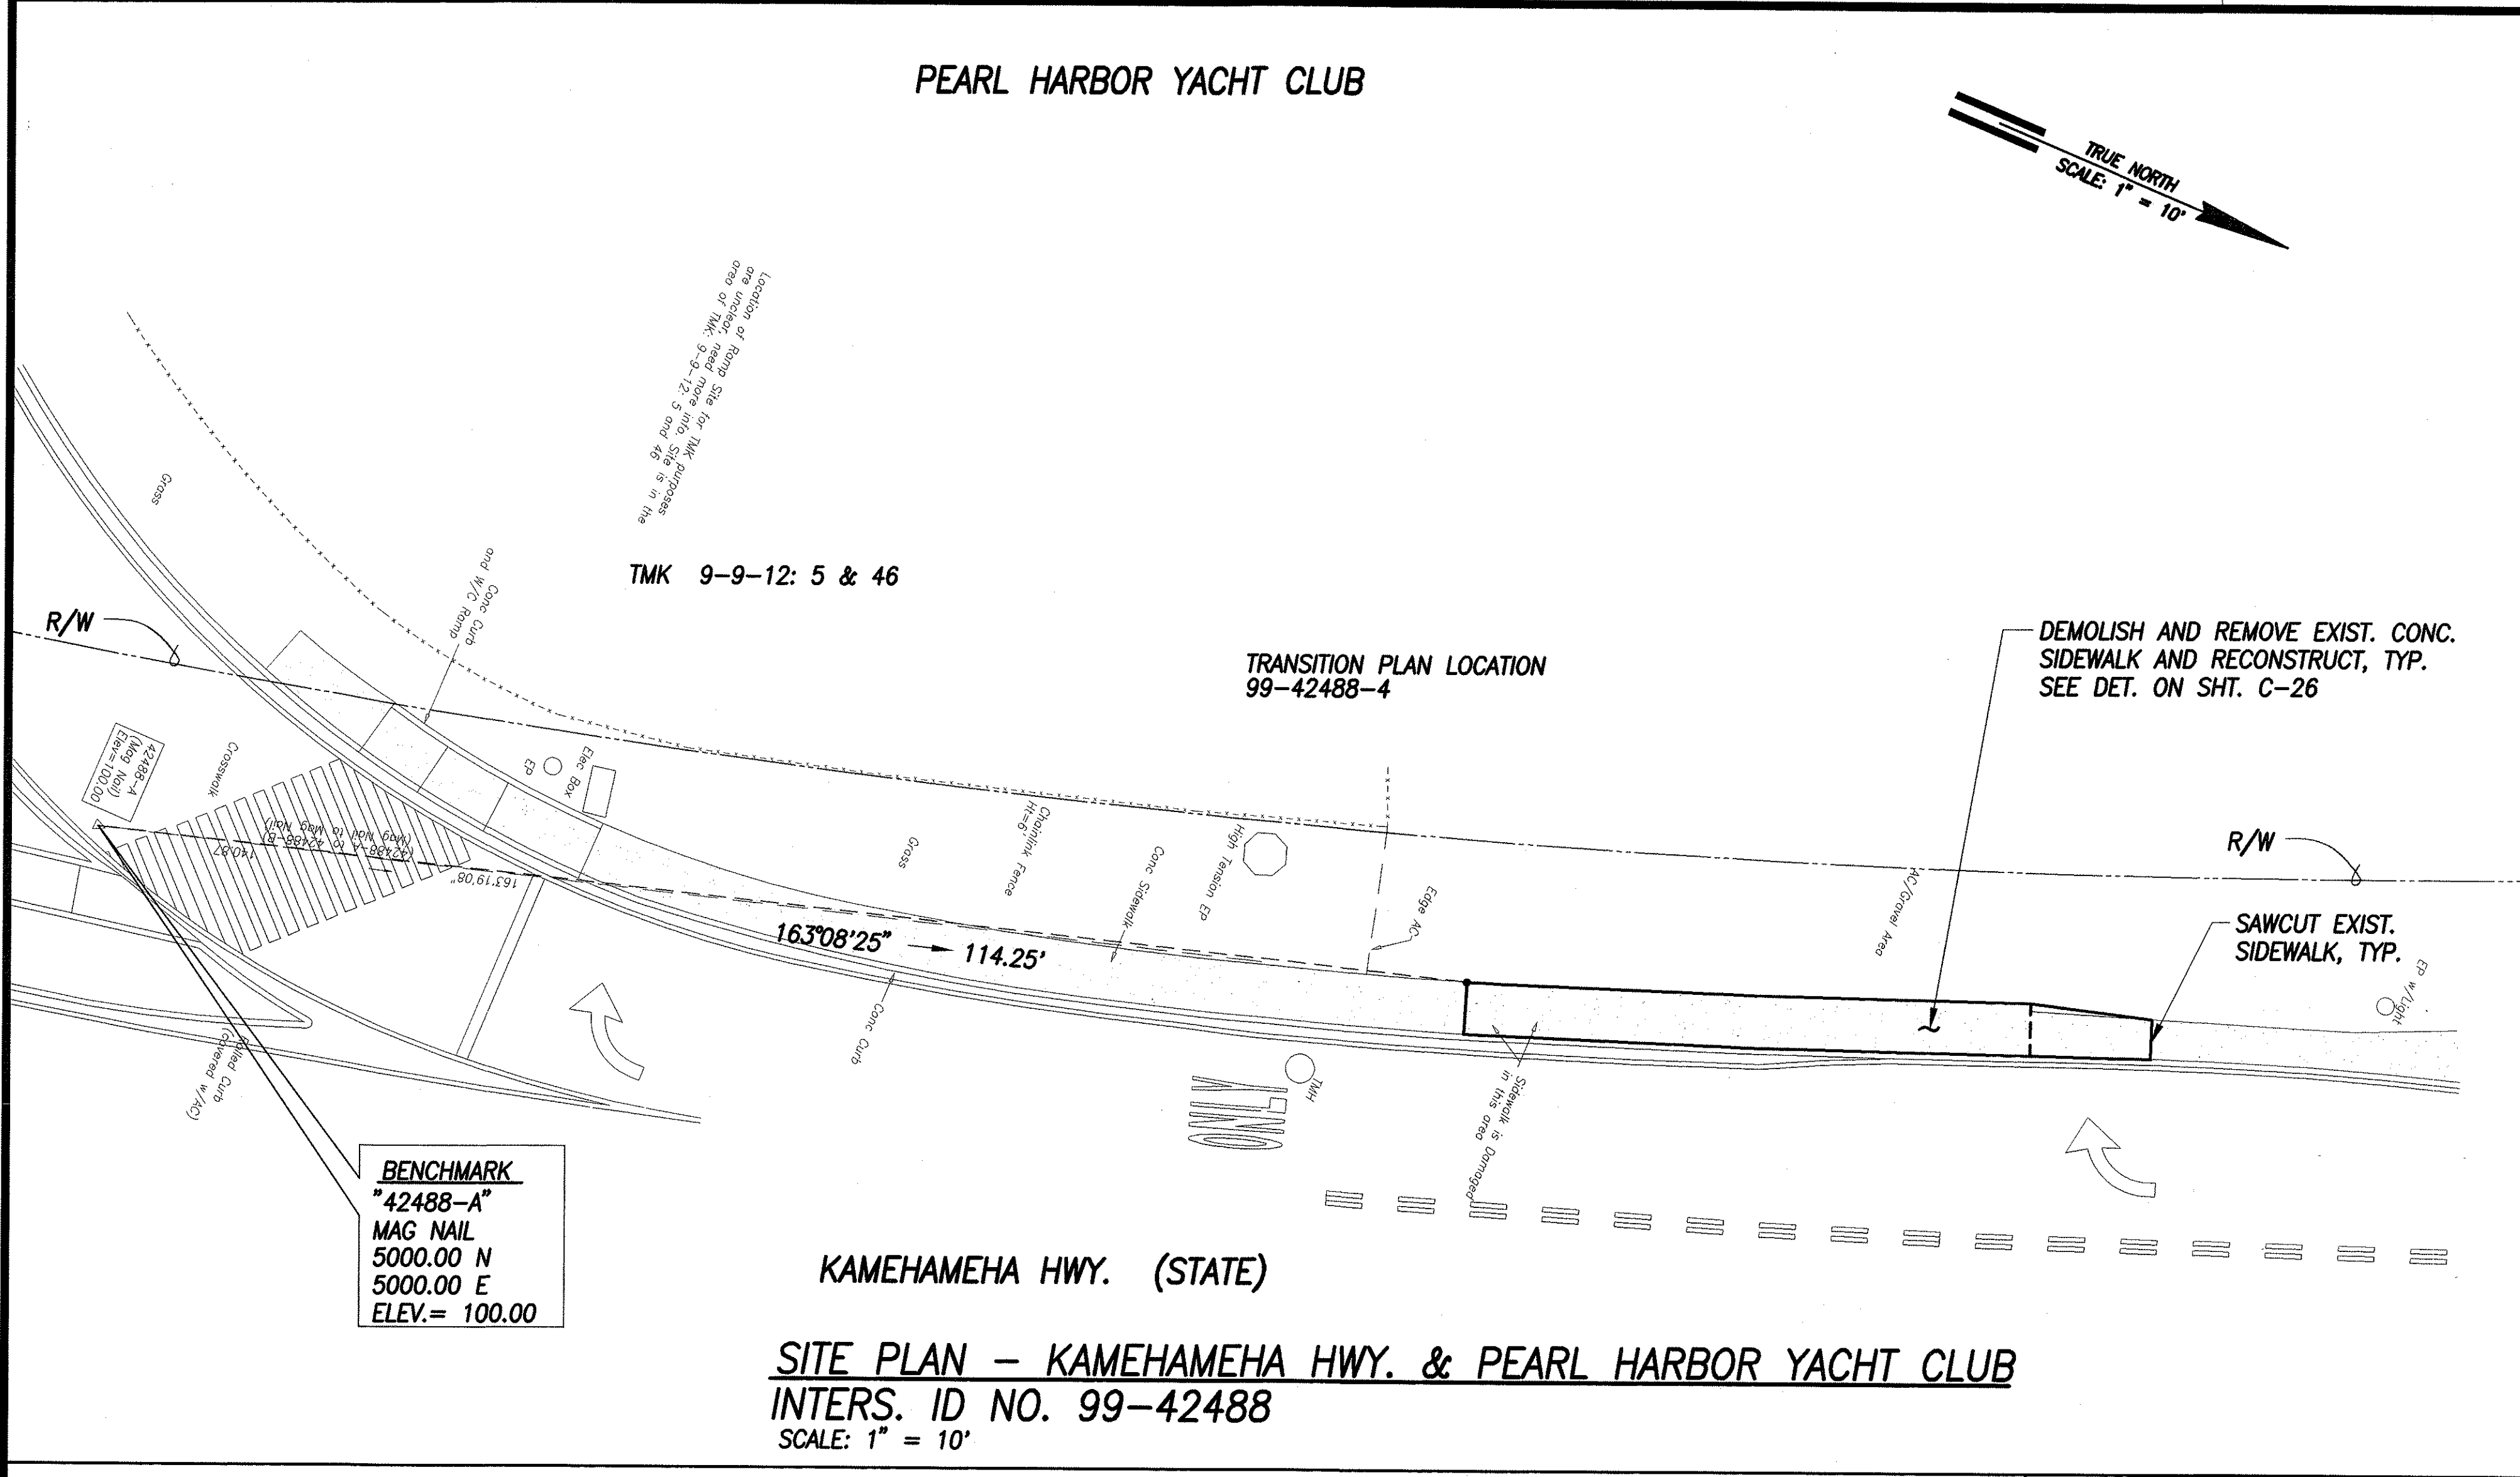

LEGEND

- x 49.52 EXIST. SPOT ELEVATION
- 52.58 FINISHED SPOT GRADE
- 51.50 TC FINISHED TOP OF CURB
- 51.00 BC FINISHED BOTTOM OF CURB

DATE	11/14/04
SURVEY PLOTTED BY	11/14/04
DRAWN BY	11/14/04
DESIGNED BY	11/14/04
QUANTITIES BY	11/14/04
CHECKED BY	11/14/04
ORIGINAL PLAN	11/14/04
NOTE BOOK	11/14/04

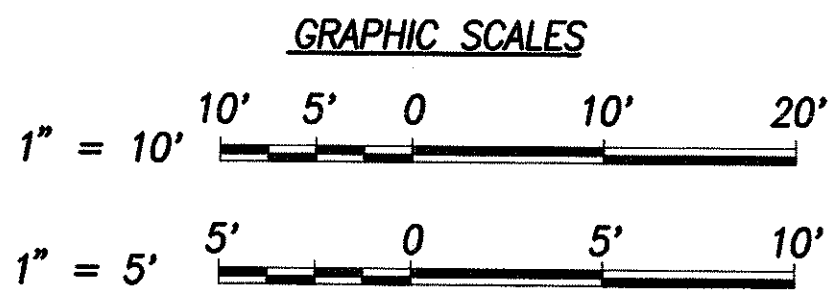

THIS WORK WAS PREPARED BY ME OR UNDER MY SUPERVISION AND CONSTRUCTION OF THIS PROJECT WILL BE UNDER MY OBSERVATION.

SIGNATURE: *Greg H. Hiyakumoto* DATE: April 30, 2006

"OBSERVATION OF CONSTRUCTION" IS DEFINED IN CHAPTER 16-115, HAWAII ADMINISTRATIVE RULES ENTITLED "PROFESSIONAL ENGINEERS, ARCHITECTS, SURVEYORS AND LANDSCAPE ARCHITECTS".

STATE OF HAWAII
DEPARTMENT OF TRANSPORTATION
HIGHWAYS DIVISION

SITE & GRADING PLAN - KAMEHAMEHA HWY. & PEARL HARBOR YACHT CLUB



Pedestrian Facilities & ADA Compliance at Various Locations on Oahu, Unit 5

Fed. Aid Proj. No. CMAQ-0300(96)


Scale: AS SHOWN Date: August 2004

SHEET No. C-31 OF 153 SHEETS

FED. ROAD DIST. NO.	STATE	FED. AID PROJ. NO.	FISCAL YEAR	SHEET NO.	TOTAL SHEETS
HAWAII	HAW.	CMAQ-0300(96)	2004	34	153

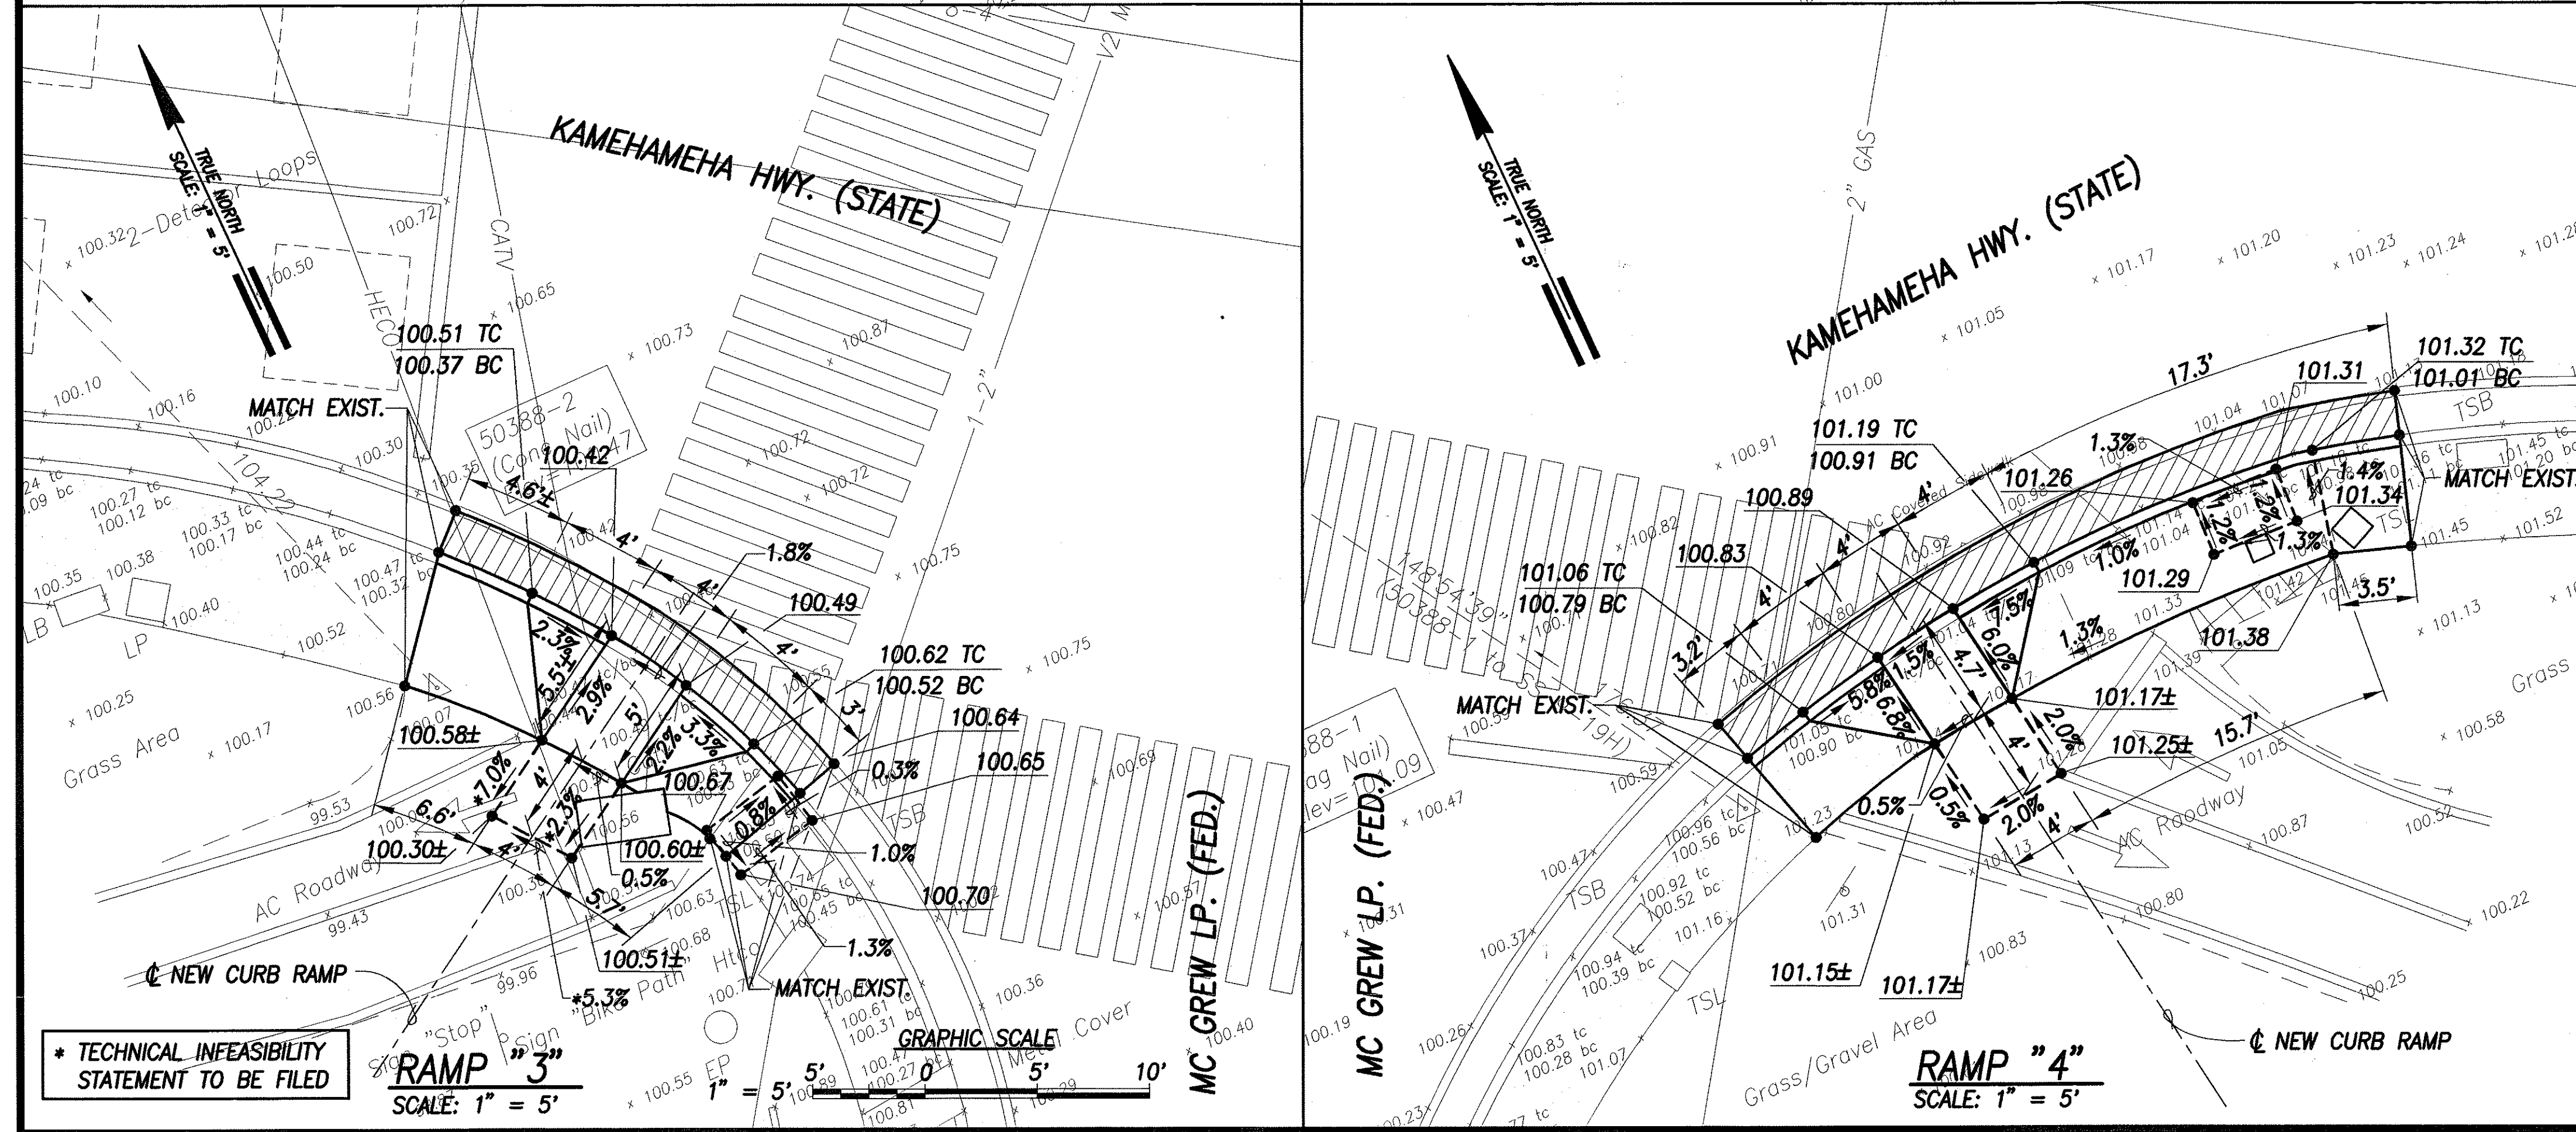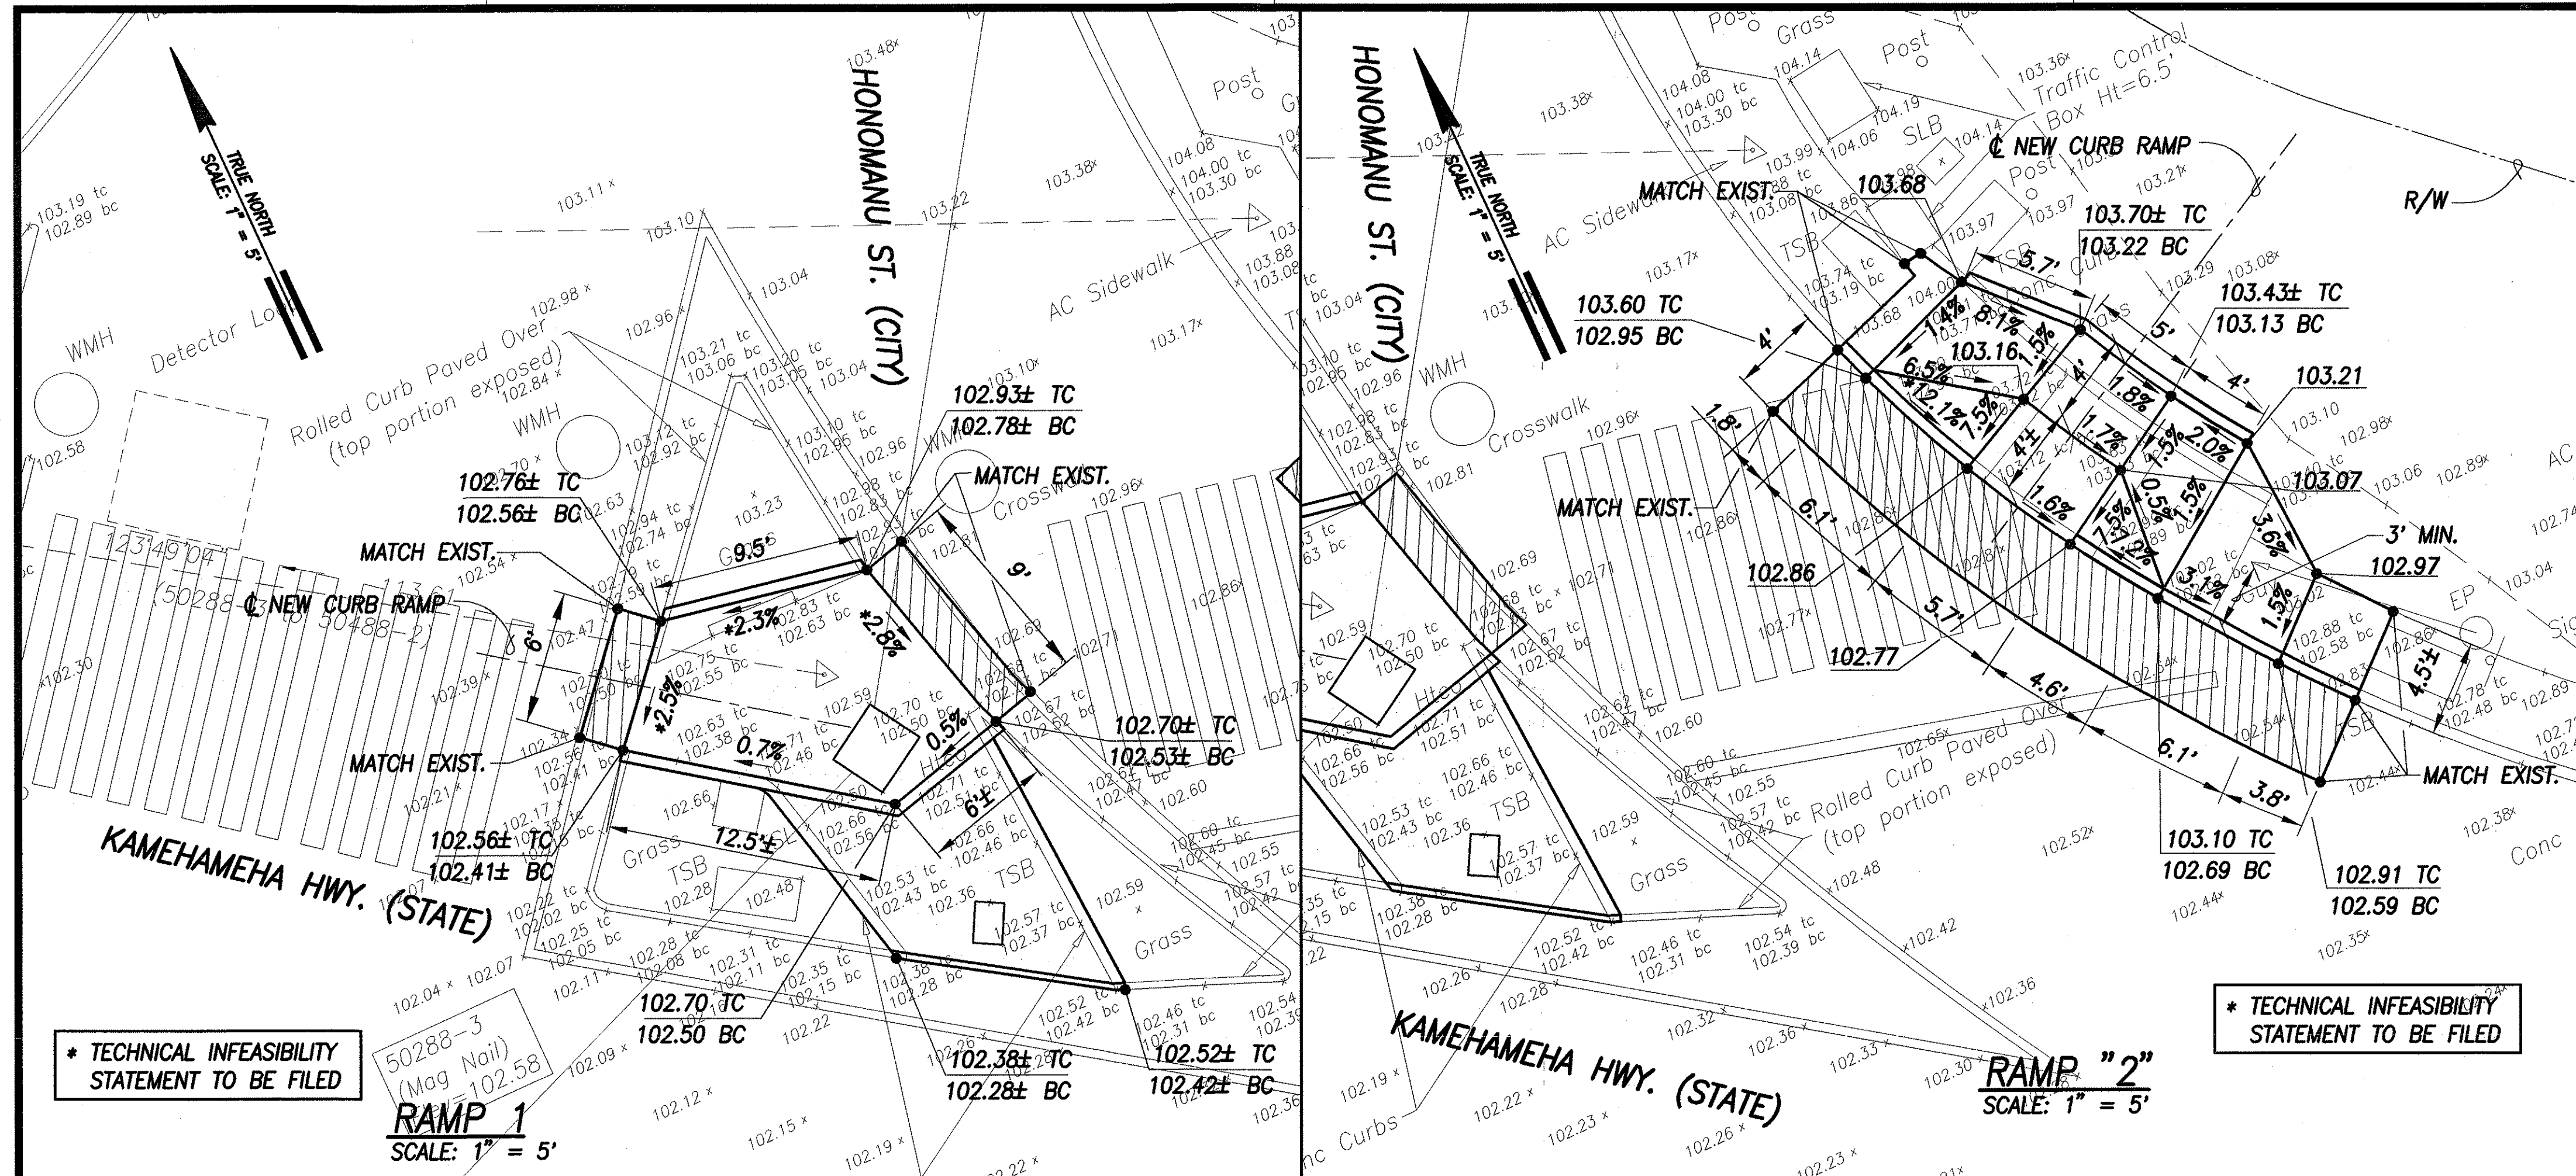

**GRADING PLAN - KAMEHAMEHA HWY.,
HONOMANU ST. & MC GREW LP.
INTERS. ID NO. 99-50288 & 99-50388
SCALE: 1" = 5'**

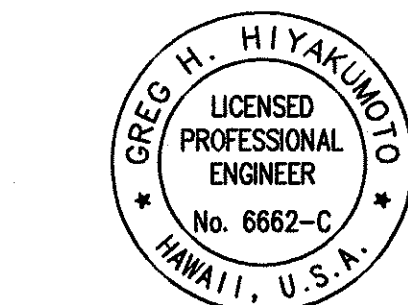

THIS WORK WAS PREPARED BY ME OR UNDER MY SUPERVISION AND CONSTRUCTION OF THIS PROJECT WILL BE UNDER MY OBSERVATION.

DATE: April 30, 2006
SIGNATURE: [Signature]
"OBSERVATION OF CONSTRUCTION" IS DEFINED IN CHAPTER 16-115, HAWAII ADMINISTRATIVE RULES ENTITLED "PROFESSIONAL ENGINEERS, ARCHITECTS, SURVEYORS AND LANDSCAPE ARCHITECTS."

**STATE OF HAWAII
DEPARTMENT OF TRANSPORTATION
HIGHWAYS DIVISION**

GRADING PLAN - KAMEHAMEHA HWY., HONOMANU ST. & MC GREW LP.


Pedestrian Facilities & ADA Compliance at Various Locations on Oahu, Unit 5

Fed. Aid Proj. No. CMAQ-0300(96)




Scale: 1" = 5'-0" Date: August, 2004

SHEET No. C-33 OF 153 SHEETS

FED. ROAD DIST. NO.	STATE	FED. AID PROJ. NO.	FISCAL YEAR	SHEET NO.	TOTAL SHEETS
HAWAII	HAW.	CMAQ-0300(96)	2004	C.O. 35	153

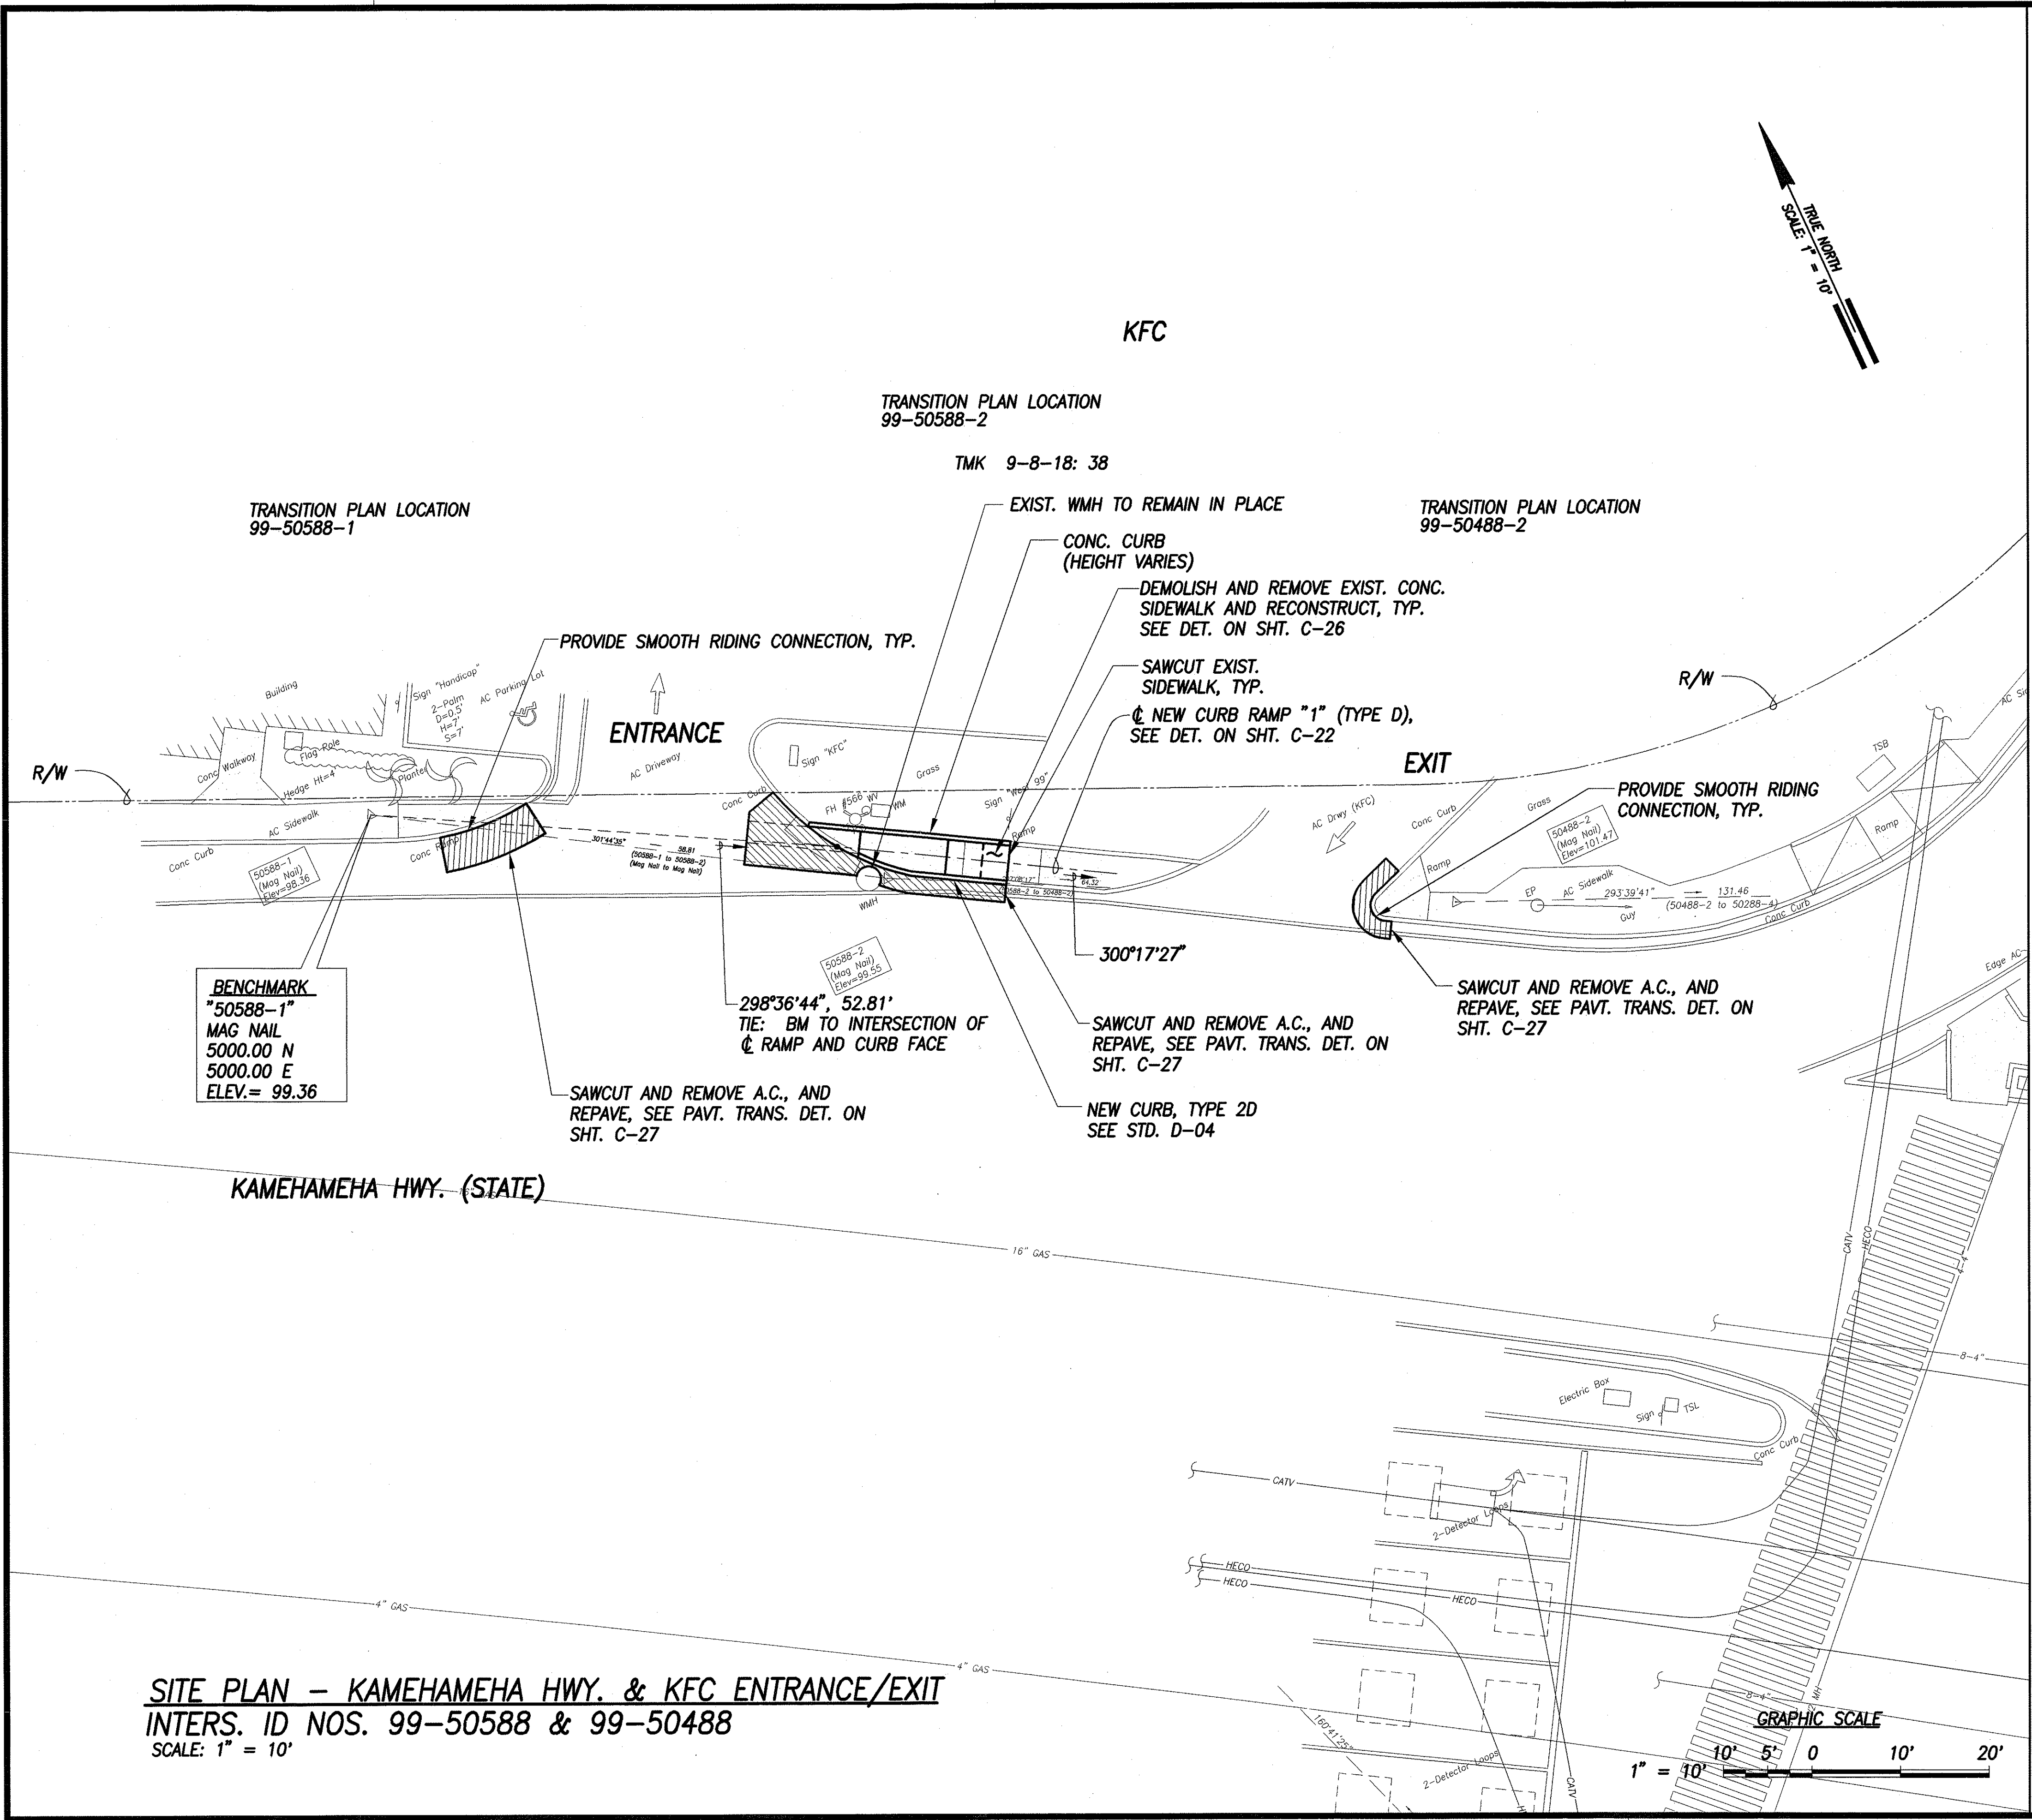


FED. ROAD DIST. NO.	STATE	FED. AID PROJ. NO.	FISCAL YEAR	SHEET NO.	TOTAL SHEETS
HAWAII	HAW.	CMAQ-0300(96)	2004	C.O. 36	153

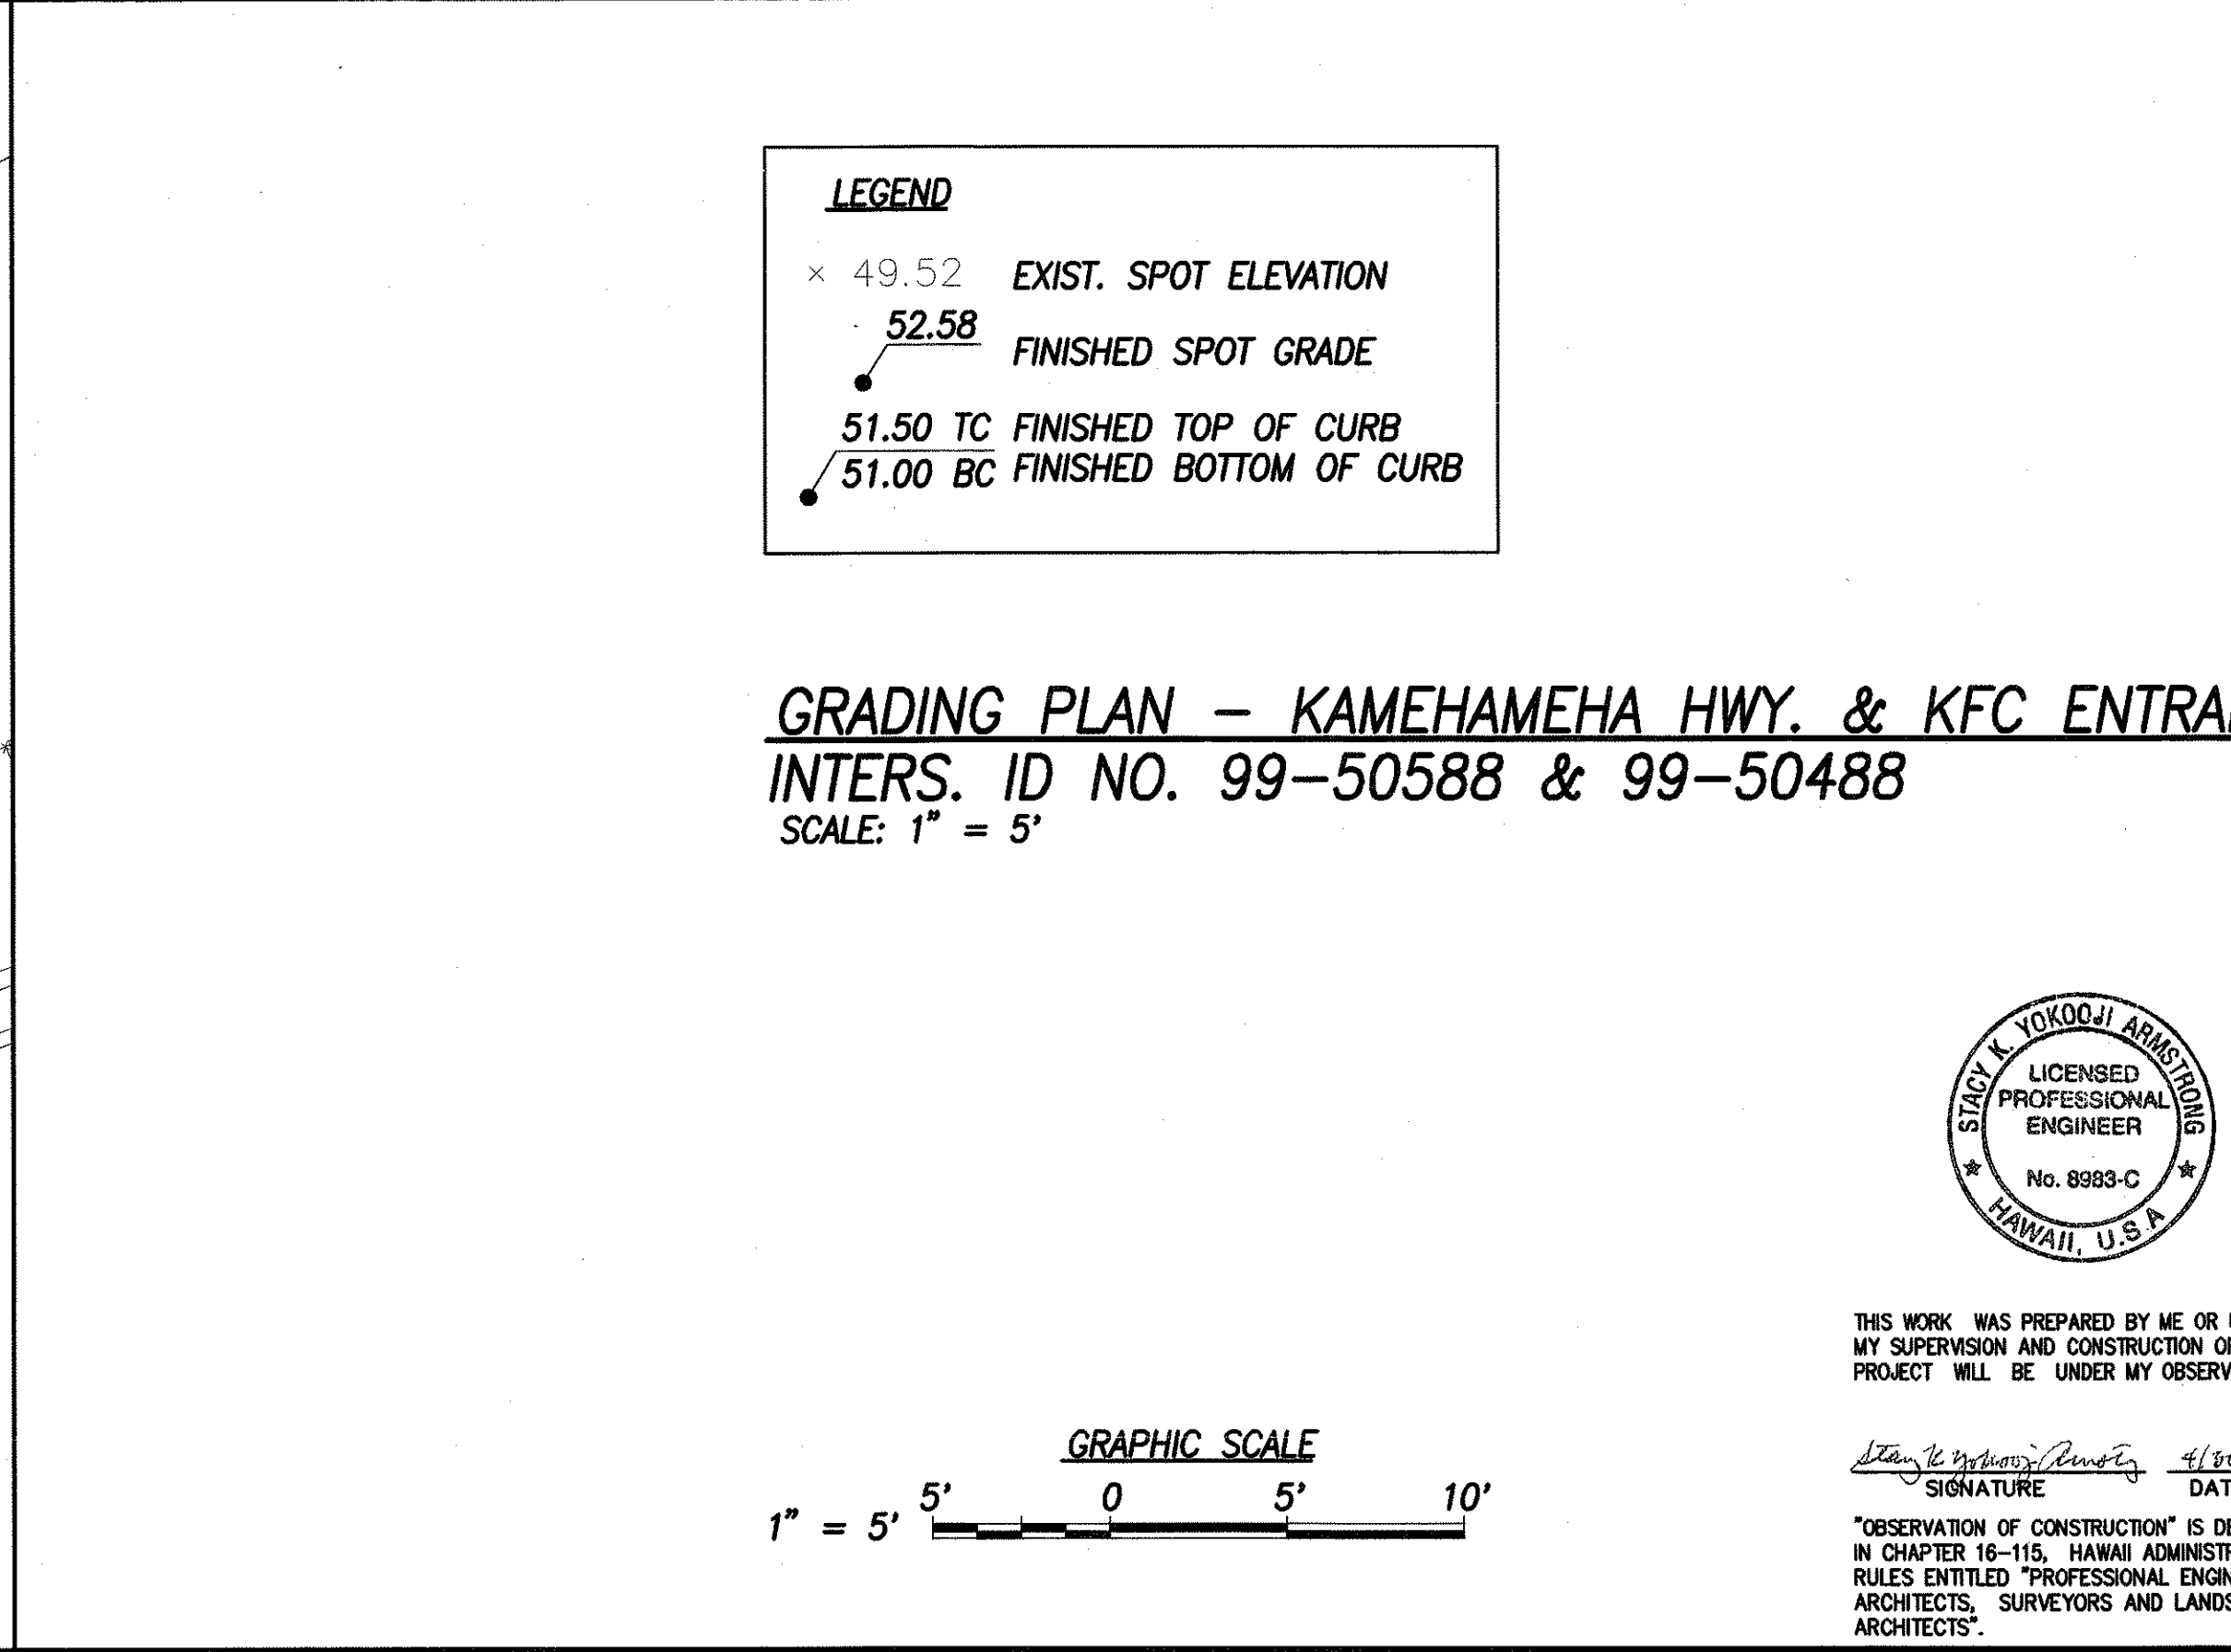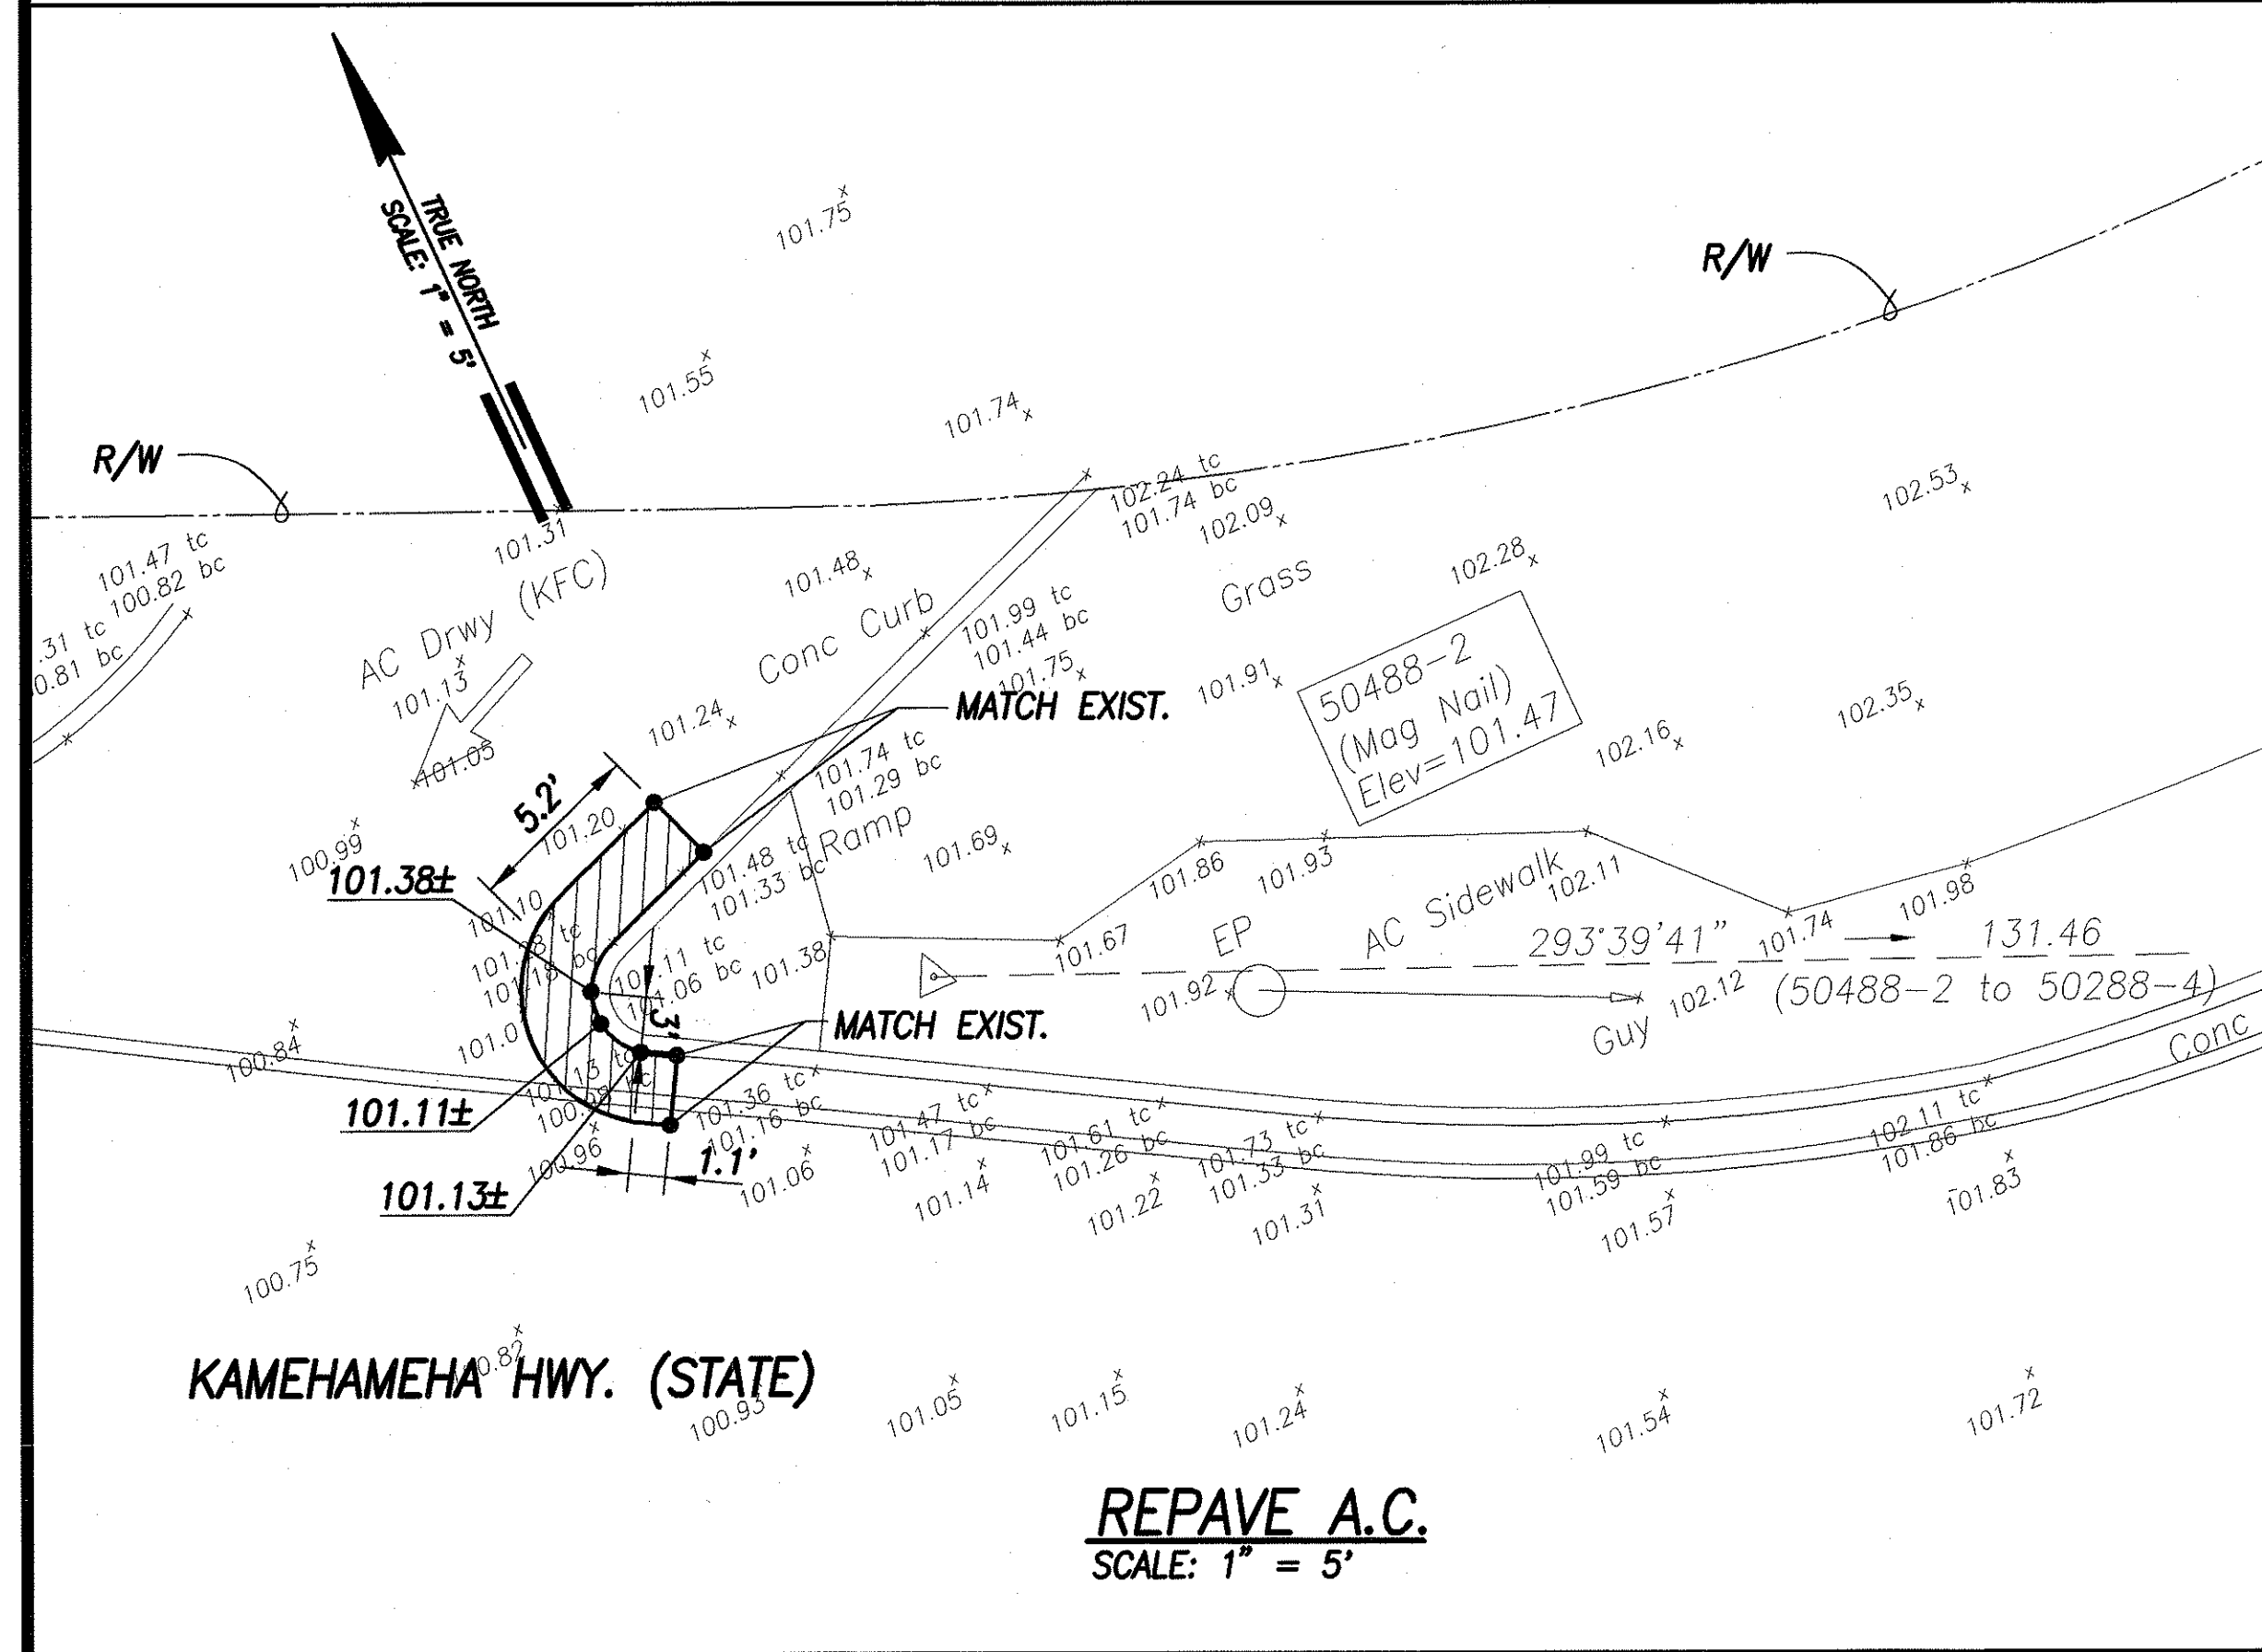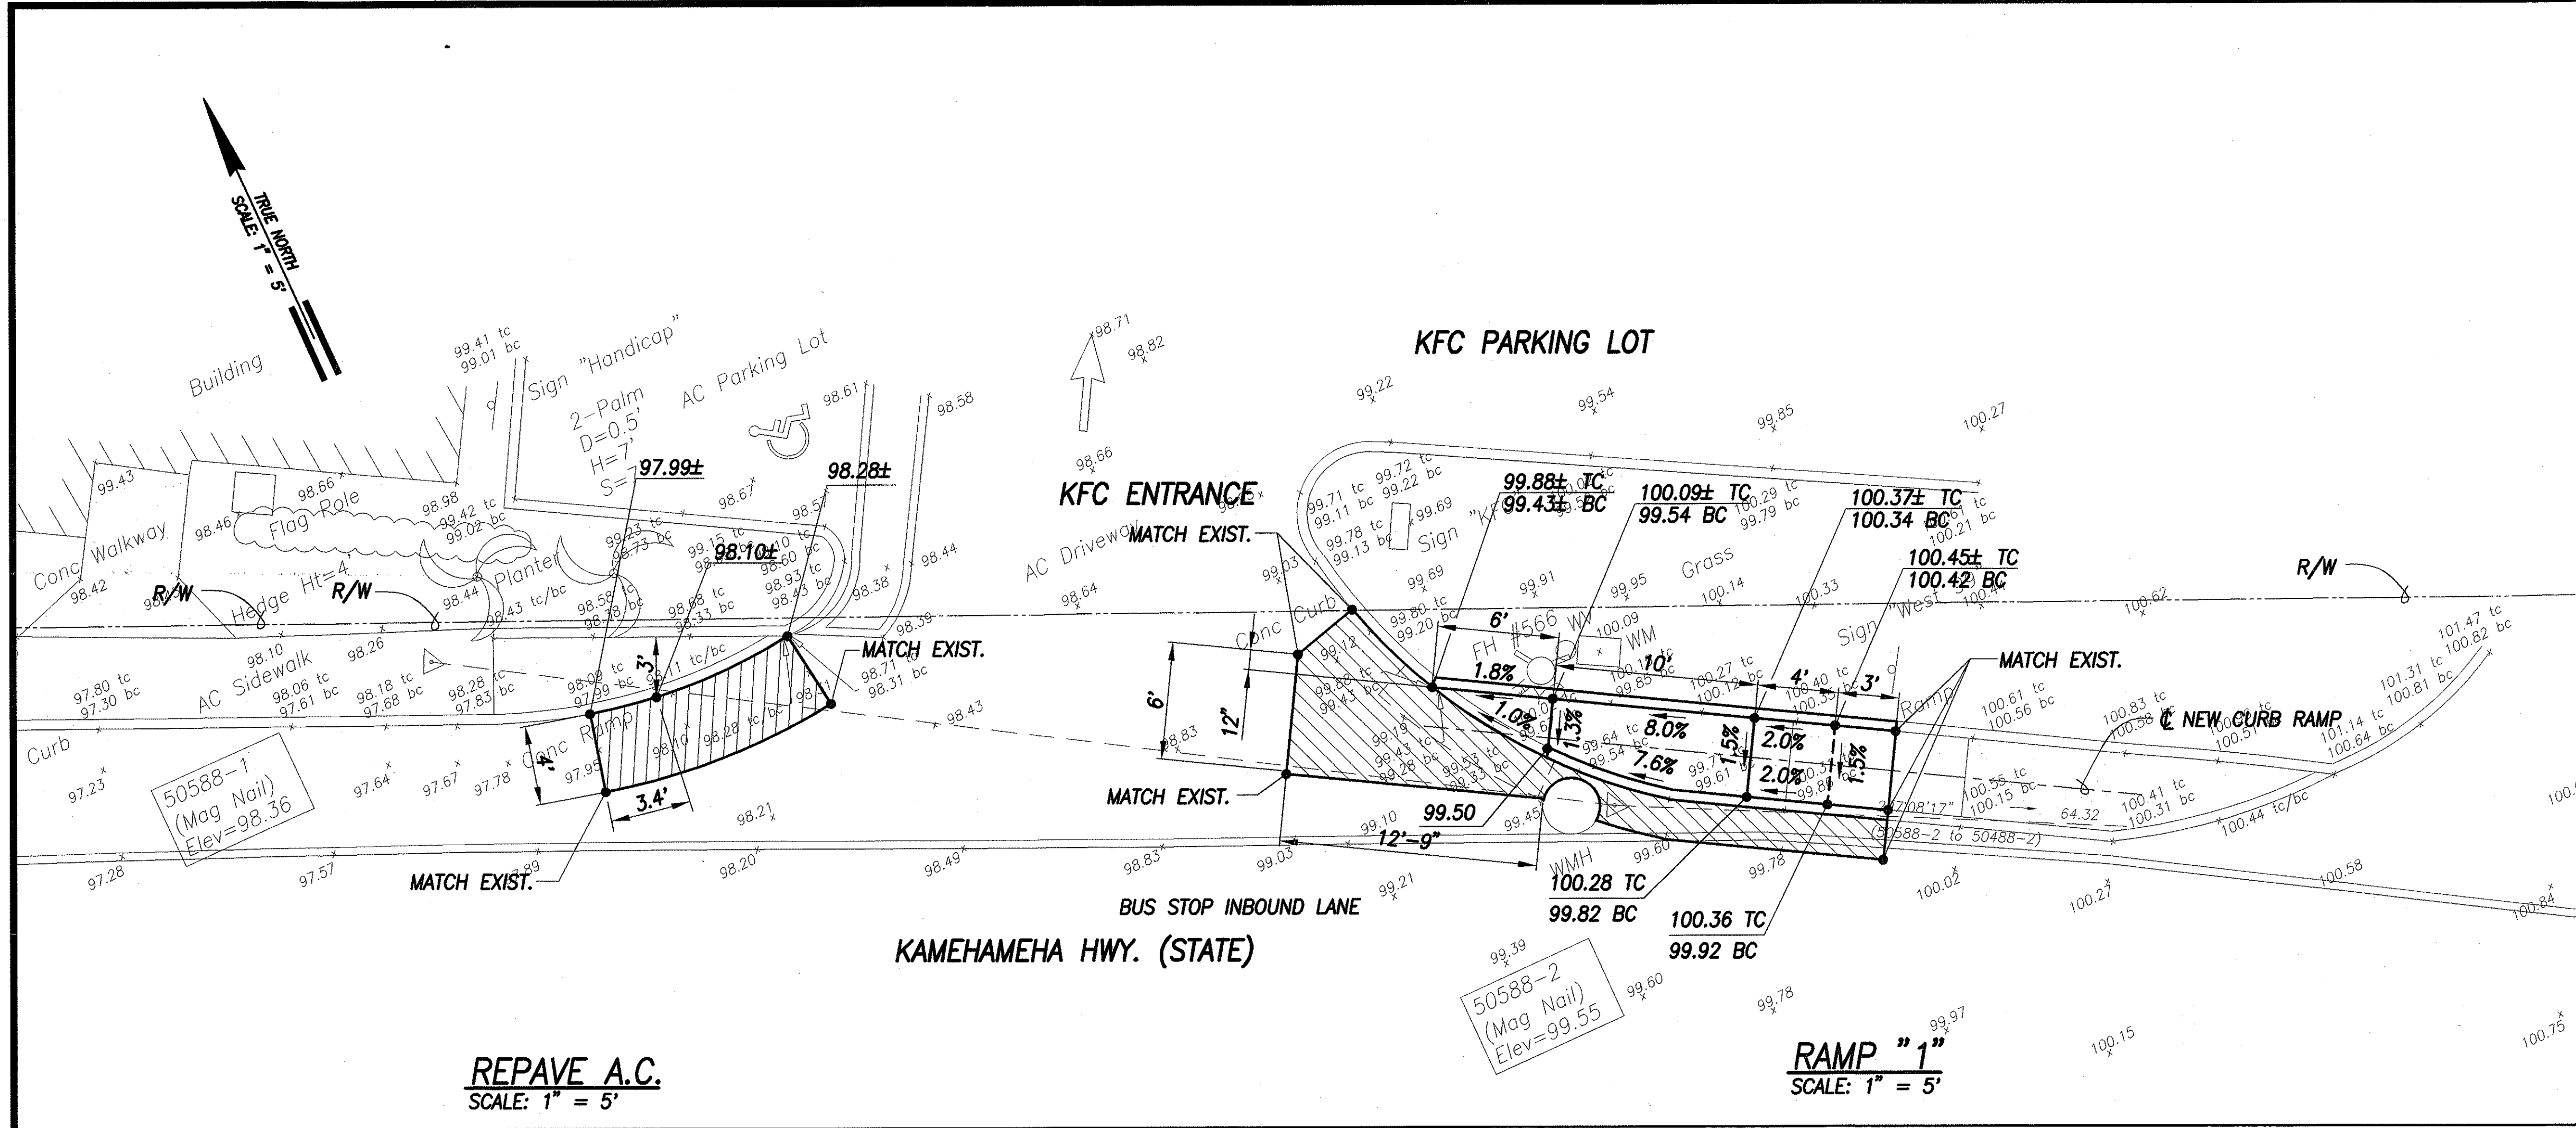

LEGEND	
× 49.52	EXIST. SPOT ELEVATION
— 52.58	FINISHED SPOT GRADE
51.50 TC	FINISHED TOP OF CURB
51.00 BC	FINISHED BOTTOM OF CURB

GRADING PLAN - KAMEHAMEHA HWY. & KFC ENTRANCE/EXIT
INTERS. ID NO. 99-50588 & 99-50488
SCALE: 1" = 5'




SURVEY PLATTED BY	DATE
DRAWN BY	
DESIGNED BY	
QUANTITIES BY	
CHECKED BY	
ORIGINAL PLAN	
NOTE BOOK	
No.	

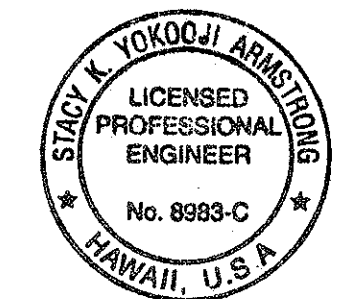

THIS WORK WAS PREPARED BY ME OR UNDER MY SUPERVISION AND CONSTRUCTION OF THIS PROJECT WILL BE UNDER MY OBSERVATION.
SIGNATURE: [Signature] DATE: 4/22/04
"OBSERVATION OF CONSTRUCTION" IS DEFINED IN CHAPTER 16-115, HAWAII ADMINISTRATIVE RULES ENTITLED "PROFESSIONAL ENGINEERS, ARCHITECTS, SURVEYORS AND LANDSCAPE ARCHITECTS".

STATE OF HAWAII
DEPARTMENT OF TRANSPORTATION
HIGHWAYS DIVISION
GRADING PLAN - KAMEHAMEHA HWY. & KFC ENTRANCE/EXIT
Pedestrian Facilities & ADA Compliance at Various Locations on Oahu, Unit 5
Fed. Aid Proj. No. CMAQ-0300(96)
Scale: 1" = 5'-0" Date: August 2004
SHEET No. C-35 OF 153 SHEETS

FED. ROAD DIST. NO.	STATE	FED. AID PROJ. NO.	FISCAL YEAR	SHEET NO.	TOTAL SHEETS
HAWAII	HAW.	CMAQ-0300(96)	2004	37	153

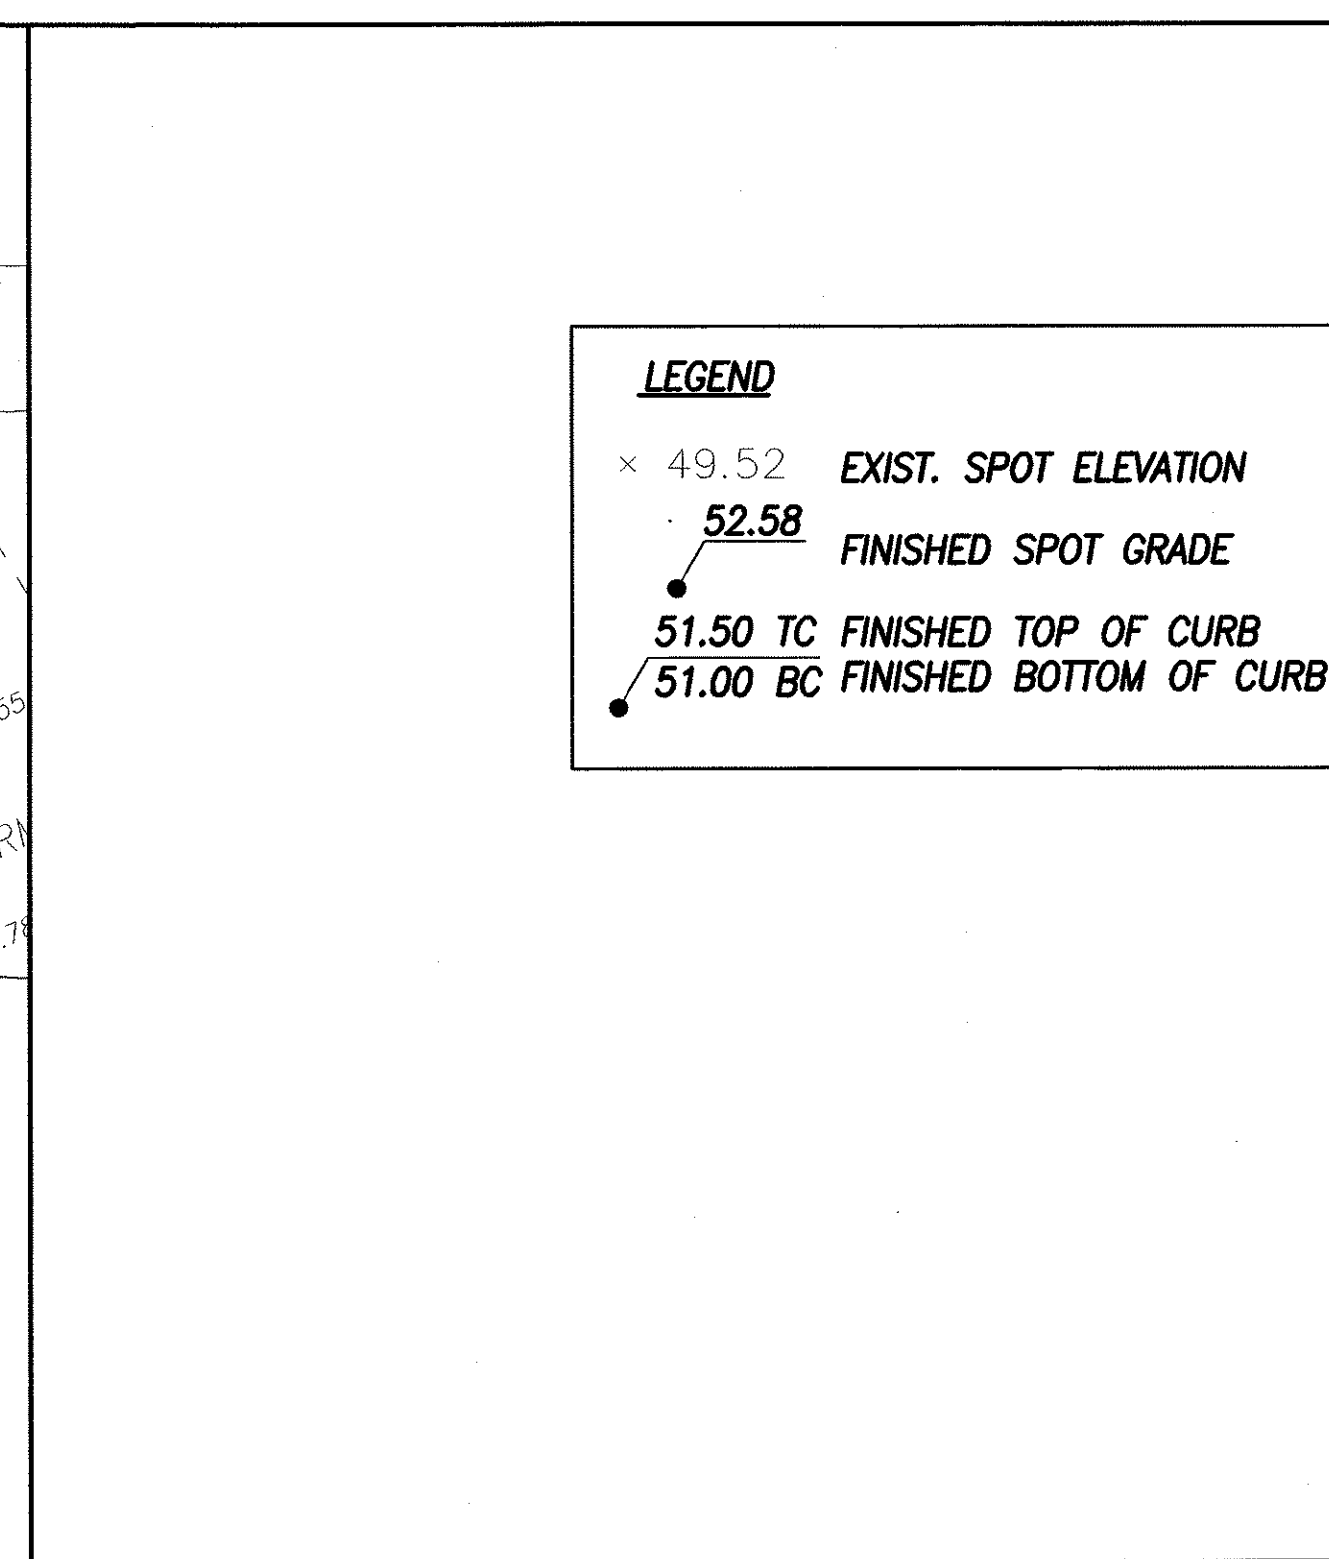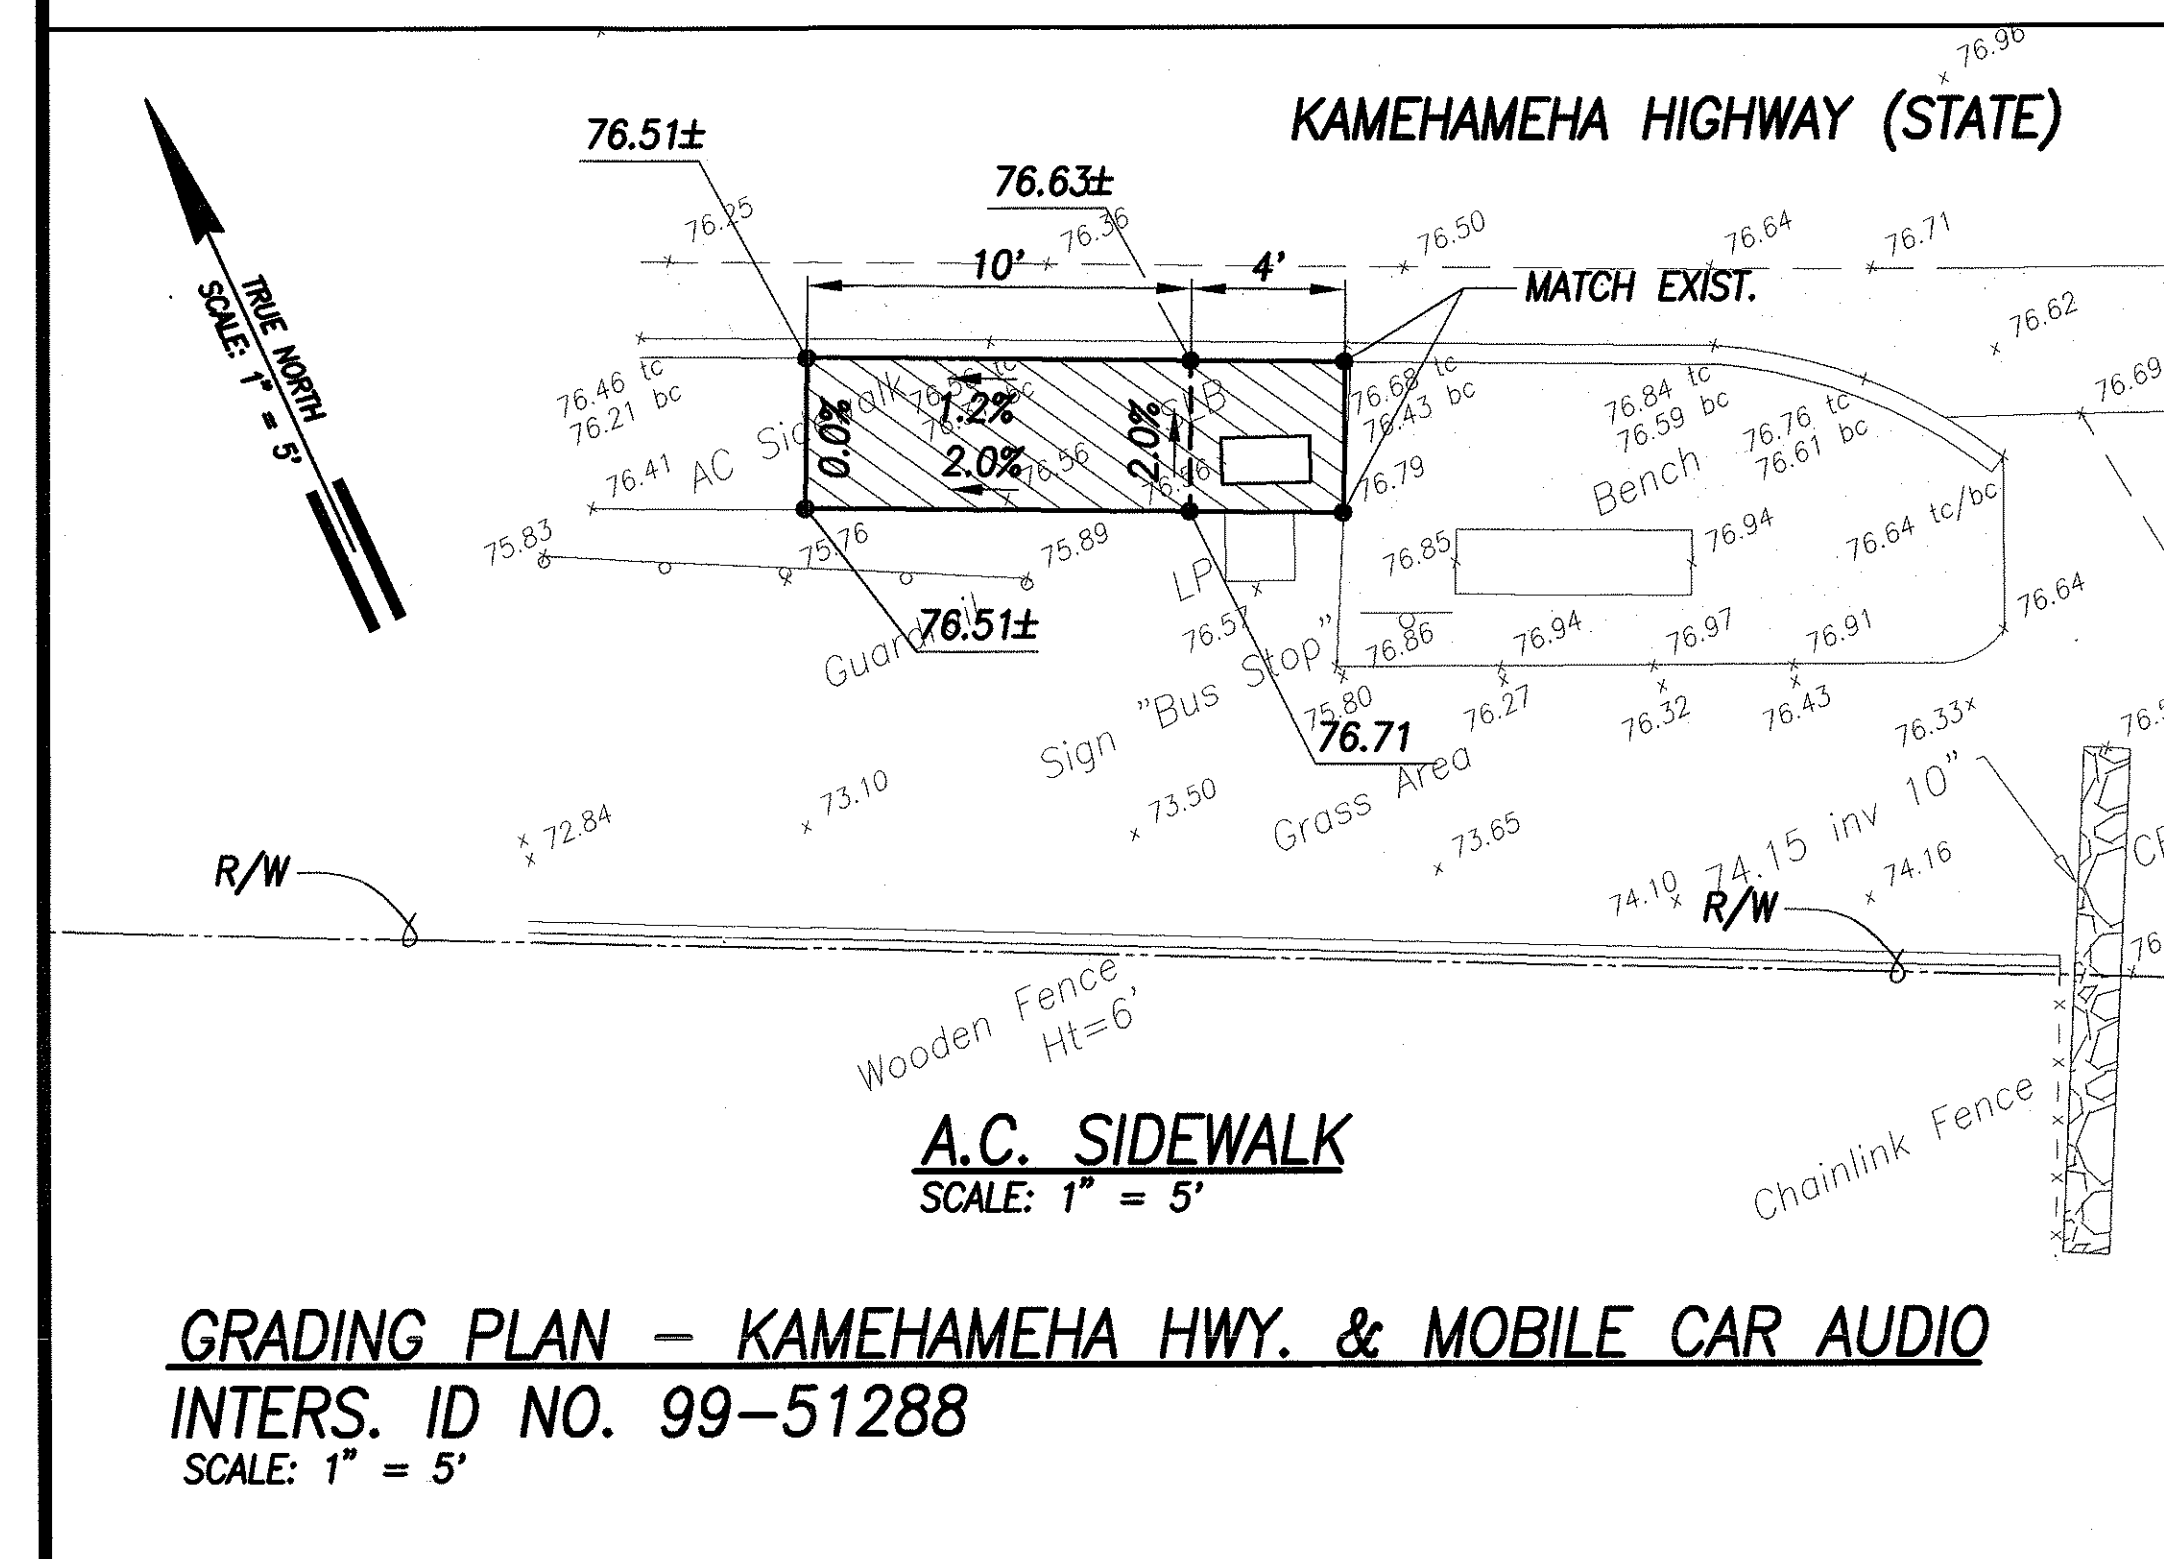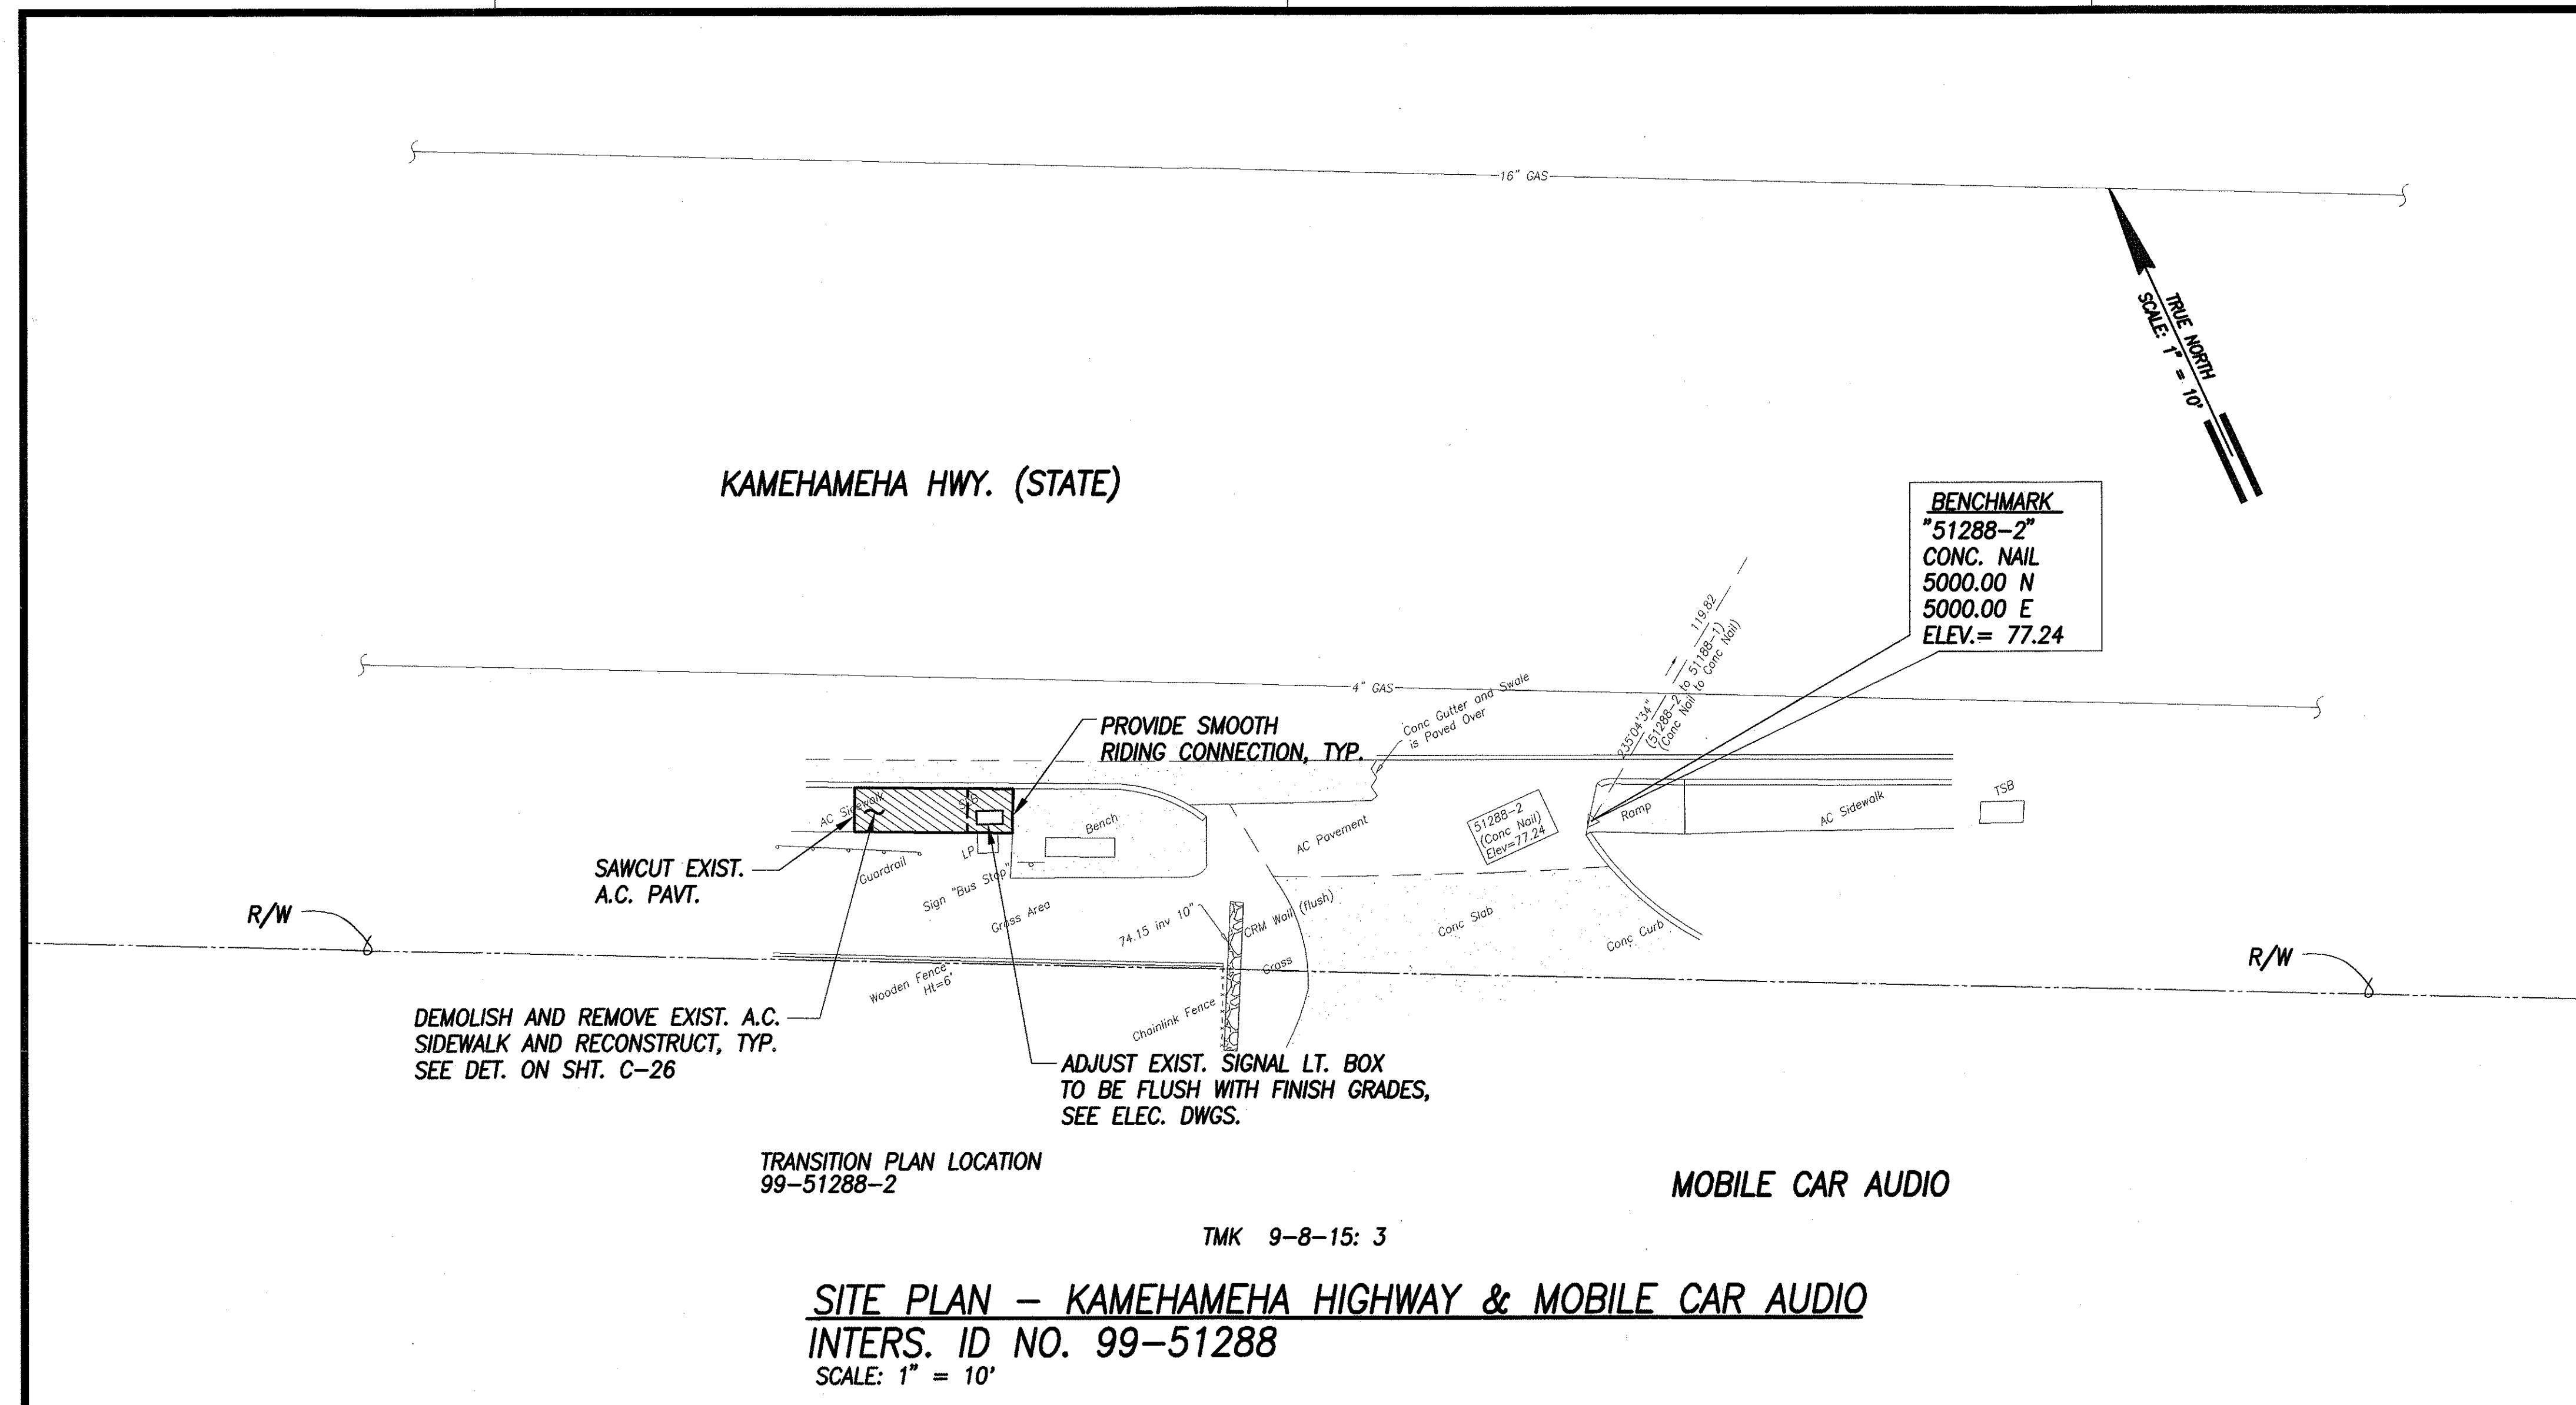

DATE	_____
SURVEY PLOTTED BY	_____
DESIGNED BY	_____
TRACED BY	_____
NOTED BY	_____
CHECKED BY	_____
NO.	_____



THIS WORK WAS PREPARED BY ME OR UNDER MY SUPERVISION AND CONSTRUCTION OF THIS PROJECT WILL BE UNDER MY OBSERVATION.

SIGNATURE: *Greg H. Hiyaumoto* DATE: April 30, 2006

"OBSERVATION OF CONSTRUCTION" IS DEFINED IN CHAPTER 16-115, HAWAII ADMINISTRATIVE RULES ENTITLED "PROFESSIONAL ENGINEERS, ARCHITECTS, SURVEYORS AND LANDSCAPE ARCHITECTS".

STATE OF HAWAII
DEPARTMENT OF TRANSPORTATION
HIGHWAYS DIVISION


SITE & GRADING PLAN
KAMEHAMEHA HWY. & MOBILE CAR AUDIO

Pedestrian Facilities & ADA Compliance at Various Locations on Oahu, Unit 5
Fed. Aid Proj. No. CMAQ-0300(96)


Scale: AS SHOWN Date: August 2004

SHEET No. C-36 OF 153 SHEETS

FED. ROAD DIST. NO.	STATE	FED. AID PROJ. NO.	FISCAL YEAR	SHEET NO.	TOTAL SHEETS
HAWAII	HAW.	CMAQ-0300(96)	2004	ADD. 38	153

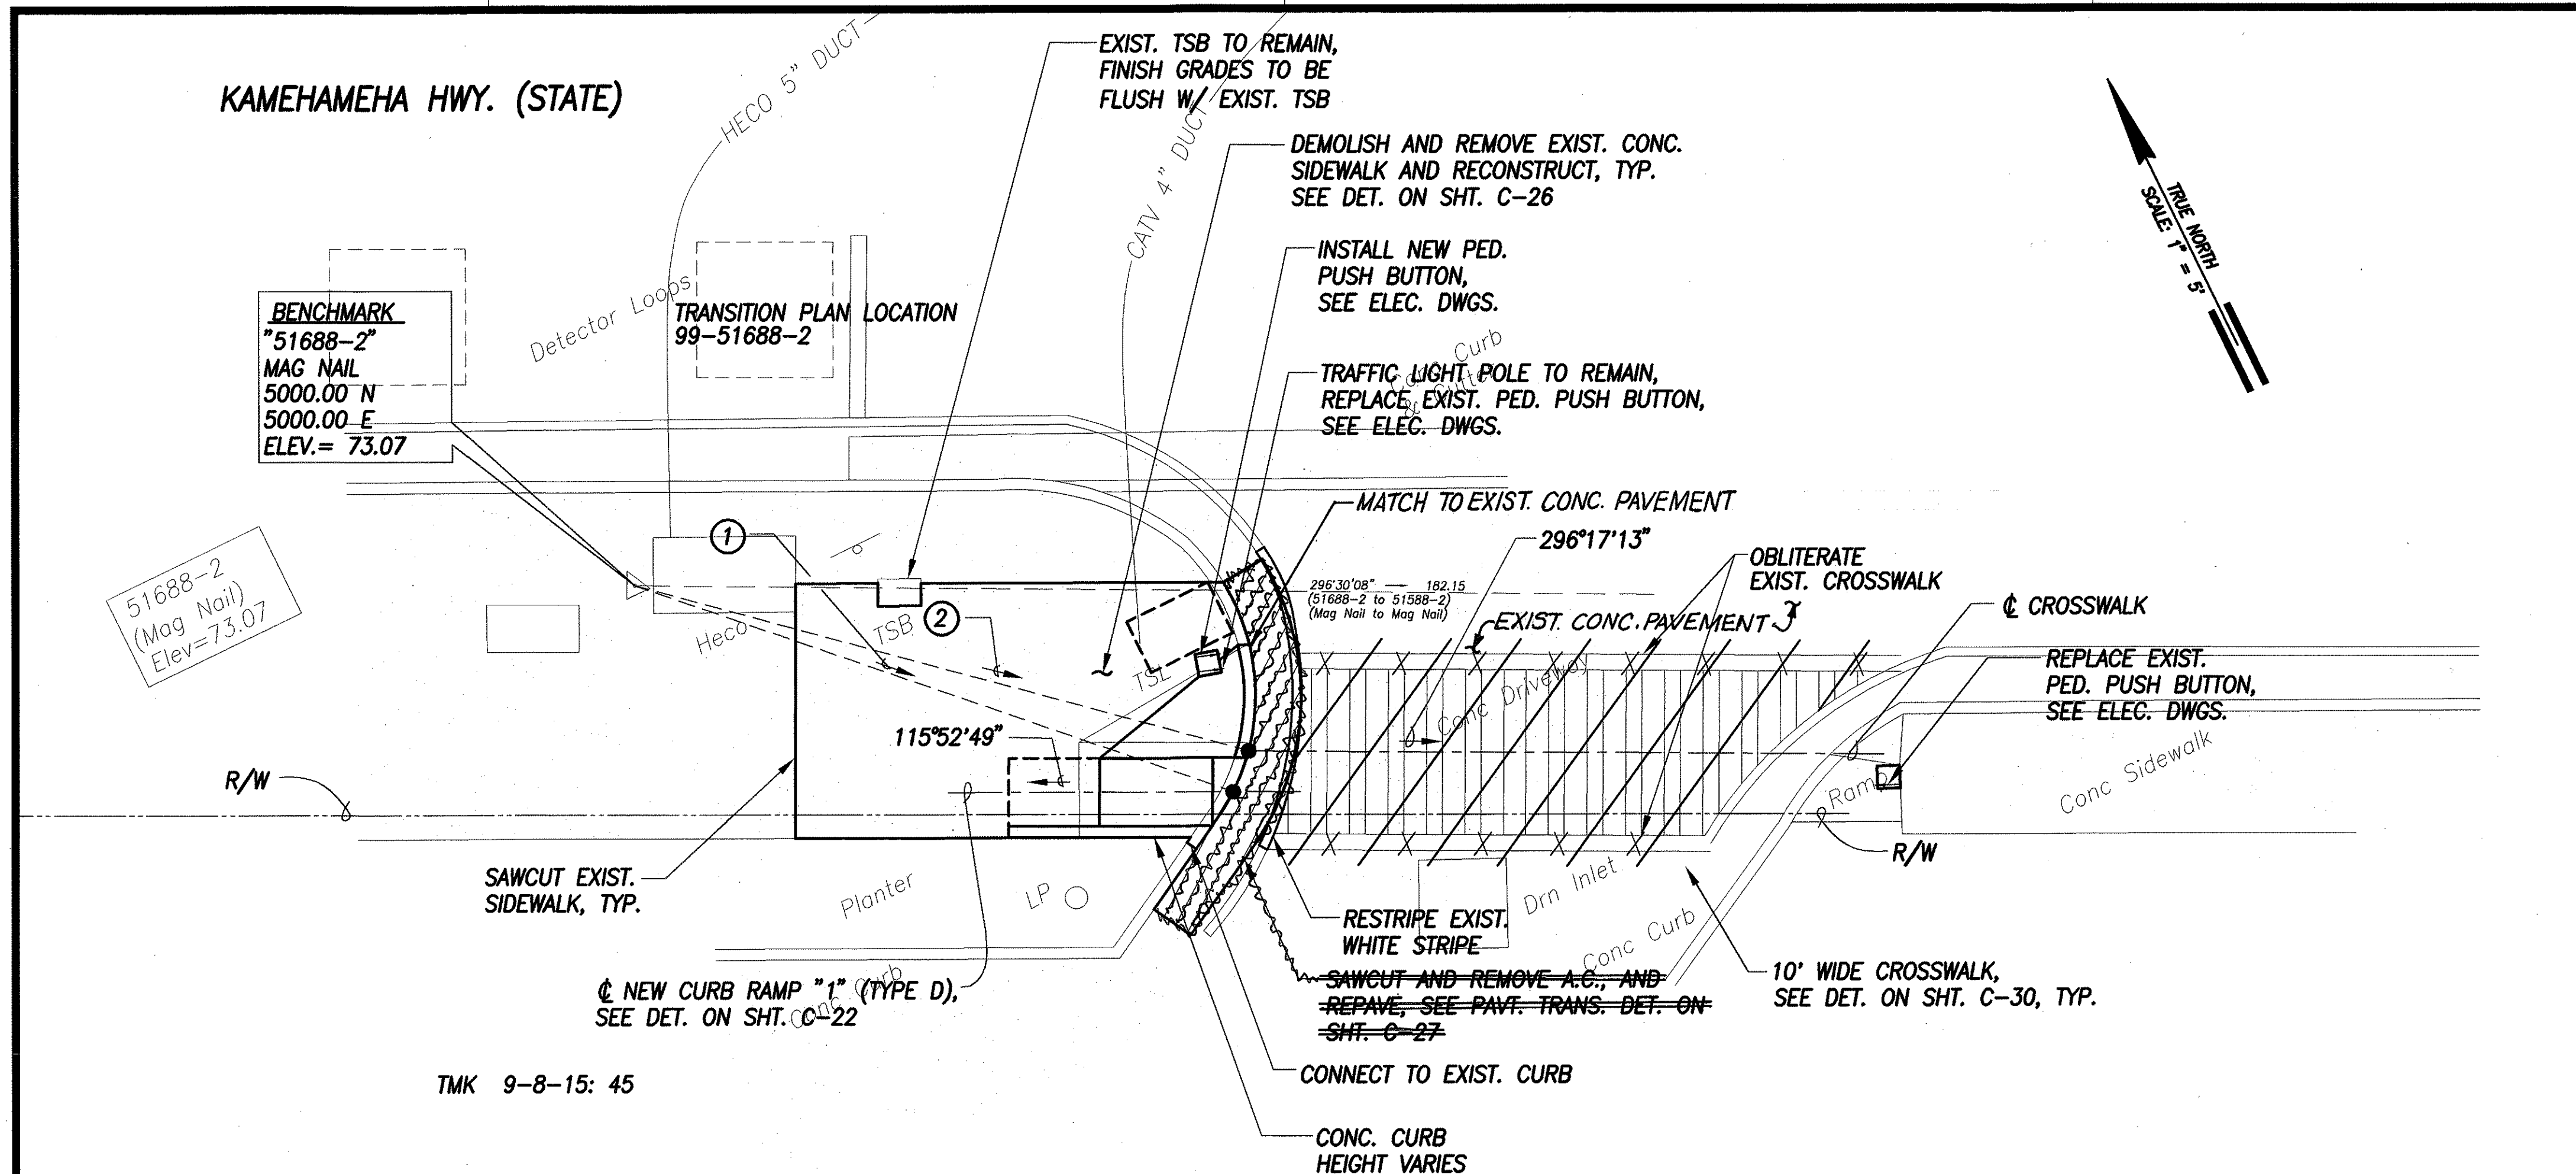

- ① 311°08'34" 28.02'
TIE: BM TO INTERSECTION OF
C CROSSWALK AND CURB FACE
- ② 315°05'47" 27.91'
TIE: BM TO INTERSECTION OF
C CROSSWALK AND CURB FACE

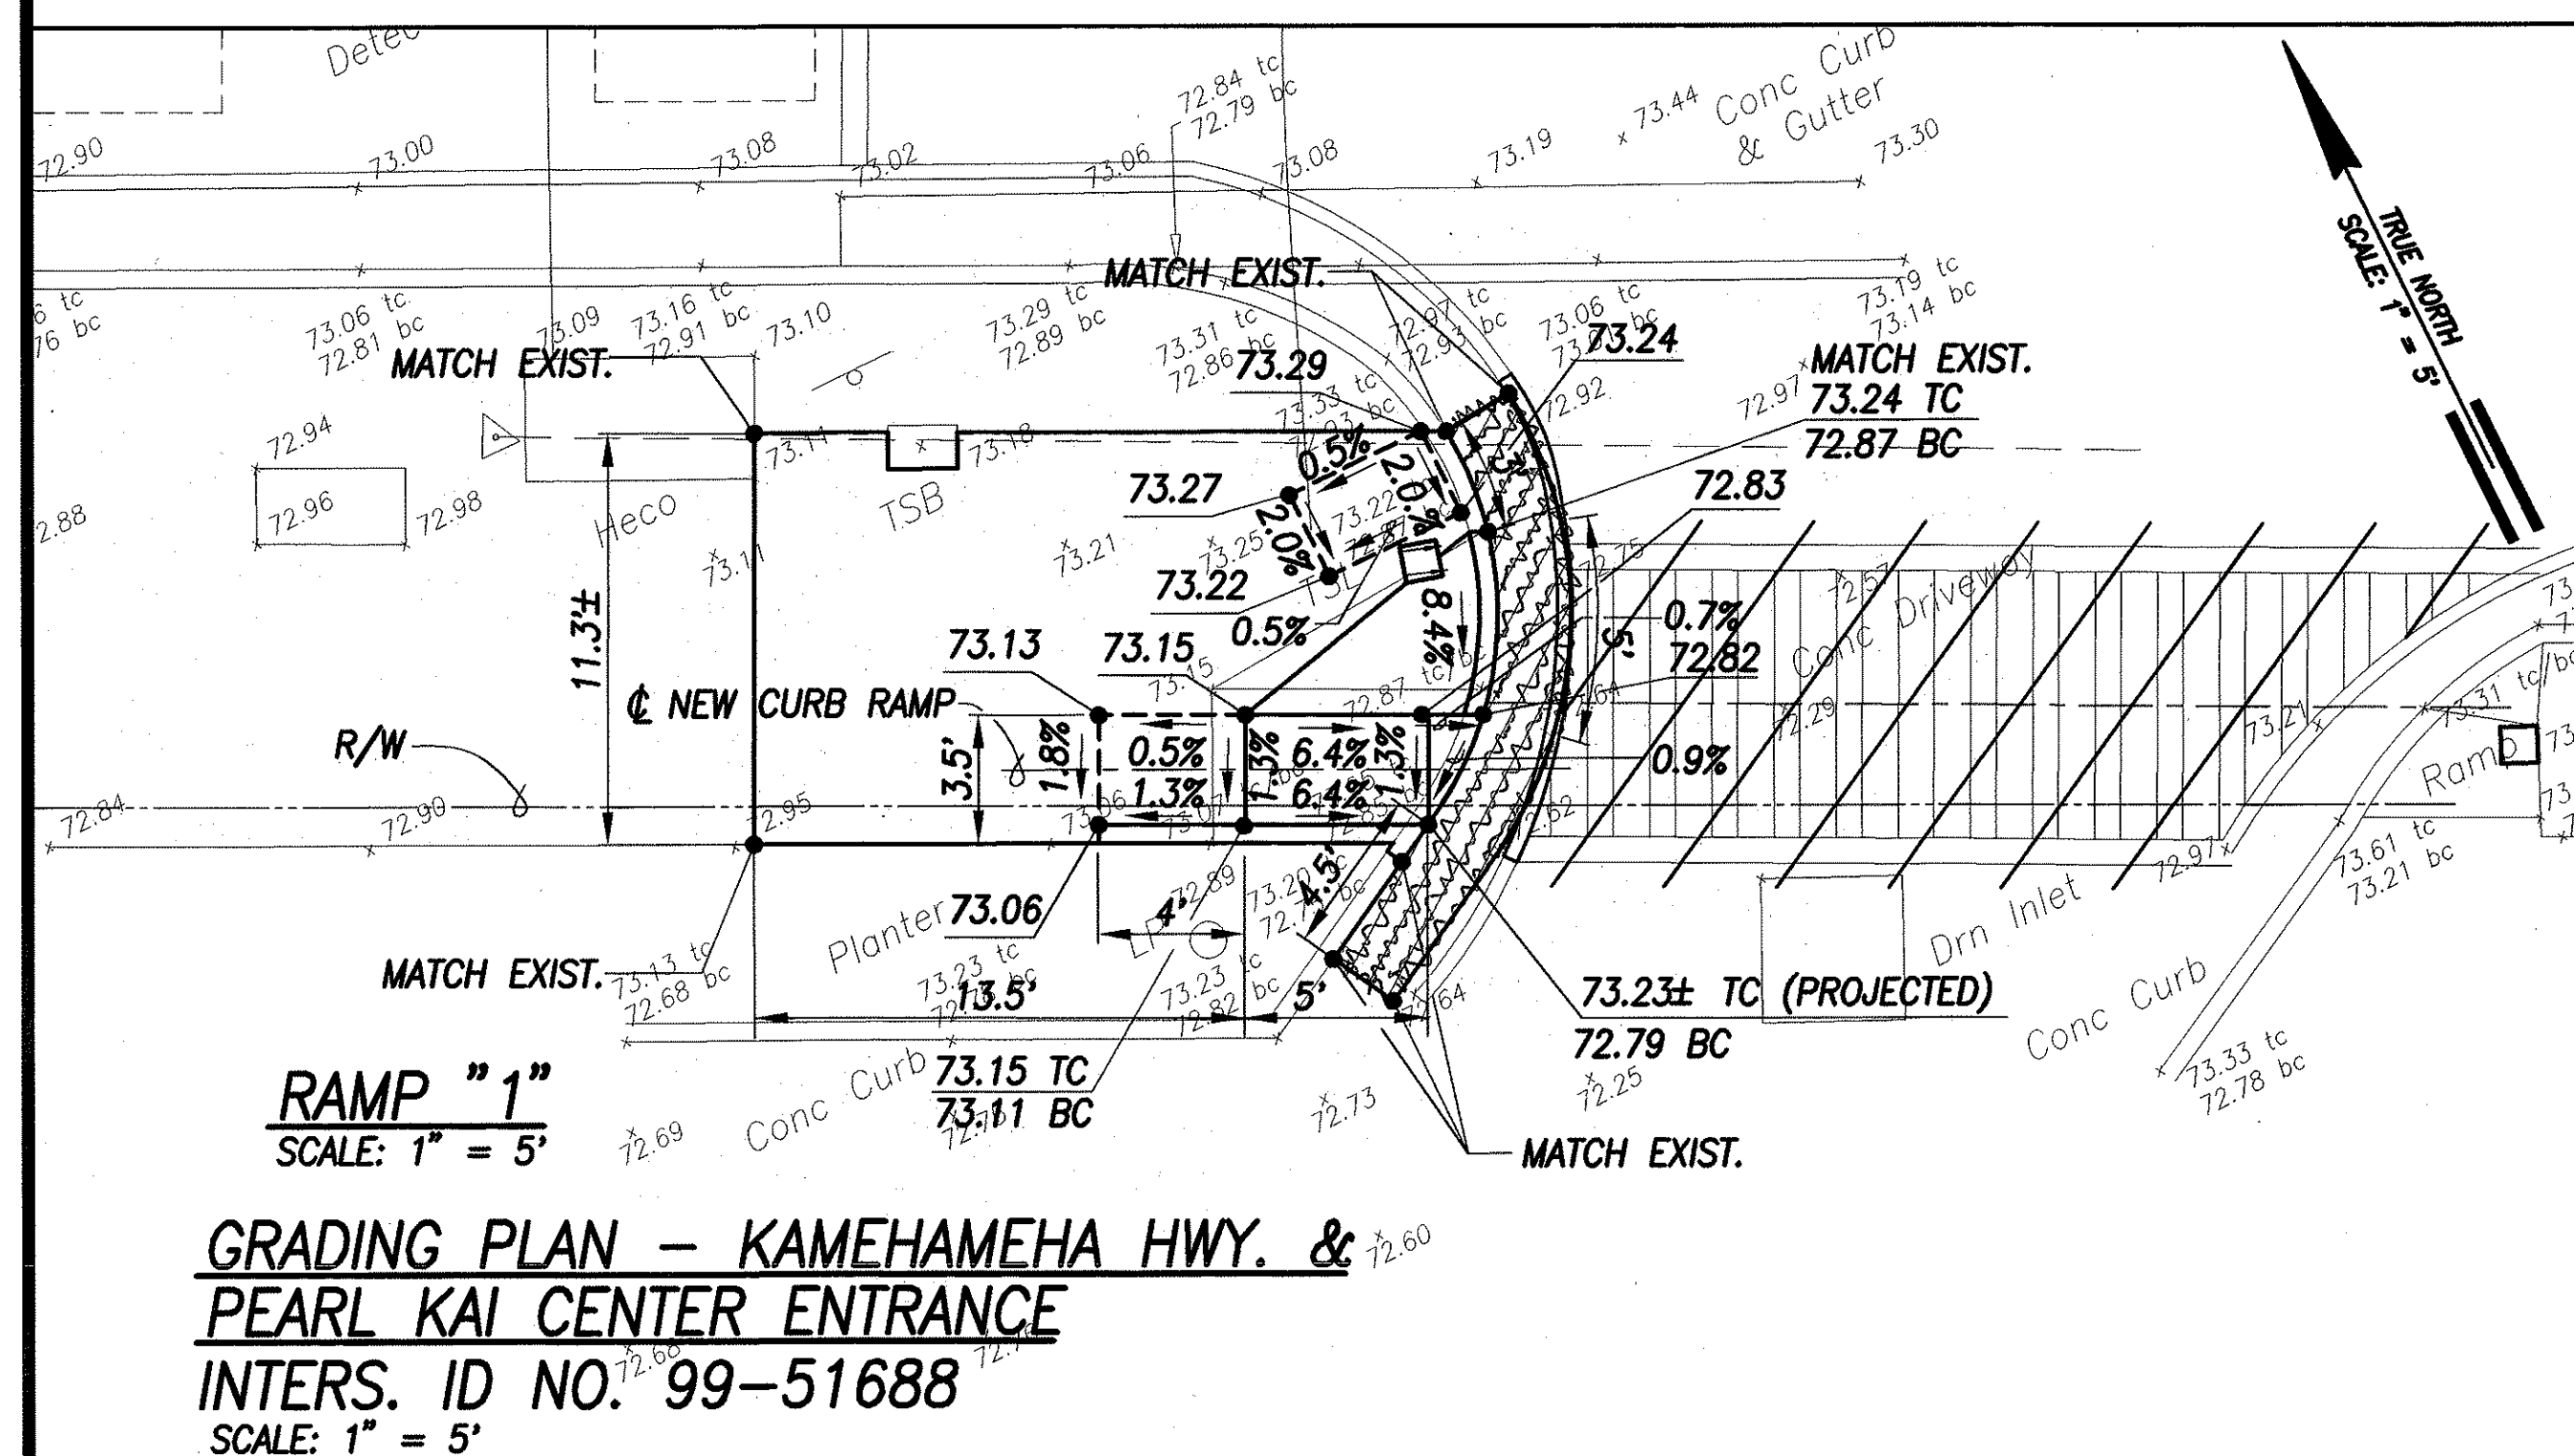

SURVEY PLOTTED BY	DATE
DRAWN BY	
DESIGNED BY	
QUANTITIES BY	
CHECKED BY	
ORIGINAL PLAN	
NOTE BOOK	
No.	



THIS WORK WAS PREPARED BY ME OR UNDER MY SUPERVISION AND CONSTRUCTION OF THIS PROJECT WILL BE UNDER MY OBSERVATION.

SIGNATURE *Greg H. Hiyaunoto* DATE April 30, 2006

"OBSERVATION OF CONSTRUCTION" IS DEFINED IN CHAPTER 16-115, HAWAII ADMINISTRATIVE RULES ENTITLED "PROFESSIONAL ENGINEERS, ARCHITECTS, SURVEYORS AND LANDSCAPE ARCHITECTS".

9/16/04	ADD. 1 - REMOVED CALL OUT, REVISED CROSSWALK STRIPING, AND ADDED PUSH BUTTON TO BE REPLACED
DATE	REVISION

STATE OF HAWAII
 DEPARTMENT OF TRANSPORTATION
 HIGHWAYS DIVISION
SITE & GRADING PLAN
KAMEHAMEHA HWY. & PEARL KAI CENTER ENTRANCE

Pedestrian Facilities & ADA Compliance
at Various Locations on Oahu, Unit 5
 Fed. Aid Proj. No. CMAQ-0300(96)

Scale: AS SHOWN Date: August 2004


SHEET No. C-37 OF 153 SHEETS

"AS-BUILT" ADD. 38

FED. ROAD DIST. NO.	STATE	FED. AID PROJ. NO.	FISCAL YEAR	SHEET NO.	TOTAL SHEETS
HAWAII	HAW.	CMAQ-0300(96)	2004	39	153


TRANSITION PLAN LOCATION
99-52188-2

TMK 9-8-16: 29

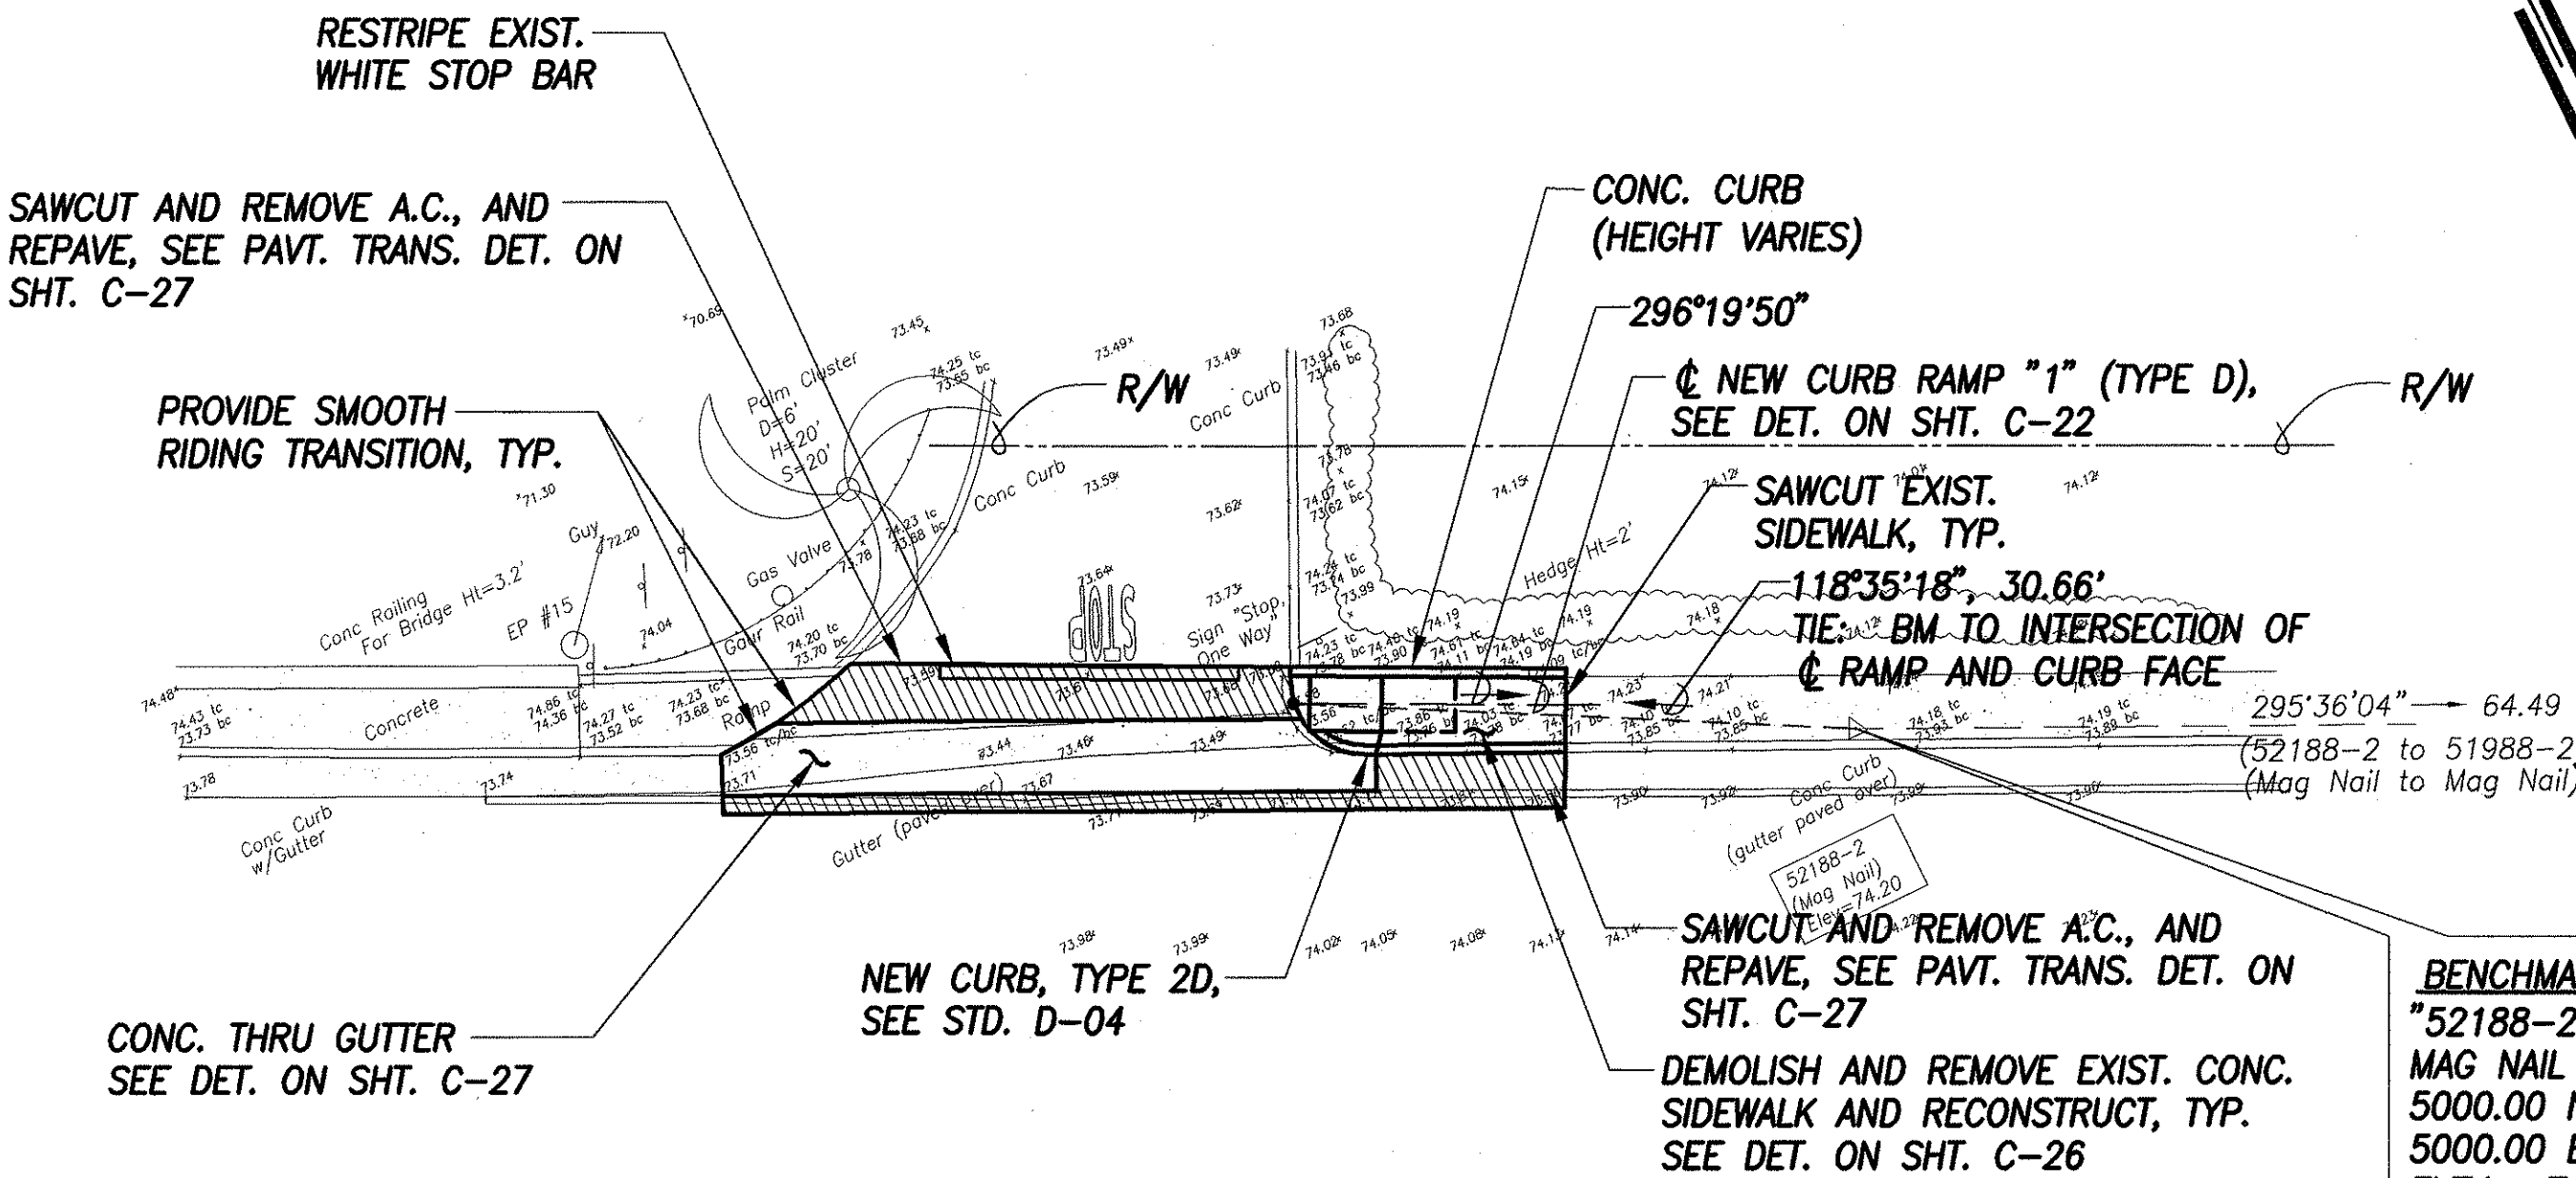


KAMEHAMEHA HWY. (STATE)

SITE PLAN - KAMEHAMEHA HWY. & PEARLRIDGE SHOPPING CTR. (SEARS EXIT)
INTERS. ID NO. 99-52188
SCALE: 1" = 10'

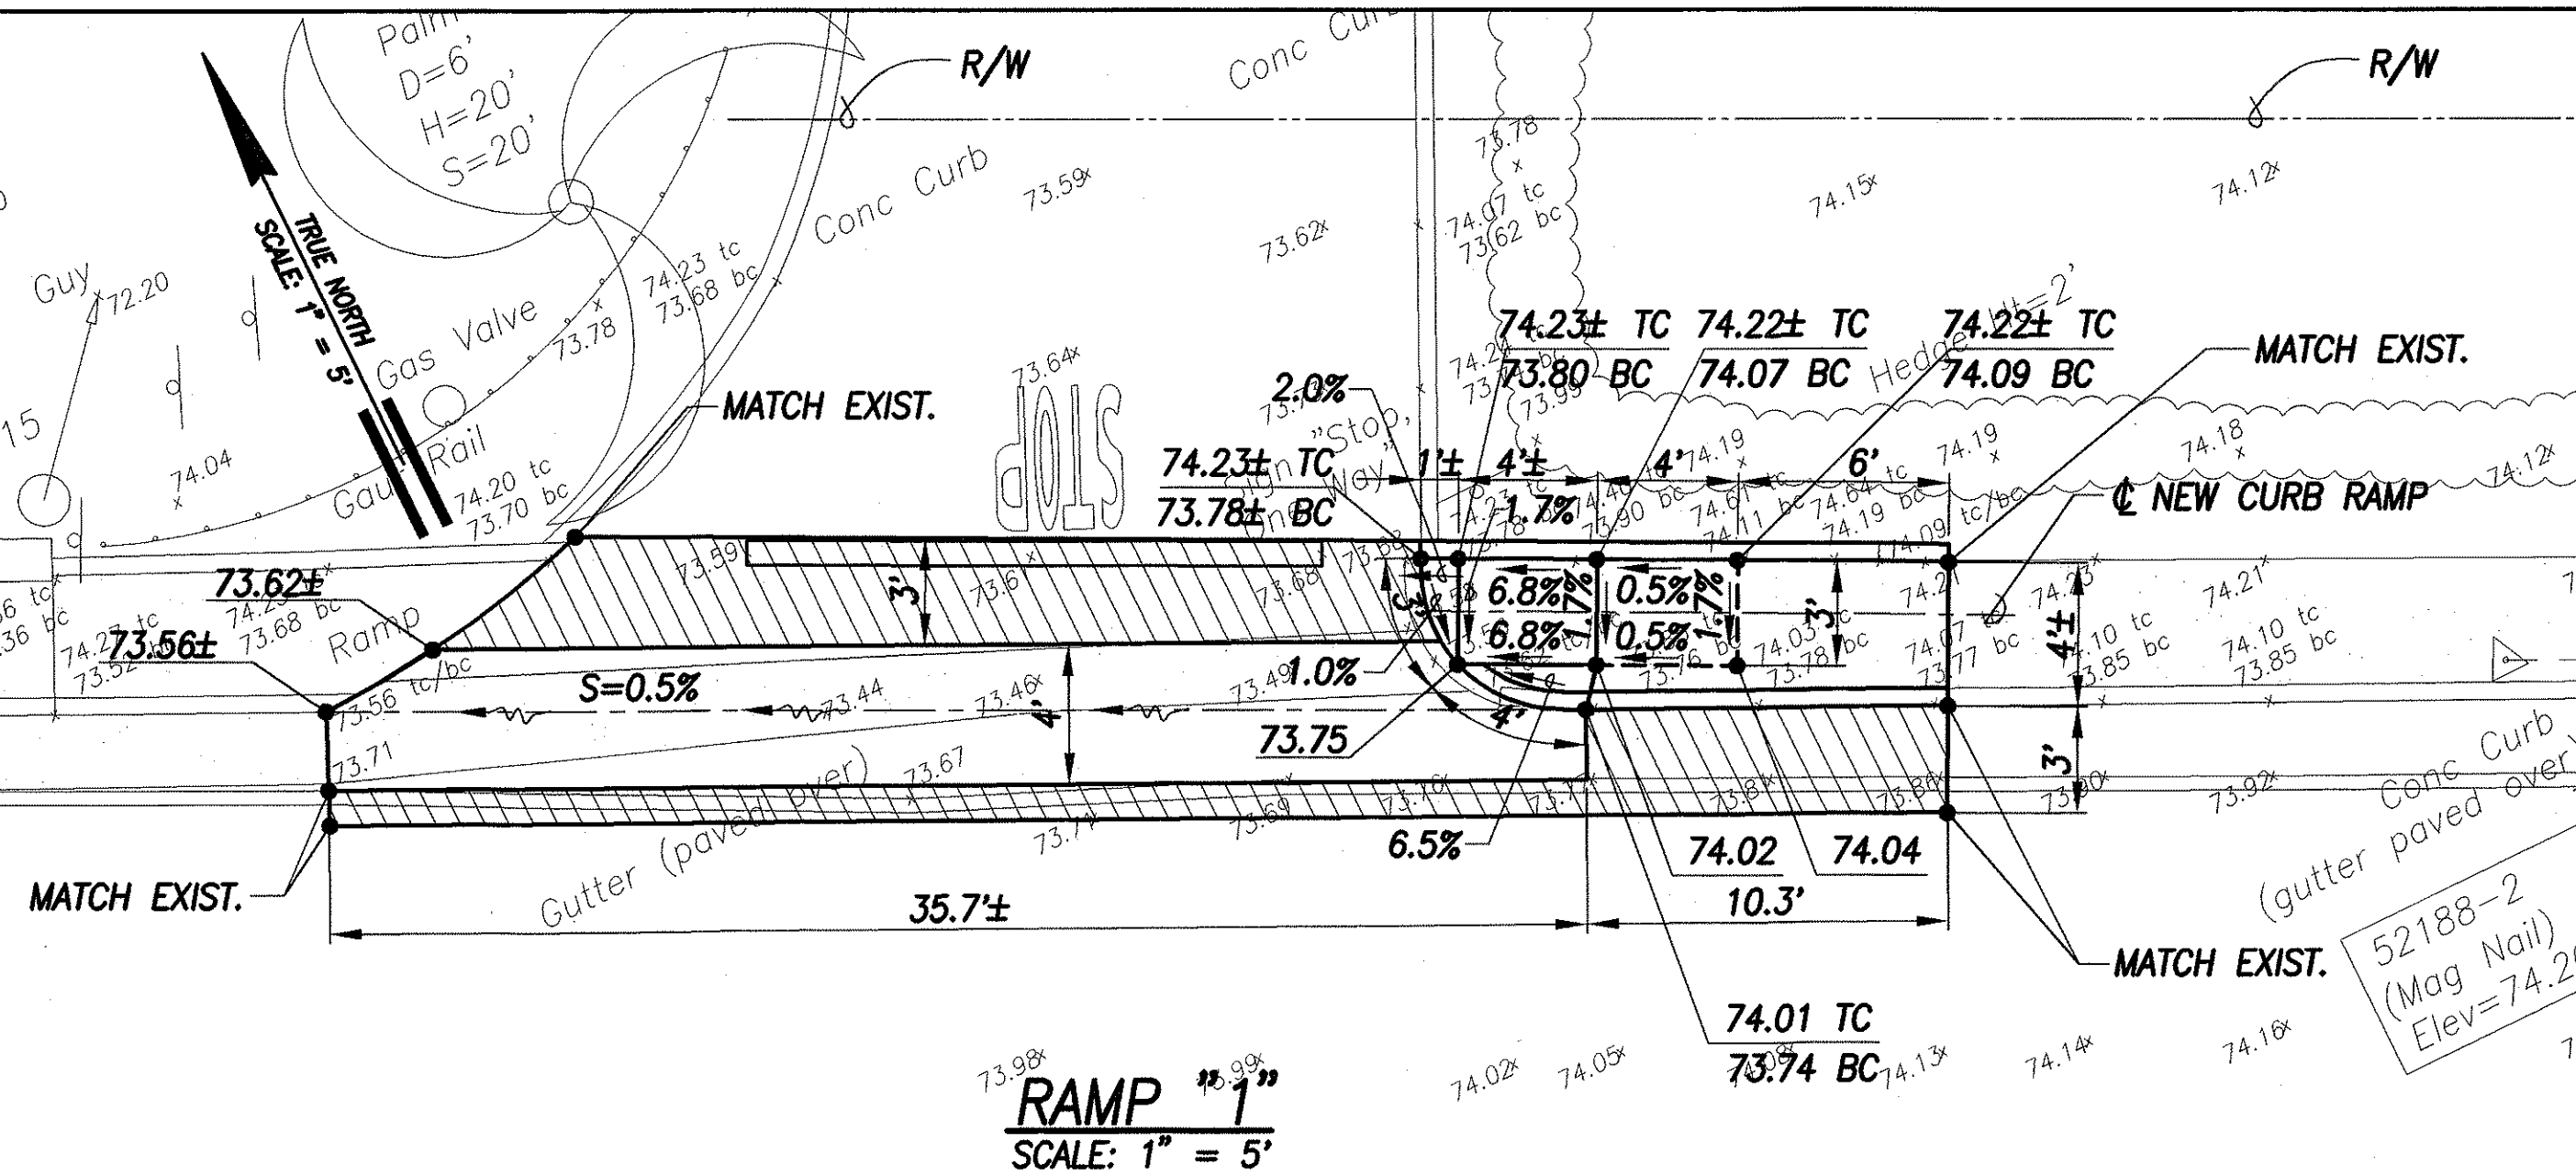

- LEGEND**
- × 49.52 EXIST. SPOT ELEVATION
 - 52.58 FINISHED SPOT GRADE
 - 51.50 TC FINISHED TOP OF CURB
 - 51.00 BC FINISHED BOTTOM OF CURB

GRADING PLAN - KAMEHAMEHA HWY. & PEARLRIDGE SHOPPING CTR. (SEARS EXIT)
INTERS. ID NO. 99-52188
SCALE: 1" = 5'

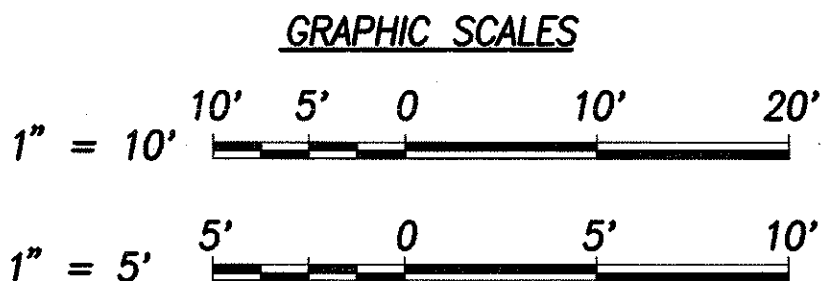

THIS WORK WAS PREPARED BY ME OR UNDER MY SUPERVISION AND CONSTRUCTION OF THIS PROJECT WILL BE UNDER MY OBSERVATION.


Signature: *Greg H. Hiyaunio* DATE: April 30, 2006

"OBSERVATION OF CONSTRUCTION" IS DEFINED IN CHAPTER 16-115, HAWAII ADMINISTRATIVE RULES ENTITLED "PROFESSIONAL ENGINEERS, ARCHITECTS, SURVEYORS AND LANDSCAPE ARCHITECTS".

STATE OF HAWAII
DEPARTMENT OF TRANSPORTATION
HIGHWAYS DIVISION
SITE & GRADING PLAN - KAMEHAMEHA HWY. & PEARLRIDGE SHOPPING CTR. (SEARS EXIT)
Pedestrian Facilities & ADA Compliance
at Various Locations on Oahu, Unit 5
Fed. Aid Proj. No. CMAQ-0300(96)
Scale: AS SHOWN Date: August 2004
SHEET No. C-38 OF 153 SHEETS


FED. ROAD DIST. NO.	STATE	FED. AID PROJ. NO.	FISCAL YEAR	SHEET NO.	TOTAL SHEETS
HAWAII	HAW.	CMAQ-0300(96)	2004	40	153

- 172°55'56" 15.64'
TIE: BM TO INTERSECTION OF
RAMP EDGE AND CURB FACE
- 163°36'37" 21.73'
TIE: BM TO INTERSECTION OF
CROSSWALK AND CURB FACE
- 163°36'37" 21.73'
TIE: BM TO INTERSECTION OF
RAMP EDGE AND CURB FACE

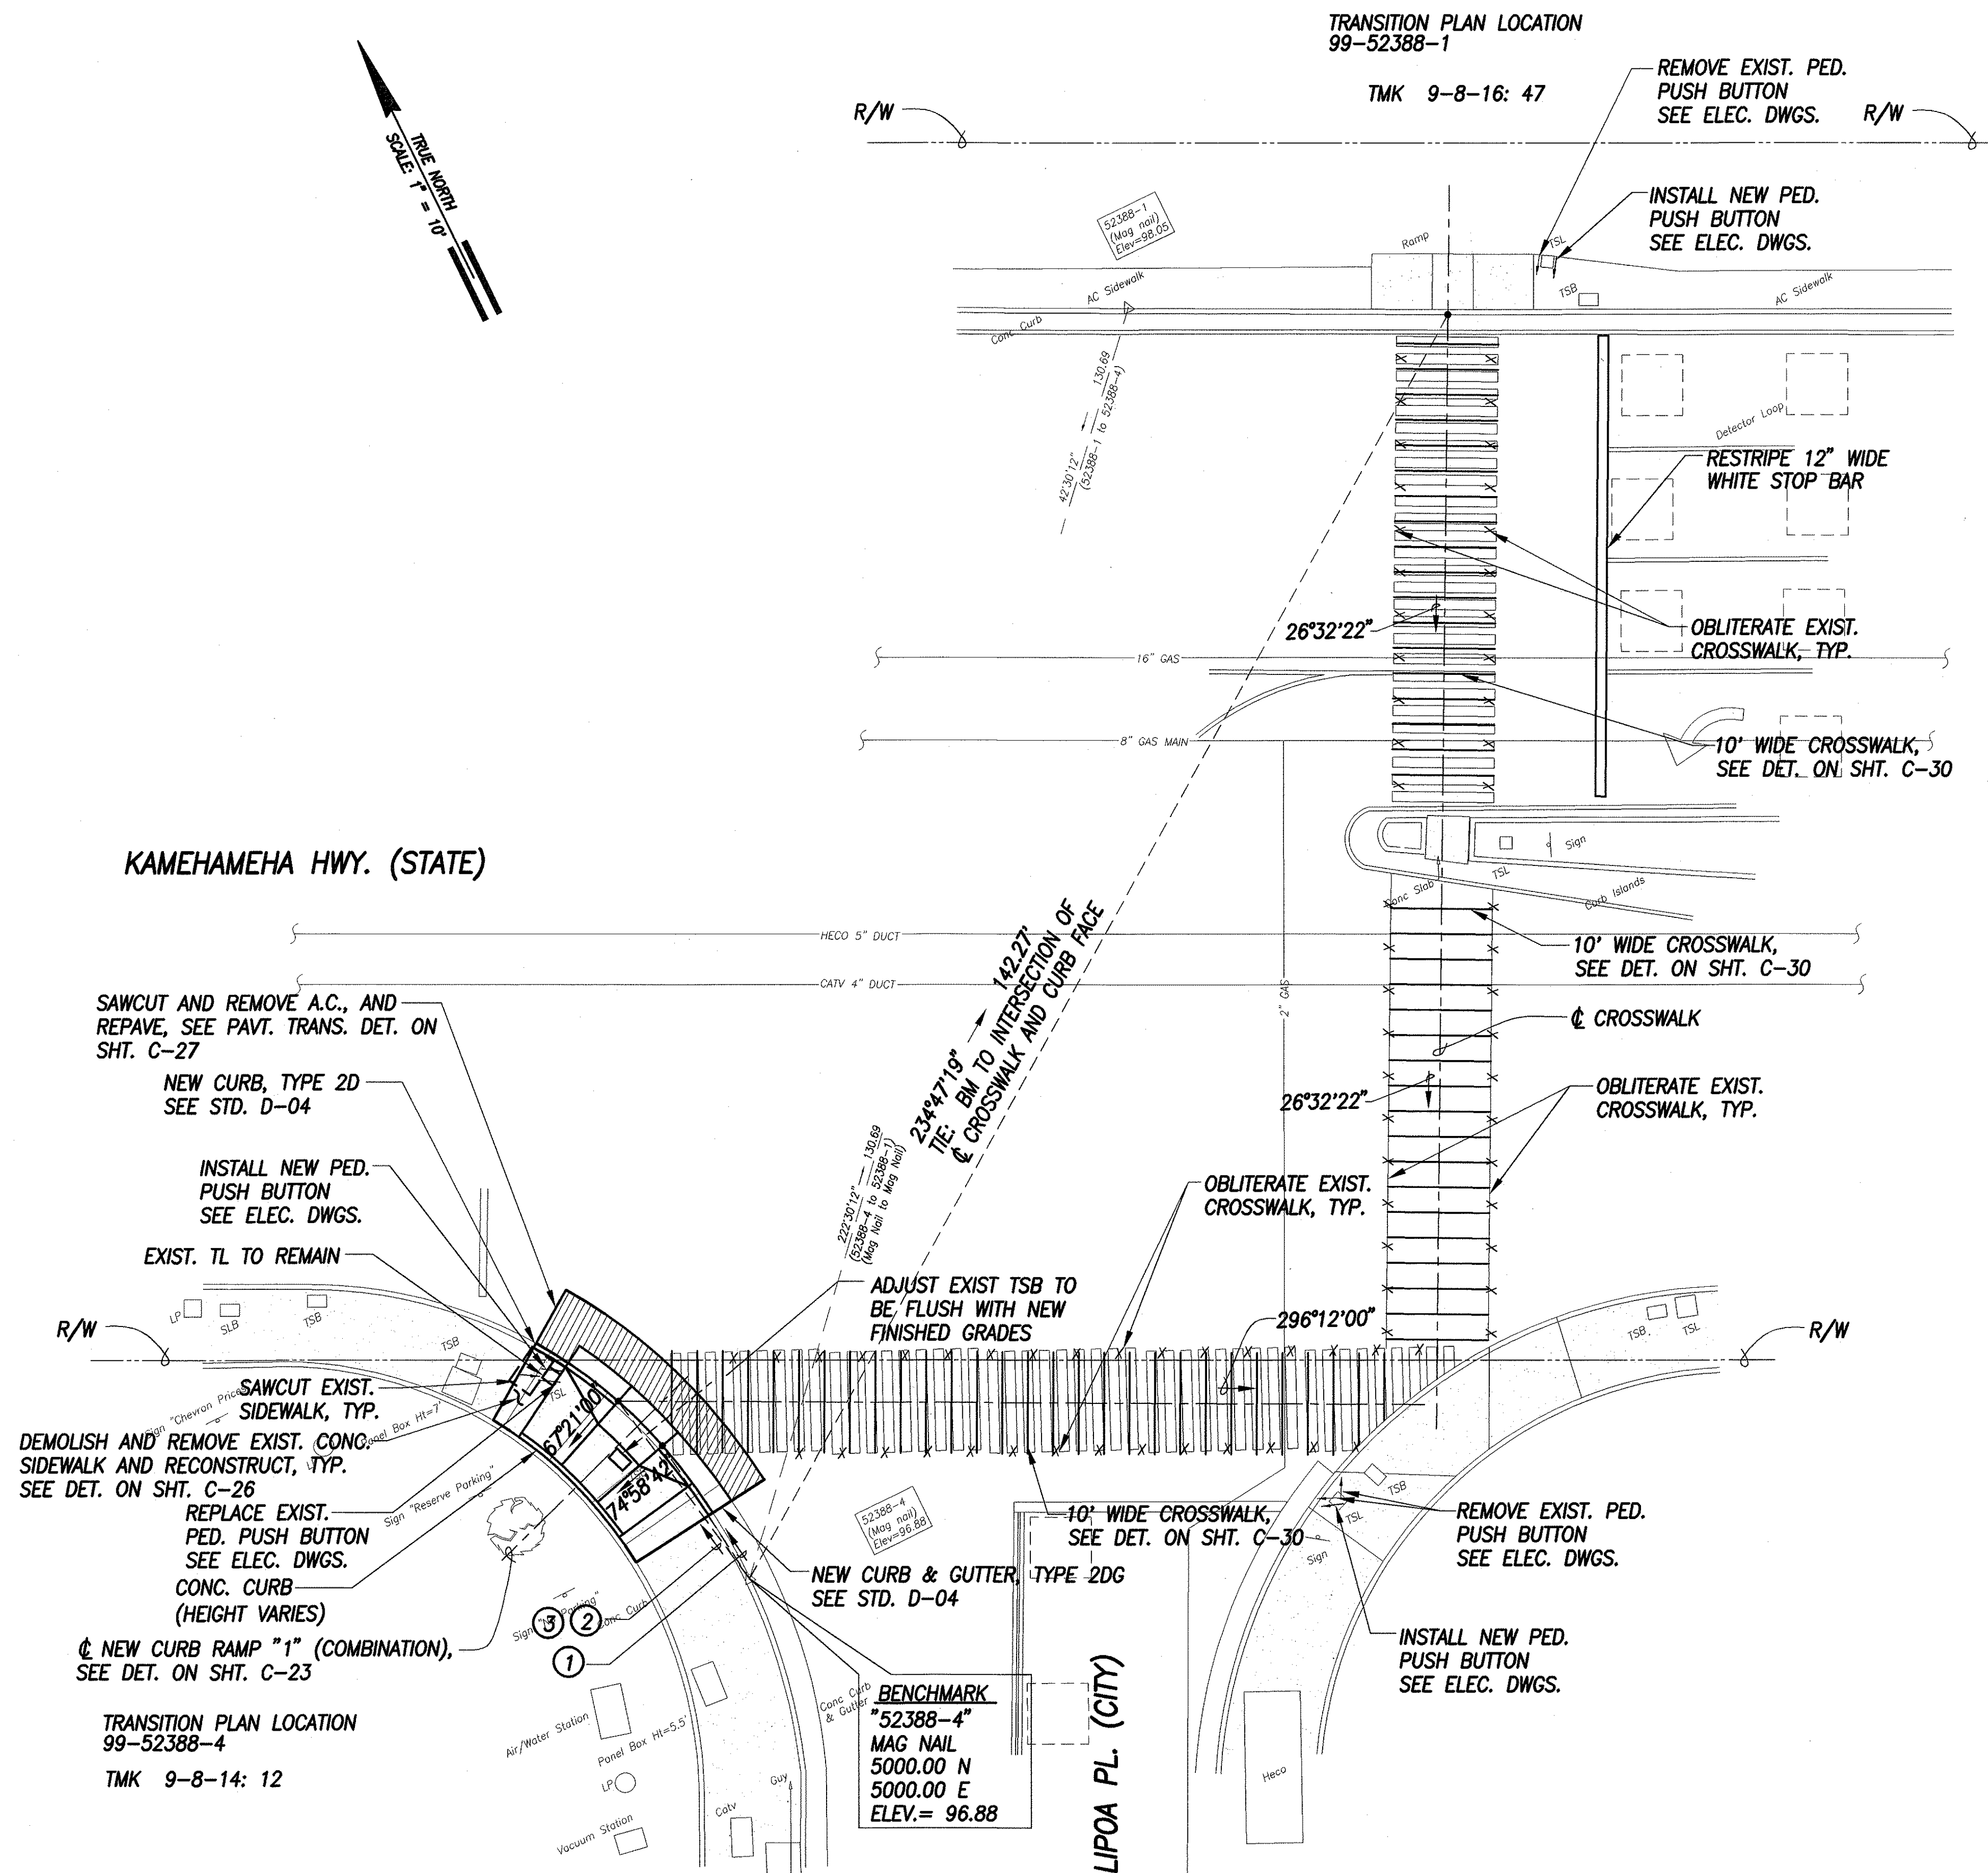

SURVEY PLOTTED BY	DATE
DRAWN BY	
DESIGNED BY	
QUANTITIES BY	
CHECKED BY	
ORIGINAL PLAN	
NOTE BOOK	
No.	

SITE PLAN - KAMEHAMEHA HWY. & LIPOA PL.
INTERS. ID NO. 99-52388
 SCALE: 1" = 10'

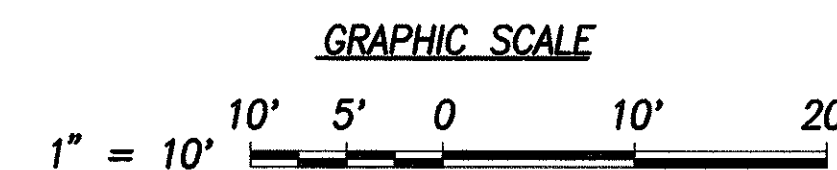

THIS WORK WAS PREPARED BY ME OR UNDER MY SUPERVISION AND CONSTRUCTION OF THIS PROJECT WILL BE UNDER MY OBSERVATION.

SIGNATURE: *Greg H. Hiyaunoto* DATE: April 30, 2006

"OBSERVATION OF CONSTRUCTION" IS DEFINED IN CHAPTER 16-115, HAWAII ADMINISTRATIVE RULES ENTITLED "PROFESSIONAL ENGINEERS, ARCHITECTS, SURVEYORS AND LANDSCAPE ARCHITECTS".

STATE OF HAWAII
 DEPARTMENT OF TRANSPORTATION
 HIGHWAYS DIVISION


SITE PLAN
KAMEHAMEHA HWY. & LIPOA PL.

*Pedestrian Facilities & ADA Compliance
 at Various Locations on Oahu, Unit 5*
 Fed. Aid Proj. No. CMAQ-0300(96)

Scale: 1" = 10'-0" Date: August 2004


SHEET No. C-39 OF 153 SHEETS

FED. ROAD DIST. NO.	STATE	FED. AID PROJ. NO.	FISCAL YEAR	SHEET NO.	TOTAL SHEETS
HAWAII	HAW.	CMAQ-0300(96)	2004	42	153

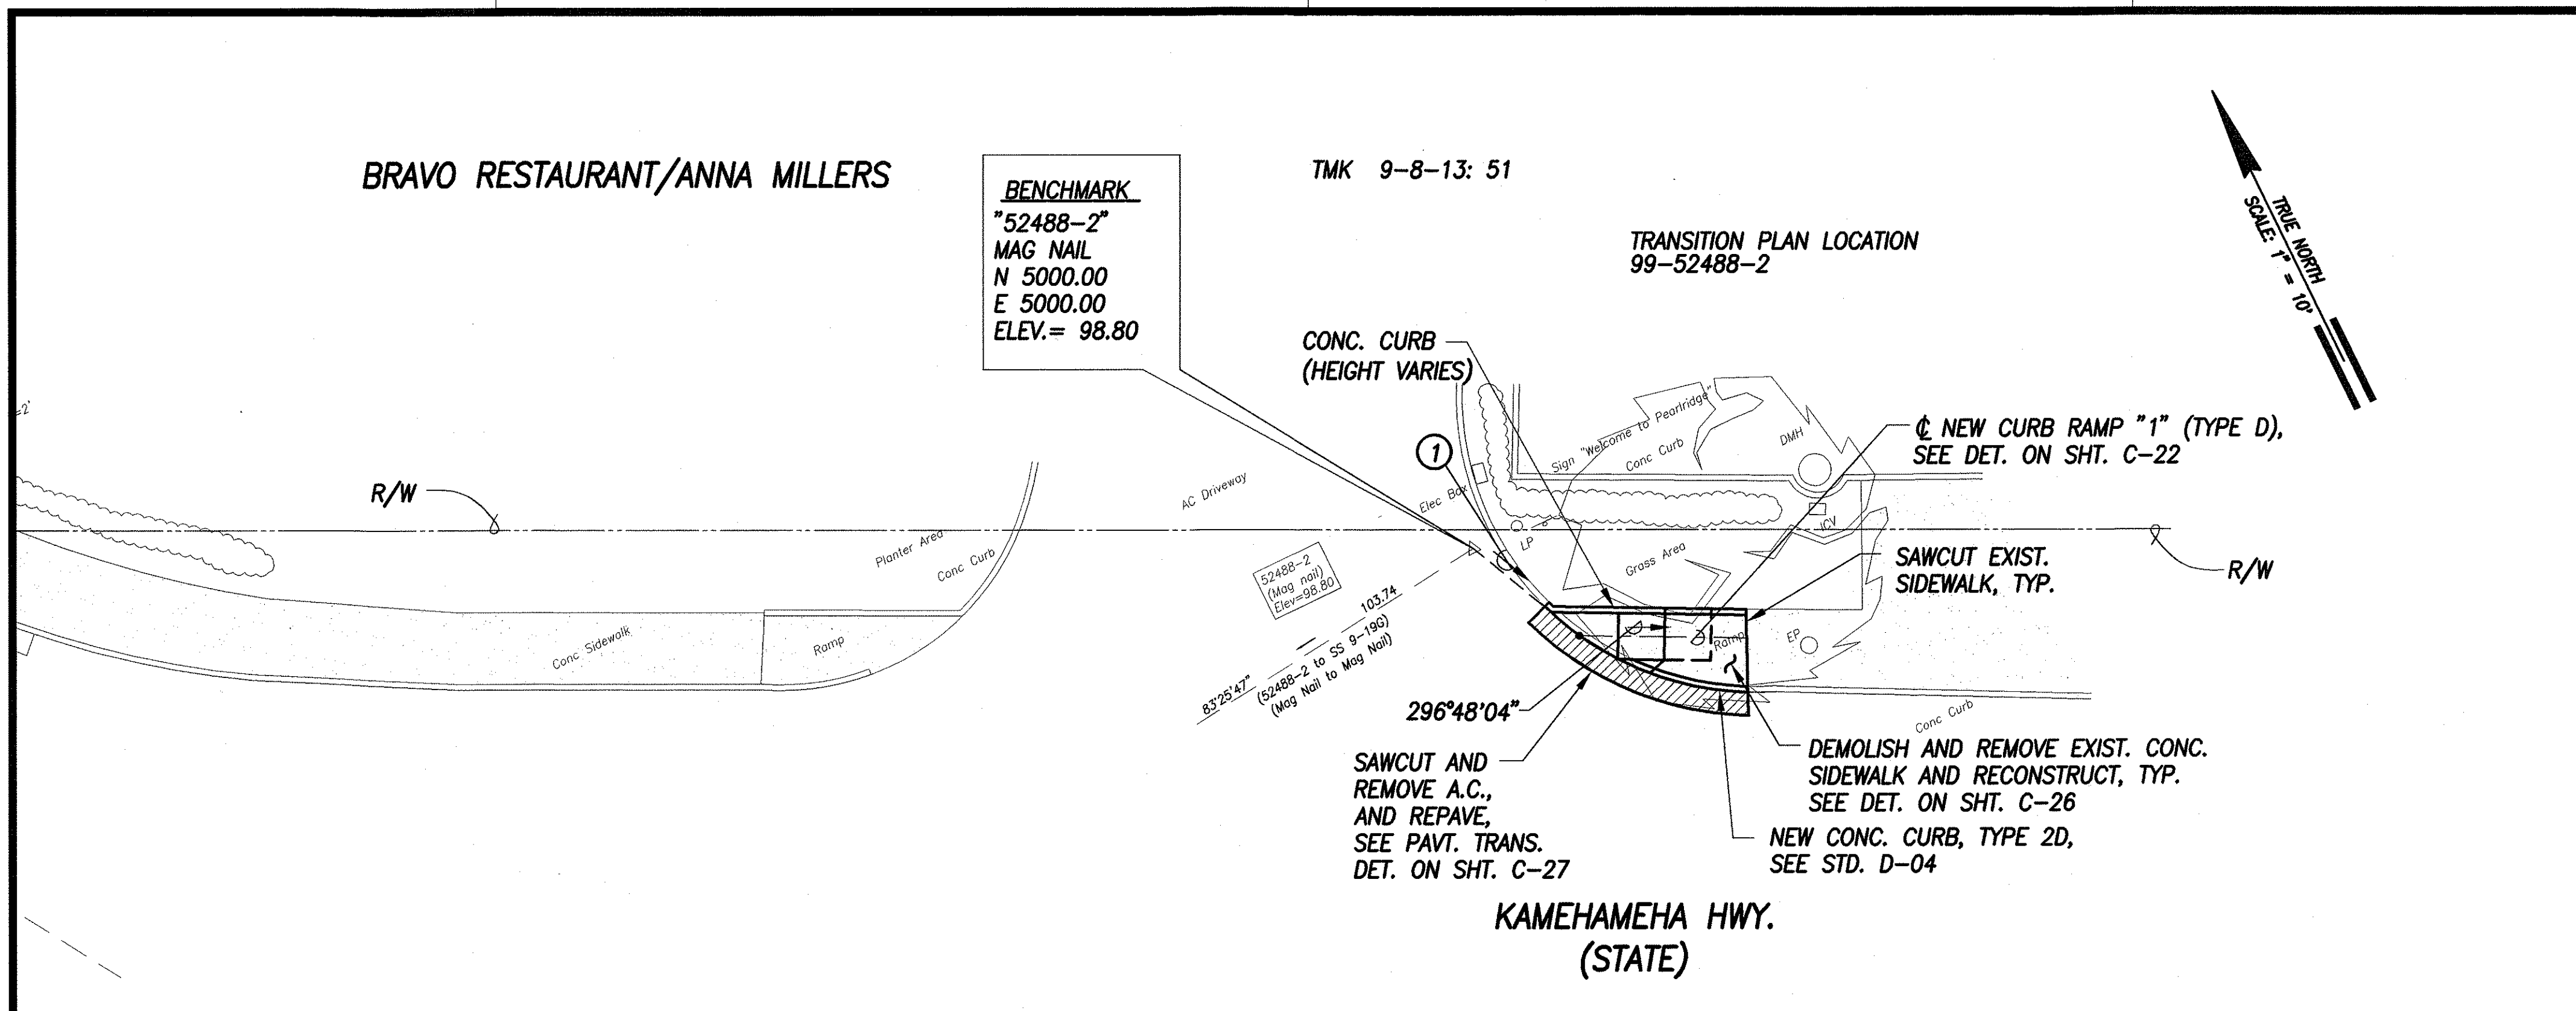


SITE PLAN - KAMEHAMEHA HWY. & BRAVO RESTAURANT
 INTERS. ID NO. 99-52488
 SCALE: 1" = 10'

① 335°37'15" 11.89'
 TIE: BM TO INTERSECTION OF RAMP AND CURB FACE

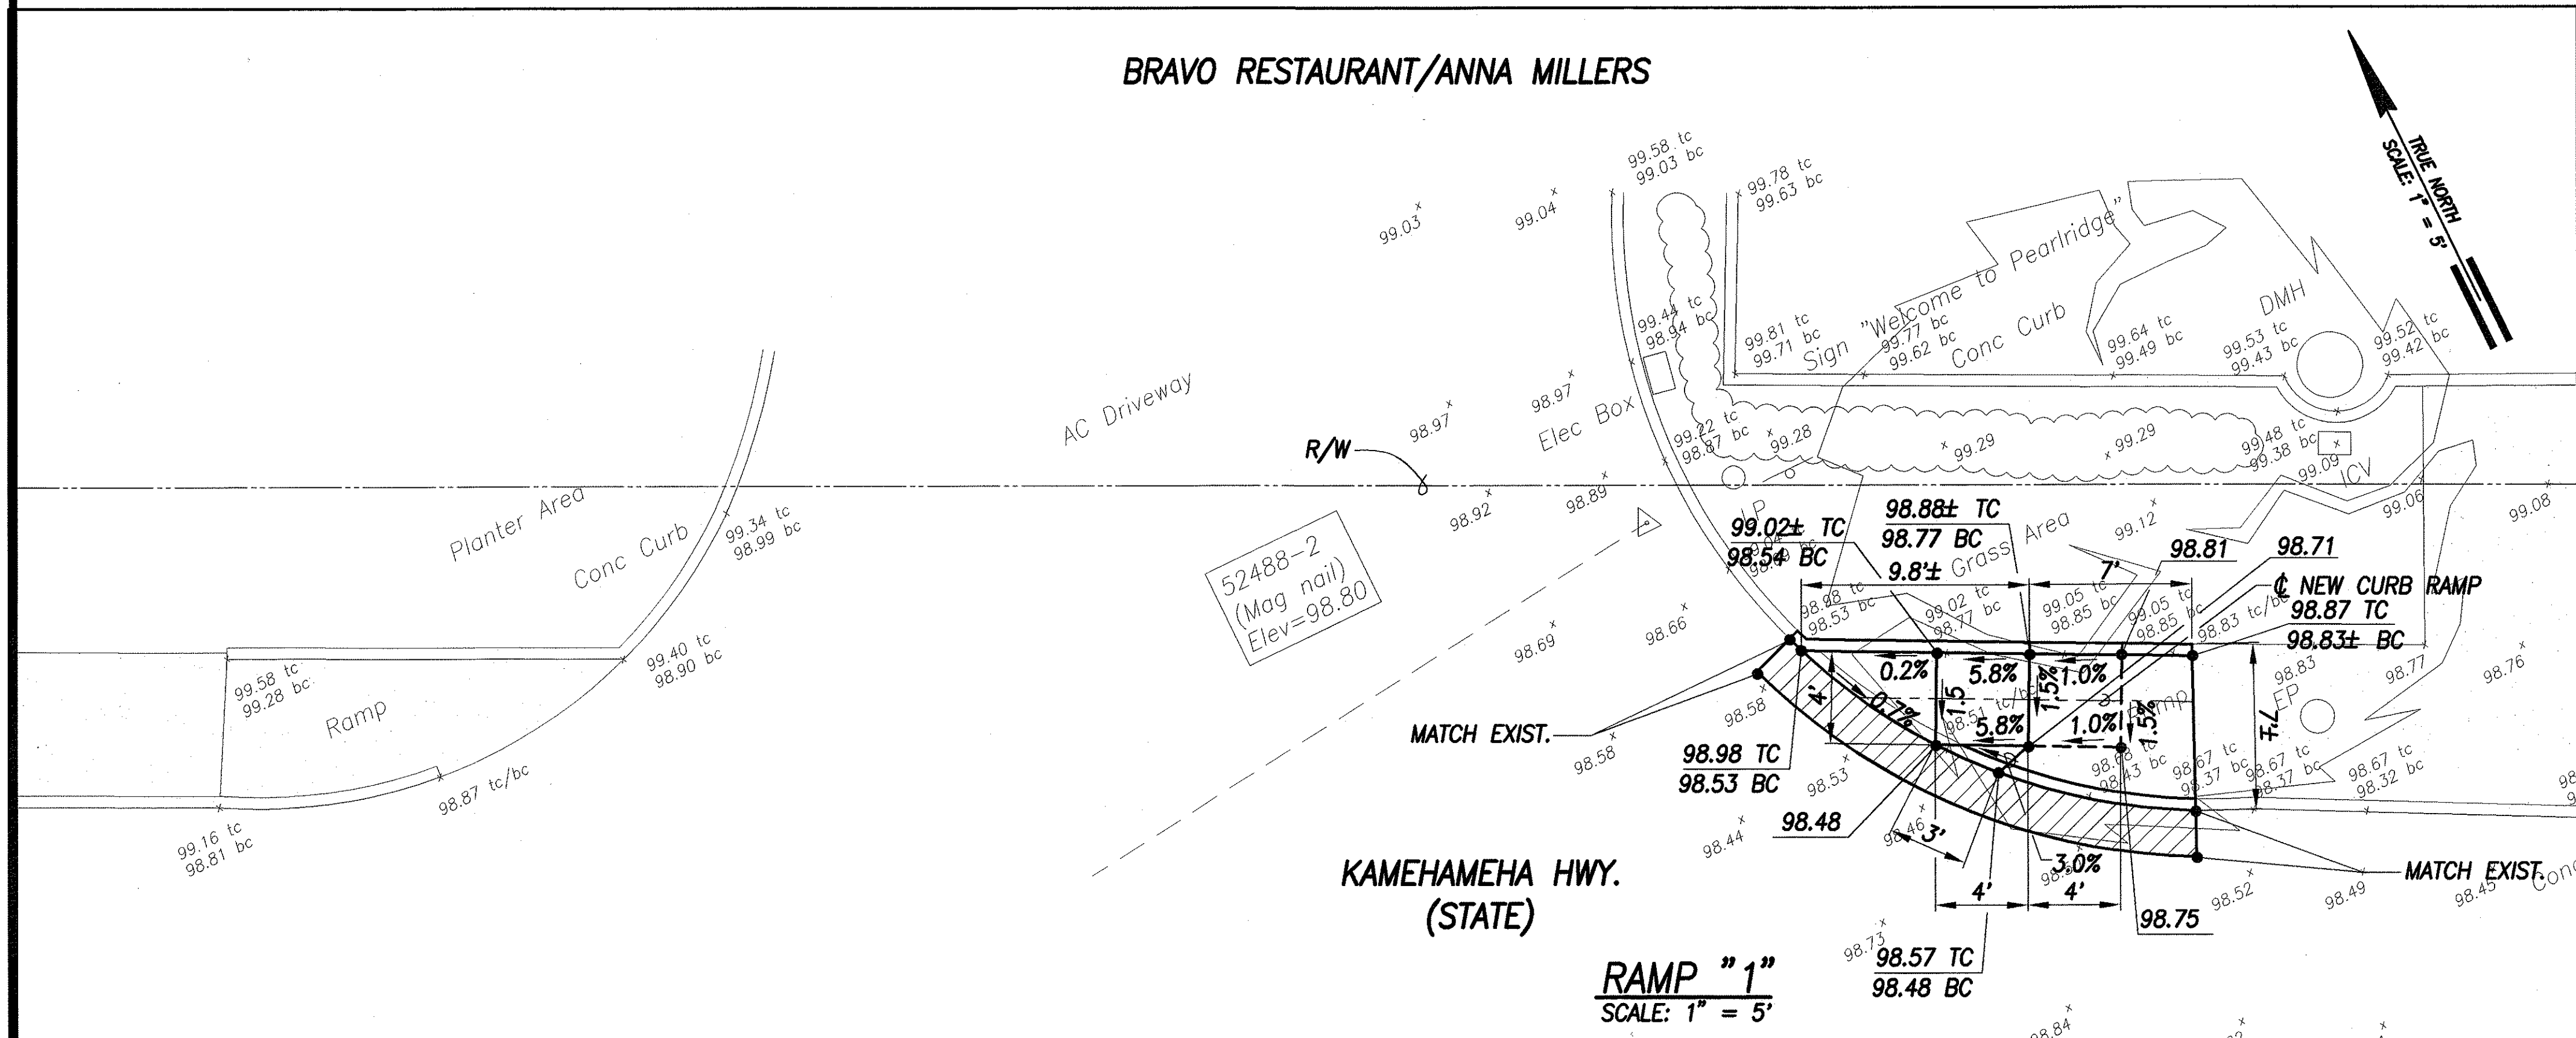

FED. ROAD DIST. NO.	STATE	FED. AID PROJ. NO.	FISCAL YEAR	SHEET NO.	TOTAL SHEETS
HAWAII	HAW.	CMAQ-0300(96)	2004	43	153

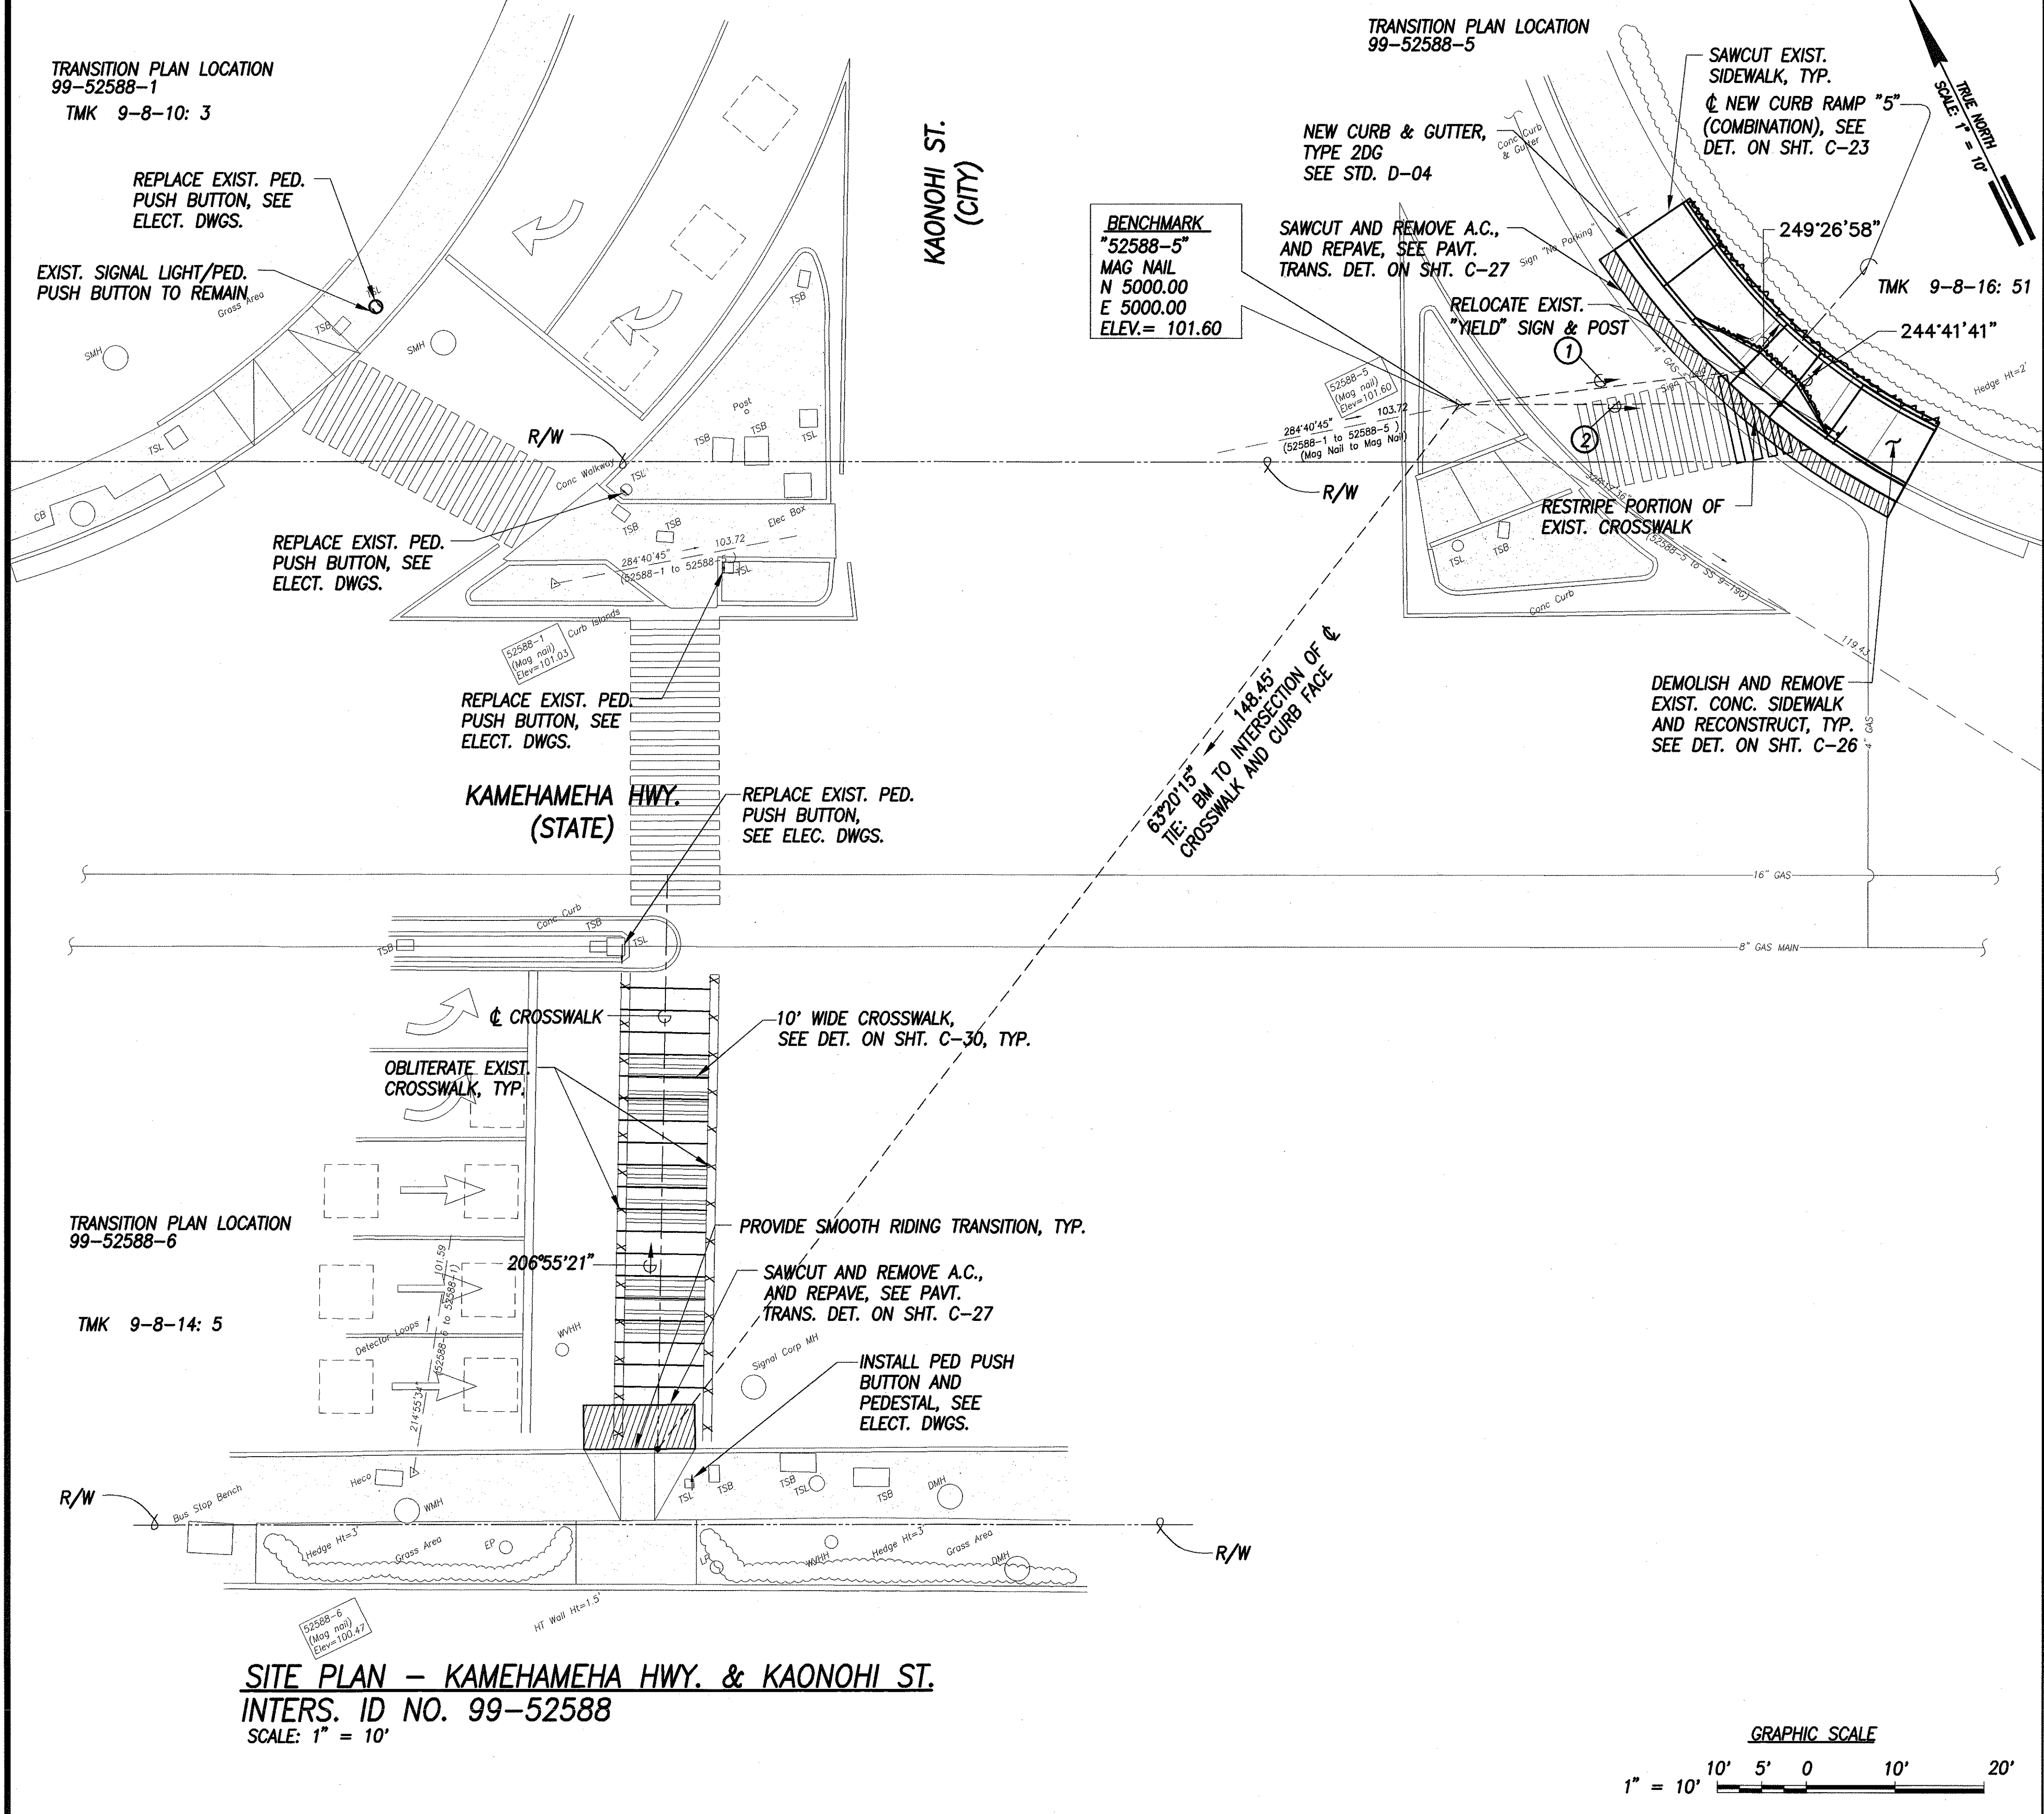

- 289°10'54" 32.02'
TIE: BM TO INTERSECTION OF RAMP
EDGE AND CURB FACE
- 295°49'30" 36.02'
TIE: BM TO INTERSECTION OF RAMP
EDGE AND CURB FACE

SURVEY PLATTED BY	DATE
DRAWN BY	
DESIGNED BY	
QUANTITIES BY	
CHECKED BY	
ORIGINAL PLAN	
NOTE BOOK	
No.	

SITE PLAN - KAMEHAMEHA HWY. & KAONOHI ST.
 INTERS. ID NO. 99-52588
 SCALE: 1" = 10'



THIS WORK WAS PREPARED BY ME OR UNDER MY SUPERVISION AND CONSTRUCTION OF THIS PROJECT WILL BE UNDER MY OBSERVATION.


SIGNATURE *Greg H. HiyaKuno* DATE *April 30, 2006*

"OBSERVATION OF CONSTRUCTION" IS DEFINED IN CHAPTER 16-115, HAWAII ADMINISTRATIVE RULES ENTITLED "PROFESSIONAL ENGINEERS, ARCHITECTS, SURVEYORS AND LANDSCAPE ARCHITECTS".

STATE OF HAWAII
 DEPARTMENT OF TRANSPORTATION
 HIGHWAYS DIVISION
SITE PLAN
KAMEHAMEHA HWY. & KAONOHI ST.
Pedestrian Facilities & ADA Compliance at Various Locations on Oahu, Unit 5
 Fed. Aid Proj. No. CMAQ-0300(96)
 Scale: 1" = 10'-0" Date: August 2004
SHEET No. C-42 OF 153 SHEETS


FED. ROAD DIST. NO.	STATE	FED. AID PROJ. NO.	FISCAL YEAR	SHEET NO.	TOTAL SHEETS
HAWAII	HAW.	CMAQ-0300(96)	2004	46	153

① 32°01'56" 113.08'
TIE: BM TO INTERSECTION OF
RAMP AND CURB FACE

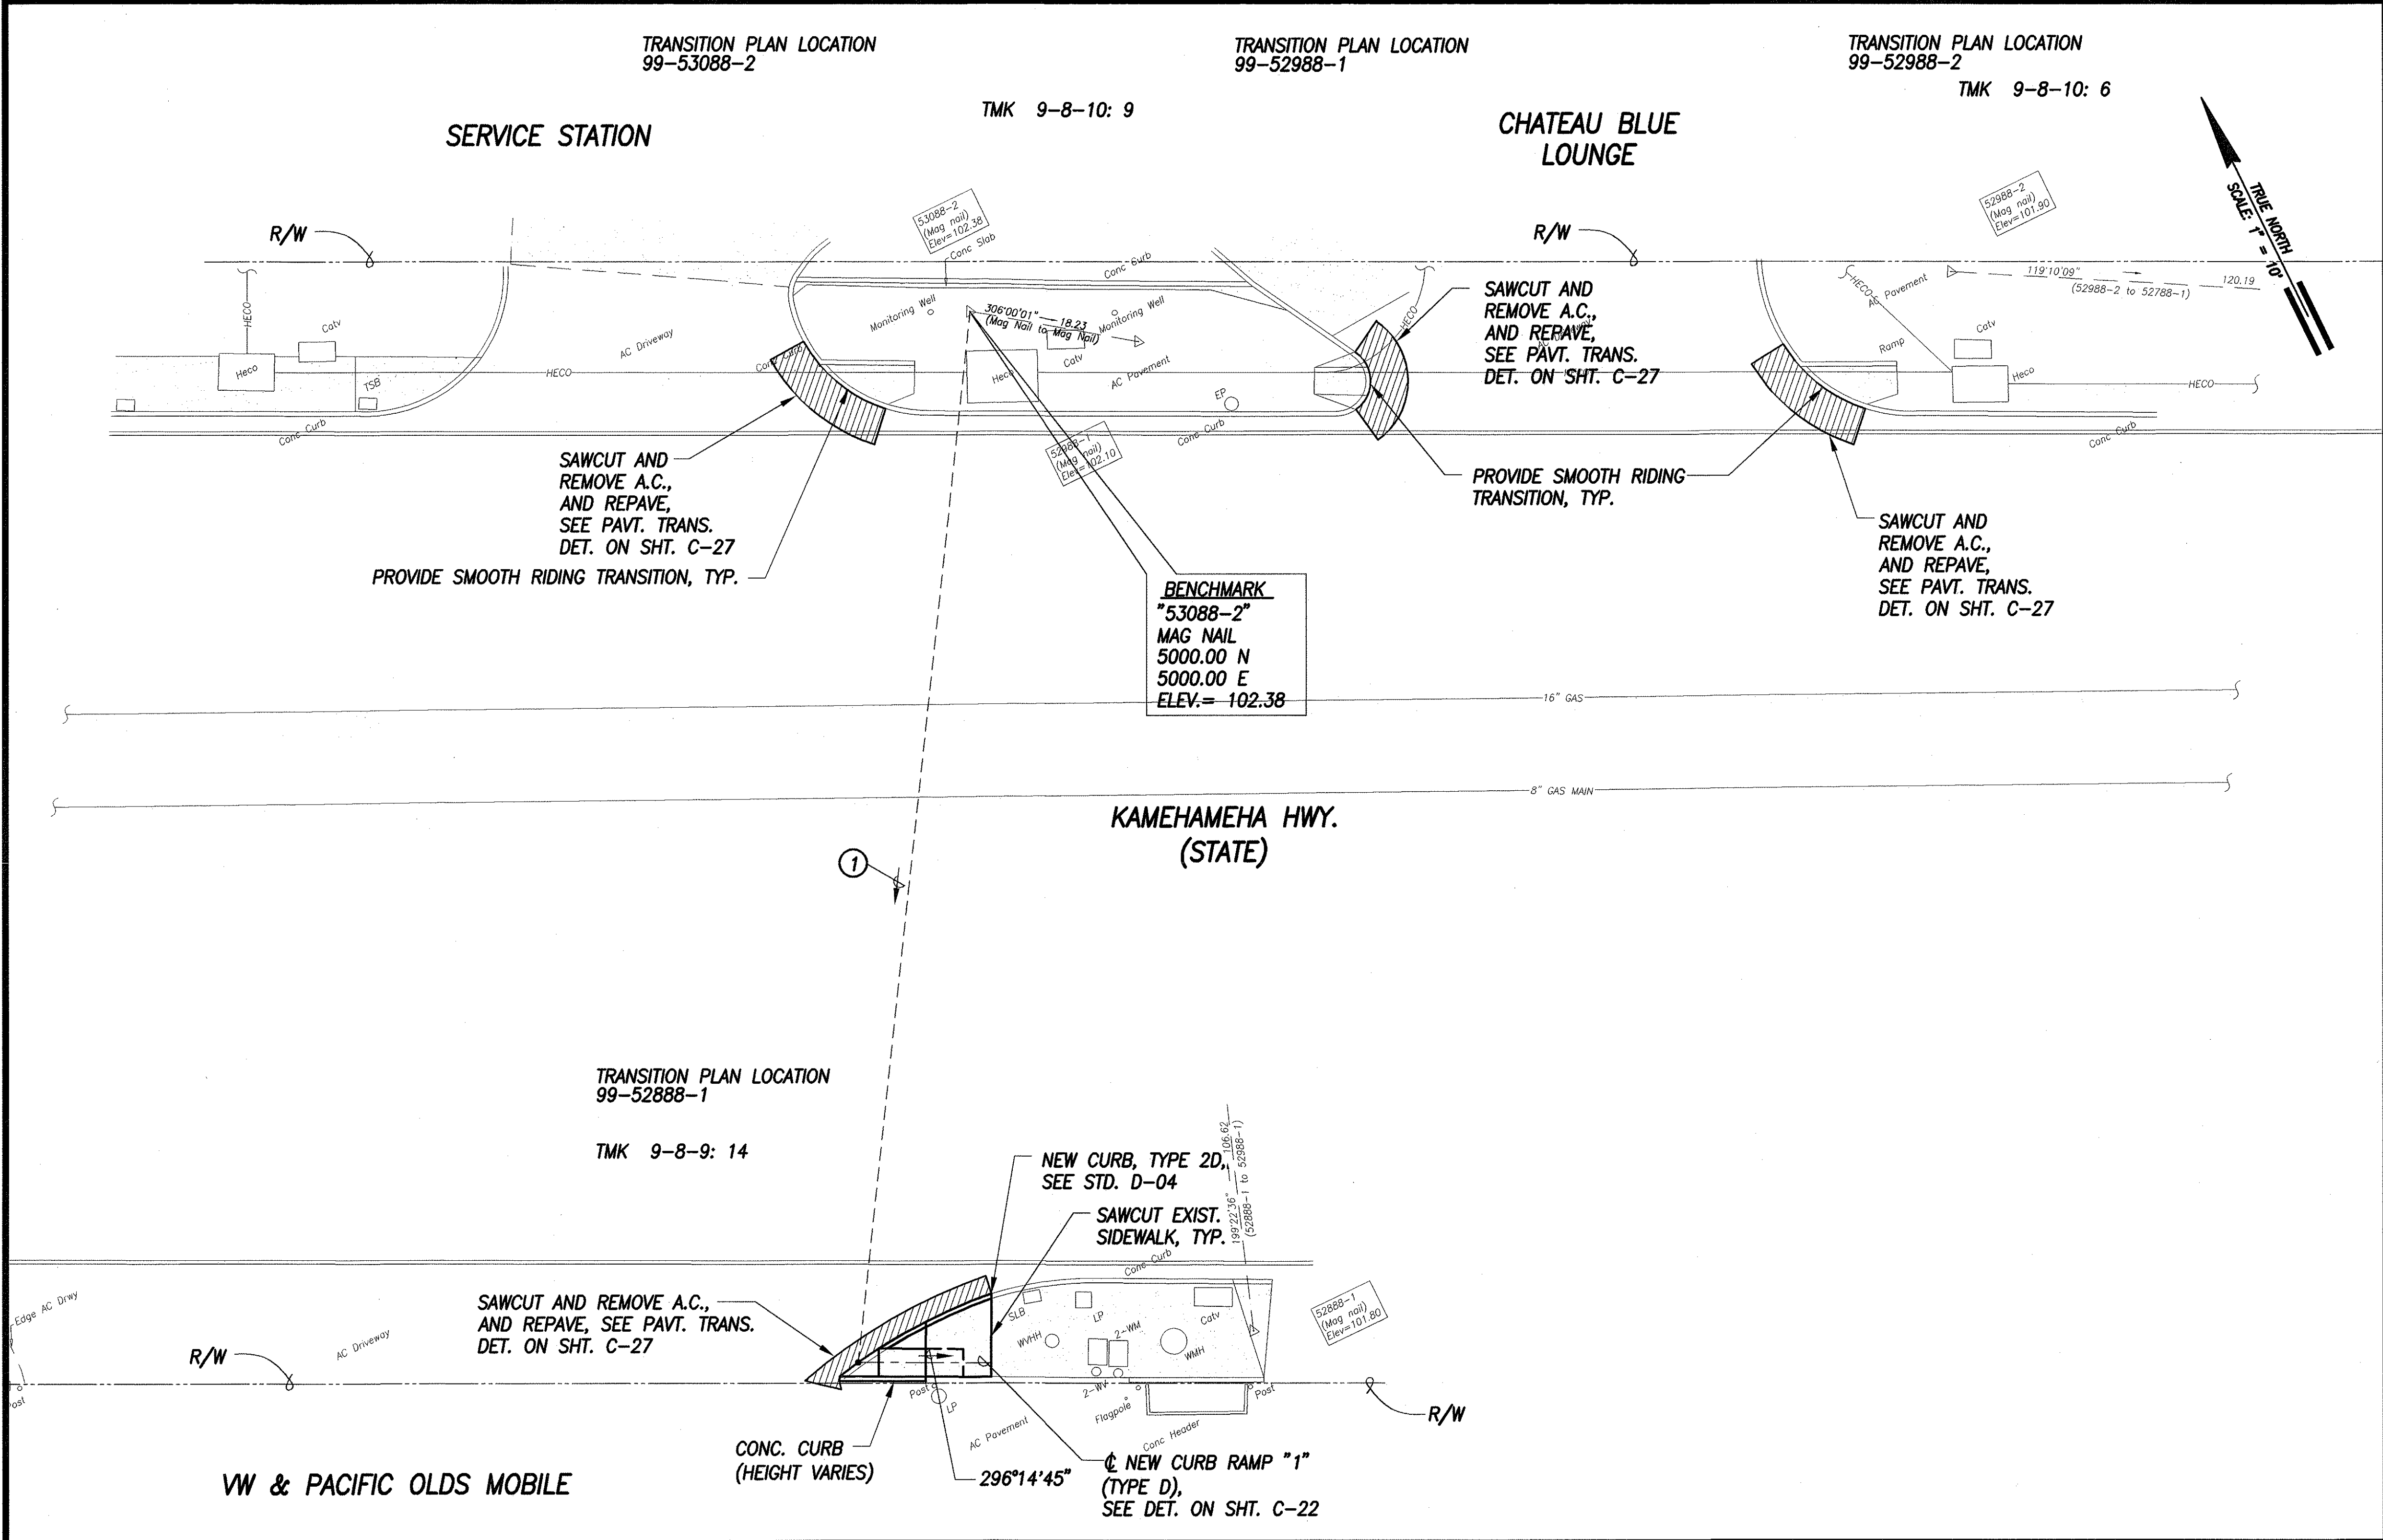


ORIGINAL PLAN	SURVEY PLATTED BY	DATE
	DRAWN BY	
	TRACED BY	
	DESIGNED BY	
NOTE BOOK	QUANTITIES BY	
	CHECKED BY	
No.		

**SITE PLAN - KAMEHAMEHA HWY., VW & PACIFIC OLDS MOBILE,
CHATEAU BLUE LOUNGE & SERVICE STATION**
INTERS. ID NOS. 99-52888, 99-52988 & 99-53088
SCALE: 1" = 10'

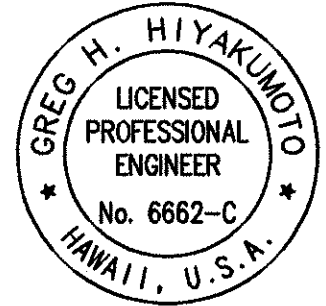

THIS WORK WAS PREPARED BY ME OR UNDER
MY SUPERVISION AND CONSTRUCTION OF THIS
PROJECT WILL BE UNDER MY OBSERVATION.

SIGNATURE *Greg H. Hiyakumoto* DATE April 30, 2006
"OBSERVATION OF CONSTRUCTION" IS DEFINED
IN CHAPTER 16-115, HAWAII ADMINISTRATIVE
RULES ENTITLED "PROFESSIONAL ENGINEERS,
ARCHITECTS, SURVEYORS AND LANDSCAPE
ARCHITECTS".


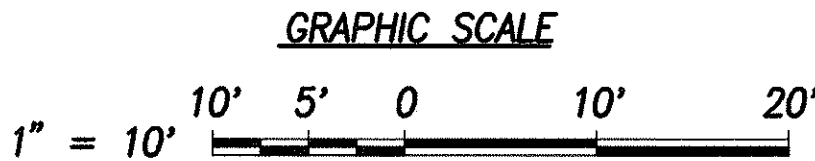


STATE OF HAWAII
DEPARTMENT OF TRANSPORTATION
HIGHWAYS DIVISION
**SITE PLAN - KAMEHAMEHA HWY., VW & PACIFIC
OLDSMOBILE, CHATEAU BLUE LOUNGE & SERVICE STATION**
Pedestrian Facilities & ADA Compliance
at Various Locations on Oahu, Unit 5
Fed. Aid Proj. No. CMAQ-0300(96)
Scale: 1" = 10'-0" Date: August 2004
SHEET No. C-45 OF 153 SHEETS

46

FED. ROAD DIST. NO.	STATE	FED. AID PROJ. NO.	FISCAL YEAR	SHEET NO.	TOTAL SHEETS
HAWAII	HAW.	CMAQ-0300(96)	2004	49	153

- 191°15'13" 100.32'
TIE: BM TO INTERSECTION OF RAMP
EDGE AND CURB FACE
- 16°37'43" 103.91'
TIE: BM TO INTERSECTION OF RAMP
EDGE AND CURB FACE
- 345°26'59" 139.47'
TIE: BM TO INTERSECTION OF RAMP
EDGE AND CURB FACE
- 342°58'27" 140.11'
TIE: BM TO INTERSECTION OF RAMP
EDGE AND CURB FACE

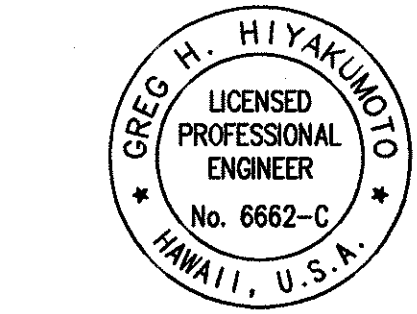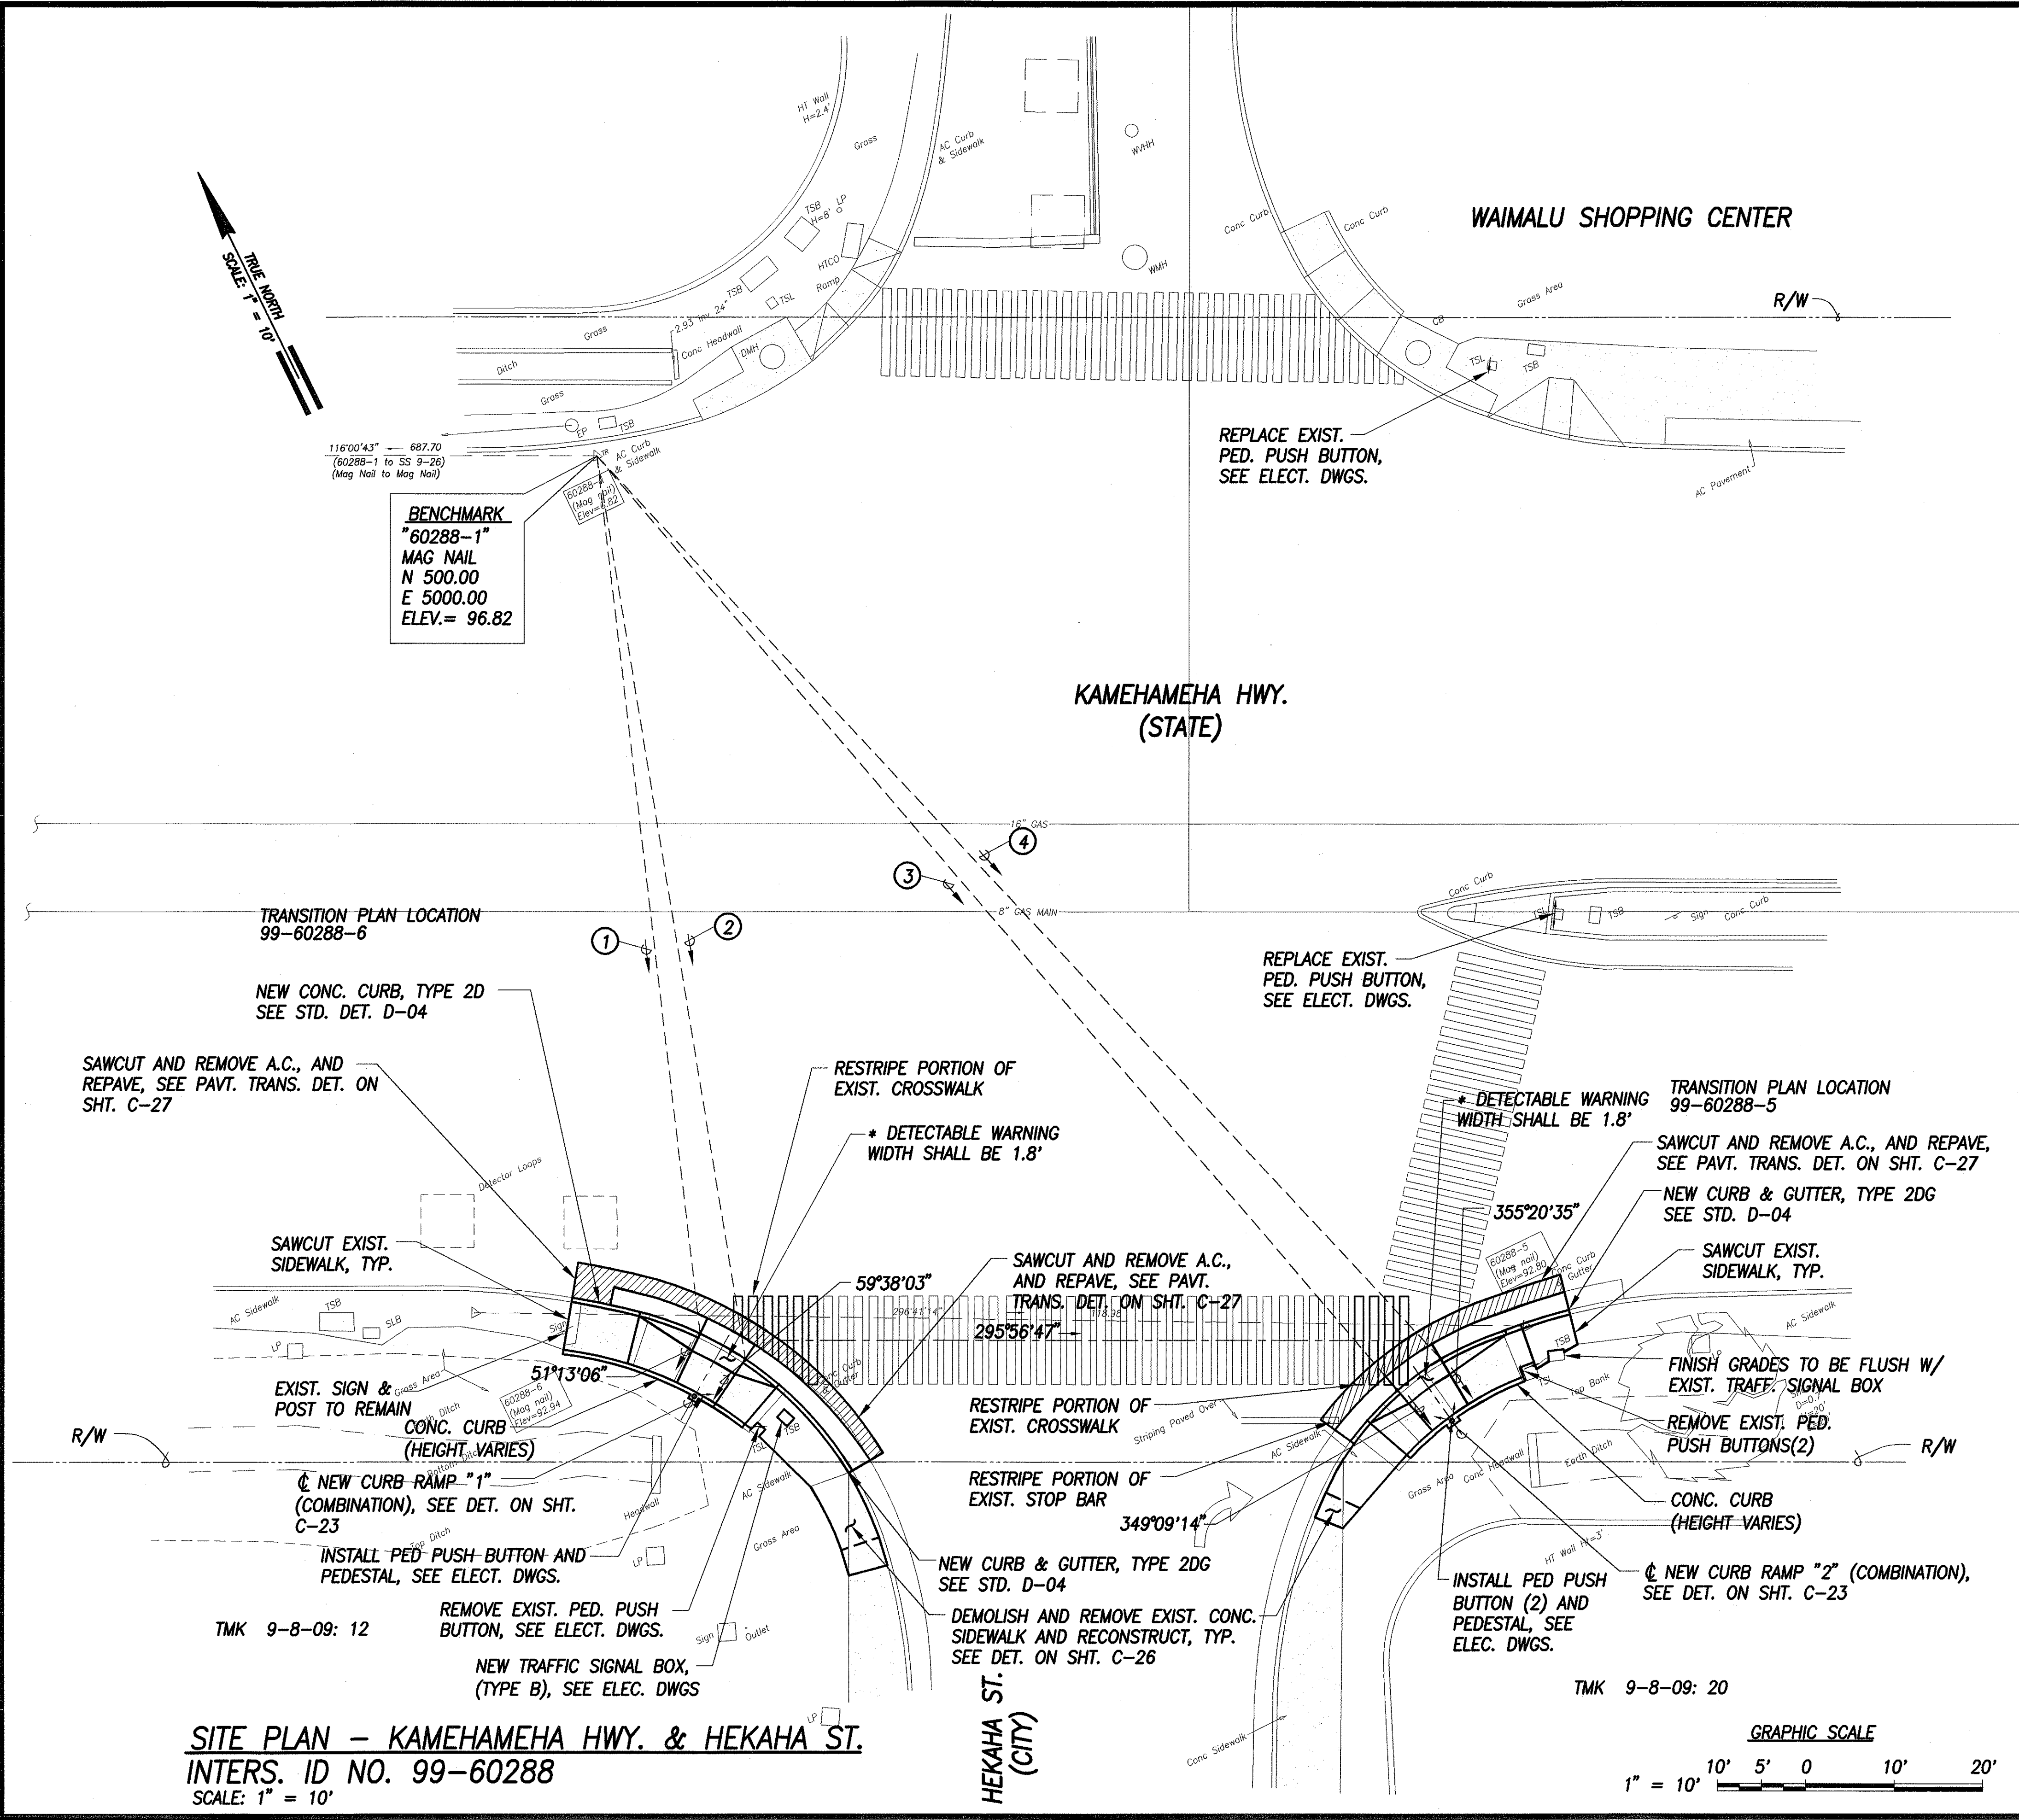


THIS WORK WAS PREPARED BY ME OR UNDER MY SUPERVISION AND CONSTRUCTION OF THIS PROJECT WILL BE UNDER MY OBSERVATION.

DATE: April 30, 2006
SIGNATURE: [Signature]
"OBSERVATION OF CONSTRUCTION" IS DEFINED IN CHAPTER 16-115, HAWAII ADMINISTRATIVE RULES ENTITLED "PROFESSIONAL ENGINEERS, ARCHITECTS, SURVEYORS AND LANDSCAPE ARCHITECTS".

STATE OF HAWAII
DEPARTMENT OF TRANSPORTATION
HIGHWAYS DIVISION
SITE PLAN
KAMEHAMEHA HWY. & HEKAHA ST.
Pedestrian Facilities & ADA Compliance at Various Locations on Oahu, Unit 5
Fed. Aid Proj. No. CMAQ-0300(96)
Scale: 1" = 10'-0"


Date: August 2004
SHEET No. C-48 OF 153 SHEETS
49

FED. ROAD DIST. NO.	STATE	FED. AID PROJ. NO.	FISCAL YEAR	SHEET NO.	TOTAL SHEETS
HAWAII	HAW.	CMAQ-0300(96)	2004	50	153

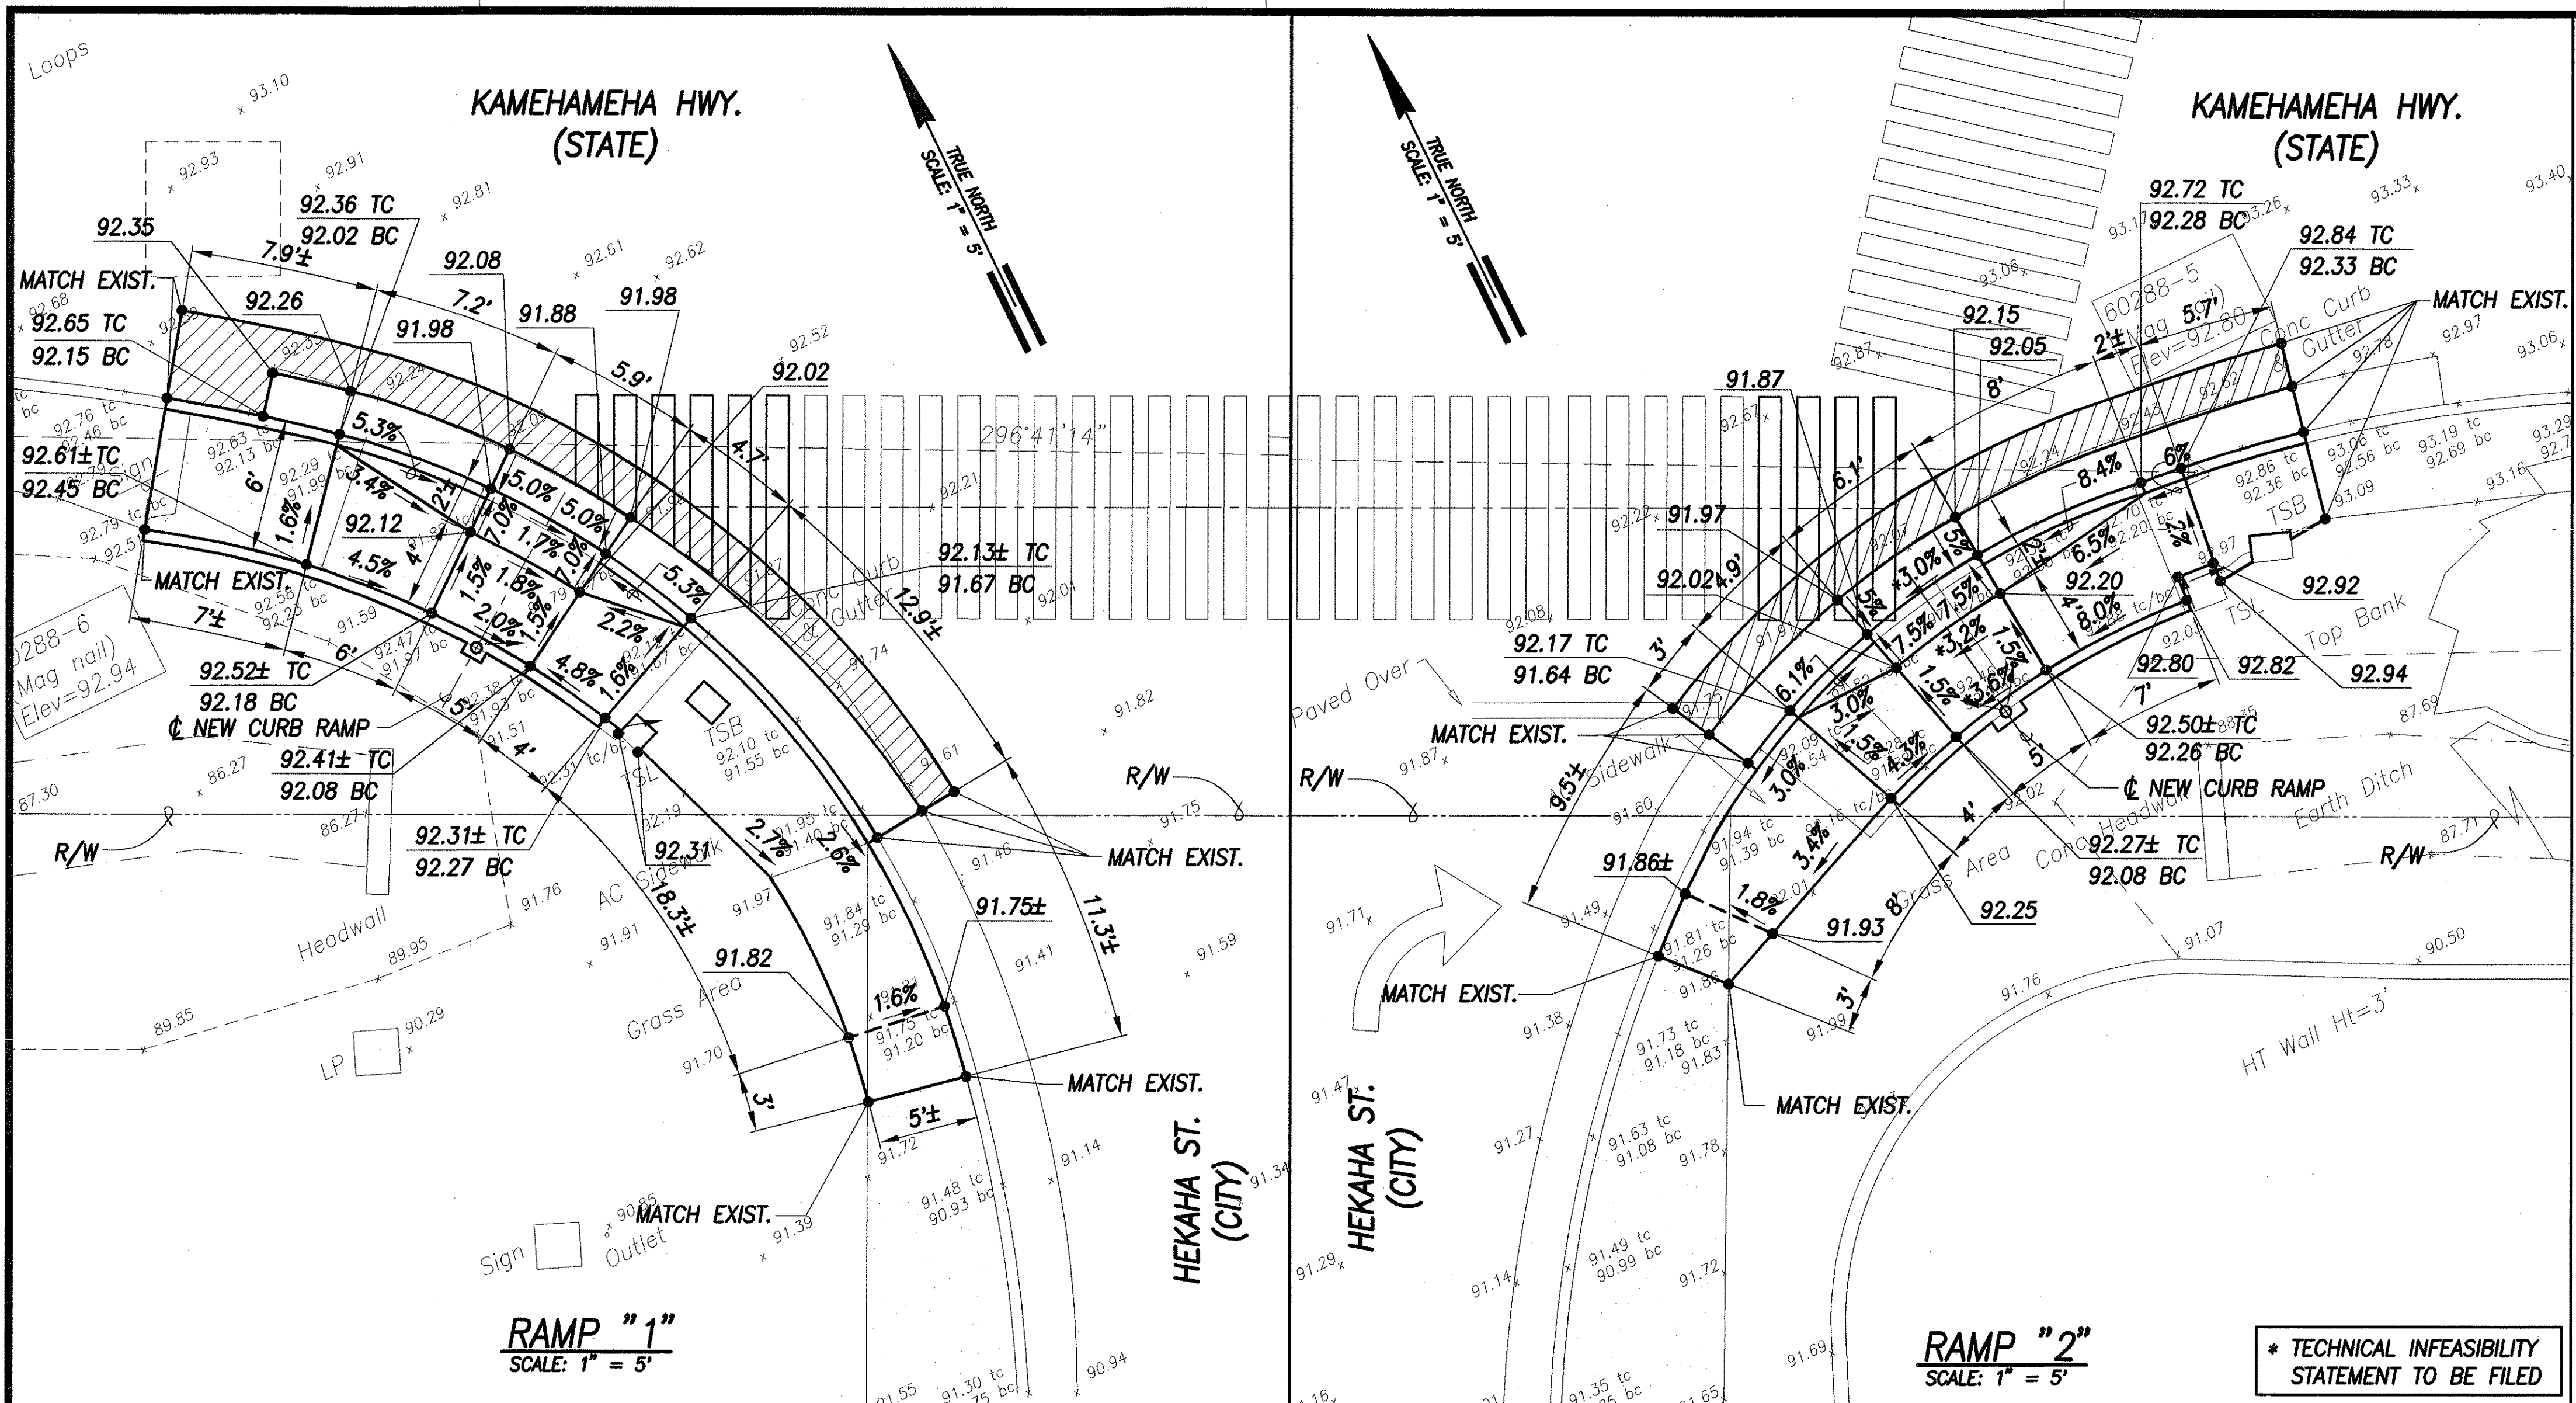

GRADING PLAN - KAMEHAMEHA HWY. & HEKAHA ST.
INTERS. ID NO. 99-60288
SCALE: 1" = 5'

ORIGINAL PLAN	SURVEY PLATTED BY	DATE
NOTE BOOK	DESIGNED BY	
IN.	CHECKED BY	

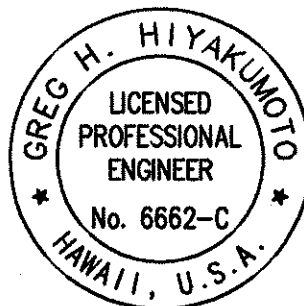



THIS WORK WAS PREPARED BY ME OR UNDER MY SUPERVISION AND CONSTRUCTION OF THIS PROJECT WILL BE UNDER MY OBSERVATION.

SIGNATURE: *Greg H. Hiyaunio* DATE: April 30, 2006


"OBSERVATION OF CONSTRUCTION" IS DEFINED IN CHAPTER 16-115, HAWAII ADMINISTRATIVE RULES ENTITLED "PROFESSIONAL ENGINEERS, ARCHITECTS, SURVEYORS AND LANDSCAPE ARCHITECTS".

STATE OF HAWAII
DEPARTMENT OF TRANSPORTATION
HIGHWAYS DIVISION
GRADING PLAN
KAMEHAMEHA HWY. & HEKAHA ST.
Pedestrian Facilities & ADA Compliance at Various Locations on Oahu, Unit 5
Fed. Aid Proj. No. CMAQ-0300(96)
Scale: 1" = 5'-0" Date: August 2004
SHEET No. C-49 OF 153 SHEETS


FED. ROAD DIST. NO.	STATE	FED. AID PROJ. NO.	FISCAL YEAR	SHEET NO.	TOTAL SHEETS
HAWAII	HAW.	CMAQ-0300(98)	2004	C.O. 52	153

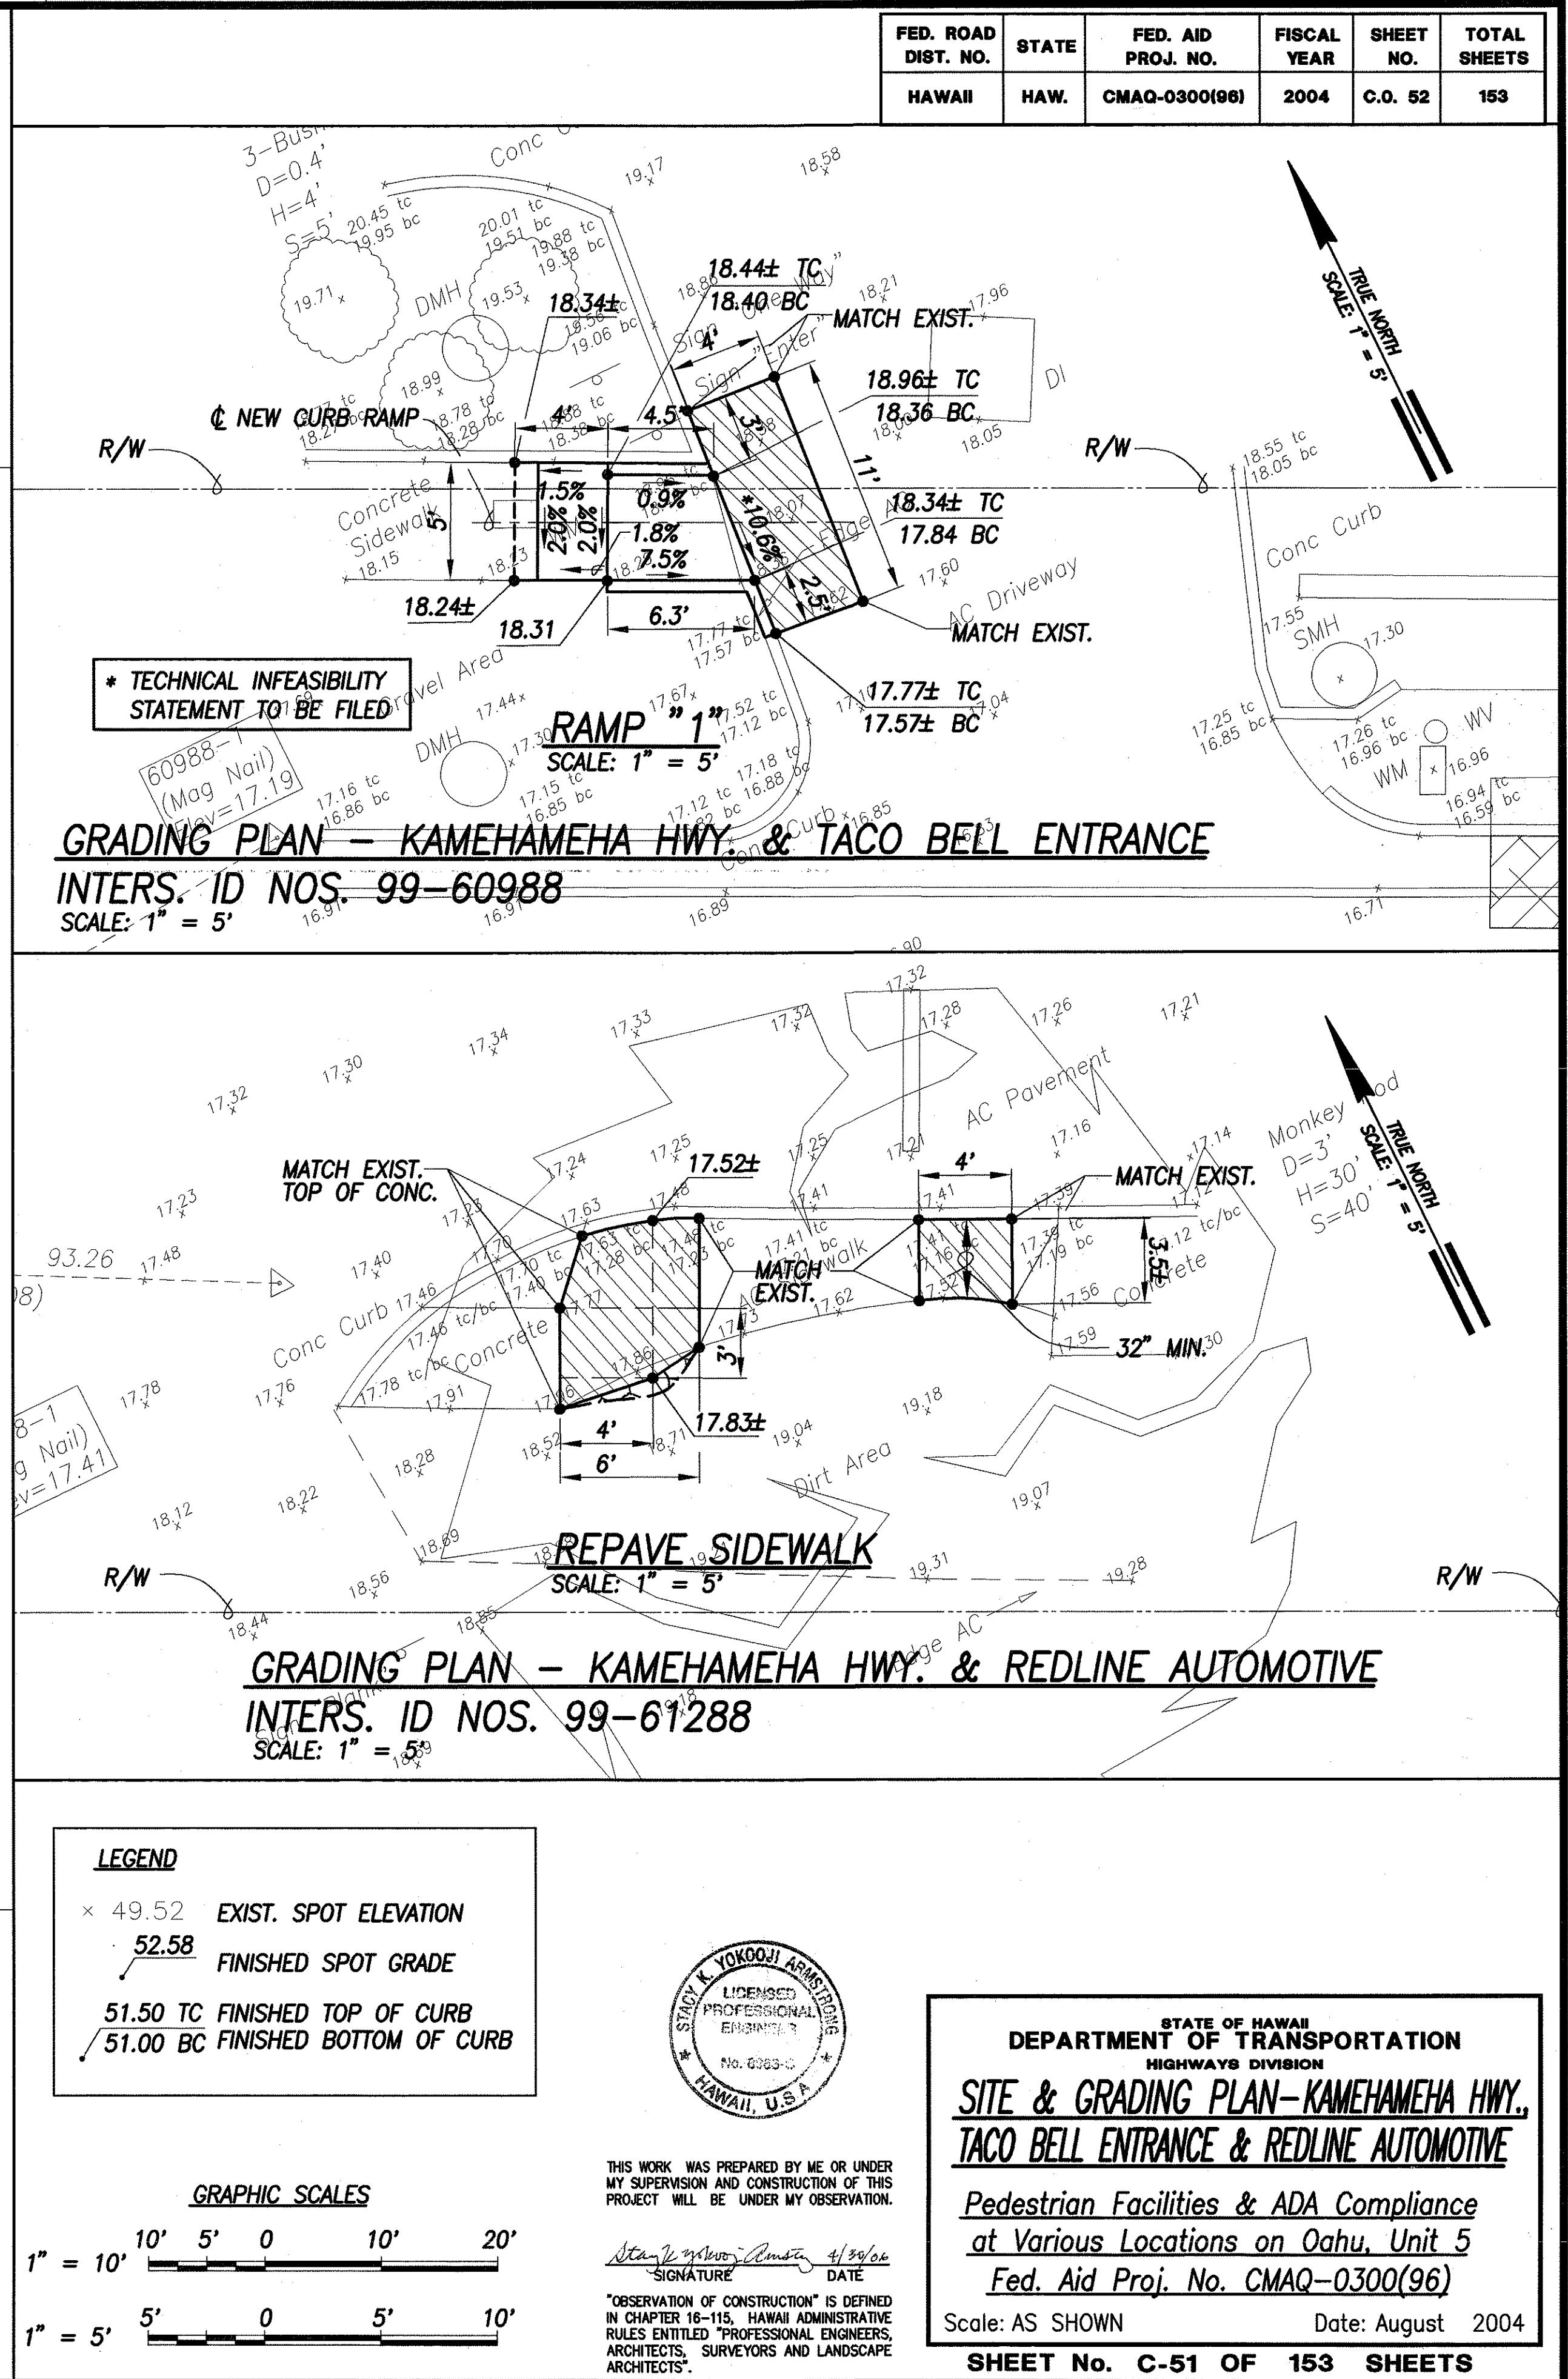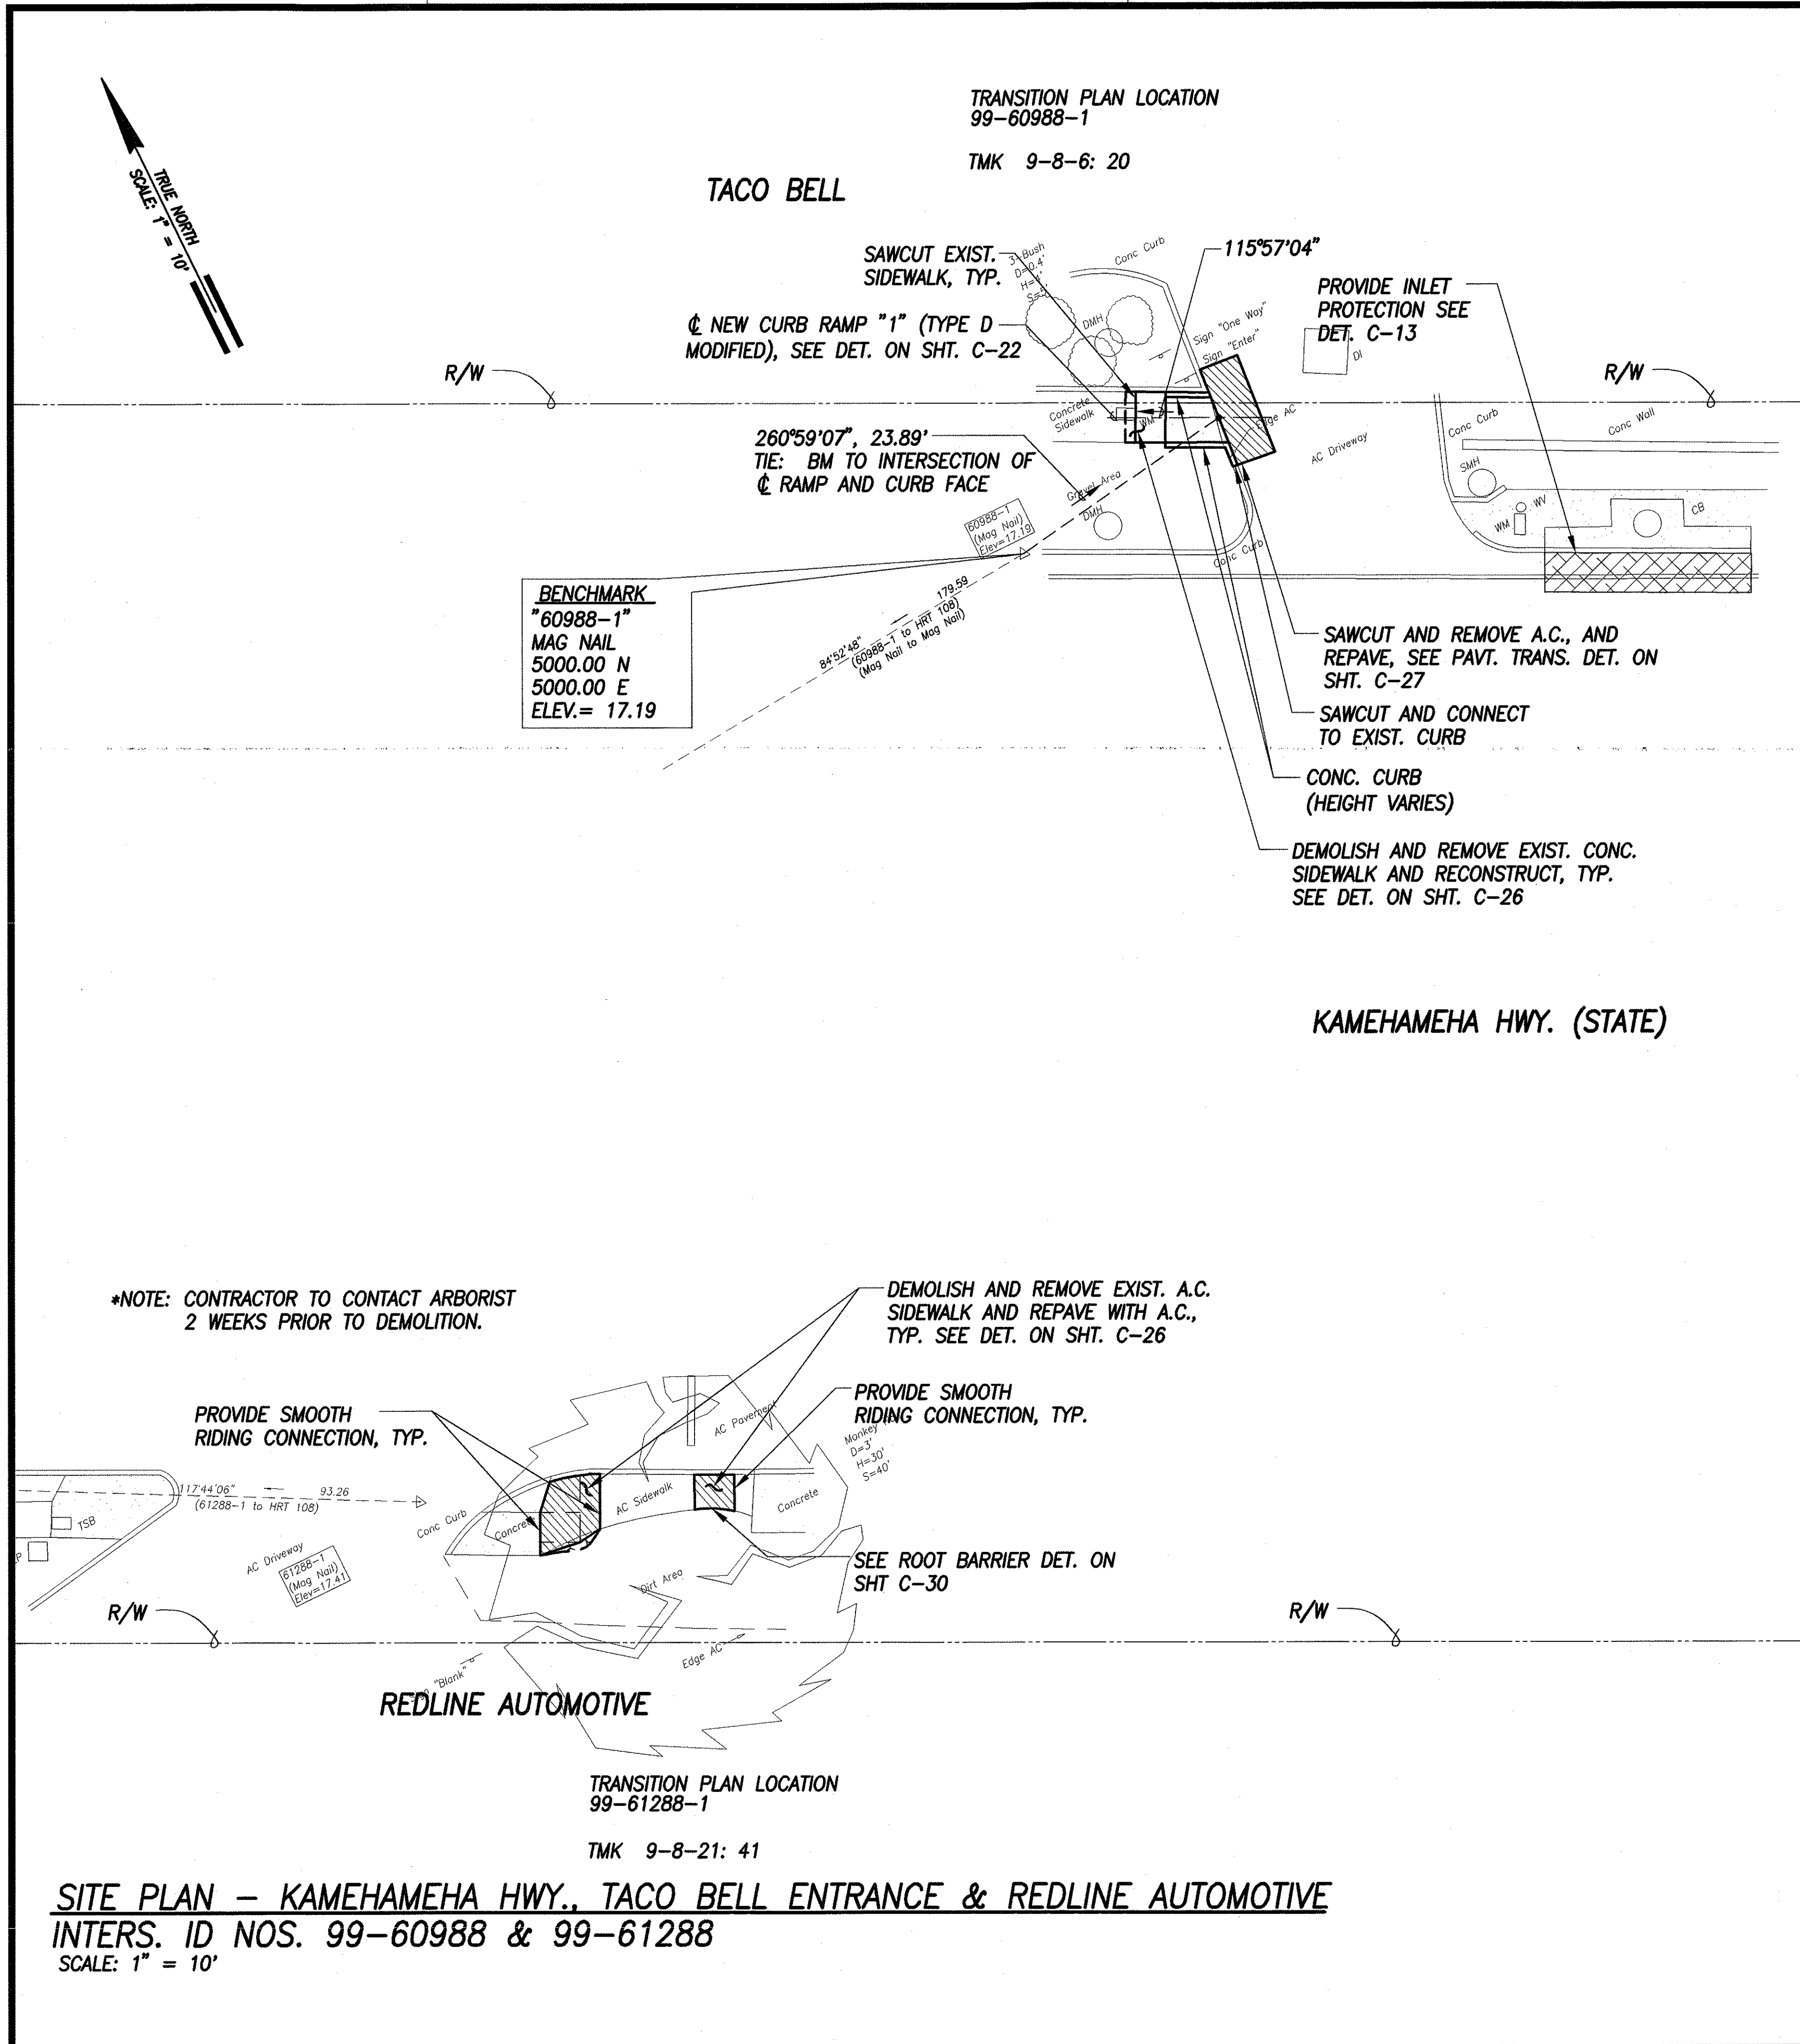


FED. ROAD DIST. NO.	STATE	FED. AID PROJ. NO.	FISCAL YEAR	SHEET NO.	TOTAL SHEETS
HAWAII	HAW.	CMAQ-0300(96)	2004	53	153

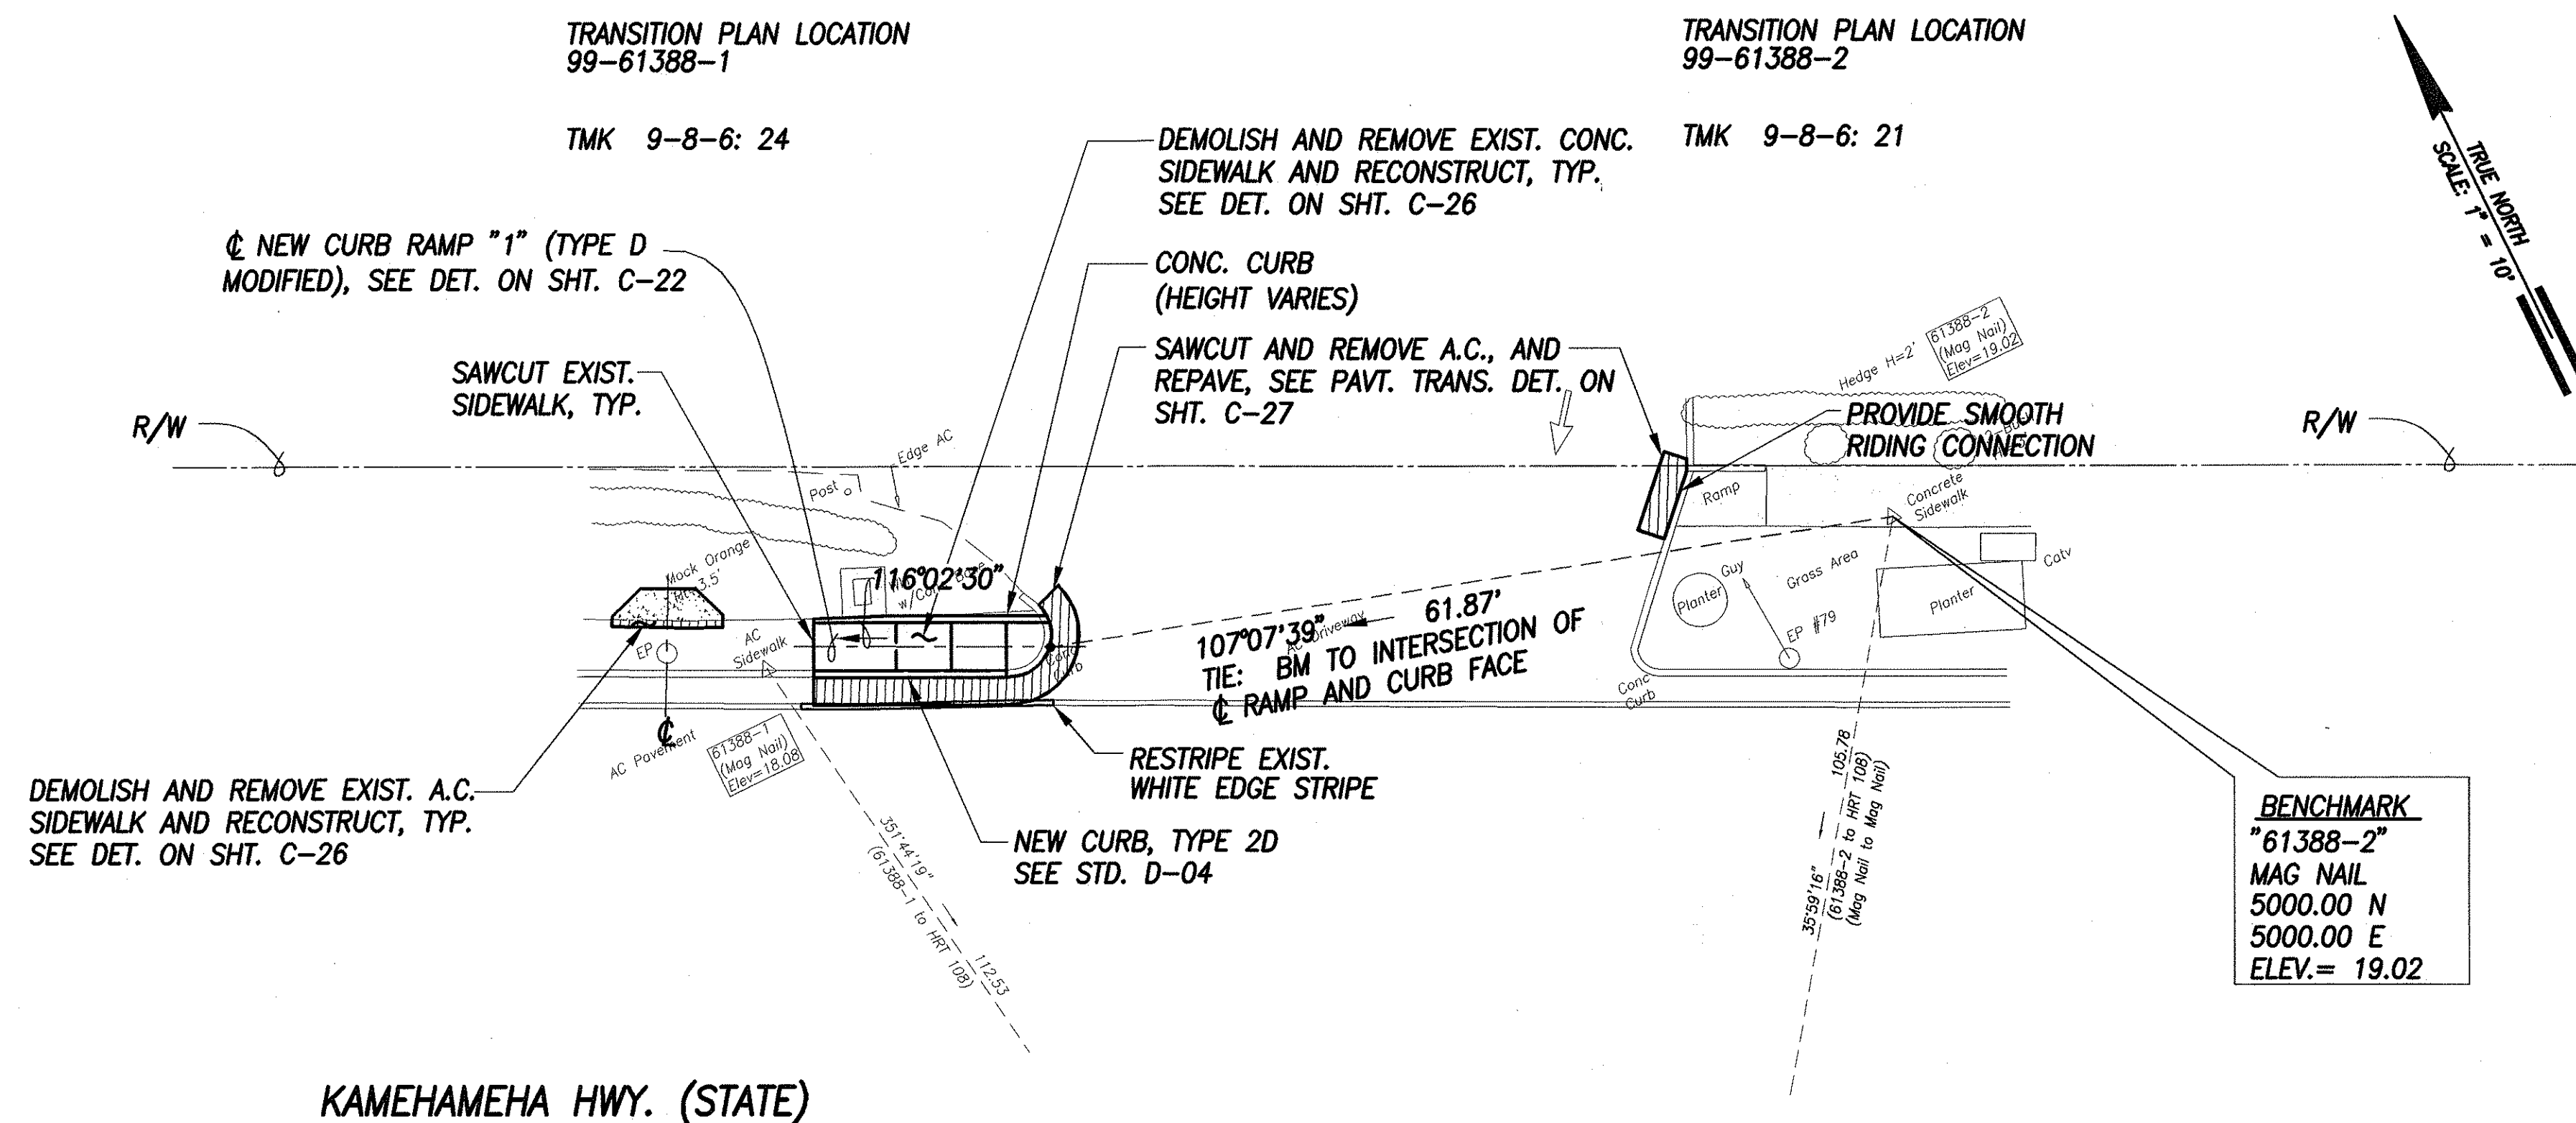

SITE PLAN - KAMEHAMEHA HWY. & JACK IN THE BOX
INTERS. ID NO. 99-61388
 SCALE: 1" = 10'

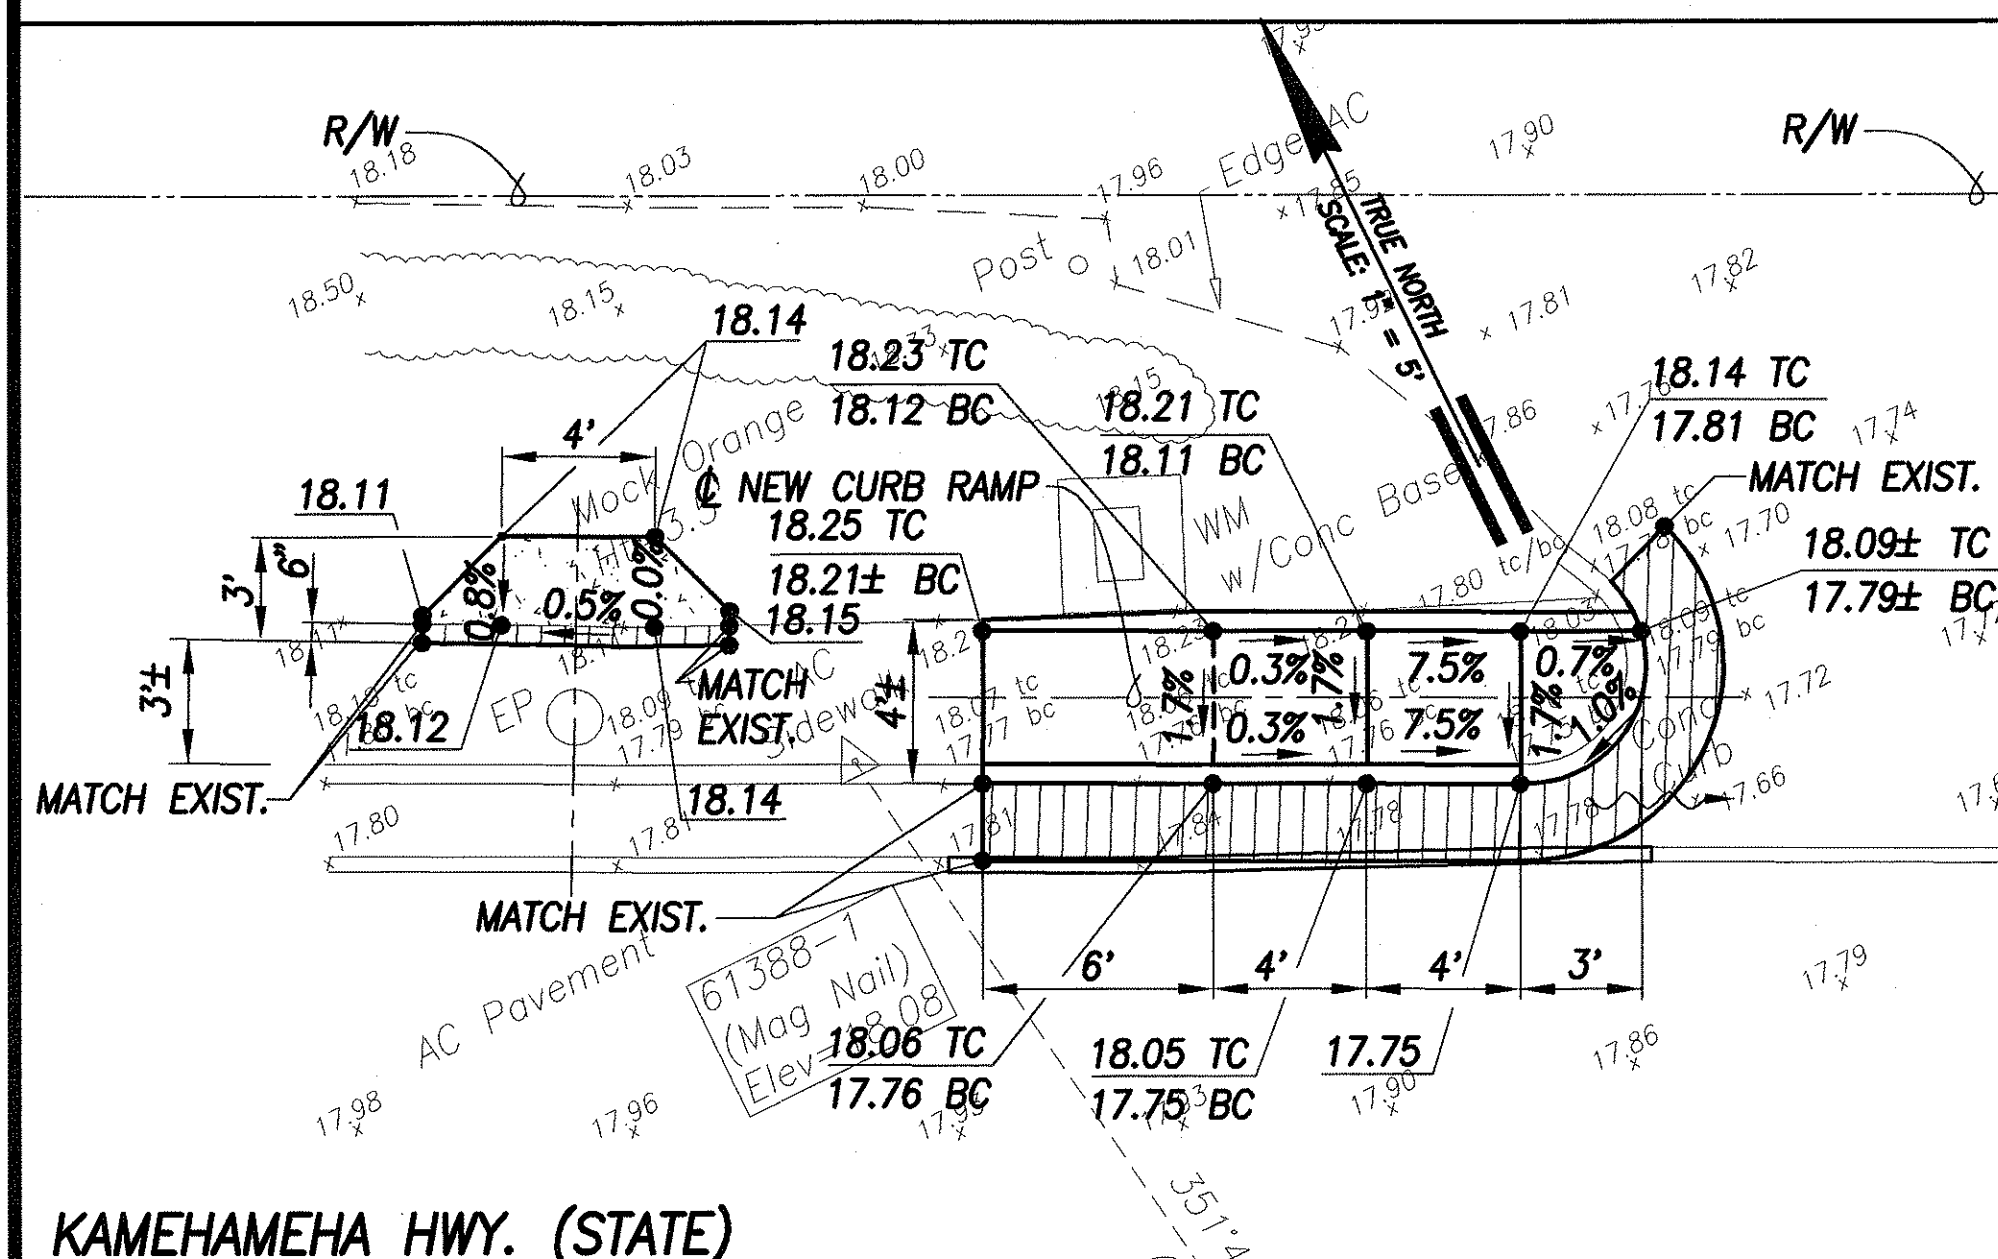


GRADING PLAN - KAMEHAMEHA HWY.
& JACK IN THE BOX
INTERS. ID NO. 99-61388
 SCALE: 1" = 5'

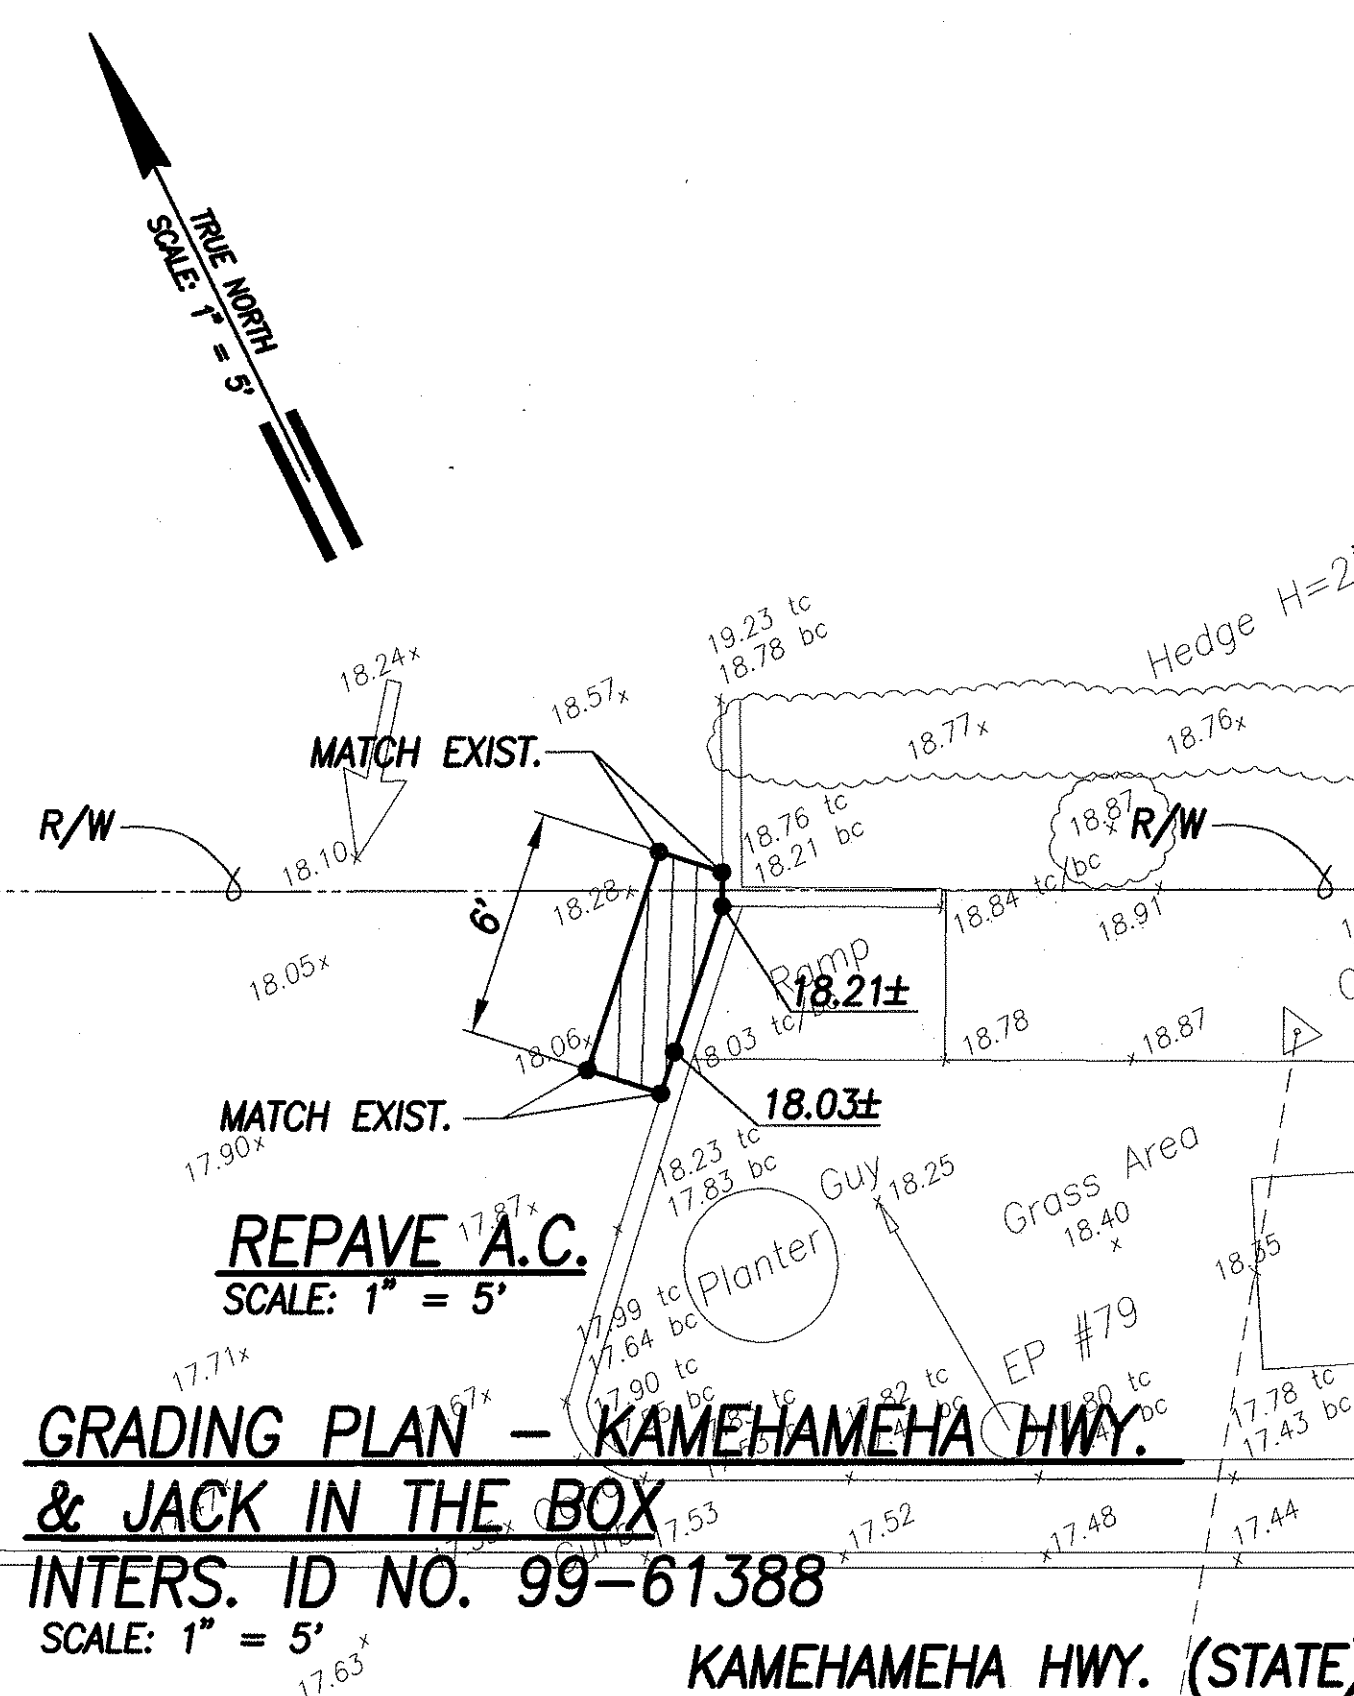

GRADING PLAN - KAMEHAMEHA HWY.
& JACK IN THE BOX
INTERS. ID NO. 99-61388
 SCALE: 1" = 5'

LEGEND

× 49.52	EXIST. SPOT ELEVATION
● 52.58	FINISHED SPOT GRADE
● 51.50 TC	FINISHED TOP OF CURB
● 51.00 BC	FINISHED BOTTOM OF CURB

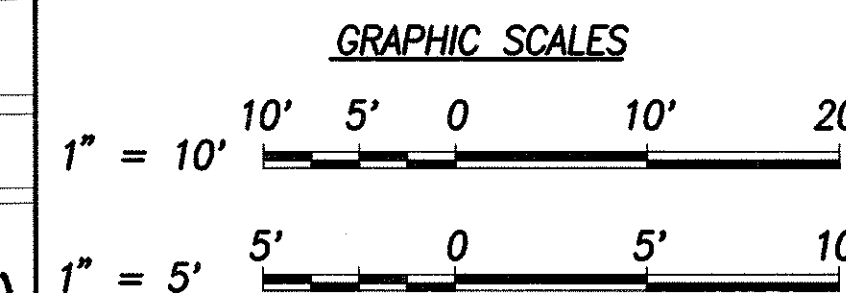

THIS WORK WAS PREPARED BY ME OR UNDER MY SUPERVISION AND CONSTRUCTION OF THIS PROJECT WILL BE UNDER MY OBSERVATION.

SIGNATURE: *Greg H. Hiyaunio* DATE: April 30, 2006

"OBSERVATION OF CONSTRUCTION" IS DEFINED IN CHAPTER 16-115, HAWAII ADMINISTRATIVE RULES ENTITLED "PROFESSIONAL ENGINEERS, ARCHITECTS, SURVEYORS AND LANDSCAPE ARCHITECTS".

STATE OF HAWAII
 DEPARTMENT OF TRANSPORTATION
 HIGHWAYS DIVISION


SITE & GRADING PLAN
KAMEHAMEHA HWY. & JACK IN THE BOX

Pedestrian Facilities & ADA Compliance at Various Locations on Oahu, Unit 5
 Fed. Aid Proj. No. CMAQ-0300(96)

Scale: AS SHOWN Date: August 2004

SHEET No. C-52 OF 153 SHEETS

FED. ROAD DIST. NO.	STATE	FED. AID PROJ. NO.	FISCAL YEAR	SHEET NO.	TOTAL SHEETS
HAWAII	HAW.	CMAQ-0300(96)	2004	54	153


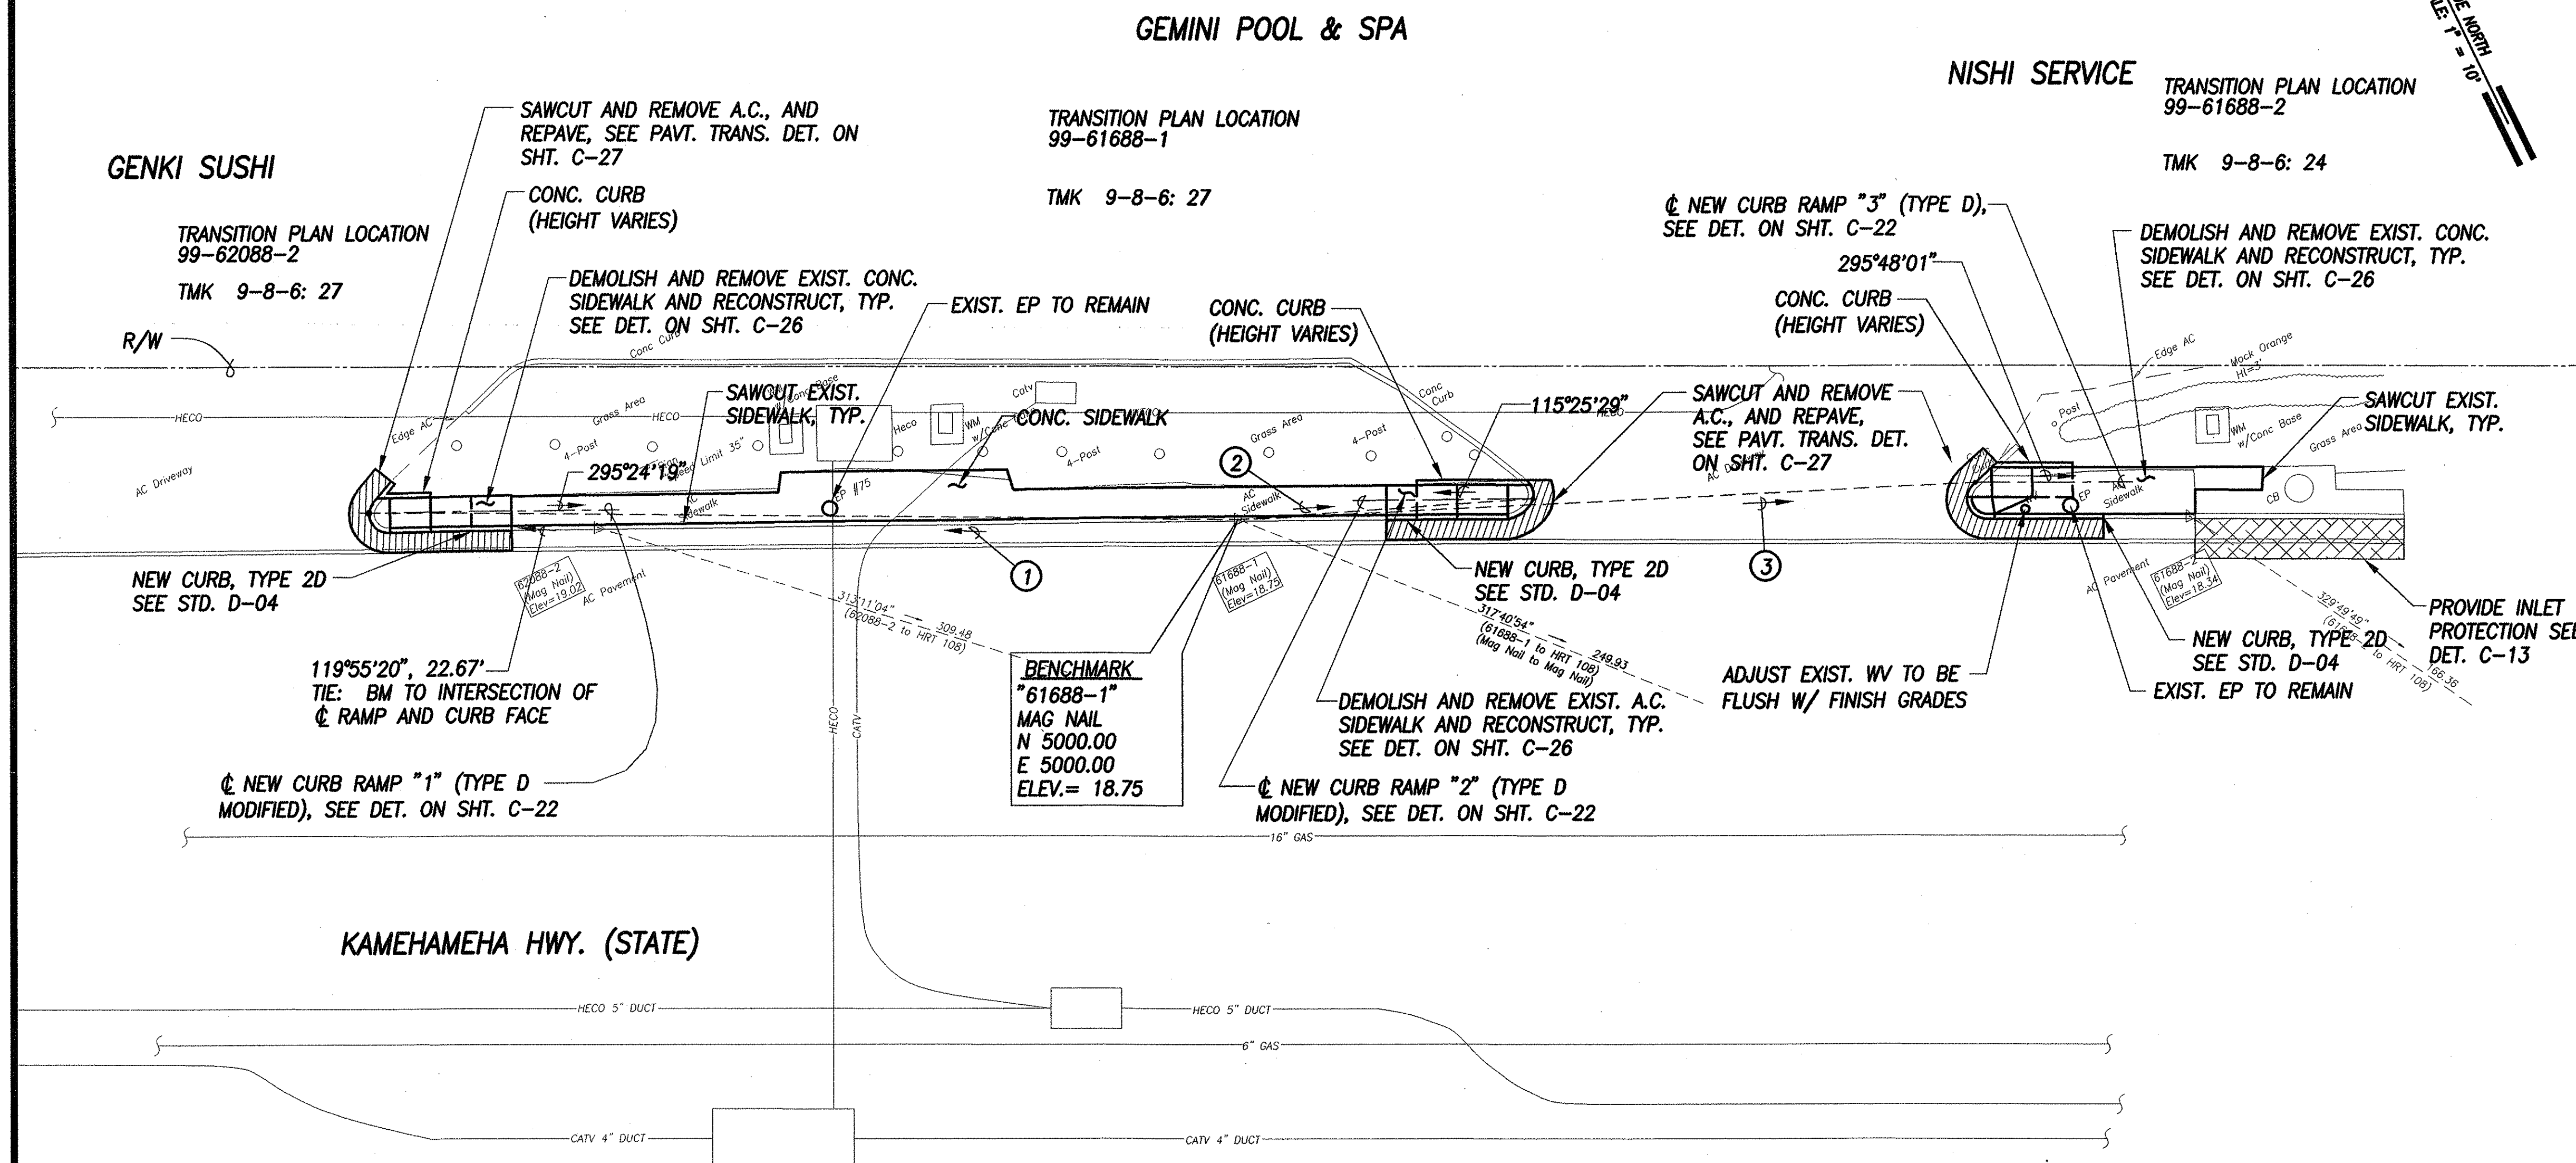


- ① 116°25'54" 86.04'
TIE: BM TO INTERSECTION OF RAMP
EDGE AND CURB FACE
- ② 291°54'10" 29.28'
TIE: BM TO INTERSECTION OF RAMP
EDGE AND CURB FACE
- ③ 293°07'39" 72.84'
TIE: BM TO INTERSECTION OF RAMP
EDGE AND CURB FACE

SITE PLAN - KAMEHAMEHA HWY., GENKI SUSHI & NISHI SERVICE
 INTERS. ID NO. 99-62088 & 99-61688
 SCALE: 1" = 10'

SURVEY PLOTTED BY	DATE
DRAWN BY	
DESIGNED BY	
QUANTITIES BY	
CHECKED BY	
ORIGINAL PLAN	
NOTE BOOK	
NO.	

Principal Executive
 Maintenance Unit, BWS
 Date: 6/24/04

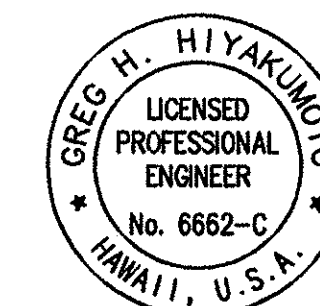
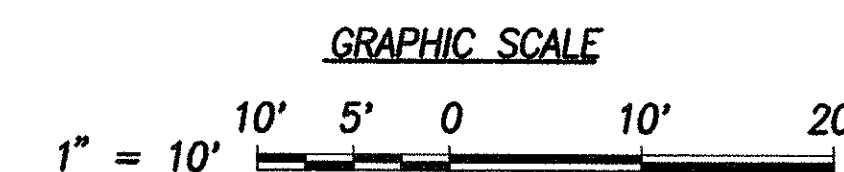


THIS WORK WAS PREPARED BY ME OR UNDER
 MY SUPERVISION AND CONSTRUCTION OF THIS
 PROJECT WILL BE UNDER MY OBSERVATION.

SIGNATURE: *Greg H. Hiyaunono* DATE: April 30, 2006
 "OBSERVATION OF CONSTRUCTION" IS DEFINED
 IN CHAPTER 16-115, HAWAII ADMINISTRATIVE
 RULES ENTITLED "PROFESSIONAL ENGINEERS,
 ARCHITECTS, SURVEYORS AND LANDSCAPE
 ARCHITECTS".


STATE OF HAWAII
 DEPARTMENT OF TRANSPORTATION
 HIGHWAYS DIVISION
**SITE PLAN - KAMEHAMEHA HWY.,
 GENKI SUSHI & NISHI SERVICE**
 Pedestrian Facilities & ADA Compliance
 at Various Locations on Oahu, Unit 5
 Fed. Aid Proj. No. CMAQ-0300(96)
 Scale: 1" = AS SHOWN Date: August 2004
SHEET No. C-53 OF 153 SHEETS

FED. ROAD DIST. NO.	STATE	FED. AID PROJ. NO.	FISCAL YEAR	SHEET NO.	TOTAL SHEETS
HAWAII	HAW.	CMAQ-0300(96)	2004	55	153

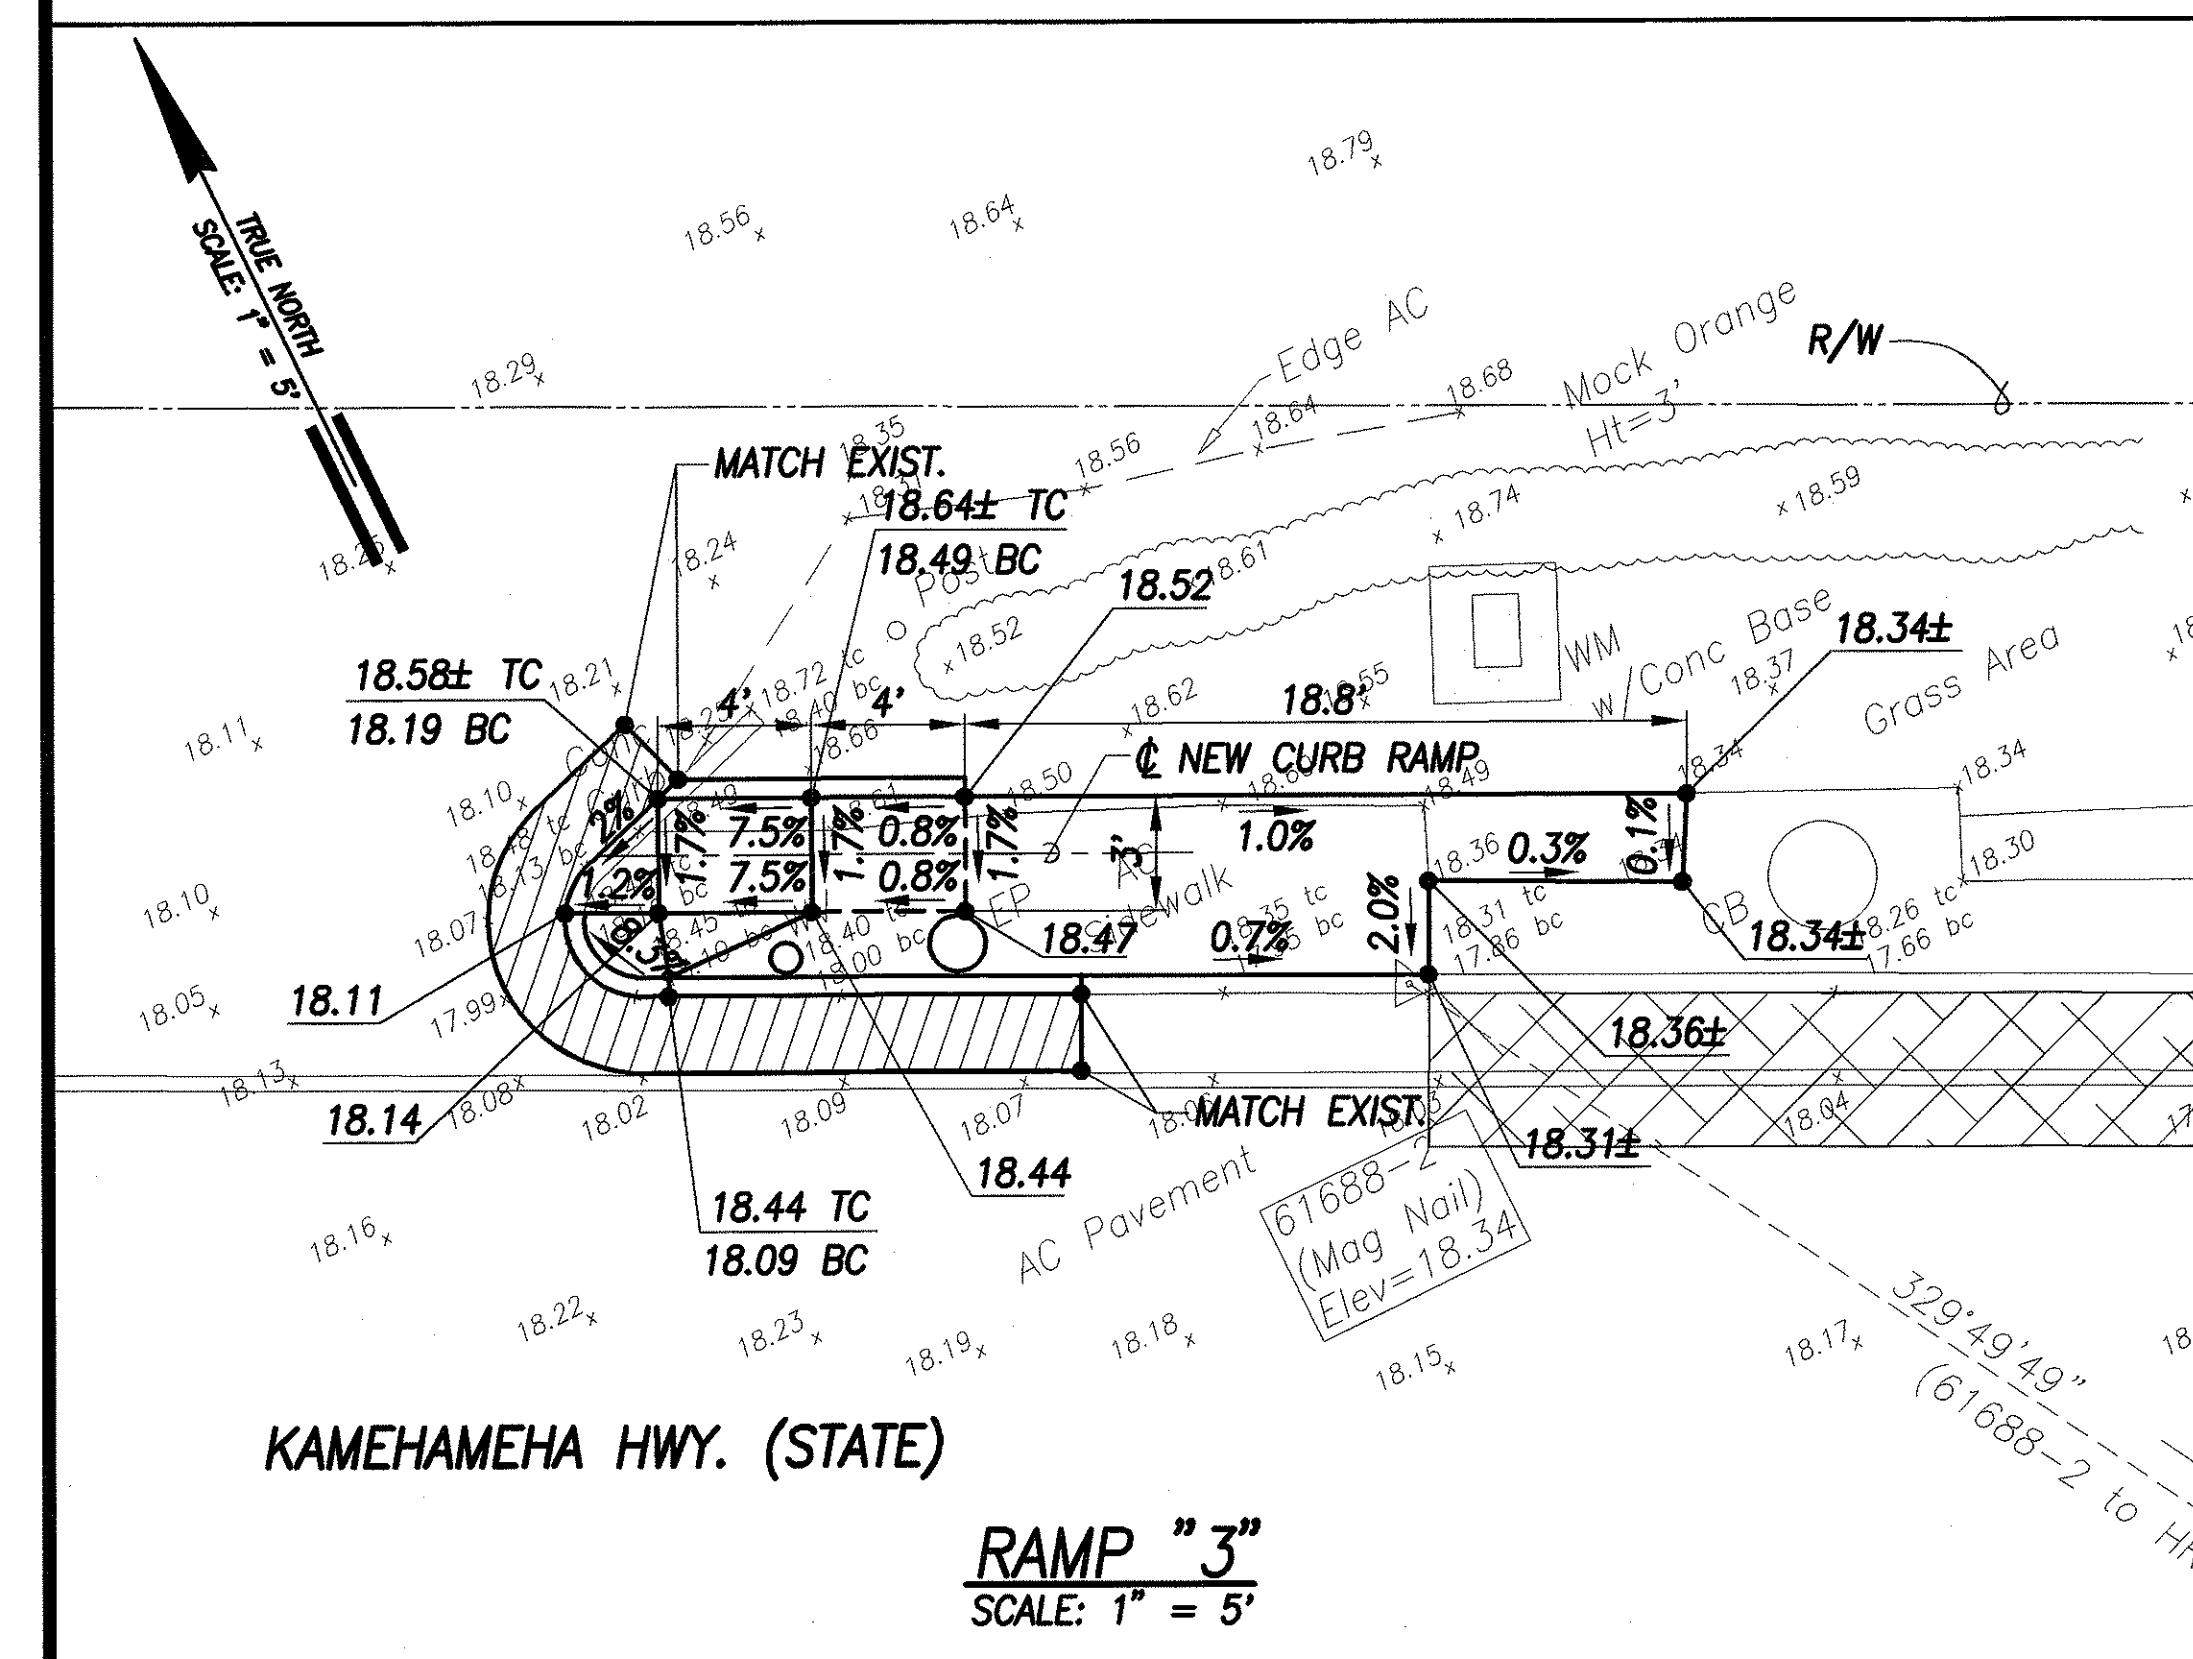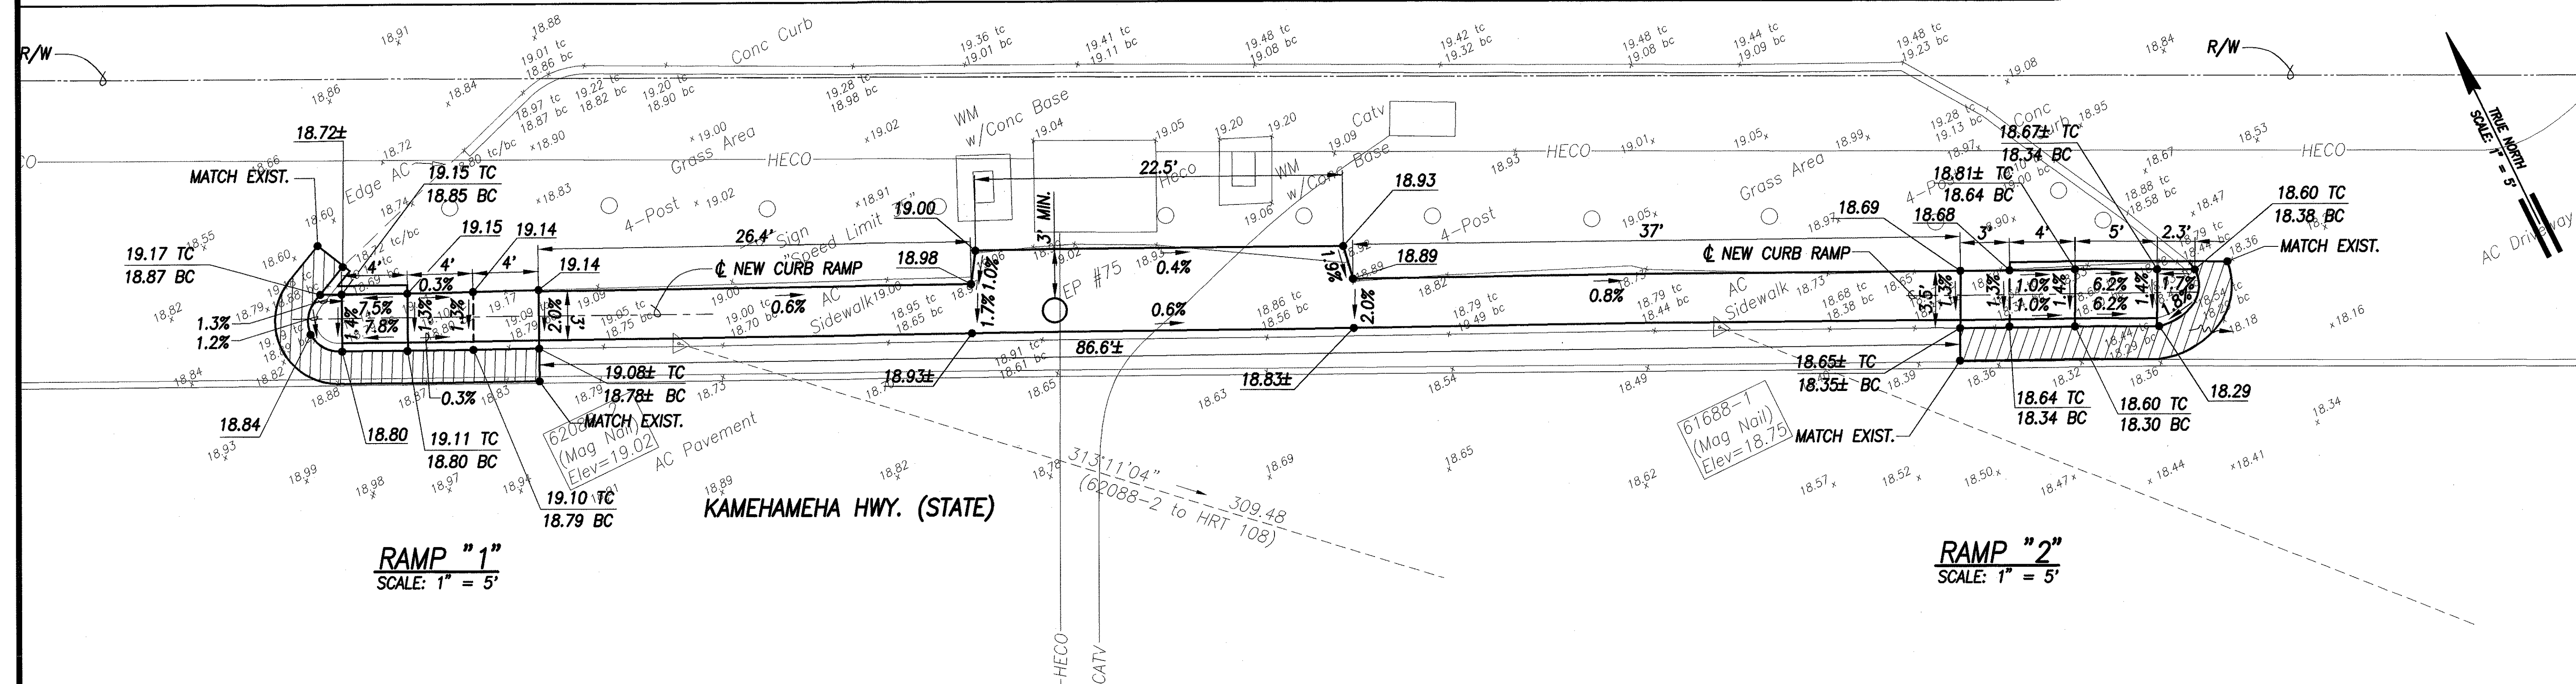

GRADING PLAN - KAMEHAMEHA HWY., GENKI SUSHI & NISHI SERVICE
INTERS. ID NO. 99-62088 & 99-61688
 SCALE: 1" = 5'

LEGEND	
x 49.52	EXIST. SPOT ELEVATION
52.58	FINISHED SPOT GRADE
51.50 TC	FINISHED TOP OF CURB
51.00 BC	FINISHED BOTTOM OF CURB

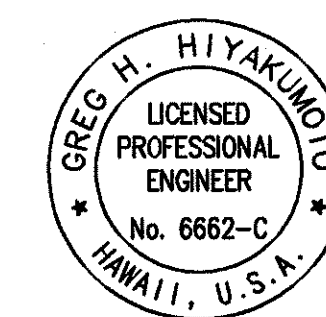


THIS WORK WAS PREPARED BY ME OR UNDER MY SUPERVISION AND CONSTRUCTION OF THIS PROJECT WILL BE UNDER MY OBSERVATION.

Greg H. Hiyaikuto
 SIGNATURE
 DATE: April 30, 2006



"OBSERVATION OF CONSTRUCTION" IS DEFINED IN CHAPTER 16-115, HAWAII ADMINISTRATIVE RULES ENTITLED "PROFESSIONAL ENGINEERS, ARCHITECTS, SURVEYORS AND LANDSCAPE ARCHITECTS".

GRAPHIC SCALE

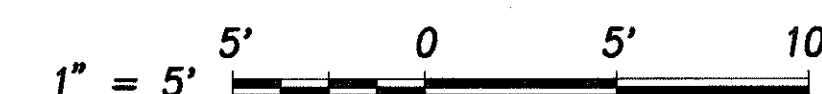



STATE OF HAWAII
 DEPARTMENT OF TRANSPORTATION
 HIGHWAYS DIVISION
GRADING PLAN - KAMEHAMEHA HWY., GENKI SUSHI & NISHI SERVICE
Pedestrian Facilities & ADA Compliance at Various Locations on Oahu, Unit 5
 Fed. Aid Proj. No. CMAQ-0300(96)
 Scale: 1" = AS SHOWN Date: August 2004
SHEET No. C-54 OF 153 SHEETS

FED. ROAD DIST. NO.	STATE	FED. AID PROJ. NO.	FISCAL YEAR	SHEET NO.	TOTAL SHEETS
HAWAII	HAW.	CMAQ-0300(96)	2004	56	153

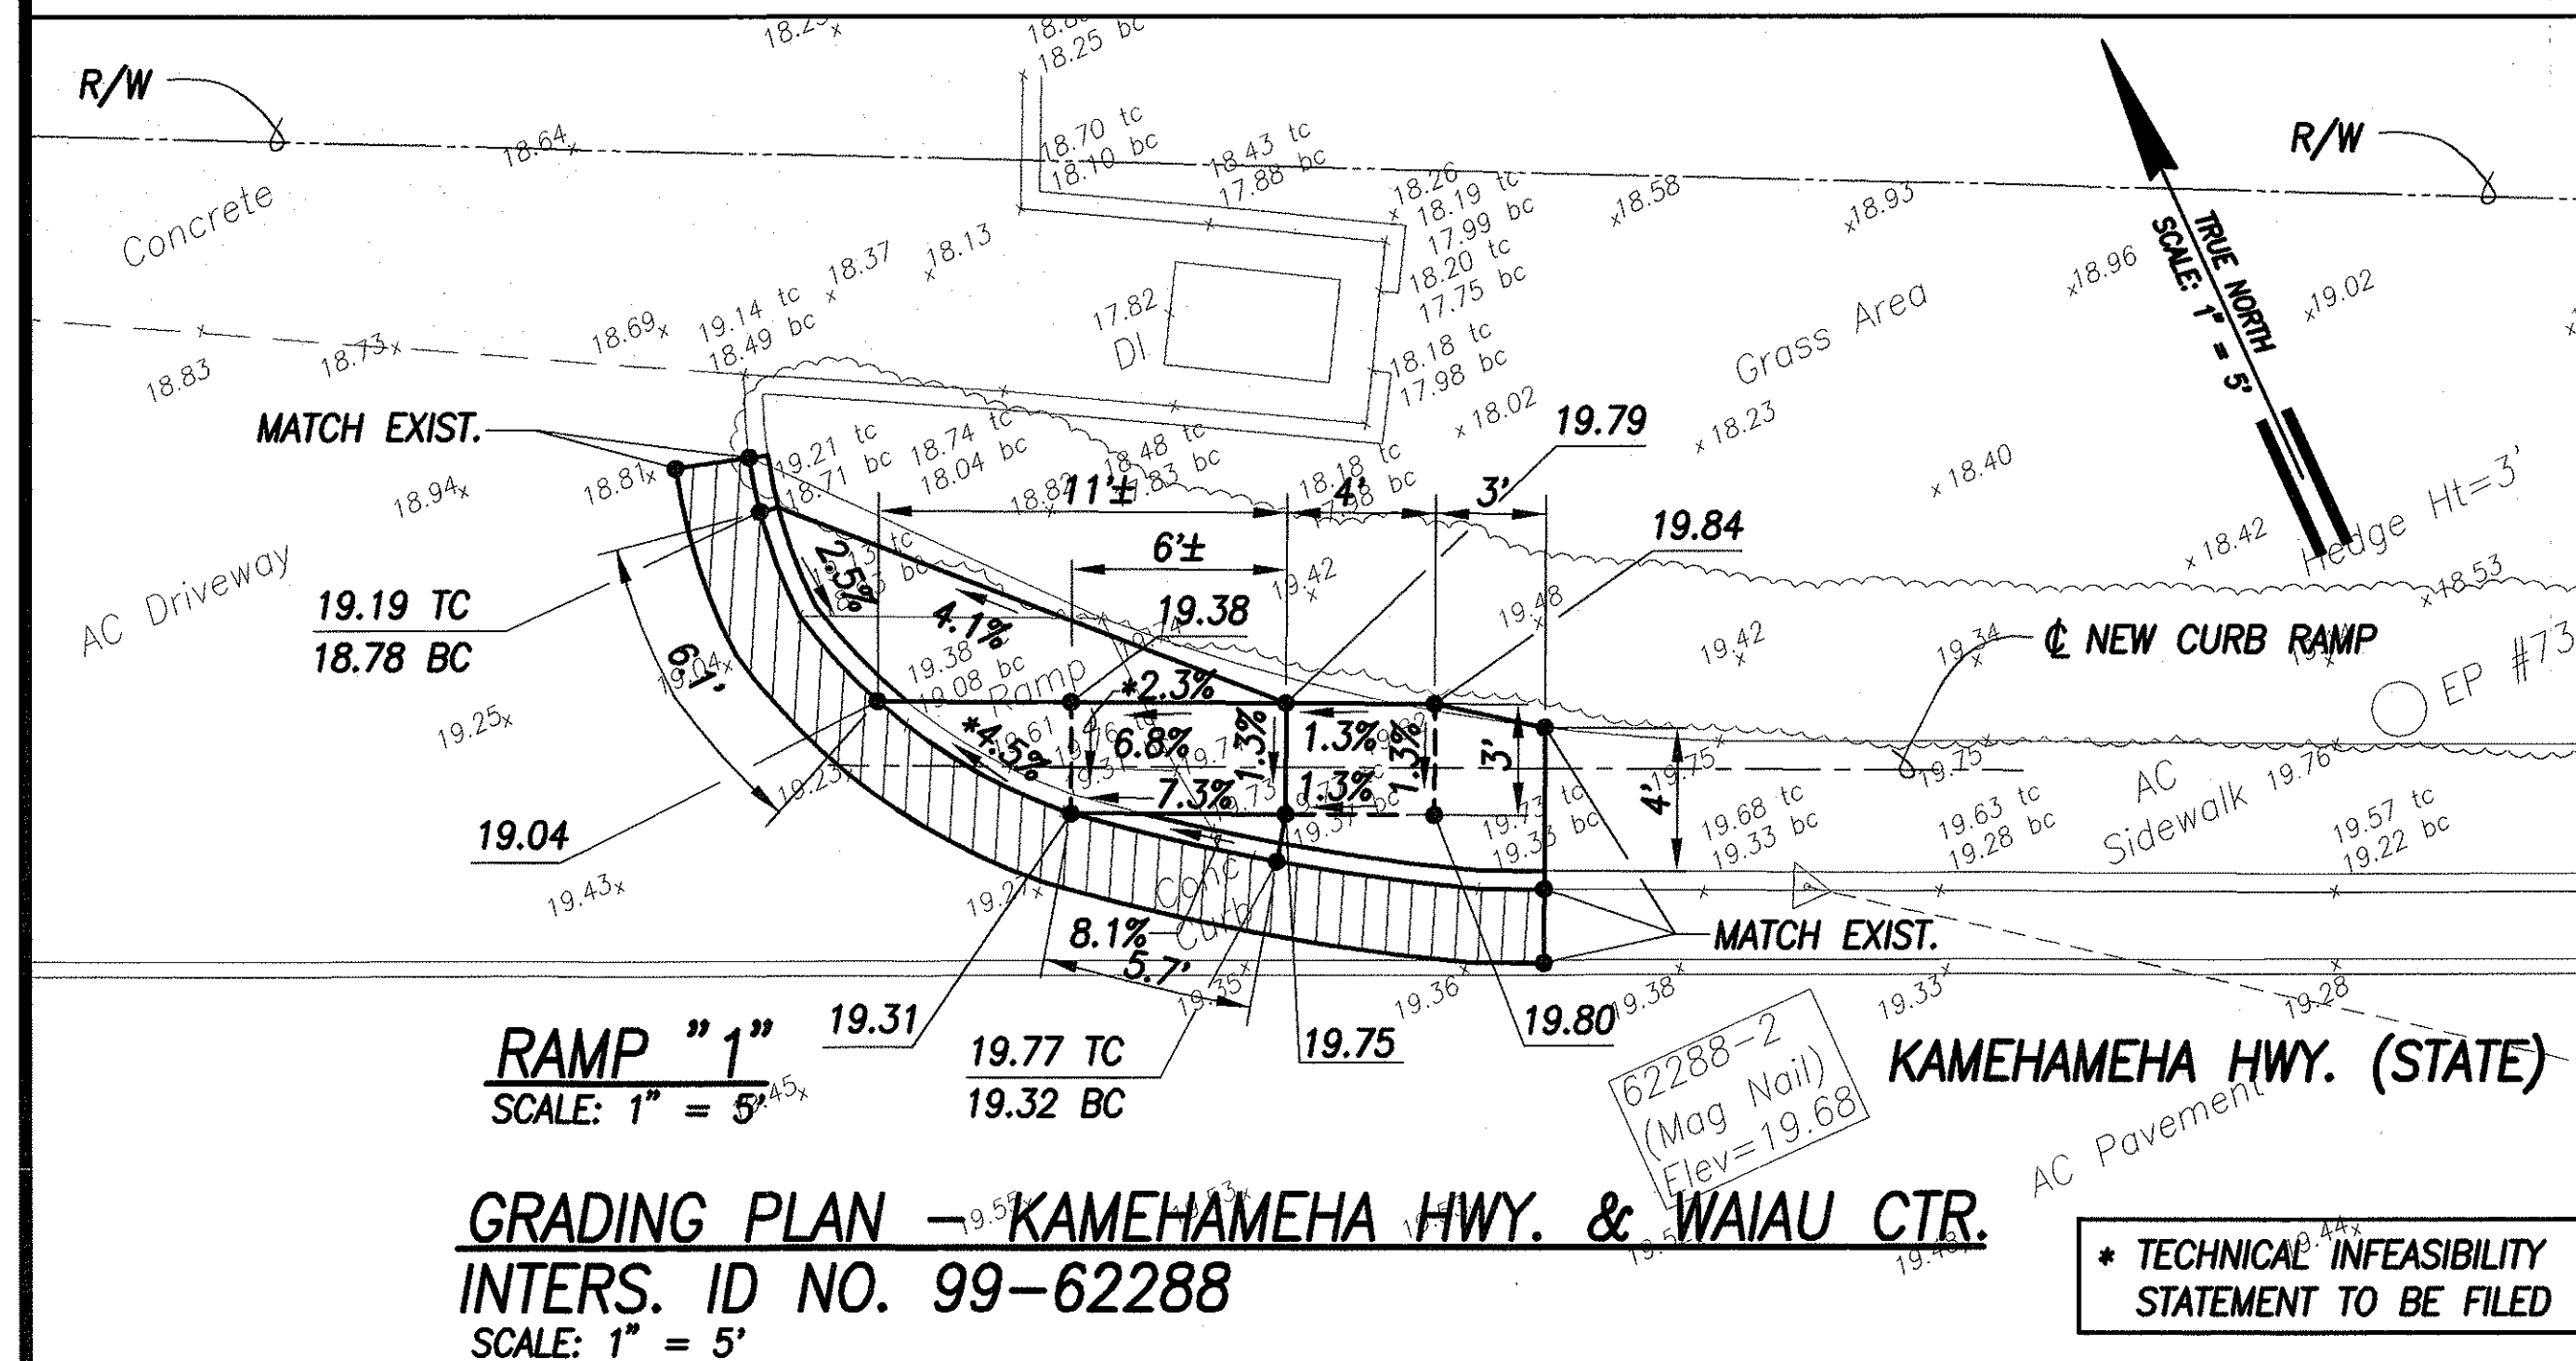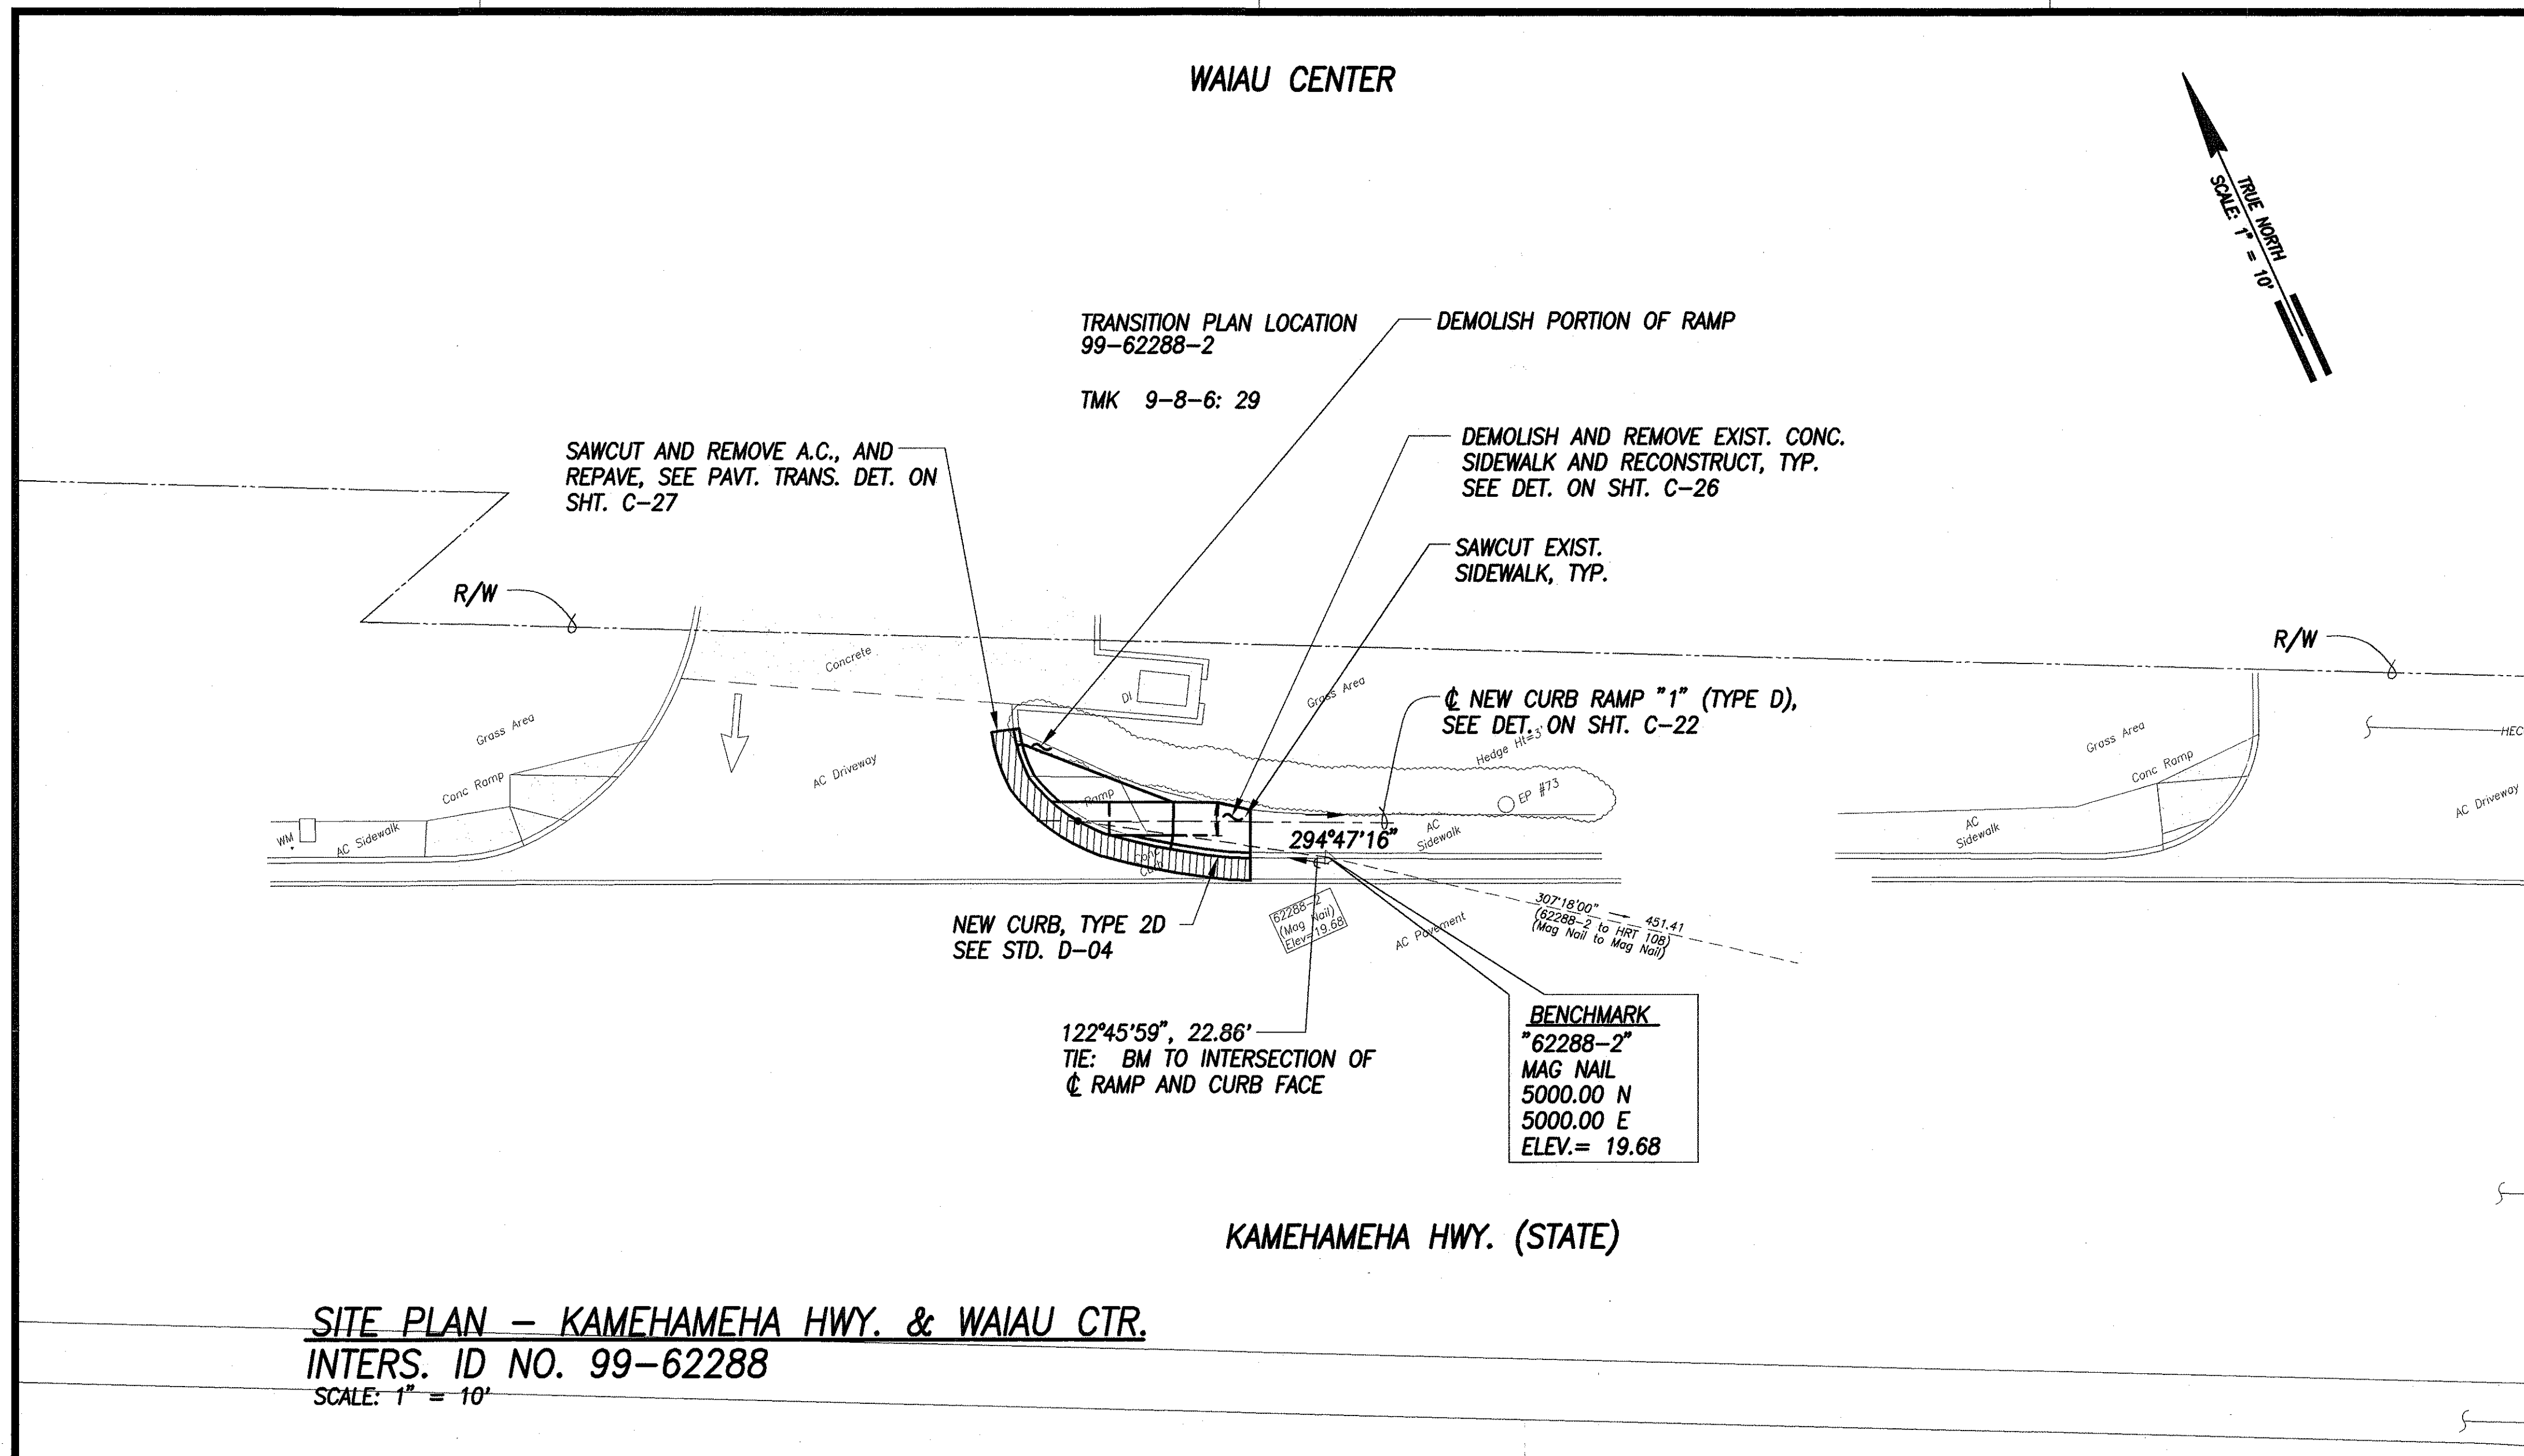

LEGEND

× 49.52	EXIST. SPOT ELEVATION
52.58	FINISHED SPOT GRADE
51.50 TC	FINISHED TOP OF CURB
51.00 BC	FINISHED BOTTOM OF CURB

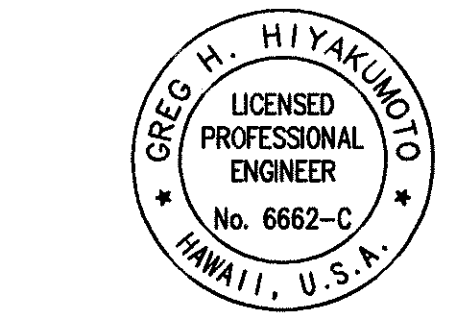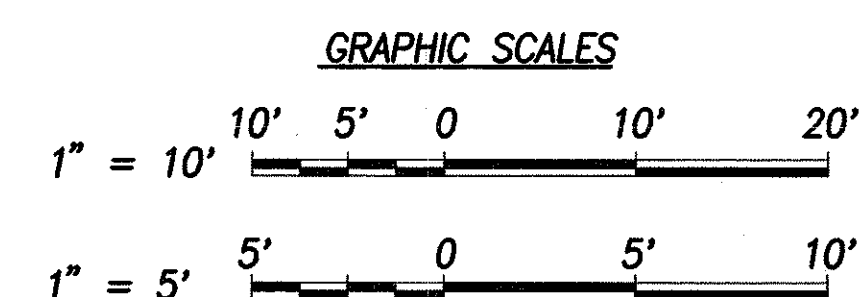

THIS WORK WAS PREPARED BY ME OR UNDER MY SUPERVISION AND CONSTRUCTION OF THIS PROJECT WILL BE UNDER MY OBSERVATION.

DATE: April 30, 2006

SIGNATURE: *Greg H. Hiyaunio*

"OBSERVATION OF CONSTRUCTION" IS DEFINED IN CHAPTER 16-115, HAWAII ADMINISTRATIVE RULES ENTITLED "PROFESSIONAL ENGINEERS, ARCHITECTS, SURVEYORS AND LANDSCAPE ARCHITECTS".

STATE OF HAWAII
DEPARTMENT OF TRANSPORTATION
HIGHWAYS DIVISION

SITE & GRADING PLAN
KAMEHAMEHA HWY. & WAI'AU CTR.

Pedestrian Facilities & ADA Compliance at Various Locations on Oahu, Unit 5
Fed. Aid Proj. No. CMAQ-0300(96)


Scale: AS SHOWN Date: August 2004

SHEET No. C-55 OF 153 SHEETS

SURVEY PLOTTED BY	DATE
DRAWN BY	
DESIGNED BY	
QUANTITIES BY	
CHECKED BY	
ORIGINAL PLAN	
NOTE BOOK	
No.	


* TECHNICAL INFEASIBILITY STATEMENT TO BE FILED

FED. ROAD DIST. NO.	STATE	FED. AID PROJ. NO.	FISCAL YEAR	SHEET NO.	TOTAL SHEETS
HAWAII	HAW.	CMAQ-0300(96)	2004	58	153

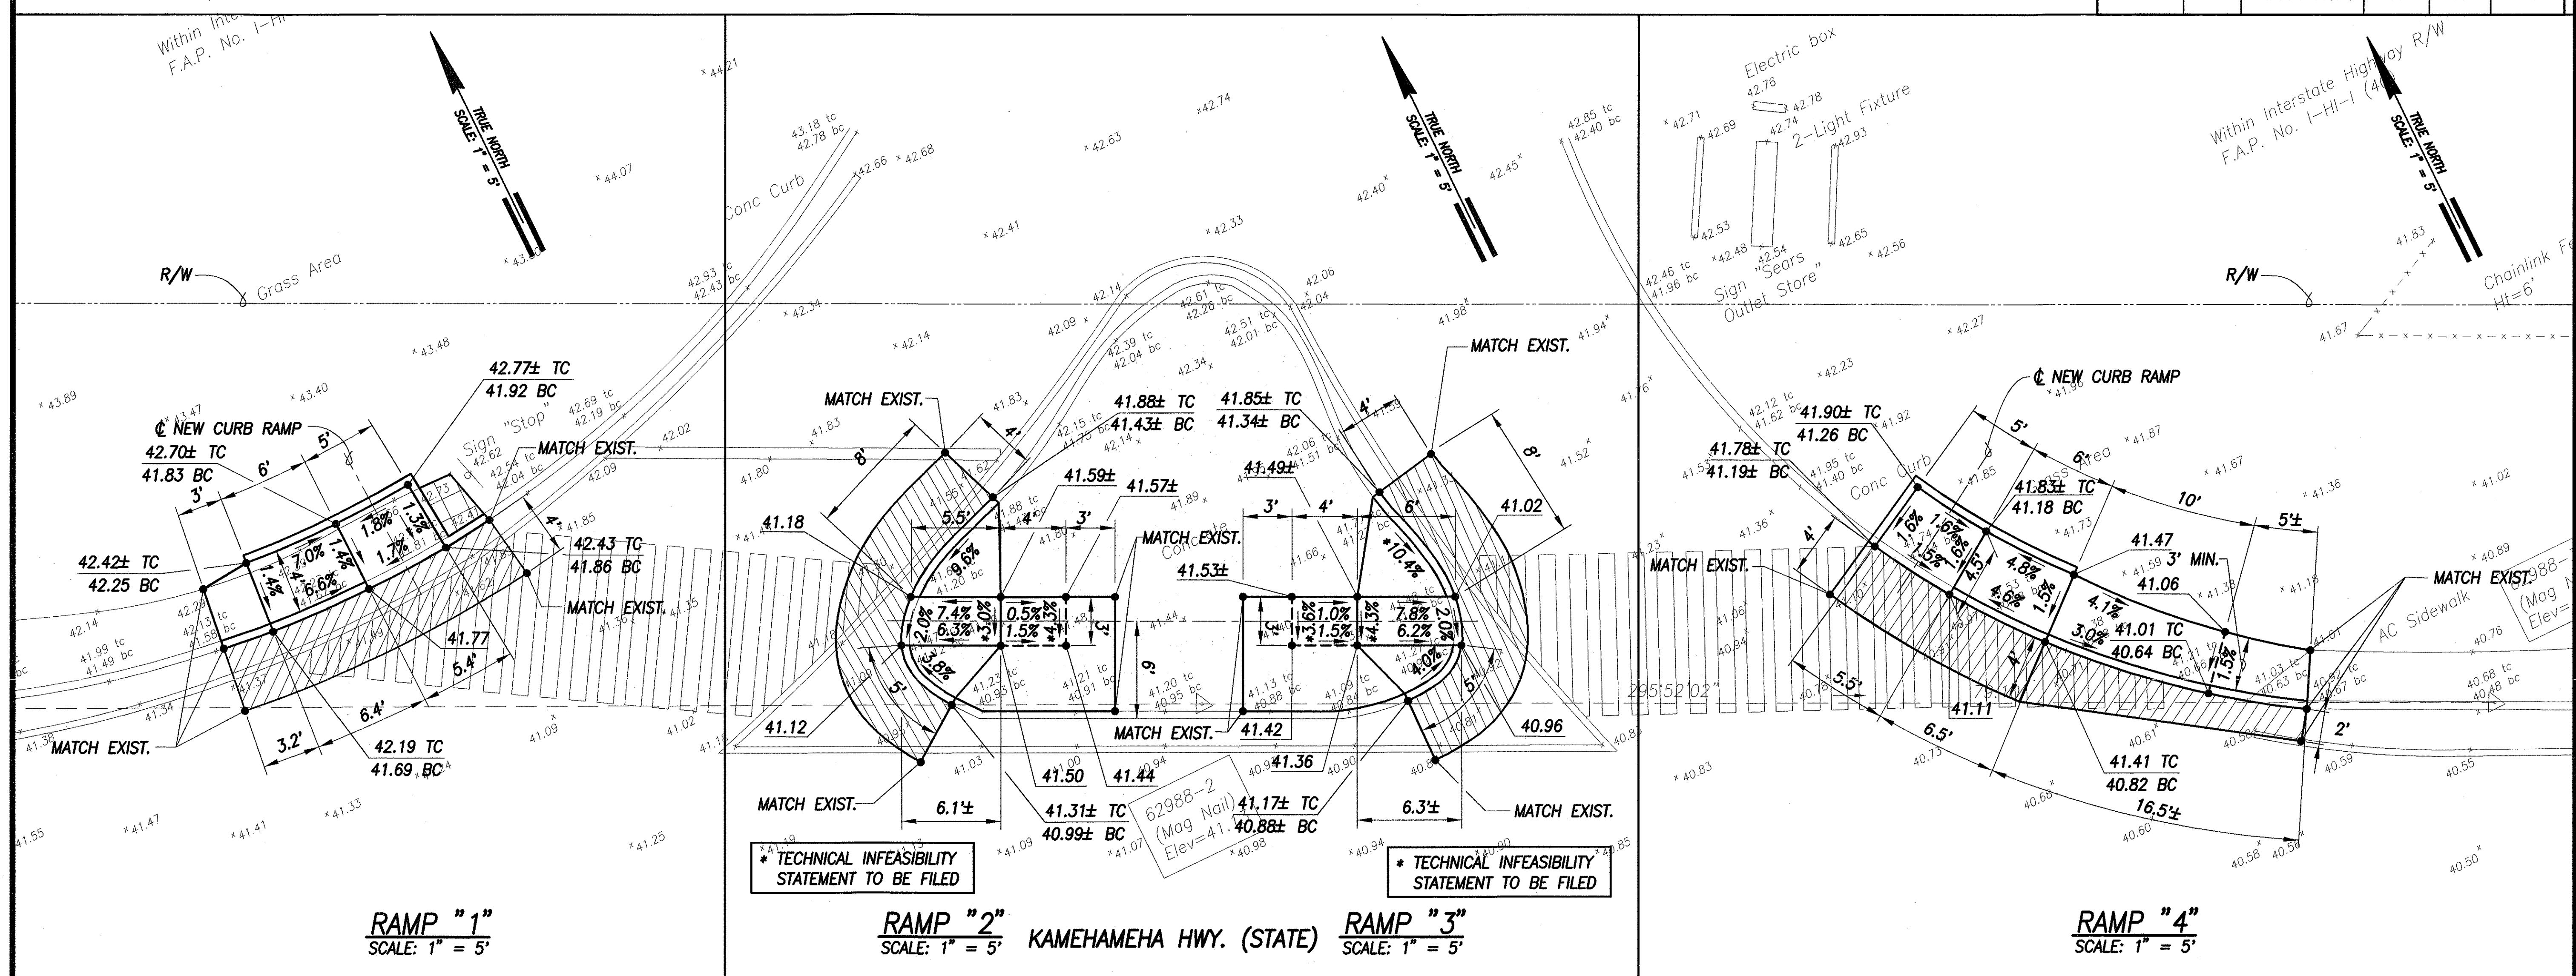

LEGEND	
× 49.52	EXIST. SPOT ELEVATION
52.58	FINISHED SPOT GRADE
51.50 TC	FINISHED TOP OF CURB
51.00 BC	FINISHED BOTTOM OF CURB

GRADING PLAN - KAMEHAMEHA HWY. & SEARS
INTERS. ID NO. 99-62988
SCALE: 1" = 5'

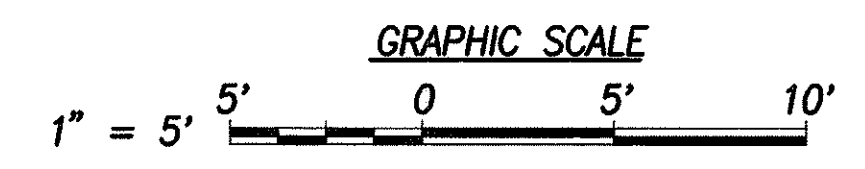

GREG H. HIYAKUNO
LICENSED PROFESSIONAL ENGINEER
No. 6662-C
HAWAII, U.S.A.

THIS WORK WAS PREPARED BY ME OR UNDER MY SUPERVISION AND CONSTRUCTION OF THIS PROJECT WILL BE UNDER MY OBSERVATION.

Signature: [Signature] DATE: April 30, 2006

"OBSERVATION OF CONSTRUCTION" IS DEFINED IN CHAPTER 16-115, HAWAII ADMINISTRATIVE RULES ENTITLED "PROFESSIONAL ENGINEERS, ARCHITECTS, SURVEYORS AND LANDSCAPE ARCHITECTS".

STATE OF HAWAII
DEPARTMENT OF TRANSPORTATION
HIGHWAYS DIVISION

GRADING PLAN
KAMEHAMEHA HWY. & SEARS

Pedestrian Facilities & ADA Compliance at Various Locations on Oahu, Unit 5
Fed. Aid Proj. No. CMAQ-0300(96)


Scale: 1" = 5'-0" Date: August 2004

SHEET No. C-57 OF 153 SHEETS

SURVEY PLOTTED BY	DATE
DRAWN BY	
DESIGNED BY	
QUANTITIES BY	
CHECKED BY	


ORIGINAL PLAN	No.
NOTE BOOK	

FED. ROAD DIST. NO.	STATE	FED. AID PROJ. NO.	FISCAL YEAR	SHEET NO.	TOTAL SHEETS
HAWAII	HAW.	CMAQ-0300(96)	2004	59	153

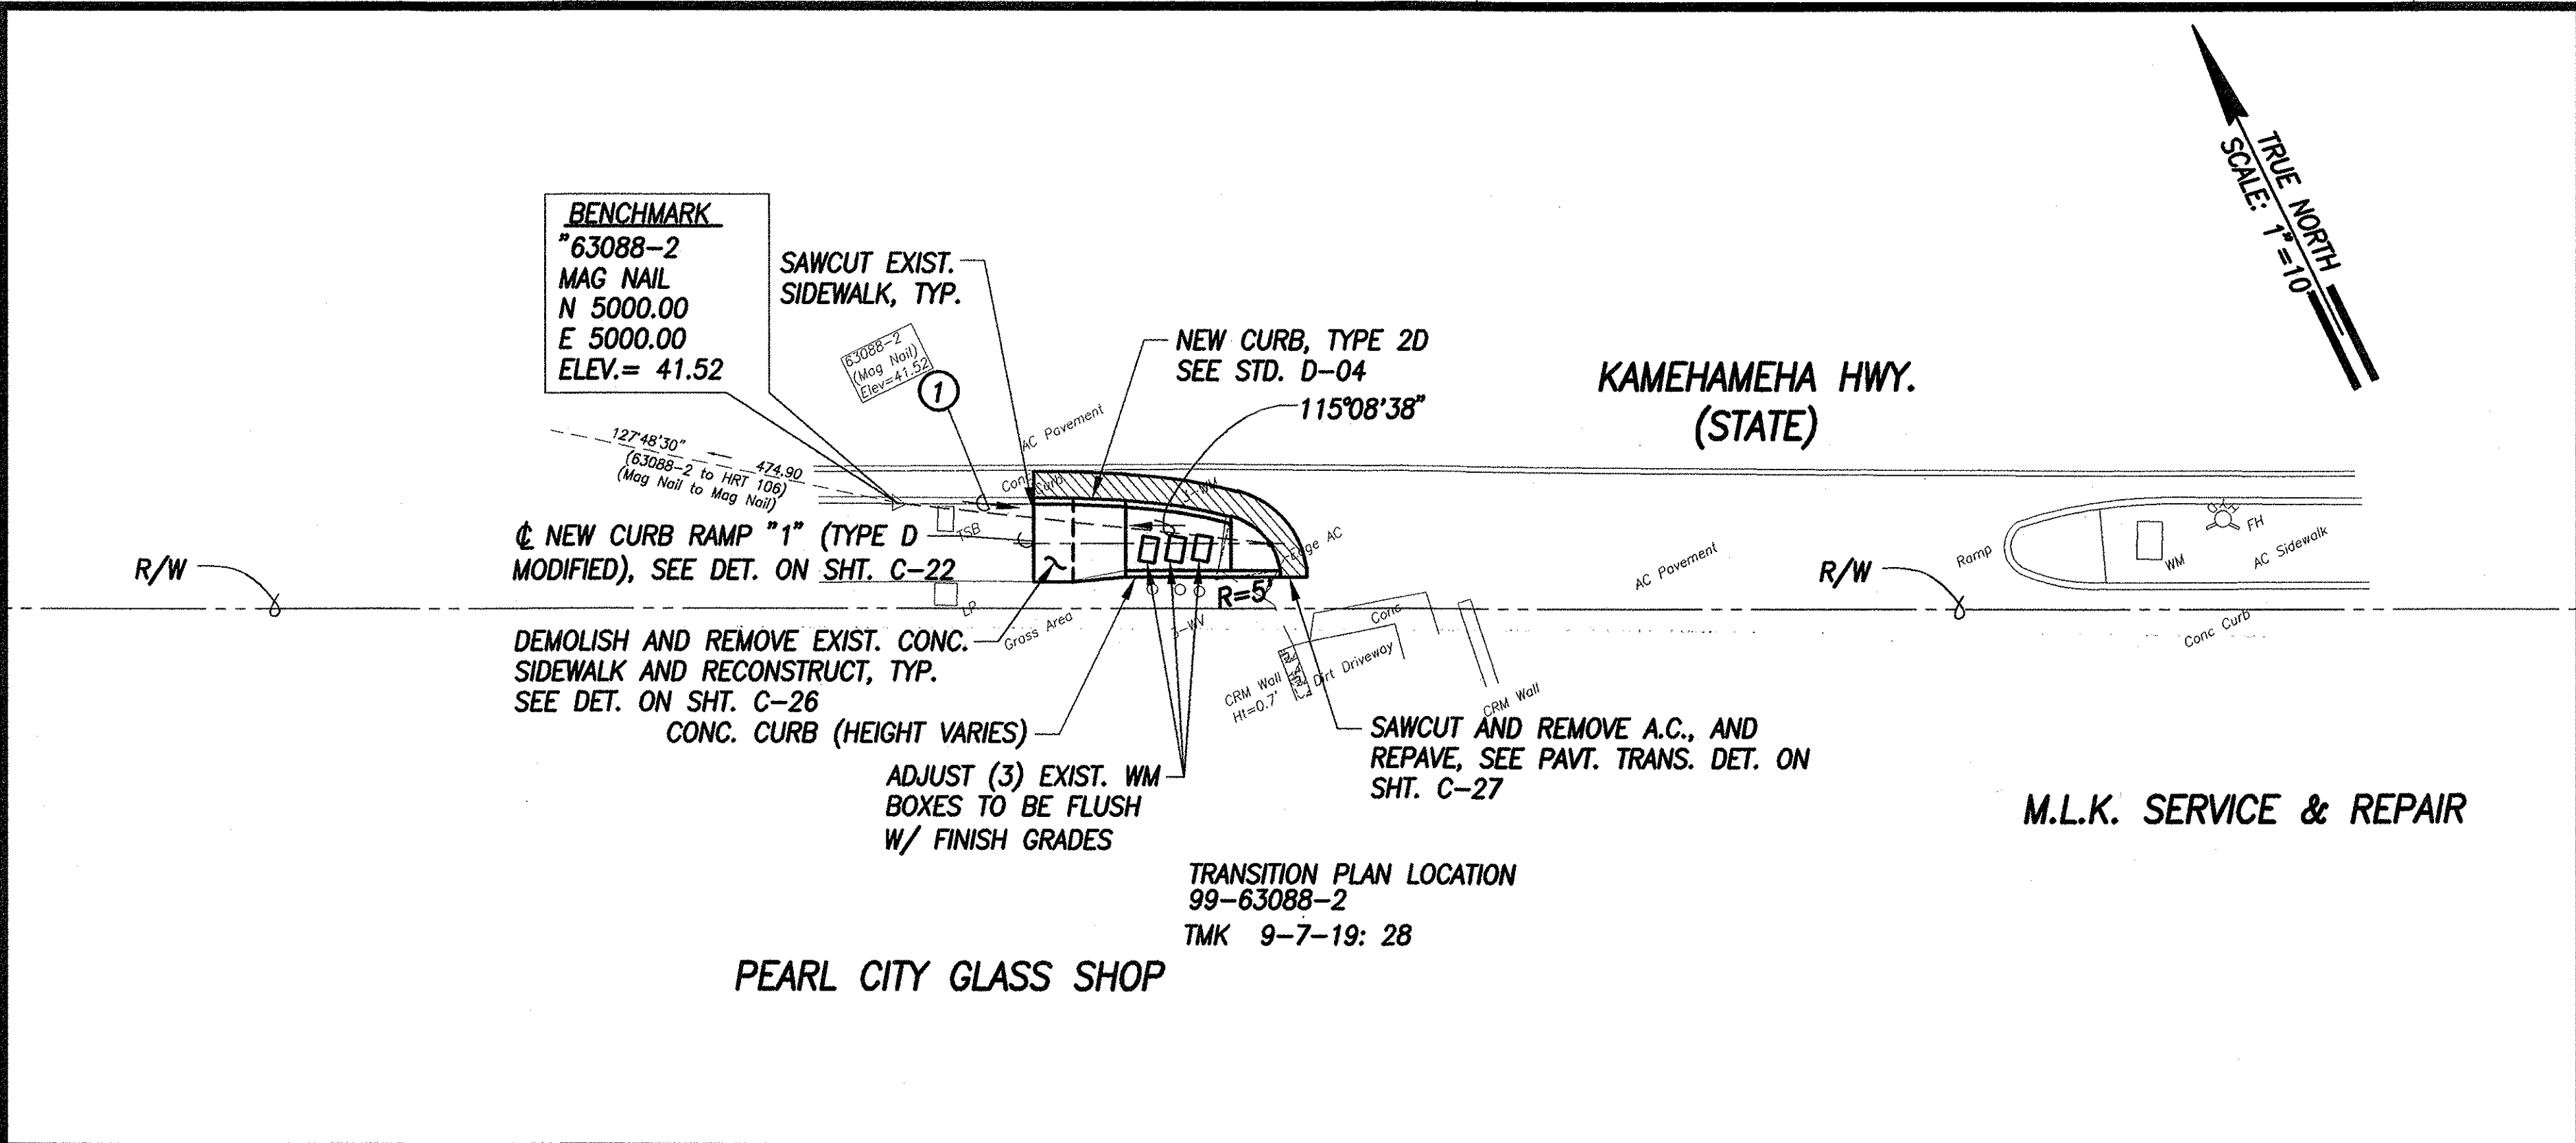

① 302°08'36" 28.49'
TIE: BM TO INTERSECTION OF
RAMP AND CURB FACE

SITE PLAN – KAMEHAMEHA HWY. & PEARL CITY GLASS SHOP
 INTERS. ID NO. 99-63088
 SCALE: 1" = 10'

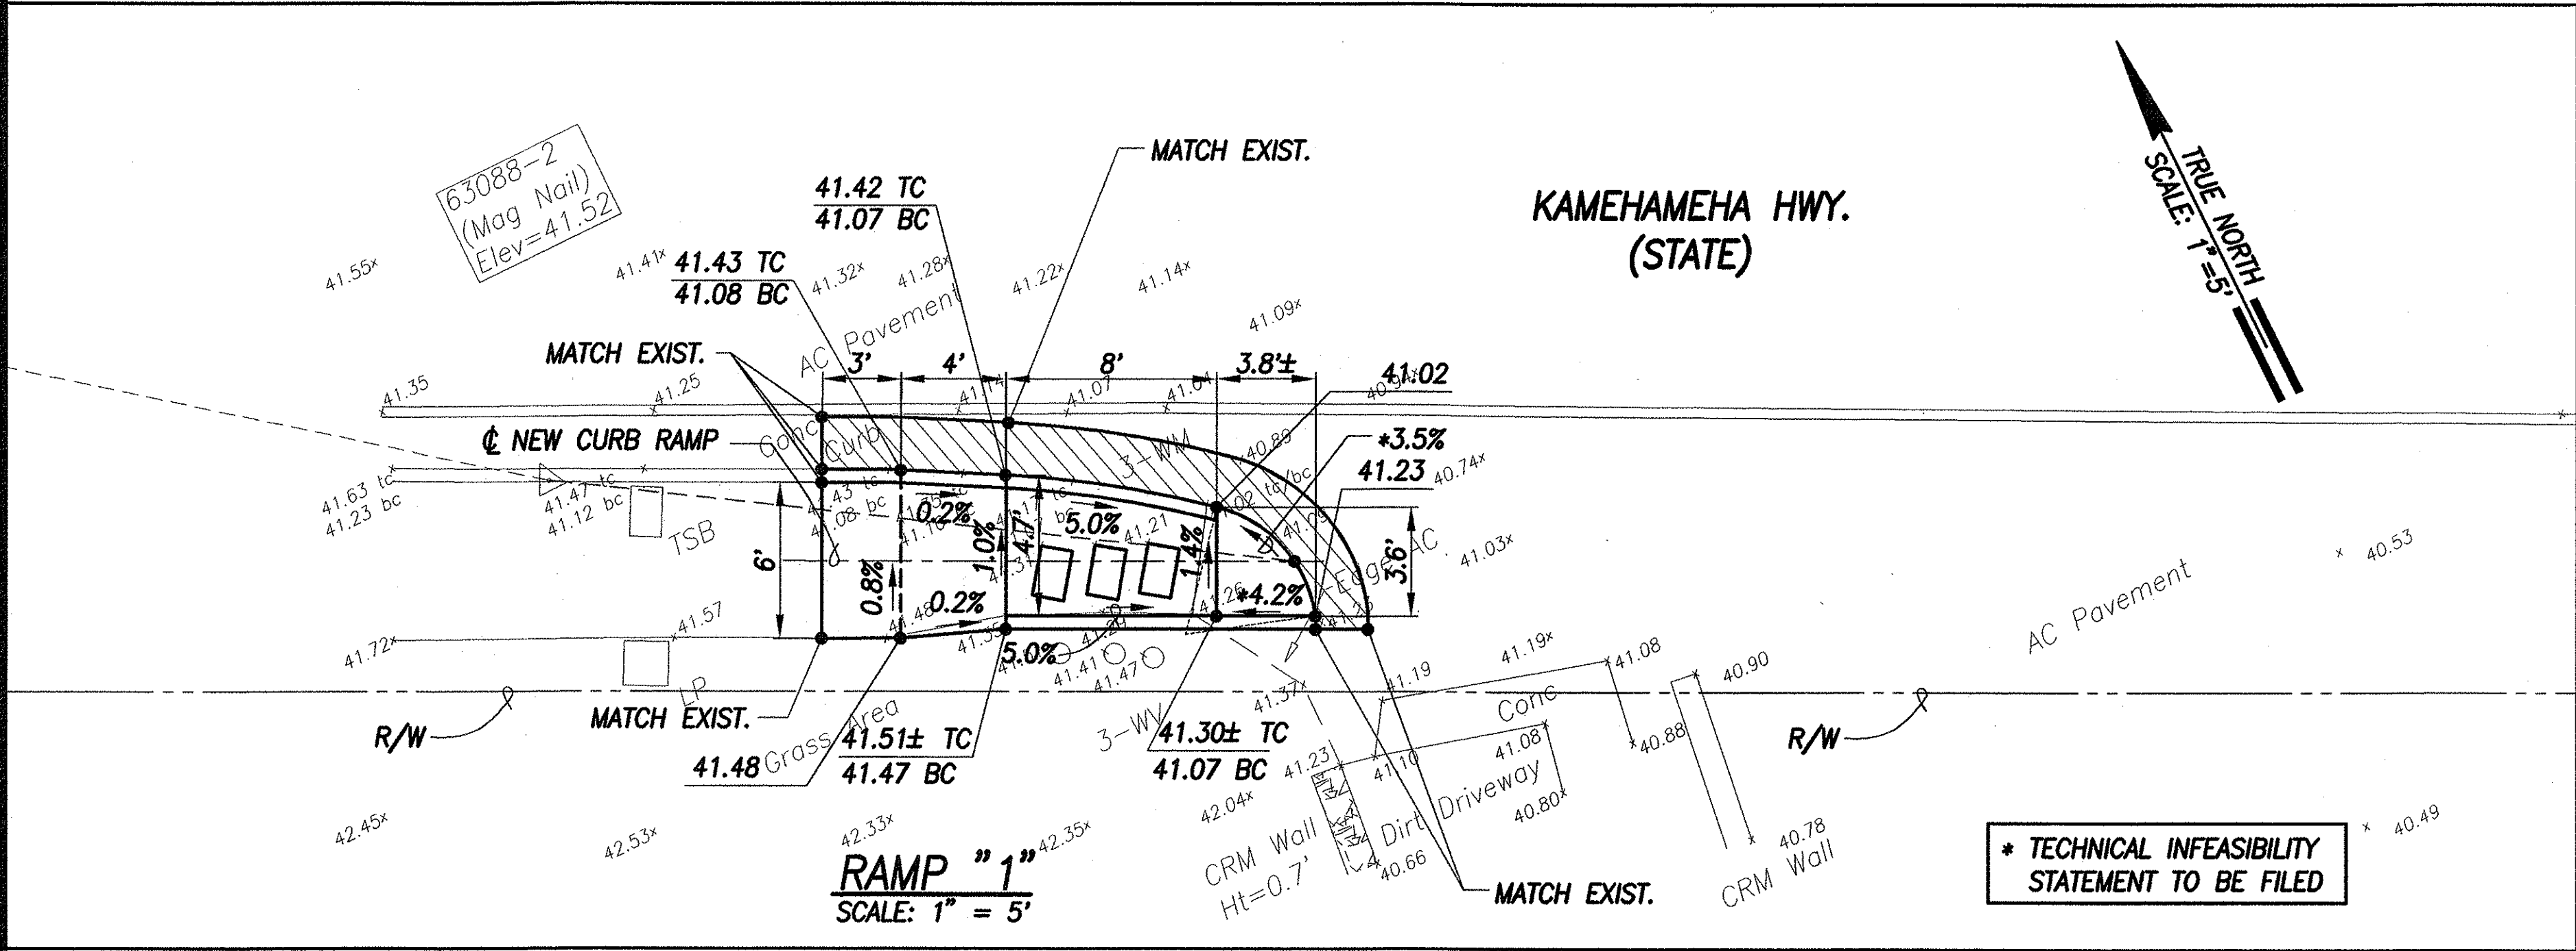



LEGEND

x 49.52	EXIST. SPOT ELEVATION
52.58	FINISHED SPOT GRADE
51.50 TC	FINISHED TOP OF CURB
51.00 BC	FINISHED BOTTOM OF CURB

DATE	_____
DESIGNED BY	_____
TRACED BY	_____
NOTED BY	_____
CHECKED BY	_____
ORIGINAL PLAN	_____
NOTE BOOK	_____
No.	_____

GRADING PLAN – KAMEHAMEHA HWY. & PEARL CITY GLASS SHOP
 INTERS. ID NO. 99-63088
 SCALE: 1" = 5'

[Signature]
 Principal Executive
 Maintenance Unit, BWS
 Date: 6/24/04

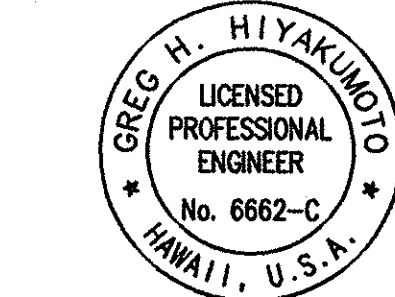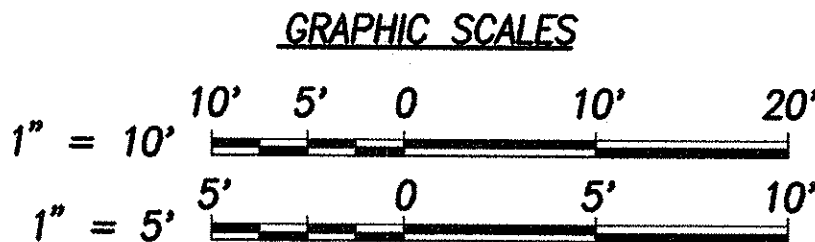


THIS WORK WAS PREPARED BY ME OR UNDER MY SUPERVISION AND CONSTRUCTION OF THIS PROJECT WILL BE UNDER MY OBSERVATION.

[Signature] April 30, 2006
 DATE



"OBSERVATION OF CONSTRUCTION" IS DEFINED IN CHAPTER 16-115, HAWAII ADMINISTRATIVE RULES ENTITLED "PROFESSIONAL ENGINEERS, ARCHITECTS, SURVEYORS AND LANDSCAPE ARCHITECTS".

STATE OF HAWAII
 DEPARTMENT OF TRANSPORTATION
 HIGHWAYS DIVISION
SITE & GRADING PLAN
KAMEHAMEHA HWY. & PEARL CITY GLASS SHOP
Pedestrian Facilities & ADA Compliance at Various Locations on Oahu, Unit 5
 Fed. Aid Proj. No. CMAQ-0300(96)
 Scale: AS SHOWN Date: August 2004
SHEET No. C-58 OF 153 SHEETS

FED. ROAD DIST. NO.	STATE	FED. AID PROJ. NO.	FISCAL YEAR	SHEET NO.	TOTAL SHEETS
HAWAII	HAW.	CMAQ-0300(96)	2004	60	153

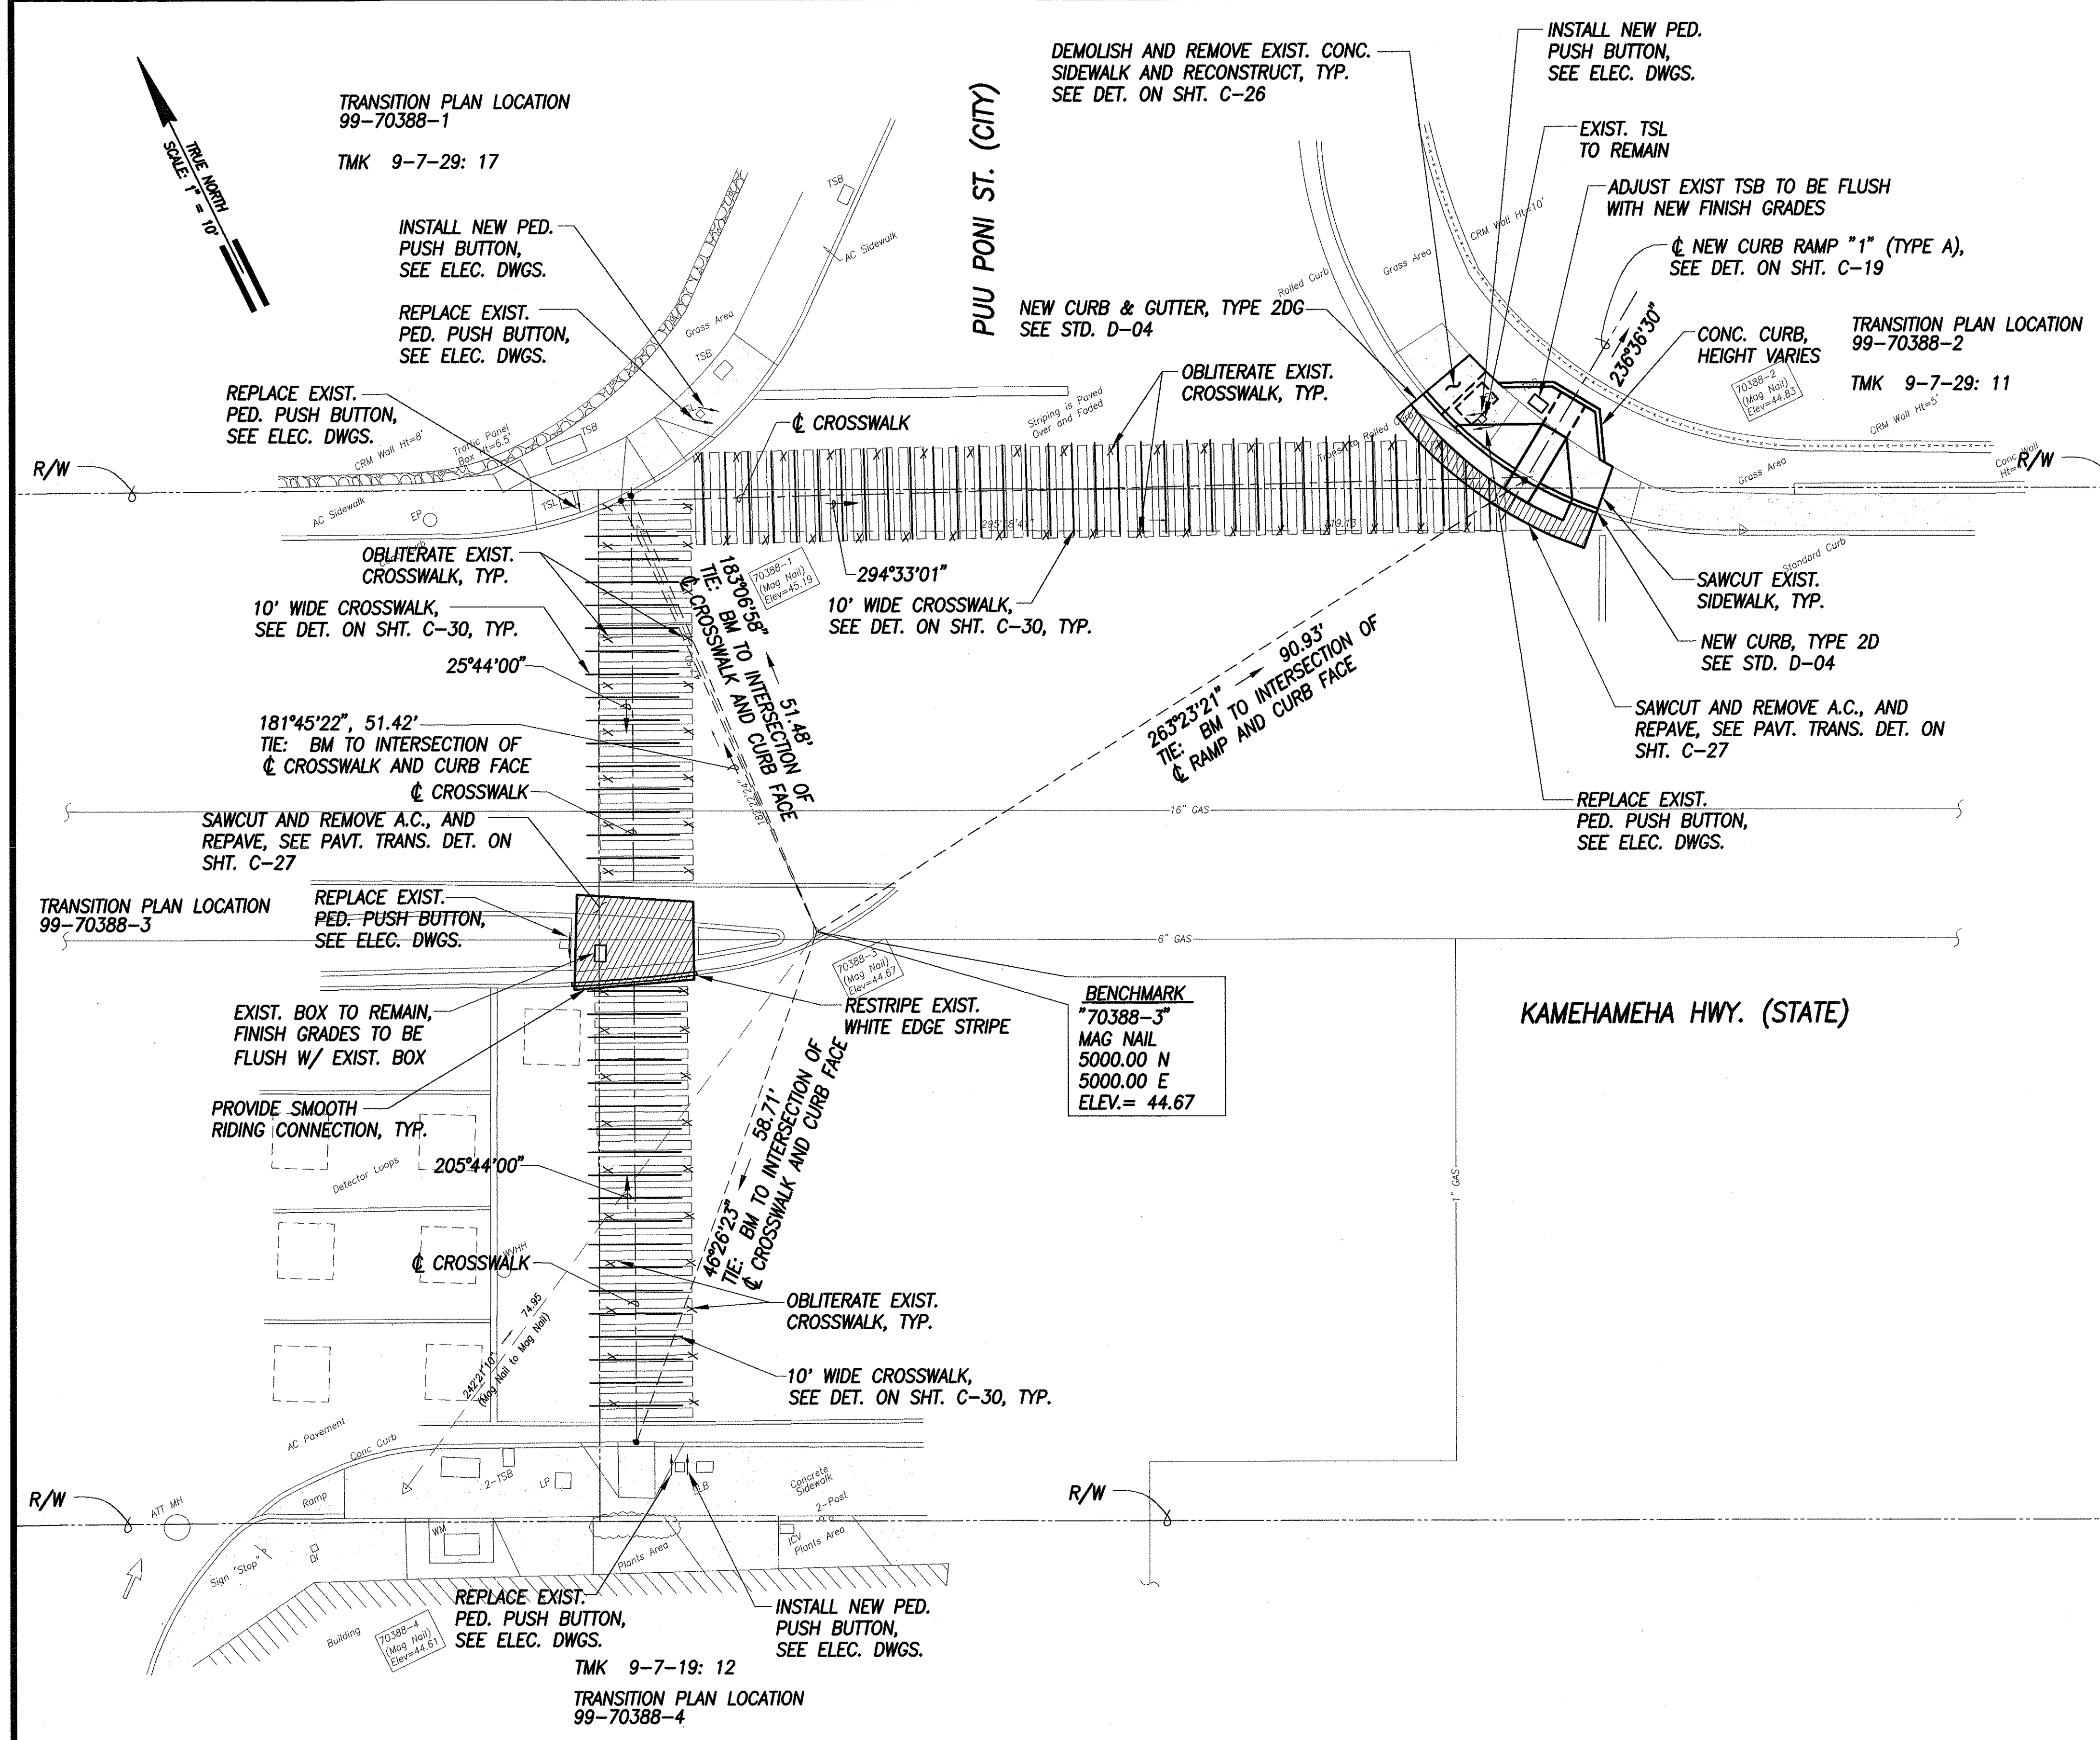

SITE PLAN - KAMEHAMEHA HWY. & PUU PONĪ ST.
INTERS. ID NO. 99-70388
 SCALE: 1" = 10'

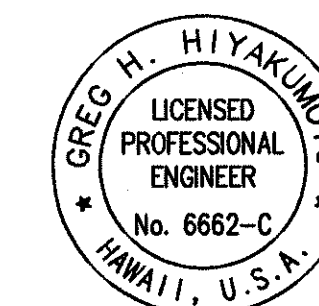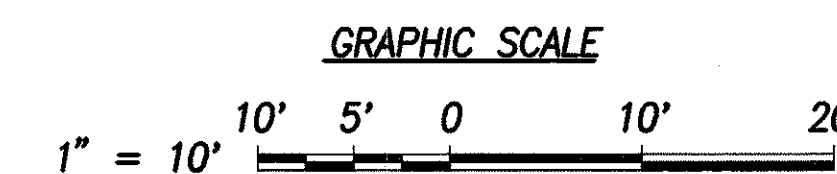


THIS WORK WAS PREPARED BY ME OR UNDER MY SUPERVISION AND CONSTRUCTION OF THIS PROJECT WILL BE UNDER MY OBSERVATION.

SIGNATURE: *Greg H. Hiyaunio* DATE: April 30, 2006

"OBSERVATION OF CONSTRUCTION" IS DEFINED IN CHAPTER 16-115, HAWAII ADMINISTRATIVE RULES ENTITLED "PROFESSIONAL ENGINEERS, ARCHITECTS, SURVEYORS AND LANDSCAPE ARCHITECTS".

STATE OF HAWAII
 DEPARTMENT OF TRANSPORTATION
 HIGHWAYS DIVISION
SITE PLAN
KAMEHAMEHA HWY. & PUU PONĪ ST.
Pedestrian Facilities & ADA Compliance
at Various Locations on Oahu, Unit 5
 Fed. Aid Proj. No. CMAQ-0300(96)
 Scale: 1" = 10'-0" Date: August 2004
SHEET No. C-59 OF 153 SHEETS


FED. ROAD DIST. NO.	STATE	FED. AID PROJ. NO.	FISCAL YEAR	SHEET NO.	TOTAL SHEETS
HAWAII	HAW.	CMAQ-0300(96)	2004	61	153

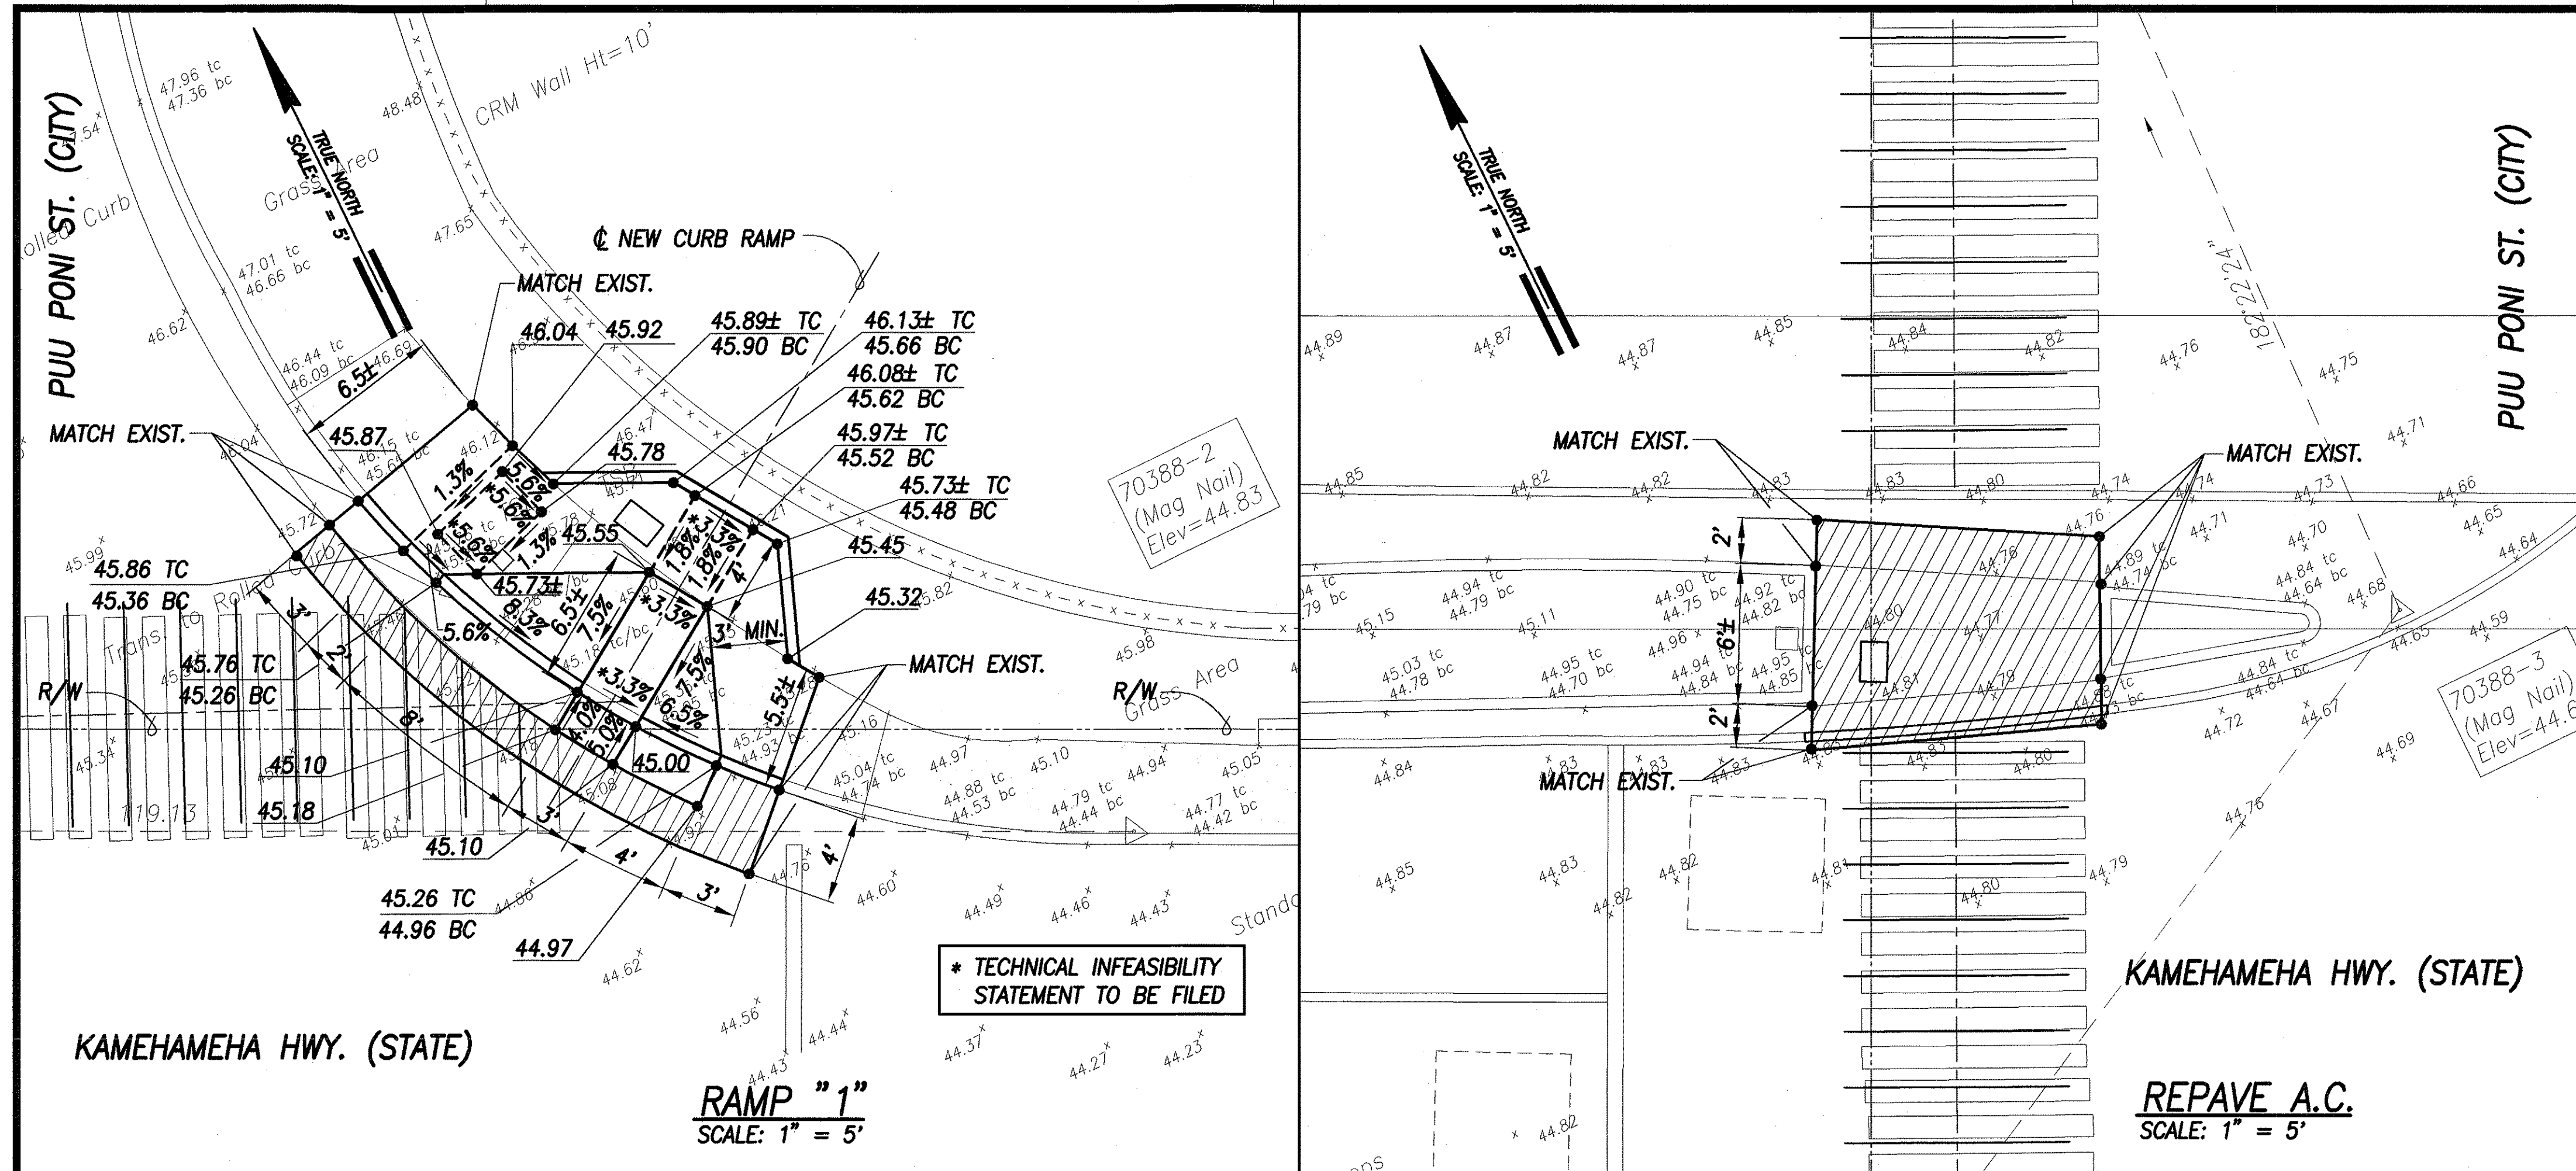

LEGEND	
× 49.52	EXIST. SPOT ELEVATION
52.58	FINISHED SPOT GRADE
51.50 TC	FINISHED TOP OF CURB
51.00 BC	FINISHED BOTTOM OF CURB

GRADING PLAN - KAMEHAMEHA HWY. & PUU PONI ST.
 INTERS. ID NO. 99-70388
 SCALE: 1" = 5'


DESIGNED BY	DATE
TRACED BY	
NOTED BY	
CHECKED BY	
ORIGINAL PLAN	
NOTE BOOK	
No.	

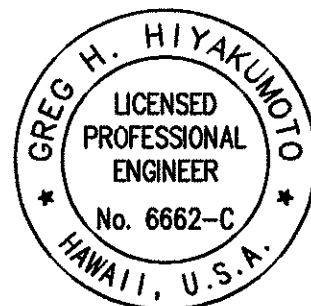

THIS WORK WAS PREPARED BY ME OR UNDER MY SUPERVISION AND CONSTRUCTION OF THIS PROJECT WILL BE UNDER MY OBSERVATION.

SIGNATURE: *Greg H. Hiyaumoto* DATE: April 30, 2006

"OBSERVATION OF CONSTRUCTION" IS DEFINED IN CHAPTER 16-115, HAWAII ADMINISTRATIVE RULES ENTITLED "PROFESSIONAL ENGINEERS, ARCHITECTS, SURVEYORS AND LANDSCAPE ARCHITECTS".

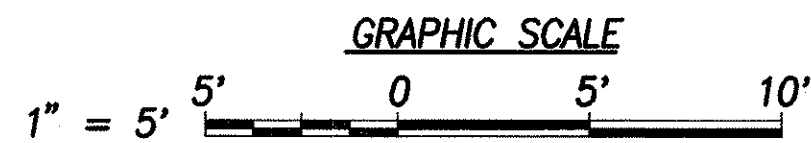

STATE OF HAWAII
 DEPARTMENT OF TRANSPORTATION
 HIGHWAYS DIVISION
GRADING PLAN
KAMEHAMEHA HWY. & PUU PONI ST.
Pedestrian Facilities & ADA Compliance at Various Locations on Oahu, Unit 5
 Fed. Aid Proj. No. CMAQ-0300(96)
 Scale: 1" = 5'-0" Date: August 2004
SHEET No. C-60 OF 153 SHEETS

FED. ROAD DIST. NO.	STATE	FED. AID PROJ. NO.	FISCAL YEAR	SHEET NO.	TOTAL SHEETS
HAWAII	HAW.	CMAQ-0300(96)	2004	63	153

KAMEHAMEHA HWY. (STATE)


CHEVRON

TMK 9-7-19: 10

TRANSITION PLAN LOCATION
99-70788-1

IGLESIA NI KRISTO CHURCH

SITE PLAN - KAMEHAMEHA HWY. & IGLESIA NI KRISTO CHURCH
INTERS. ID NO. 99-70788
 SCALE: 1" = 10'

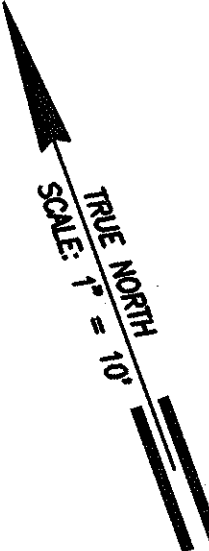

BENCHMARK
 "70788-1"
 MAG NAIL
 5000.00 N
 5000.00 E
 ELEV.= 43.38

SAWCUT AND REMOVE A.C., AND
 REPAVE, SEE PAVT. TRANS. DET. ON
 SHT. C-27

PROVIDE SMOOTH
 RIDING TRANSITION, TYP.


KAMEHAMEHA HWY. (STATE)

REPAVE A.C.
 SCALE: 1" = 5'

GRADING PLAN - KAMEHAMEHA HWY. & IGLESIA NI KRISTO CHURCH
INTERS. ID NO. 99-70788
 SCALE: 1" = 5'

LEGEND

- × 49.52 EXIST. SPOT ELEVATION
- 52.58 FINISHED SPOT GRADE
- 51.50 TC FINISHED TOP OF CURB
- 51.00 BC FINISHED BOTTOM OF CURB

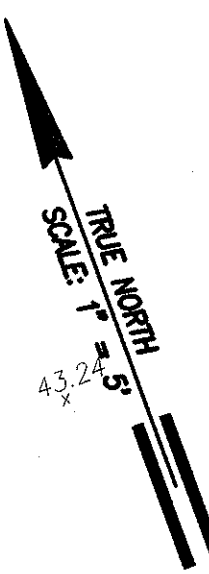


70788-1
 (Mag Nail)
 Elev=43.38



THIS WORK WAS PREPARED BY ME OR UNDER
 MY SUPERVISION AND CONSTRUCTION OF THIS
 PROJECT WILL BE UNDER MY OBSERVATION.

DATE: April 30, 2006
 SIGNATURE: [Signature]

"OBSERVATION OF CONSTRUCTION" IS DEFINED
 IN CHAPTER 16-115, HAWAII ADMINISTRATIVE
 RULES ENTITLED "PROFESSIONAL ENGINEERS,
 ARCHITECTS, SURVEYORS AND LANDSCAPE
 ARCHITECTS".

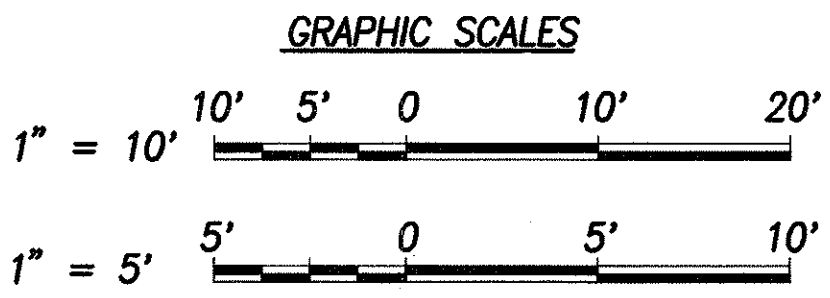

STATE OF HAWAII
 DEPARTMENT OF TRANSPORTATION
 HIGHWAYS DIVISION

**SITE & GRADING PLAN - KAMEHAMEHA
 HWY. & IGLESIA NI KRISTO CHURCH**

*Pedestrian Facilities & ADA Compliance
 at Various Locations on Oahu, Unit 5*


Fed. Aid Proj. No. CMAQ-0300(96)

Scale: AS SHOWN Date: August 2004

SHEET No. C-62 OF 153 SHEETS




DATE	_____
SURVEY PLANNED BY	_____
DRAWN BY	_____
TRACED BY	_____
DESIGNED BY	_____
QUANTITIES BY	_____
CHECKED BY	_____
ORIGINAL PLAN	_____
NOTE BOOK	_____
No.	_____

FED. ROAD DIST. NO.	STATE	FED. AID PROJ. NO.	FISCAL YEAR	SHEET NO.	TOTAL SHEETS
HAWAII	HAW.	CMAQ-0300(96)	2004	64	153

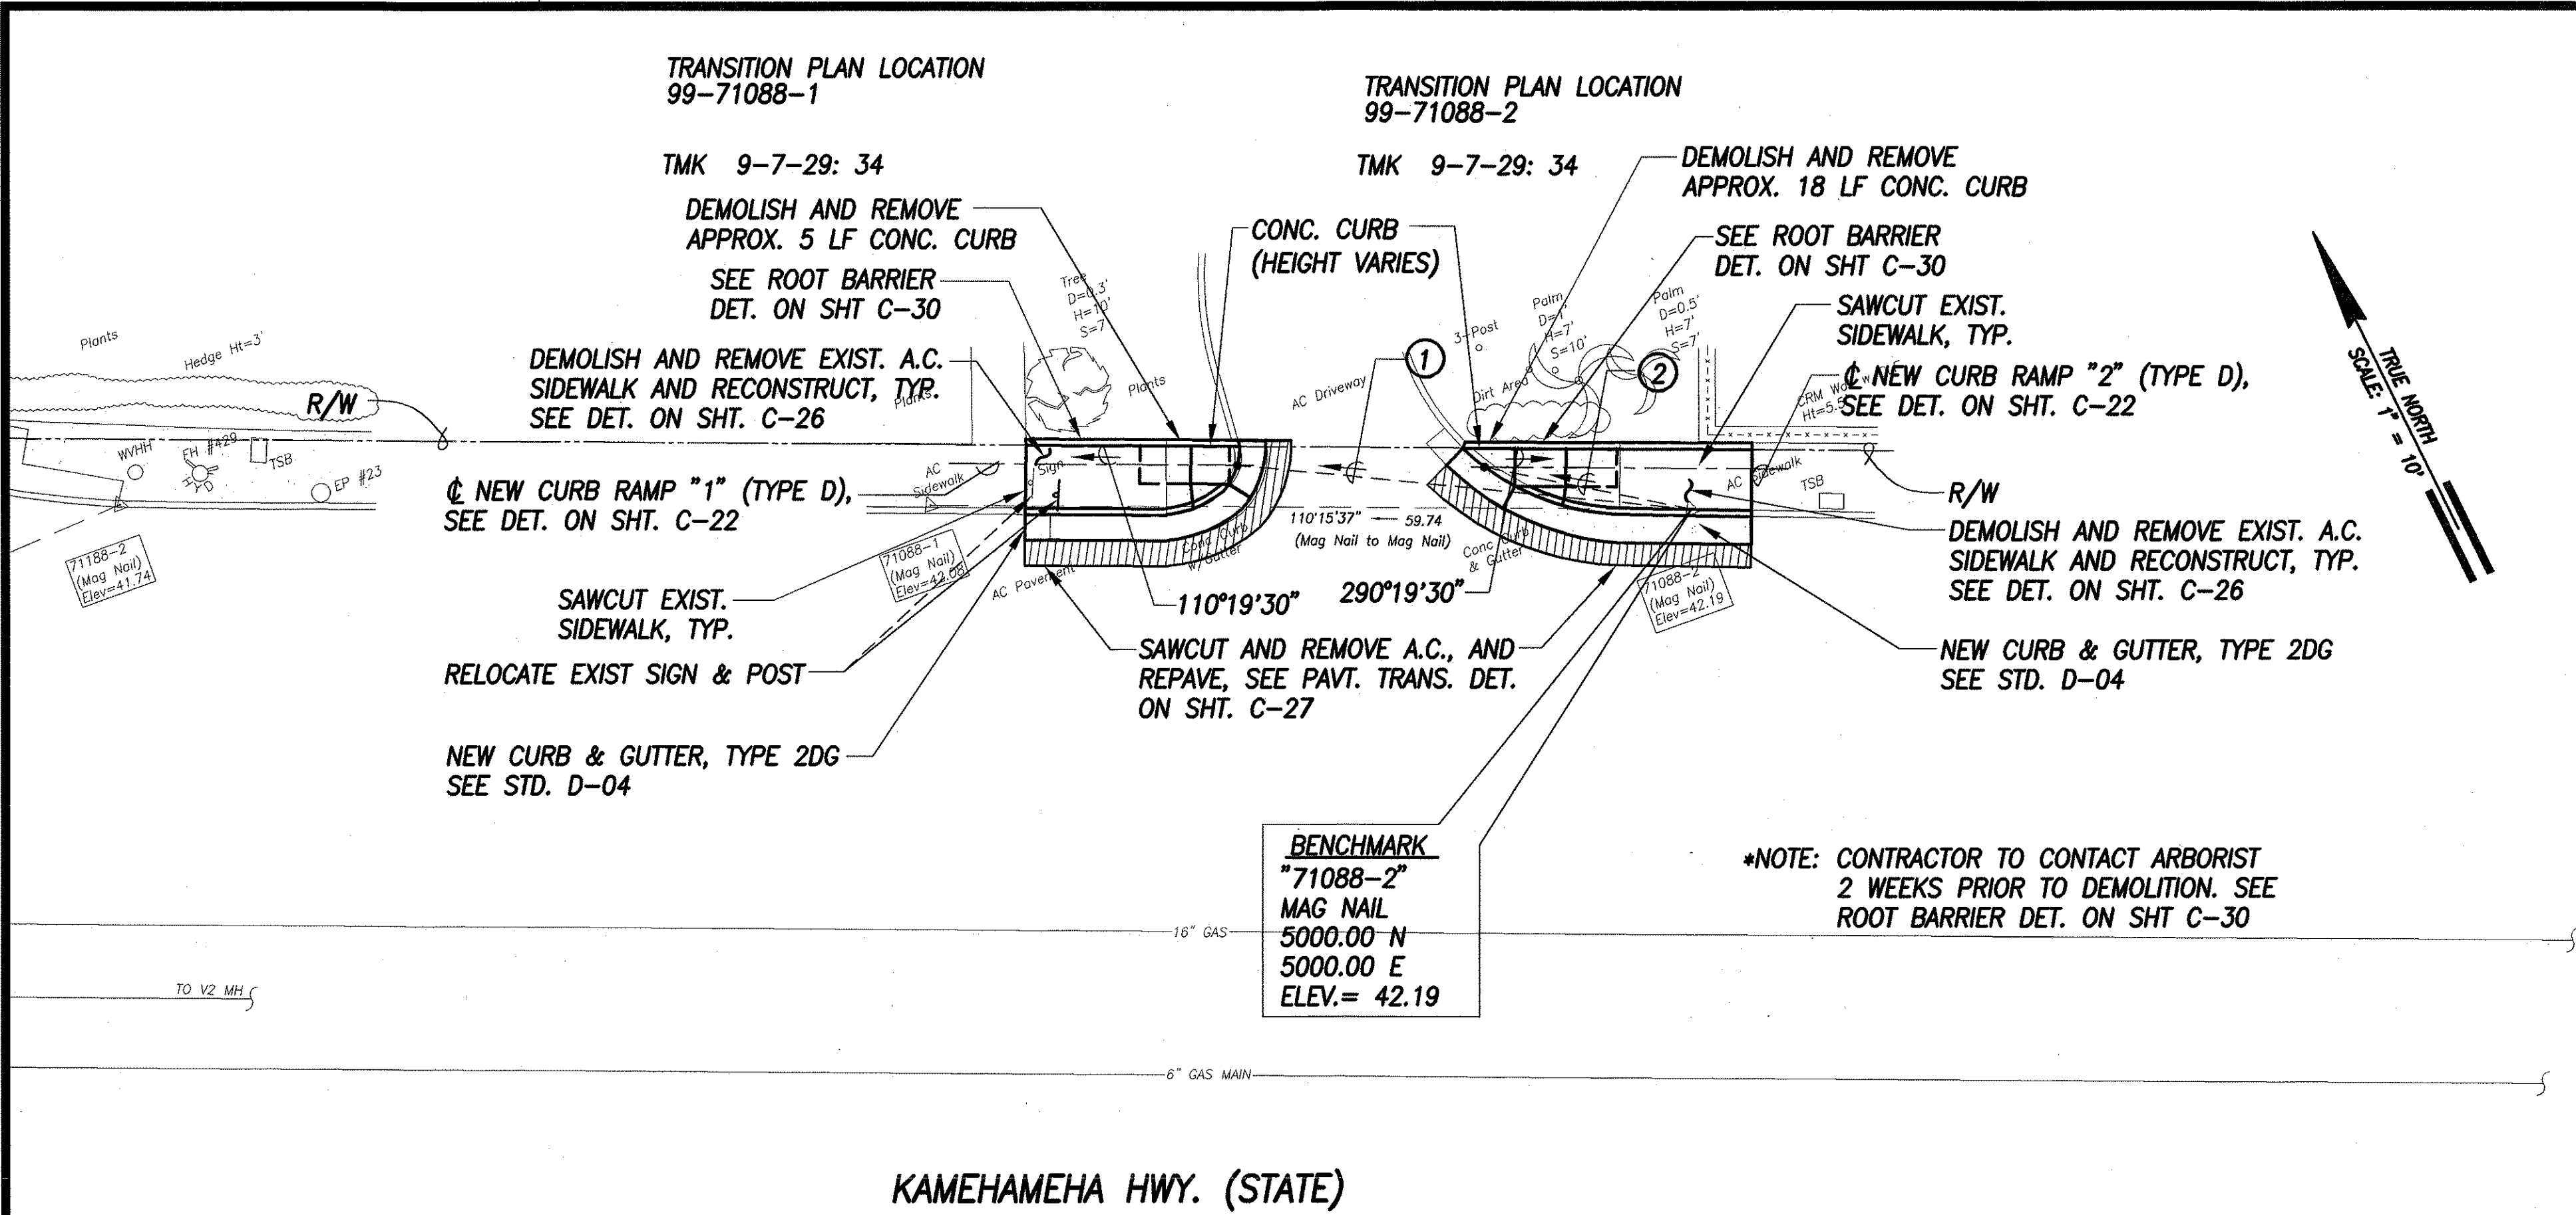

SITE PLAN - KAMEHAMEHA HWY. & ZIPPY'S
INTERS. ID NO. 99-71088
SCALE: 1" = 10'

- LEGEND
- × 49.52 EXIST. SPOT ELEVATION
 - 52.58 FINISHED SPOT GRADE
 - 51.50 TC FINISHED TOP OF CURB
 - 51.00 BC FINISHED BOTTOM OF CURB

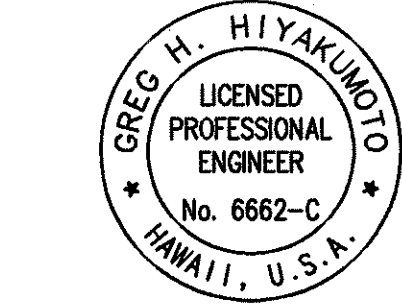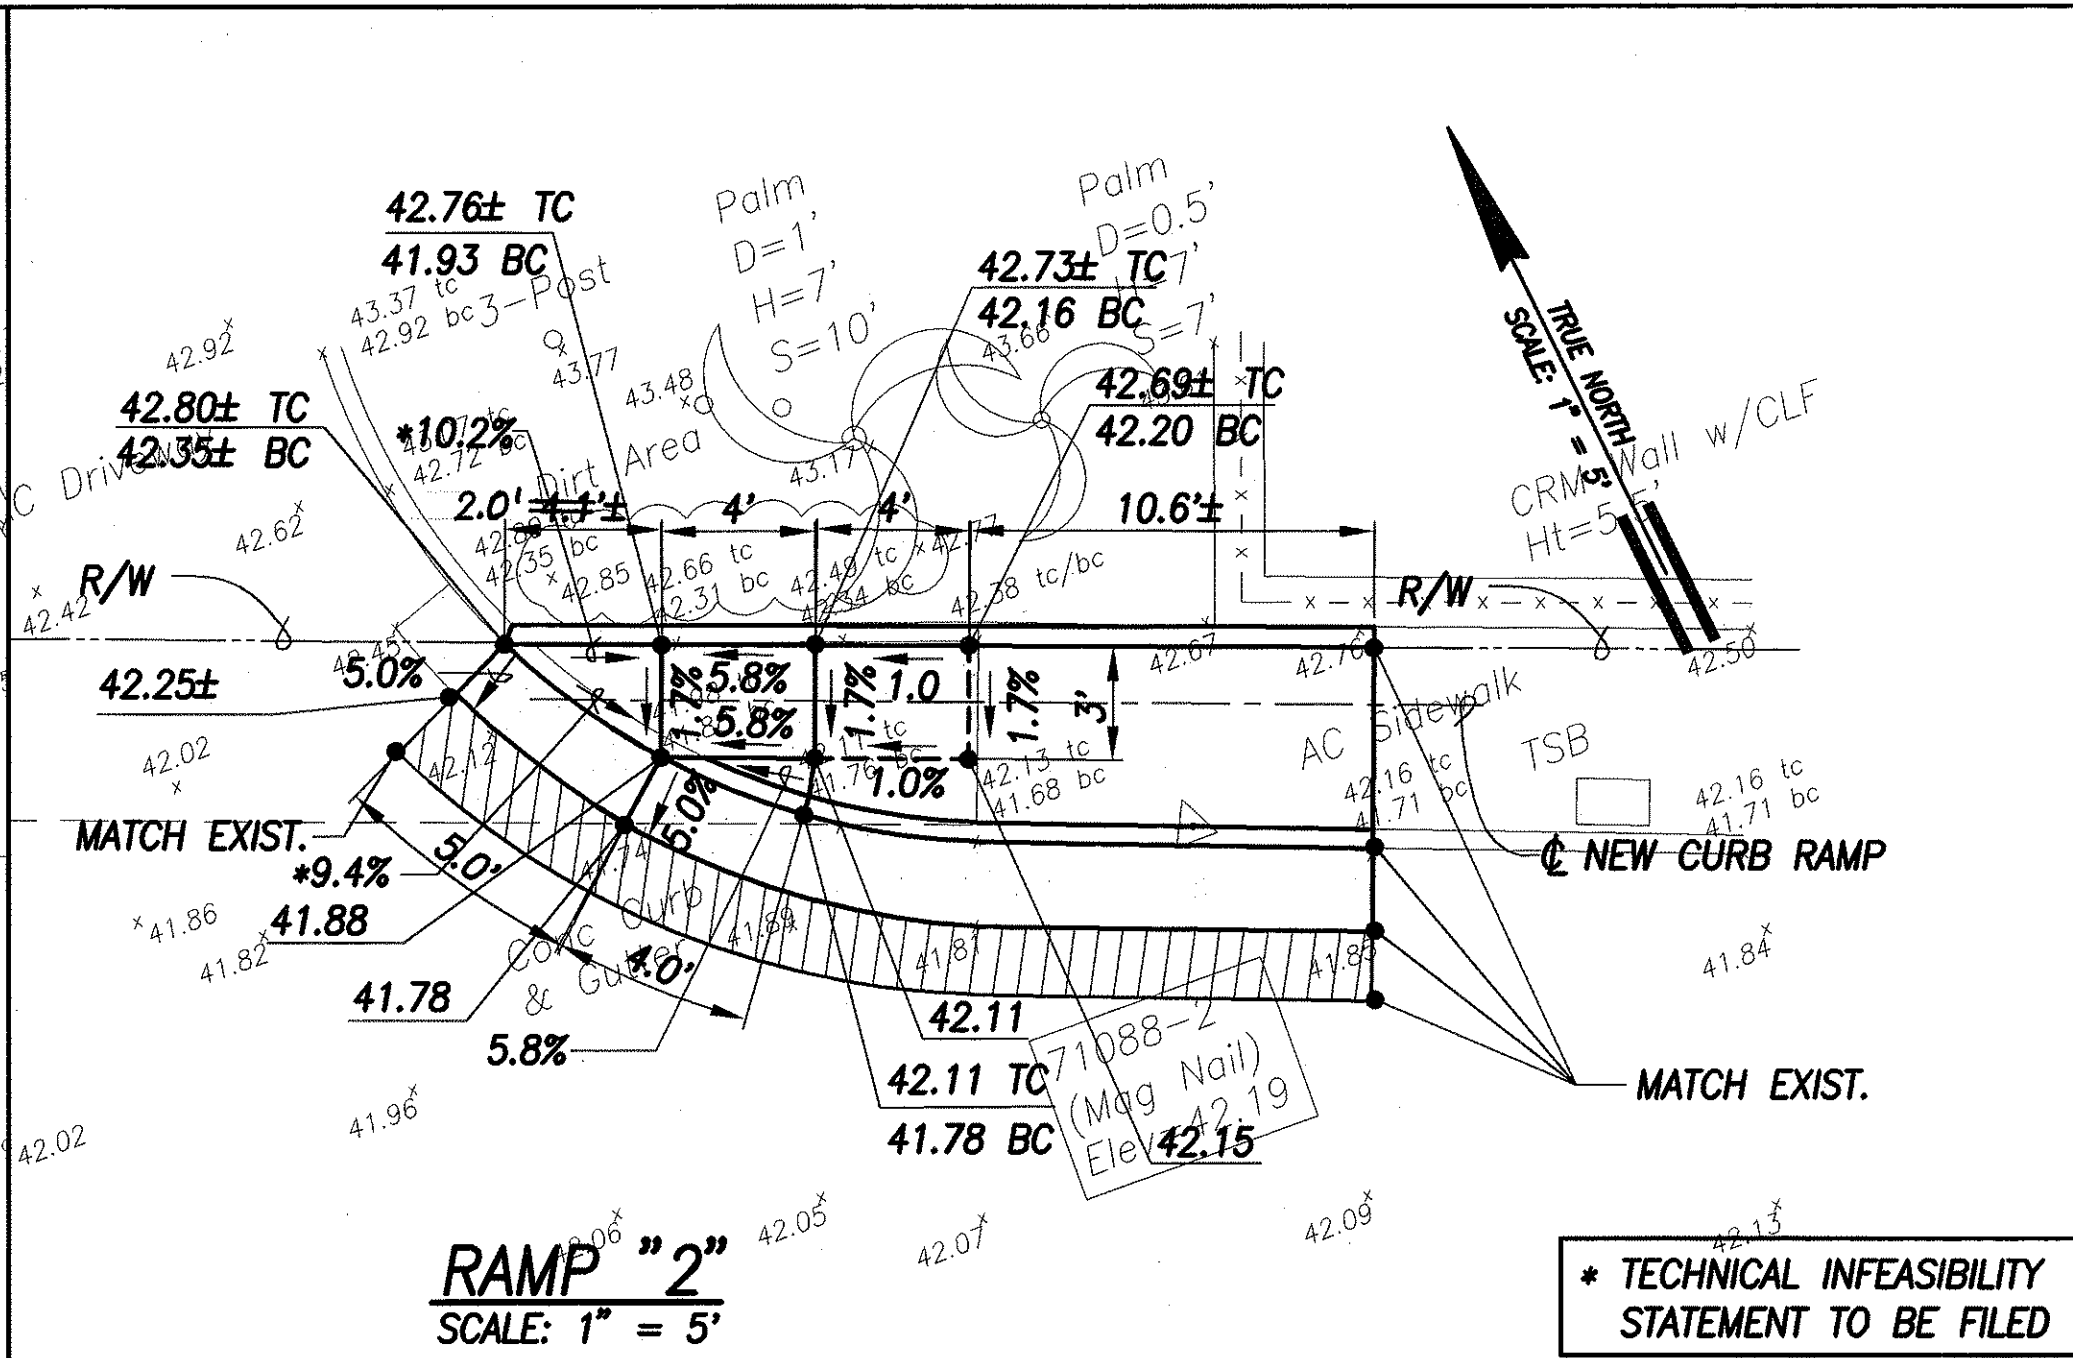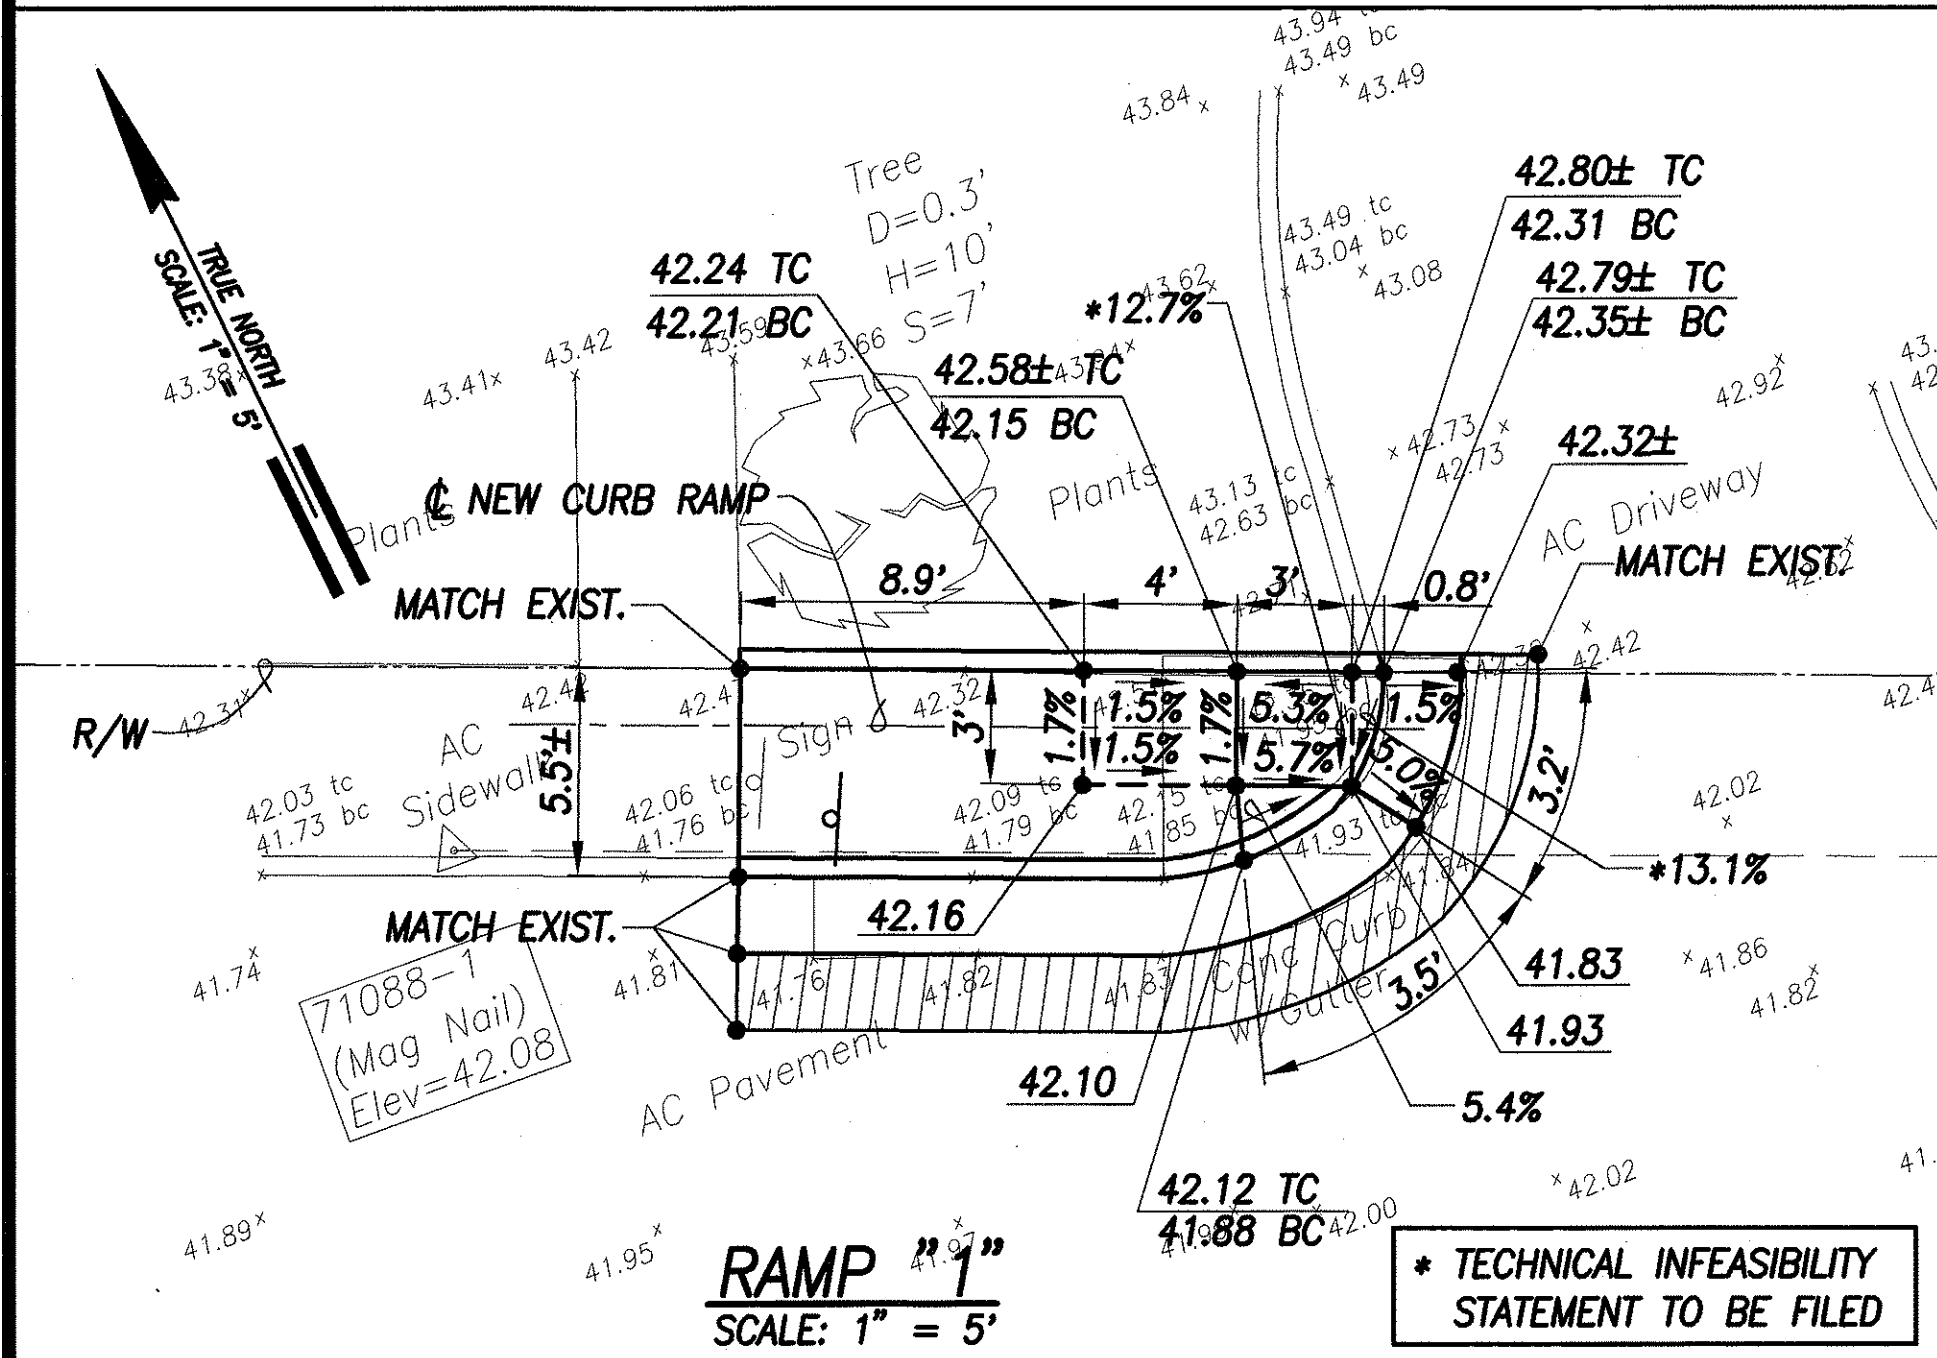

STATE OF HAWAII
DEPARTMENT OF TRANSPORTATION
HIGHWAYS DIVISION

SITE & GRADING PLAN
KAMEHAMEHA HWY. & ZIPPY'S

*Pedestrian Facilities & ADA Compliance
at Various Locations on Oahu, Unit 5*

Fed. Aid Proj. No. CMAQ-0300(96)

Scale: AS SHOWN Date: August 2004


SHEET No. C-63 OF 153 SHEETS

THIS WORK WAS PREPARED BY ME OR UNDER MY SUPERVISION AND CONSTRUCTION OF THIS PROJECT WILL BE UNDER MY OBSERVATION.

DATE 4/30/2006


SIGNATURE [Signature] DATE 4/30/2006

"OBSERVATION OF CONSTRUCTION" IS DEFINED IN CHAPTER 16-115, HAWAII ADMINISTRATIVE RULES ENTITLED "PROFESSIONAL ENGINEERS, ARCHITECTS, SURVEYORS AND LANDSCAPE ARCHITECTS".

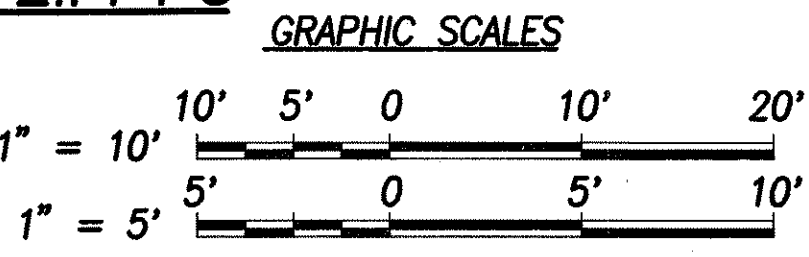

DATE	
DESIGNED BY	
CHECKED BY	
NOTED BY	
ORIGINAL PLAN	
NO.	

FED. ROAD DIST. NO.	STATE	FED. AID PROJ. NO.	FISCAL YEAR	SHEET NO.	TOTAL SHEETS
HAWAII	HAW.	CMAQ-0300(96)	2004	65	153

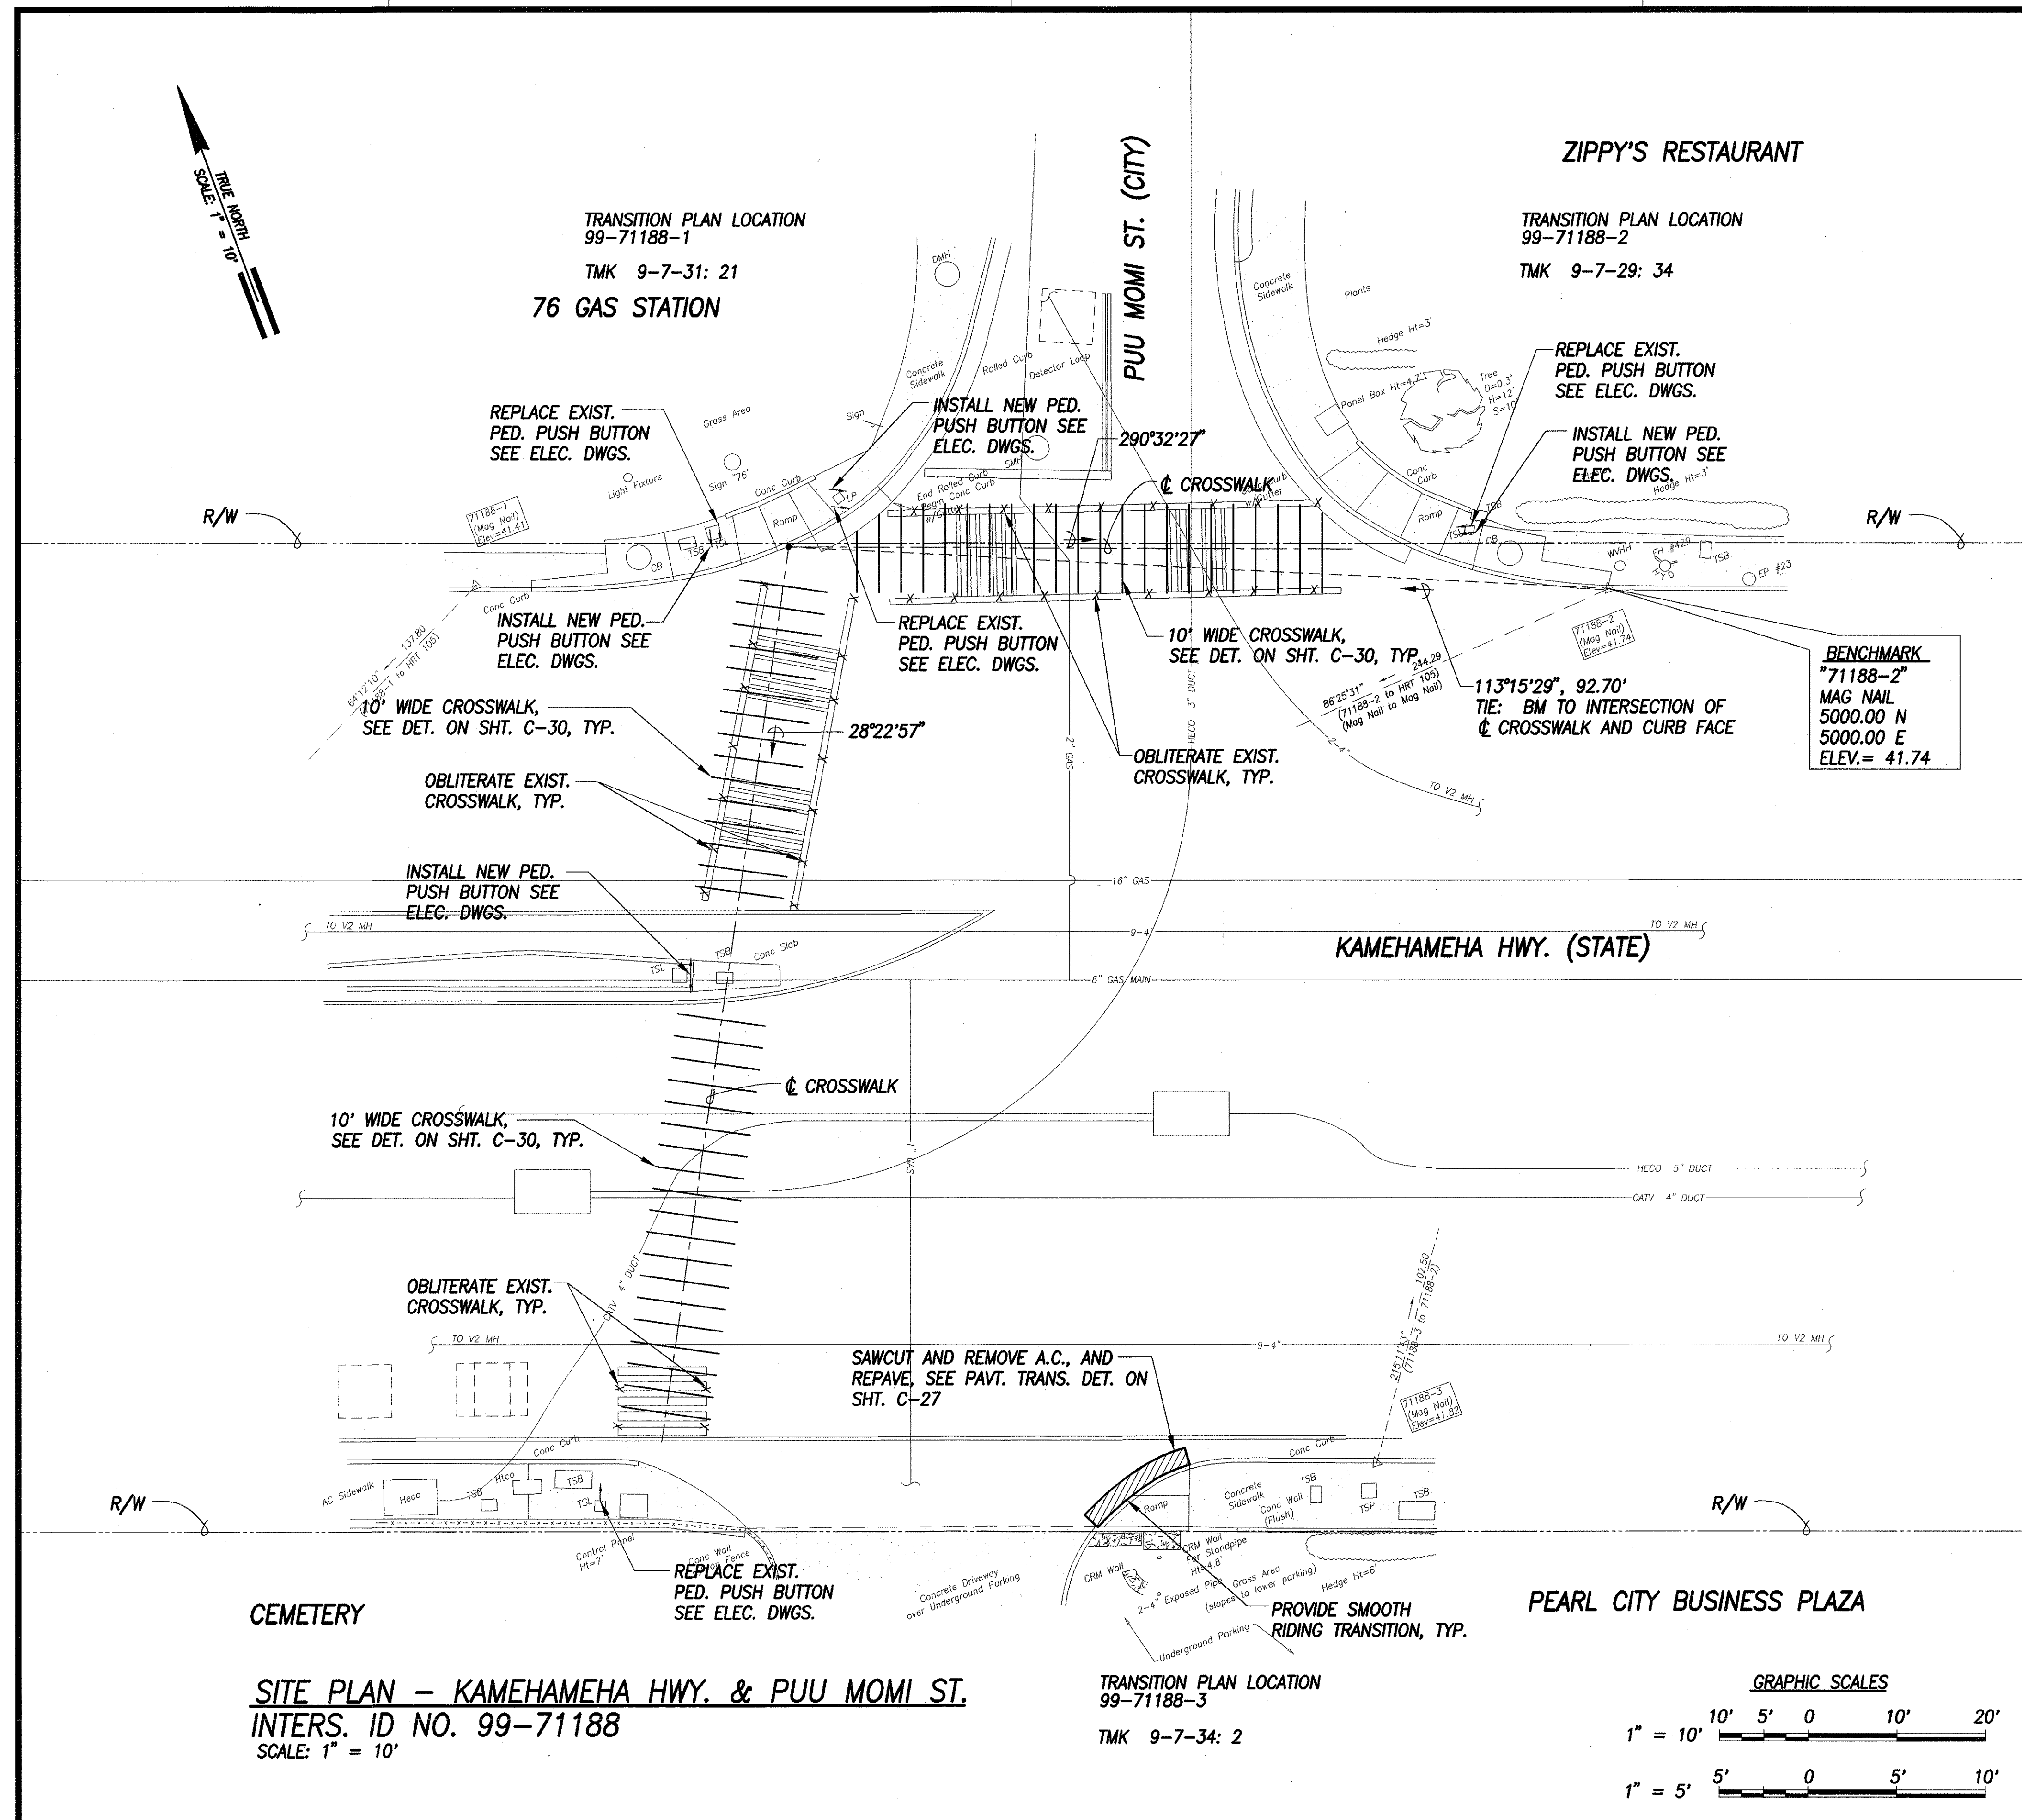

ORIGINAL PLAN	SURVEY PLOTTED BY _____ DATE _____
NOTE BOOK	DRAWN BY _____
	TRACED BY _____
	DESIGNED BY _____
	QUANTITIES BY _____
No. _____	CHECKED BY _____

LEGEND

× 49.52 EXIST. SPOT ELEVATION

52.58 FINISHED SPOT GRADE

● 51.50 TC FINISHED TOP OF CURB

● 51.00 BC FINISHED BOTTOM OF CURB



THIS WORK WAS PREPARED BY ME OR UNDER MY SUPERVISION AND CONSTRUCTION OF THIS PROJECT WILL BE UNDER MY OBSERVATION.

Sheng Li Hsienkwan April 30, 2006
SIGNATURE 871104 DATE *OK*

"OBSERVATION OF CONSTRUCTION" IS DEFINED IN CHAPTER 16-115, HAWAII ADMINISTRATIVE RULES ENTITLED "PROFESSIONAL ENGINEERS, ARCHITECTS, SURVEYORS AND LANDSCAPE ARCHITECTS".

STATE OF HAWAII
DEPARTMENT OF TRANSPORTATION
HIGHWAYS DIVISION



SITE & GRADING PLAN
KAMEHAMEHA HWY. & PUU MOMI ST.

Pedestrian Facilities & ADA Compliance
at Various Locations on Oahu, Unit 5
Fed. Aid Proj. No. CMAQ-0300(96)

Scale: AS SHOWN Date: August 2004

SHEET No. C-64 OF 153 SHEETS


FED. ROAD DIST. NO.	STATE	FED. AID PROJ. NO.	FISCAL YEAR	SHEET NO.	TOTAL SHEETS
HAWAII	HAW.	CMAQ-0300(96)	2004	66	153

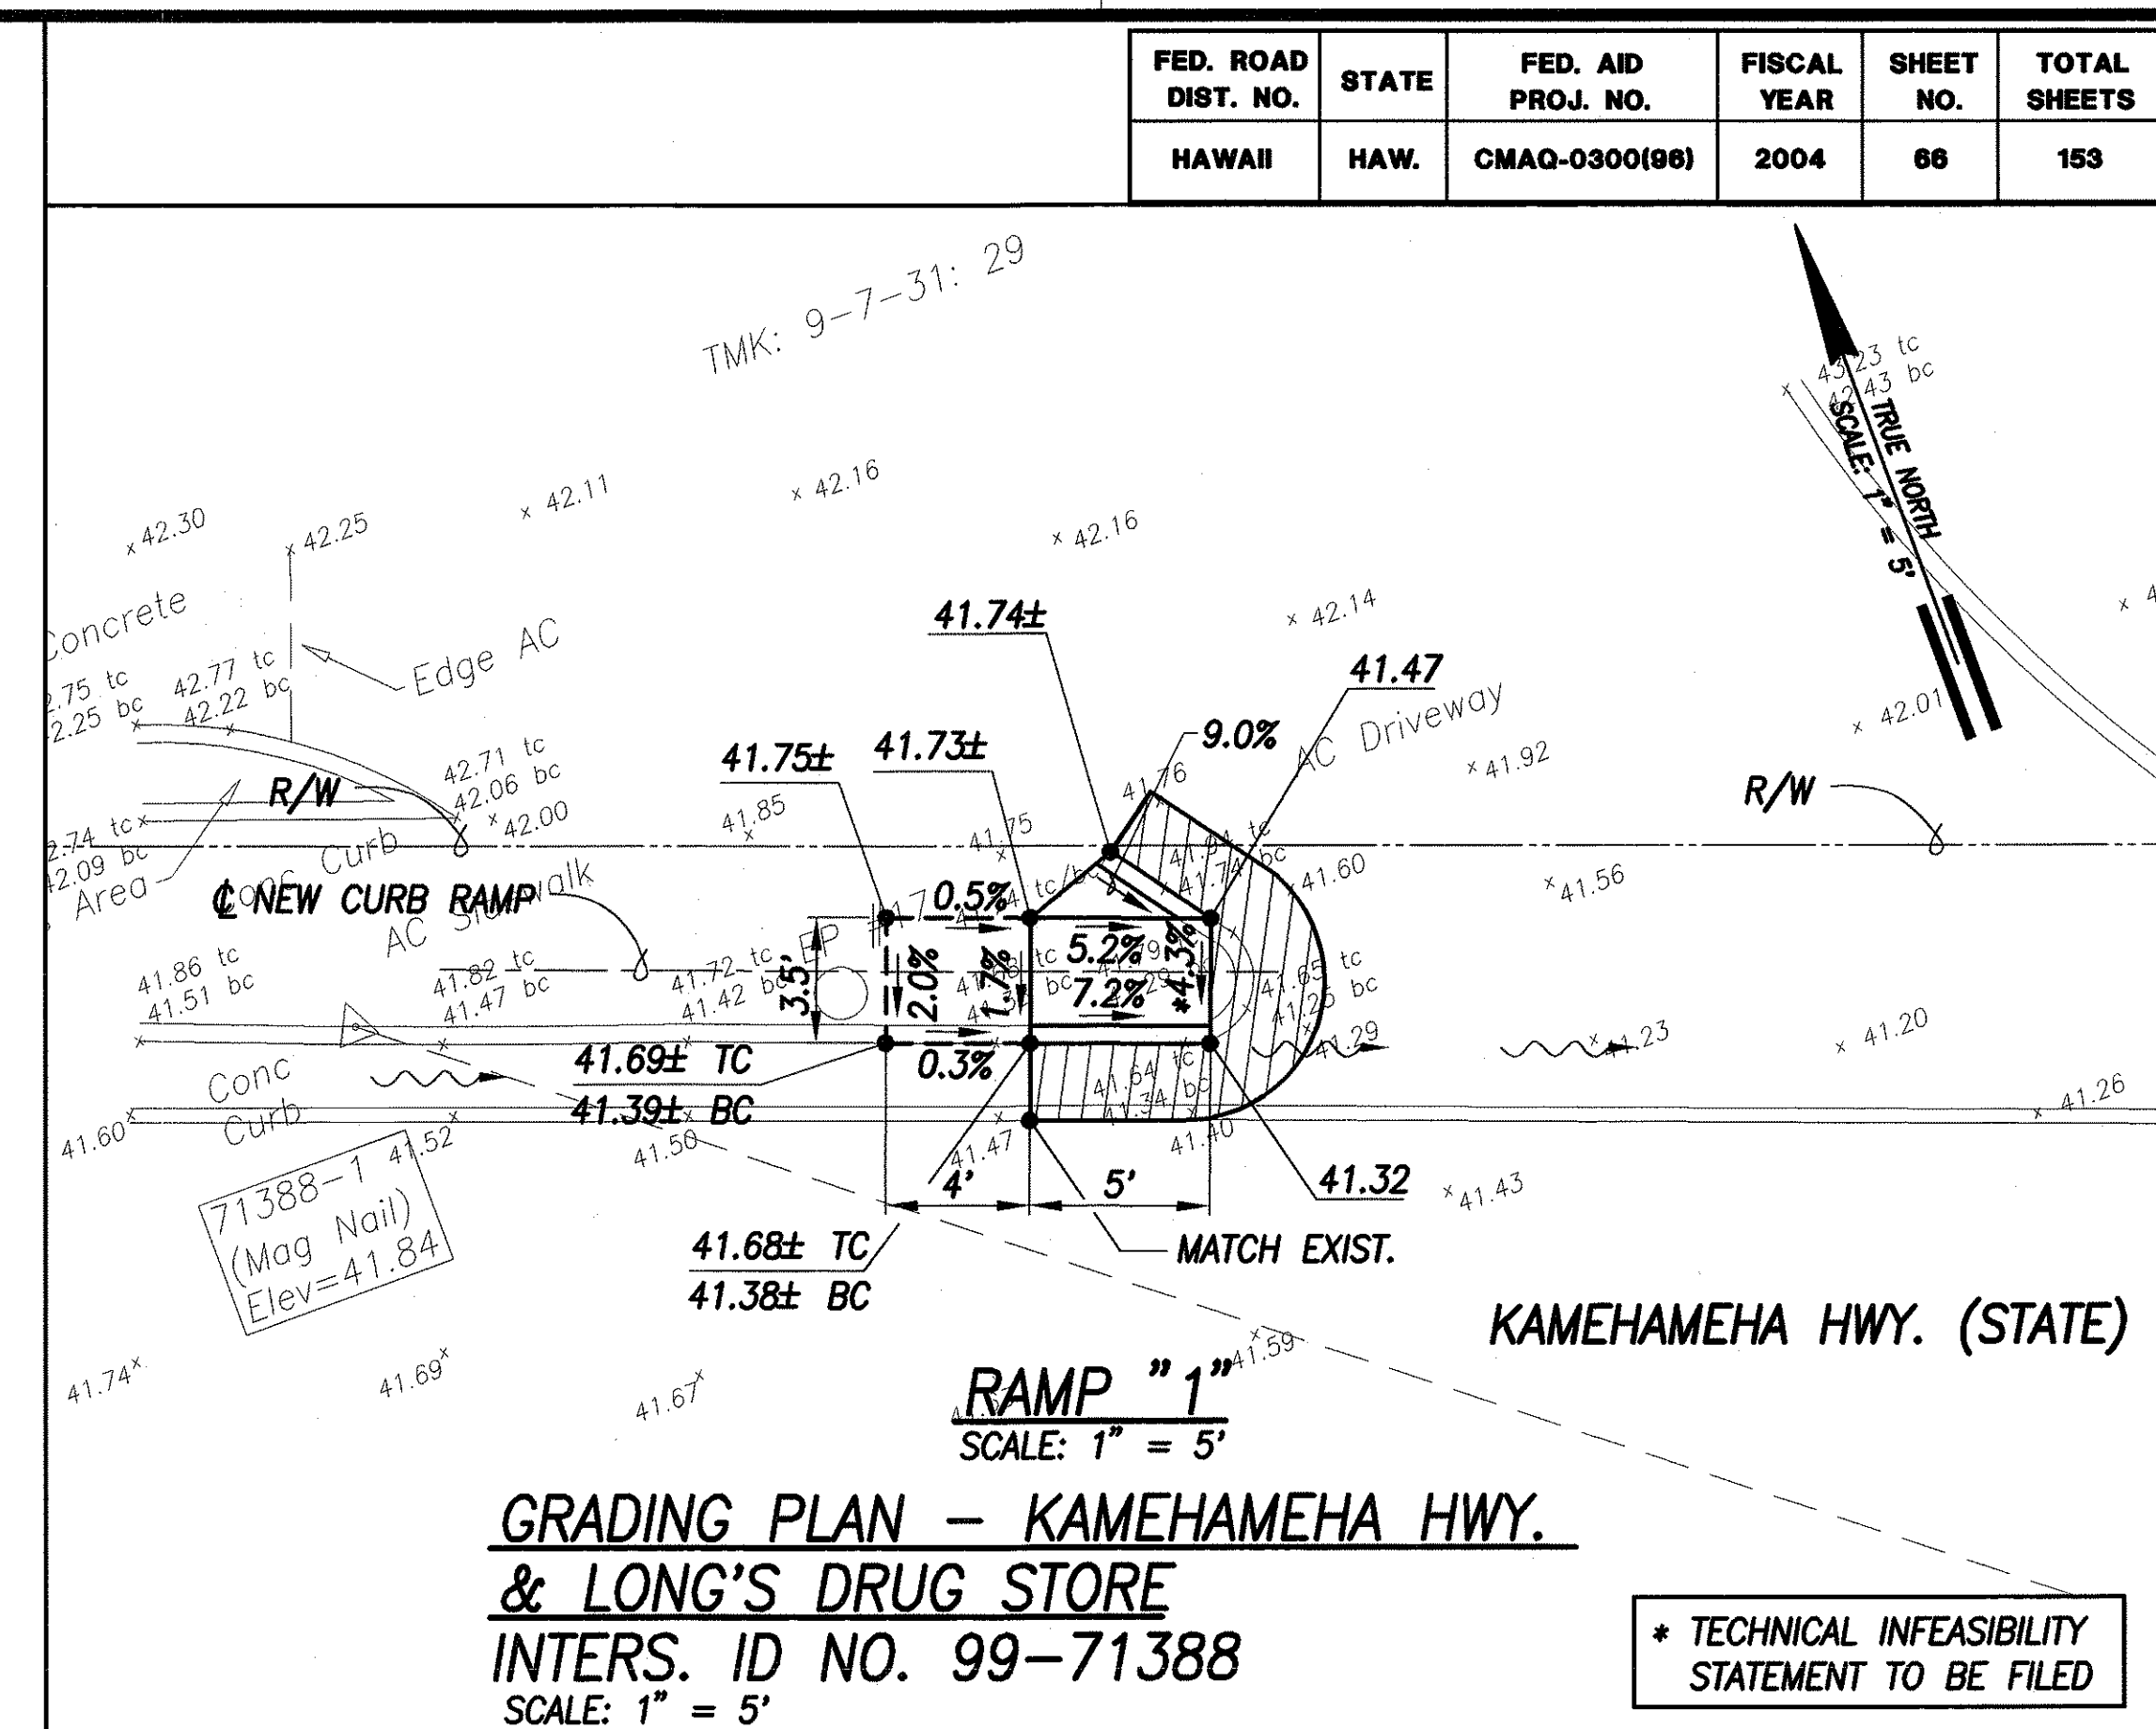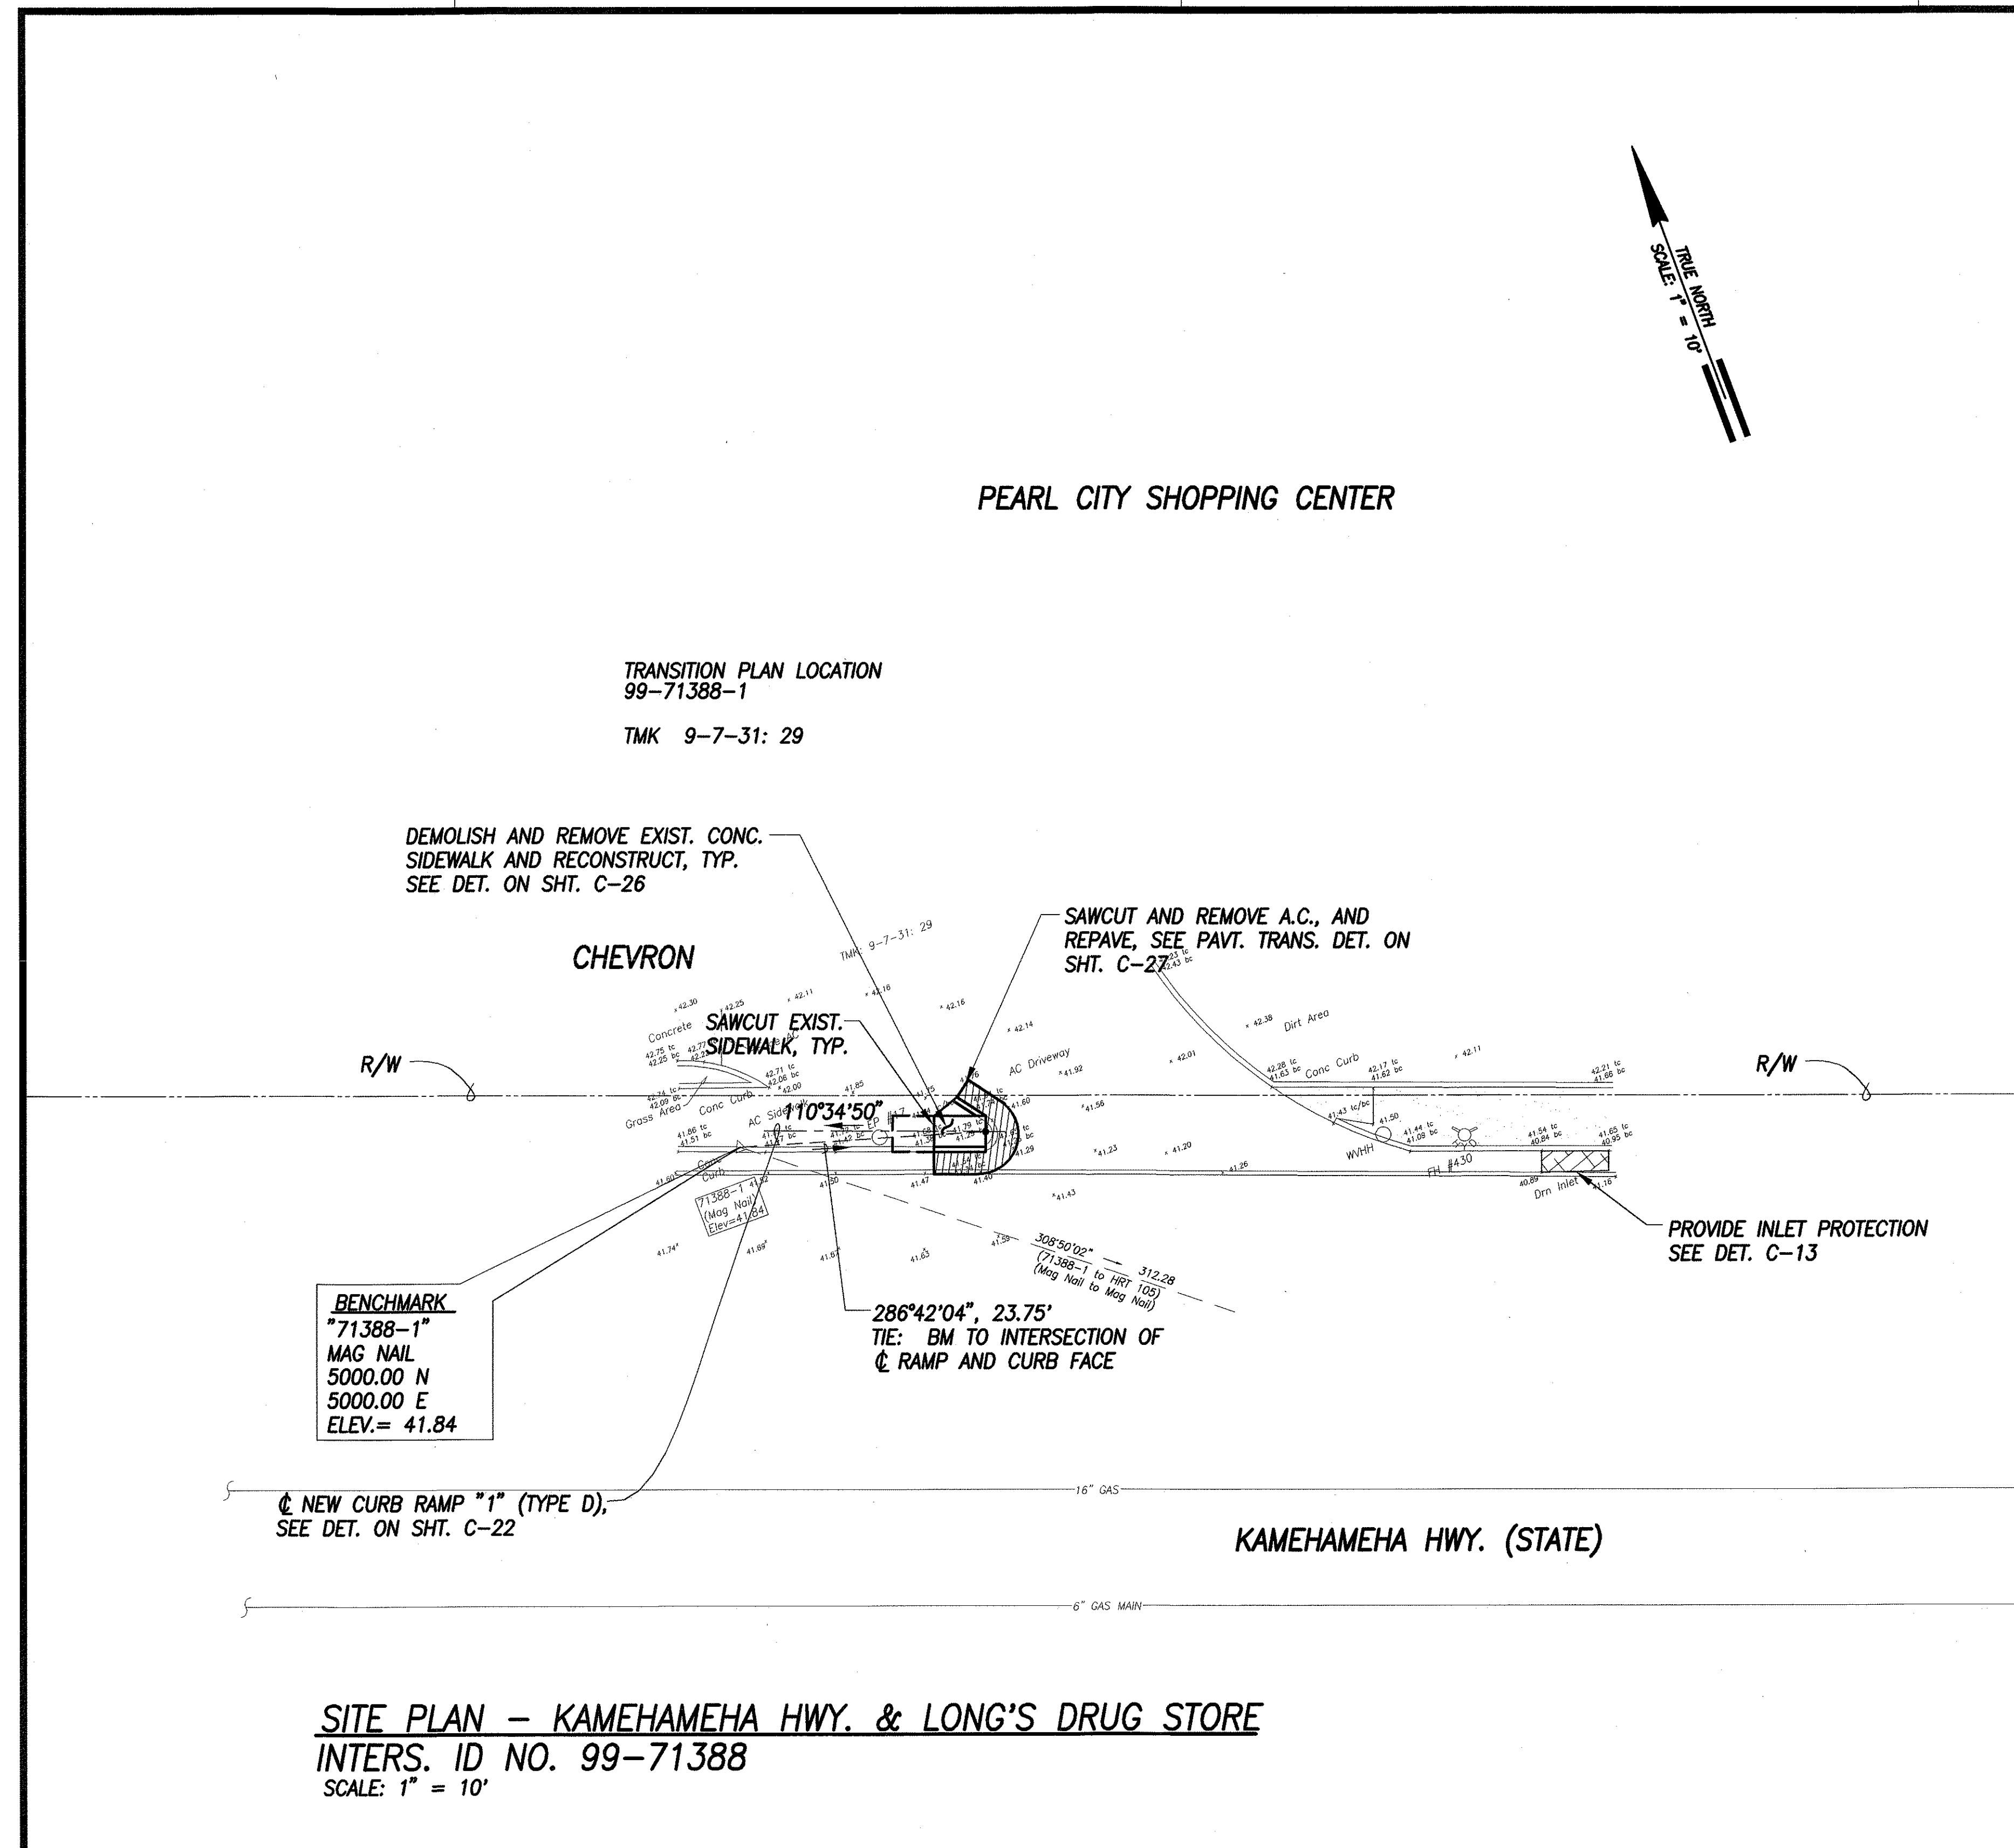

LEGEND

x 49.52	EXIST. SPOT ELEVATION
52.58	FINISHED SPOT GRADE
51.50 TC	FINISHED TOP OF CURB
51.00 BC	FINISHED BOTTOM OF CURB

DATE	_____
SURVEY PLOTTED BY	_____
DESIGNED BY	_____
QUANTITIES BY	_____
CHECKED BY	_____
NO.	_____

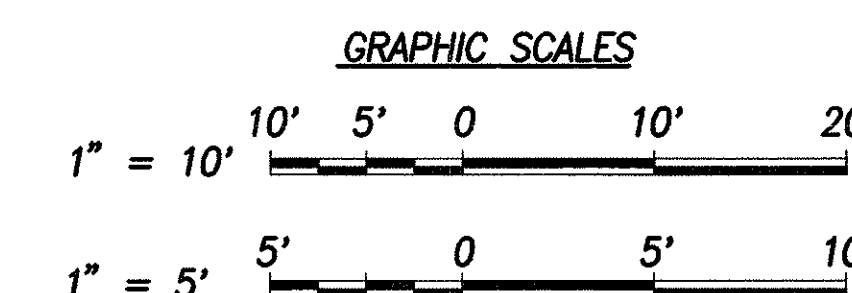

THIS WORK WAS PREPARED BY ME OR UNDER MY SUPERVISION AND CONSTRUCTION OF THIS PROJECT WILL BE UNDER MY OBSERVATION.

SIGNATURE: *Greg H. Hiyaquino* DATE: April 30, 2006

"OBSERVATION OF CONSTRUCTION" IS DEFINED IN CHAPTER 16-115, HAWAII ADMINISTRATIVE RULES ENTITLED "PROFESSIONAL ENGINEERS, ARCHITECTS, SURVEYORS AND LANDSCAPE ARCHITECTS".

STATE OF HAWAII
DEPARTMENT OF TRANSPORTATION
HIGHWAYS DIVISION



SITE & GRADING PLAN
KAMEHAMEHA HWY. & LONG'S DRUG STORE

Pedestrian Facilities & ADA Compliance
at Various Locations on Oahu, Unit 5
Fed. Aid Proj. No. CMAQ-0300(96)

Scale: AS SHOWN Date: August 2004

SHEET No. C-65 OF 153 SHEETS

FED. ROAD DIST. NO.	STATE	FED. AID PROJ. NO.	FISCAL YEAR	SHEET NO.	TOTAL SHEETS
HAWAII	HAW.	CMAQ-0300(96)	2004	67	153

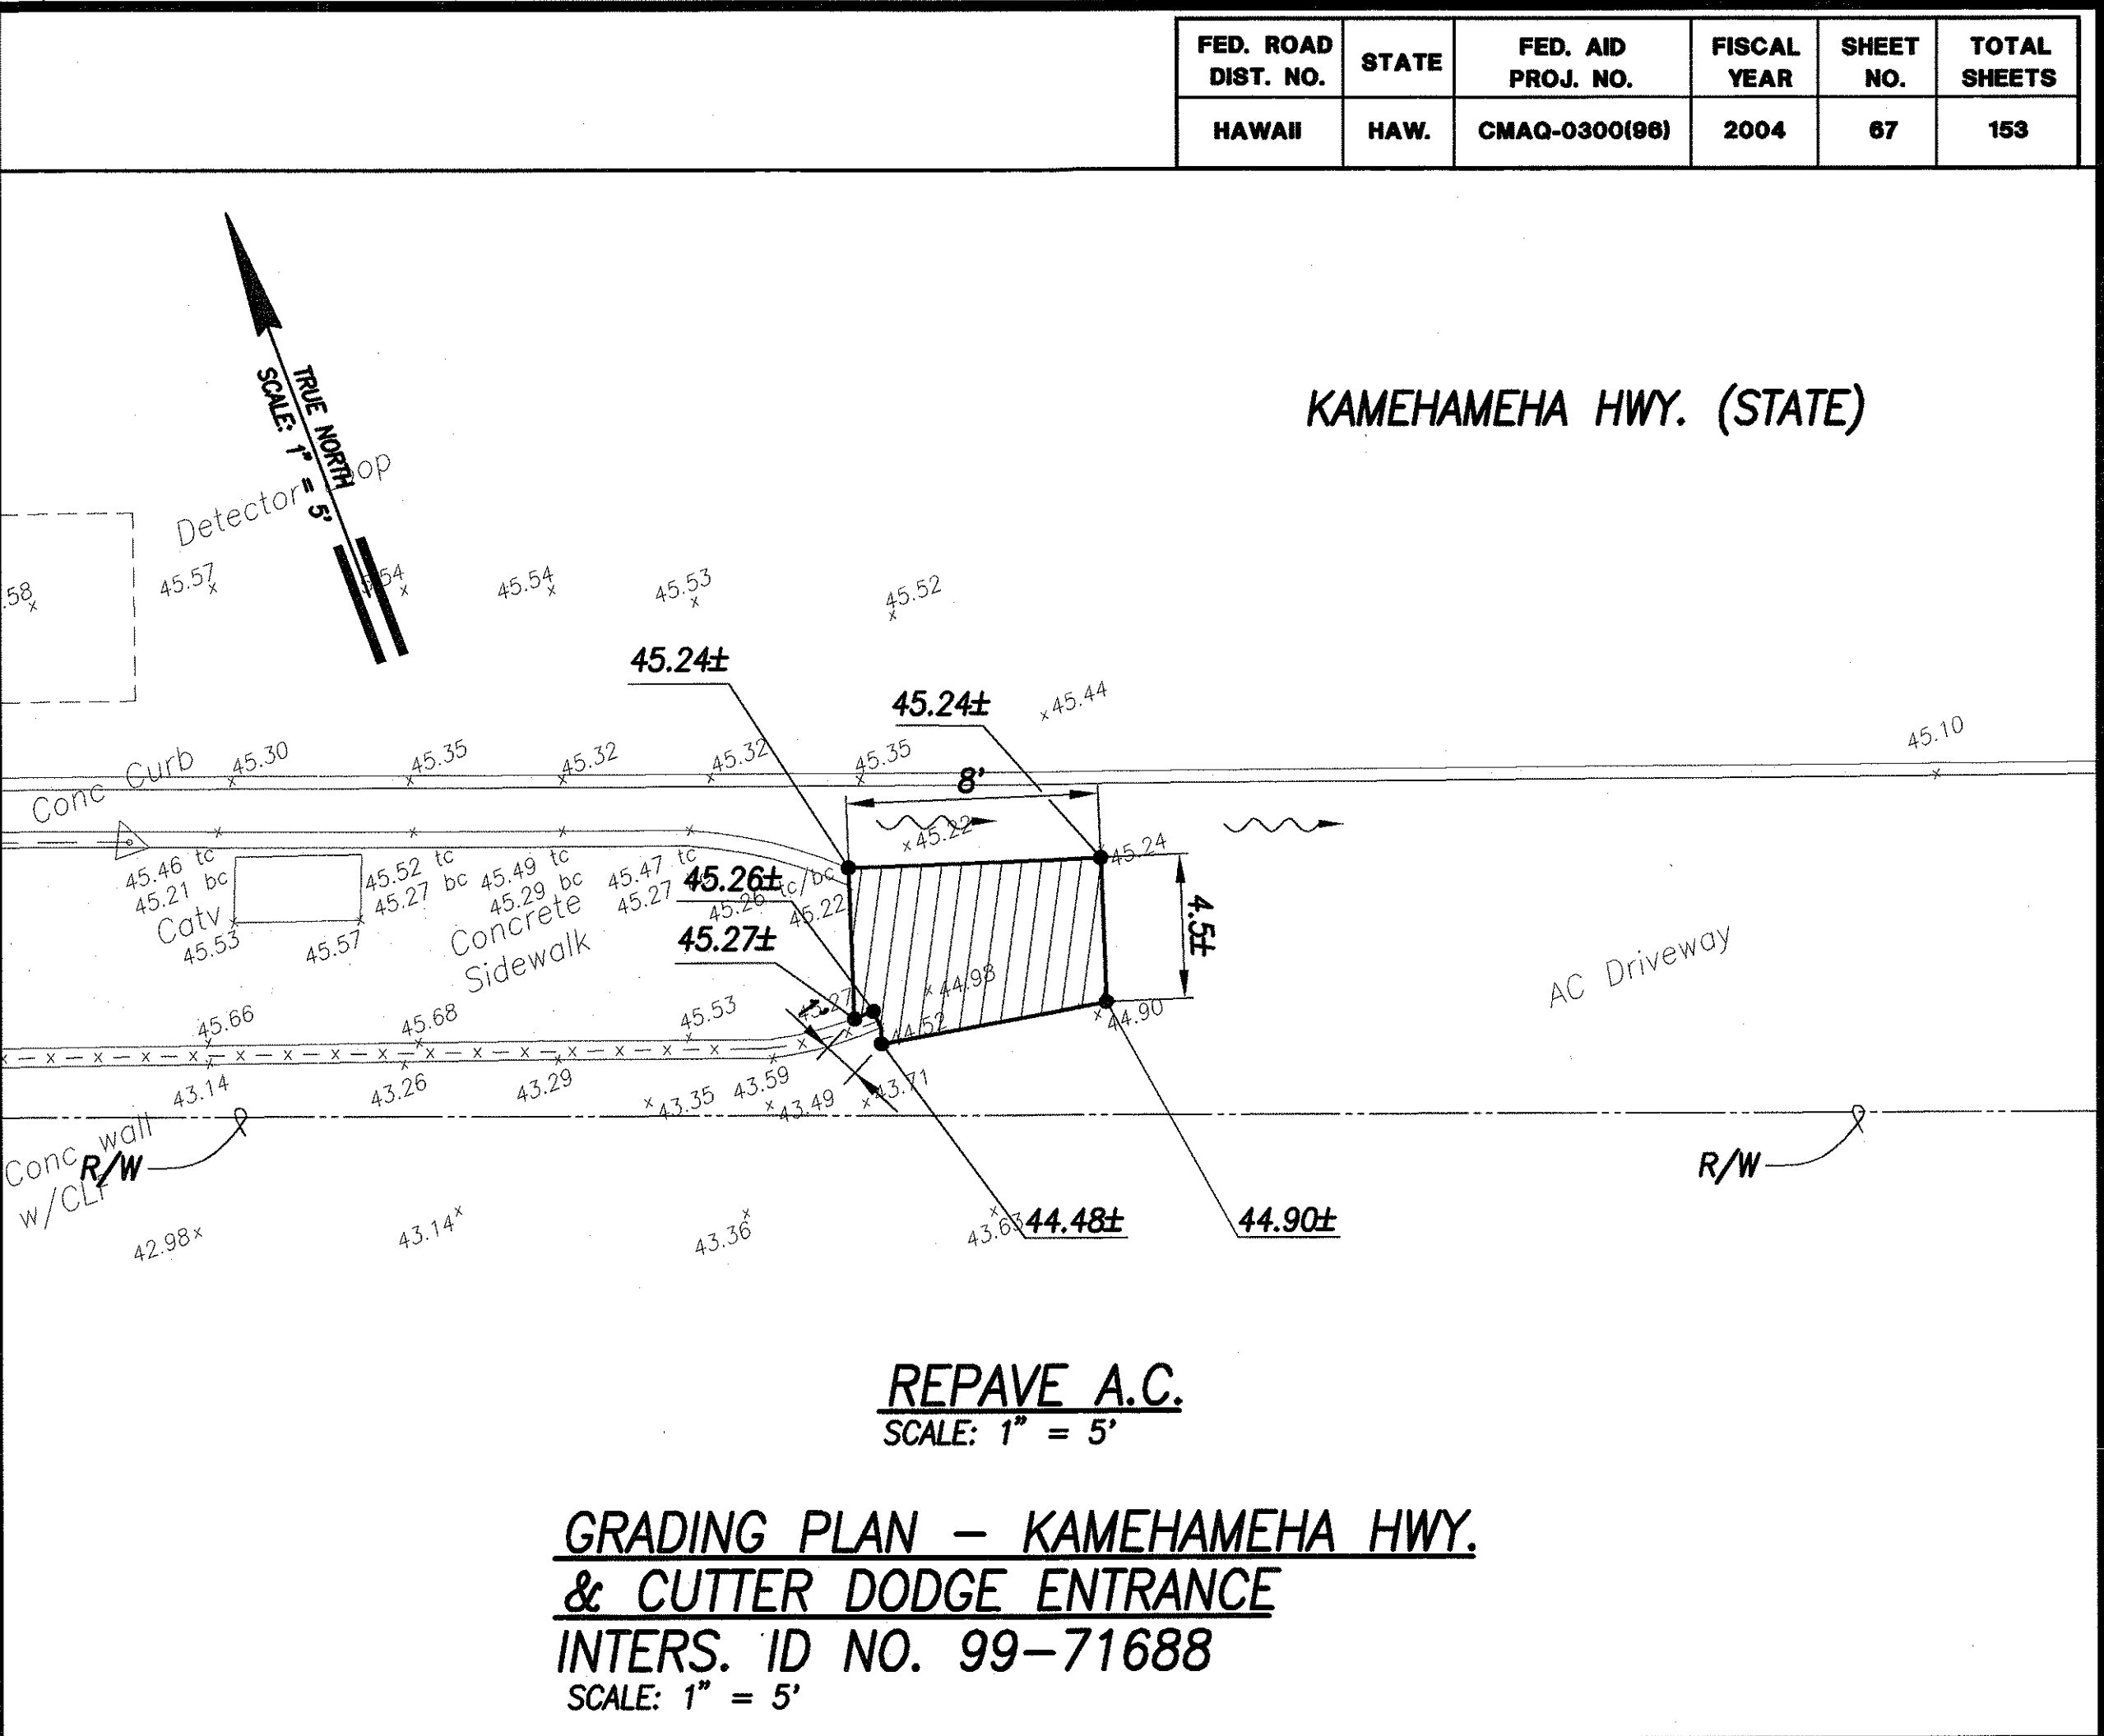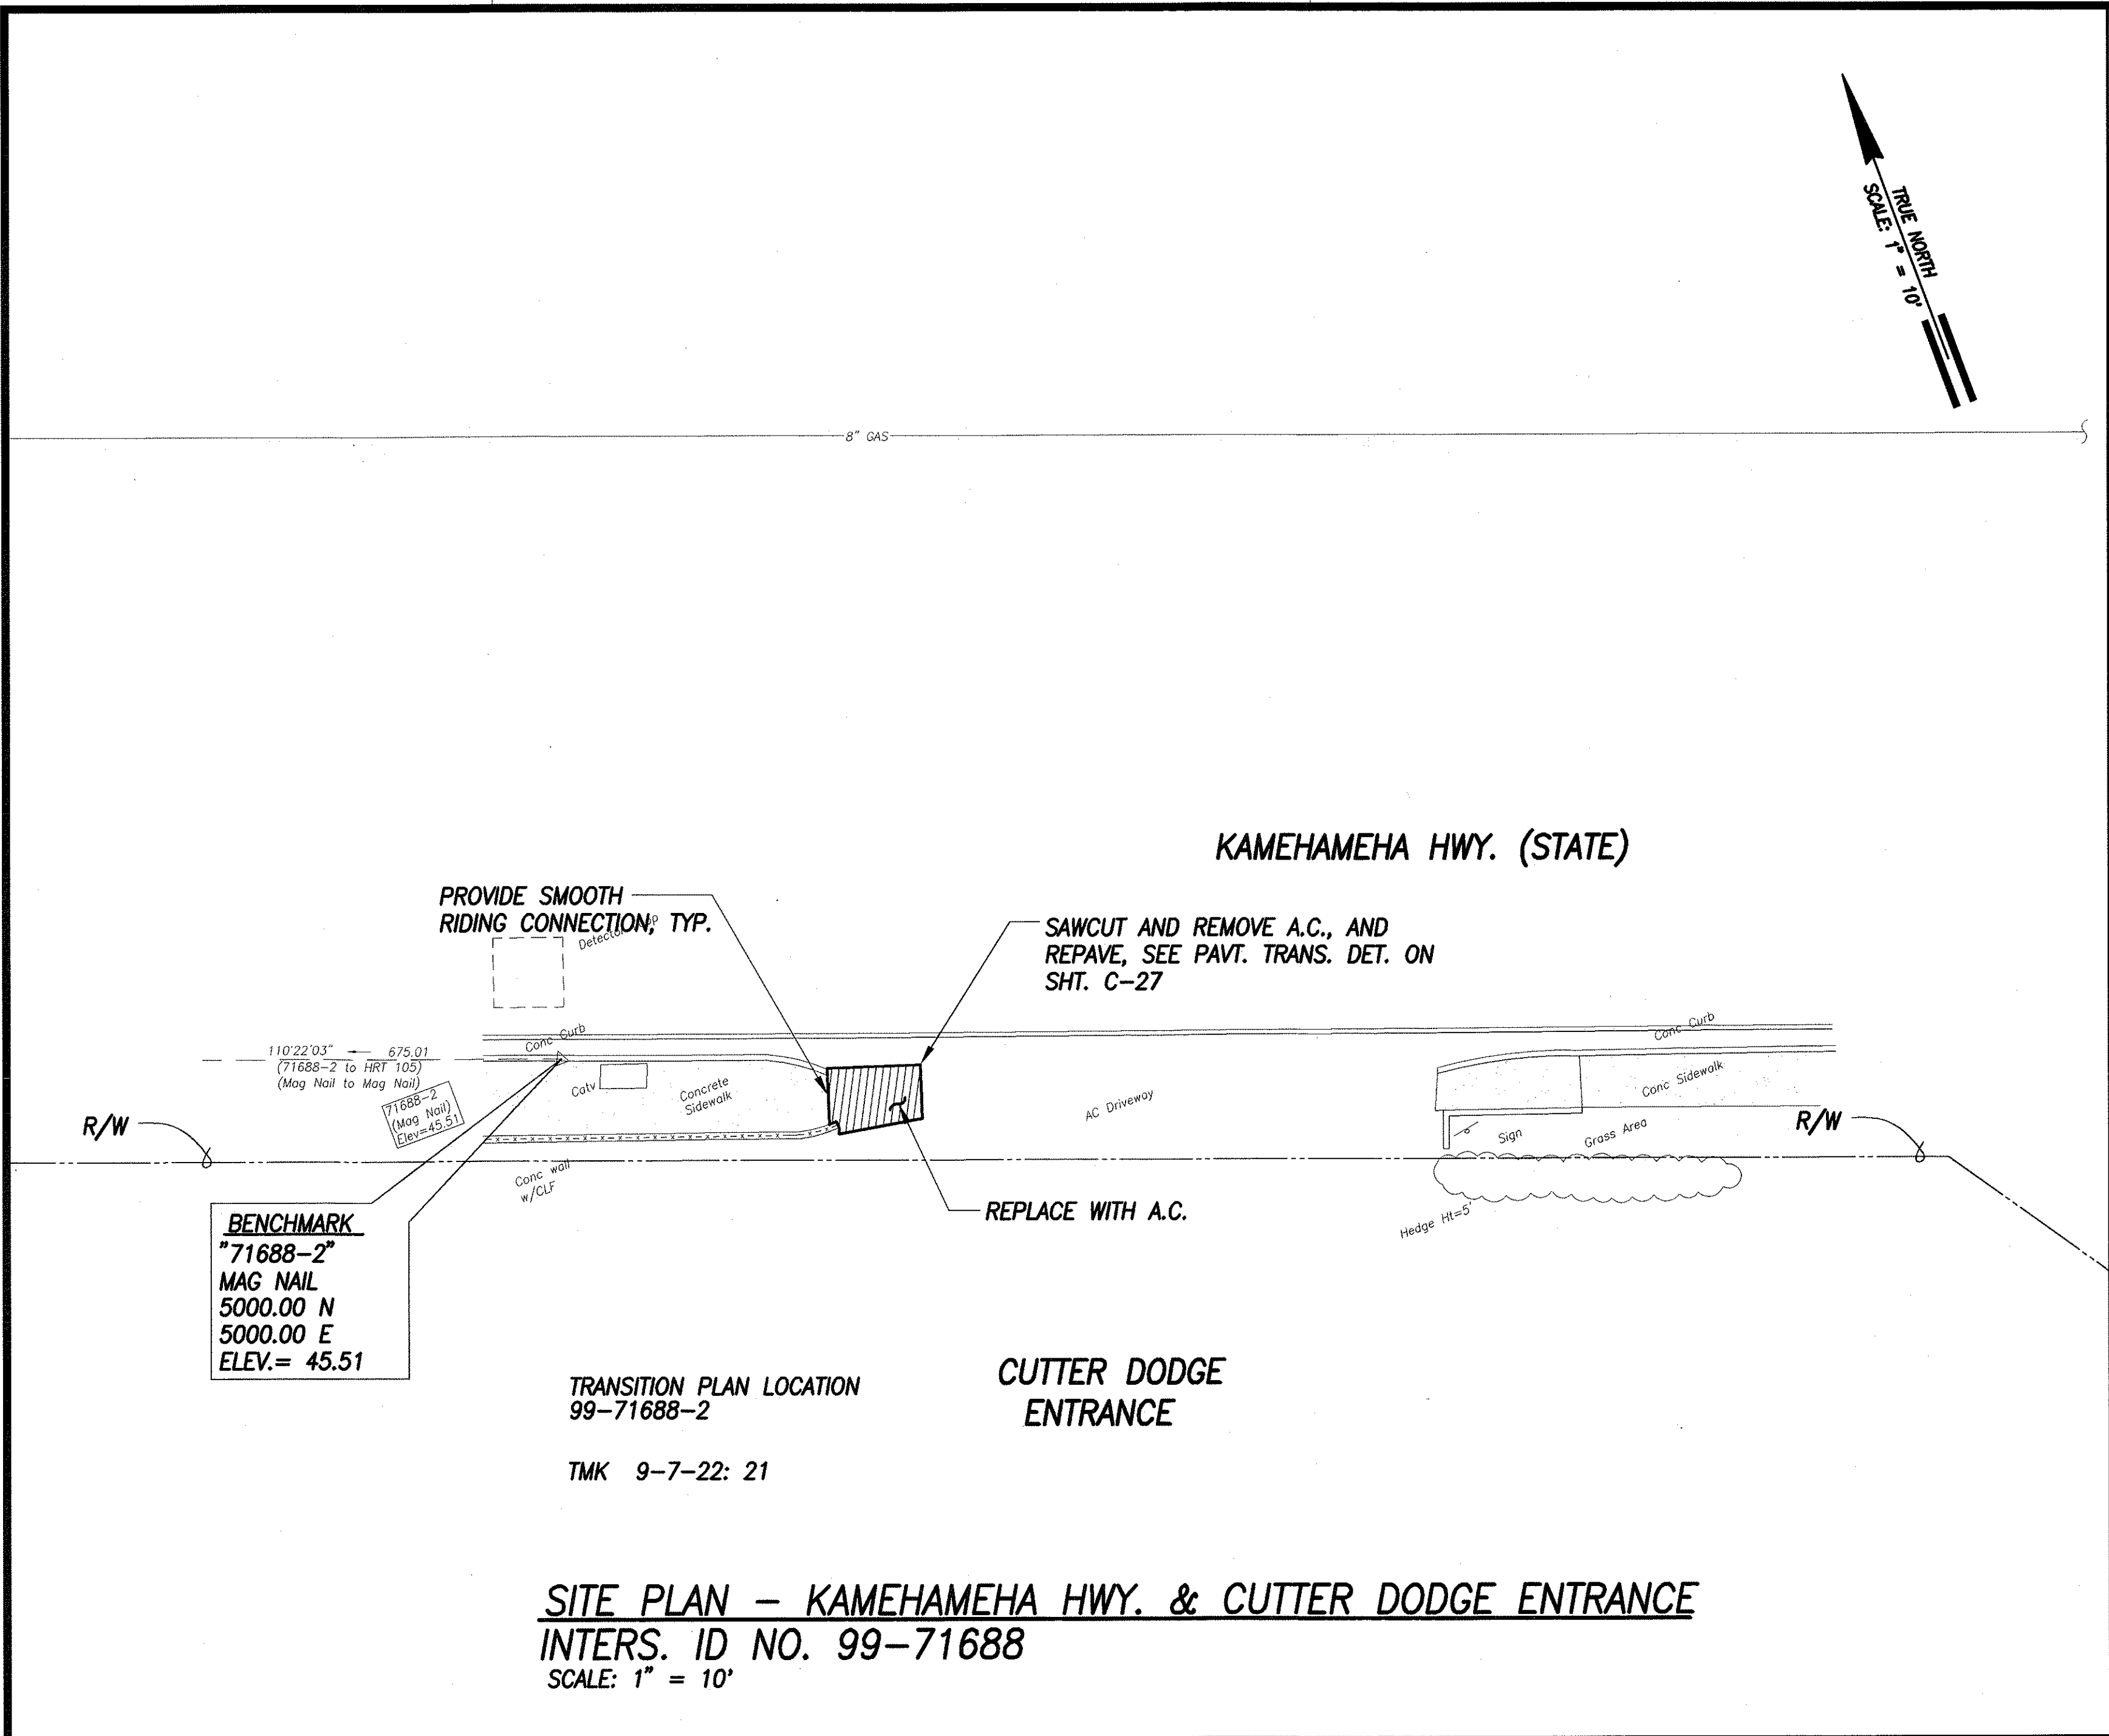



TRANSITION PLAN LOCATION
99-71688-2

TMK 9-7-22: 21

SITE PLAN - KAMEHAMEHA HWY. & CUTTER DODGE ENTRANCE
INTER. ID NO. 99-71688
SCALE: 1" = 10'

LEGEND	
× 49.52	EXIST. SPOT ELEVATION
• 52.58	FINISHED SPOT GRADE
— 51.50 TC	FINISHED TOP OF CURB
— 51.00 BC	FINISHED BOTTOM OF CURB

SURVEY PLANNED BY	DATE
DRAWN BY	
DESIGNED BY	
CHECKED BY	
ORIGINAL PLAN	
NOTE BOOK	
No.	

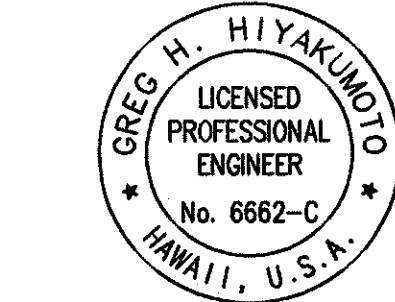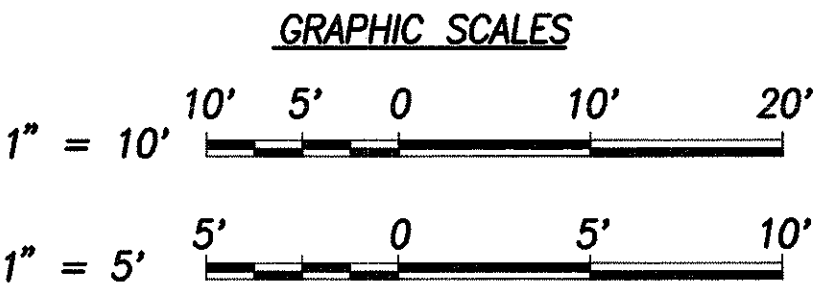

THIS WORK WAS PREPARED BY ME OR UNDER MY SUPERVISION AND CONSTRUCTION OF THIS PROJECT WILL BE UNDER MY OBSERVATION.

SIGNATURE *Greg H. Hiyakumoto* DATE *April 30, 2006*

"OBSERVATION OF CONSTRUCTION" IS DEFINED IN CHAPTER 16-115, HAWAII ADMINISTRATIVE RULES ENTITLED "PROFESSIONAL ENGINEERS, ARCHITECTS, SURVEYORS AND LANDSCAPE ARCHITECTS".



STATE OF HAWAII
DEPARTMENT OF TRANSPORTATION
HIGHWAYS DIVISION

SITE & GRADING PLAN
KAMEHAMEHA HWY. & CUTTER DODGE ENTRANCE
Pedestrian Facilities & ADA Compliance at Various Locations on Oahu, Unit 5
Fed. Aid Proj. No. CMAQ-0300(96)

Scale: AS SHOWN
Date: August 2004



SHEET No. C-66 OF 153 SHEETS

FED. ROAD DIST. NO.	STATE	FED. AID PROJ. NO.	FISCAL YEAR	SHEET NO.	TOTAL SHEETS
HAWAII	HAW.	CMAQ-0300(96)	2004	68	153

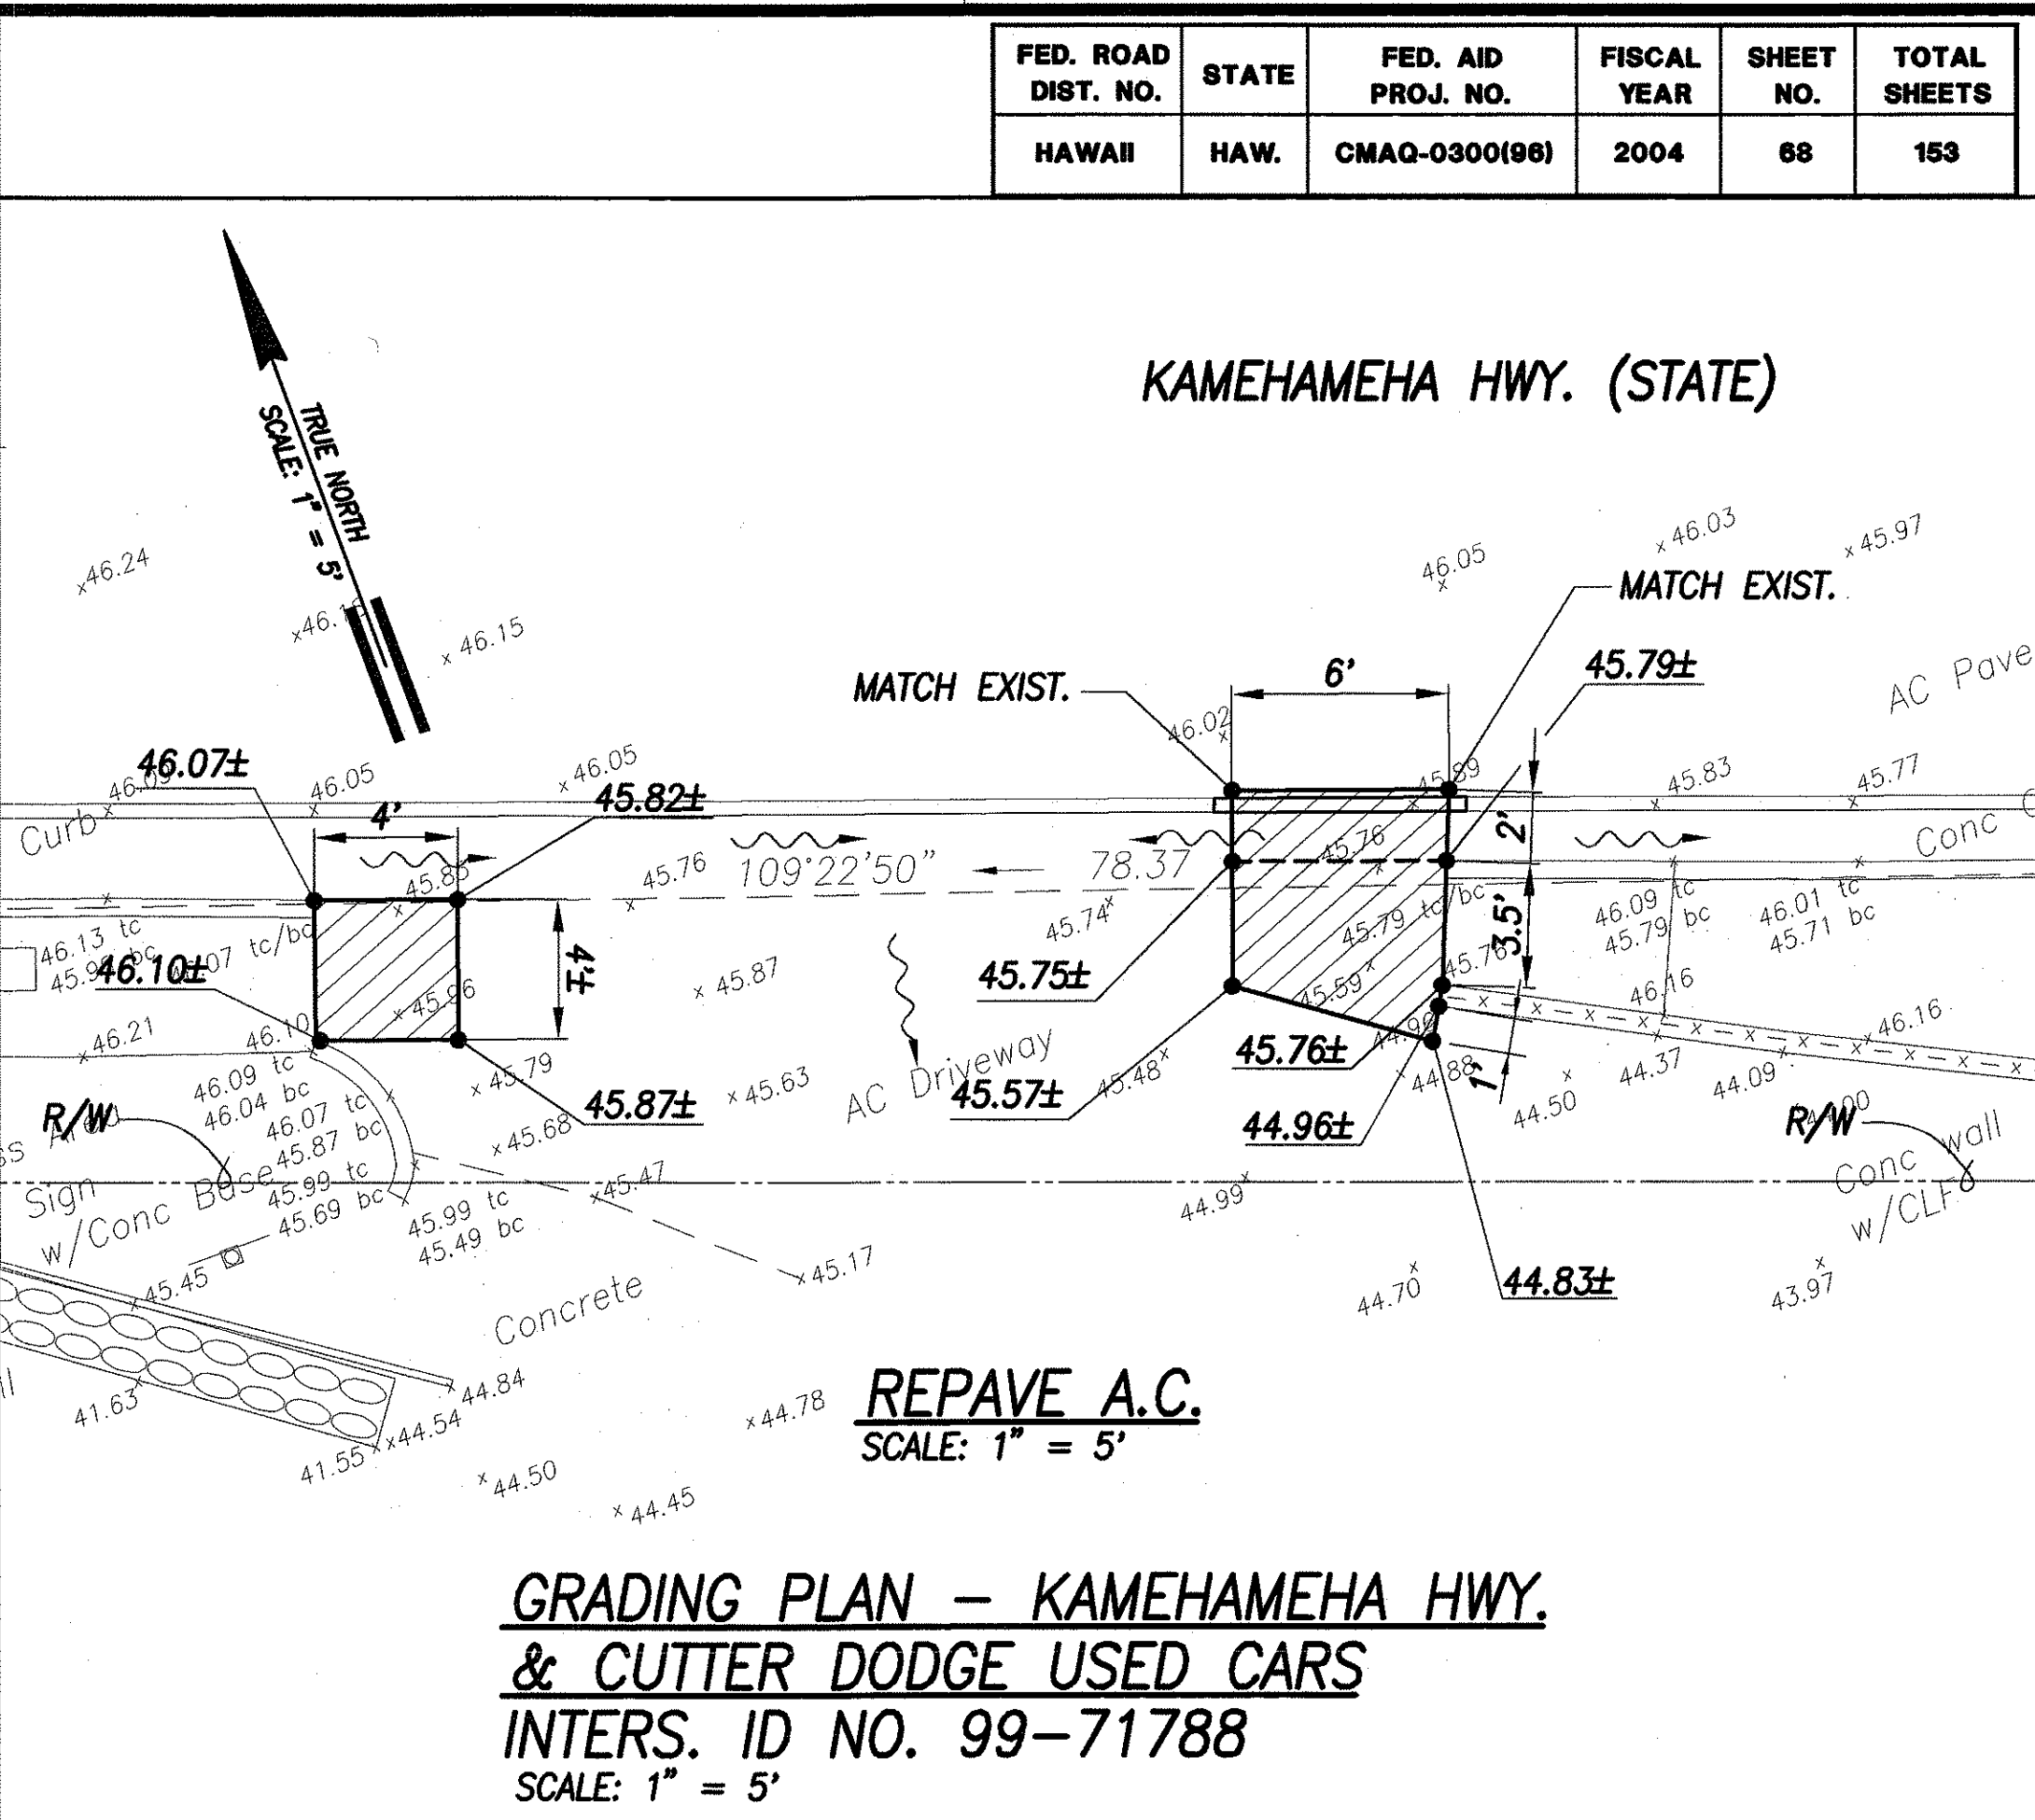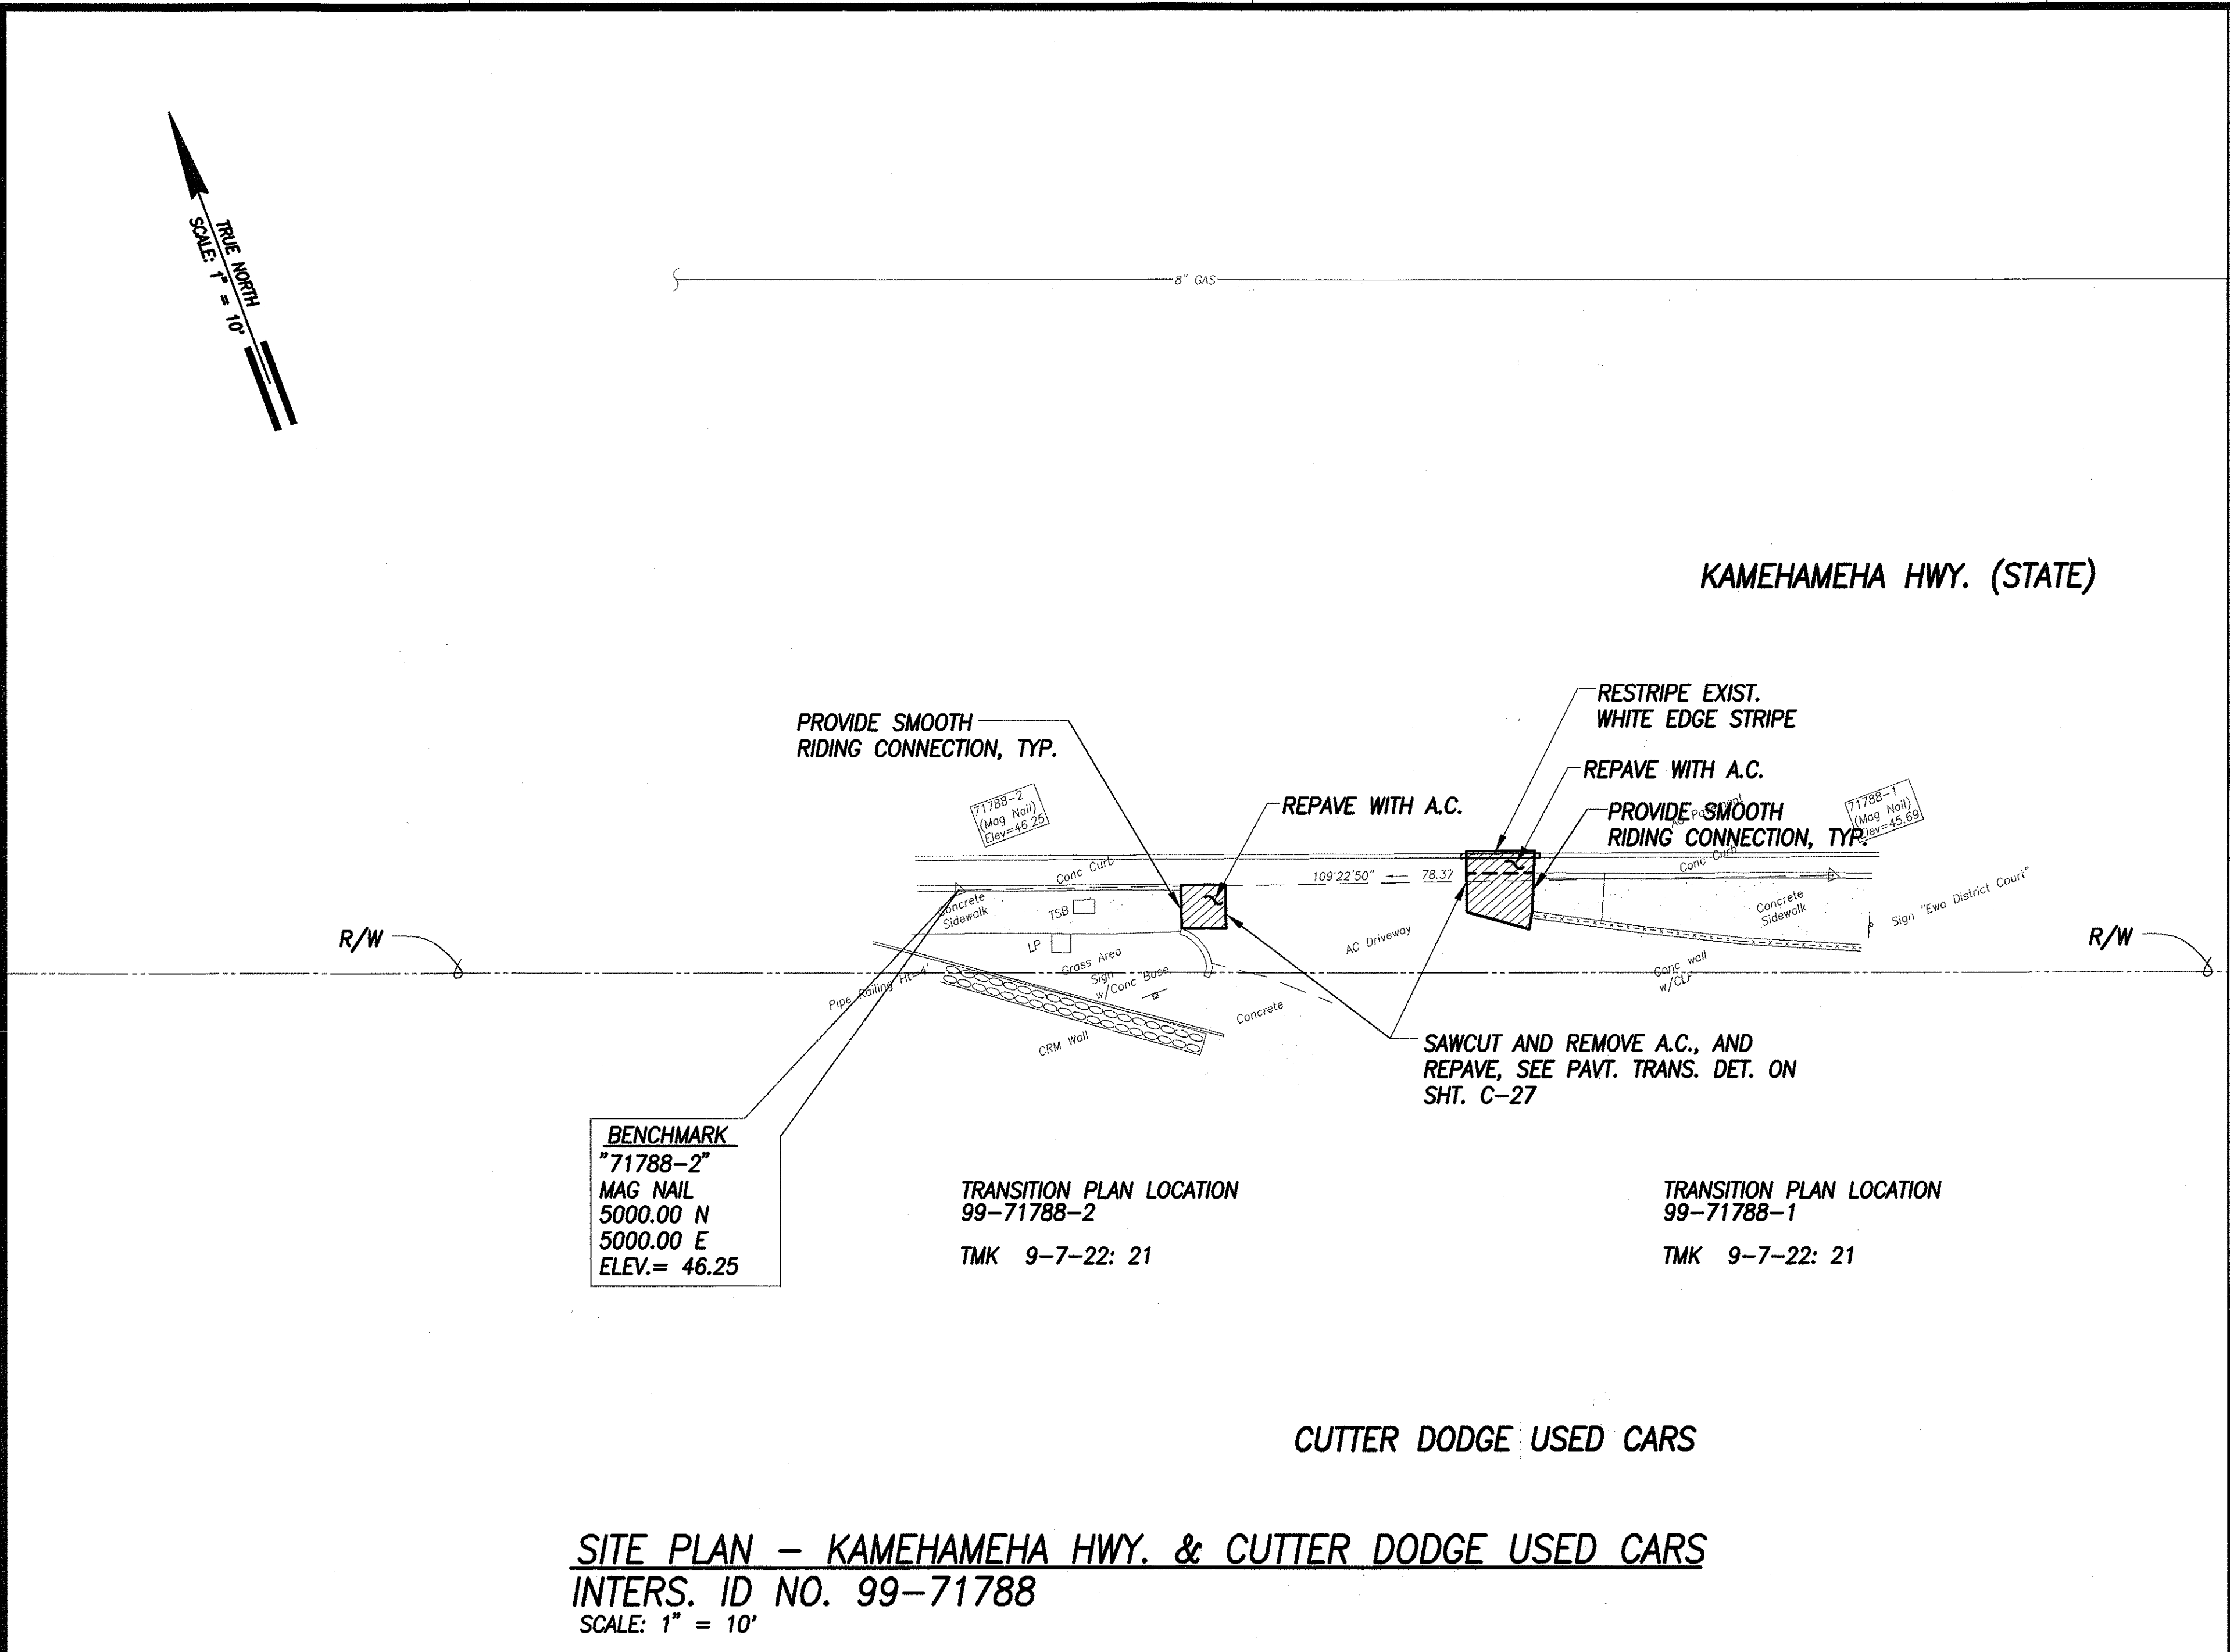

SURVEY PLOTTED BY	DATE
DRAWN BY	
DESIGNED BY	
CHECKED BY	
ORIGINAL PLAN	
NOTE BOOK	
No.	

LEGEND	
× 49.52	EXIST. SPOT ELEVATION
• 52.58	FINISHED SPOT GRADE
• 51.50 TC	FINISHED TOP OF CURB
• 51.00 BC	FINISHED BOTTOM OF CURB

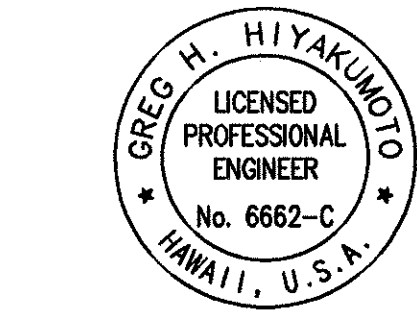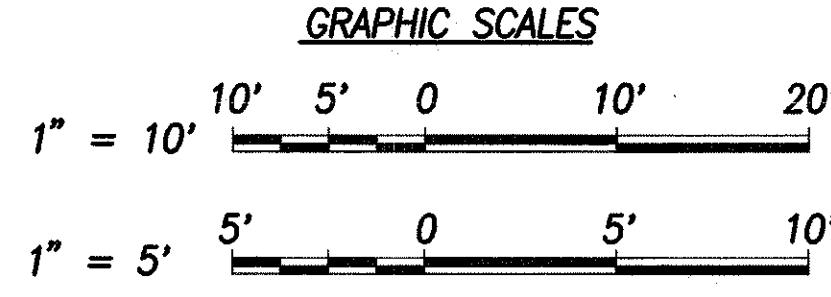

THIS WORK WAS PREPARED BY ME OR UNDER MY SUPERVISION AND CONSTRUCTION OF THIS PROJECT WILL BE UNDER MY OBSERVATION.



SIGNATURE: *Greg H. Hiyakundo* DATE: April 30, 2006

"OBSERVATION OF CONSTRUCTION" IS DEFINED IN CHAPTER 16-115, HAWAII ADMINISTRATIVE RULES ENTITLED "PROFESSIONAL ENGINEERS, ARCHITECTS, SURVEYORS AND LANDSCAPE ARCHITECTS".

STATE OF HAWAII
DEPARTMENT OF TRANSPORTATION
HIGHWAYS DIVISION
SITE & GRADING PLAN
KAMEHAMEHA HWY. & CUTTER DODGE USED CARS
Pedestrian Facilities & ADA Compliance at Various Locations on Oahu, Unit 5
Fed. Aid Proj. No. CMAQ-0300(96)
Scale: AS SHOWN Date: August 2004
SHEET No. C-67 OF 153 SHEETS

68

FED. ROAD DIST. NO.	STATE	FED. AID PROJ. NO.	FISCAL YEAR	SHEET NO.	TOTAL SHEETS
HAWAII	HAW.	CMAQ-0300(96)	2004	69	153

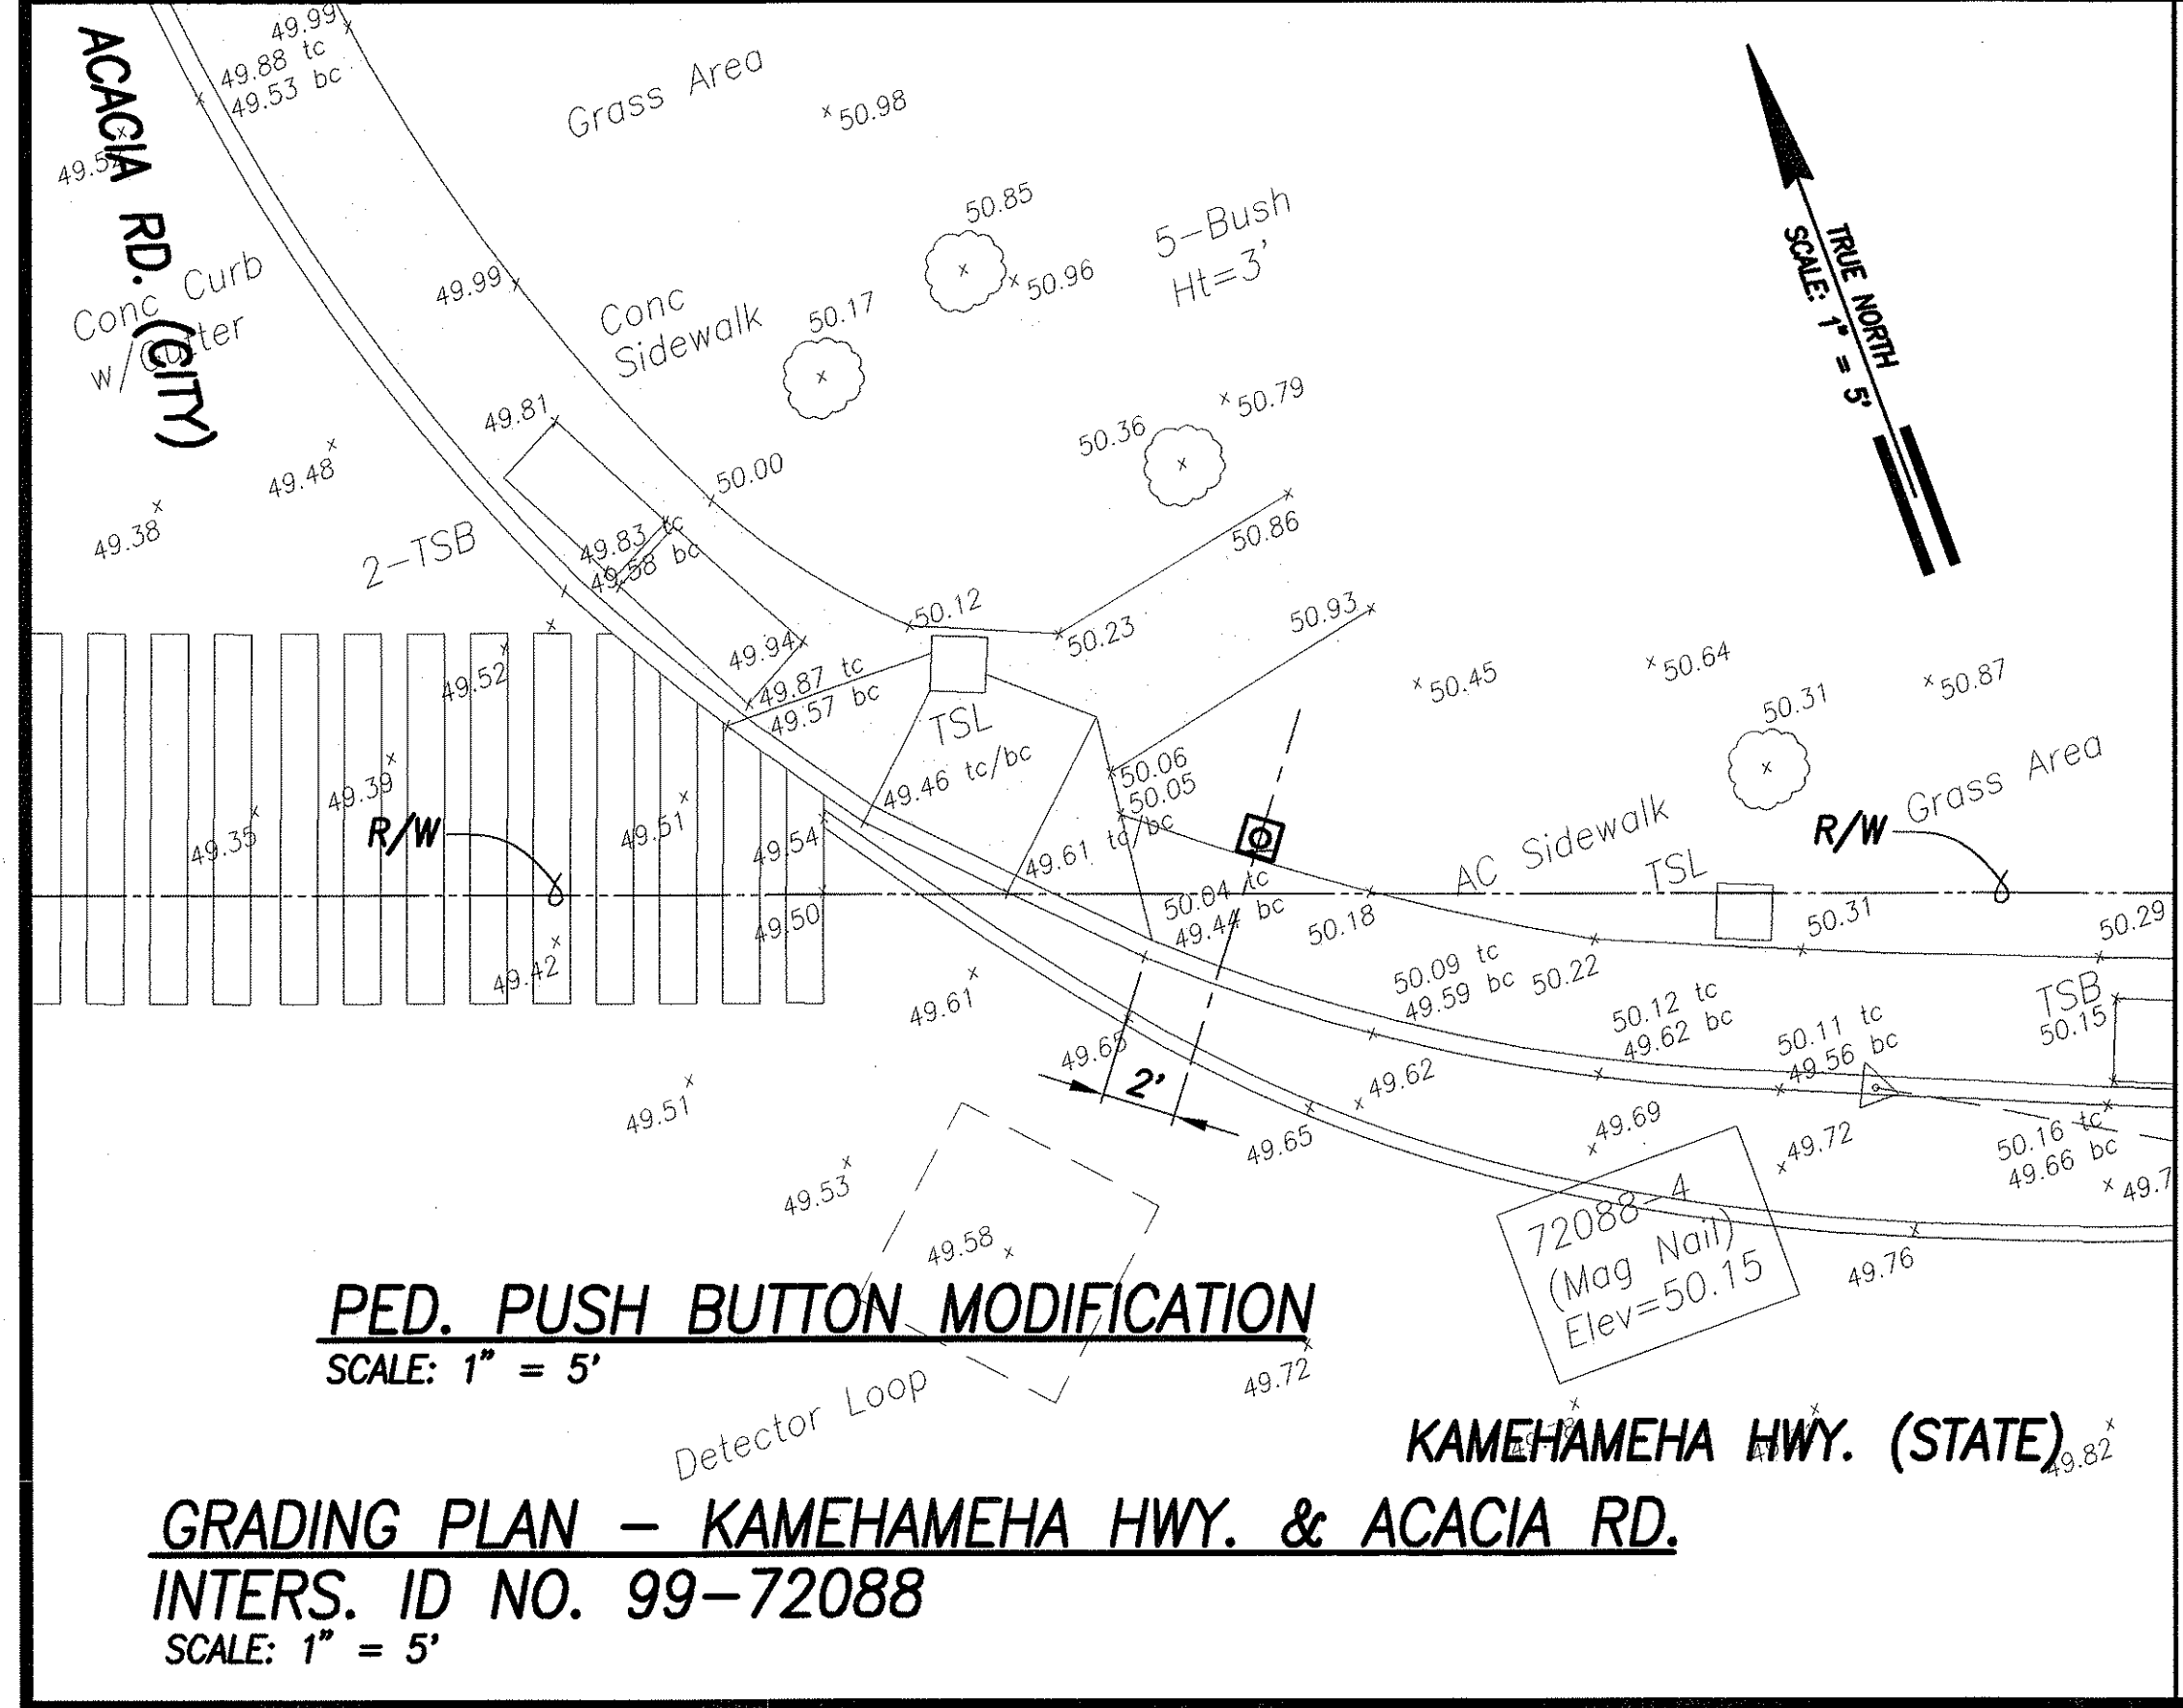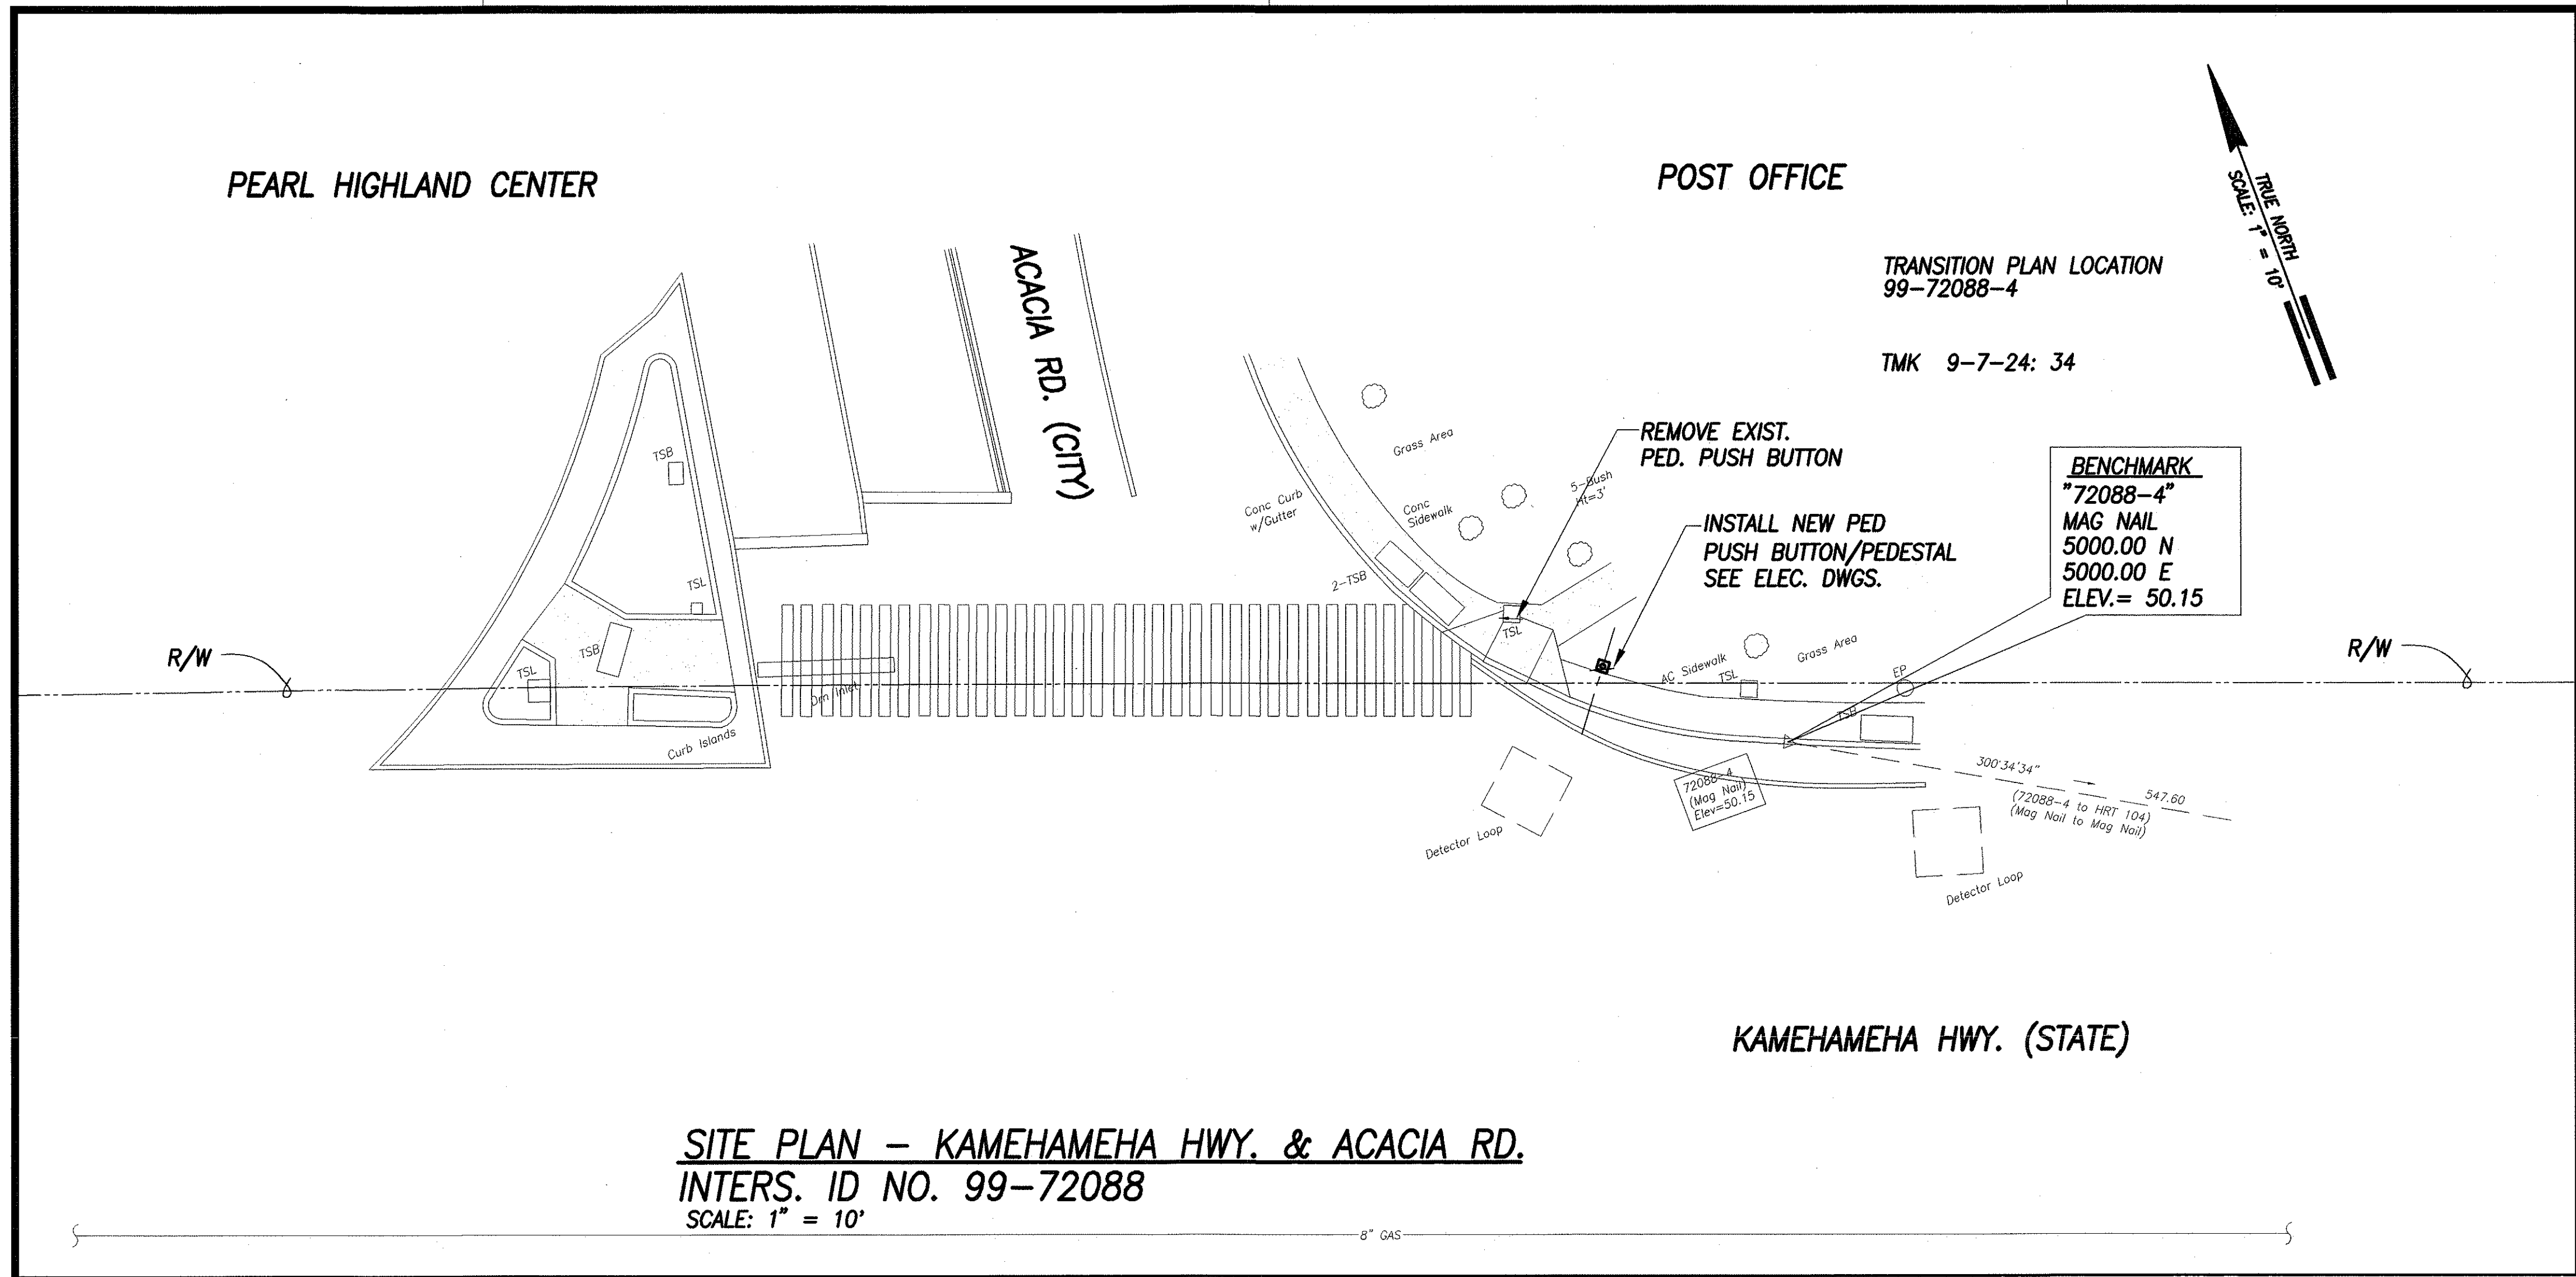

LEGEND	
× 49.52	EXIST. SPOT ELEVATION
52.58	FINISHED SPOT GRADE
51.50 TC	FINISHED TOP OF CURB
51.00 BC	FINISHED BOTTOM OF CURB




THIS WORK WAS PREPARED BY ME OR UNDER MY SUPERVISION AND CONSTRUCTION OF THIS PROJECT WILL BE UNDER MY OBSERVATION.

DATE: April 30, 2006

SIGNATURE: [Signature]

"OBSERVATION OF CONSTRUCTION" IS DEFINED IN CHAPTER 16-115, HAWAII ADMINISTRATIVE RULES ENTITLED "PROFESSIONAL ENGINEERS, ARCHITECTS, SURVEYORS AND LANDSCAPE ARCHITECTS".

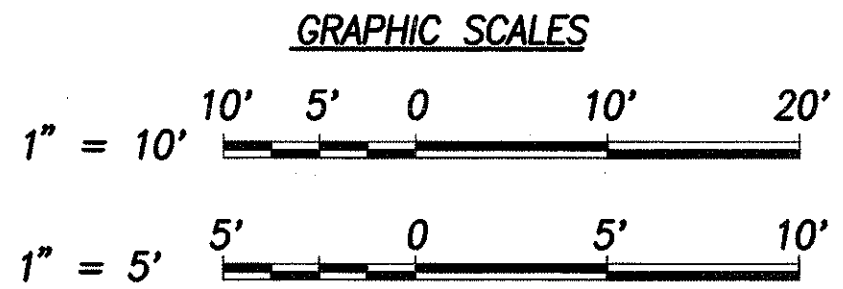

STATE OF HAWAII
DEPARTMENT OF TRANSPORTATION
HIGHWAYS DIVISION

SITE & GRADING PLAN -
KAMEHAMEHA HWY. & ACACIA RD.

Pedestrian Facilities & ADA Compliance
at Various Locations on Oahu, Unit 5
Fed. Aid Proj. No. CMAQ-0300(96)


Scale: AS SHOWN Date: August 2004

SHEET No. C-68 OF 153 SHEETS

DATE	SURVEY PLATTED BY
DATE	DRAWN BY
DATE	DESIGNED BY
DATE	CHECKED BY


ORIGINAL PLAN No. _____

FED. ROAD DIST. NO.	STATE	FED. AID PROJ. NO.	FISCAL YEAR	SHEET NO.	TOTAL SHEETS
HAWAII	HAW.	CMAQ-0300(96)	2004	70	153

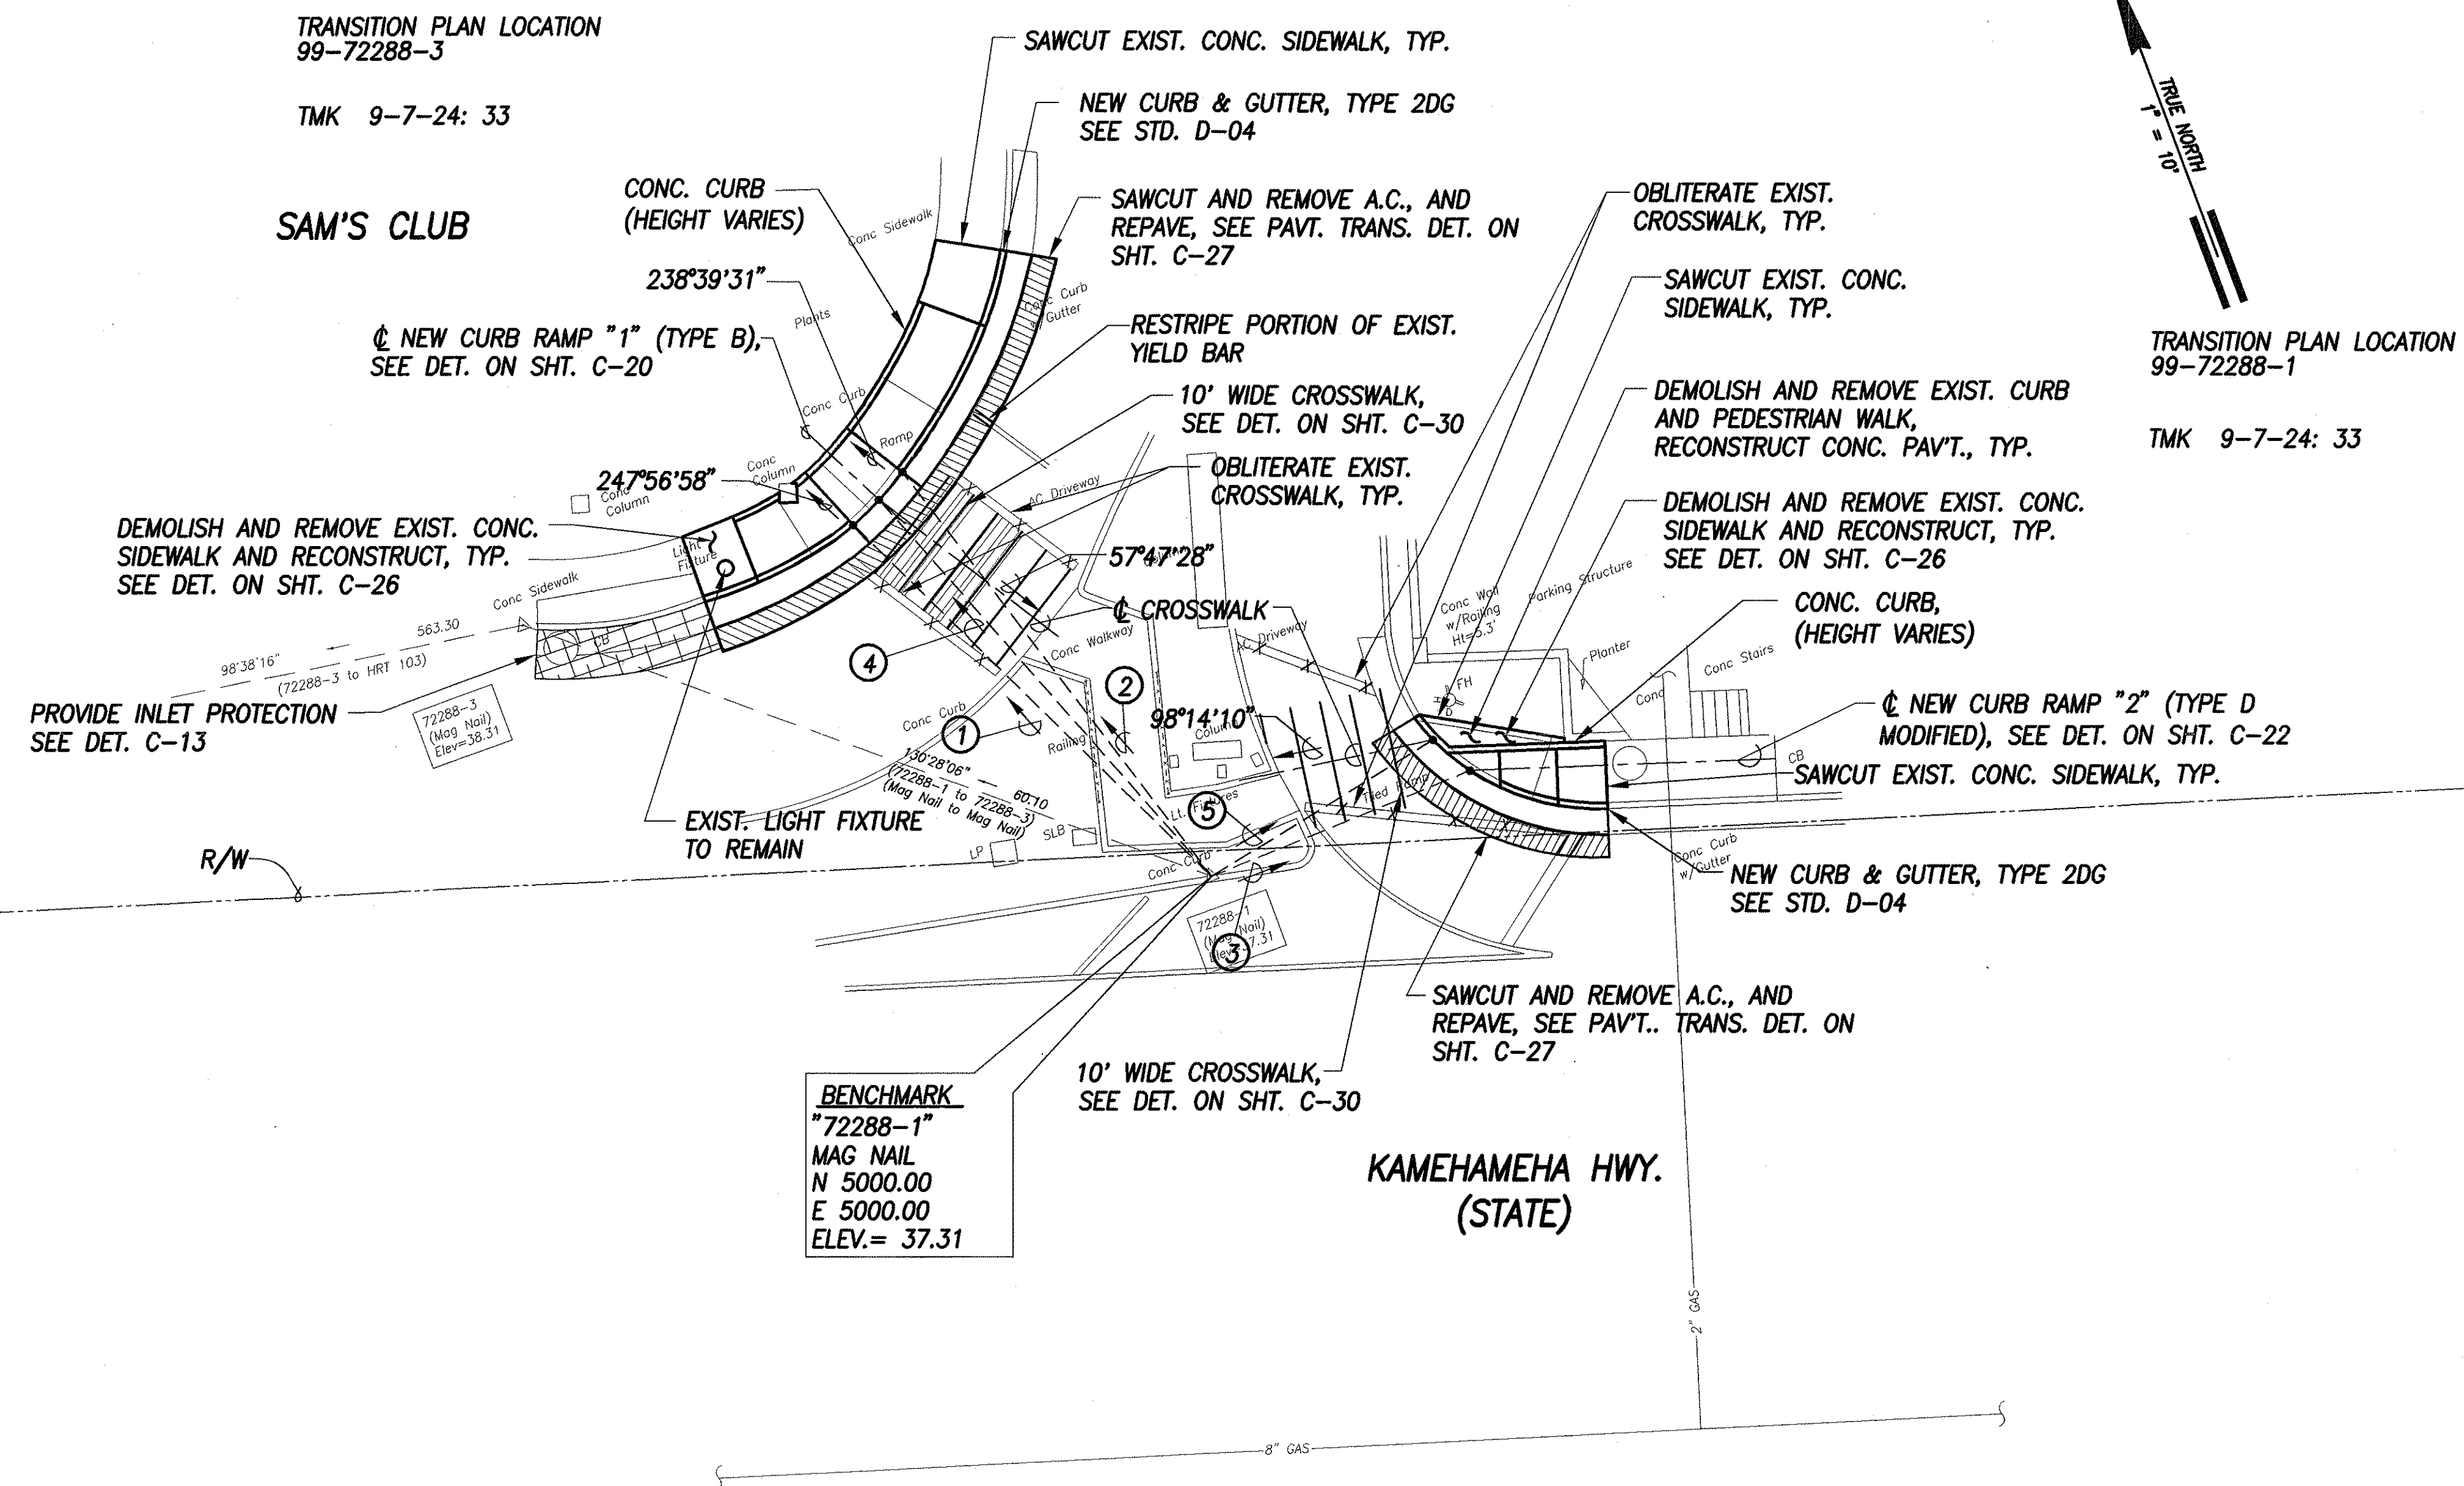

- ① 244°51'53" 41.24'
TIE: BM TO INTERSECTION OF RAMP
EDGE AND CURB FACE
- ② 253°01'33" 41.87'
TIE: BM TO INTERSECTION OF RAMP
EDGE AND CURB FACE
- ③ 357°48'55" 22.91'
TIE: BM TO INTERSECTION OF
RAMP AND CURB FACE
- ④ 248°59'47" 41.37'
TIE: BM TO INTERSECTION OF
CROSSWALK AND CURB FACE
- ⑤ 258°24'25" 21.37'
TIE: BM TO INTERSECTION OF
CROSSWALK AND CURB FACE

SITE PLAN - KAMEHAMEHA HWY. & PEARL HIGHLANDS CTR.
INTERS. ID NO. 99-72288
 SCALE: 1" = 10'

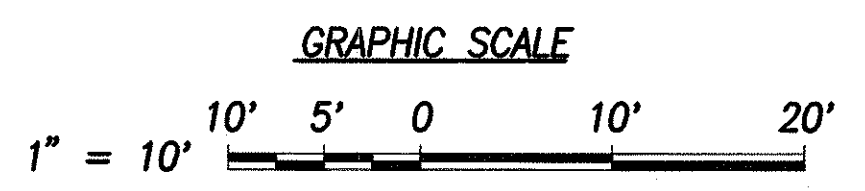

THIS WORK WAS PREPARED BY ME OR UNDER MY SUPERVISION AND CONSTRUCTION OF THIS PROJECT WILL BE UNDER MY OBSERVATION.

SIGNATURE: *Greg H. Hiyaunio* DATE: April 30, 2006

"OBSERVATION OF CONSTRUCTION" IS DEFINED IN CHAPTER 16-115, HAWAII ADMINISTRATIVE RULES ENTITLED "PROFESSIONAL ENGINEERS, ARCHITECTS, SURVEYORS AND LANDSCAPE ARCHITECTS".

STATE OF HAWAII
 DEPARTMENT OF TRANSPORTATION
 HIGHWAYS DIVISION

SITE PLAN - KAMEHAMEHA HWY. & PEARL HIGHLANDS CTR.

Pedestrian Facilities & ADA Compliance at Various Locations on Oahu, Unit 5


Fed. Aid Proj. No. CMAQ-0300(96)

Scale: 1" = 10'-0" Date: August 2004

SHEET No. C-69 OF 153 SHEETS

ORIGINAL PLAN	SURVEY PLOTTED BY	DATE
NOTE BOOK	DRAWN BY	
NO.	DESIGNED BY	
	QUANTITIES BY	
	CHECKED BY	

FED. ROAD DIST. NO.	STATE	FED. AID PROJ. NO.	FISCAL YEAR	SHEET NO.	TOTAL SHEETS
HAWAII	HAW.	CMAQ-0300(96)	2004	71	153

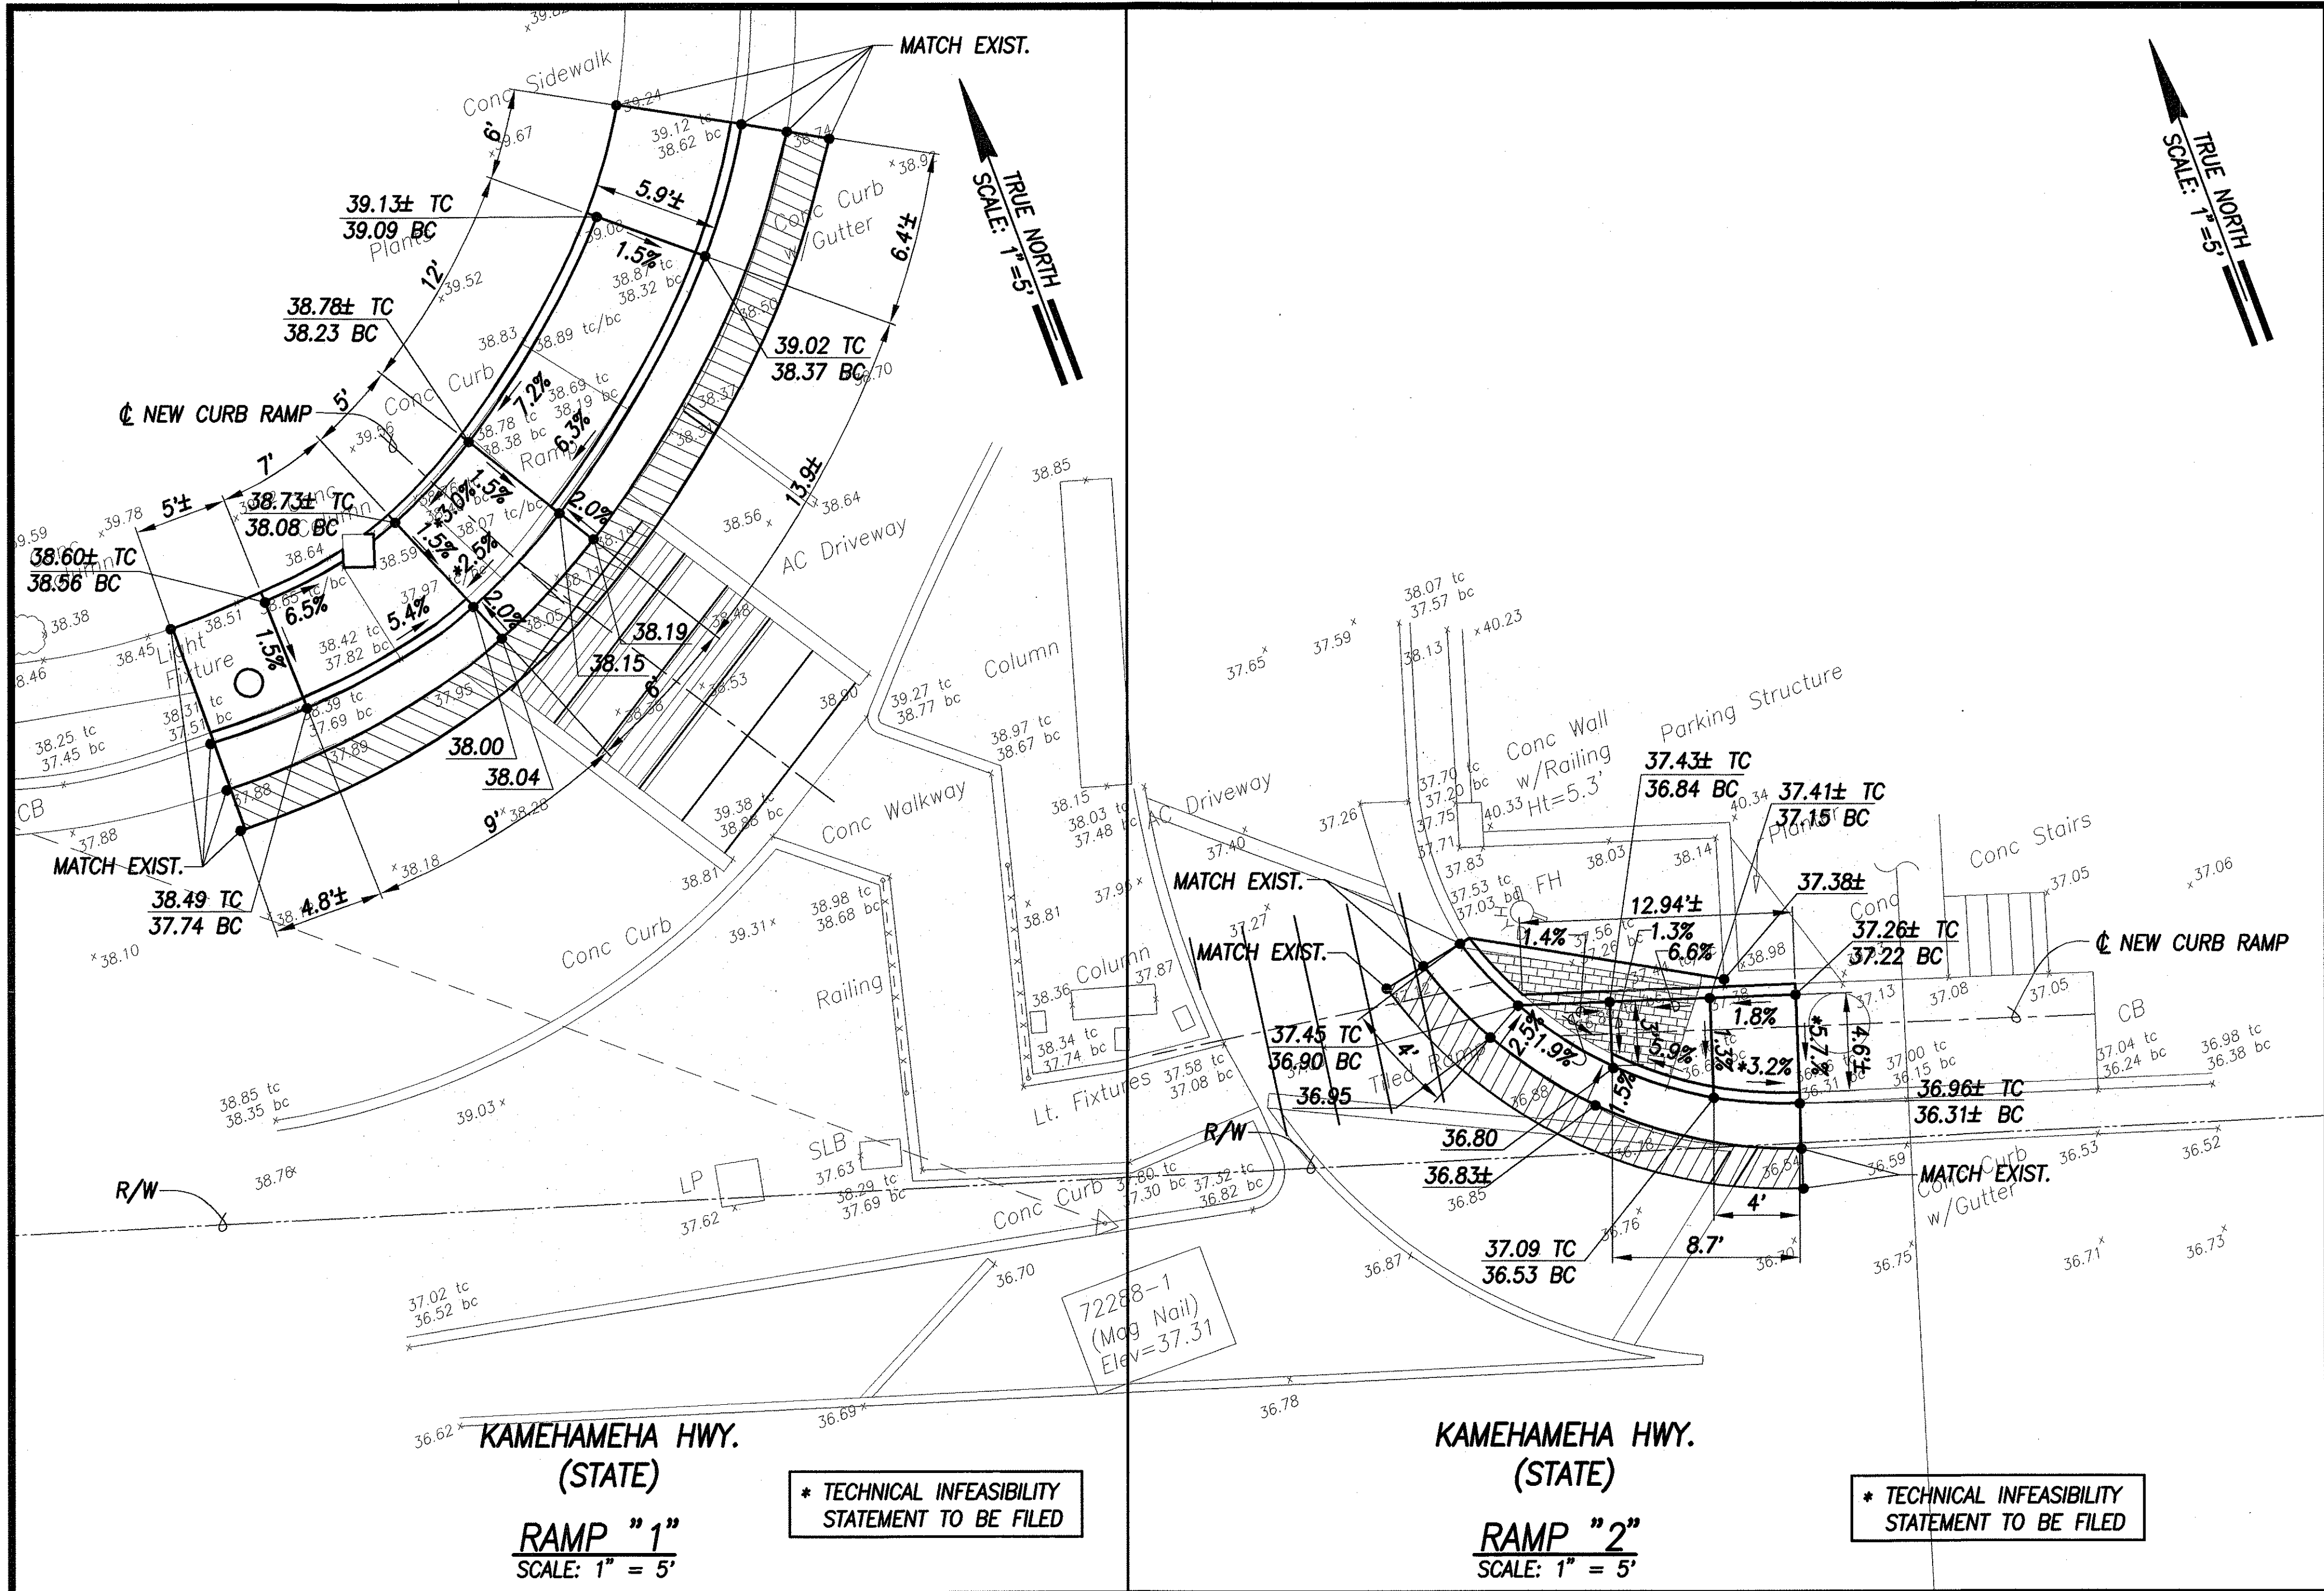

GRADING PLAN - KAMEHAMEHA HWY.
& PEARL HIGHLANDS CTR.
INTERS. ID NO. 99-72288
SCALE: 1" = 5'

SURVEY PLATTED BY	DATE
DRAWN BY	
DESIGNED BY	
CHECKED BY	
ORIGINAL PLAN	
NOTE BOOK	
No.	



THIS WORK WAS PREPARED BY ME OR UNDER MY SUPERVISION AND CONSTRUCTION OF THIS PROJECT WILL BE UNDER MY OBSERVATION.

SIGNATURE *Greg H. Hiyaikundo* DATE *April 30, 2006*

"OBSERVATION OF CONSTRUCTION" IS DEFINED IN CHAPTER 16-115, HAWAII ADMINISTRATIVE RULES ENTITLED "PROFESSIONAL ENGINEERS, ARCHITECTS, SURVEYORS AND LANDSCAPE ARCHITECTS."



STATE OF HAWAII
DEPARTMENT OF TRANSPORTATION
HIGHWAYS DIVISION


GRADING PLAN - KAMEHAMEHA HWY. & PEARL HIGHLANDS CTR.

Pedestrian Facilities & ADA Compliance at Various Locations on Oahu, Unit 5
Fed. Aid Proj. No. CMAQ-0300(96)

Scale: 1" = 5'-0" Date: August 2004

SHEET No. C-70 OF 153 SHEETS

FED. ROAD DIST. NO.	STATE	FED. AID PROJ. NO.	FISCAL YEAR	SHEET NO.	TOTAL SHEETS
HAWAII	HAW.	CMAQ-0300(96)	2004	72	153

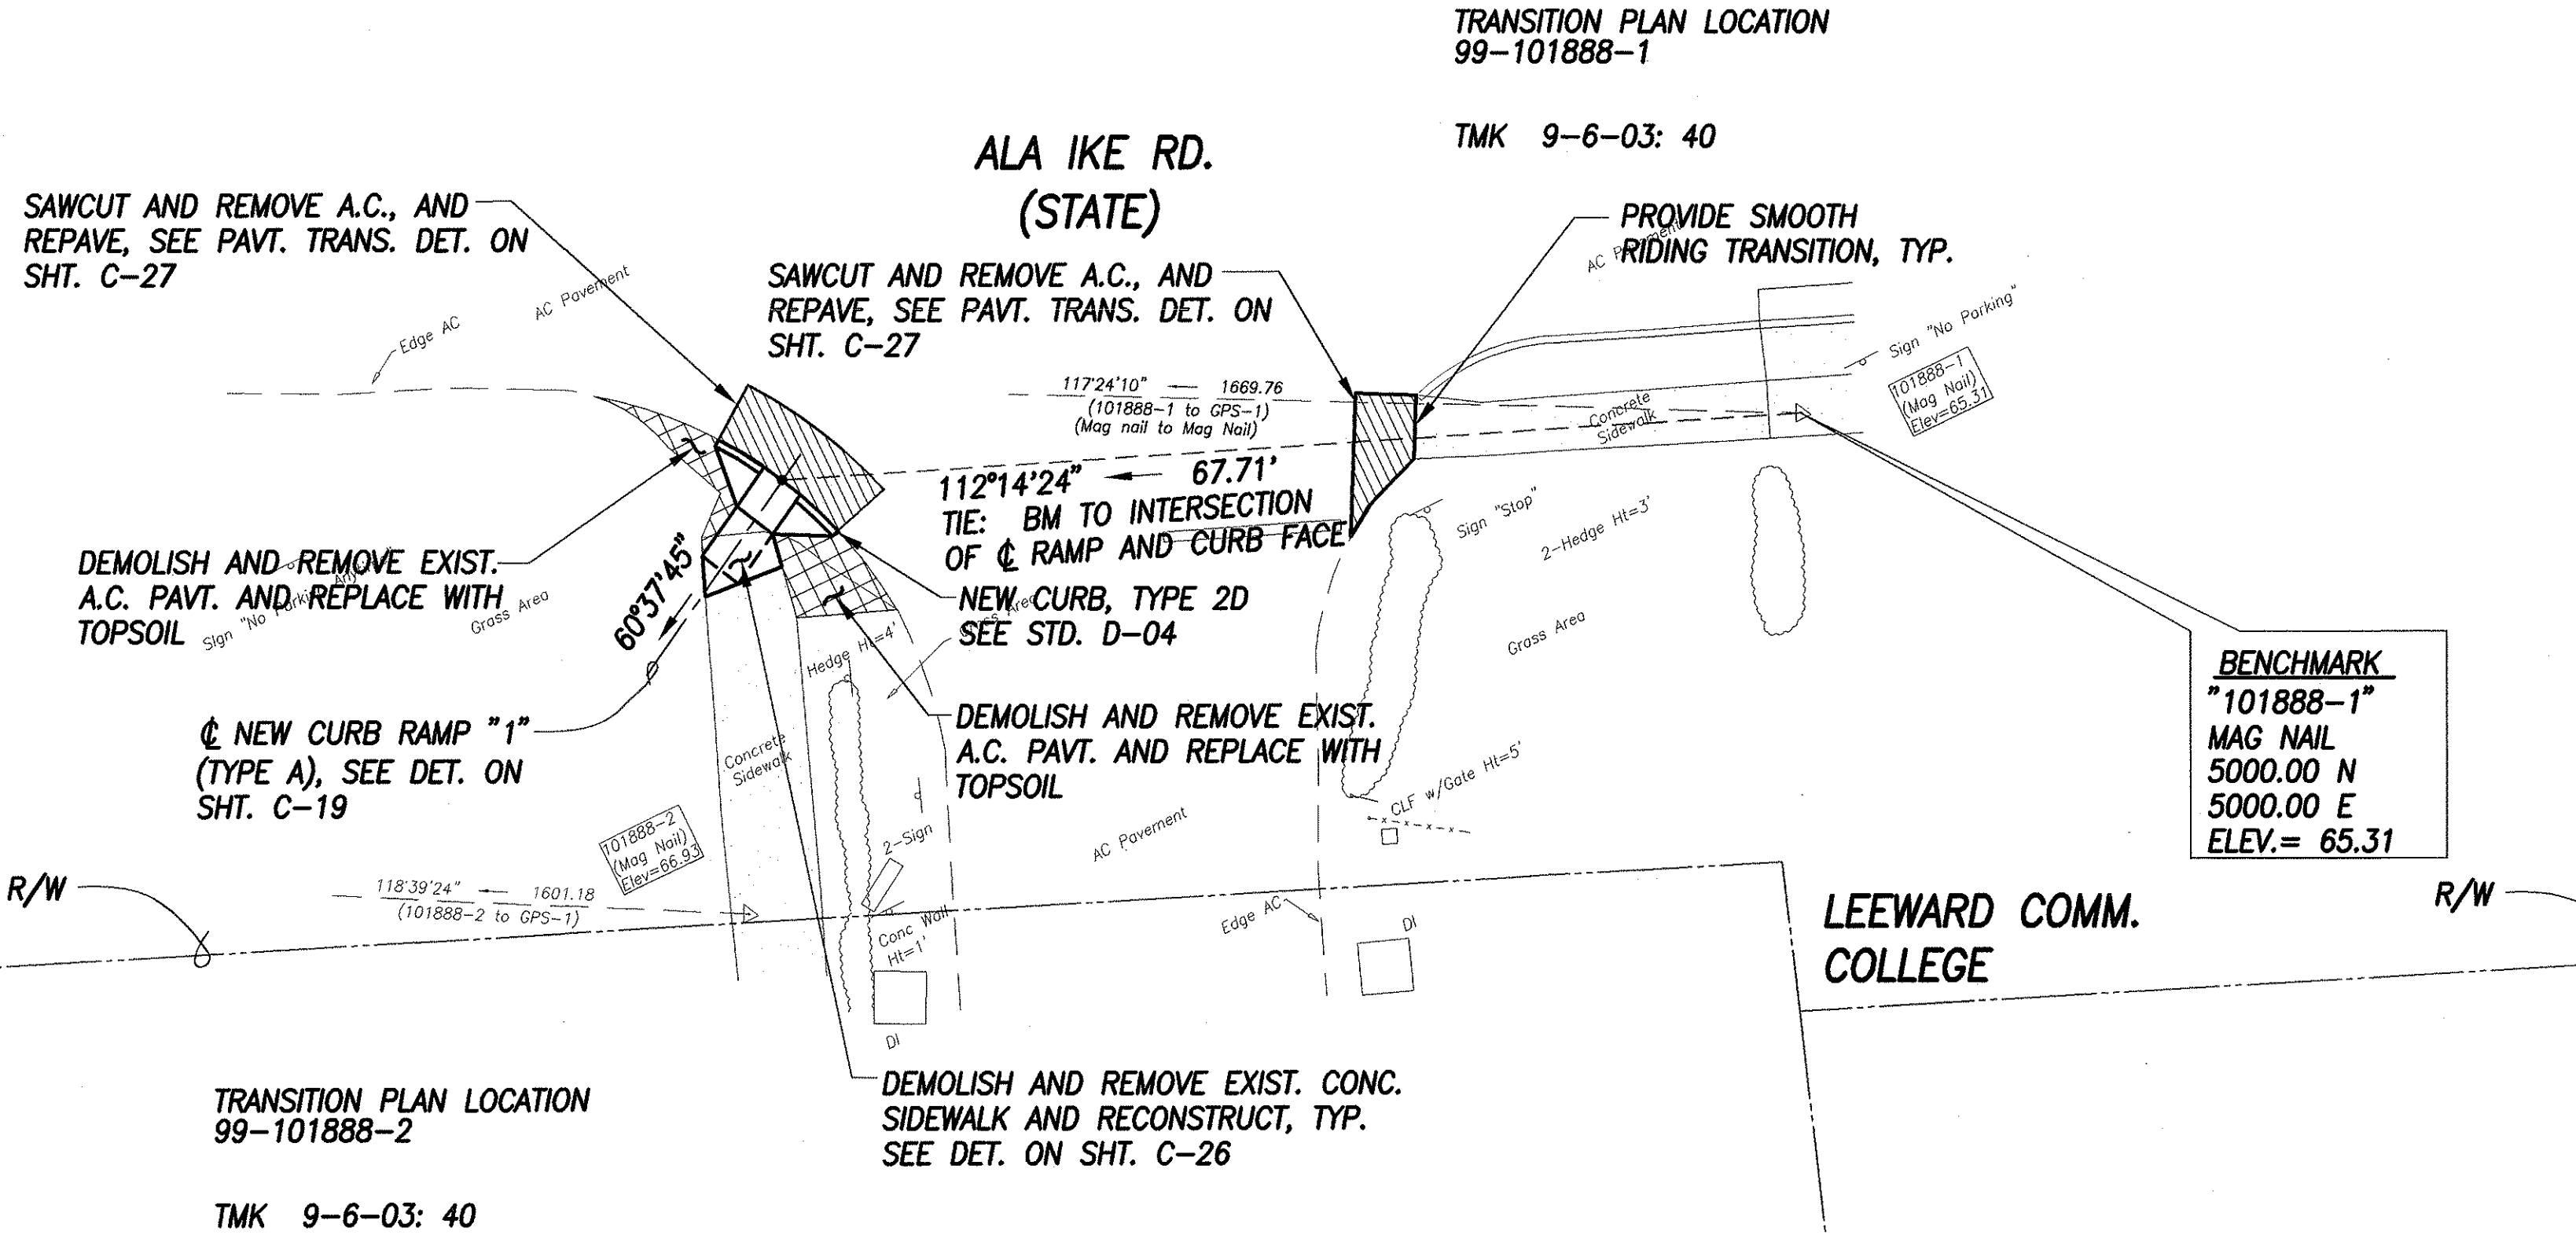


SITE PLAN - ALA IKE RD. & LEEWARD COMMUNITY COLLEGE
INTERS. ID NO. 99-101888
 SCALE: 1" = 10'


DATE	_____
SURVEY PLOTTED BY	_____
DRAWN BY	_____
DESIGNED BY	_____
QUANTITIES BY	_____
CHECKED BY	_____
ORIGINAL PLAN	_____
NOTE BOOK	_____
No.	_____

LEGEND


× 49.52	EXIST. SPOT ELEVATION
● 52.58	FINISHED SPOT GRADE
● 51.50 TC	FINISHED TOP OF CURB
● 51.00 BC	FINISHED BOTTOM OF CURB

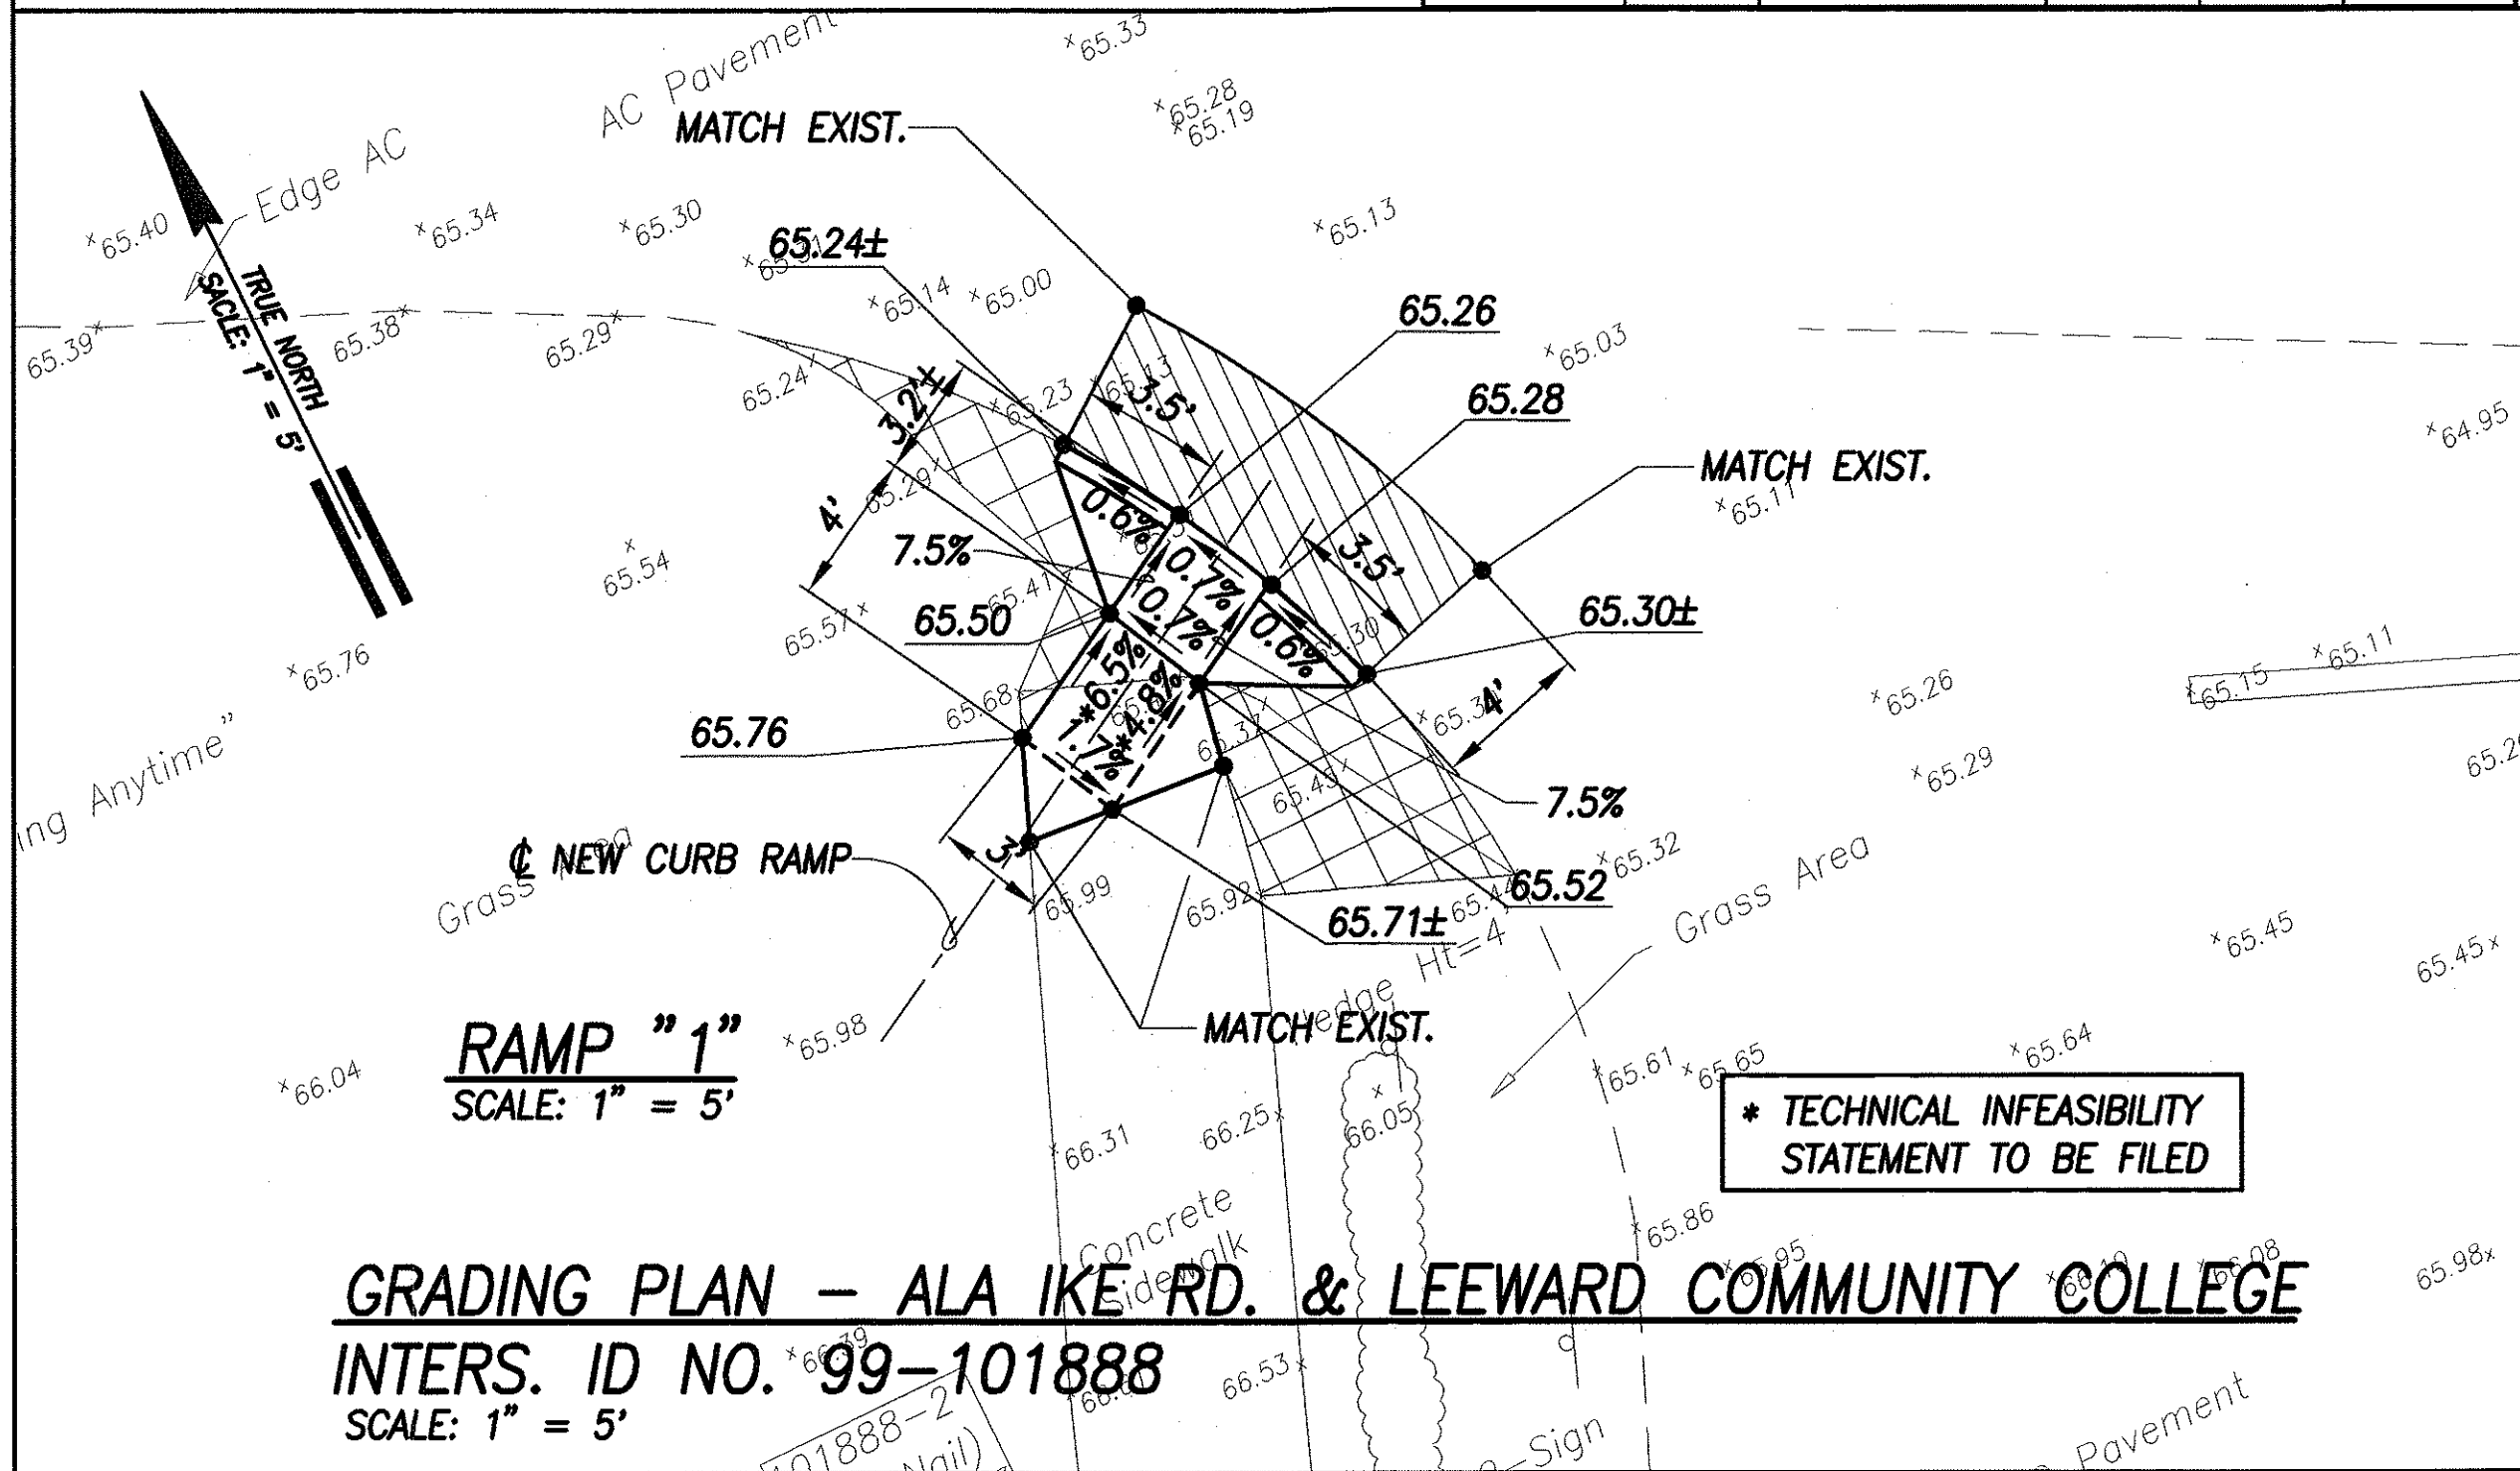

GRADING PLAN - ALA IKE RD. & LEEWARD COMMUNITY COLLEGE
INTERS. ID NO. 99-101888
 SCALE: 1" = 5'

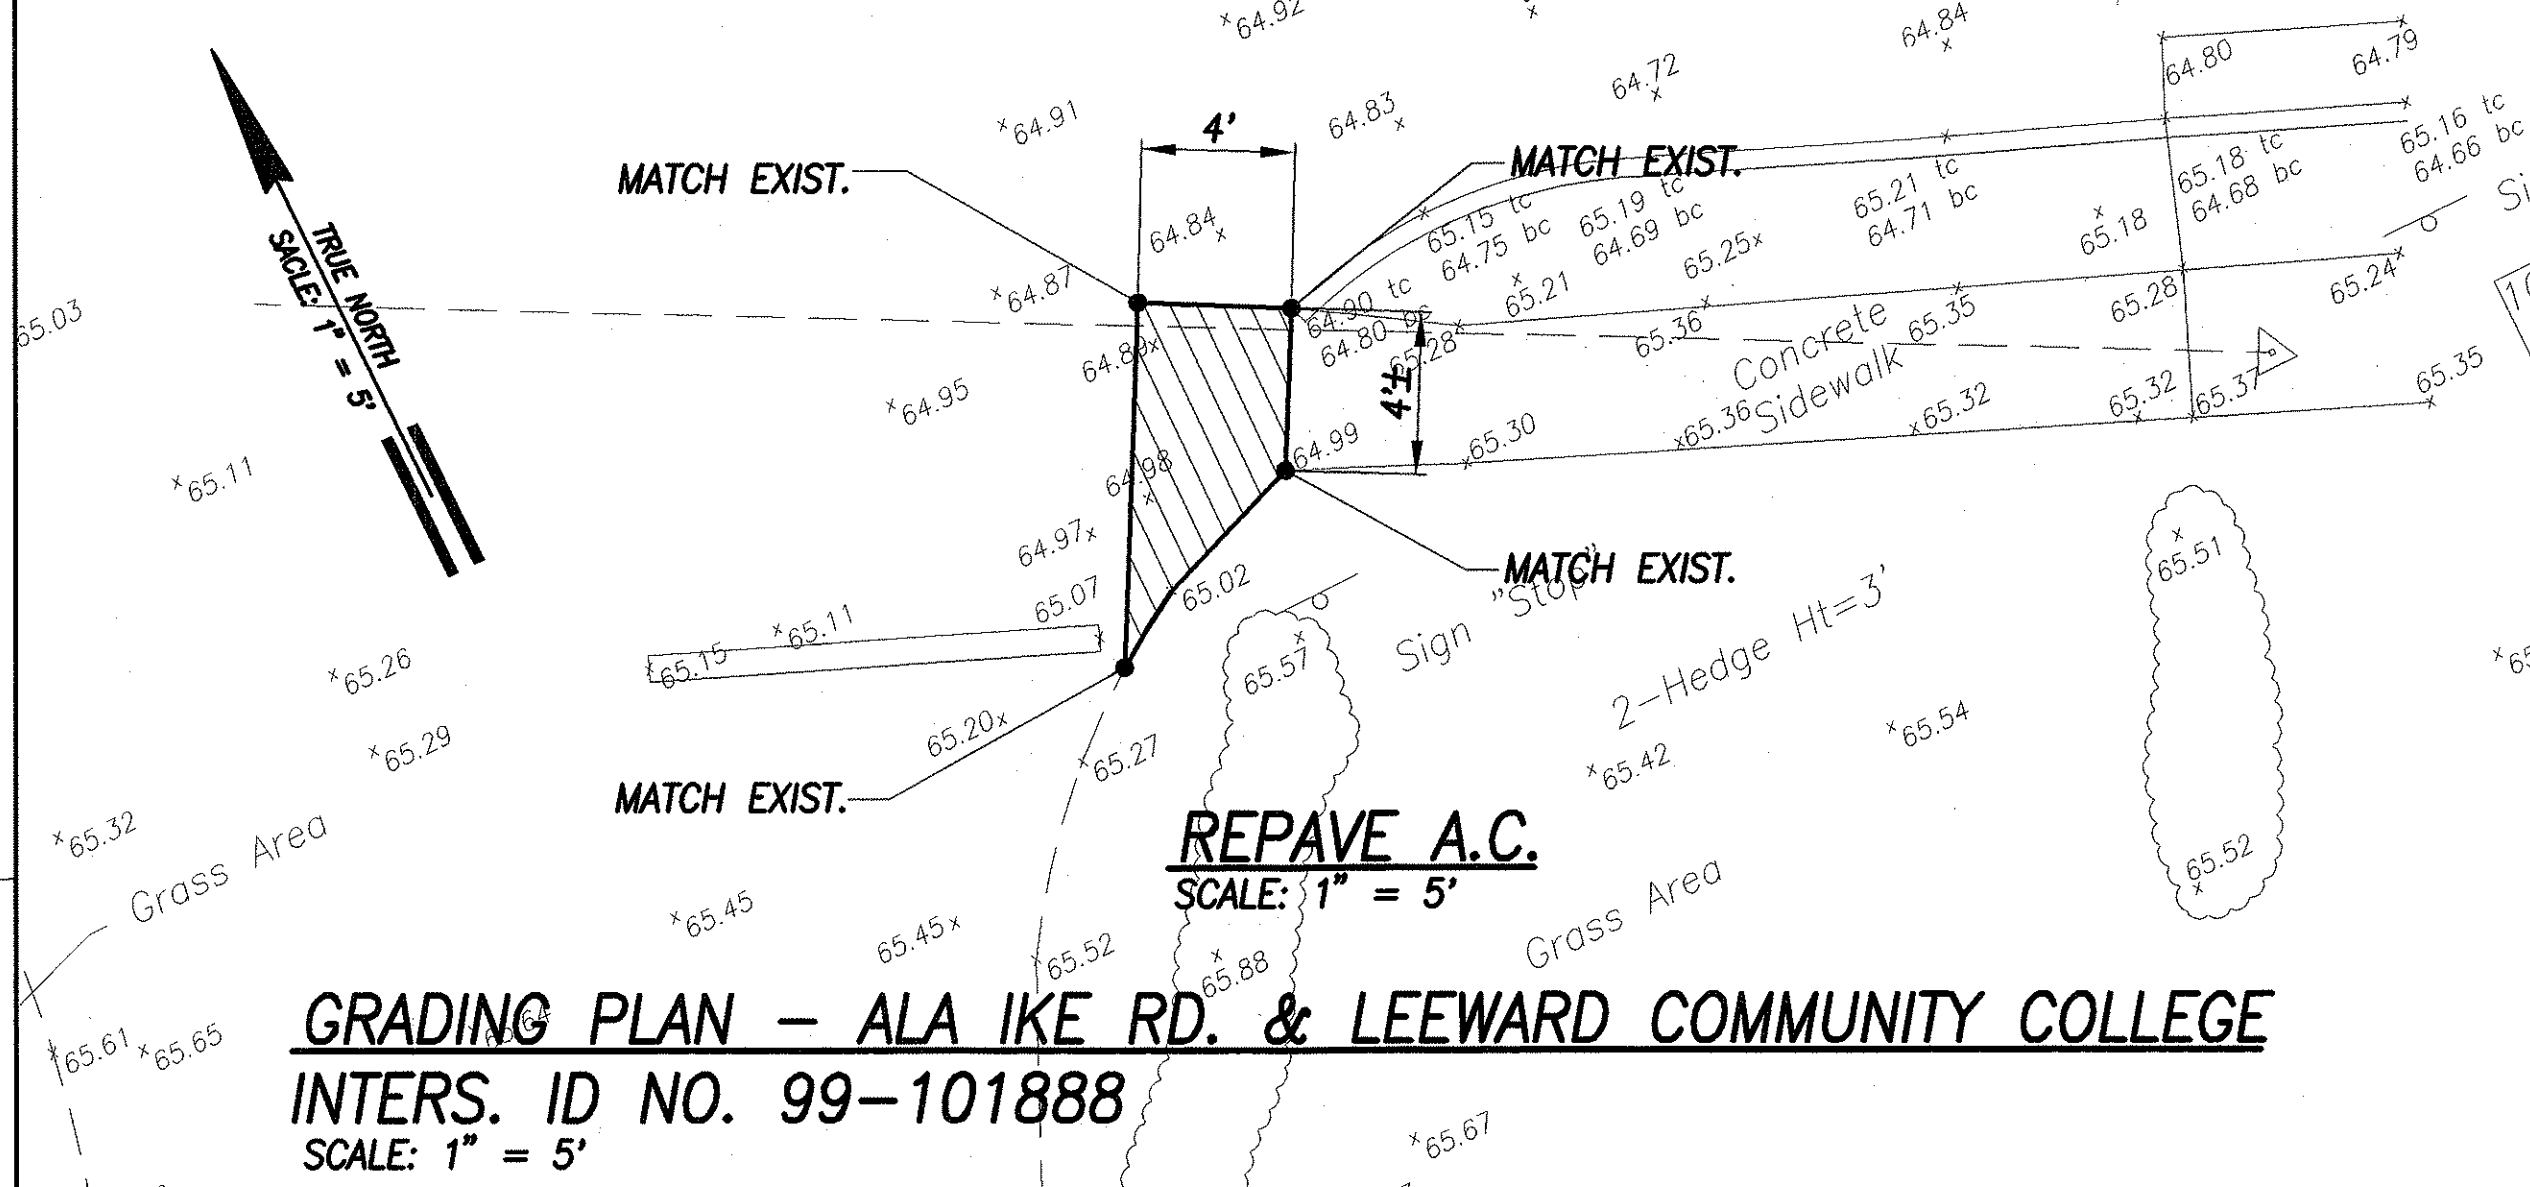


GRADING PLAN - ALA IKE RD. & LEEWARD COMMUNITY COLLEGE
INTERS. ID NO. 99-101888
 SCALE: 1" = 5'

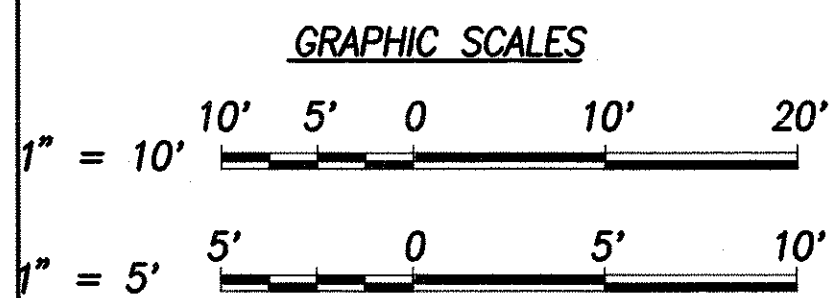

THIS WORK WAS PREPARED BY ME OR UNDER MY SUPERVISION AND CONSTRUCTION OF THIS PROJECT WILL BE UNDER MY OBSERVATION.
 SIGNATURE: *Greg H. Hiyaikunoto* DATE: April 30, 2006
 "OBSERVATION OF CONSTRUCTION" IS DEFINED IN CHAPTER 16-115, HAWAII ADMINISTRATIVE RULES ENTITLED "PROFESSIONAL ENGINEERS, ARCHITECTS, SURVEYORS AND LANDSCAPE ARCHITECTS".


STATE OF HAWAII
 DEPARTMENT OF TRANSPORTATION
 HIGHWAYS DIVISION
SITE & GRADING PLAN - ALA IKE RD. & LEEWARD COMMUNITY COLLEGE
Pedestrian Facilities & ADA Compliance at Various Locations on Oahu, Unit 5
 Fed. Aid Proj. No. CMAQ-0300(96)
 Scale: AS SHOWN Date: August, 2004
SHEET No. C-71 OF 153 SHEETS

FED. ROAD DIST. NO.	STATE	FED. AID PROJ. NO.	FISCAL YEAR	SHEET NO.	TOTAL SHEETS
HAWAII	HAW.	CMAQ-0300(98)	2004	73	153

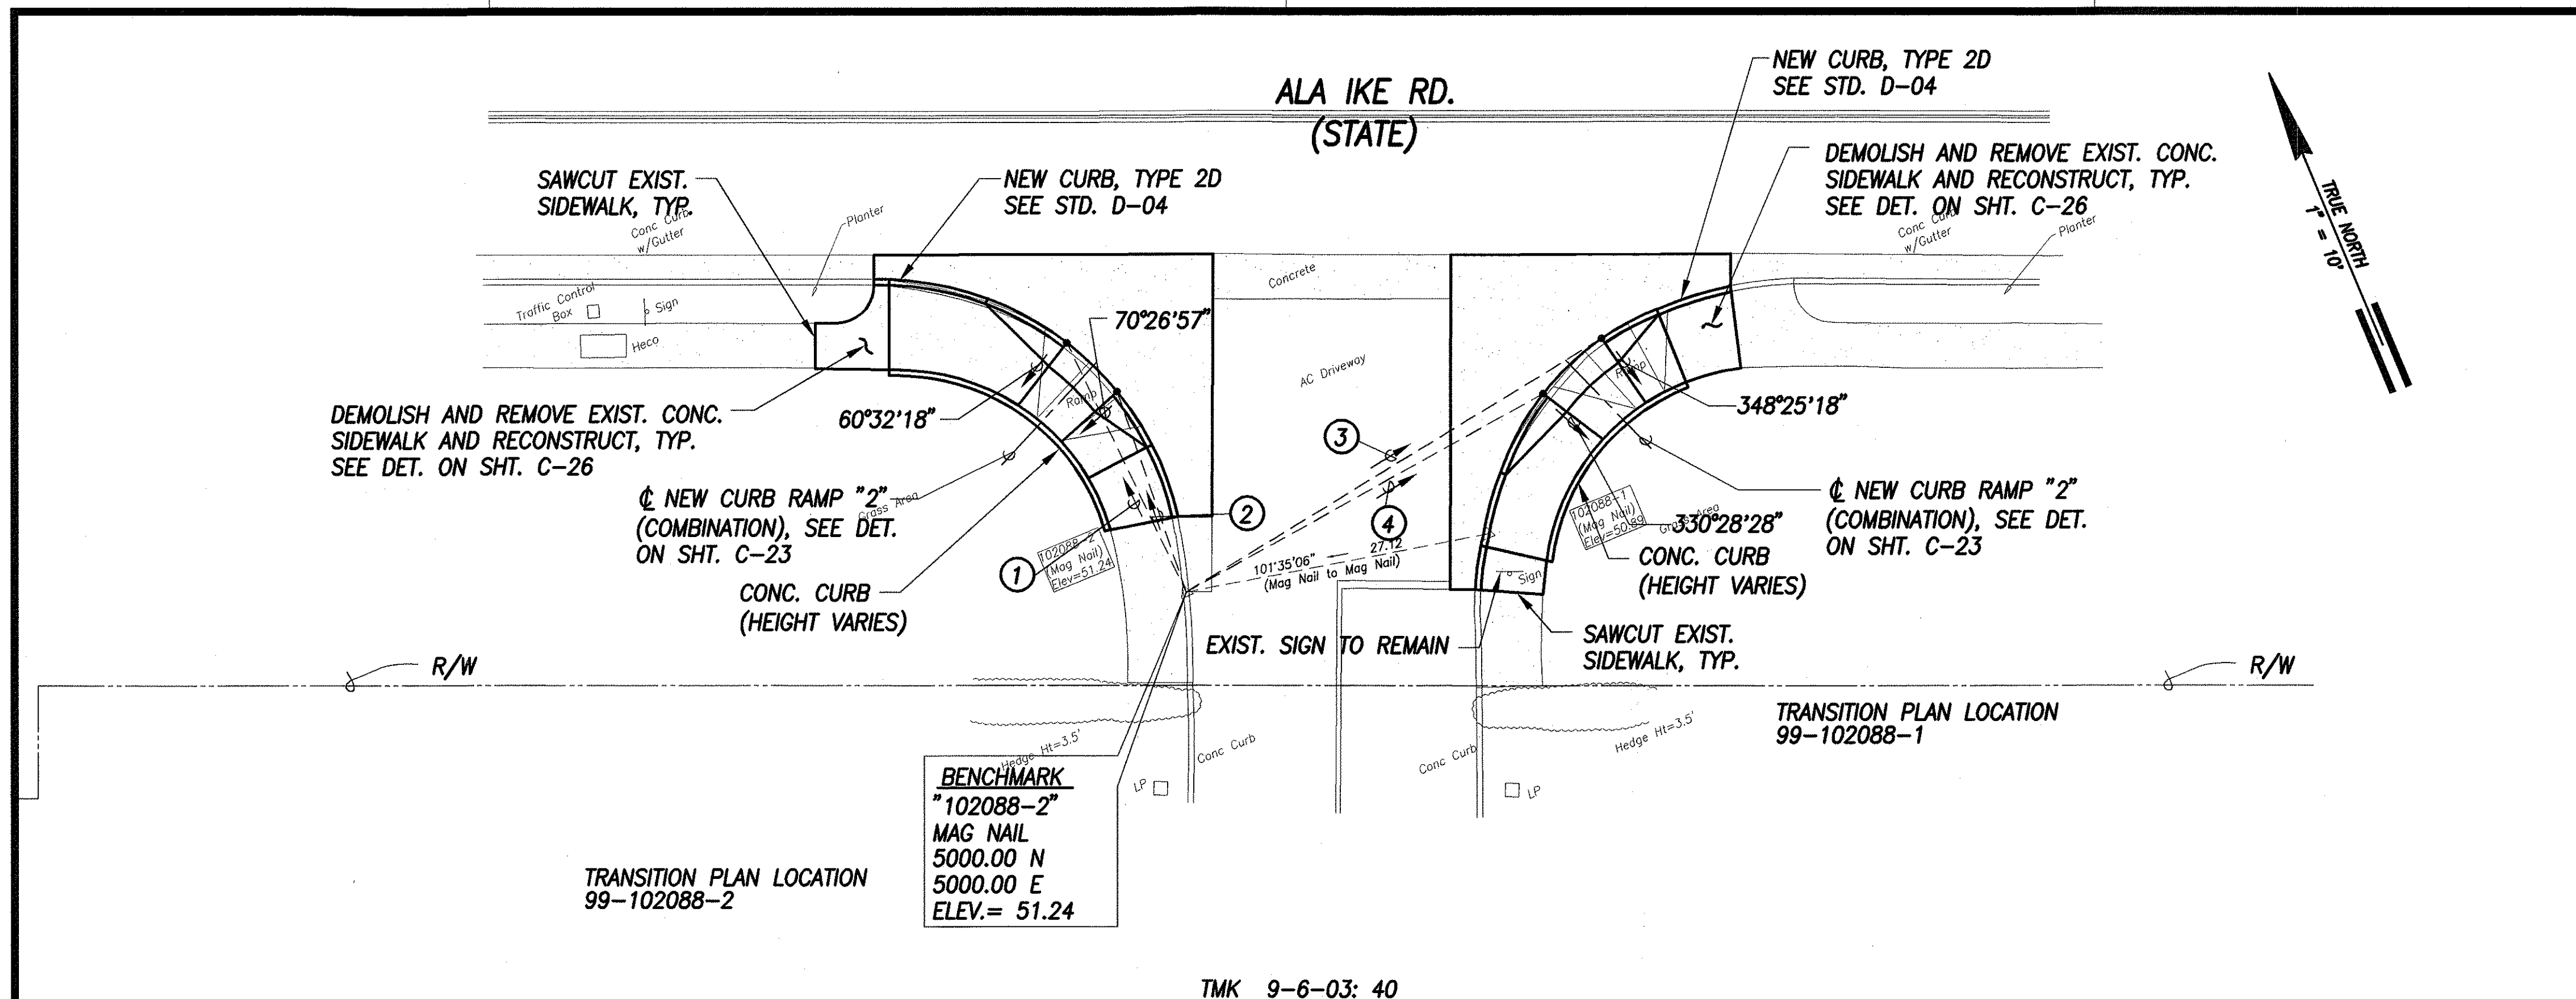


- ① 177°14'08" 24.50'
TIE: BM TO INTERSECTION OF
RAMP EDGE AND CURB FACE
- ② 183°43'21" 18.82'
TIE: BM TO INTERSECTION OF
RAMP EDGE AND CURB FACE
- ③ 261°02'53" 42.98'
TIE: BM TO INTERSECTION OF
RAMP EDGE AND CURB FACE
- ④ 263°23'03" 36.07'
TIE: BM TO INTERSECTION OF
RAMP EDGE AND CURB FACE

SITE PLAN - ALA IKE RD. & COLLEGE GARDENS
INTERS. ID NO. 99-102088
 SCALE: 1" = 10'

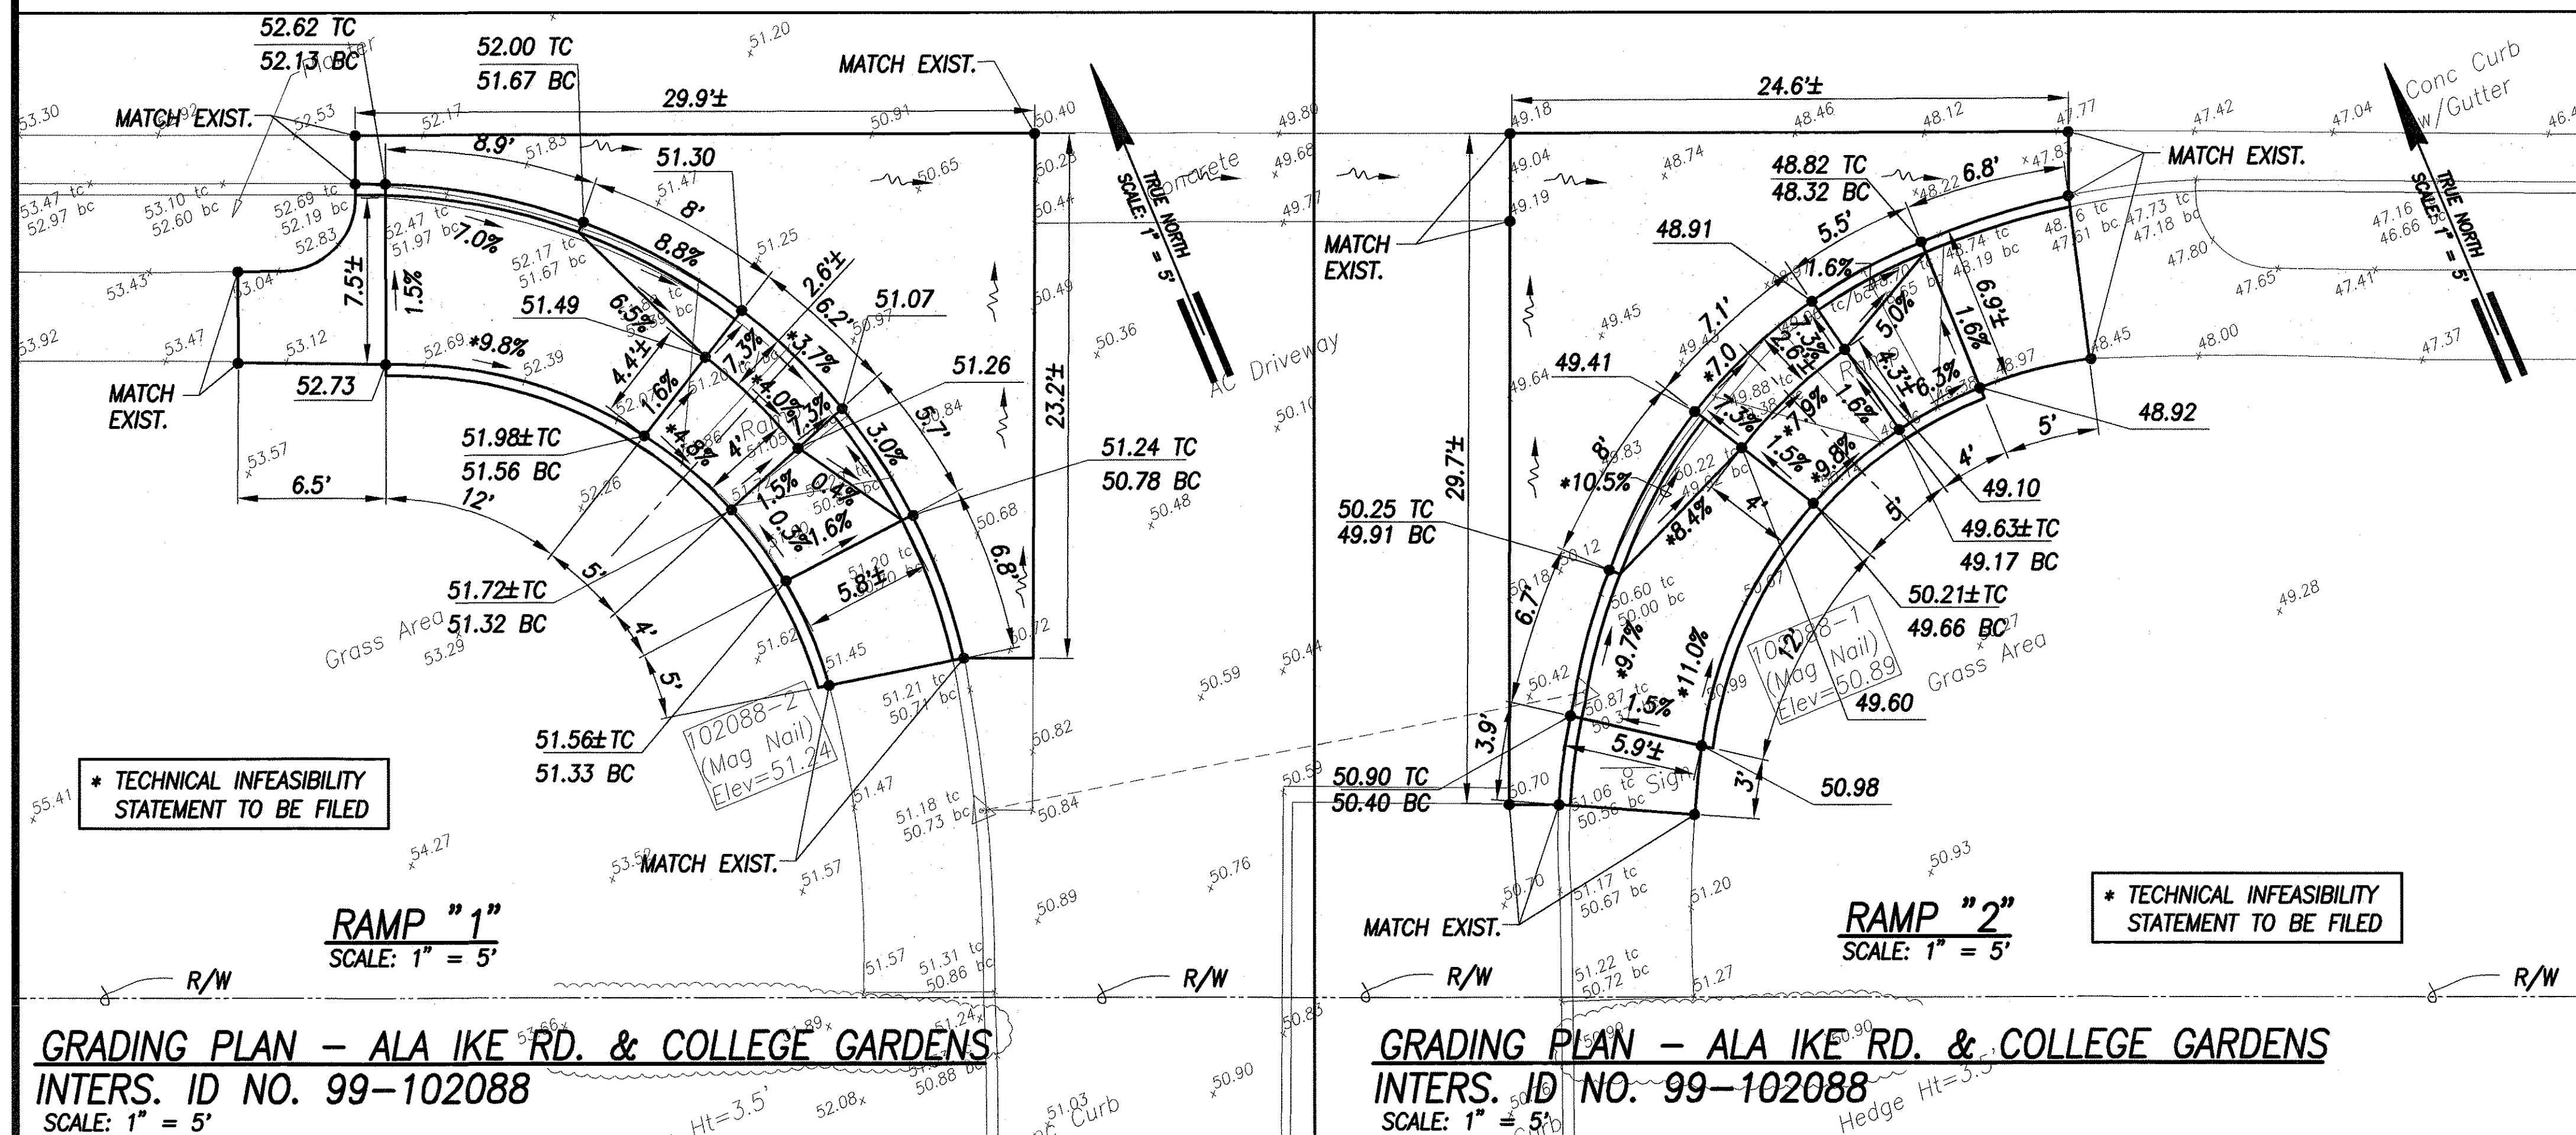

LEGEND

- x 49.52 EXIST. SPOT ELEVATION
- 52.58 FINISHED SPOT GRADE
- 51.50 TC FINISHED TOP OF CURB
- 51.00 BC FINISHED BOTTOM OF CURB

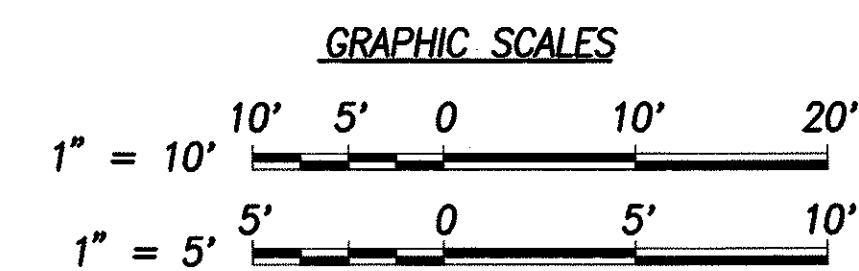

SURVEY PLATTED BY	DATE
DRAWN BY	
DESIGNED BY	
QUANTITIES BY	
CHECKED BY	
ORIGINAL PLAN	
NOTE BOOK	
No.	

GREG H. HIYAKUNO
 LICENSED PROFESSIONAL ENGINEER
 No. 6662-C
 HAWAII, U.S.A.

THIS WORK WAS PREPARED BY ME OR UNDER MY SUPERVISION AND CONSTRUCTION OF THIS PROJECT WILL BE UNDER MY OBSERVATION.

SIGNATURE: *Greg H. Hiyakuno* DATE: April 30, 2006

"OBSERVATION OF CONSTRUCTION" IS DEFINED IN CHAPTER 16-115, HAWAII ADMINISTRATIVE RULES ENTITLED "PROFESSIONAL ENGINEERS, ARCHITECTS, SURVEYORS AND LANDSCAPE ARCHITECTS".

STATE OF HAWAII
DEPARTMENT OF TRANSPORTATION
HIGHWAYS DIVISION

SITE & GRADING PLAN
ALA IKE RD. & COLLEGE GARDENS


Pedestrian Facilities & ADA Compliance at Various Locations on Oahu, Unit 5
 Fed. Aid Proj. No. CMAQ-0300(96)

Scale: AS SHOWN Date: August 2004

SHEET No. C-72 OF 153 SHEETS

FED. ROAD DIST. NO.	STATE	FED. AID PROJ. NO.	FISCAL YEAR	SHEET NO.	TOTAL SHEETS
HAWAII	HAW.	CMAQ-0300(96)	2004	74	153

- ① 163°24'41" 60.81'
TIE: BM TO INTERSECTION OF RAMP
EDGE AND CURB FACE
- ② 168°51'20" 58.46'
TIE: BM TO INTERSECTION OF RAMP
EDGE AND CURB FACE
- ③ 246°06'46" 24.74'
TIE: BM TO INTERSECTION OF RAMP
EDGE AND CURB FACE
- ④ 260°39'46" 21.35'
TIE: BM TO INTERSECTION OF RAMP
EDGE AND CURB FACE
- ⑤ 95°14'30" 122.07'
TIE: BM TO INTERSECTION OF RAMP
EDGE AND CURB FACE
- ⑥ 92°15'57" 122.88'
TIE: BM TO INTERSECTION OF RAMP
EDGE AND CURB FACE
- ⑦ 90°29'35" 97.20'
TIE: BM TO INTERSECTION OF CL
RAMP
- ⑧ 52°41'12" 80.71'
TIE: BM TO INTERSECTION OF CL
RAMP
- ⑨ 43°39'23" 102.85'
TIE: BM TO INTERSECTION OF RAMP
EDGE AND CURB FACE
- ⑩ 40°28'15" 99.71'
TIE: BM TO INTERSECTION OF RAMP
EDGE AND CURB FACE
- ⑪ 42°01'35" 101.08'
TIE: BM TO INTERSECTION OF ∇
CROSSWALK AND CURB FACE

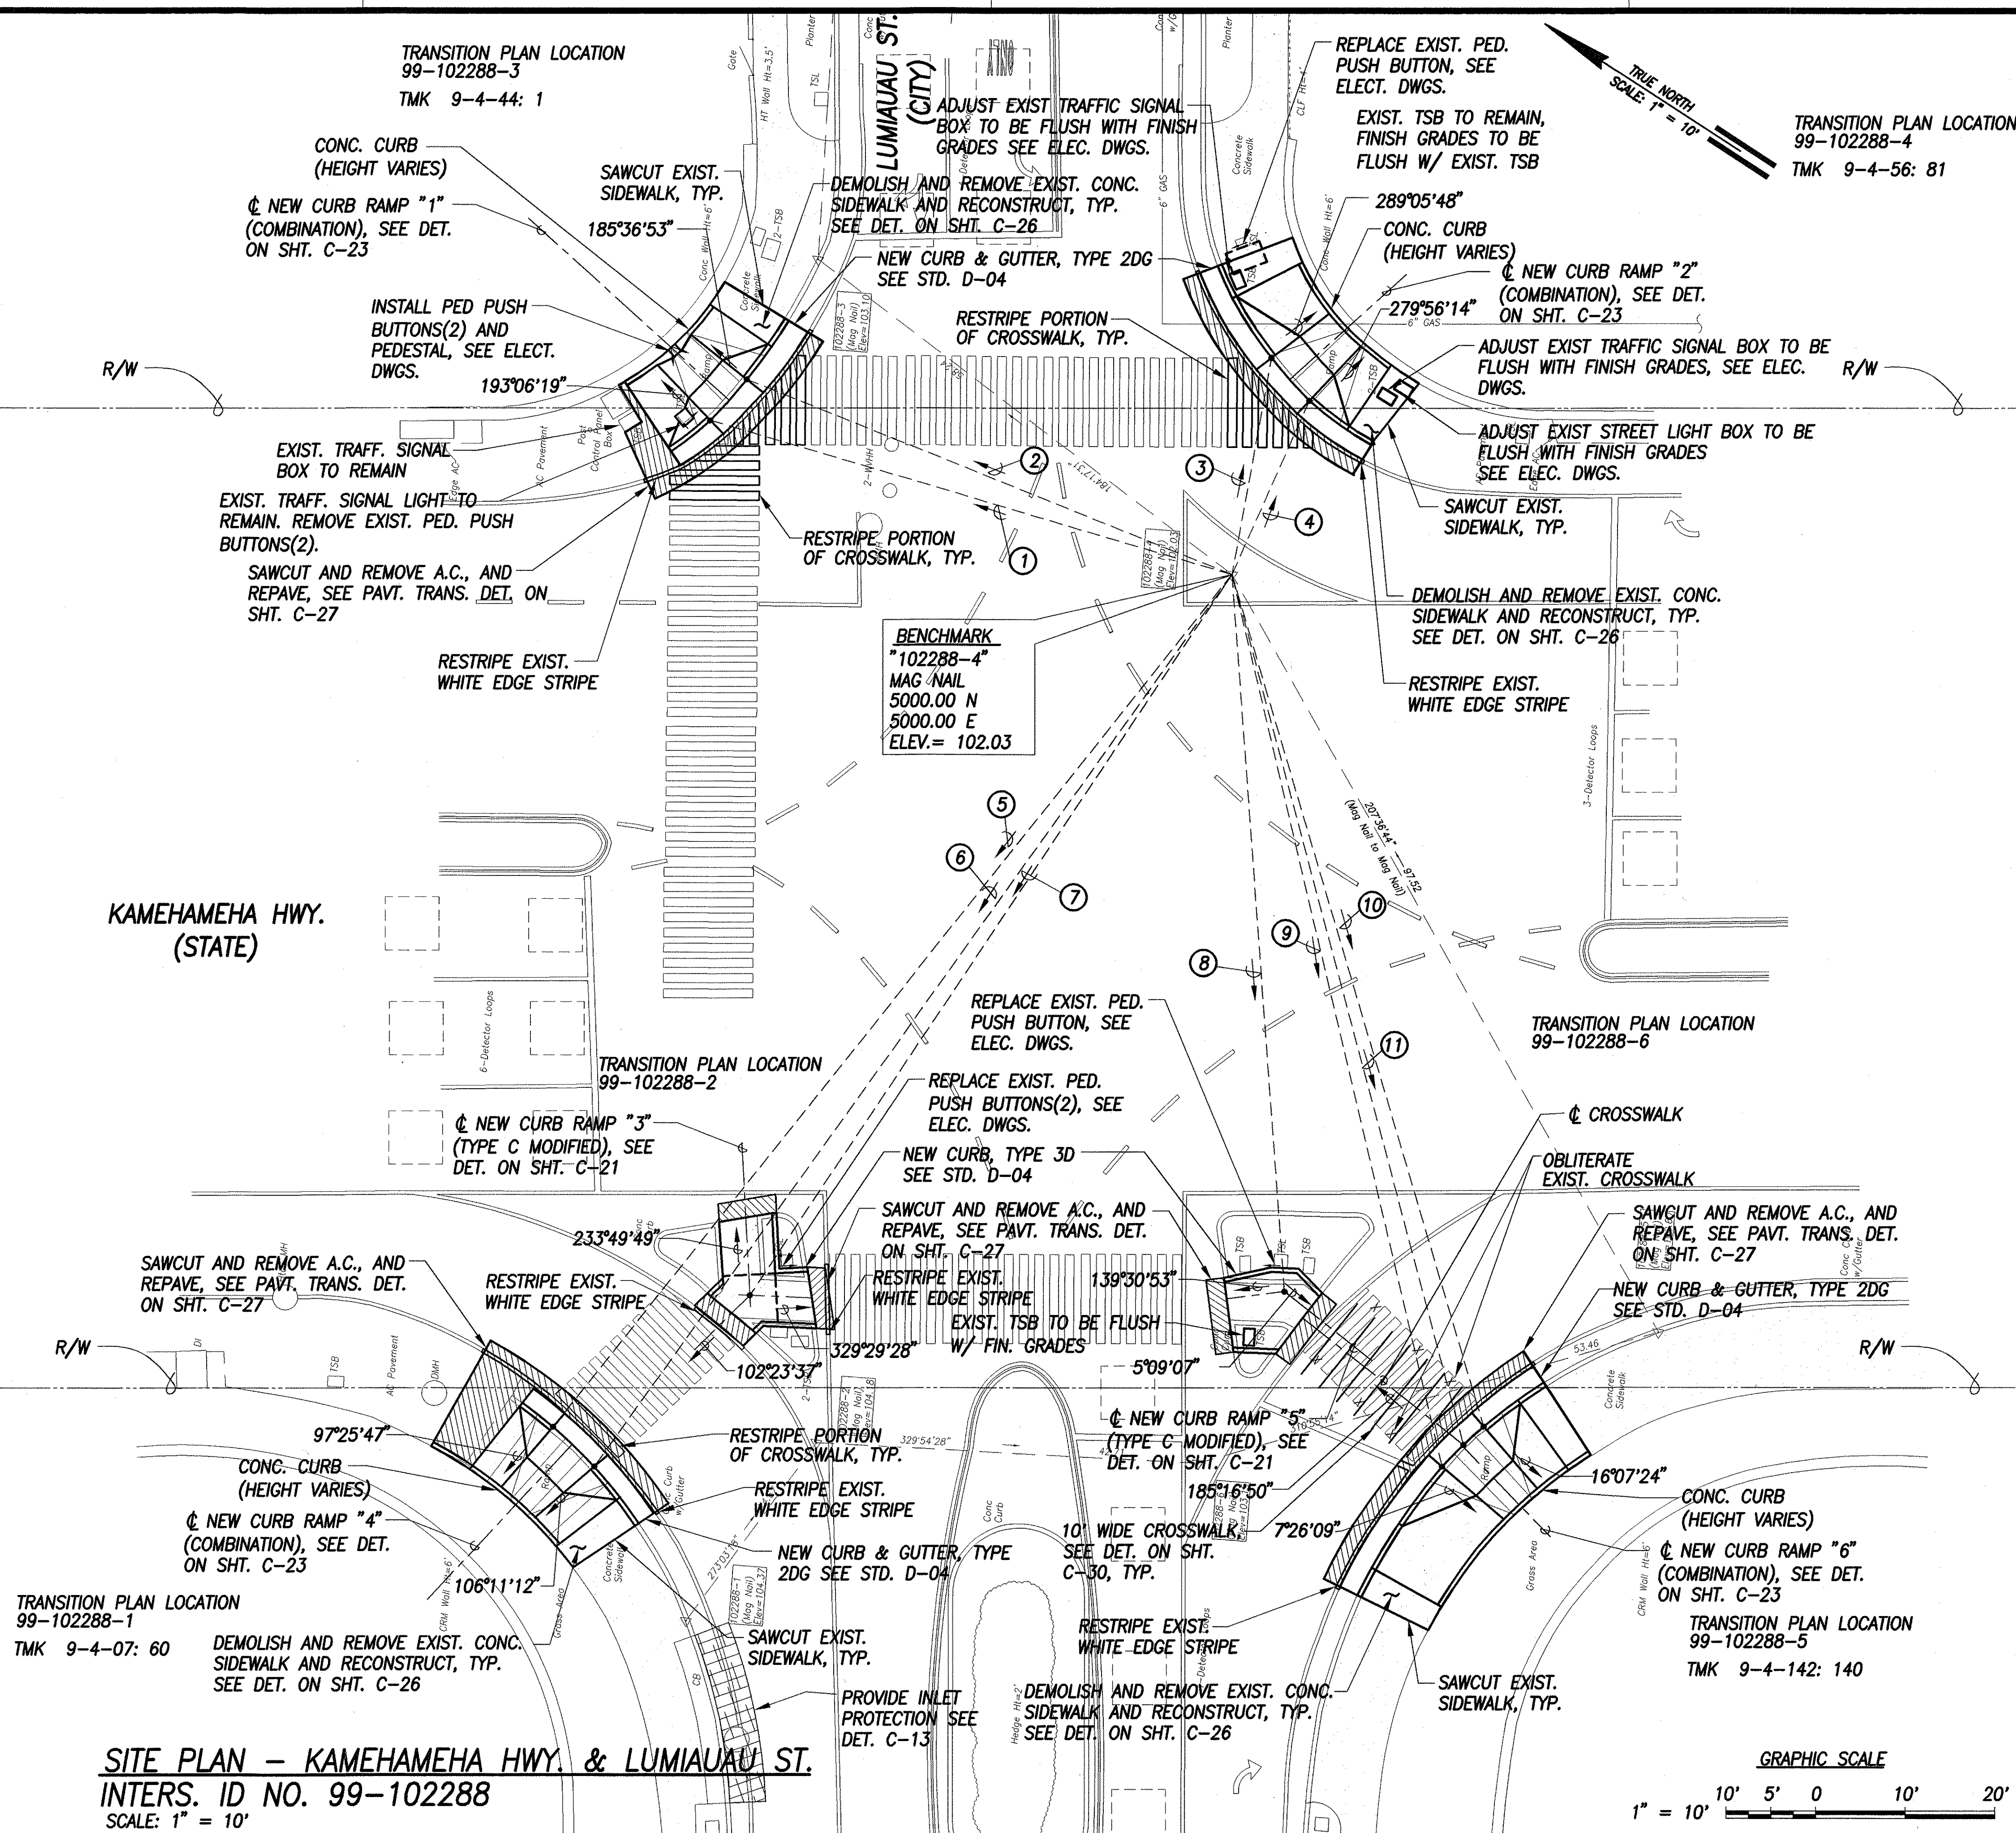

ORIGINAL PLAN	SURVEY PLOTTED BY _____ DATE _____
NOTE BOOK	DRAWN BY _____
	TRACED BY _____
	QUANTITIES BY _____
	CHECKED BY _____
No. _____	



THIS WORK WAS PREPARED BY ME OR UNDER
MY SUPERVISION AND CONSTRUCTION OF THIS
PROJECT WILL BE UNDER MY OBSERVATION.

Shirley L. Williams April 30, 20
SIGNATURE 8/11/04 DATE 04

"OBSERVATION OF CONSTRUCTION" IS DEFINED IN CHAPTER 16-115, HAWAII ADMINISTRATIVE RULES ENTITLED "PROFESSIONAL ENGINEERS, ARCHITECTS, SURVEYORS AND LANDSCAPE ARCHITECTS"

**STATE OF HAWAII
DEPARTMENT OF TRANSPORTATION
HIGHWAYS DIVISION**


SITE PLAN - KAMEHAMEHA
HWY. & LUMIAUUA ST.

Pedestrian Facilities & ADA Compliance
at Various Locations on Oahu, Unit 5
Fed. Aid Proj. No. CMAQ-0300(96)

Scale: 1" = 10'-0" Date: August 2004

SHEET No. C-73 OF 153 SHEETS



FED. ROAD DIST. NO.	STATE	FED. AID PROJ. NO.	FISCAL YEAR	SHEET NO.	TOTAL SHEETS
HAWAII	HAW.	CMAQ-0300(98)	2004	75	153

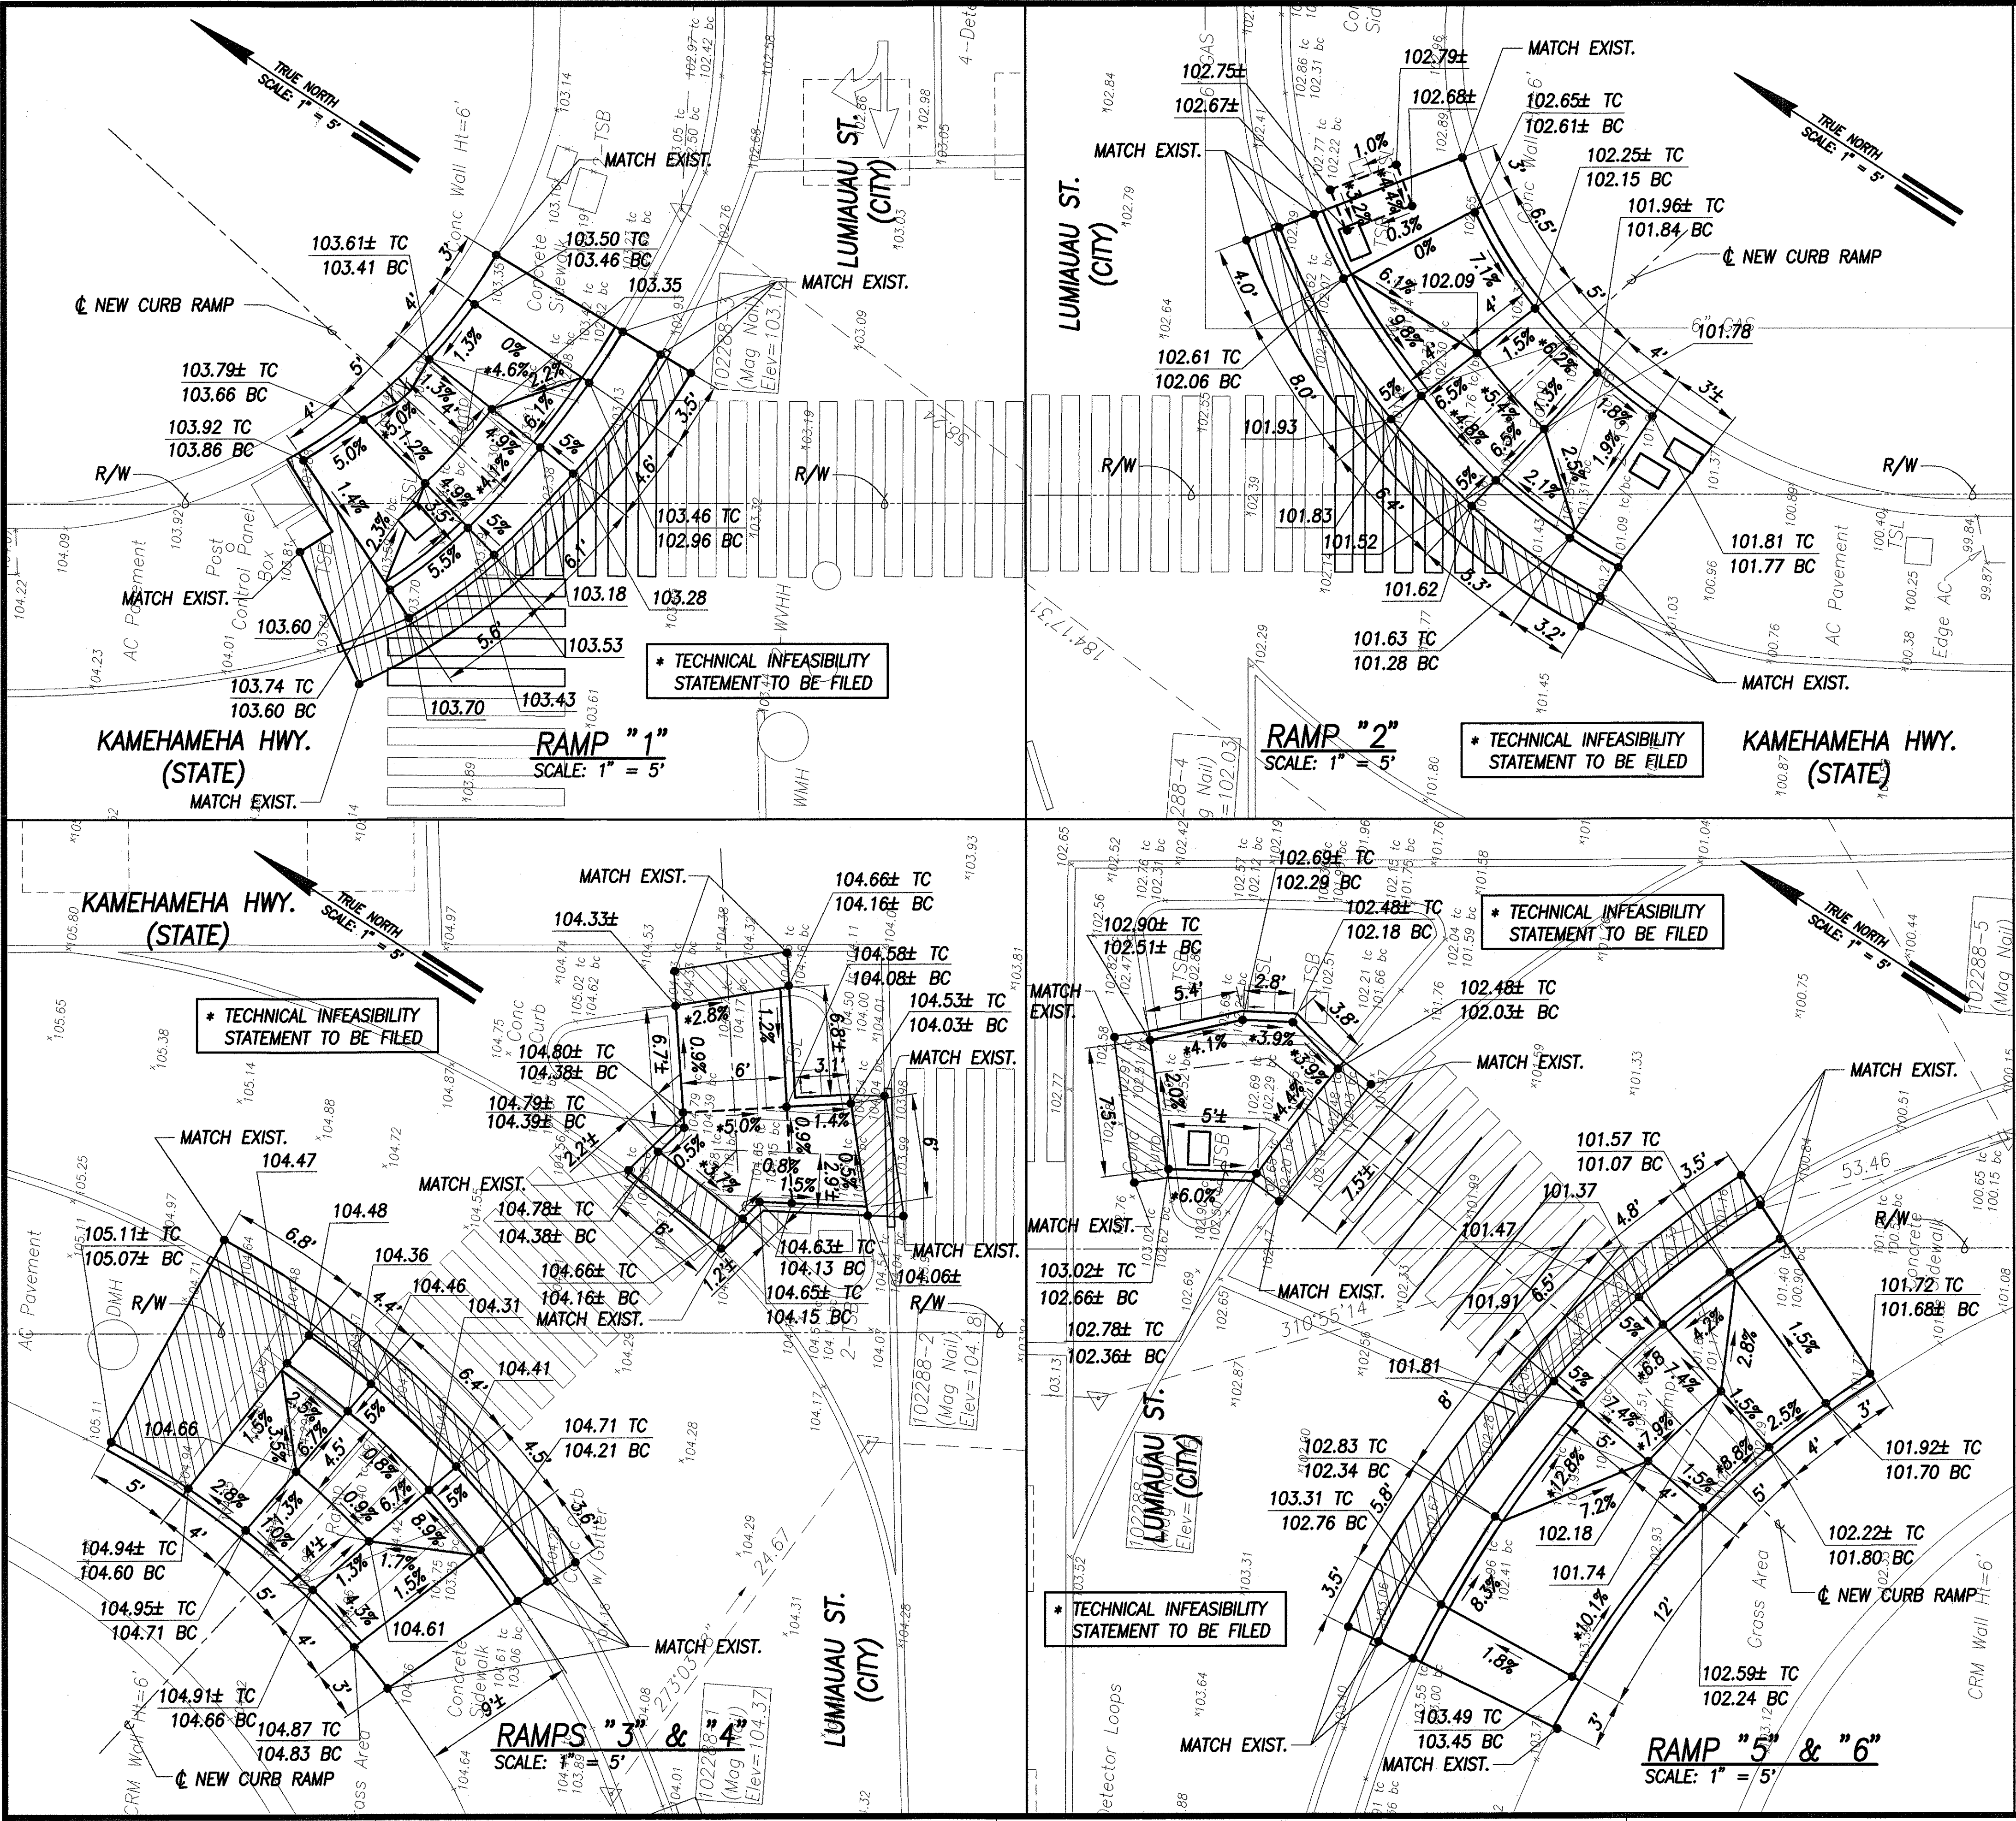

LEGEND

- × 49.52 EXIST. SPOT ELEVATION
- 52.58 FINISHED SPOT GRADE
- 51.50 TC FINISHED TOP OF CURB
- 51.00 BC FINISHED BOTTOM OF CURB

GRADING PLAN – KAMEHAMEHA HWY. & LUMIAUAU ST.
INTERS. ID NO. 99-102288
 SCALE: 1" = 5'

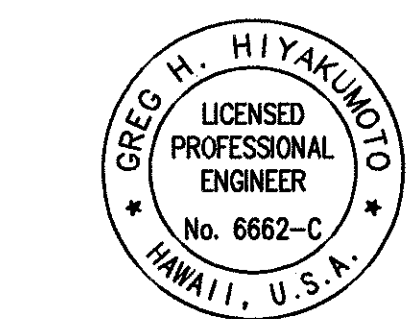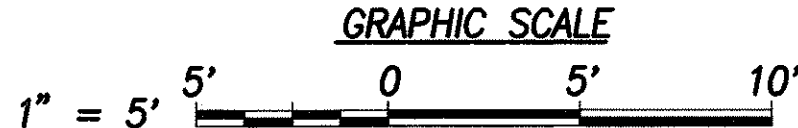

THIS WORK WAS PREPARED BY ME OR UNDER MY SUPERVISION AND CONSTRUCTION OF THIS PROJECT WILL BE UNDER MY OBSERVATION.

DATE: April 30, 2006
 SIGNATURE: [Signature]
 "OBSERVATION OF CONSTRUCTION" IS DEFINED IN CHAPTER 16-115, HAWAII ADMINISTRATIVE RULES ENTITLED "PROFESSIONAL ENGINEERS, ARCHITECTS, SURVEYORS AND LANDSCAPE ARCHITECTS".

STATE OF HAWAII
 DEPARTMENT OF TRANSPORTATION
 HIGHWAYS DIVISION

GRADING PLAN – KAMEHAMEHA HWY. & LUMIAUAU ST.


Pedestrian Facilities & ADA Compliance at Various Locations on Oahu, Unit 5
 Fed. Aid Proj. No. CMAQ-0300(96)

Scale: 1" = 5'-0" Date: August 2004

SHEET No. C-74 OF 153 SHEETS

ORIGINAL PLAN	SURVEY PLOTTED BY	DATE
DESIGNED BY		
NOTED BY		
QUANTITIES BY		
CHECKED BY		

FED. ROAD DIST. NO.	STATE	FED. AID PROJ. NO.	FISCAL YEAR	SHEET NO.	TOTAL SHEETS
HAWAII	HAW.	CMAQ-0300(96)	2004	76	153

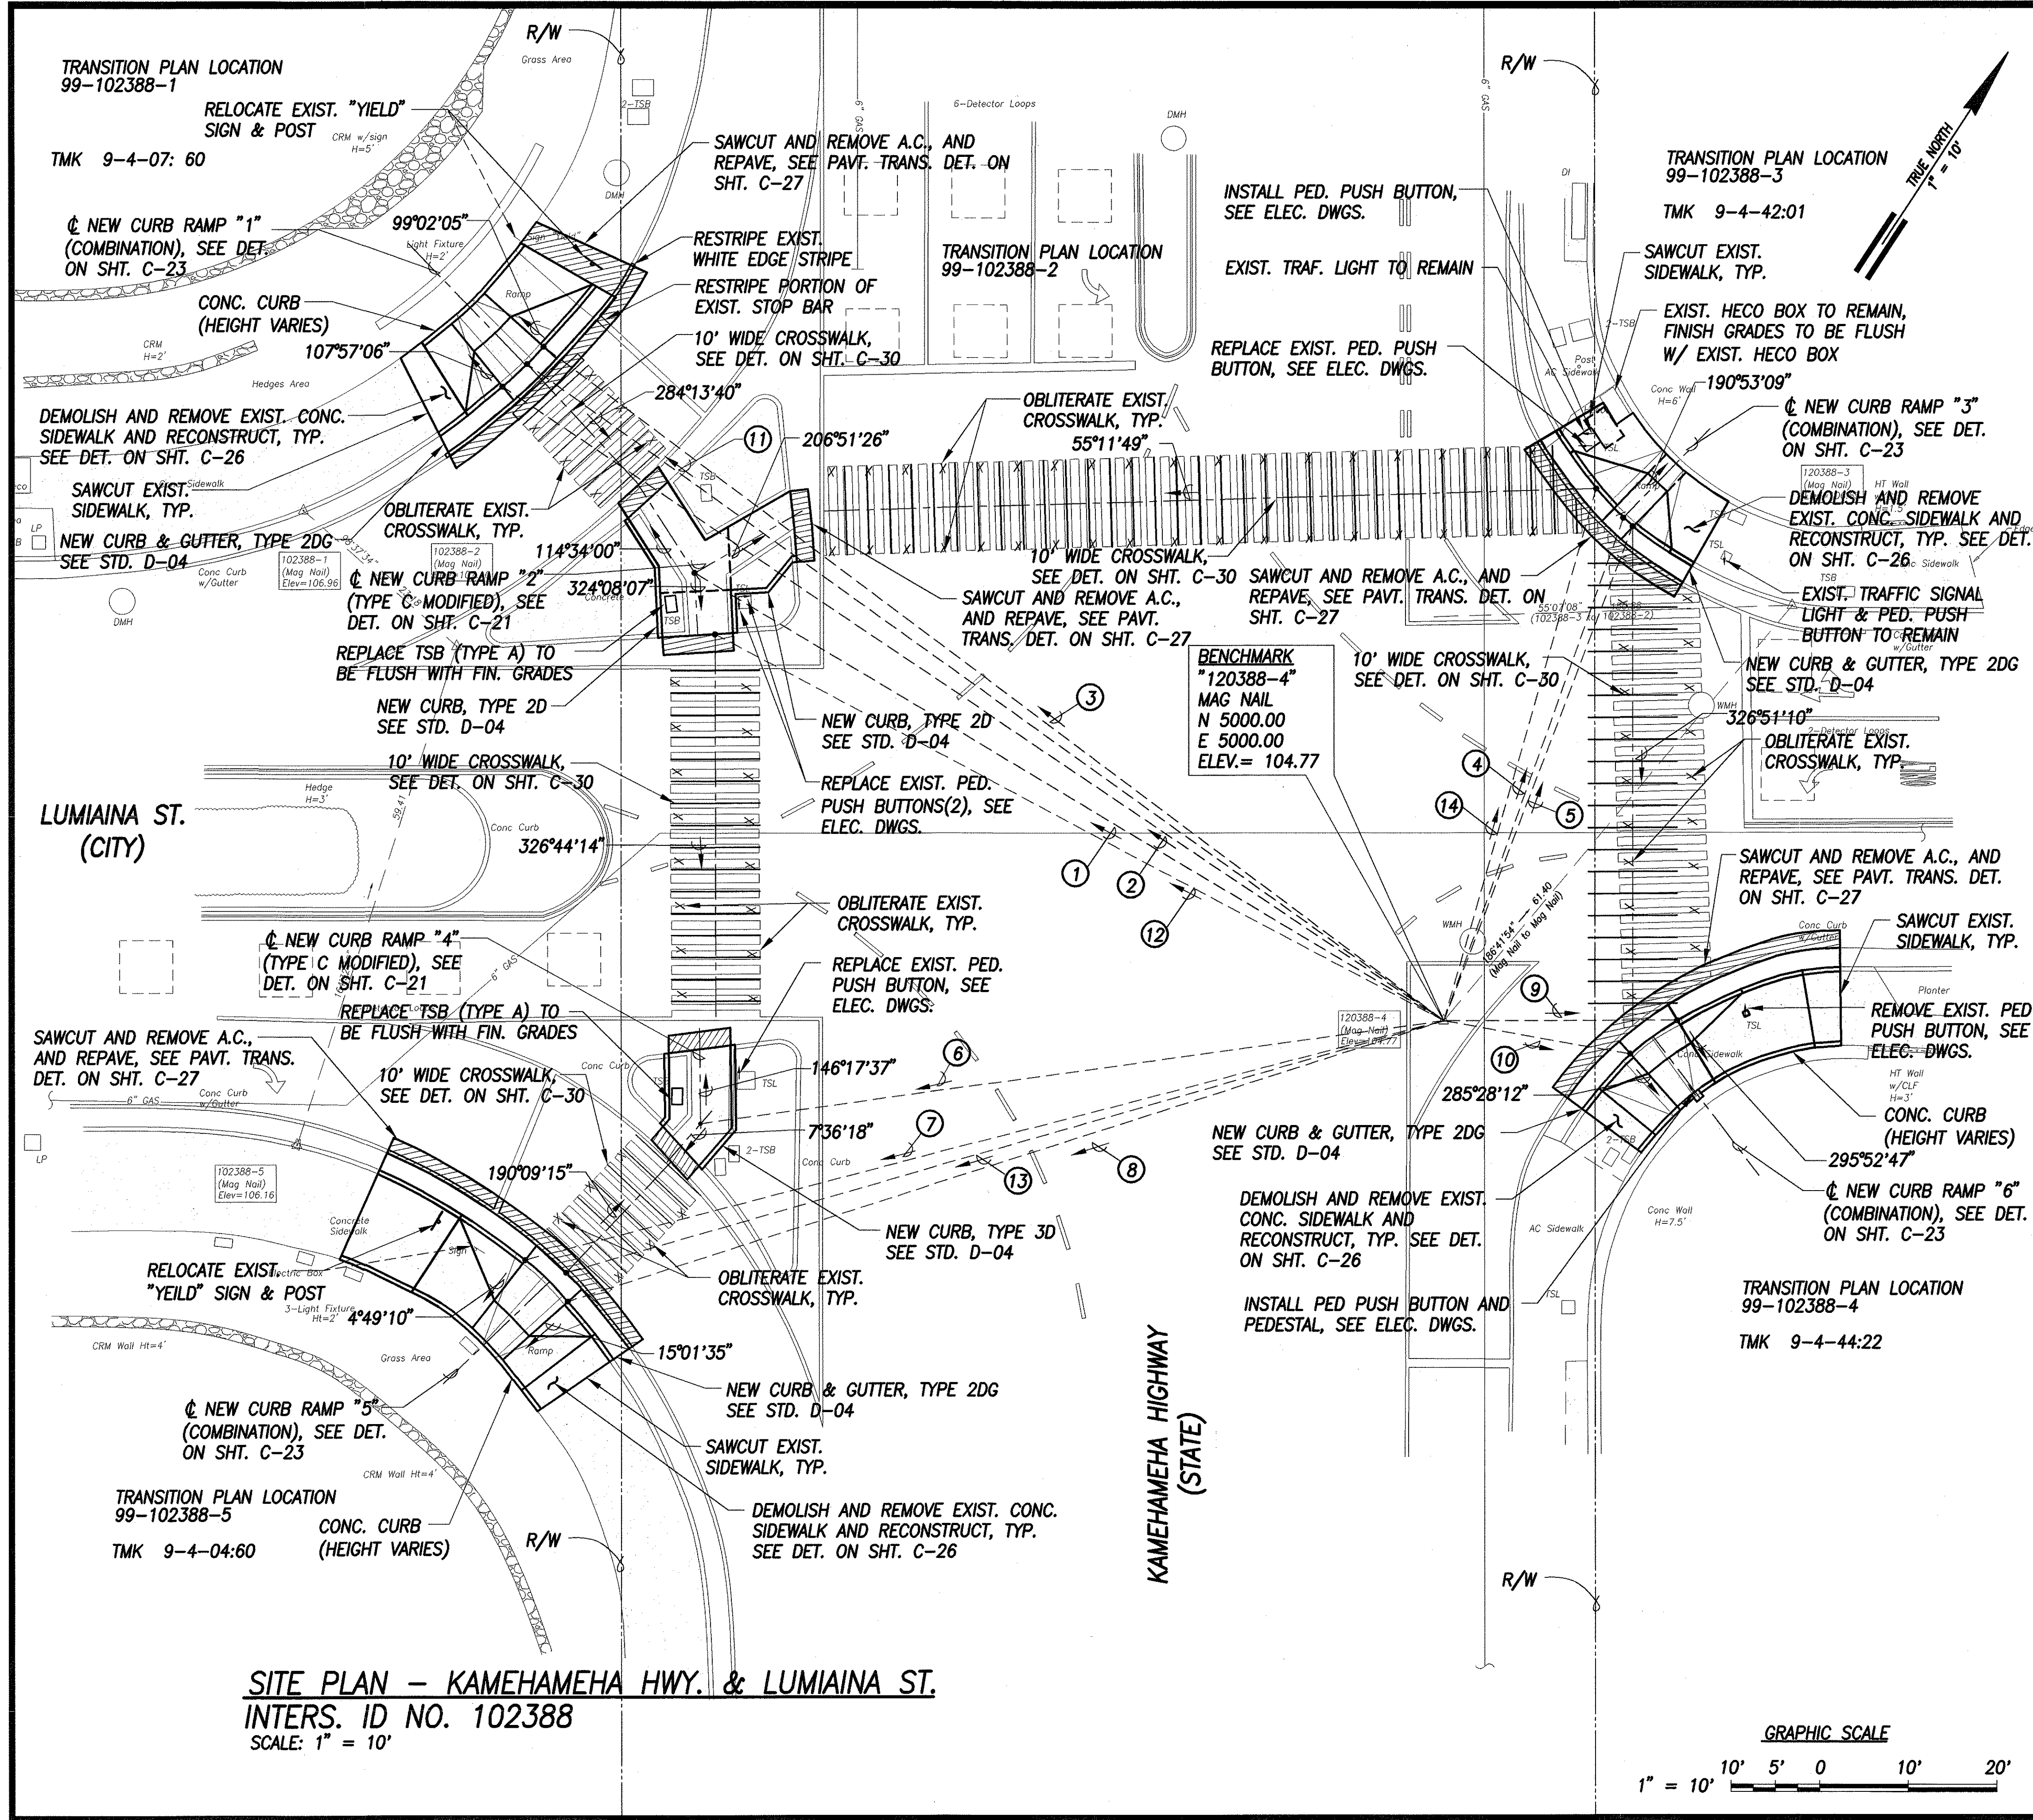

- ① 87°53'05" 98.75'
TIE: BM TO INTERSECTION OF ϕ OF RAMP
- ② 90°59'10" 128.41'
TIE: BM TO INTERSECTION OF RAMP EDGE AND CURB FACE
- ③ 93°50'47" 127.27'
TIE: BM TO INTERSECTION OF RAMP EDGE AND CURB FACE
- ④ 166°25'24" 60.59'
TIE: BM TO INTERSECTION OF ϕ RAMP AND CURB FACE
- ⑤ 167°40'41" 60.04'
TIE: BM TO INTERSECTION OF ϕ CROSSWALK AND CURB FACE
- ⑥ 48°57'16" 84.79'
TIE: BM TO INTERSECTION OF ϕ OF RAMP
- ⑦ 42°11'33" 107.25'
TIE: BM TO INTERSECTION OF RAMP EDGE AND CURB FACE
- ⑧ 39°00'21" 103.95'
TIE: BM TO INTERSECTION OF RAMP EDGE AND CURB FACE
- ⑨ 236°51'52" 26.35'
TIE: BM TO INTERSECTION OF RAMP EDGE AND CURB FACE
- ⑩ 247°12'39" 21.43'
TIE: BM TO INTERSECTION OF RAMP EDGE AND CURB FACE
- ⑪ 92°37'57" 127.60'
TIE: BM TO INTERSECTION OF ϕ CROSSWALK AND CURB FACE
- ⑫ 84°57'32" 93.33'
TIE: BM TO INTERSECTION OF ϕ CROSSWALK AND CURB FACE
- ⑬ 40°46'23" 103.17'
TIE: BM TO INTERSECTION OF ϕ CROSSWALK AND CURB FACE
- ⑭ 162°46'17" 62.85'
TIE: BM TO INTERSECTION OF ϕ CROSSWALK AND CURB FACE

SITE PLAN - KAMEHAMEHA HWY. & LUMIAINA ST.
INTERS. ID NO. 102388
 SCALE: 1" = 10'

DATE	_____
SURVEY PLATTED BY	_____
DRAWN BY	_____
DESIGNED BY	_____
QUANTITIES BY	_____
CHECKED BY	_____
ORIGINAL PLAN	_____
NOTE BOOK	_____
No.	_____

THIS WORK WAS PREPARED BY ME OR UNDER MY SUPERVISION AND CONSTRUCTION OF THIS PROJECT WILL BE UNDER MY OBSERVATION.

SIGNATURE: _____ DATE: 4/30/04

"OBSERVATION OF CONSTRUCTION" IS DEFINED IN CHAPTER 16-115, HAWAII ADMINISTRATIVE RULES ENTITLED "PROFESSIONAL ENGINEERS, ARCHITECTS, SURVEYORS AND LANDSCAPE ARCHITECTS".

STATE OF HAWAII
 DEPARTMENT OF TRANSPORTATION
 HIGHWAYS DIVISION


SITE PLAN - KAMEHAMEHA HWY. & LUMIAINA ST.

Pedestrian Facilities & ADA Compliance at Various Locations on Oahu, Unit 5





Fed. Aid Proj. No. CMAQ-0300(96)

Scale: 1" = 10'-0" Date: August 2004

SHEET No. C-75 OF 153 SHEETS

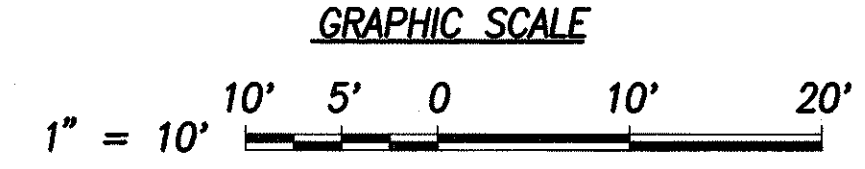


FED. ROAD DIST. NO.	STATE	FED. AID PROJ. NO.	FISCAL YEAR	SHEET NO.	TOTAL SHEETS
HAWAII	HAW.	CMAQ-0300(96)	2004	77	153

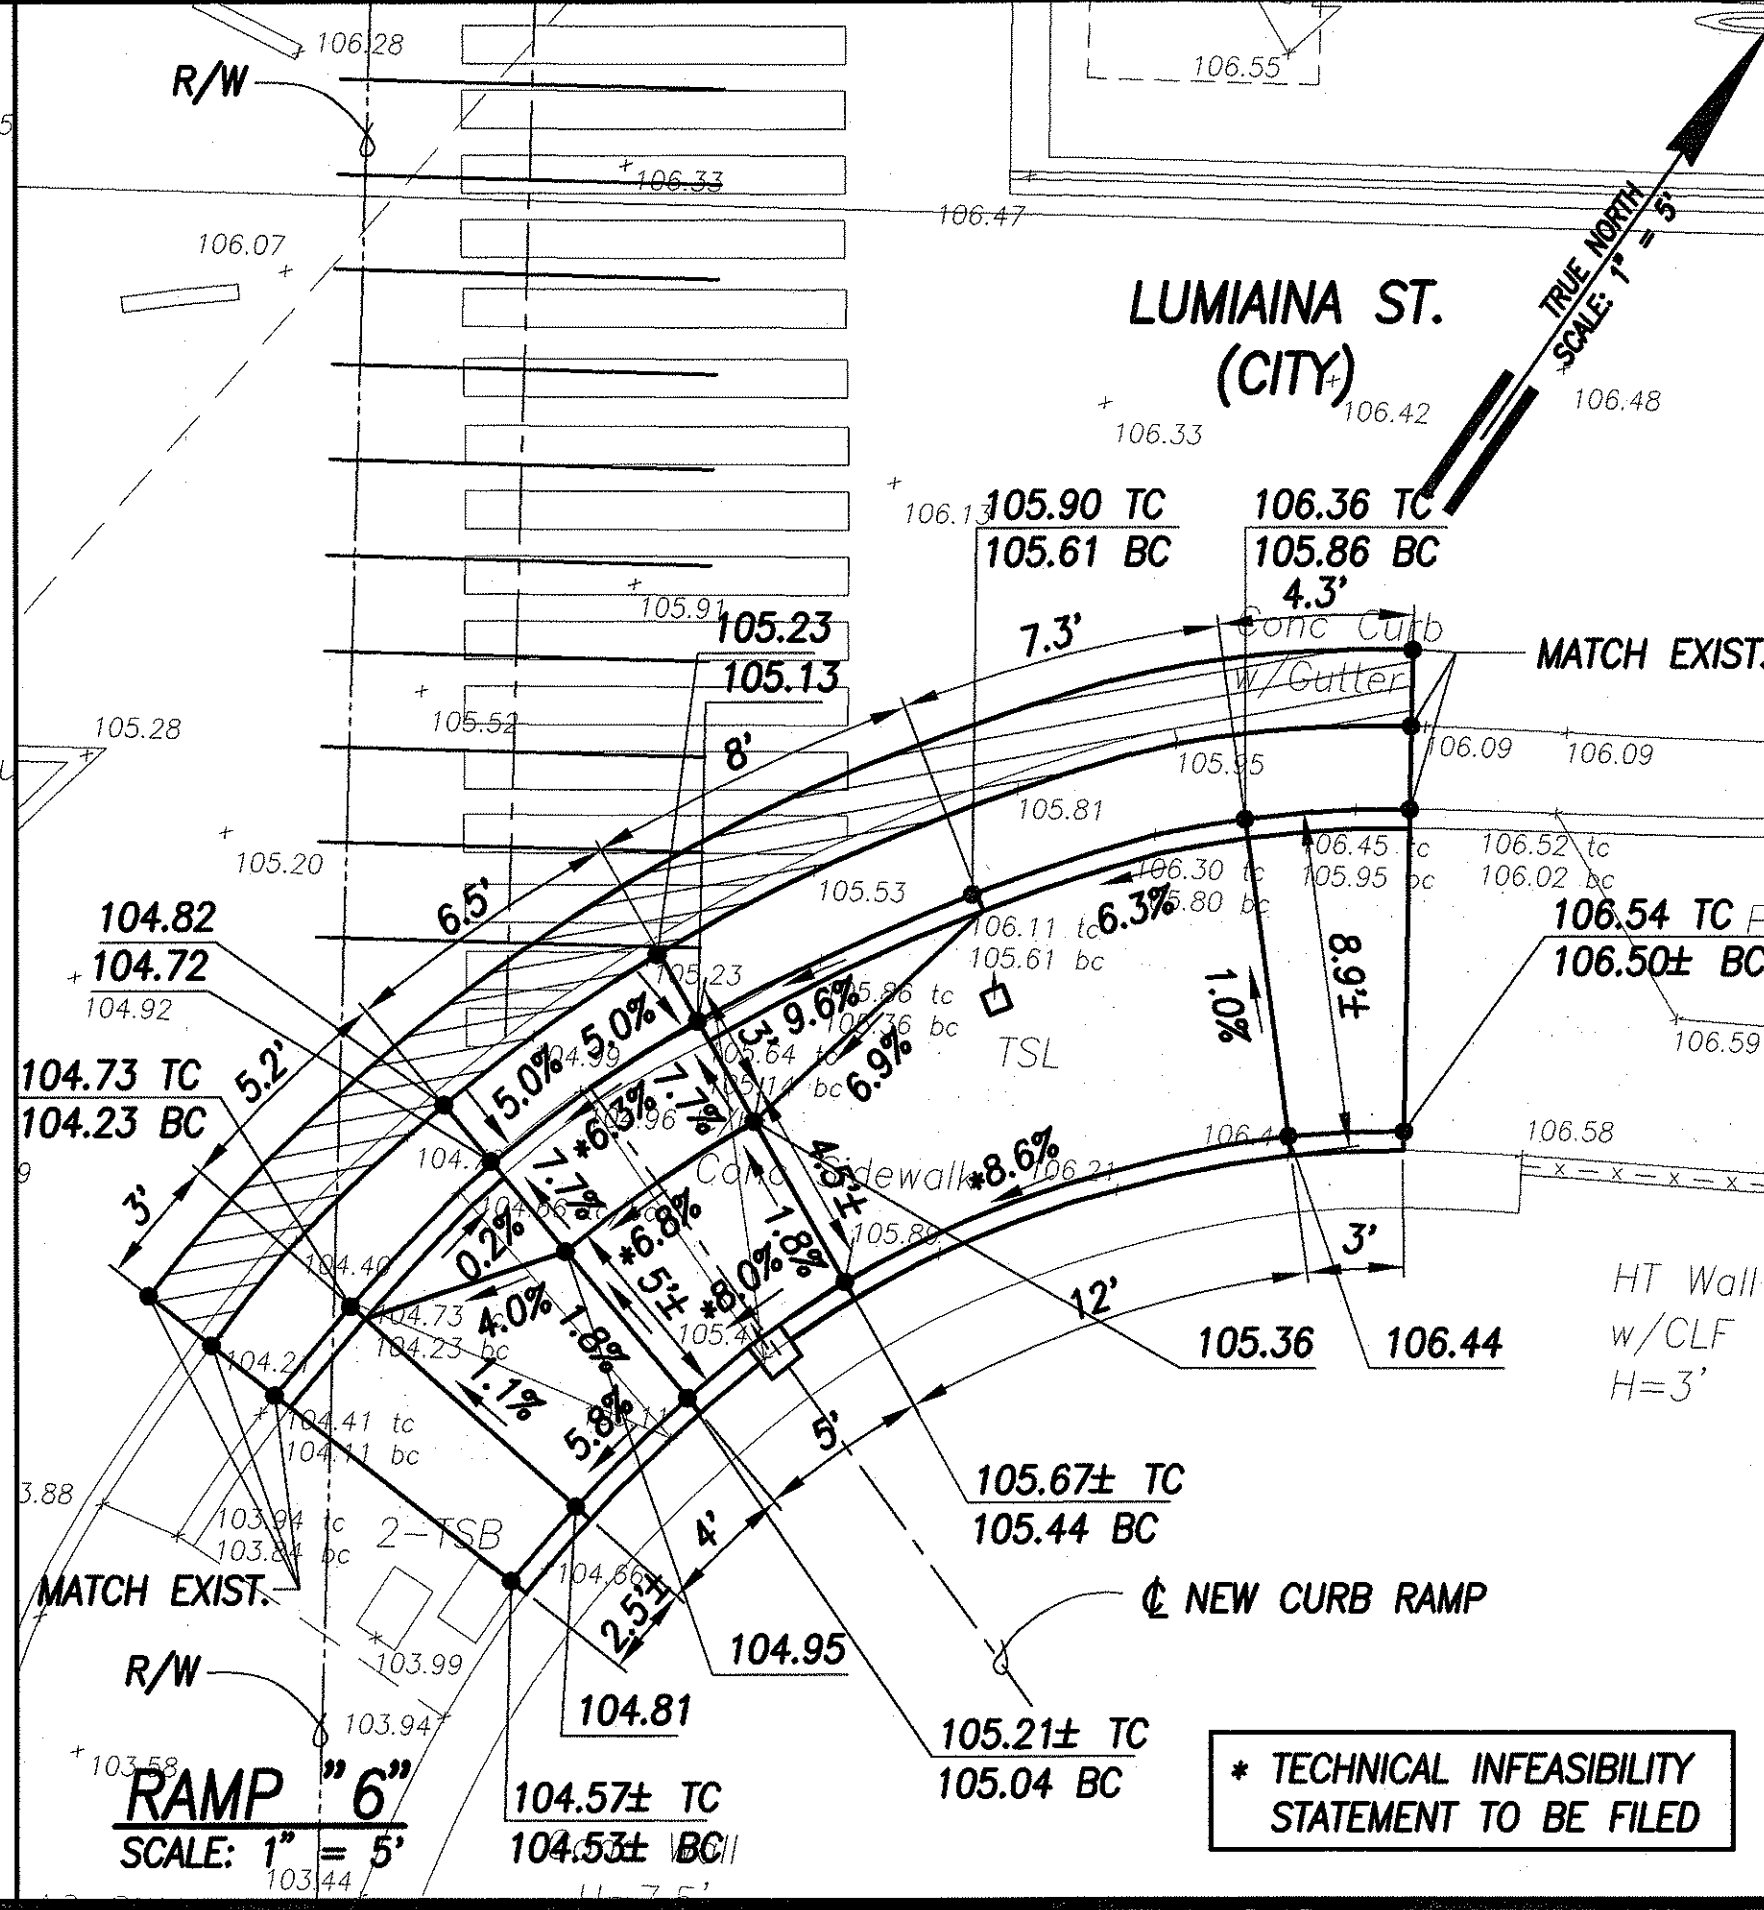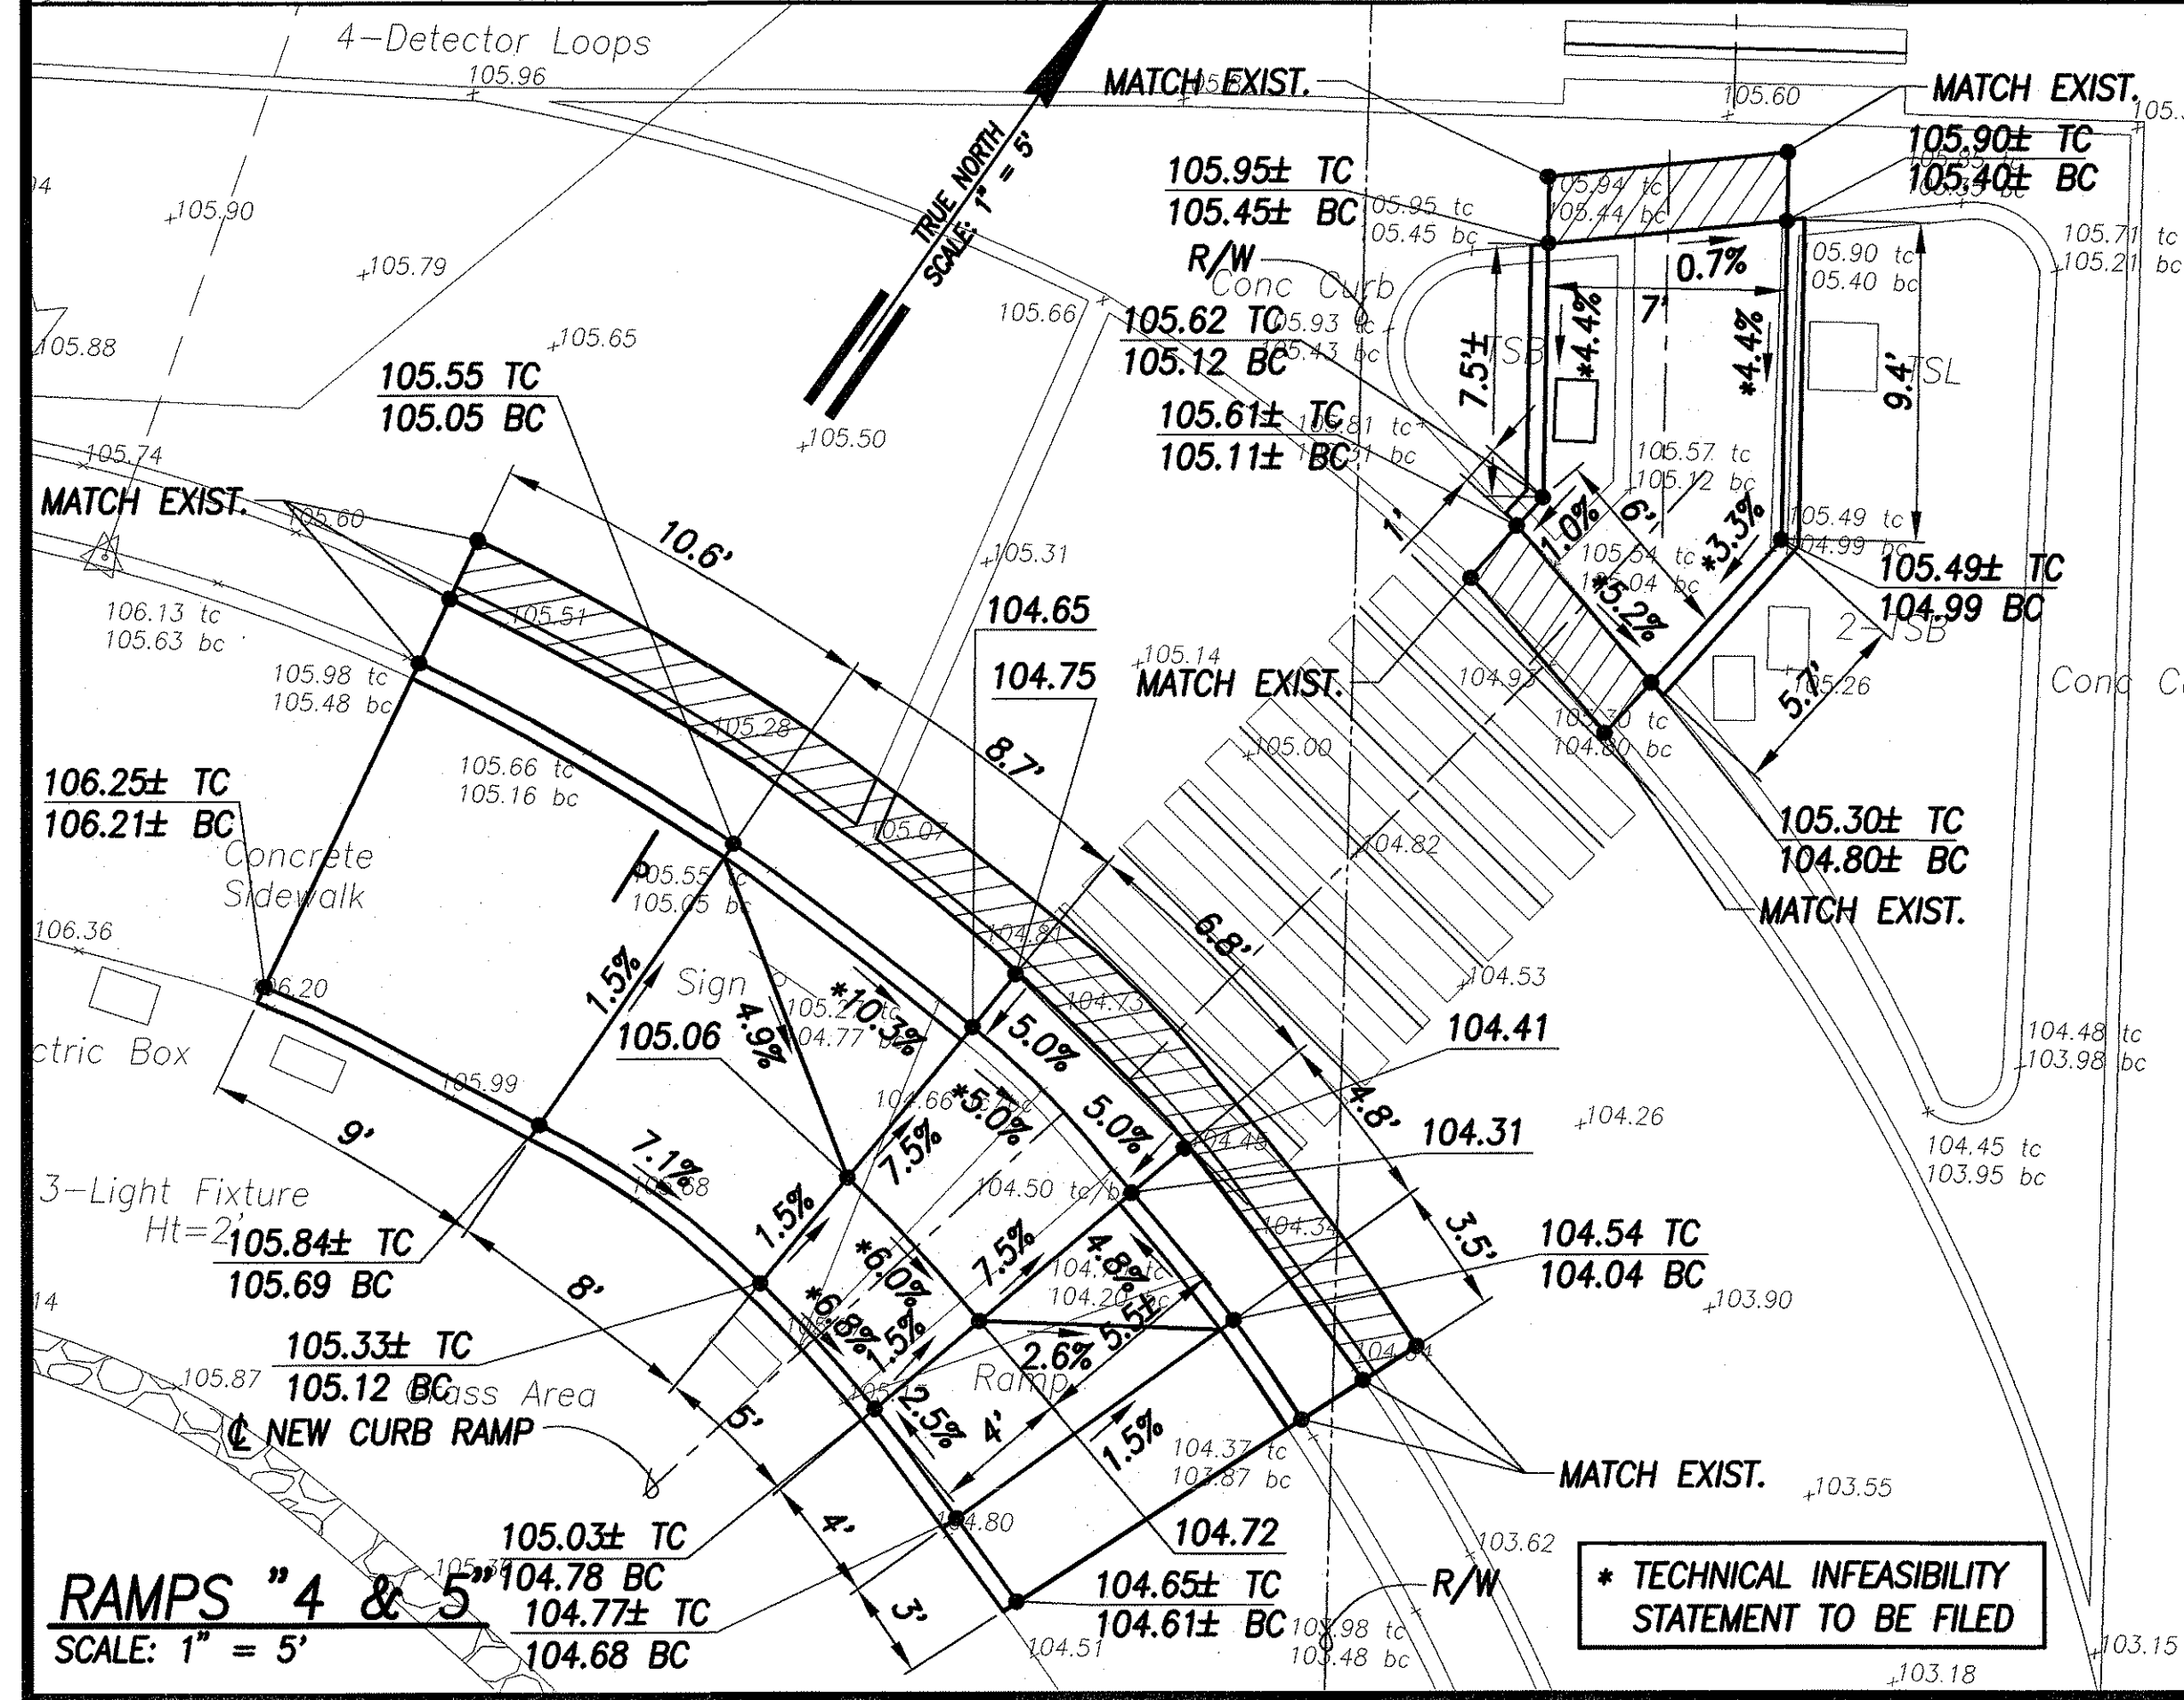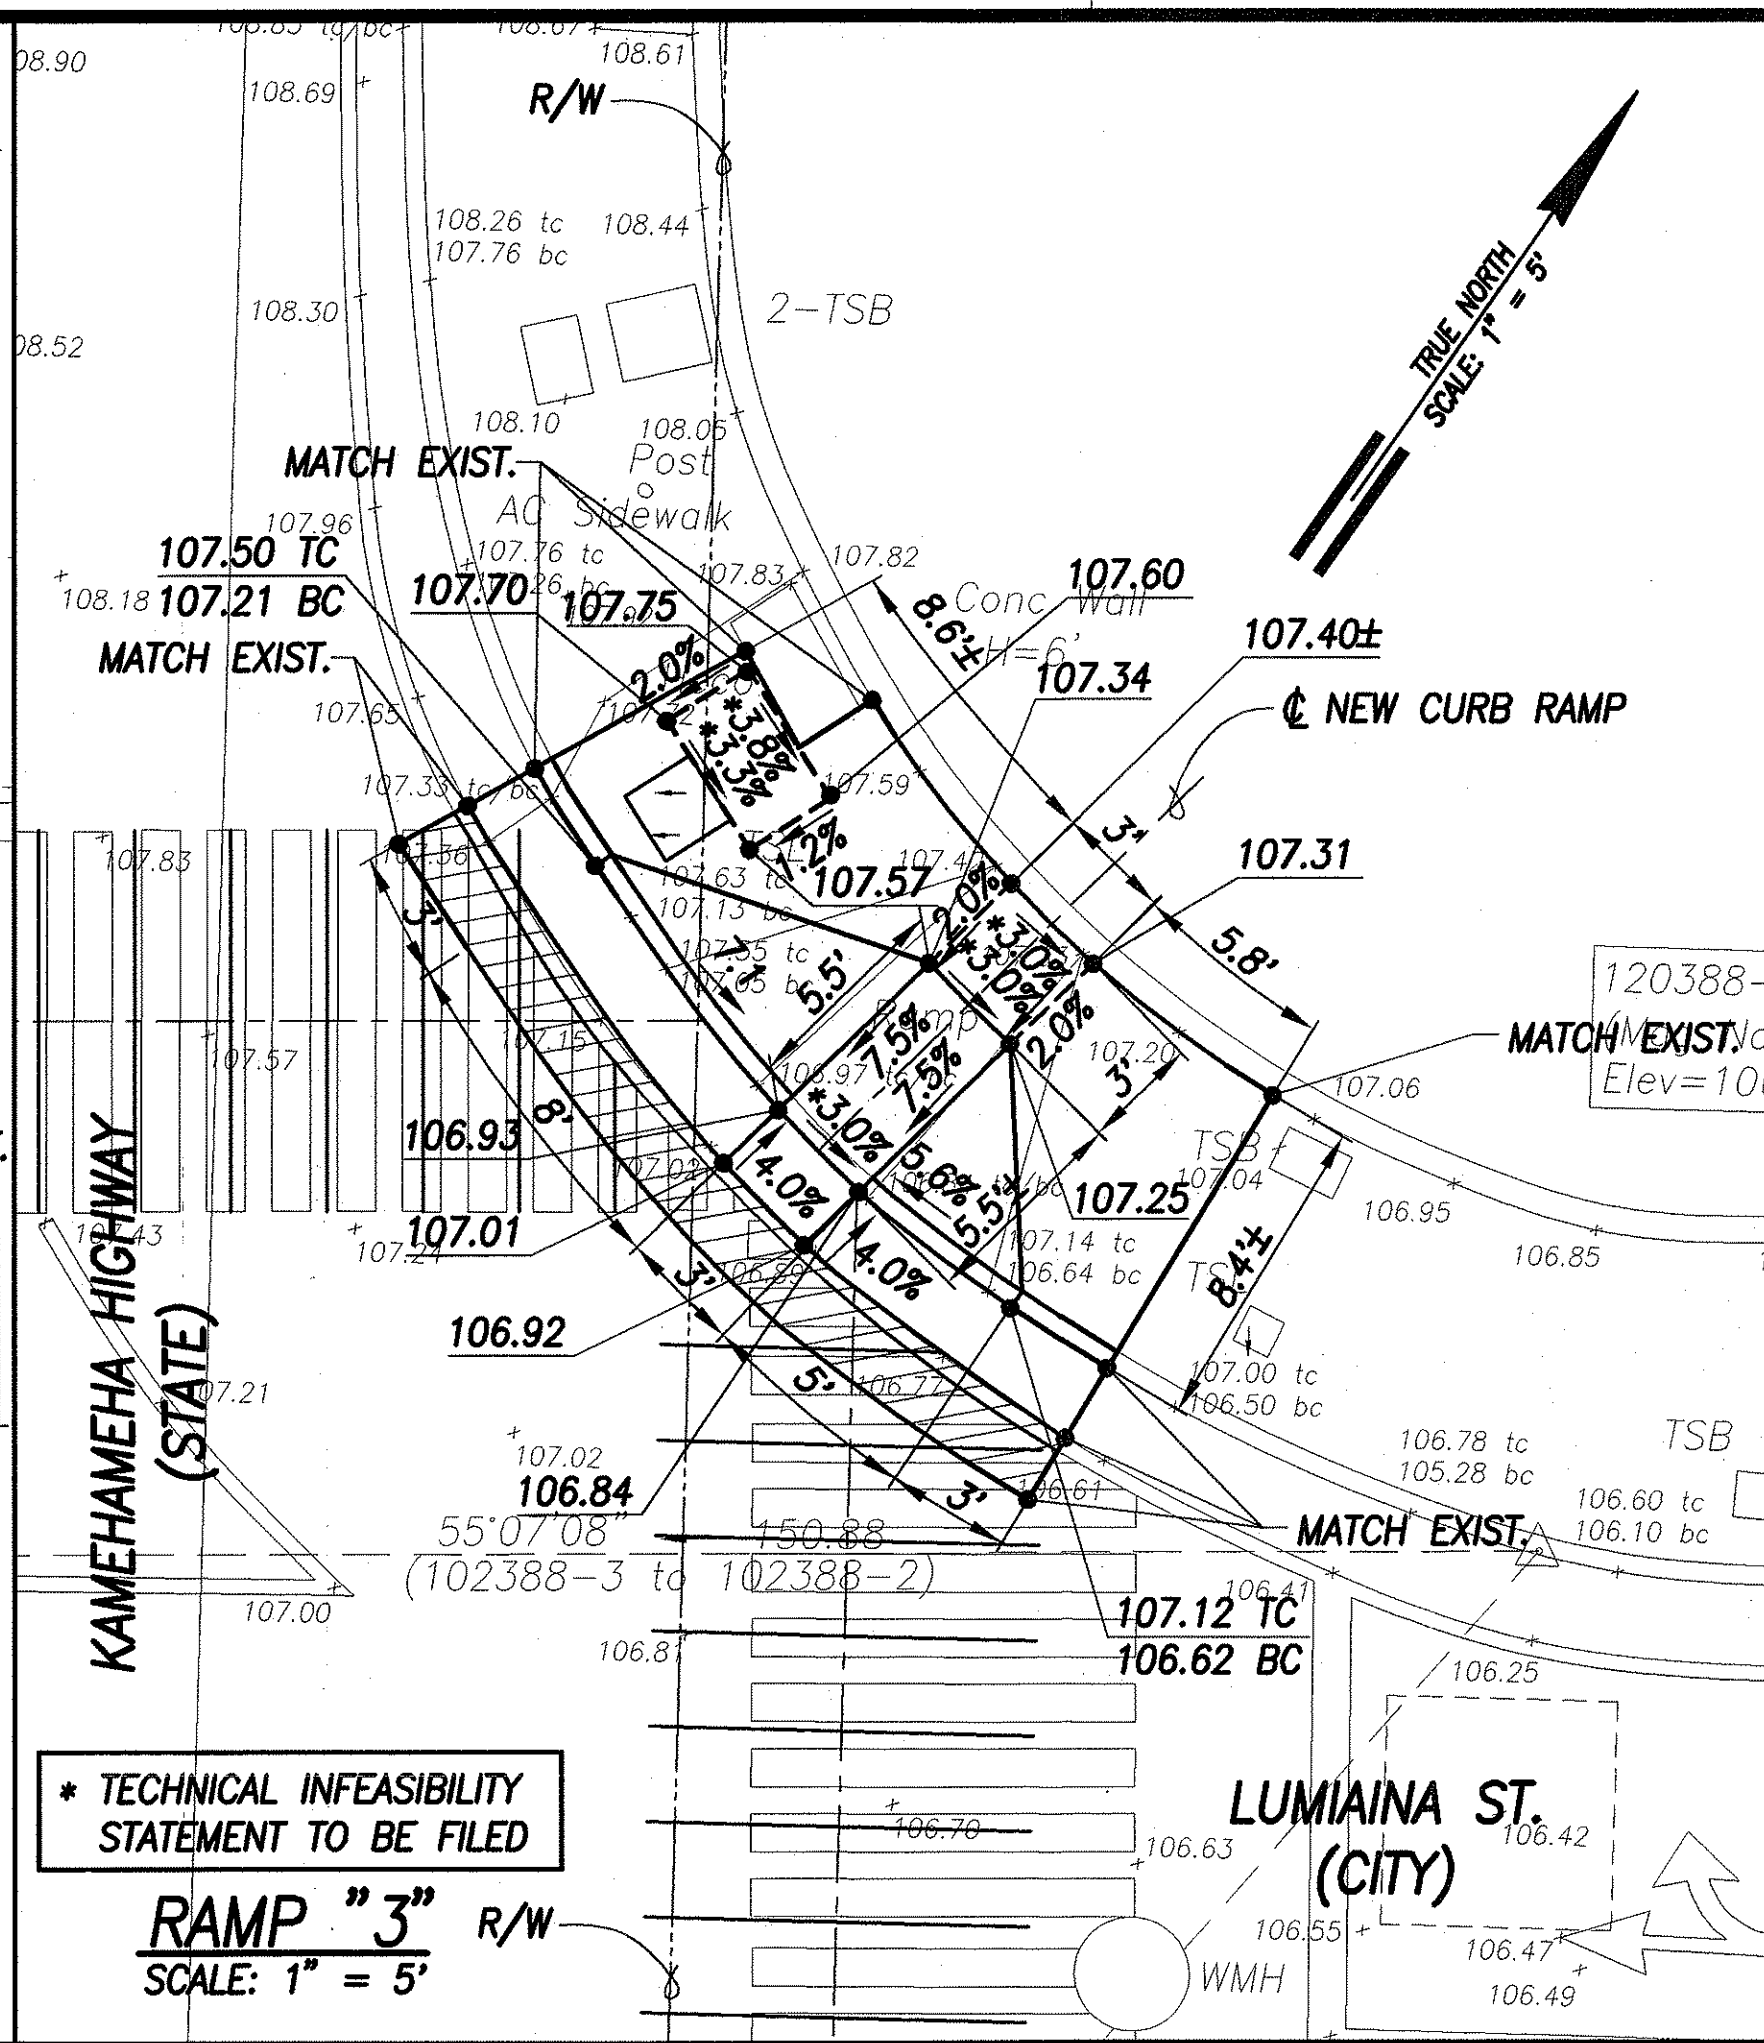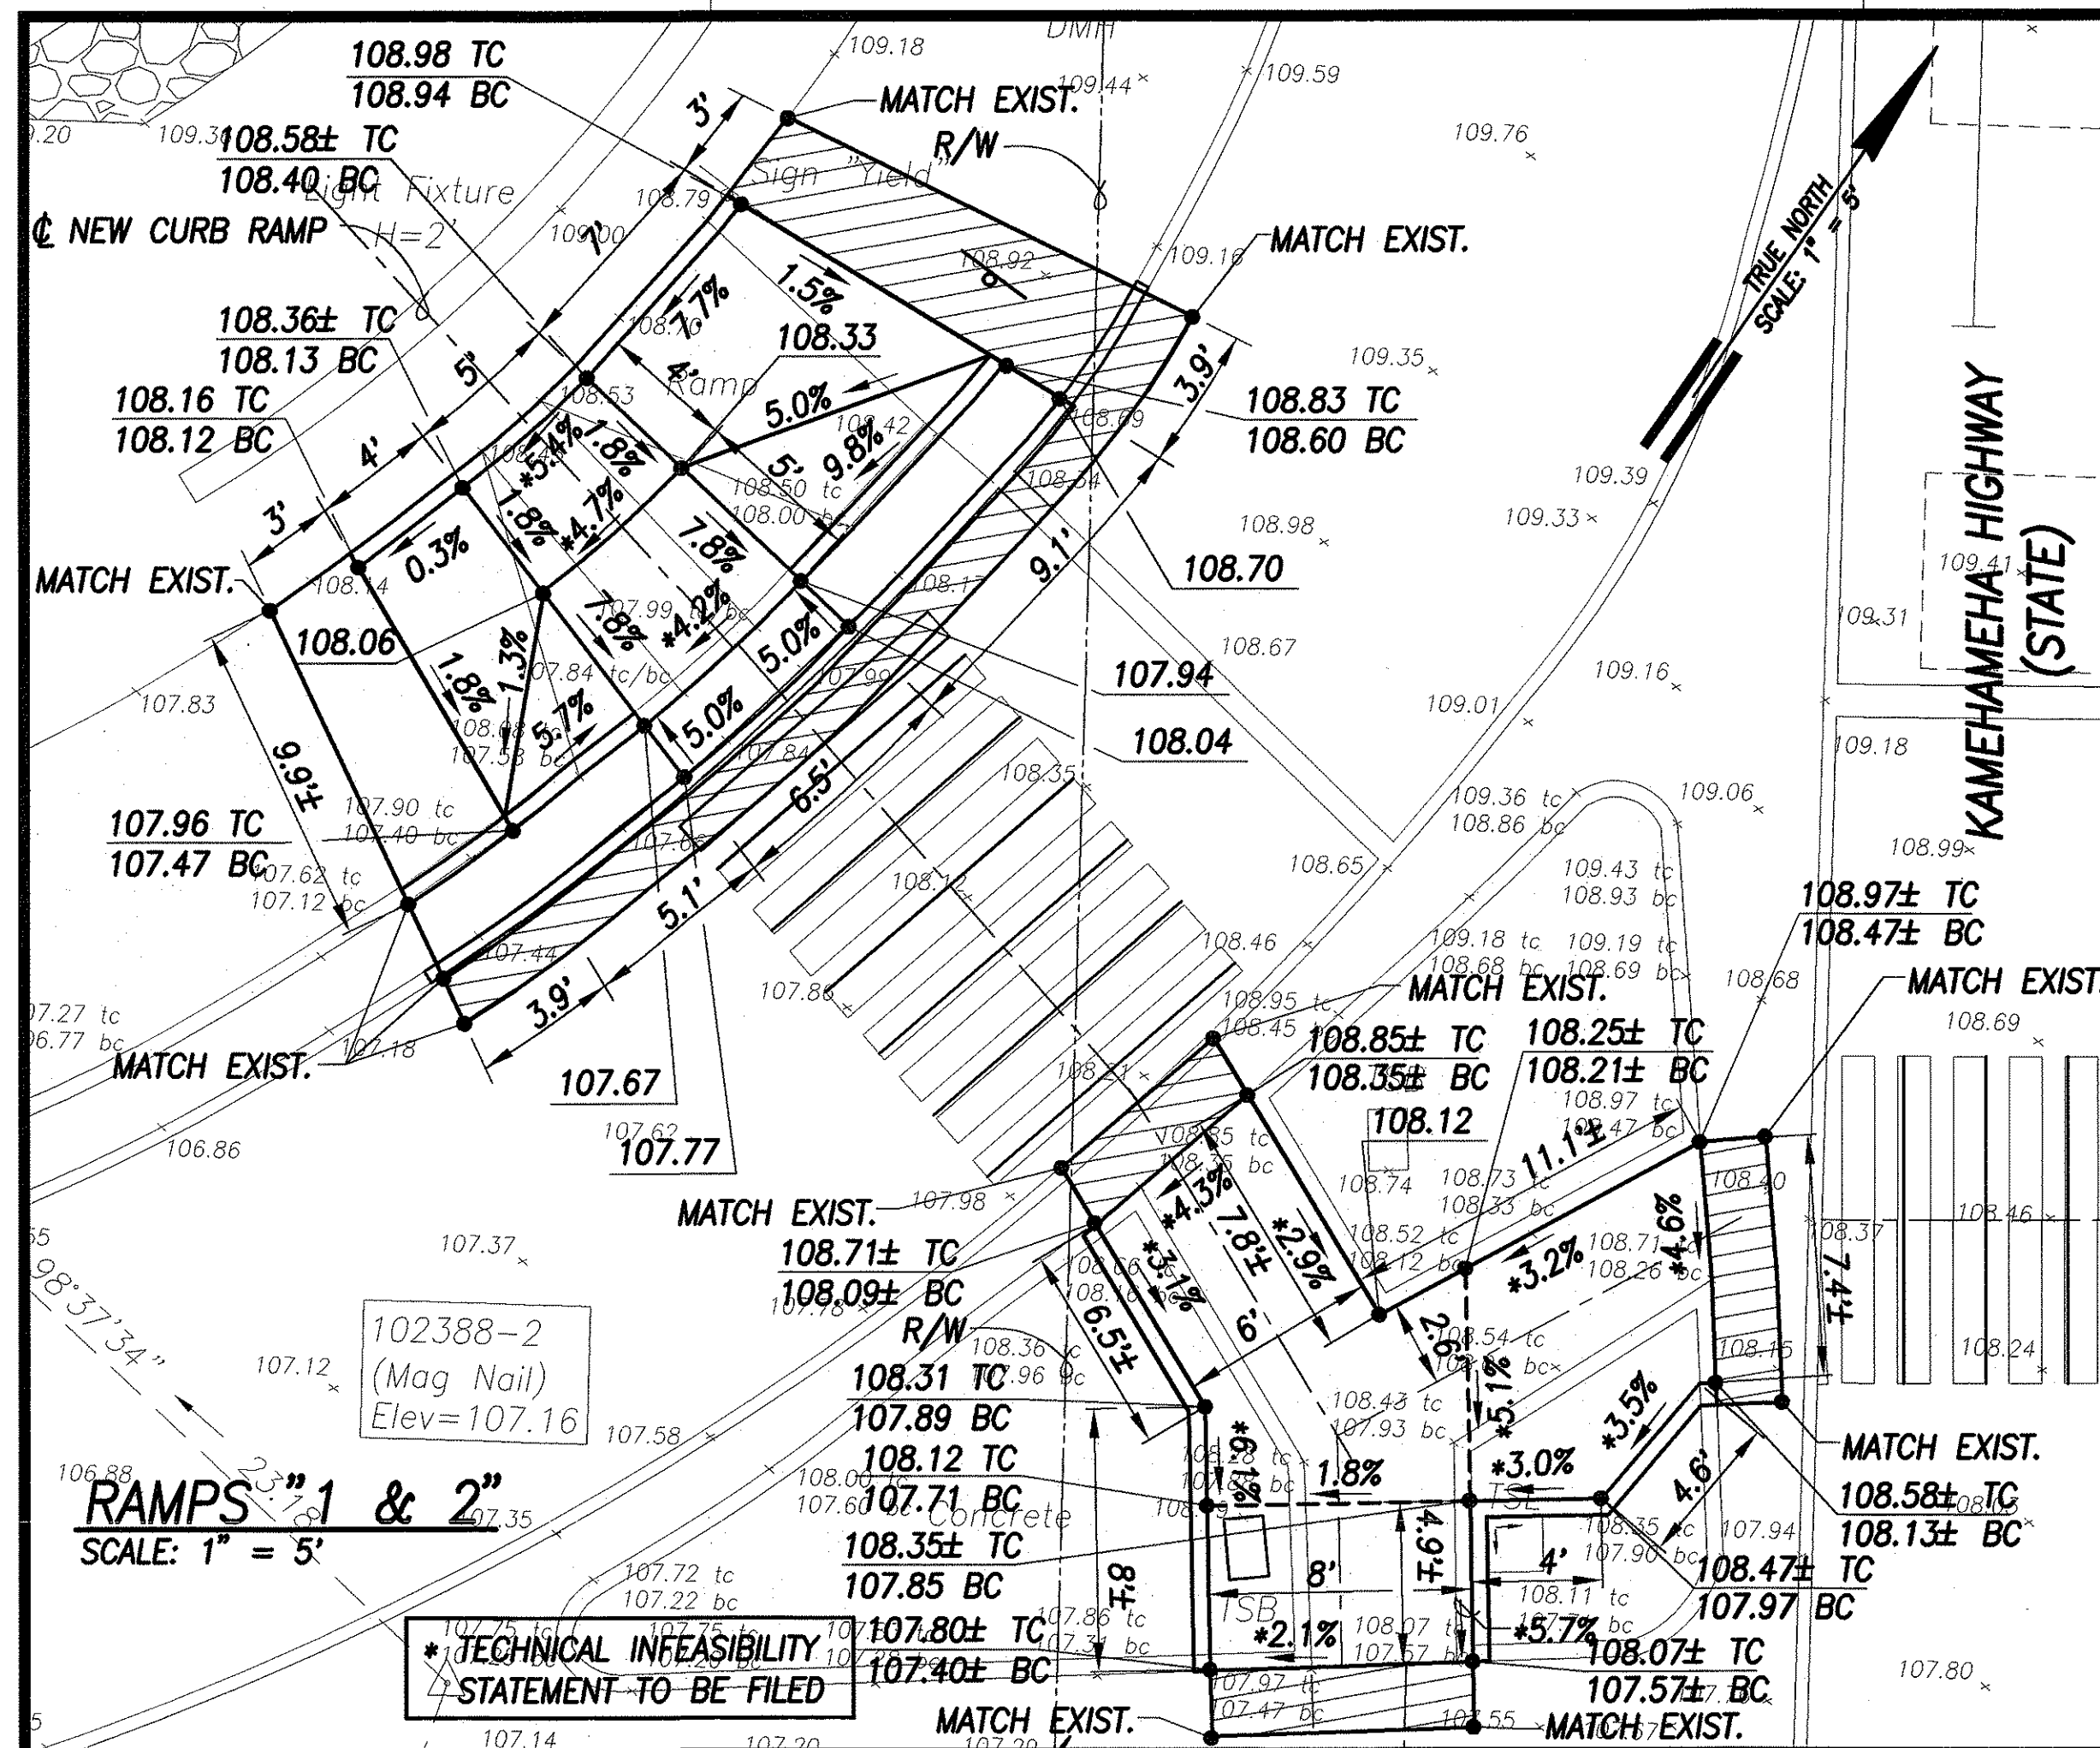

- LEGEND**
- × 49.52 EXIST. SPOT ELEVATION
 - 52.58 FINISHED SPOT GRADE
 - 51.50 TC FINISHED TOP OF CURB
 - 51.00 BC FINISHED BOTTOM OF CURB

GRADING PLAN - KAMEHAMEHA HIGHWAY & LUMIAINA ST. INTERS. ID NO. 102388
SCALE: 1" = 5'

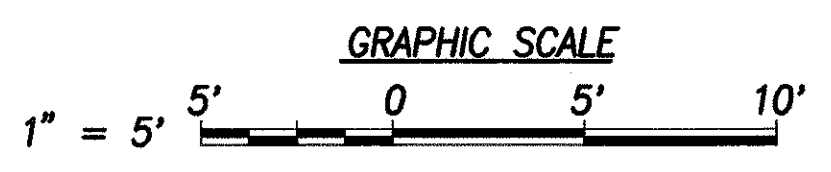

DATE	_____
SURVEY PLANNED BY	_____
DRAWN BY	_____
DESIGNED BY	_____
QUANTITIES BY	_____
CHECKED BY	_____
ORIGINAL PLAN	_____
NOTE BOOK	_____
No.	_____

THIS WORK WAS PREPARED BY ME OR UNDER MY SUPERVISION AND CONSTRUCTION OF THIS PROJECT WILL BE UNDER MY OBSERVATION.

SIGNATURE: *[Signature]* DATE: 4/30/06
DATE: CV

"OBSERVATION OF CONSTRUCTION" IS DEFINED IN CHAPTER 16-115, HAWAII ADMINISTRATIVE RULES ENTITLED "PROFESSIONAL ENGINEERS, ARCHITECTS, SURVEYORS AND LANDSCAPE ARCHITECTS".

STATE OF HAWAII
DEPARTMENT OF TRANSPORTATION
HIGHWAYS DIVISION

GRADING PLAN - KAMEHAMEHA HWY & LUMIAINA ST.




Pedestrian Facilities & ADA Compliance at Various Locations on Oahu, Unit 5

Fed. Aid Proj. No. CMAQ-0300(96)

Scale: 1" = 5'-0" Date: August 2004

SHEET No. C-76 OF 153 SHEETS

FED. ROAD DIST. NO.	STATE	FED. AID PROJ. NO.	FISCAL YEAR	SHEET NO.	TOTAL SHEETS
HAWAII	HAW.	CMAQ-0300(98)	2004	C.O. 81	153

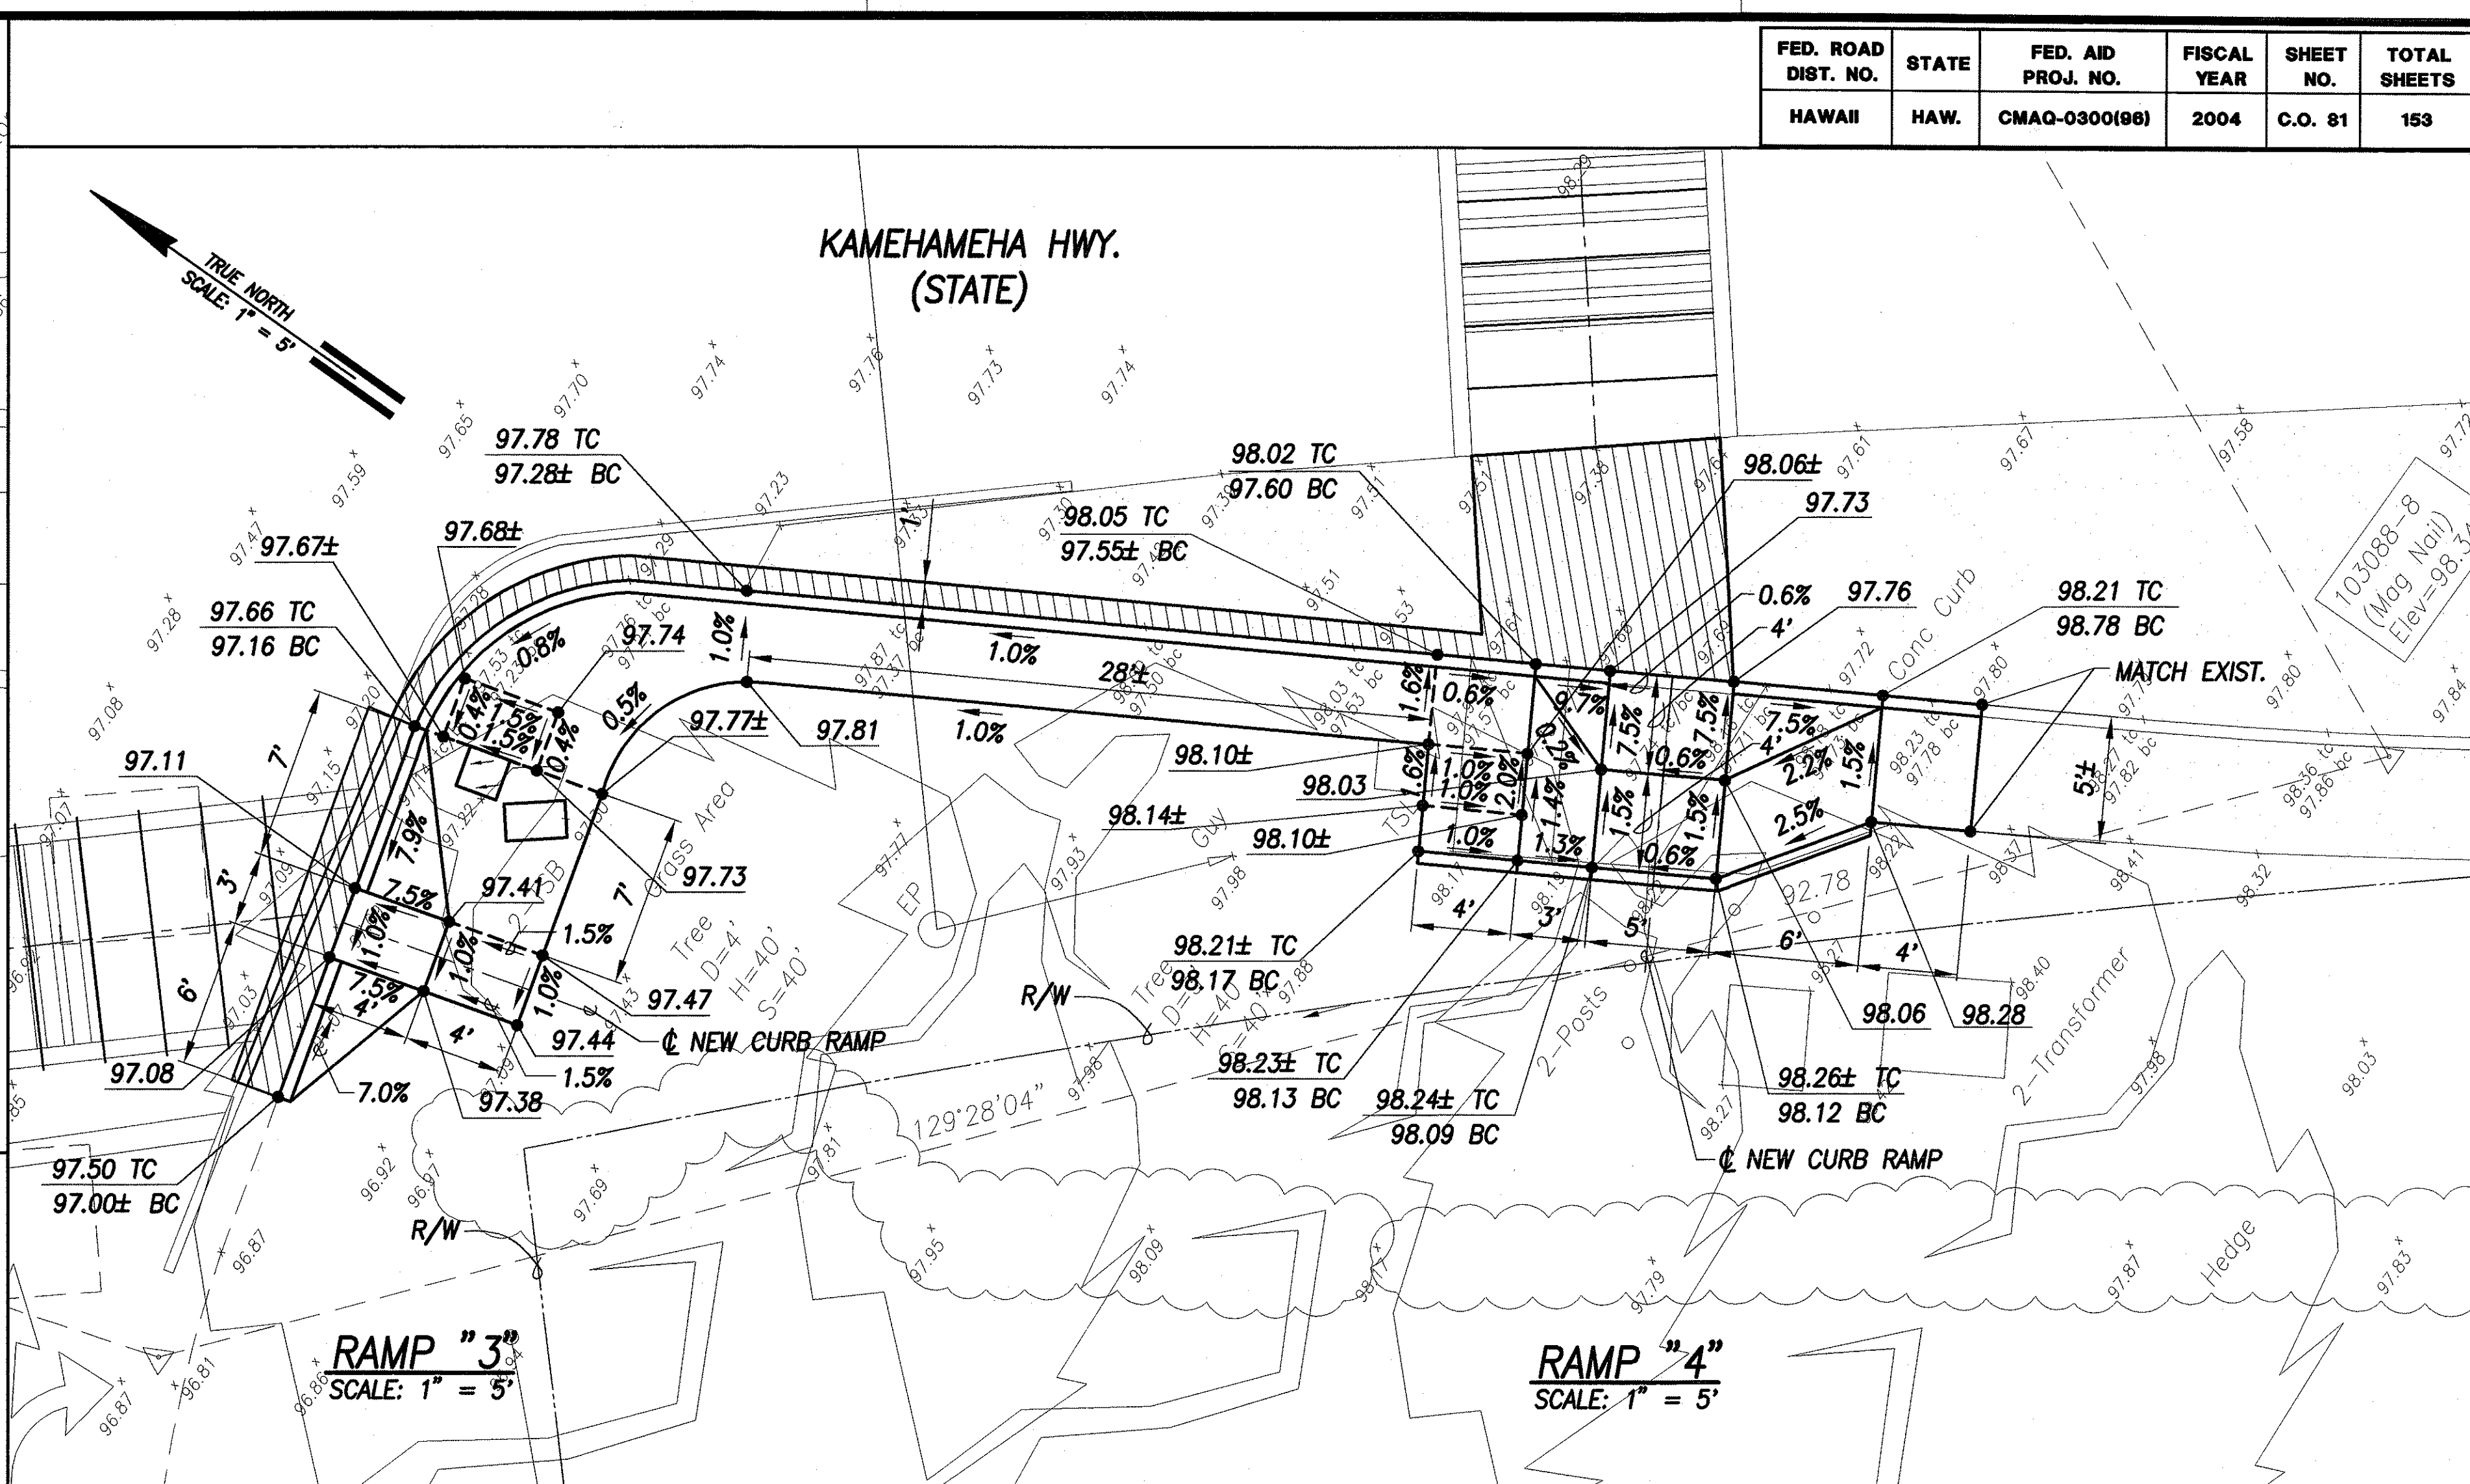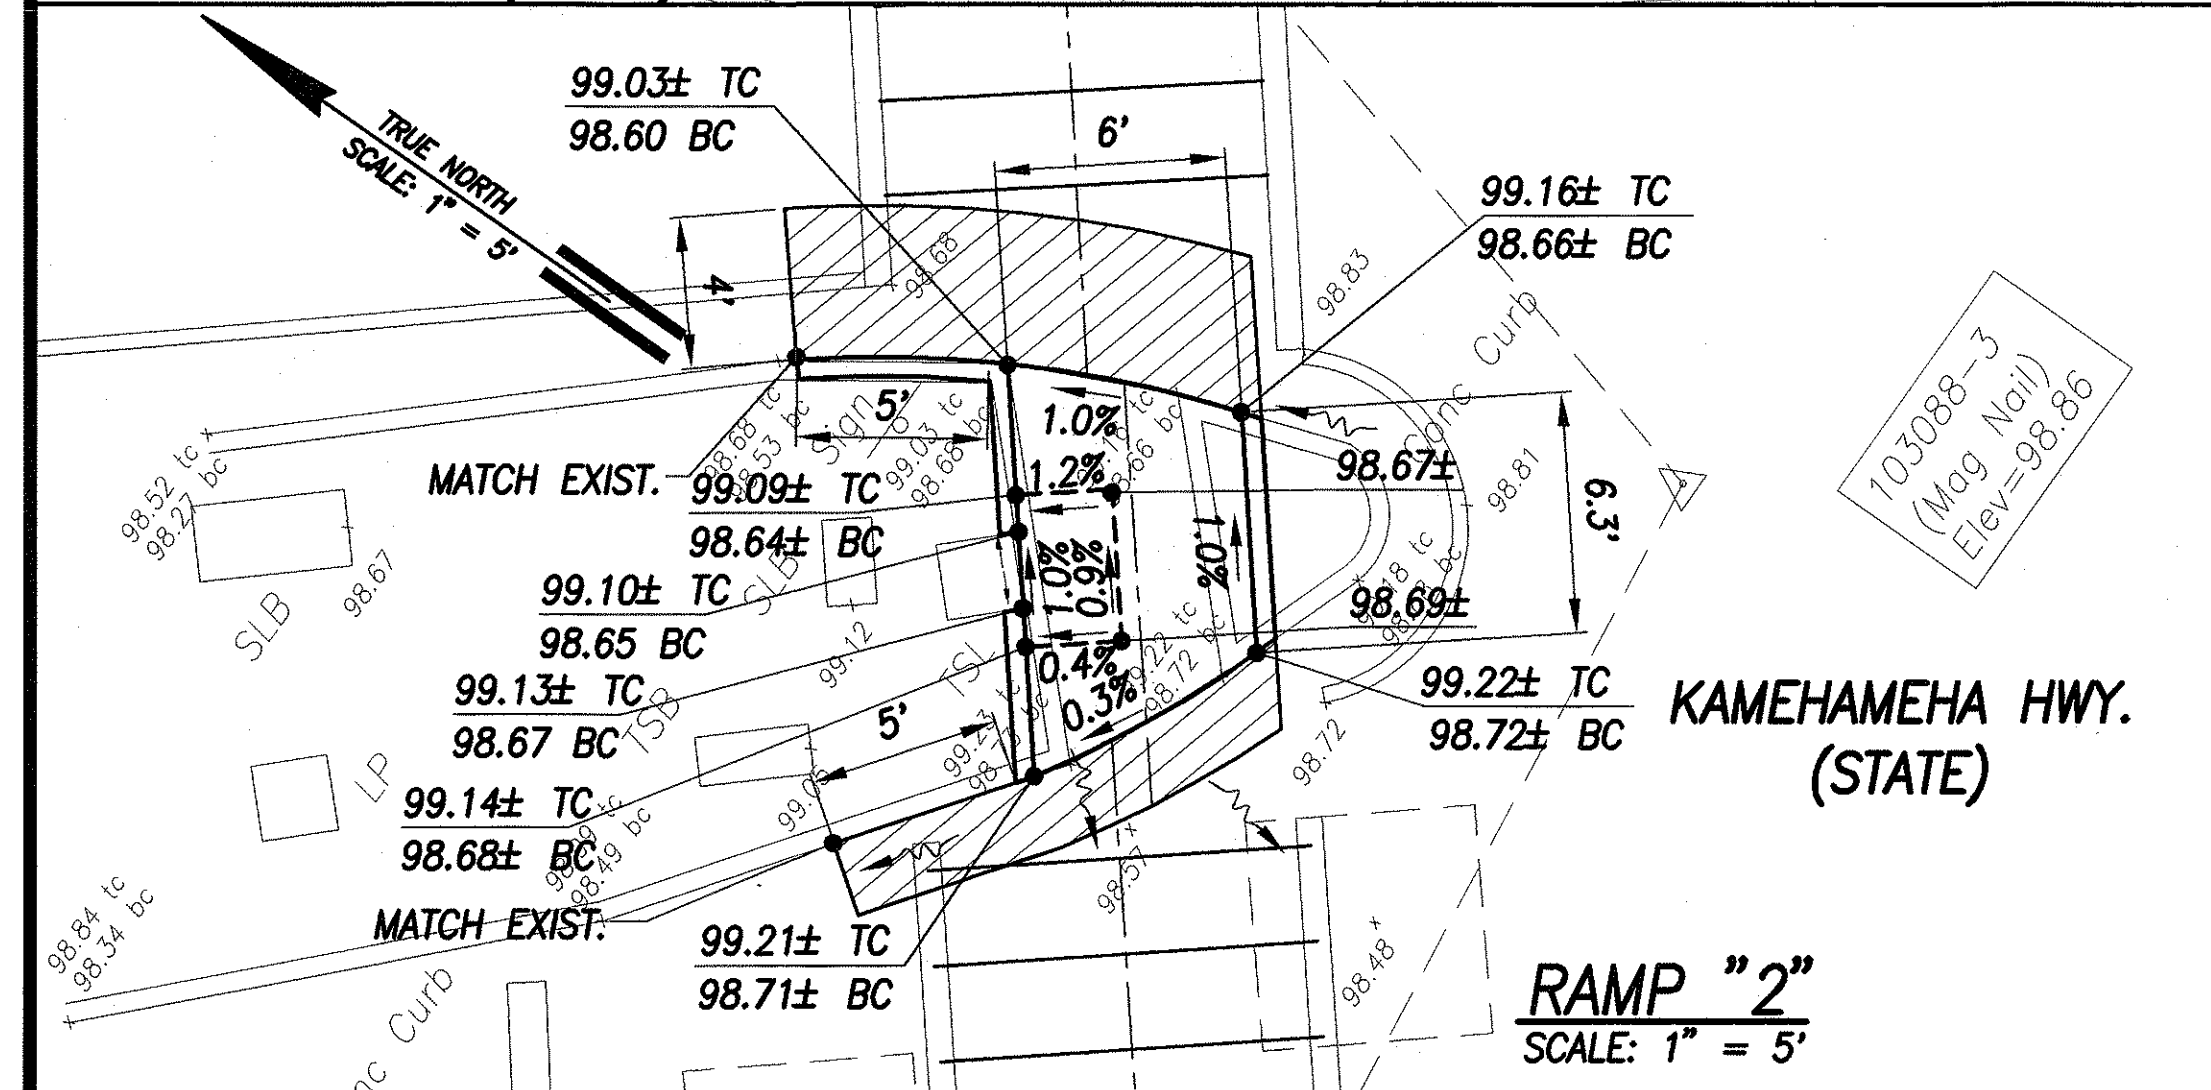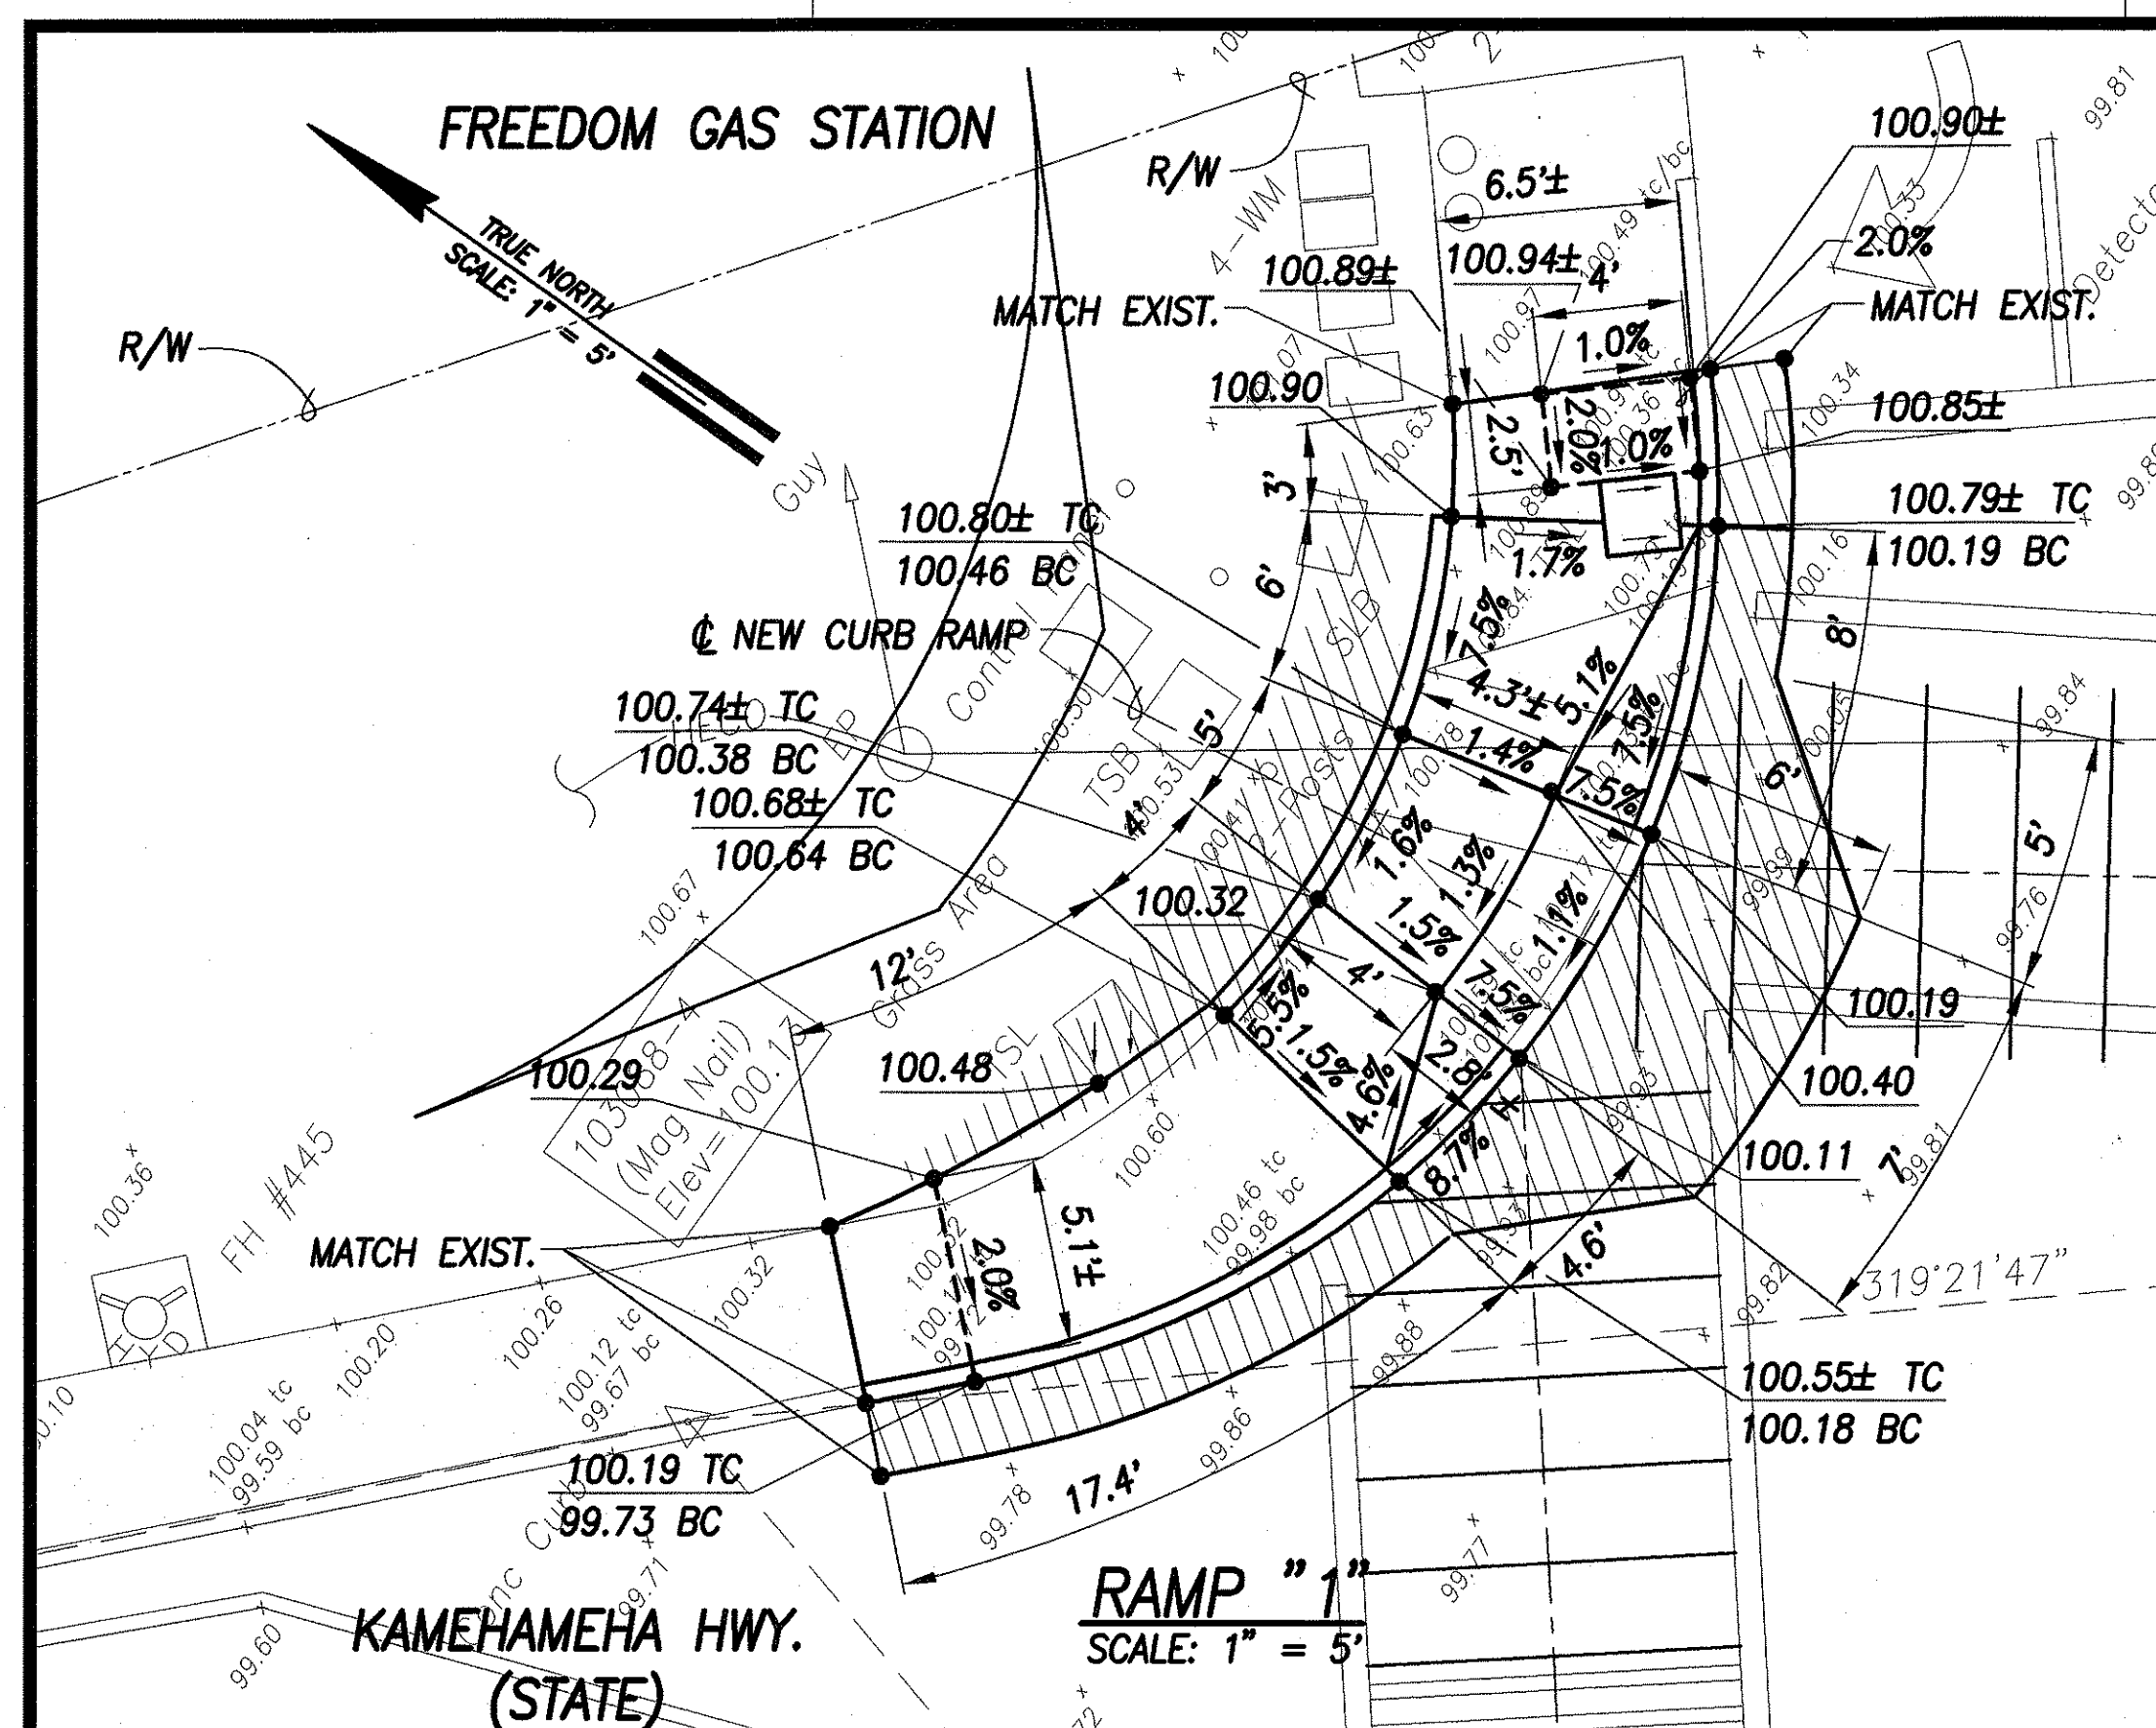


LEGEND

× 49.52	EXIST. SPOT ELEVATION
52.58	FINISHED SPOT GRADE
51.50 TC	FINISHED TOP OF CURB
51.00 BC	FINISHED BOTTOM OF CURB

GRADING PLAN – KAMEHAMEHA HWY. & KIPAPA ST.
INTERS. ID NO. 99-103088
 SCALE: 1" = 5'


DATE	_____
SURVEY PLOTTED BY	_____
DRAWN BY	_____
DESIGNED BY	_____
QUANTITIES BY	_____
CHECKED BY	_____
ORIGINAL PLAN	_____
NOTE BOOK	_____
No.	_____

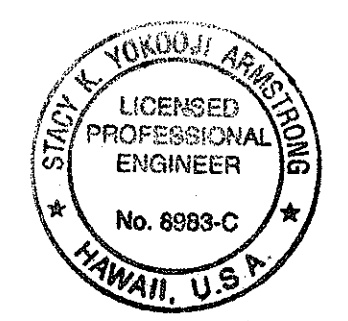

THIS WORK WAS PREPARED BY ME OR UNDER MY SUPERVISION AND CONSTRUCTION OF THIS PROJECT WILL BE UNDER MY OBSERVATION.

Signature DATE: 8/20/04

"OBSERVATION OF CONSTRUCTION" IS DEFINED IN CHAPTER 16-115, HAWAII ADMINISTRATIVE RULES ENTITLED "PROFESSIONAL ENGINEERS, ARCHITECTS, SURVEYORS AND LANDSCAPE ARCHITECTS".

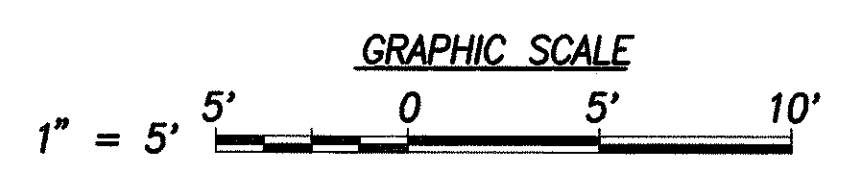


STATE OF HAWAII
 DEPARTMENT OF TRANSPORTATION
 HIGHWAYS DIVISION
GRADING PLAN
KAMEHAMEHA HWY. & KIPAPA ST.

Pedestrian Facilities & ADA Compliance
at Various Locations on Oahu, Unit 5
Fed. Aid Proj. No. CMAQ-0300(96)



Scale: 1" = 5'-0" Date: August 2004

SHEET No. C-80 OF 153 SHEETS

FED. ROAD DIST. NO.	STATE	FED. AID PROJ. NO.	FISCAL YEAR	SHEET NO.	TOTAL SHEETS
HAWAII	HAW.	CMAQ-0300(98)	2004	83	153

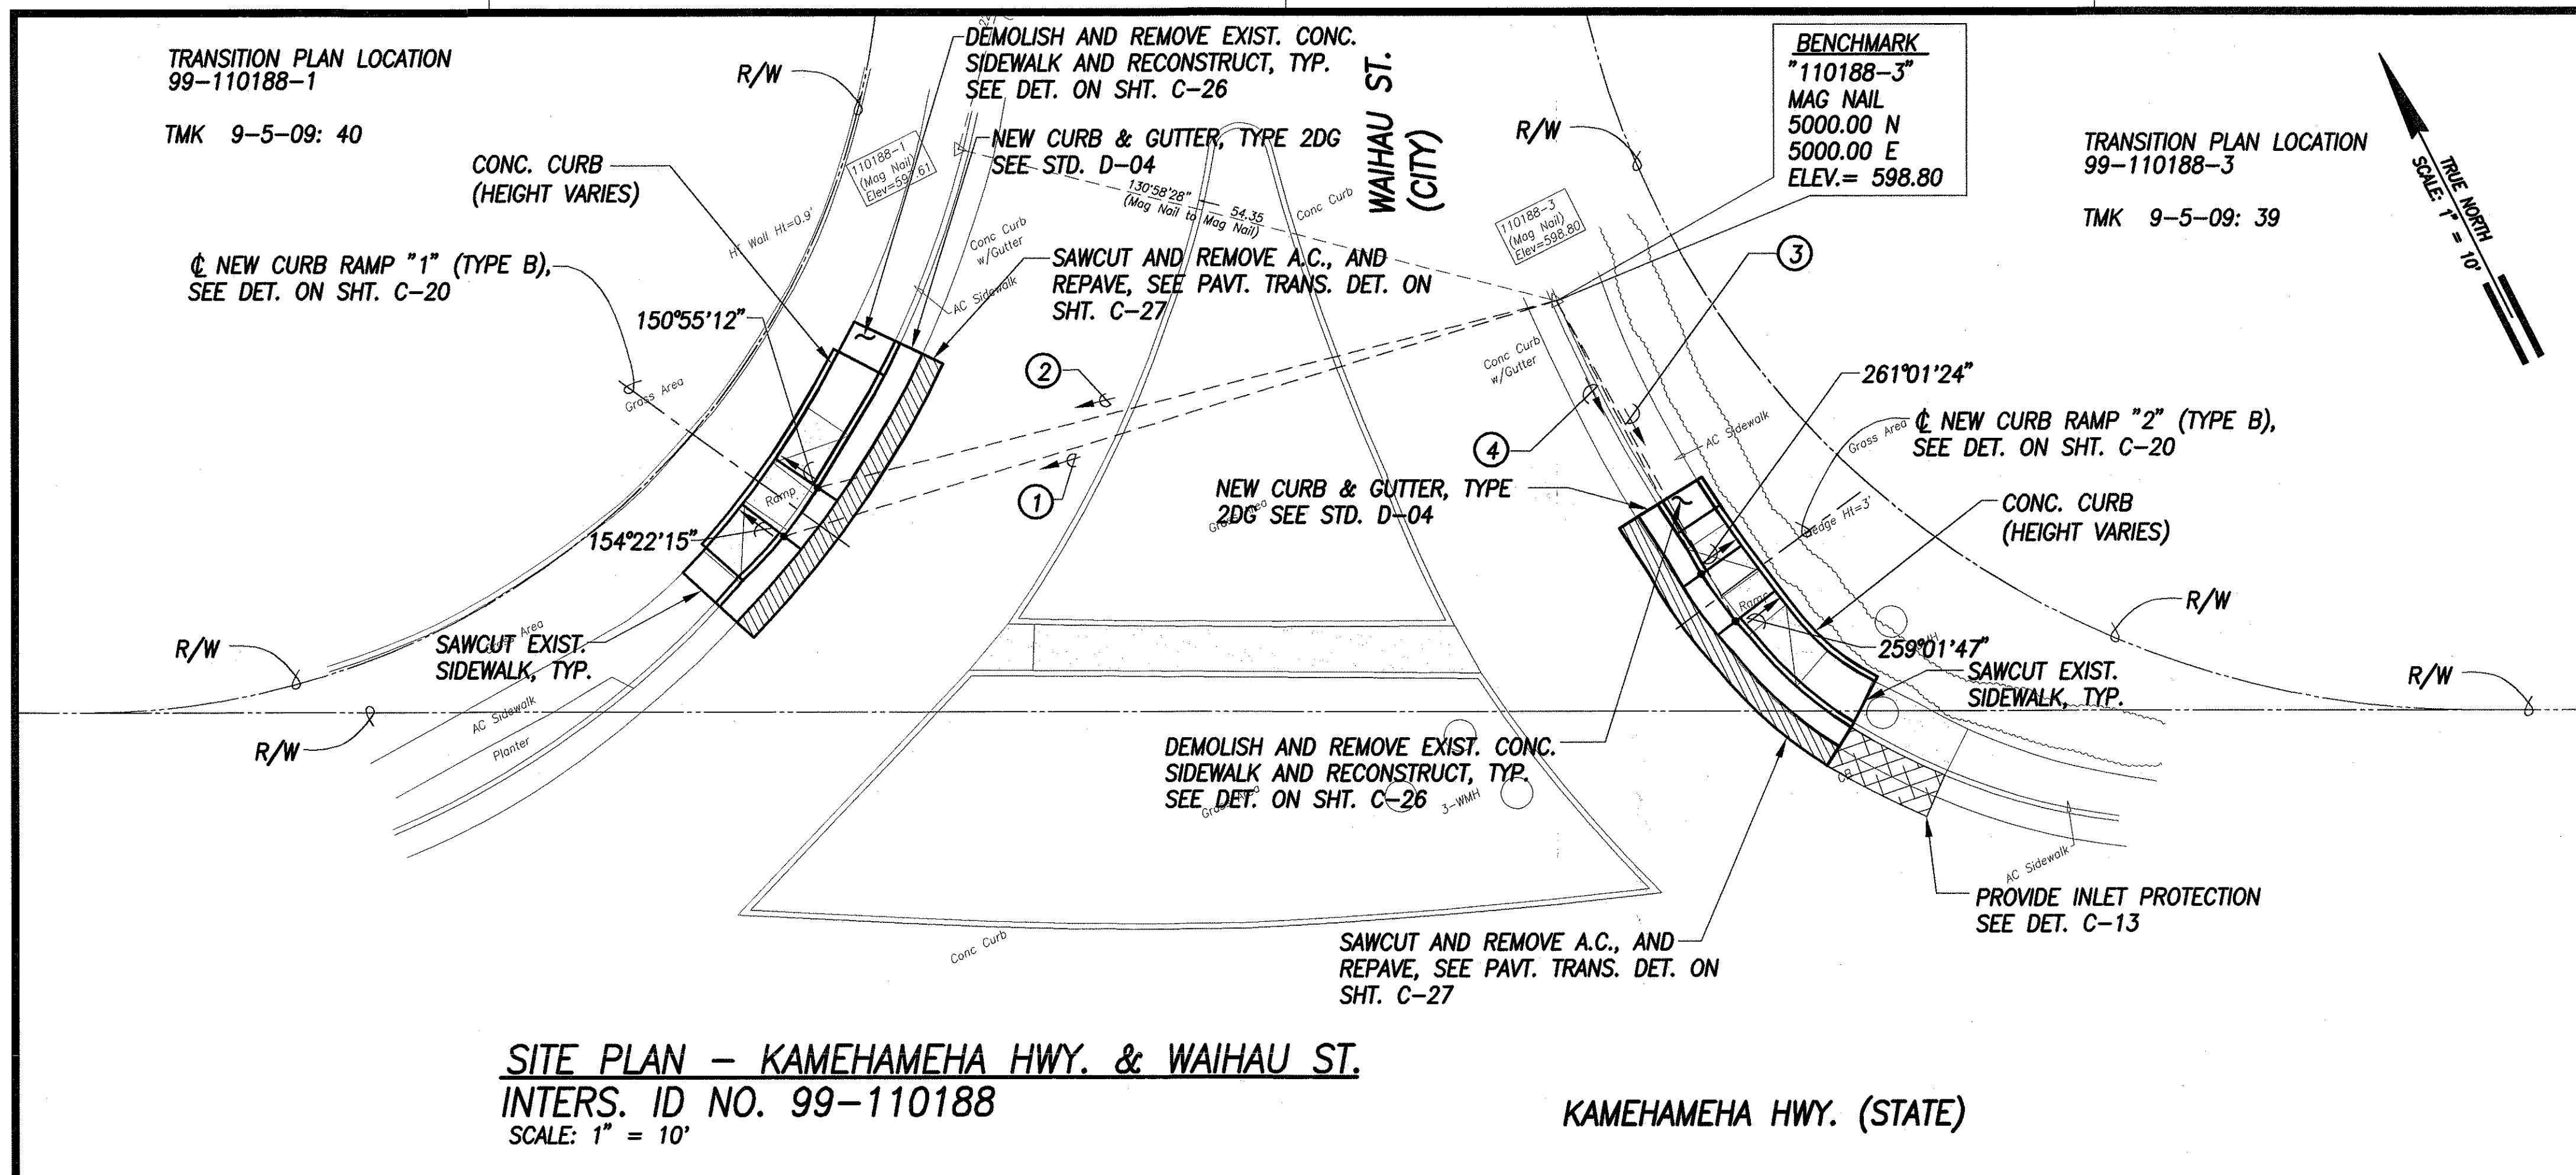

- ① 99°43'06" 71.17'
TIE: BM TO INTERSECTION OF RAMP
EDGE AND CURB FACE
- ② 102°30'17" 67.14'
TIE: BM TO INTERSECTION OF RAMP
EDGE AND CURB FACE
- ③ 357°39'11" 32.44'
TIE: BM TO INTERSECTION OF RAMP
EDGE AND CURB FACE
- ④ 358°54'47" 27.35'
TIE: BM TO INTERSECTION OF RAMP
EDGE AND CURB FACE

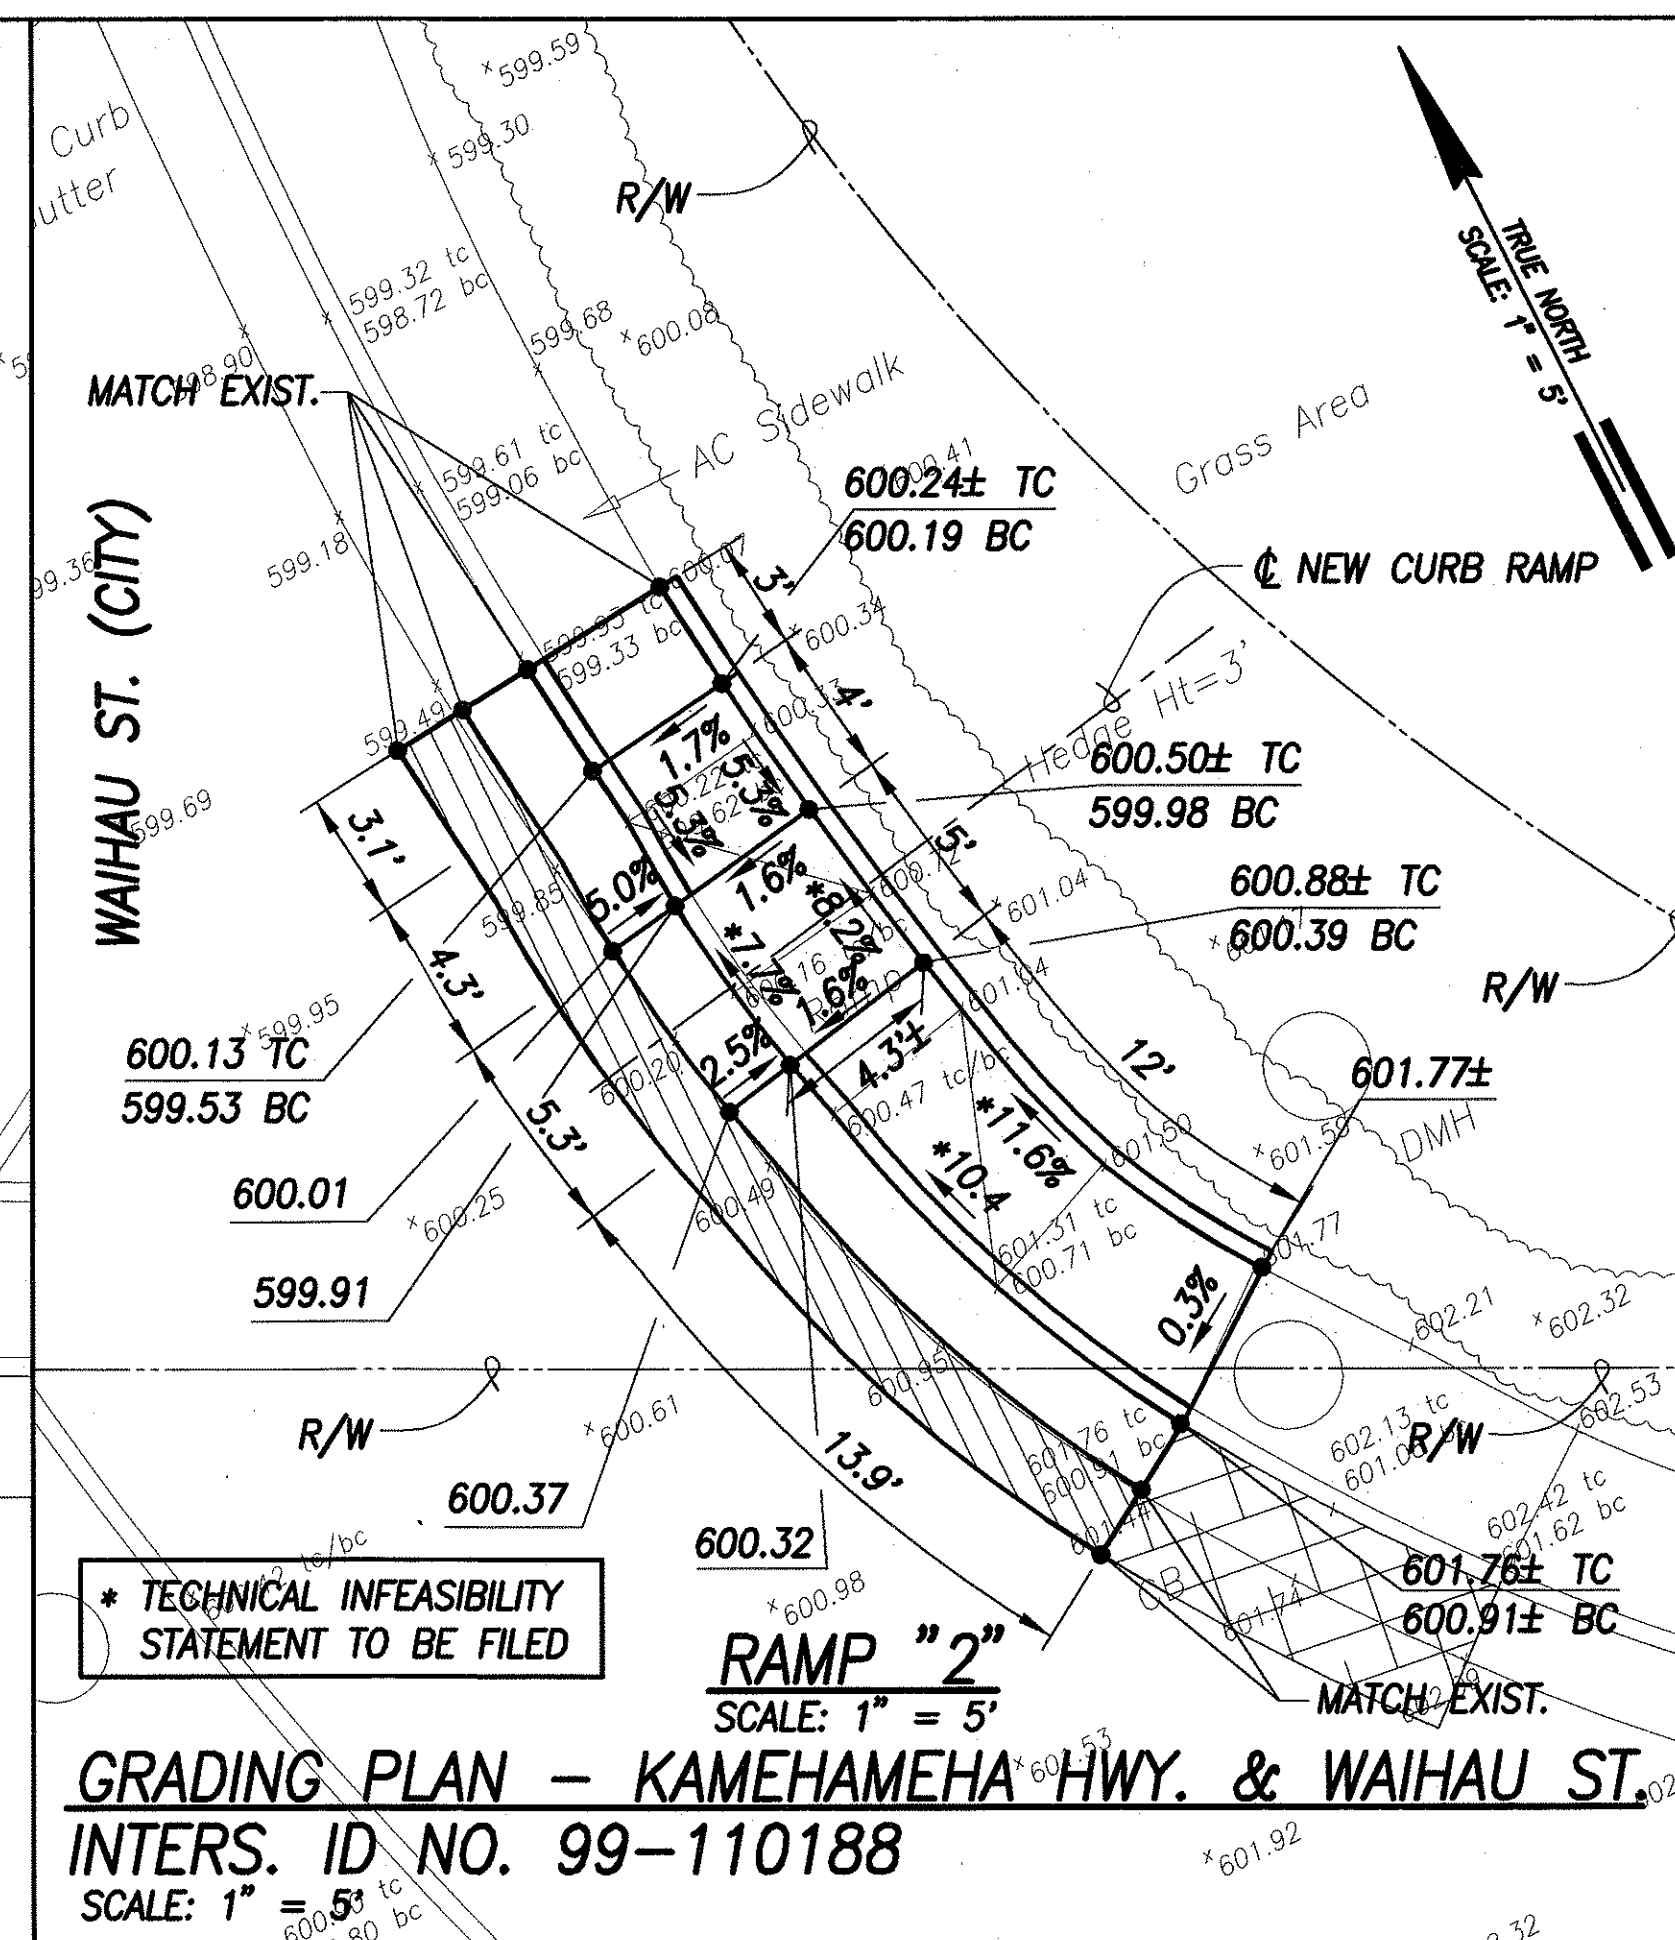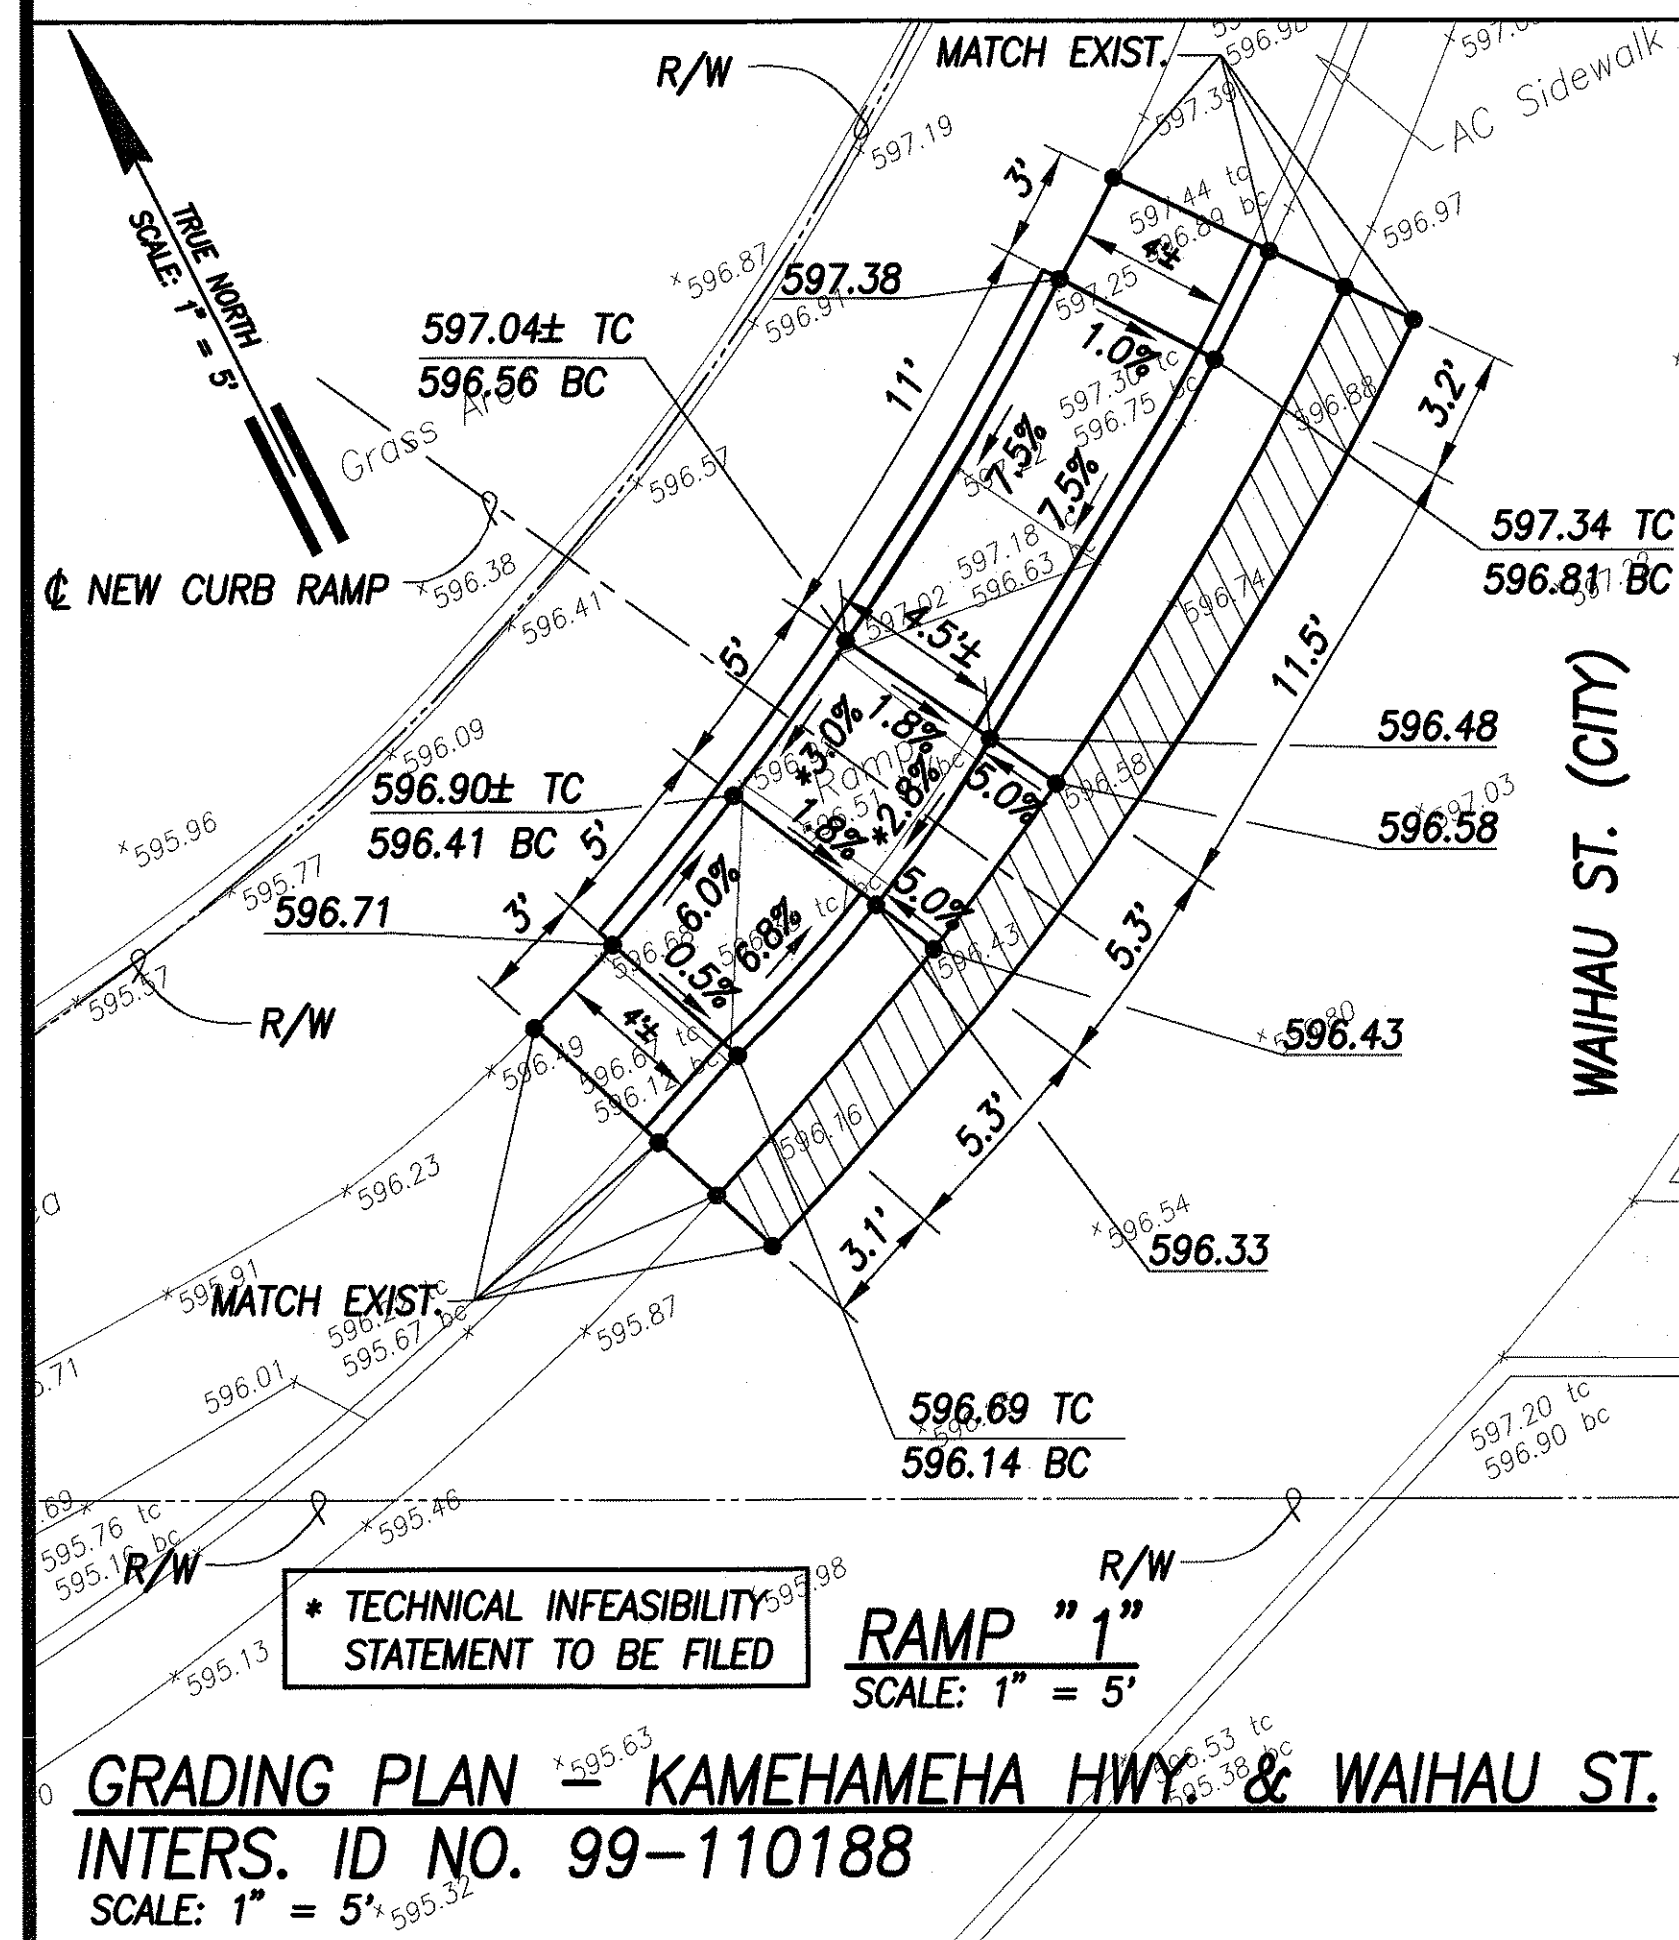


LEGEND

× 49.52 EXIST. SPOT ELEVATION

● 52.58 FINISHED SPOT GRADE

● 51.50 TC FINISHED TOP OF CURB

● 51.00 BC FINISHED BOTTOM OF CURB

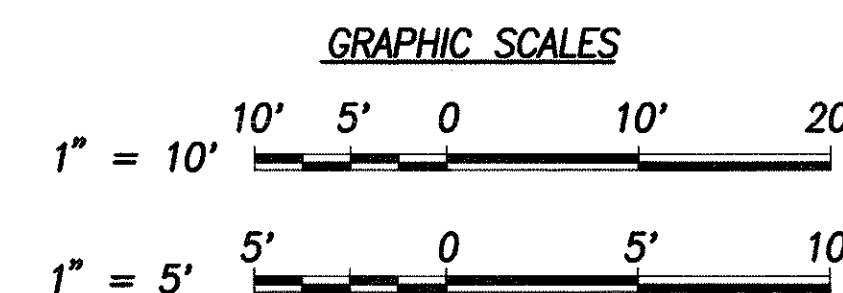

THIS WORK WAS PREPARED BY ME OR UNDER
MY SUPERVISION AND CONSTRUCTION OF THIS
PROJECT WILL BE UNDER MY OBSERVATION

Ray W. White April 30, 2014
SIGNATURE DATE

"OBSERVATION OF CONSTRUCTION" IS DEFINED IN CHAPTER 16-115, HAWAII ADMINISTRATIVE RULES ENTITLED "PROFESSIONAL ENGINEERS, ARCHITECTS, SURVEYORS AND LANDSCAPE ARCHITECTS"

STATE OF HAWAII
DEPARTMENT OF TRANSPORTATION
HIGHWAYS DIVISION

SITE & GRADING PLAN


KAMEHAMEHA HWY. & WAIHAU ST.

Pedestrian Facilities & ADA Compliance
at Various Locations on Oahu, Unit 5
Fed. Aid Proj. No. CMAQ-0300(96)


Scale: AS SHOWN Date: August, 2004

SHEET No. C-82 OF 153 SHEETS

FED. ROAD DIST. NO.	STATE	FED. AID PROJ. NO.	FISCAL YEAR	SHEET NO.	TOTAL SHEETS
HAWAII	HAW.	CMAQ-0300(96)	2004	C.O. 84	153


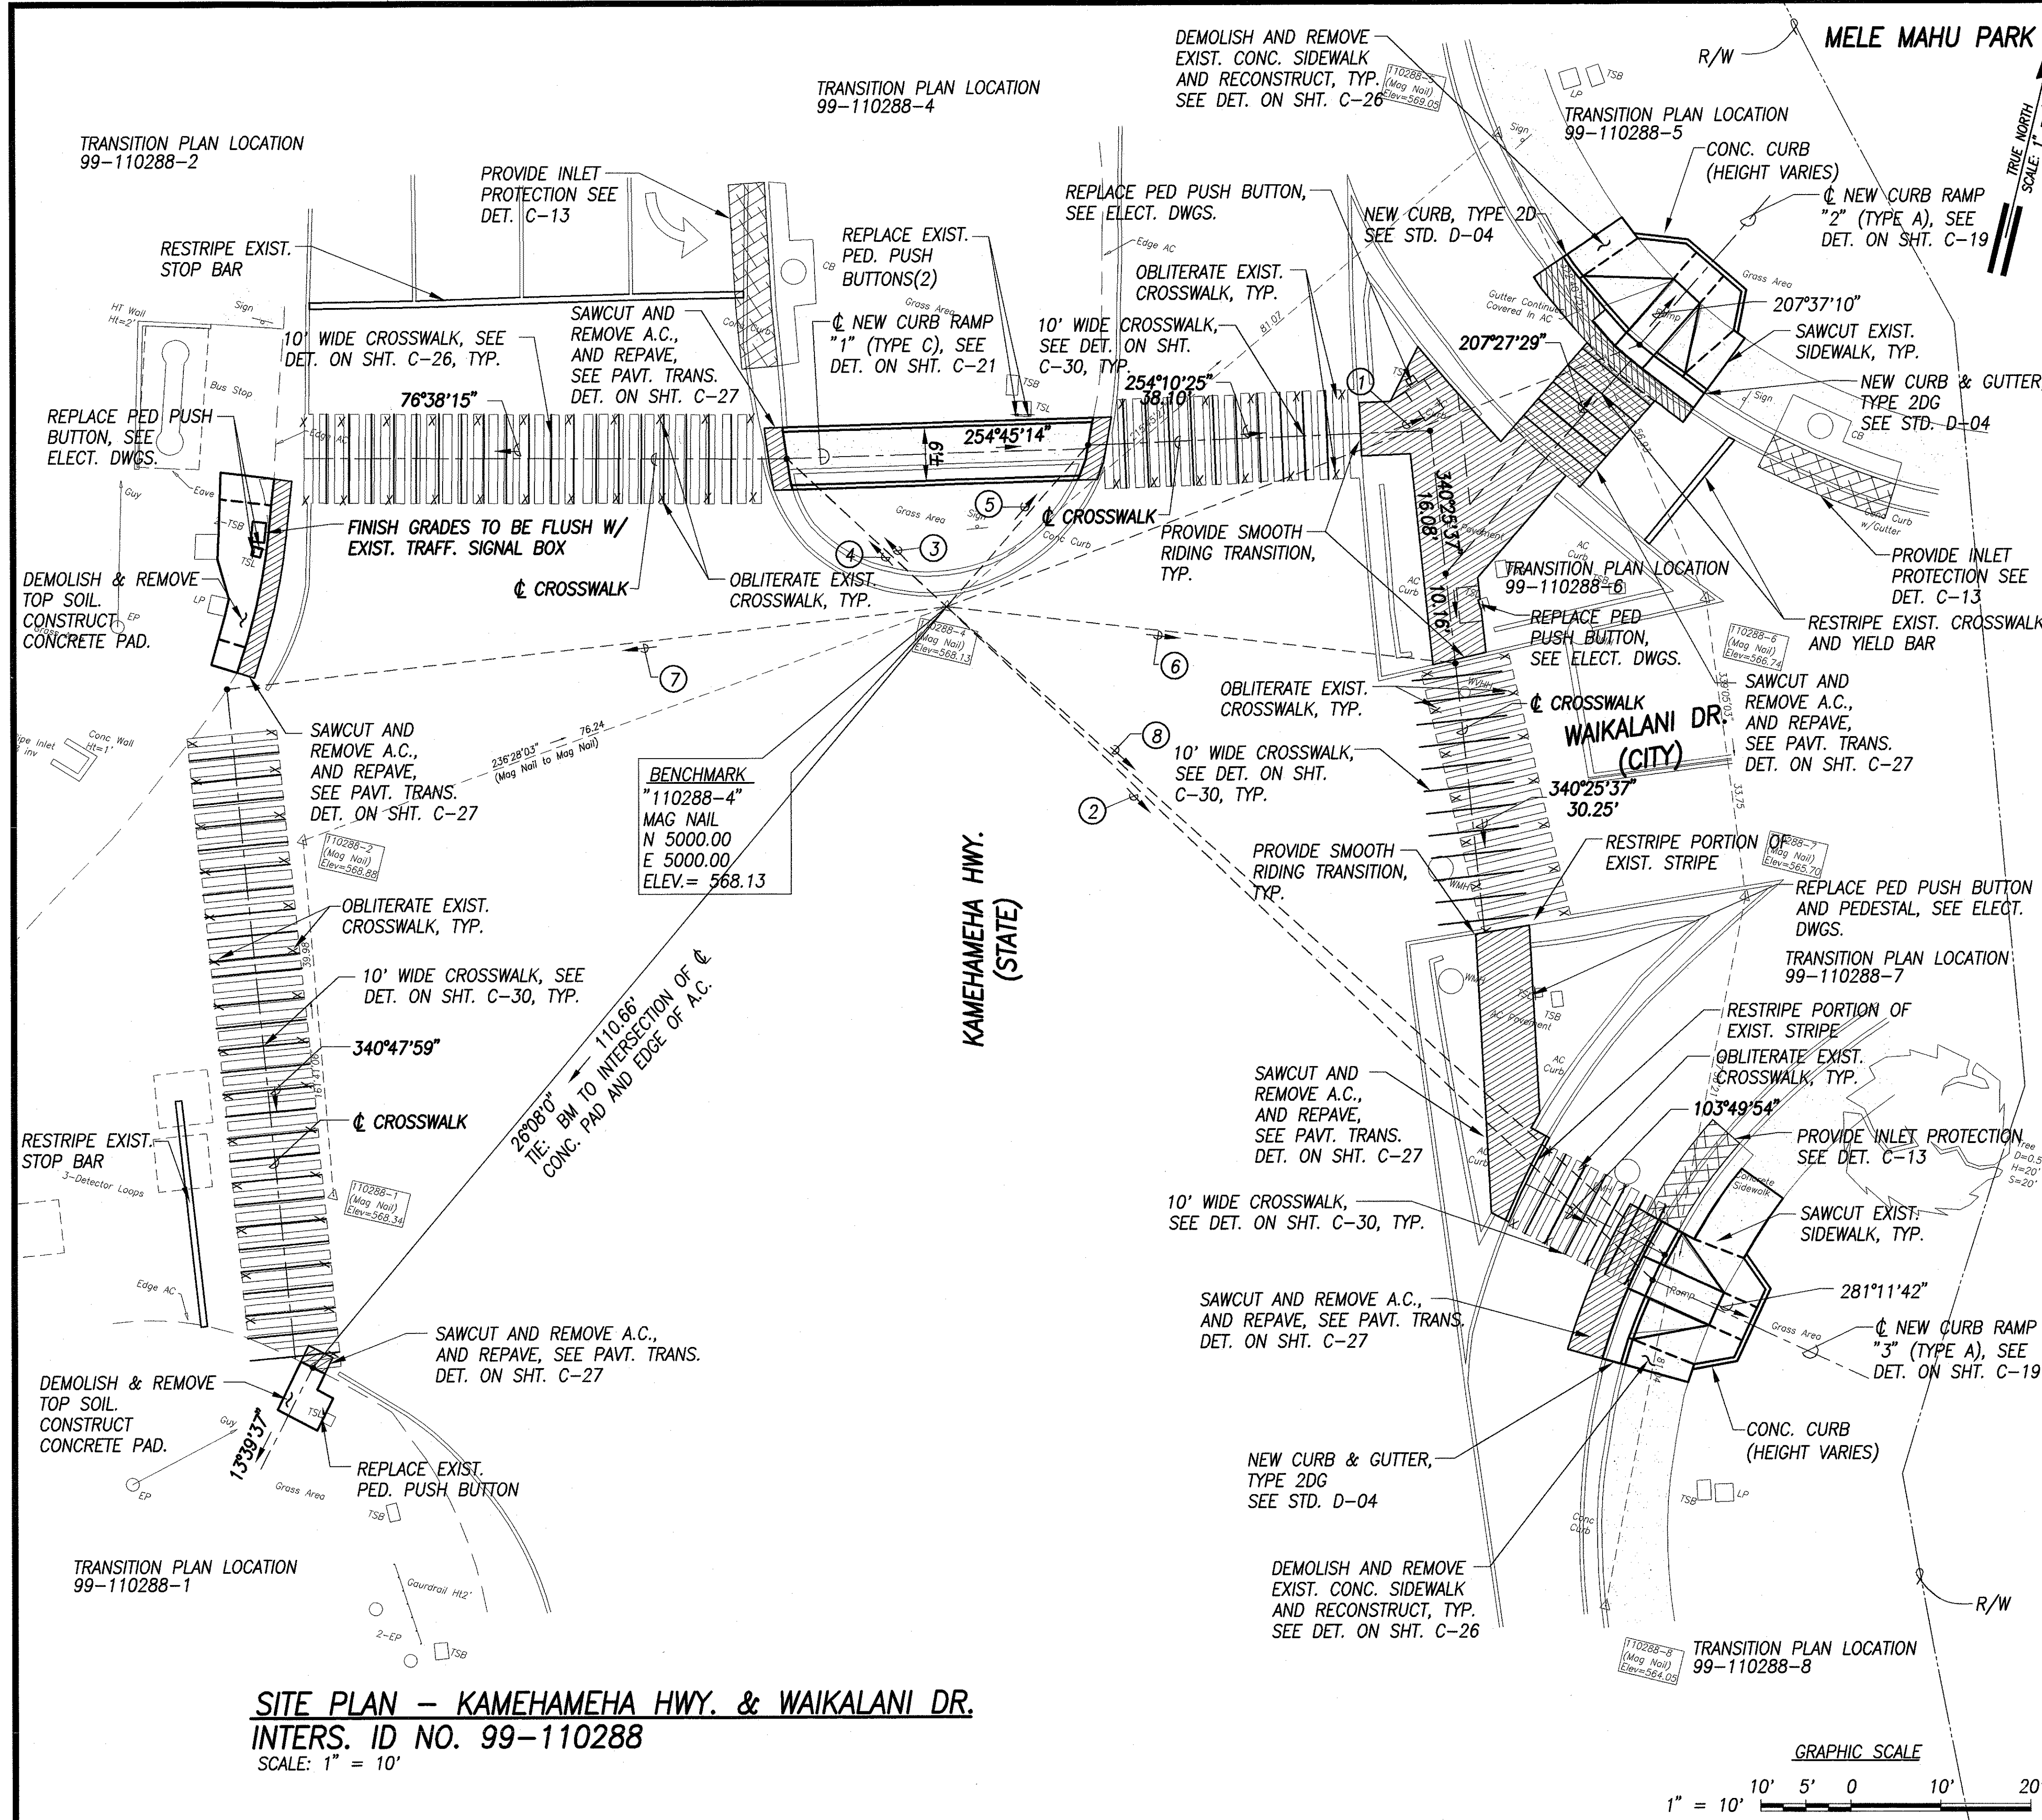


- ① 231°42'40" 82.50'
TIE: BM TO INTERSECTION OF RAMP AND CURB FACE
- ② 300°29'15" 109.01'
TIE: BM TO INTERSECTION OF RAMP AND CURB FACE
- ③ 119°38'22" 24.37'
TIE: BM TO INTERSECTION OF RAMP AND CURB FACE
- ④ 119°38'22" 24.37'
TIE: BM TO INTERSECTION OF CROSSWALK AND CURB FACE
- ⑤ 119°38'22" 24.37'
TIE: BM TO INTERSECTION OF CROSSWALK AND CURB FACE
- ⑥ 262°59'34" 56.95'
TIE: BM TO INTERSECTION OF CROSSWALK AND EDGE OF STRIPE
- ⑦ 69°57'36" 80.58'
TIE: BM TO INTERSECTION OF CROSSWALK AND EDGE OF A.C.
- ⑧ 298°54'45" 108.09'
TIE: BM TO INTERSECTION OF CROSSWALK AND CURB FACE

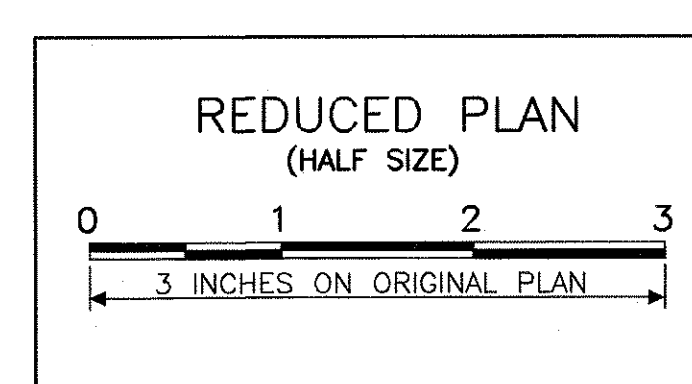

SURVEY PLOTTED BY	DATE
DRAWN BY	
CHECKED BY	
NOTED BY	
ORIGINAL PLAN	
NOTE BOOK	
No.	




SITE PLAN - KAMEHAMEHA HWY. & WAIKALANI DR.
INTERS. ID NO. 99-110288
 SCALE: 1" = 10'

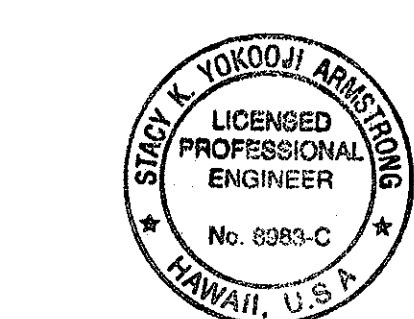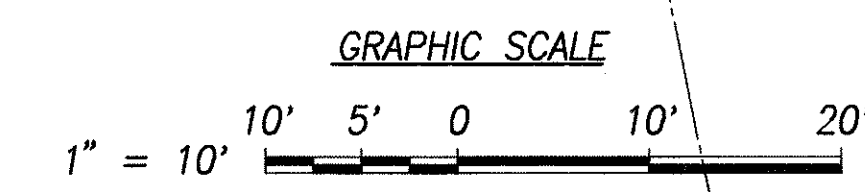


THIS WORK WAS PREPARED BY ME OR UNDER MY SUPERVISION AND CONSTRUCTION OF THIS PROJECT WILL BE UNDER MY OBSERVATION.
 SIGNATURE: *Stacy K. Yokooji* DATE: 4/30/06
 "OBSERVATION OF CONSTRUCTION" IS DEFINED IN CHAPTER 16-115, HAWAII ADMINISTRATIVE RULES ENTITLED "PROFESSIONAL ENGINEERS, ARCHITECTS, SURVEYORS AND LANDSCAPE ARCHITECTS".

DATE	REVISION
STATE OF HAWAII DEPARTMENT OF TRANSPORTATION HIGHWAYS DIVISION SITE PLAN KAMEHAMEHA HWY. & WAIKALANI DR. <i>Pedestrian Facilities & ADA Compliance</i> <i>at Various Locations on Oahu, Unit 5</i> <i>Fed. Aid Proj. No. CMAQ-0300(96)</i> Scale: 1" = 10'-0" Date: August 2004 SHEET No. C-83 OF 153 SHEETS	

FED. ROAD DIST. NO.	STATE	FED. AID PROJ. NO.	FISCAL YEAR	SHEET NO.	TOTAL SHEETS
HAWAII	HAW.	CMAQ-0300(96)	2004	C.O. 85	153

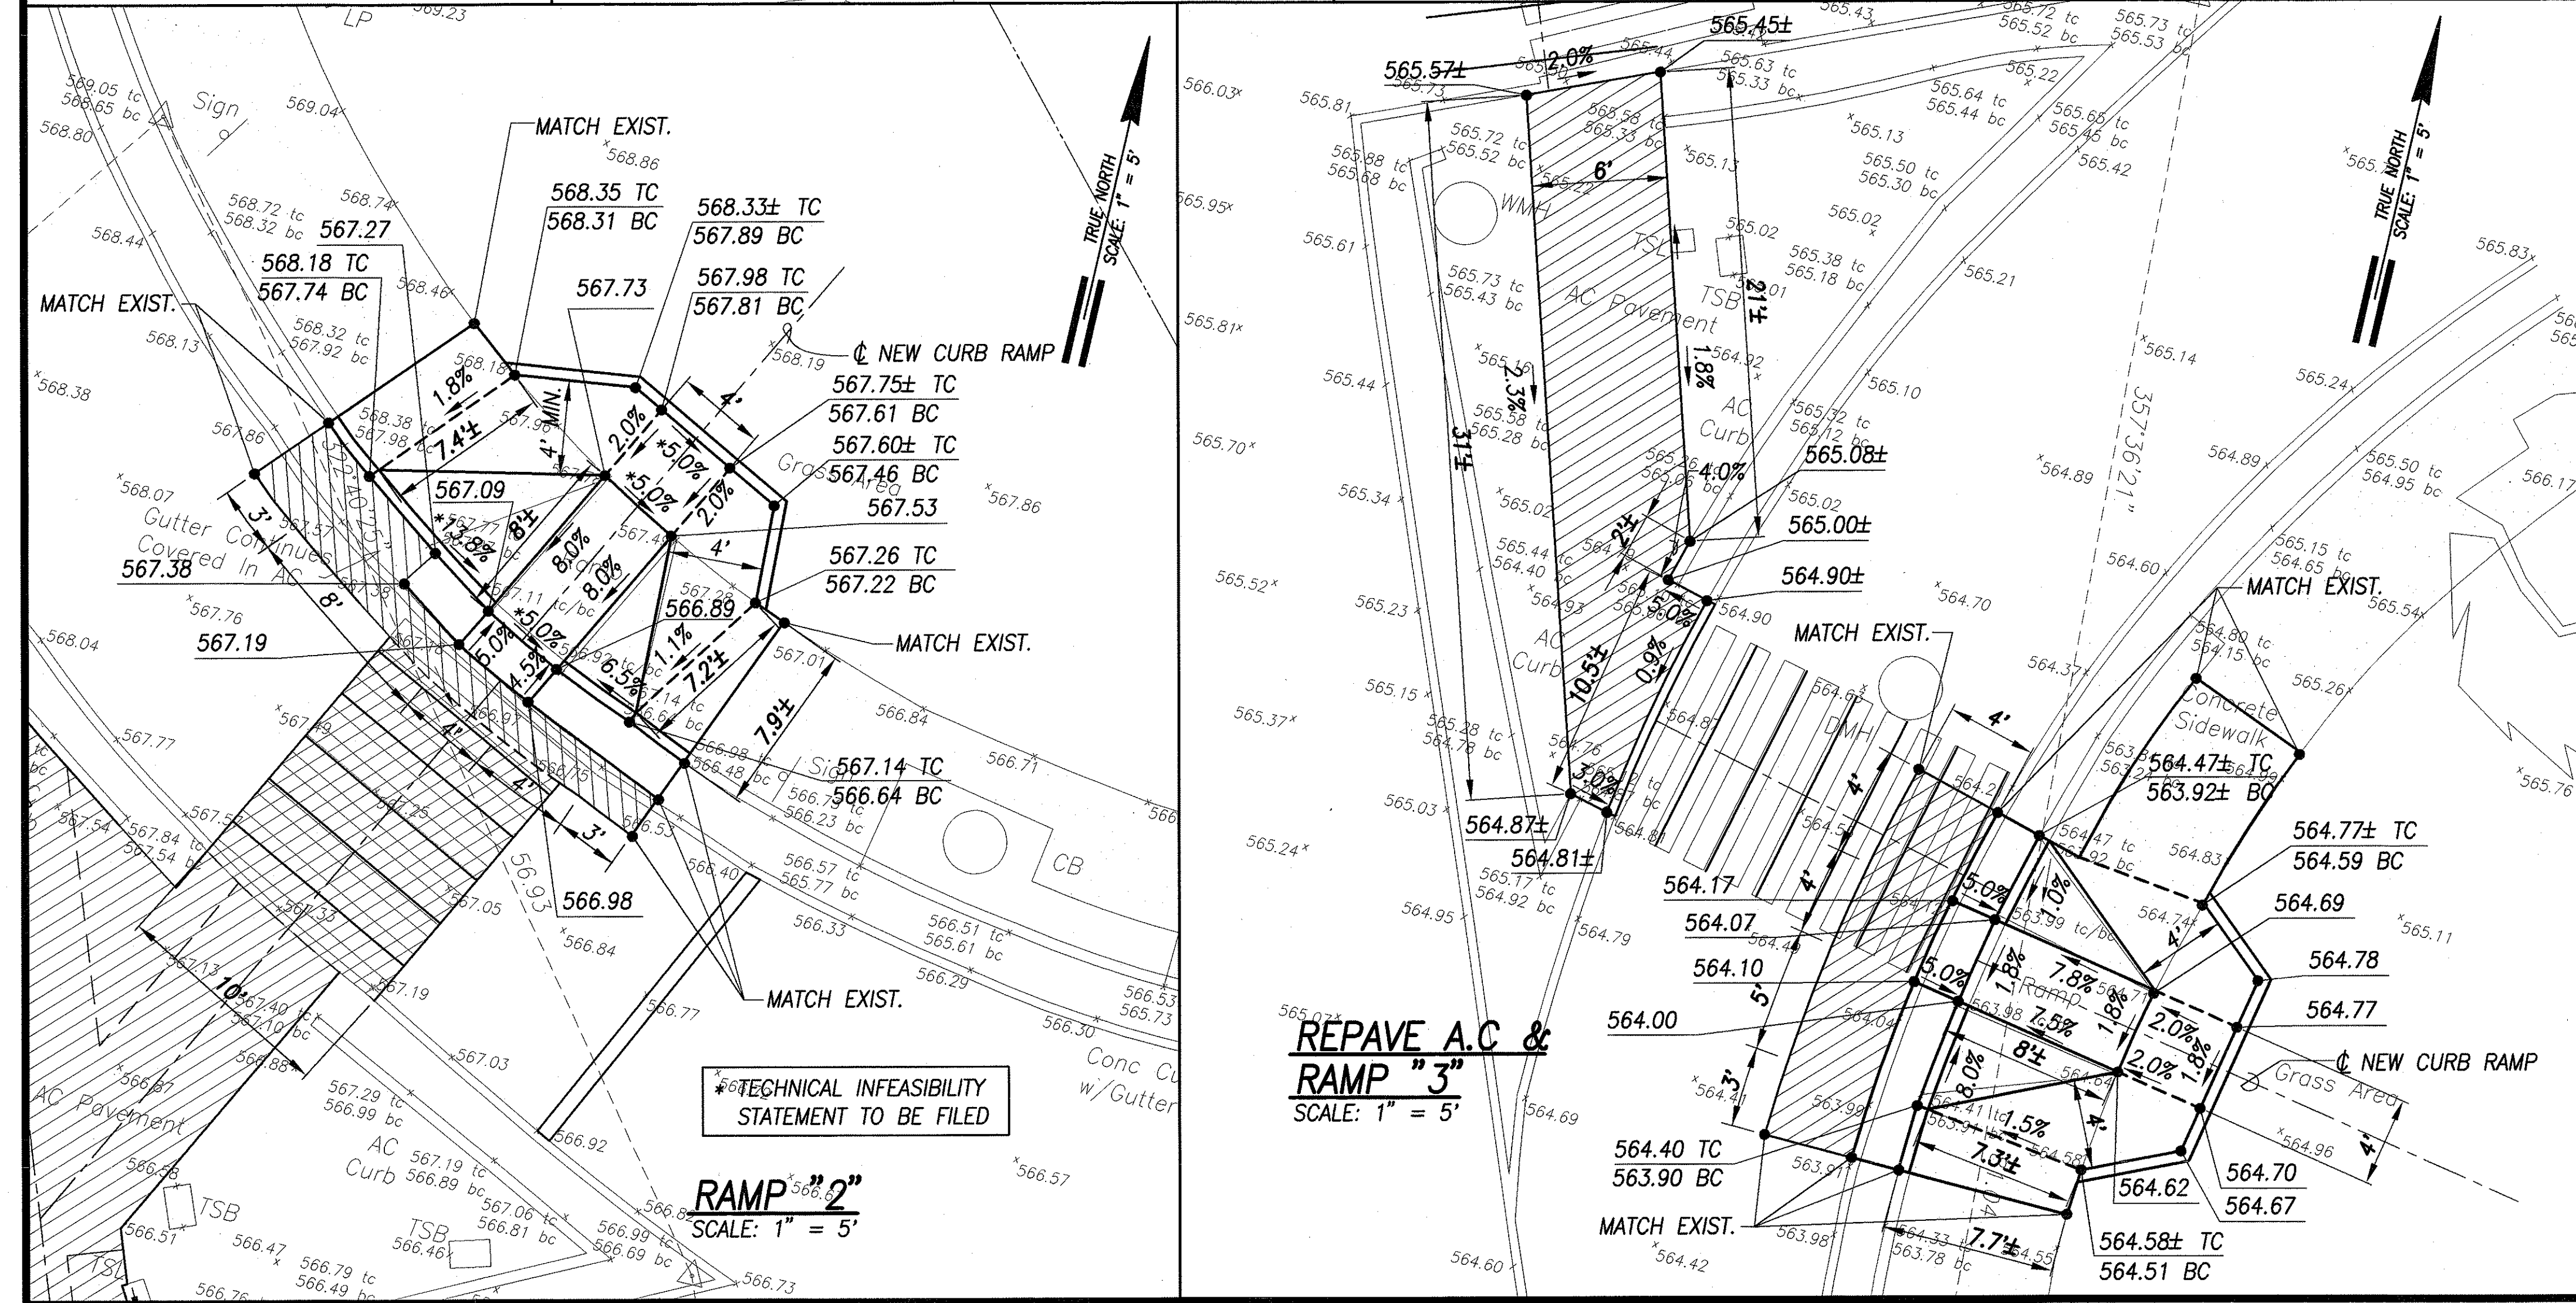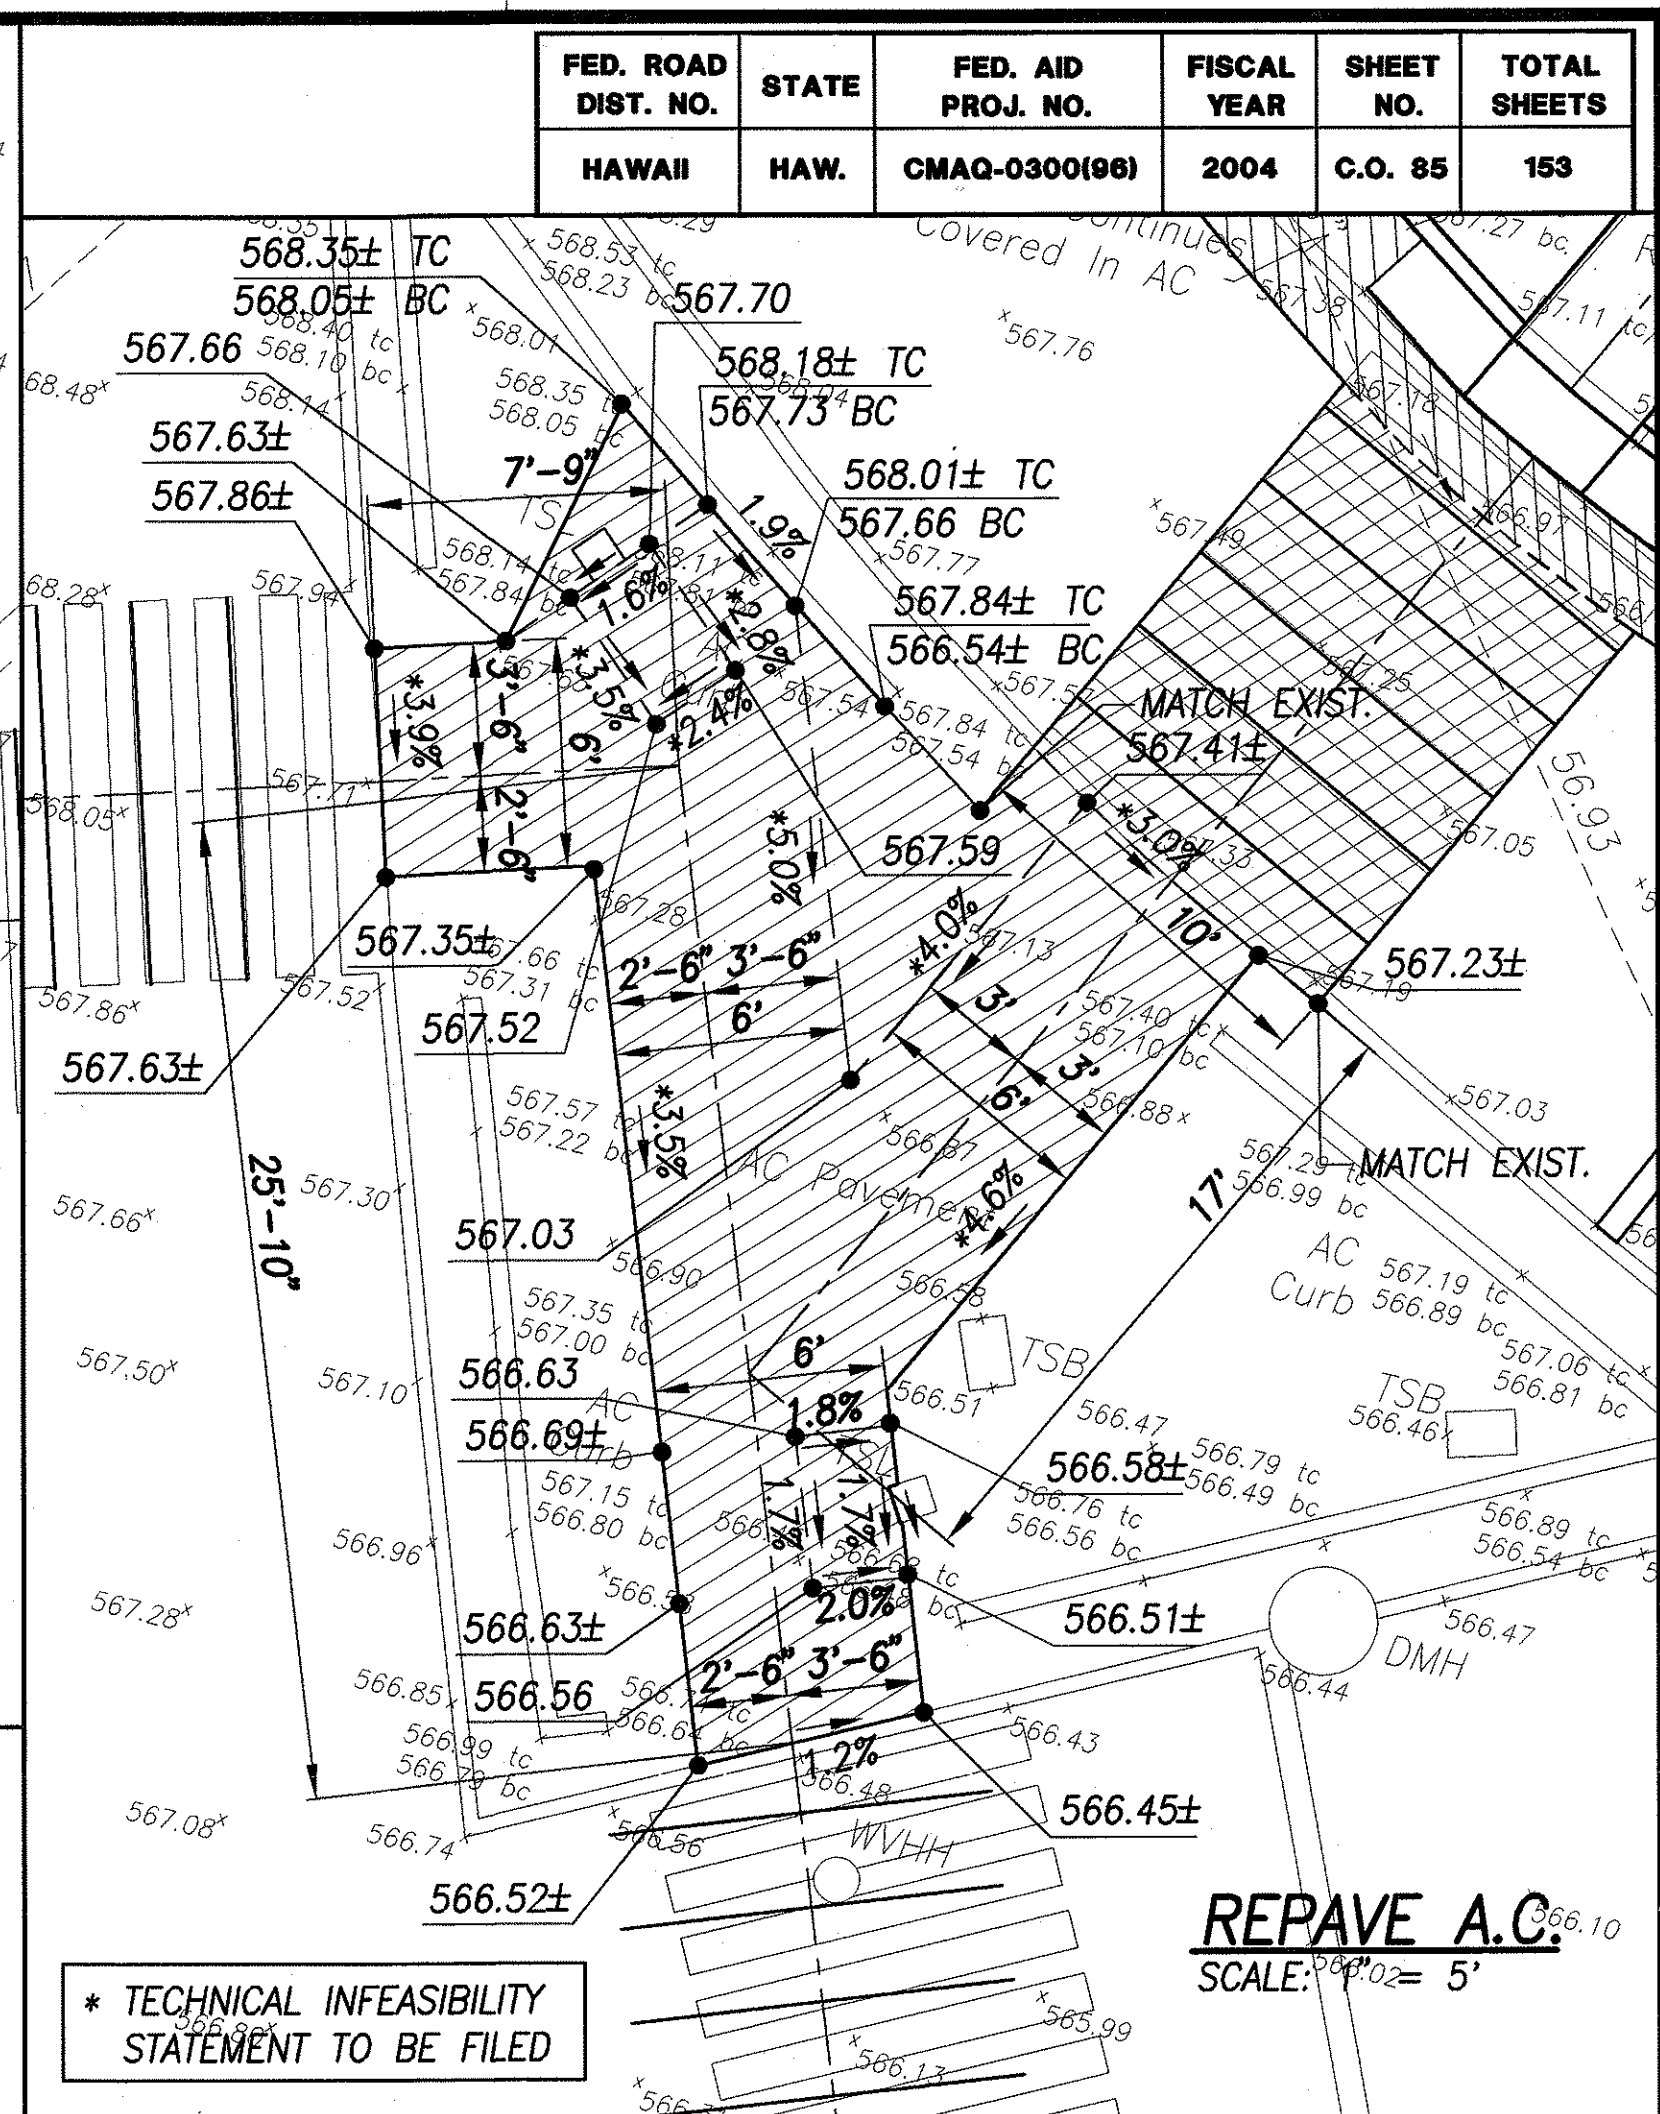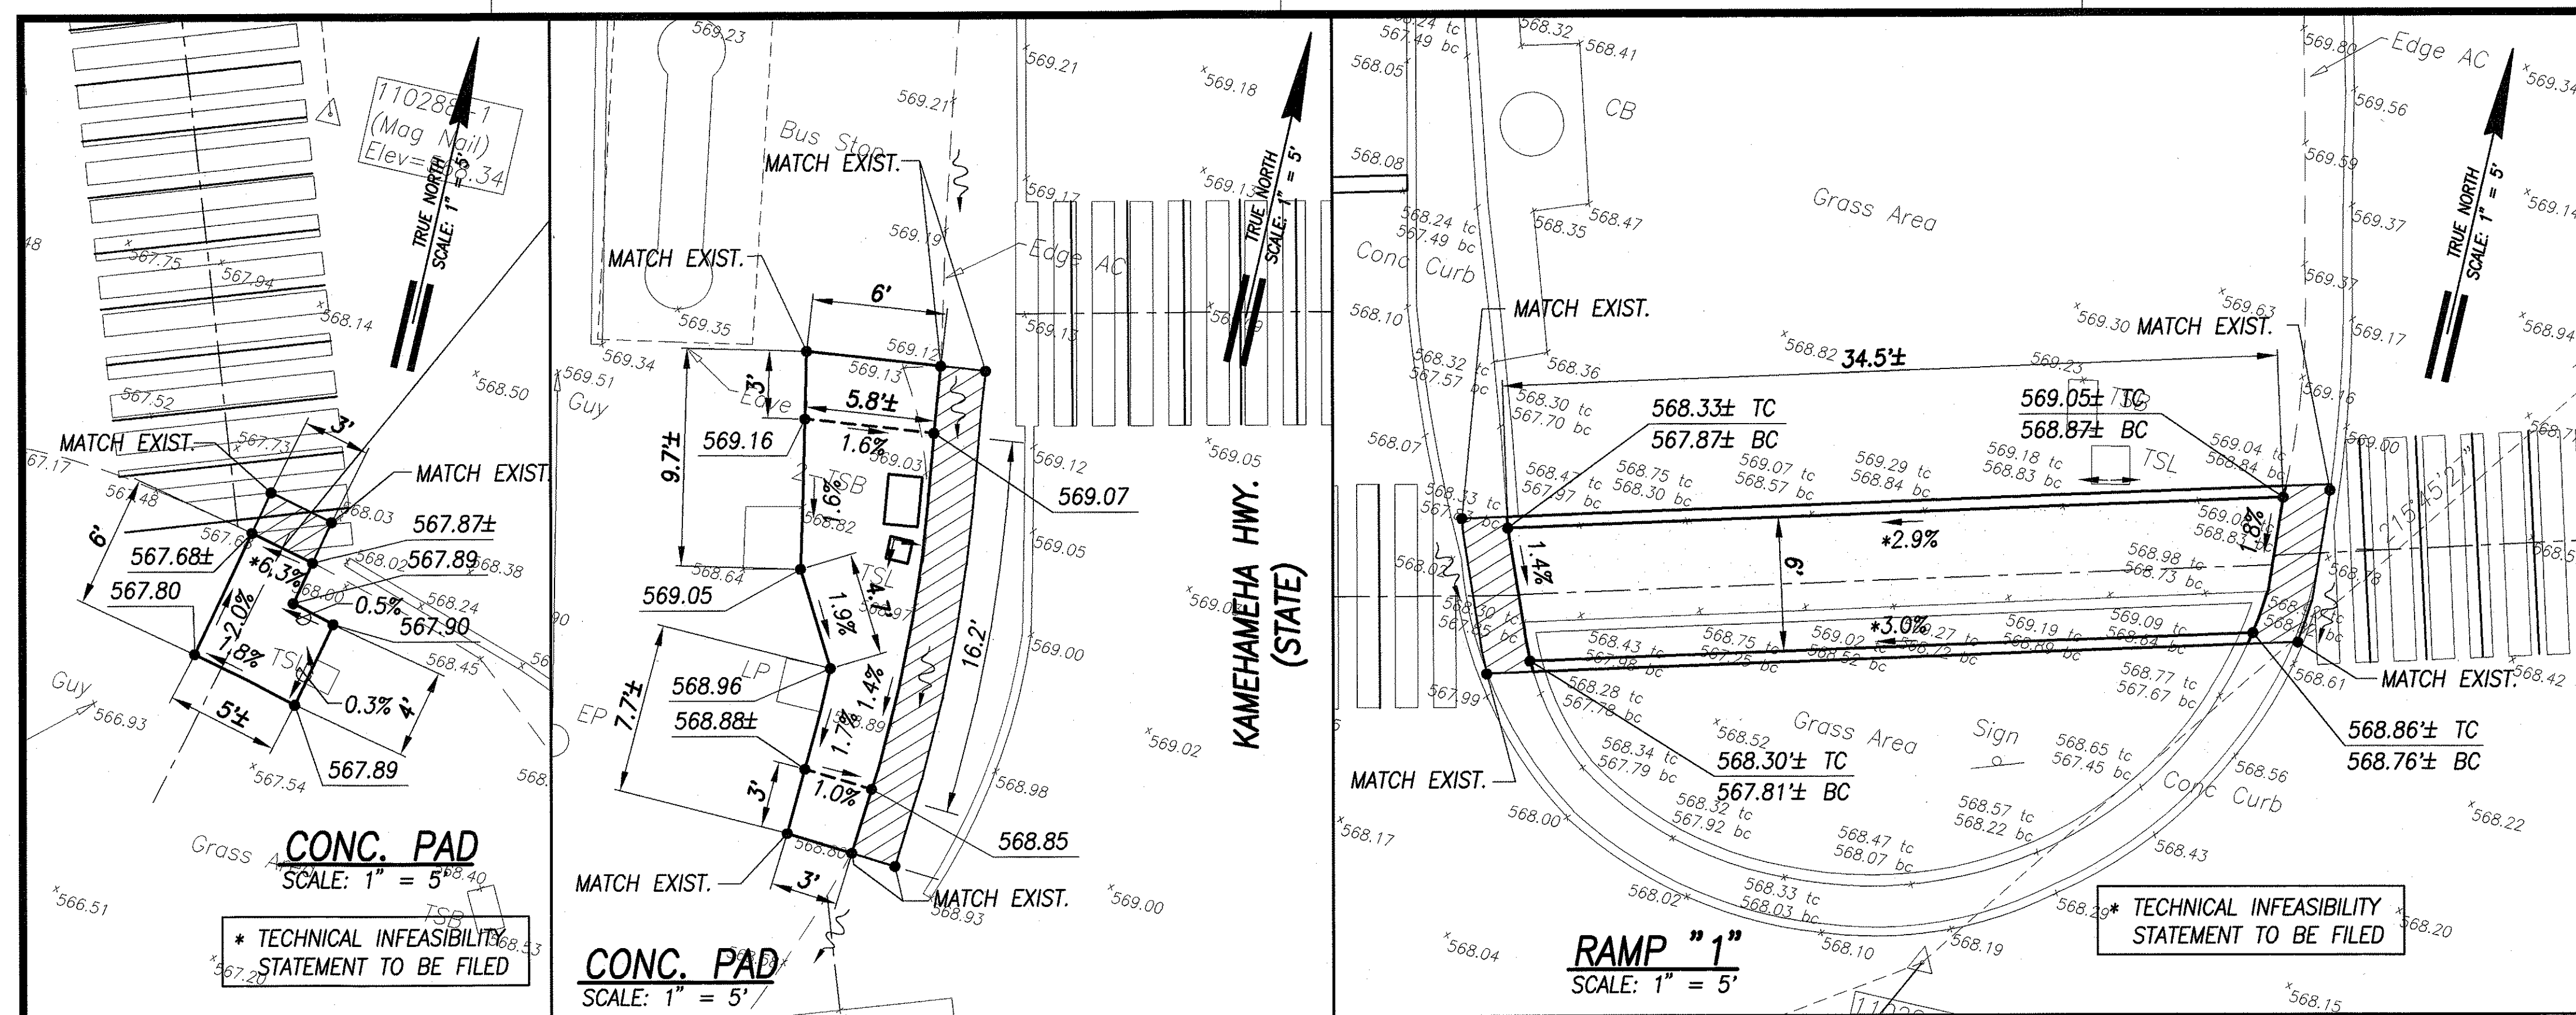

GRADING PLAN - KAMEHAMEHA HWY. & WAIKALANI DR.
INTERS. ID NO. 99-110288
 SCALE: 1" = 5'

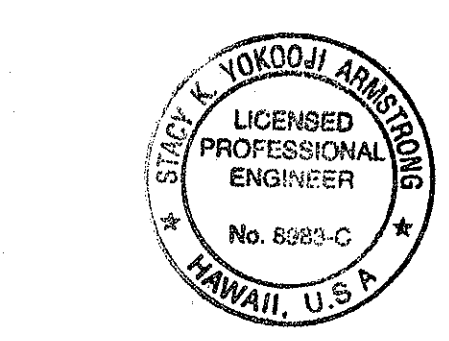

THIS WORK WAS PREPARED BY ME OR UNDER MY SUPERVISION AND CONSTRUCTION OF THIS PROJECT WILL BE UNDER MY OBSERVATION.

4/2/04
DATE

SHEET No. C-84 OF 153 SHEETS


DATE	REVISION

STATE OF HAWAII
HIGHWAYS DIVISION
GRADING PLAN
KAMEHAMEHA HWY. & WAIKALANI DR.

Pedestrian Facilities & ADA Compliance at Various Locations on Oahu, Unit 5
 Fed. Aid Proj. No. CMAQ-0300(96)

Scale: 1" = 5'-0" Date: August 2004



FED. ROAD DIST. NO.	STATE	FED. AID PROJ. NO.	FISCAL YEAR	SHEET NO.	TOTAL SHEETS
HAWAII	HAW.	CMAQ-0300(96)	2004	ADD. 90	153

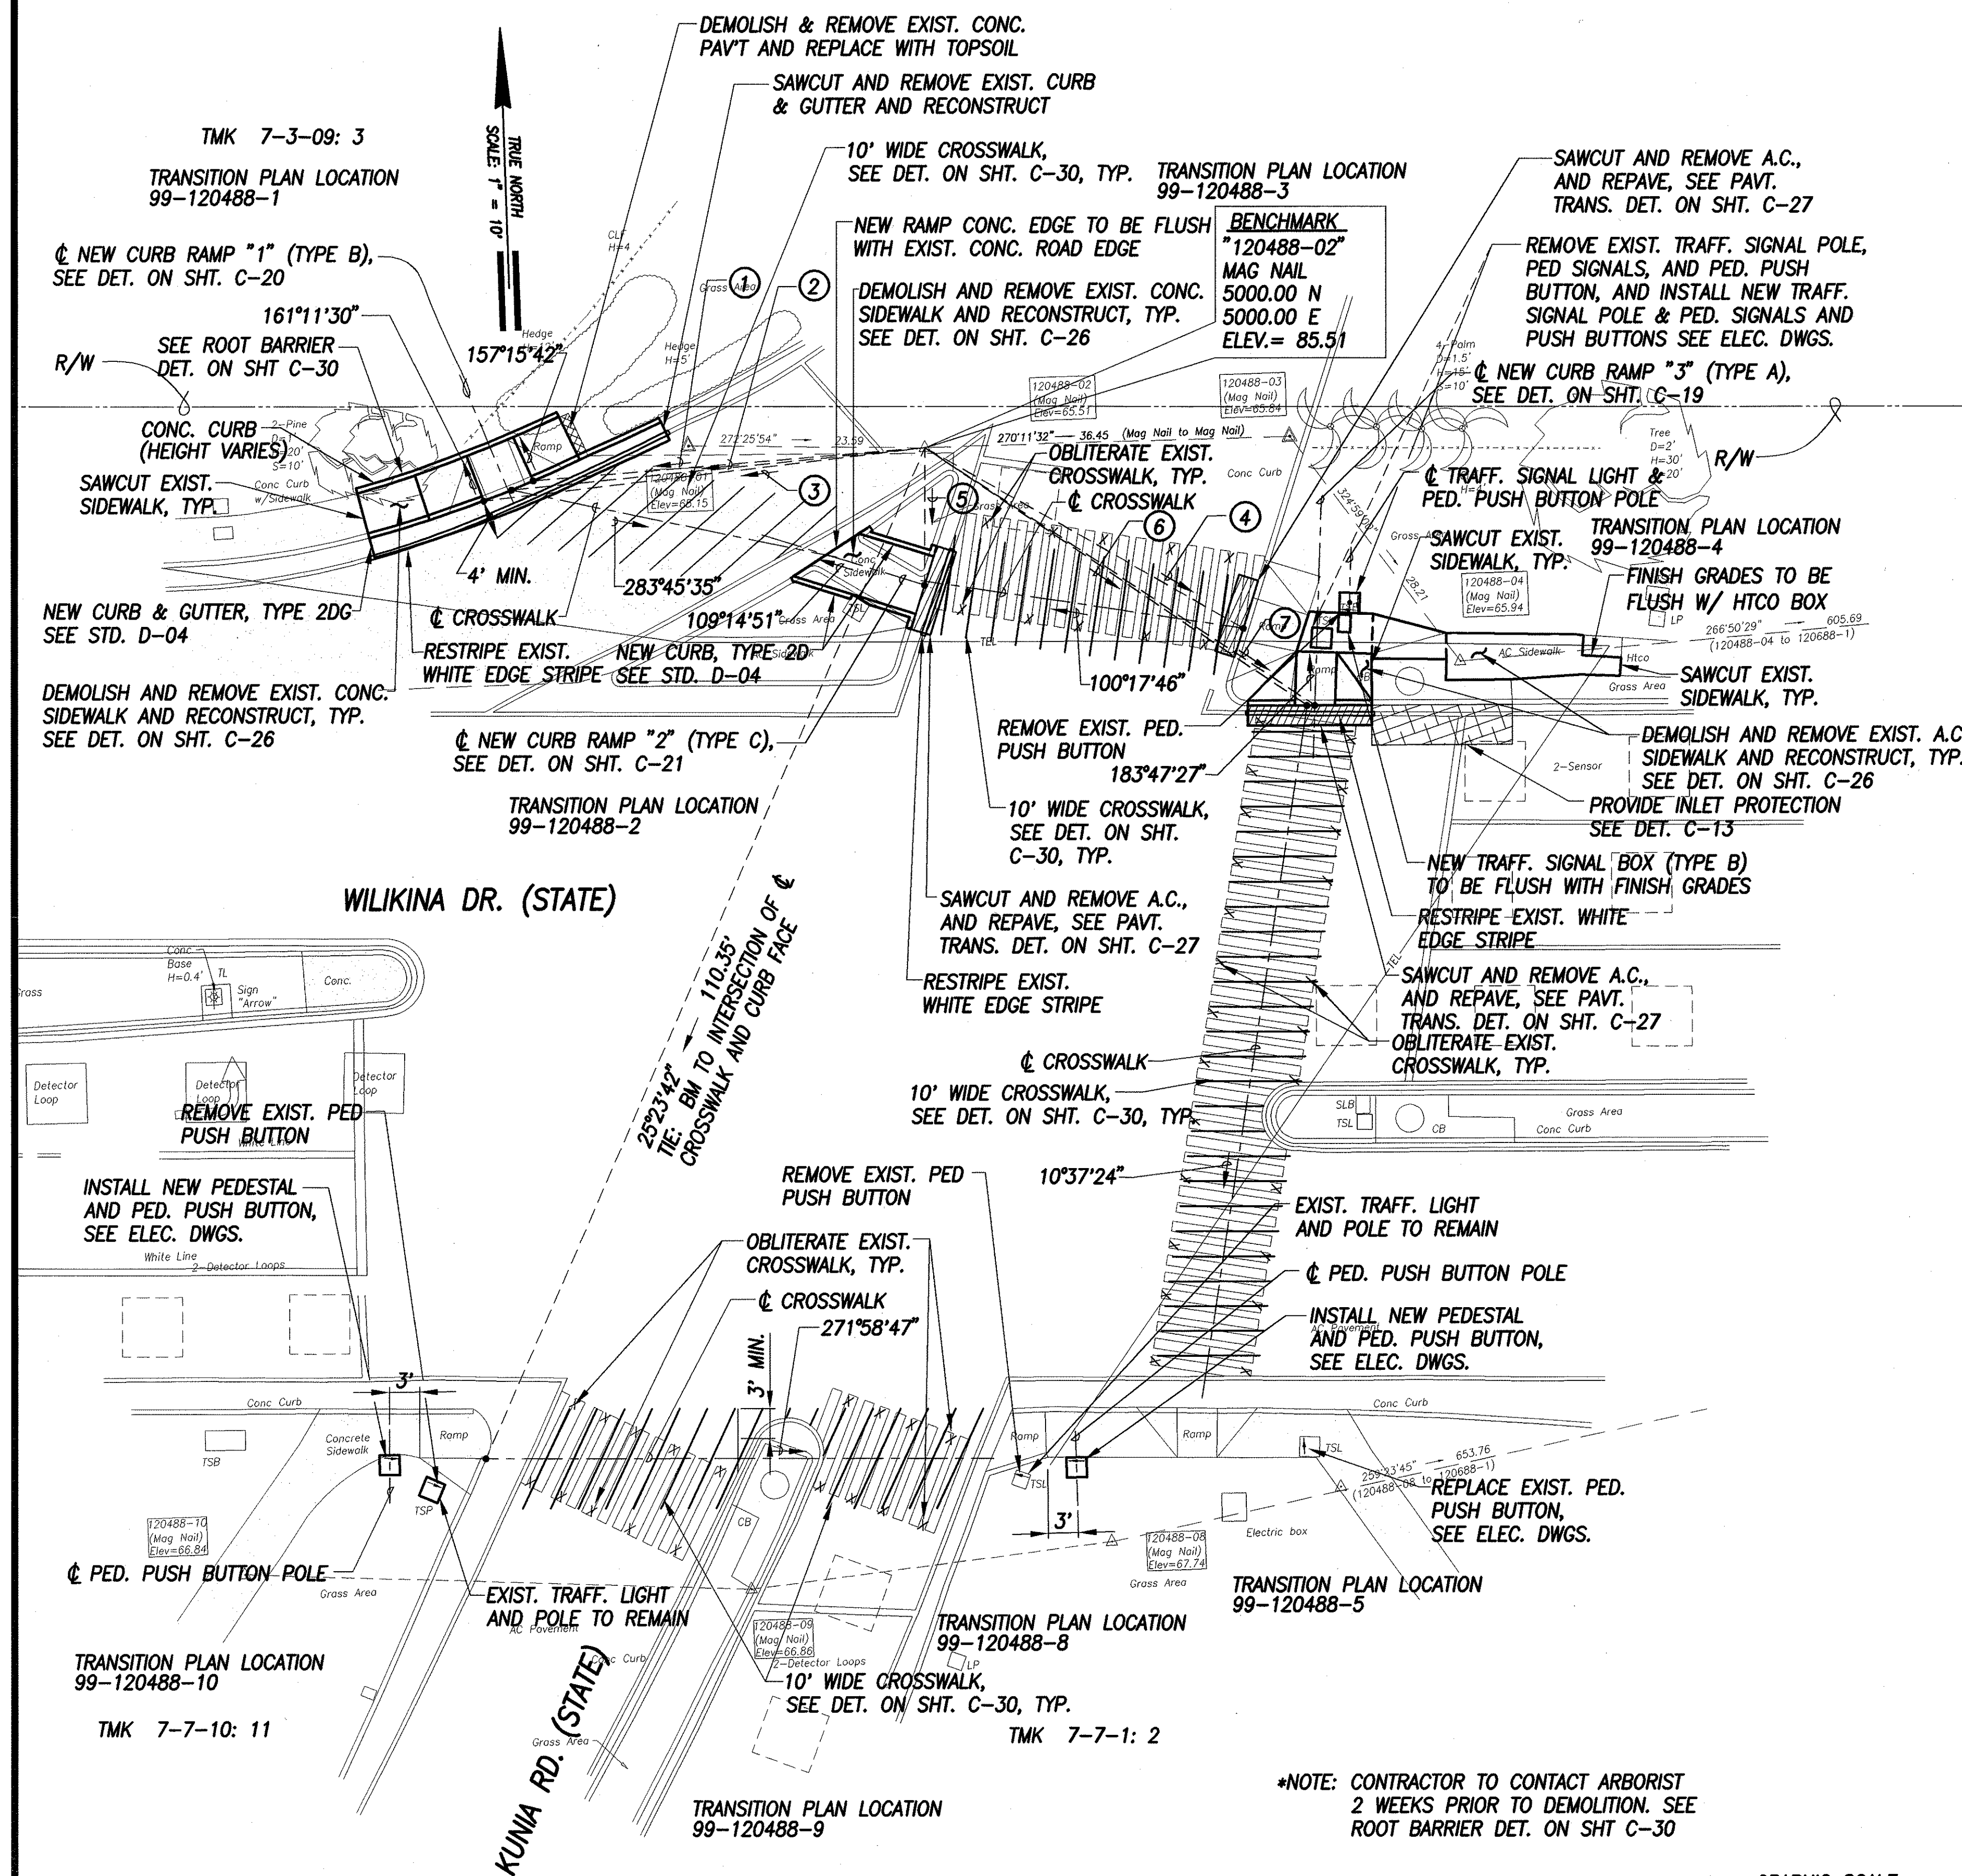

- 87°09'33", 39.21'
TIE: BM TO INTERSECTION OF RAMP
EDGE AND CURB FACE
- 86°08'29", 41.43'
TIE: BM TO INTERSECTION OF
CROSSWALK AND CURB FACE
- 85°05'39", 44.33'
TIE: BM TO INTERSECTION OF RAMP
EDGE AND CURB FACE
- 301°33'37", 36.55'
TIE: BM TO INTERSECTION OF
CROSSWALK AND CURB FACE
- 2°10'27", 13.77'
TIE: BM TO INTERSECTION OF
RAMP AND CURB FACE
- 306°02'23", 46.04'
TIE: BM TO INTERSECTION OF
CROSSWALK AND CURB FACE
- 305°3'11", 46.68'
TIE: BM TO INTERSECTION OF
RAMP AND CURB FACE

DATE	_____
SURVEY PLOTTED BY	_____
DRAWN BY	_____
DESIGNED BY	_____
CHECKED BY	_____
NOTE BOOK	_____
No.	_____

SITE PLAN - WILIKINA DR. & KUNIA RD.
INTERS. ID NO. 99-120488
 SCALE: 1" = 10'

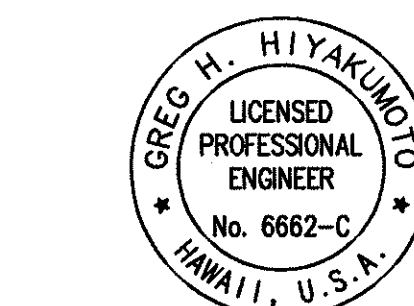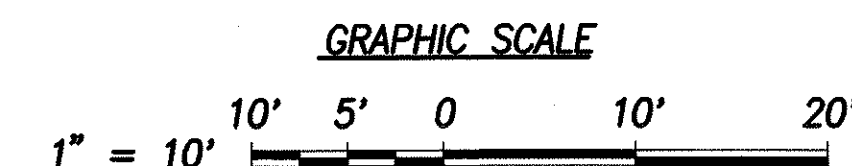

THIS WORK WAS PREPARED BY ME OR UNDER MY SUPERVISION AND CONSTRUCTION OF THIS PROJECT WILL BE UNDER MY OBSERVATION.



SIGNATURE *Greg H. Hiyaunono* DATE April 30, 2006

"OBSERVATION OF CONSTRUCTION" IS DEFINED IN CHAPTER 16-115, HAWAII ADMINISTRATIVE RULES ENTITLED "PROFESSIONAL ENGINEERS, ARCHITECTS, SURVEYORS AND LANDSCAPE ARCHITECTS".


9/16/04	ADD. 1 - REVISED CROSSWALKS STRIPING AND DELETED DARKENED TSB BOX
DATE	REVISION
STATE OF HAWAII DEPARTMENT OF TRANSPORTATION HIGHWAYS DIVISION SITE PLAN WILIKINA DR. & KUNIA RD. Pedestrian Facilities & ADA Compliance at Various Locations on Oahu, Unit 5 Fed. Aid Proj. No. CMAQ-0300(96) Scale: 1" = 10'-0" Date: August 2004 SHEET No. C-89 OF 153 SHEETS	

ADD. 90


FED. ROAD DIST. NO.	STATE	FED. AID PROJ. NO.	FISCAL YEAR	SHEET NO.	TOTAL SHEETS
HAWAII	HAW.	CMAQ-0300(96)	2004	92	153

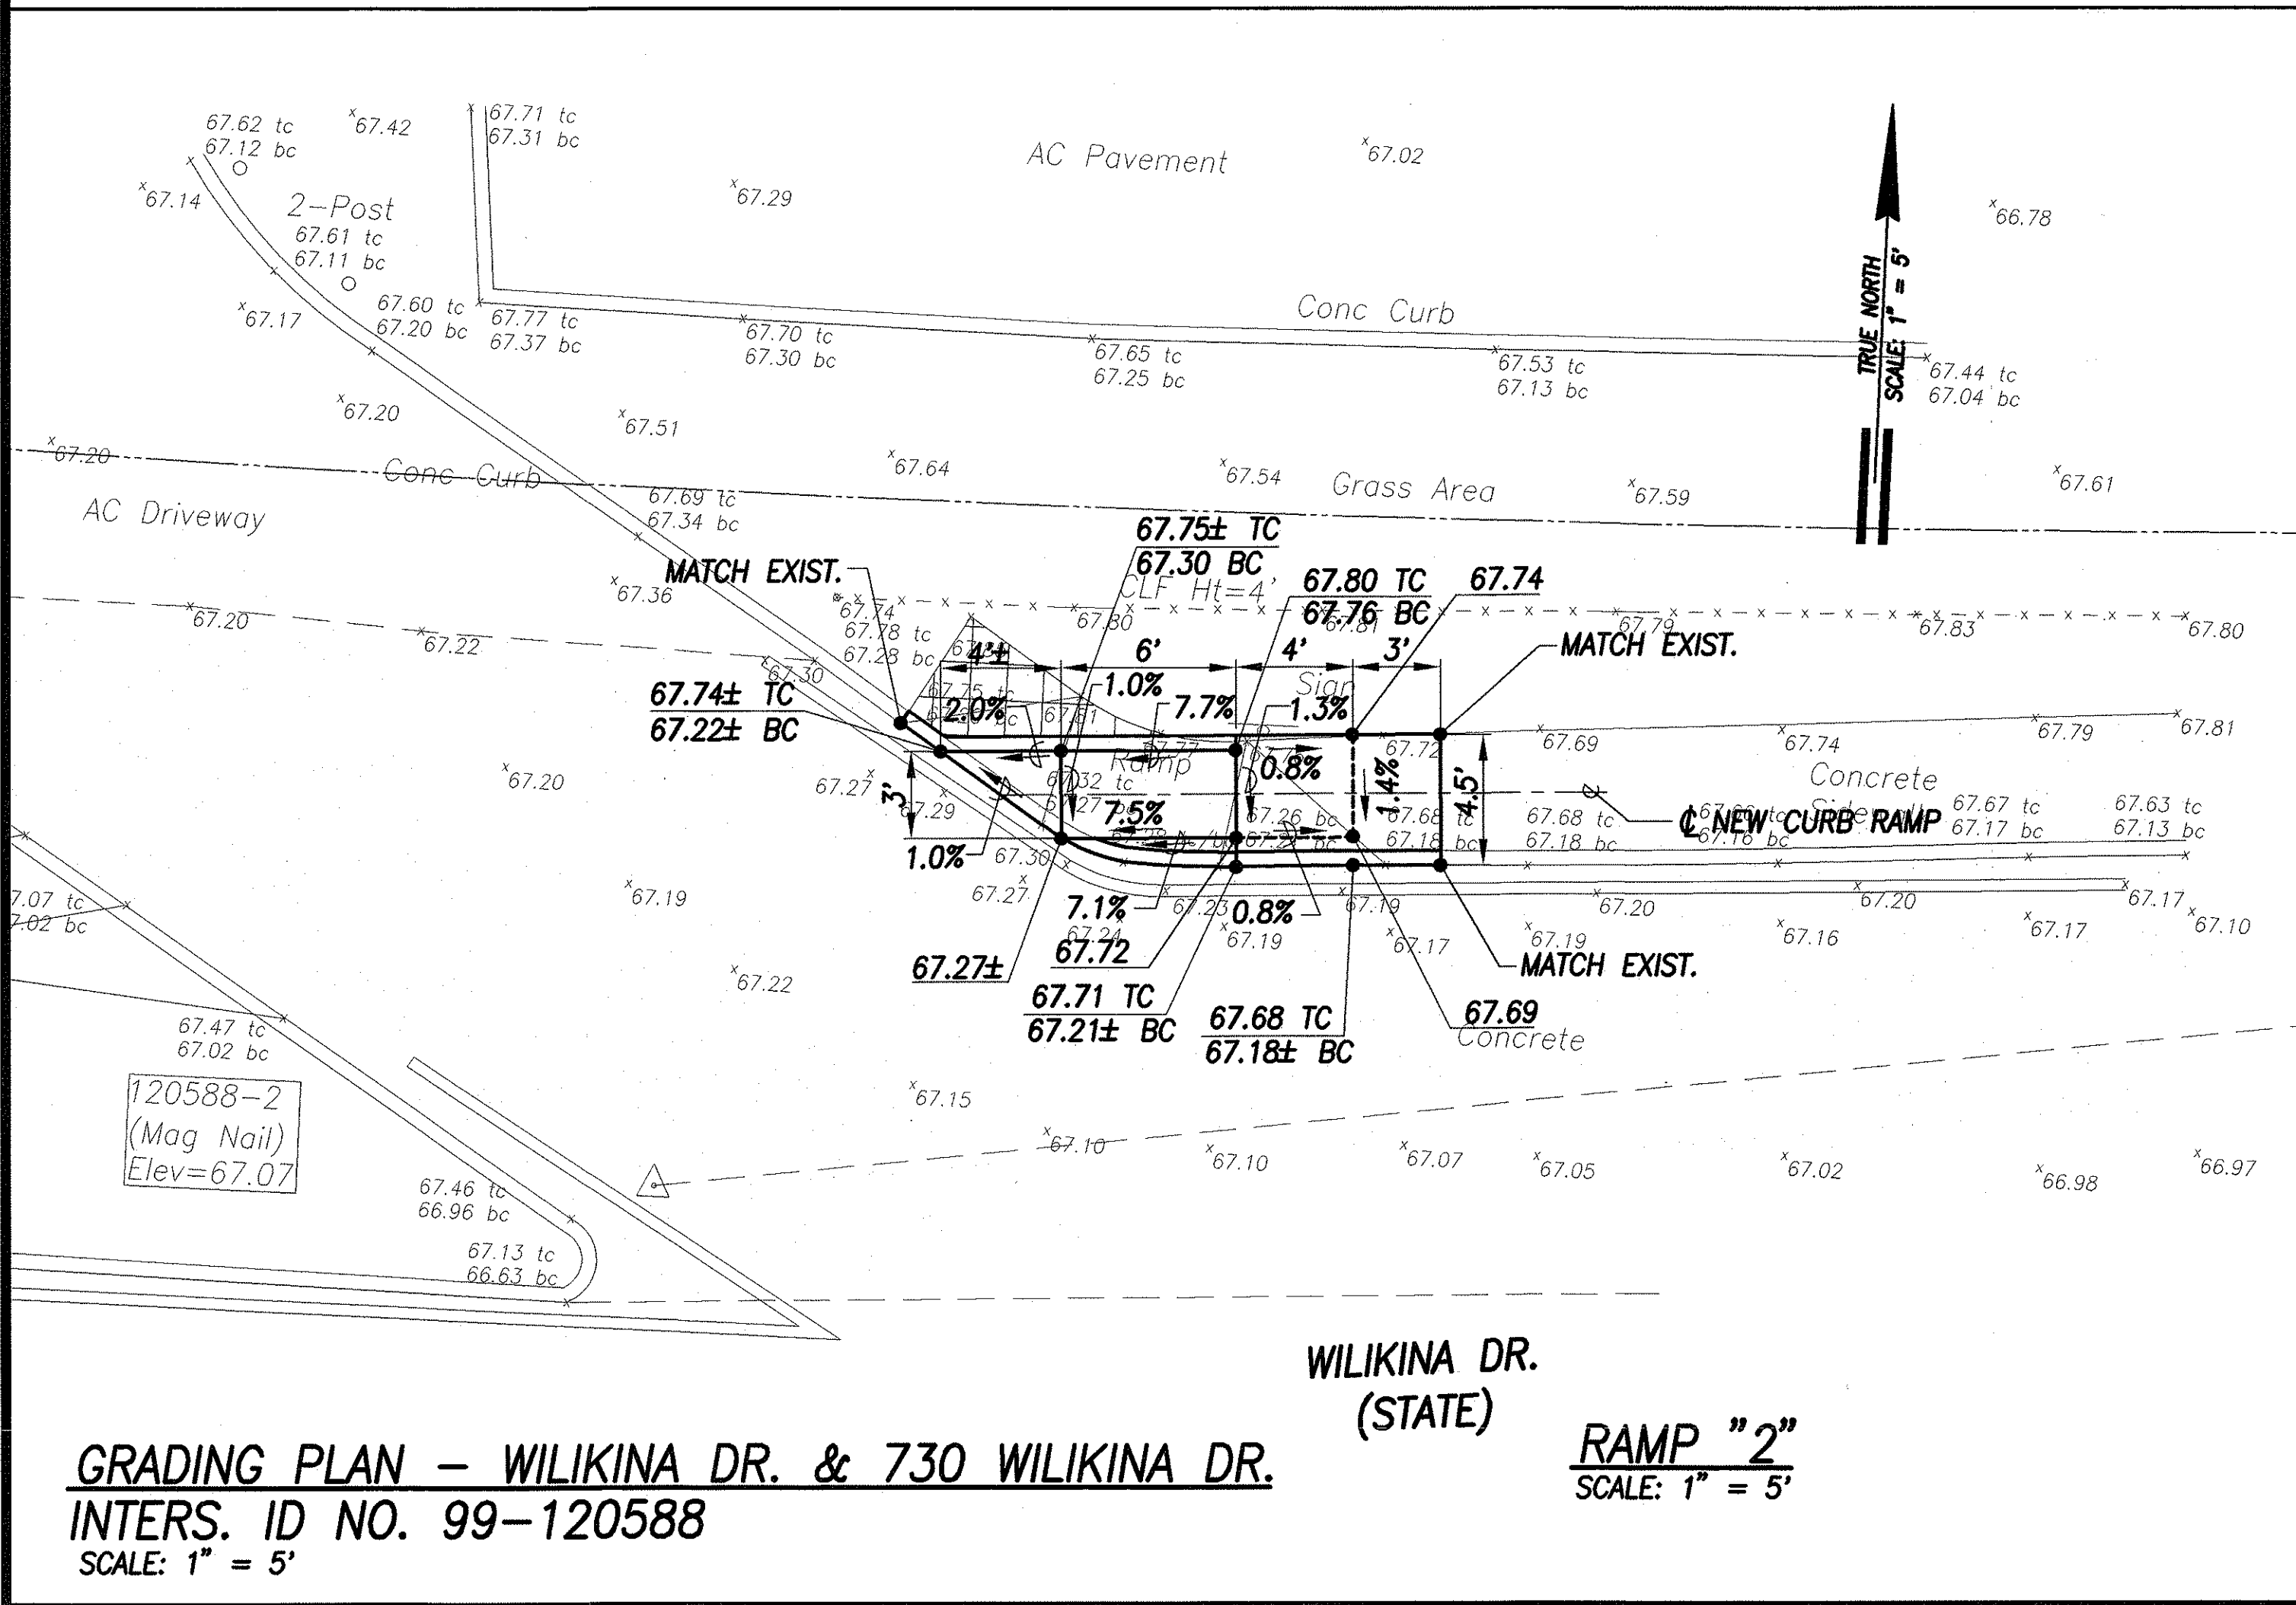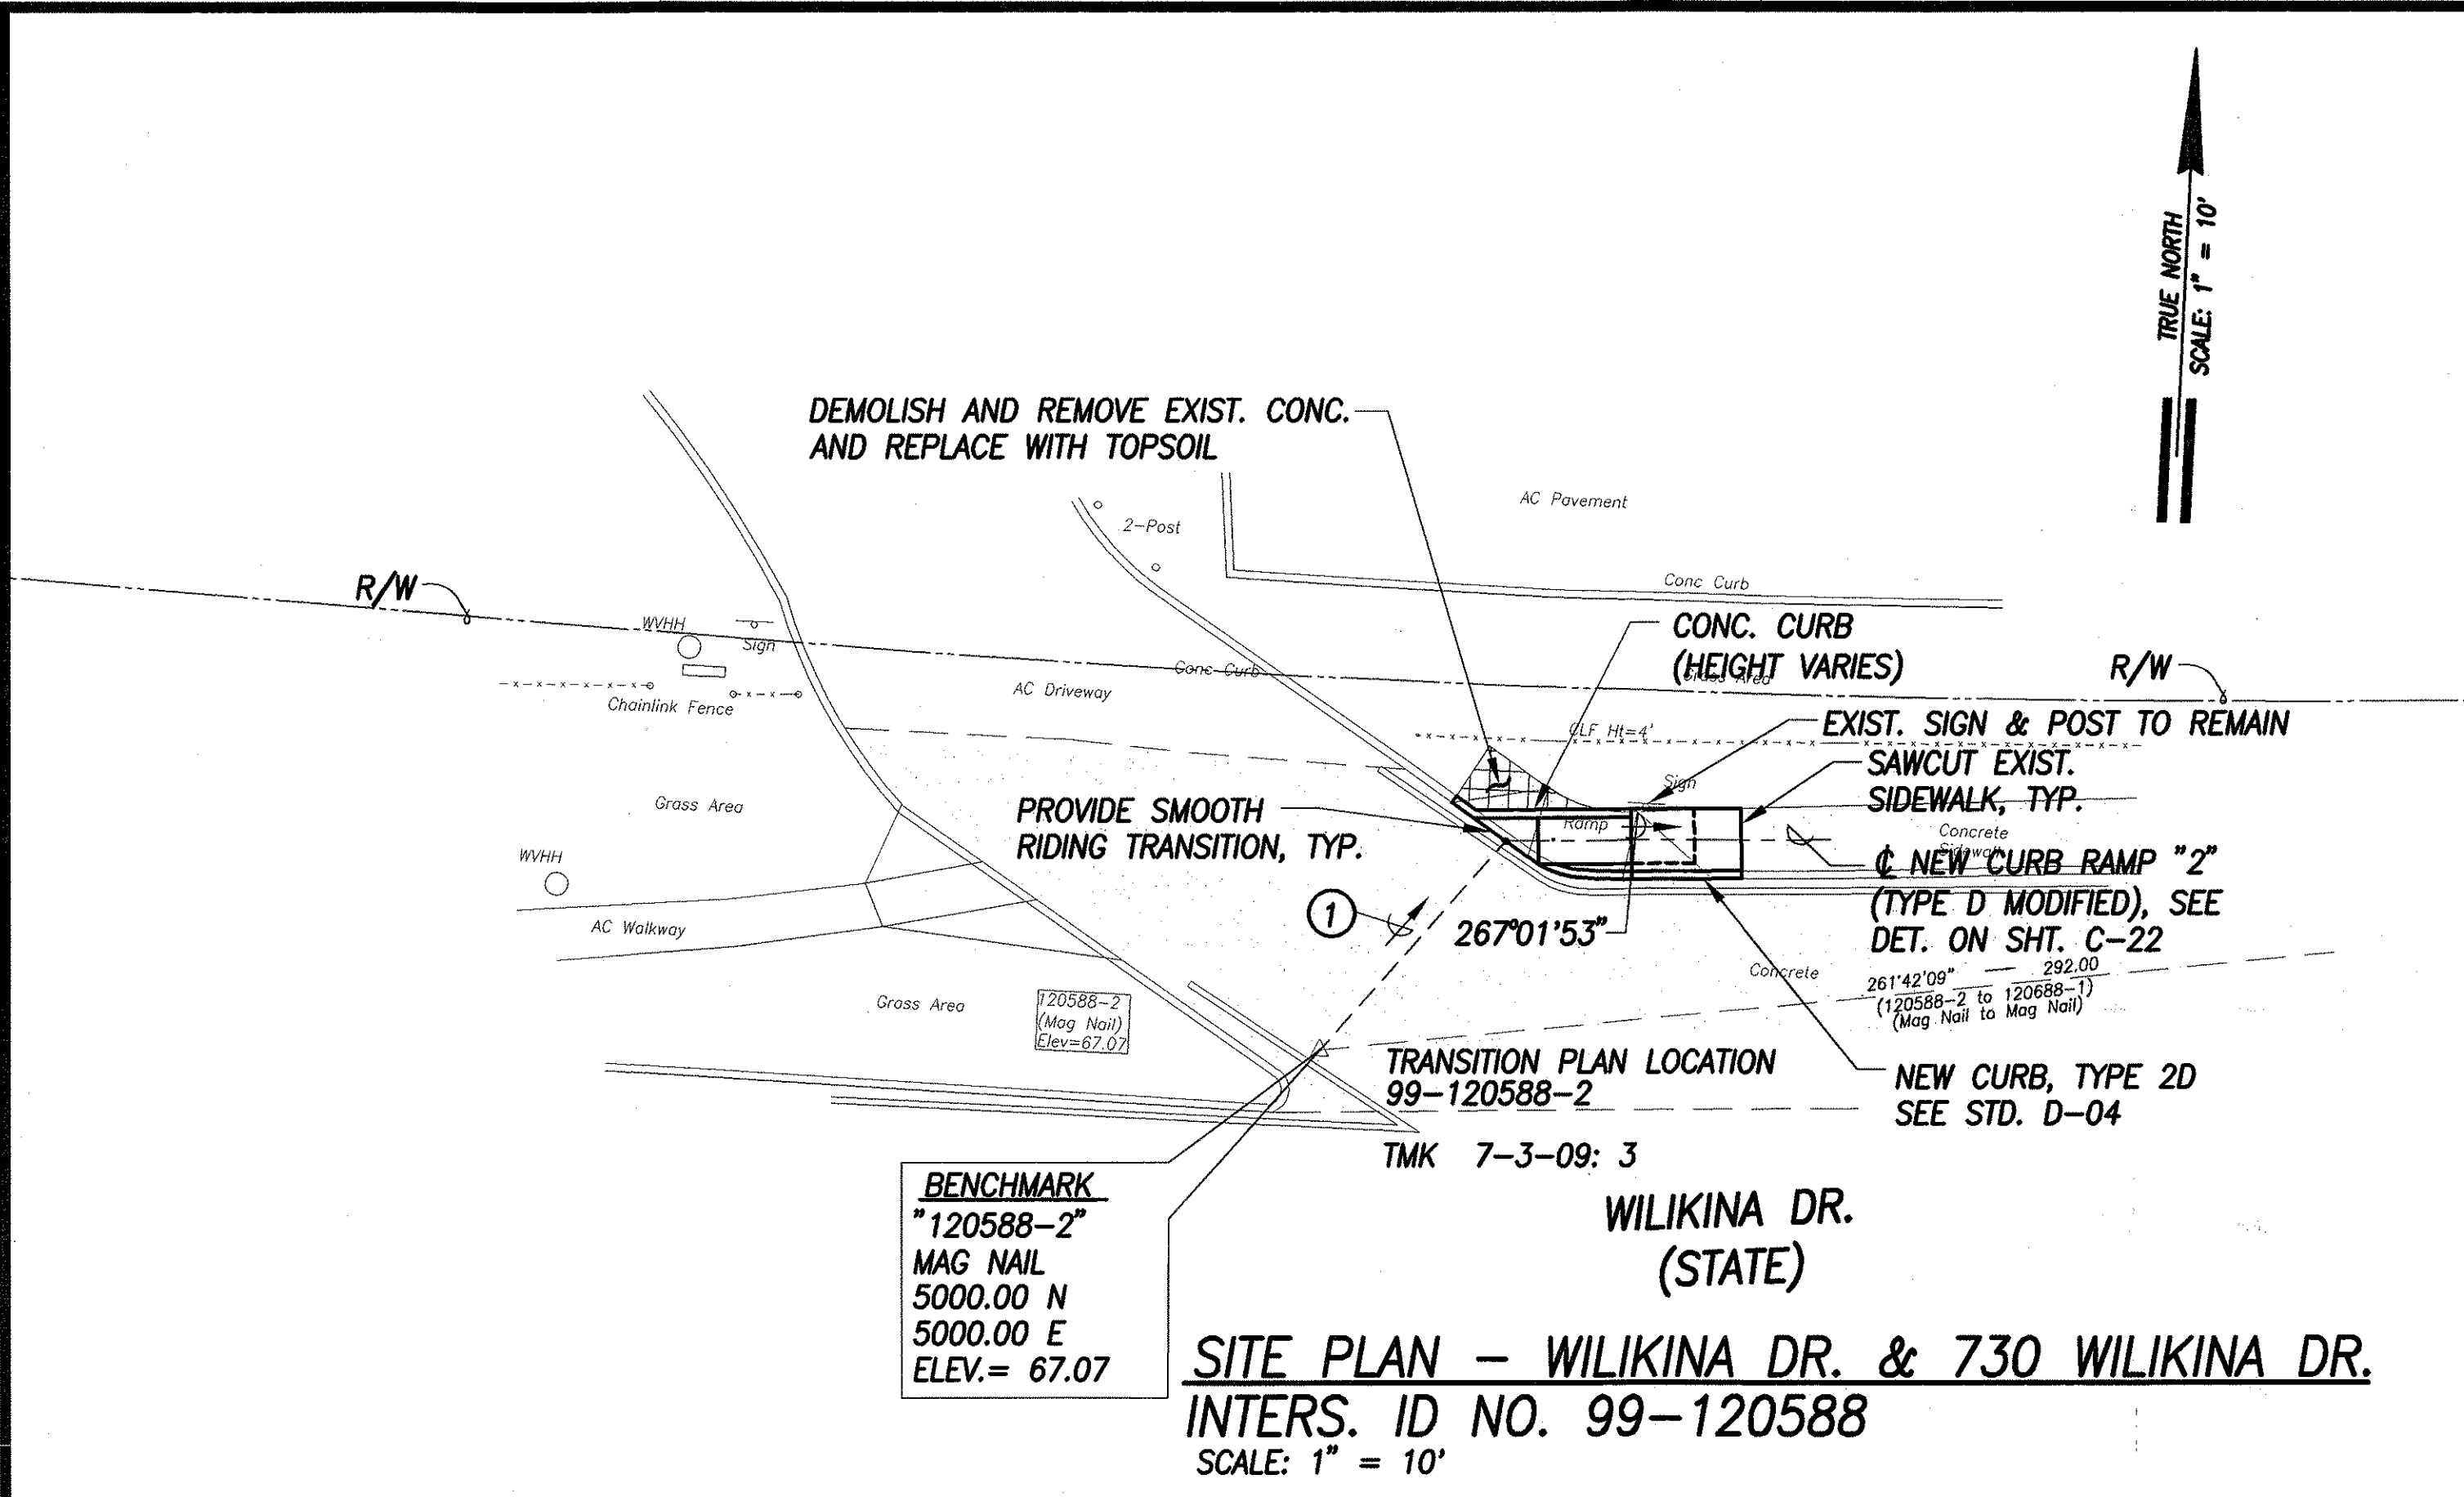

FED. ROAD DIST. NO.	STATE	FED. AID PROJ. NO.	FISCAL YEAR	SHEET NO.	TOTAL SHEETS
HAWAII	HAW.	CMAQ-0300(96)	2004	94	153

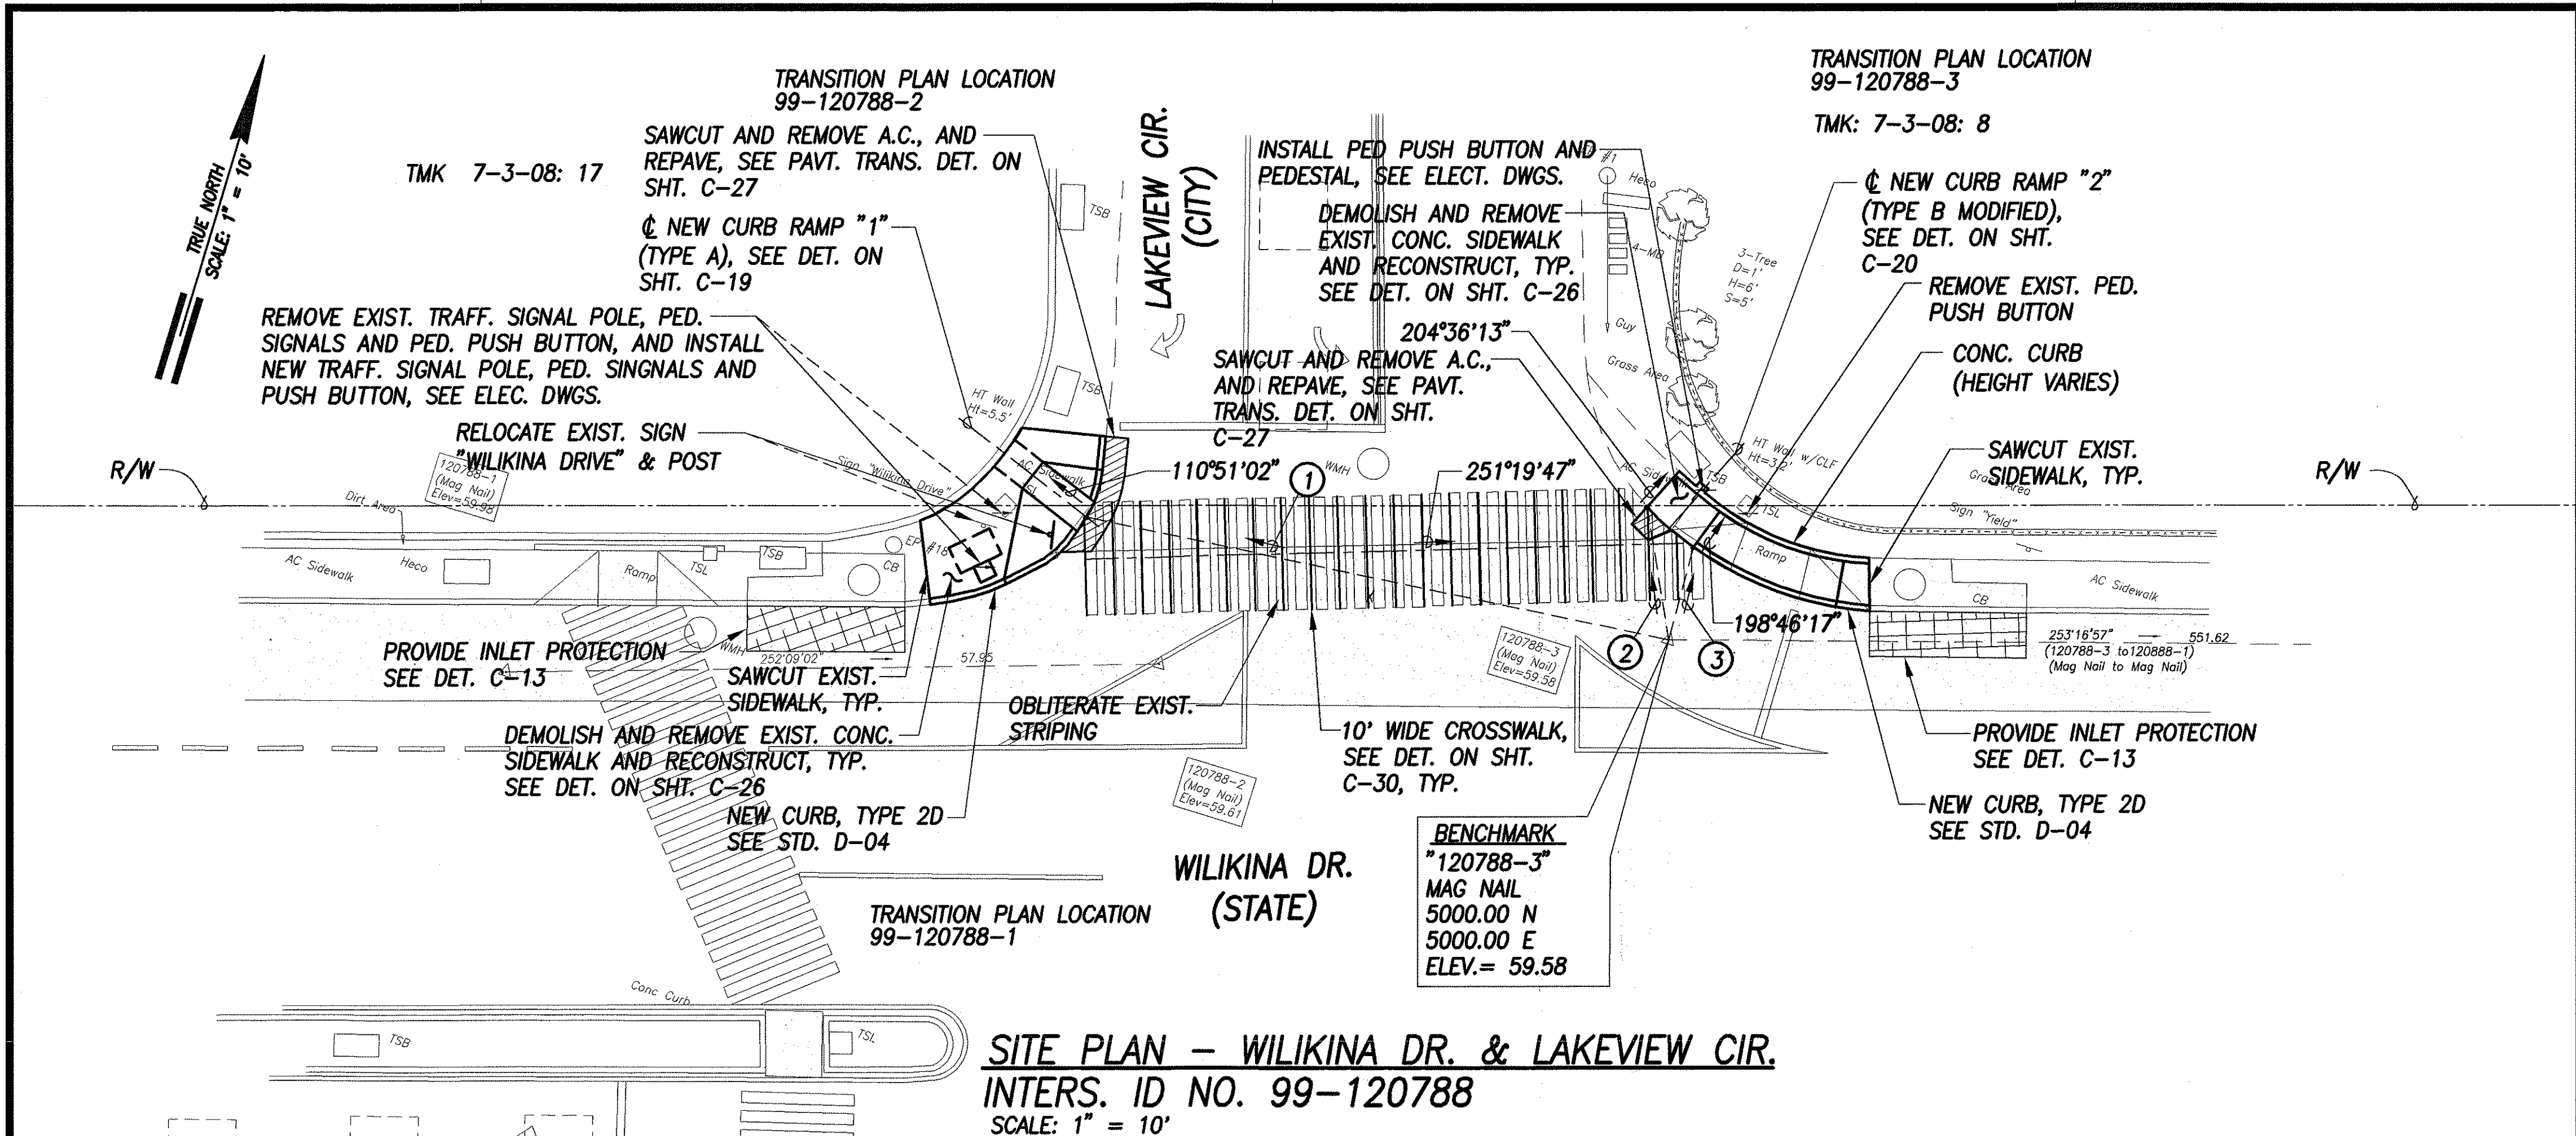

- ① 84°47'12" 52.79'
TIE: BM TO INTERSECTION OF RAMP AND CURB FACE
- ② 153°36'43" 11.99'
TIE: BM TO INTERSECTION OF RAMP EDGE AND CURB FACE
- ③ 177°37'24" 8.53'
TIE: BM TO INTERSECTION OF RAMP EDGE AND CURB FACE

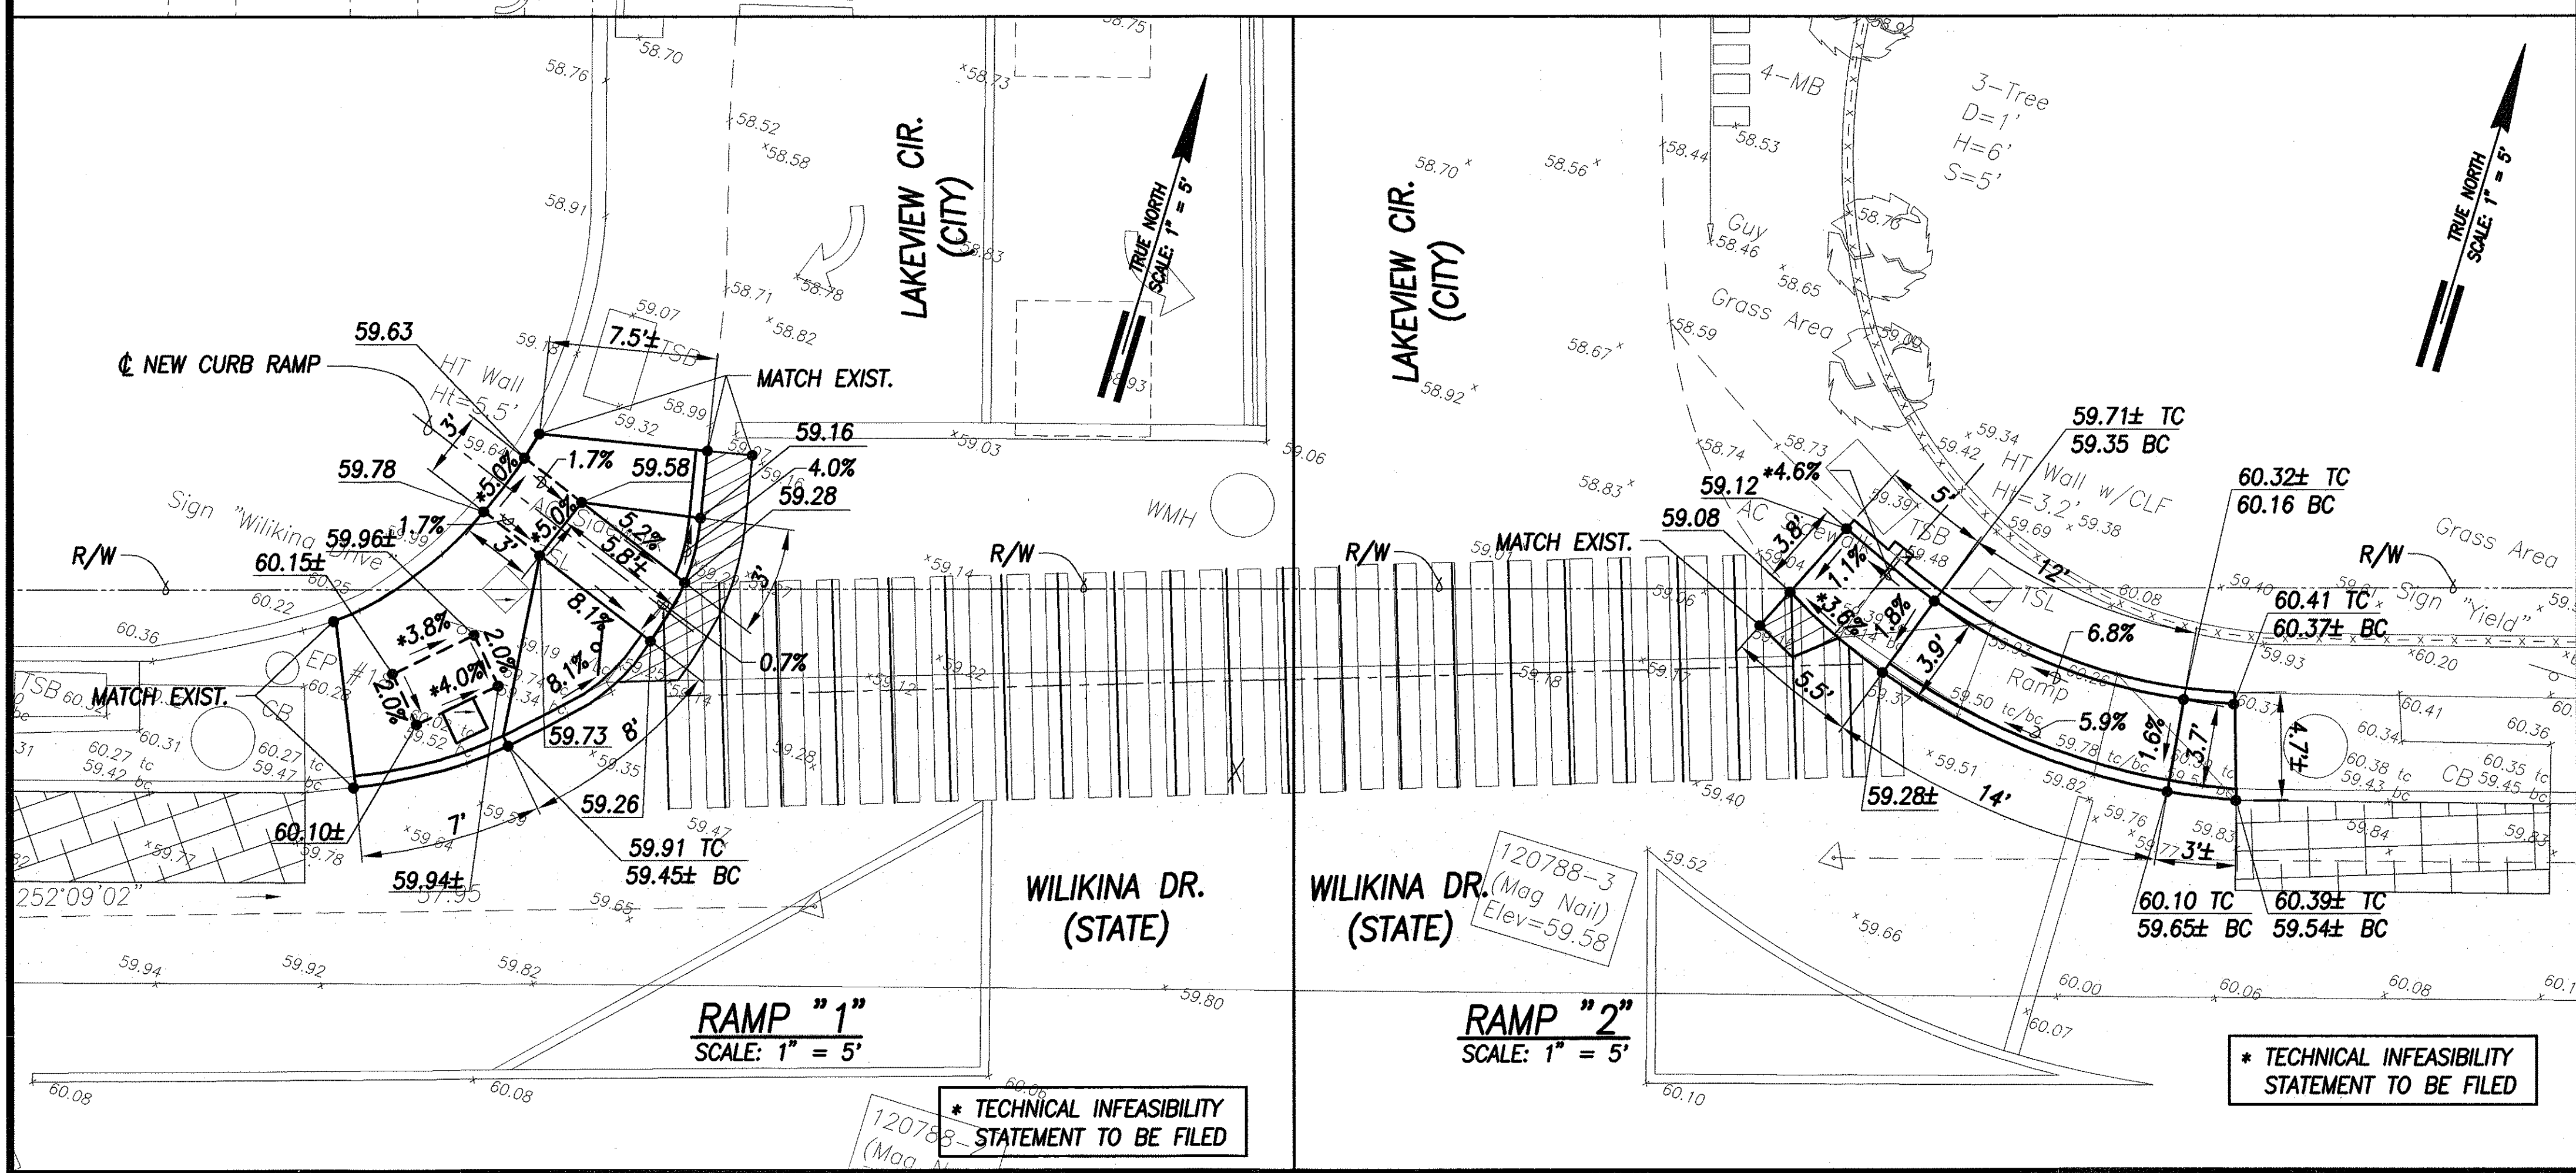

DATE	_____
SURVEY PLOTTED BY	_____
DRAWN BY	_____
TRACED BY	_____
CHECKED BY	_____
ORIGINAL PLAN	_____
NOTE BOOK	_____
No.	_____

GREG H. HIYAKUMOTO
LICENSED PROFESSIONAL ENGINEER
No. 6682-C
HAWAII, U.S.A.





THIS WORK WAS PREPARED BY ME OR UNDER MY SUPERVISION AND CONSTRUCTION OF THIS PROJECT WILL BE UNDER MY OBSERVATION.

DATE 4/30/2006
SIGNATURE _____

"OBSERVATION OF CONSTRUCTION" IS DEFINED IN CHAPTER 16-115, HAWAII ADMINISTRATIVE RULES ENTITLED "PROFESSIONAL ENGINEERS, ARCHITECTS, SURVEYORS AND LANDSCAPE ARCHITECTS".

FED. ROAD DIST. NO.	STATE	FED. AID PROJ. NO.	FISCAL YEAR	SHEET NO.	TOTAL SHEETS
HAWAII	HAW.	CMAQ-0300(96)	2004	95	153

- ① 97°09'23" 8.20'
TIE: BM TO INTERSECTION ϕ OF RAMP AND CURB FACE
- ② 246°37'33" 59.81'
TIE: BM TO INTERSECTION ϕ OF RAMP AND CURB FACE

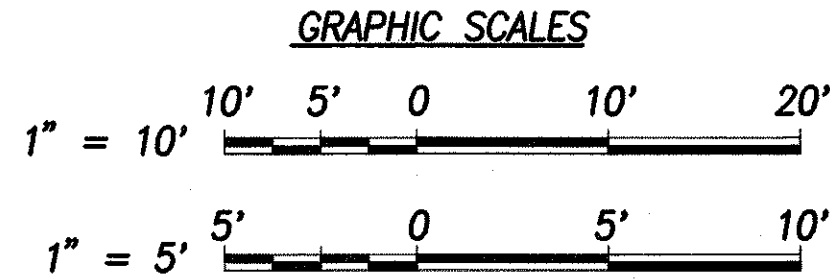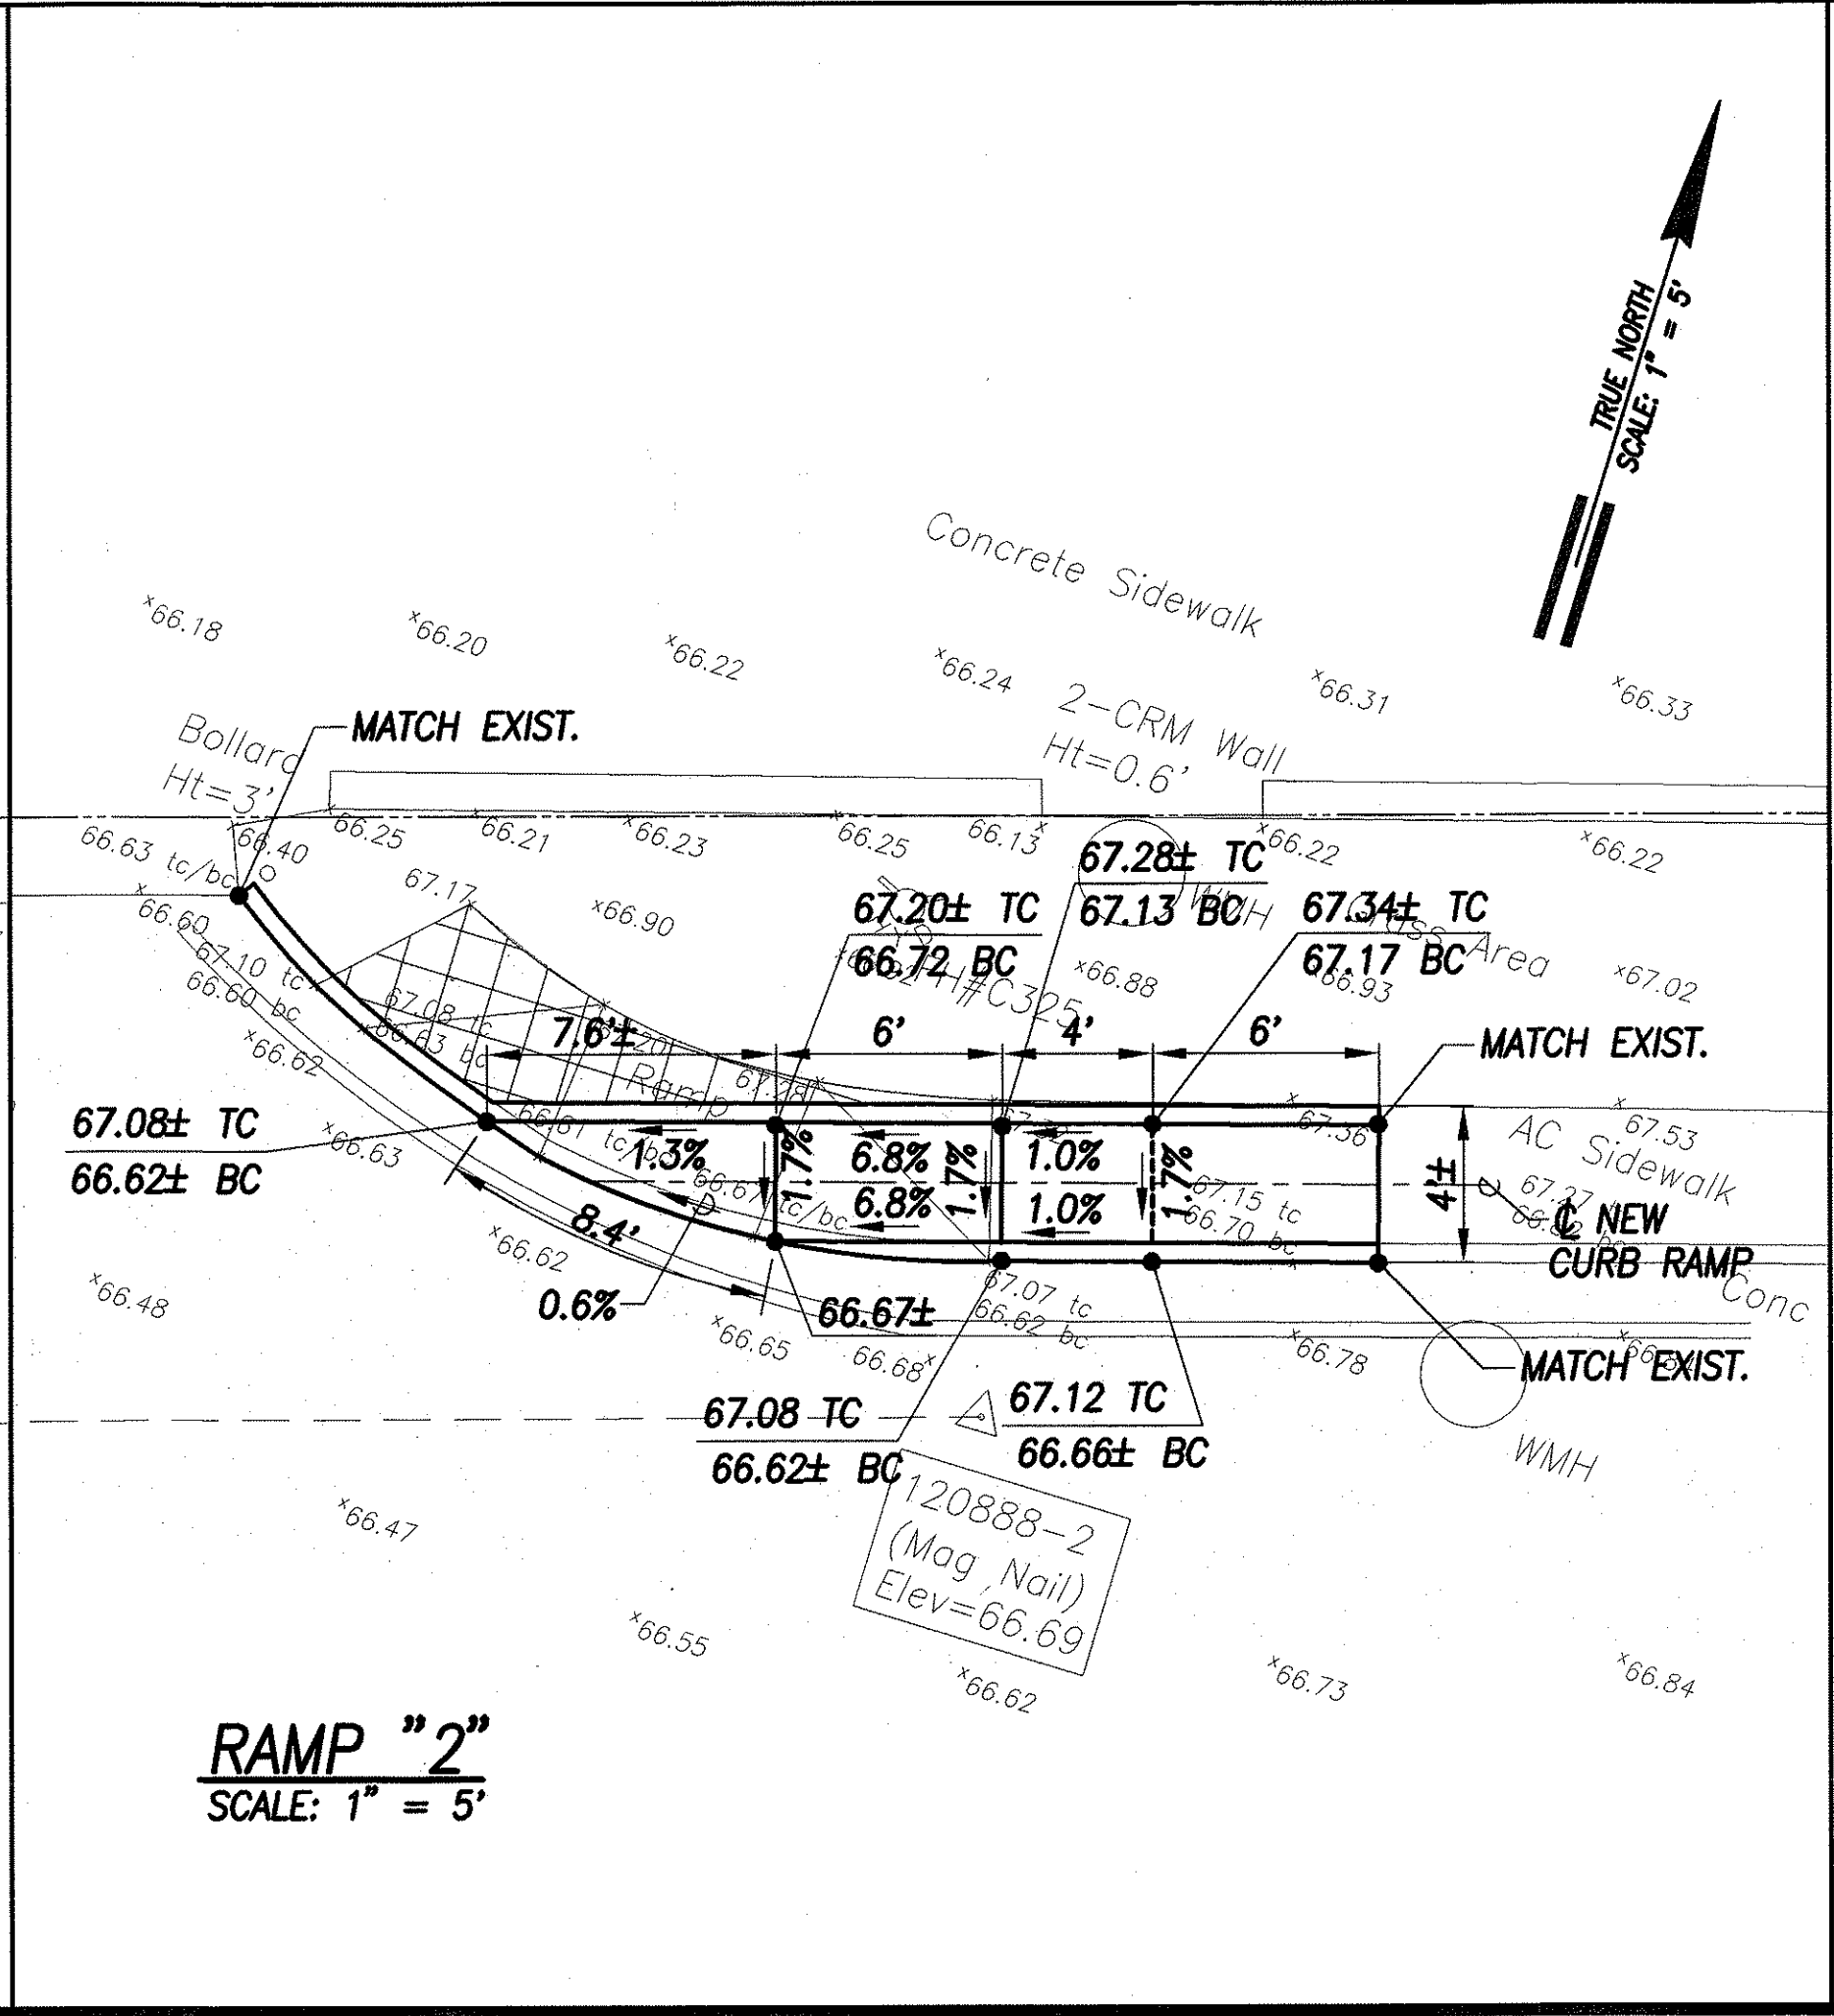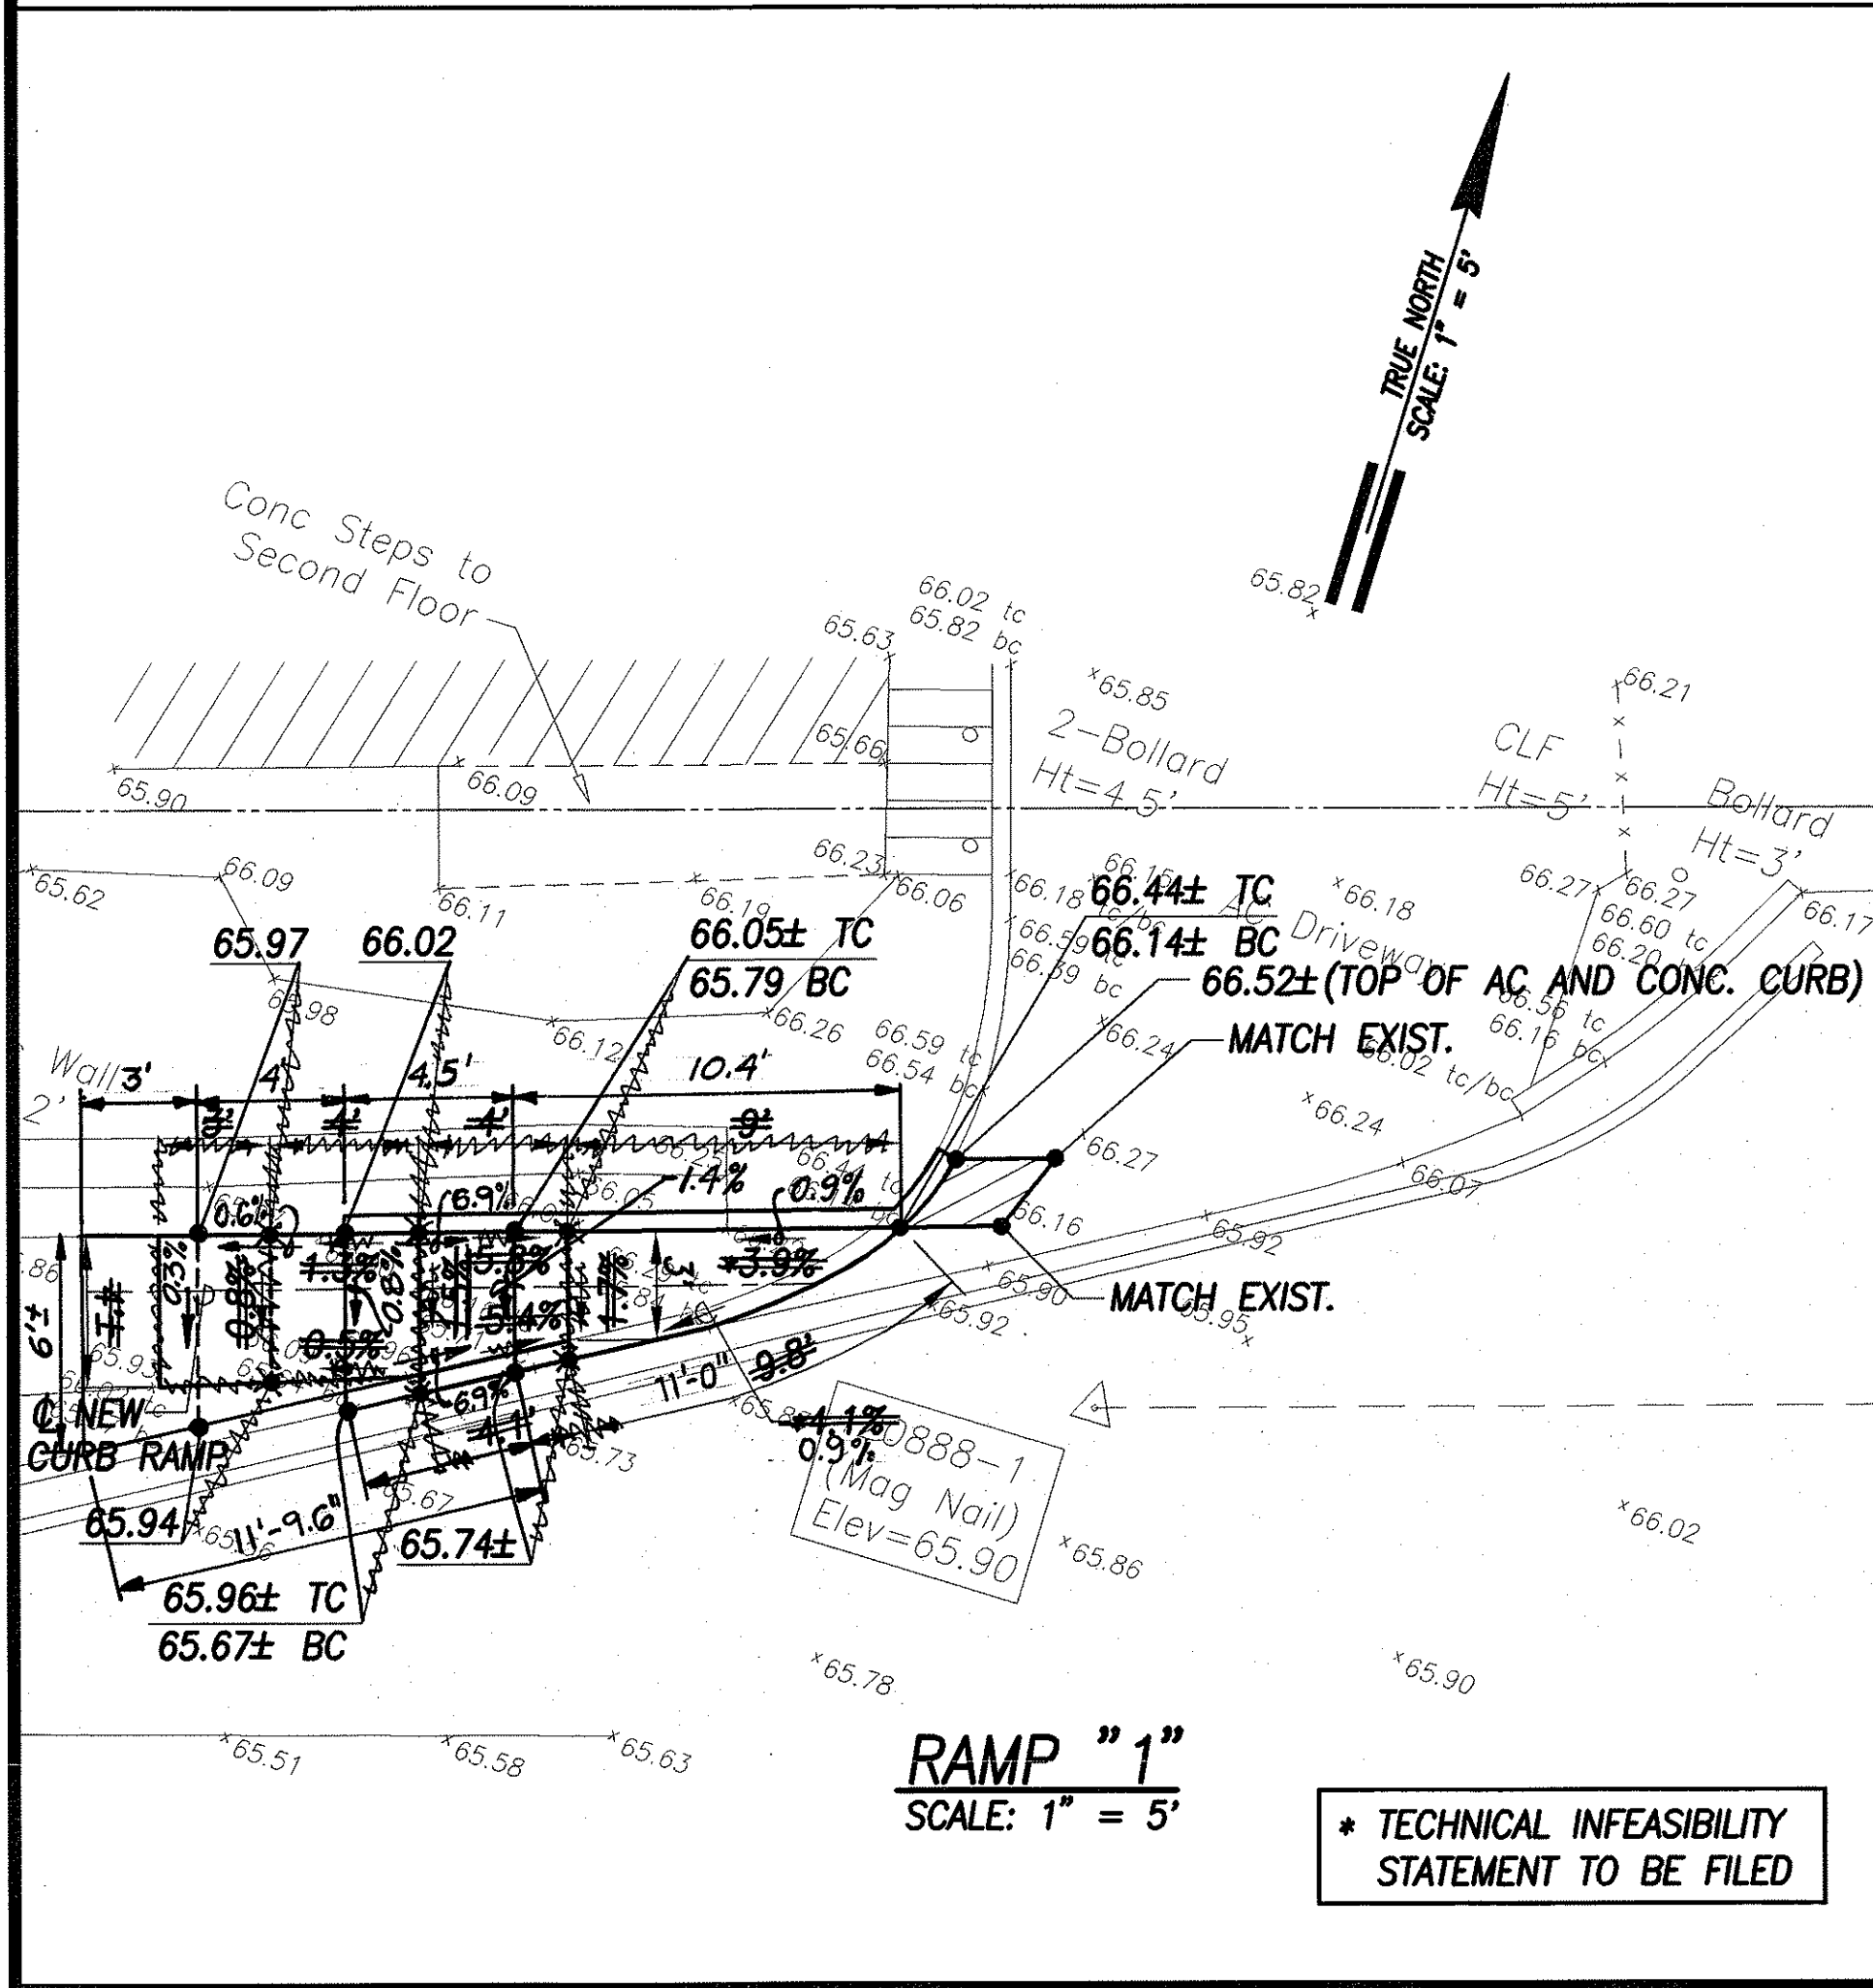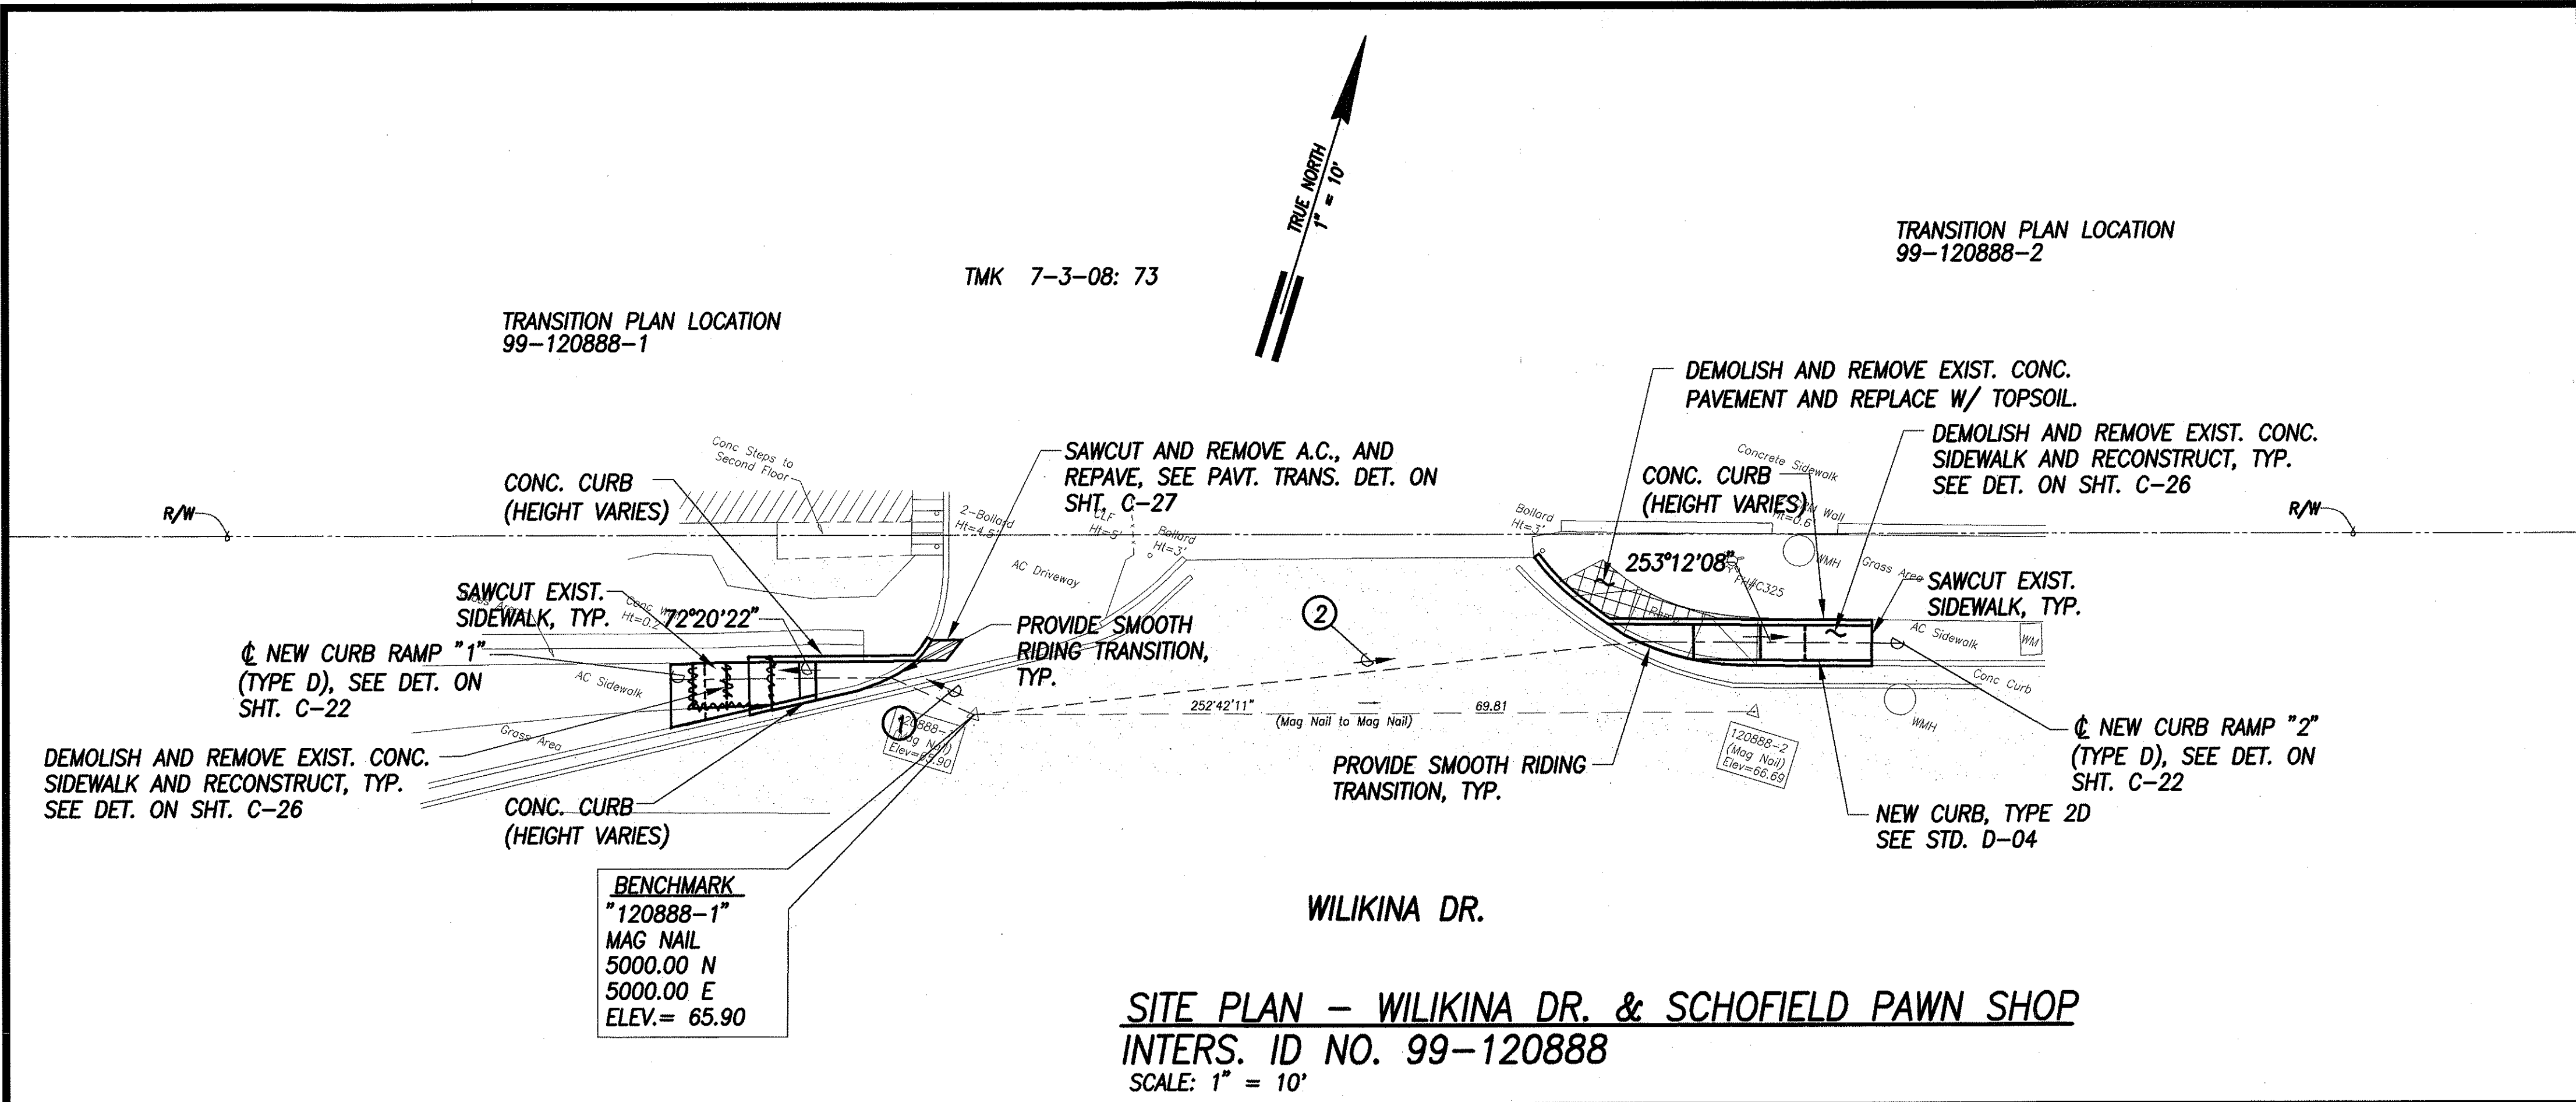

LEGEND	
x 49.52	EXIST. SPOT ELEVATION
52.58	FINISHED SPOT GRADE
51.50 TC	FINISHED TOP OF CURB
51.00 BC	FINISHED BOTTOM OF CURB

DATE	
SURVEY PLANNED BY	
DESIGNED BY	
TRACED BY	
NOTE BOOK	
QUANTITIES BY	
CHECKED BY	
No.	



THIS WORK WAS PREPARED BY ME OR UNDER MY SUPERVISION AND CONSTRUCTION OF THIS PROJECT WILL BE UNDER MY OBSERVATION.

SIGNATURE *Greg H. Hiyakumoto* DATE *April 30, 2006*
"OBSERVATION OF CONSTRUCTION" IS DEFINED IN CHAPTER 16-115, HAWAII ADMINISTRATIVE RULES ENTITLED "PROFESSIONAL ENGINEERS, ARCHITECTS, SURVEYORS AND LANDSCAPE ARCHITECTS"

STATE OF HAWAII
DEPARTMENT OF TRANSPORTATION
HIGHWAYS DIVISION

SITE & GRADING PLAN
WILIKINA DR. & SCHOFIELD PAWN SHOP

Pedestrian Facilities & ADA Compliance at Various Locations on Oahu, Unit 5
Fed. Aid Proj. No. CMAQ-0300(96)

Scale: AS SHOWN Date: August, 2004

SHEET No. C-94 OF 153 SHEETS

TRANSITION PLAN LOCATION
99-121288-1



TRANSITION PLAN LOCATION
99-121288-2

TRANSITION PLAN LOCATION
99-121388-1

FED. ROAD DIST. NO.	STATE	FED. AID PROJ. NO.	FISCAL YEAR	SHEET NO.	TOTAL SHEETS
HAWAII	HAW.	CMAQ-0300(96)	2004	99	153

TMK 7-3-01: 2

TRANSITION PLAN LOCATION
99-121388-2

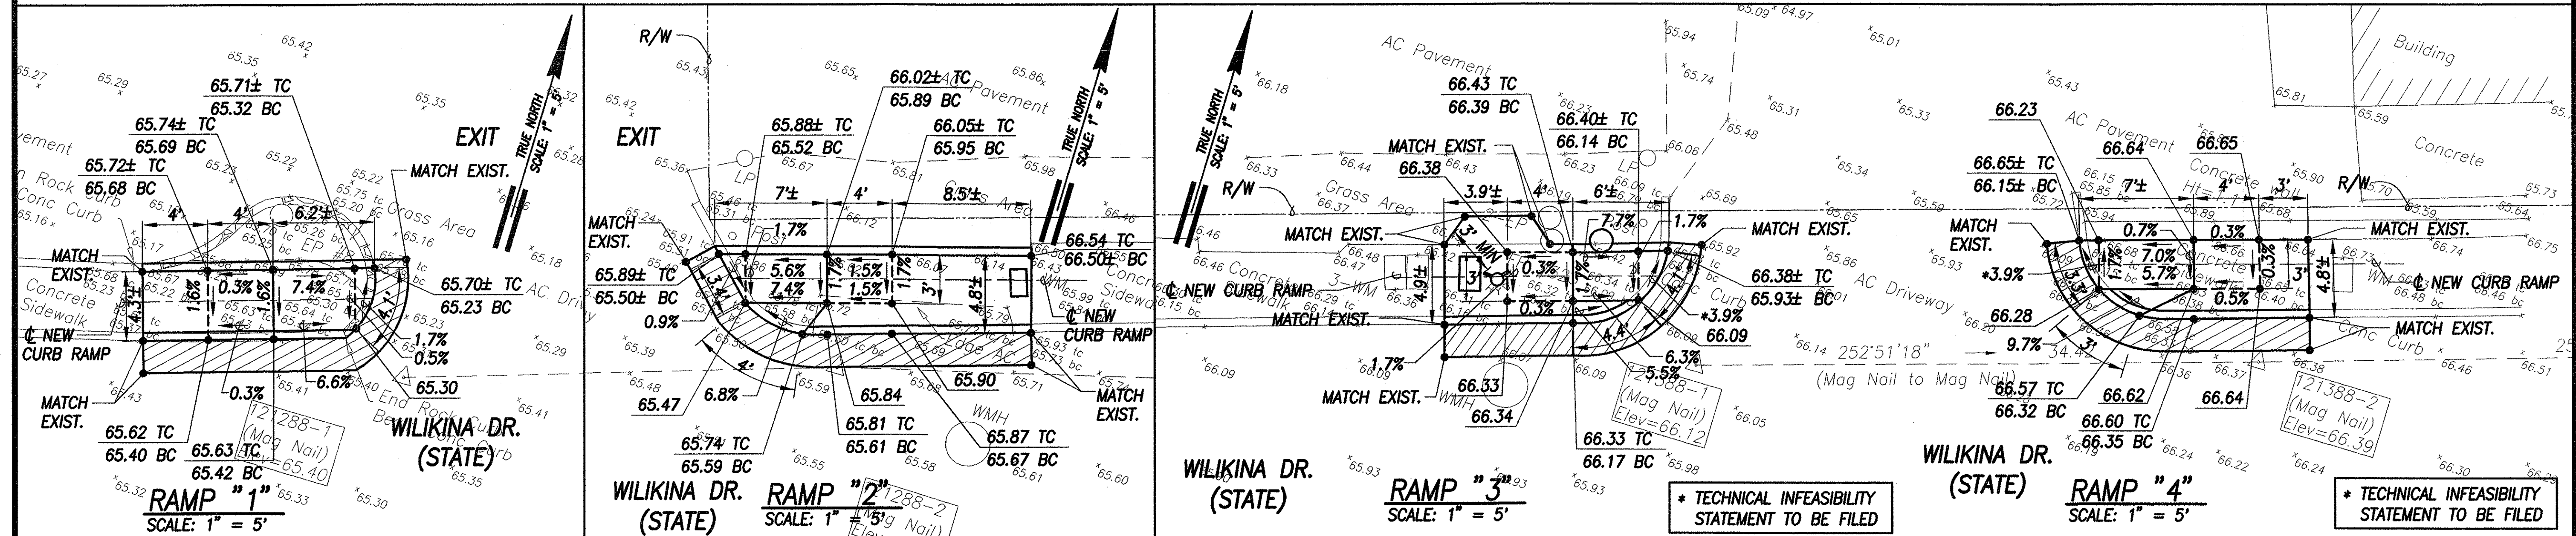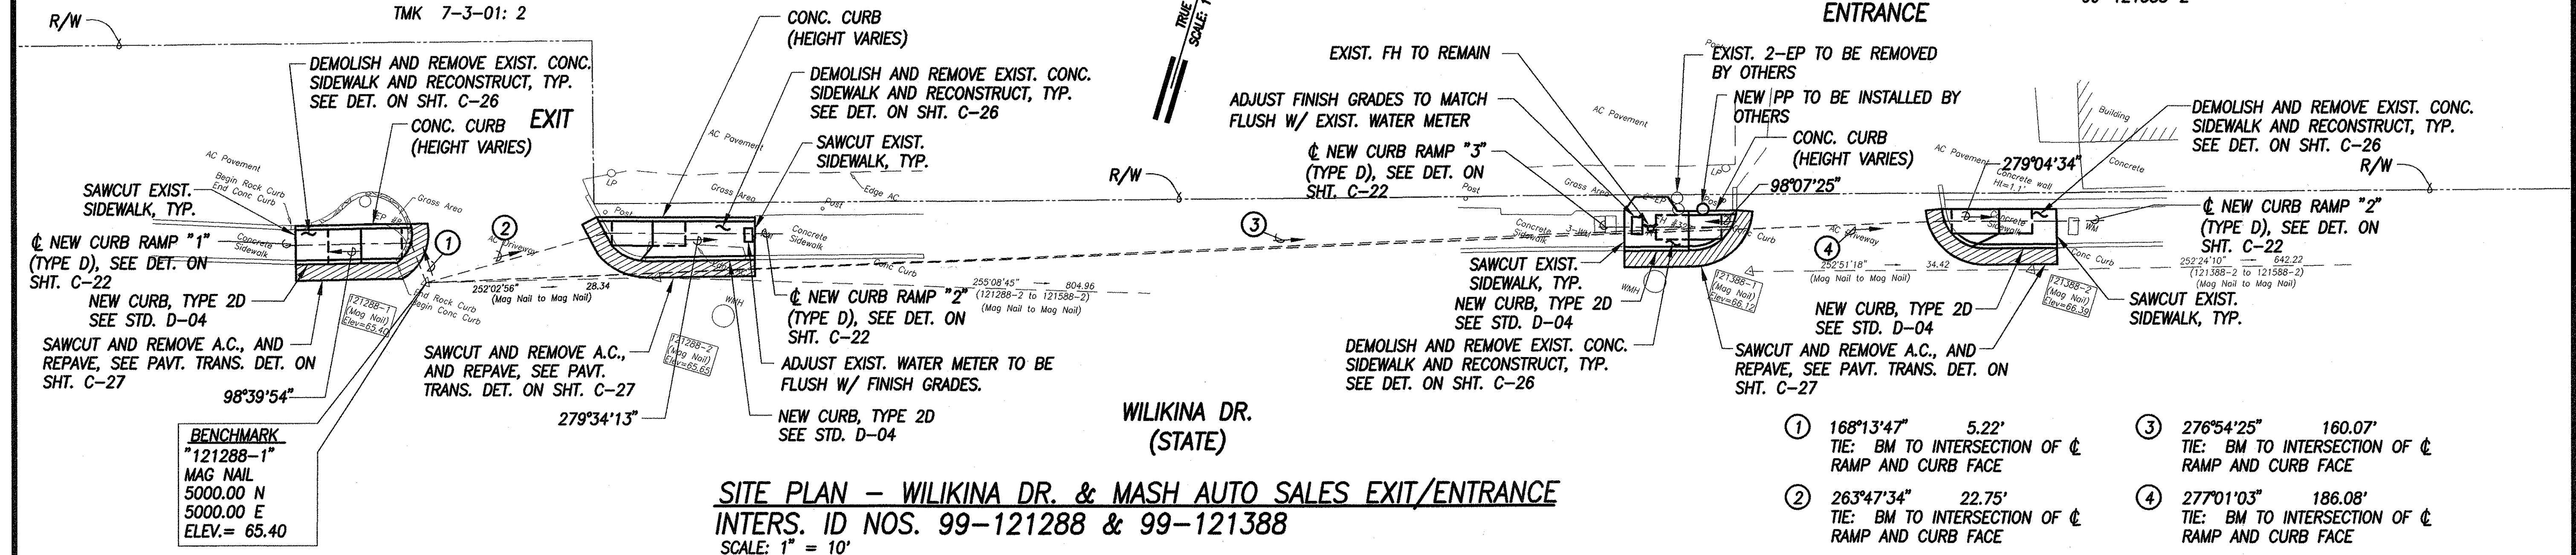

GRADING PLAN - WILIKINA DR. & MASH AUTO SALES EXIT/ENTRANCE
INTERS. ID NOS. 99-121288 & 99-121388
SCALE: 1" = 5'

LEGEND

x 49.52 EXIST. SPOT ELEVATION

52.58 FINISHED SPOT GRADE

51.50 TC FINISHED TOP OF CURB

51.00 BC FINISHED BOTTOM OF CURB

[Signature] 6/24/04
Principal Executive
Maintenance Unit, BWS
Date

GREG H. HIYAKUMOTO
LICENSED
PROFESSIONAL
ENGINEER
No. 6662-C
HAWAII, U.S.A.


THIS WORK WAS PREPARED BY ME OR UNDER MY SUPERVISION AND CONSTRUCTION OF THIS PROJECT WILL BE UNDER MY OBSERVATION.

[Signature] April 30, 2006
DATE

"OBSERVATION OF CONSTRUCTION" IS DEFINED IN CHAPTER 16-115, HAWAII ADMINISTRATIVE RULES ENTITLED "PROFESSIONAL ENGINEERS, ARCHITECTS, SURVEYORS AND LANDSCAPE ARCHITECTS".


STATE OF HAWAII
DEPARTMENT OF TRANSPORTATION
HIGHWAYS DIVISION
SITE & GRADING PLAN
WILIKINA DR. & MASH AUTO SALES EXIT/ENTRANCE
Pedestrian Facilities & ADA Compliance
at Various Locations on Oahu, Unit 5
Fed. Aid Proj. No. CMAQ-0300(96)
Scale: AS SHOWN Date: August 2004
SHEET No. C-98 OF 153 SHEETS

FED. ROAD DIST. NO.	STATE	FED. AID PROJ. NO.	FISCAL YEAR	SHEET NO.	TOTAL SHEETS
HAWAII	HAW.	CMAQ-0300(96)	2004	100	153

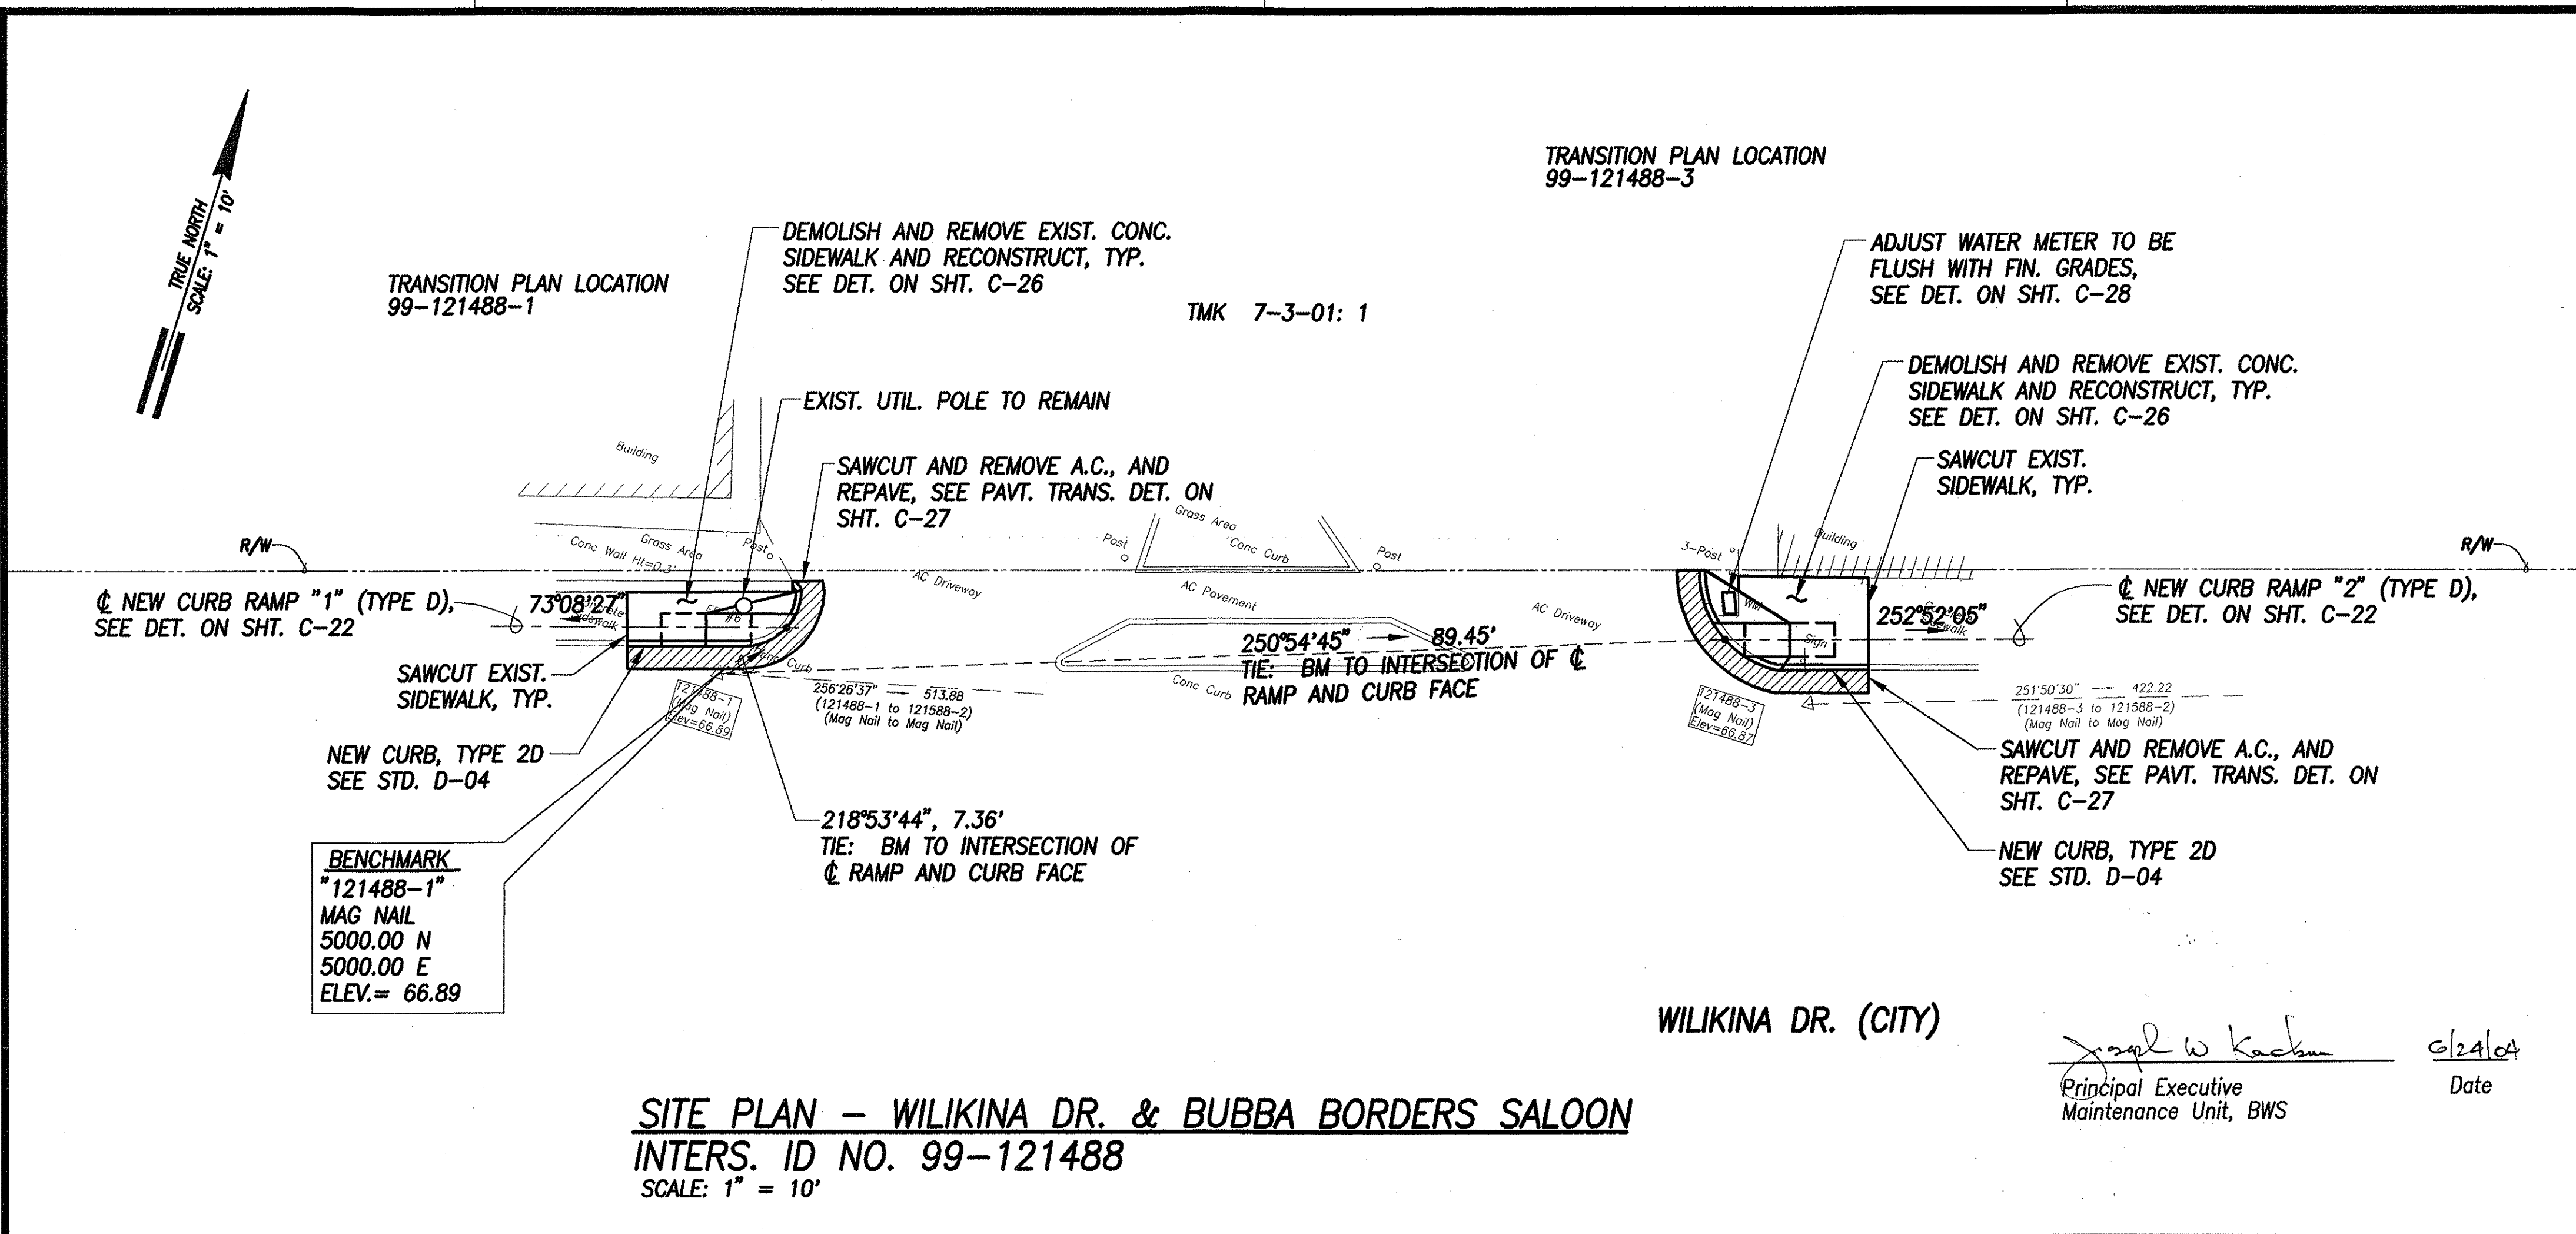


LEGEND

× 49.52	EXIST. SPOT ELEVATION
52.58	FINISHED SPOT GRADE
51.50 TC	FINISHED TOP OF CURB
51.00 BC	FINISHED BOTTOM OF CURB

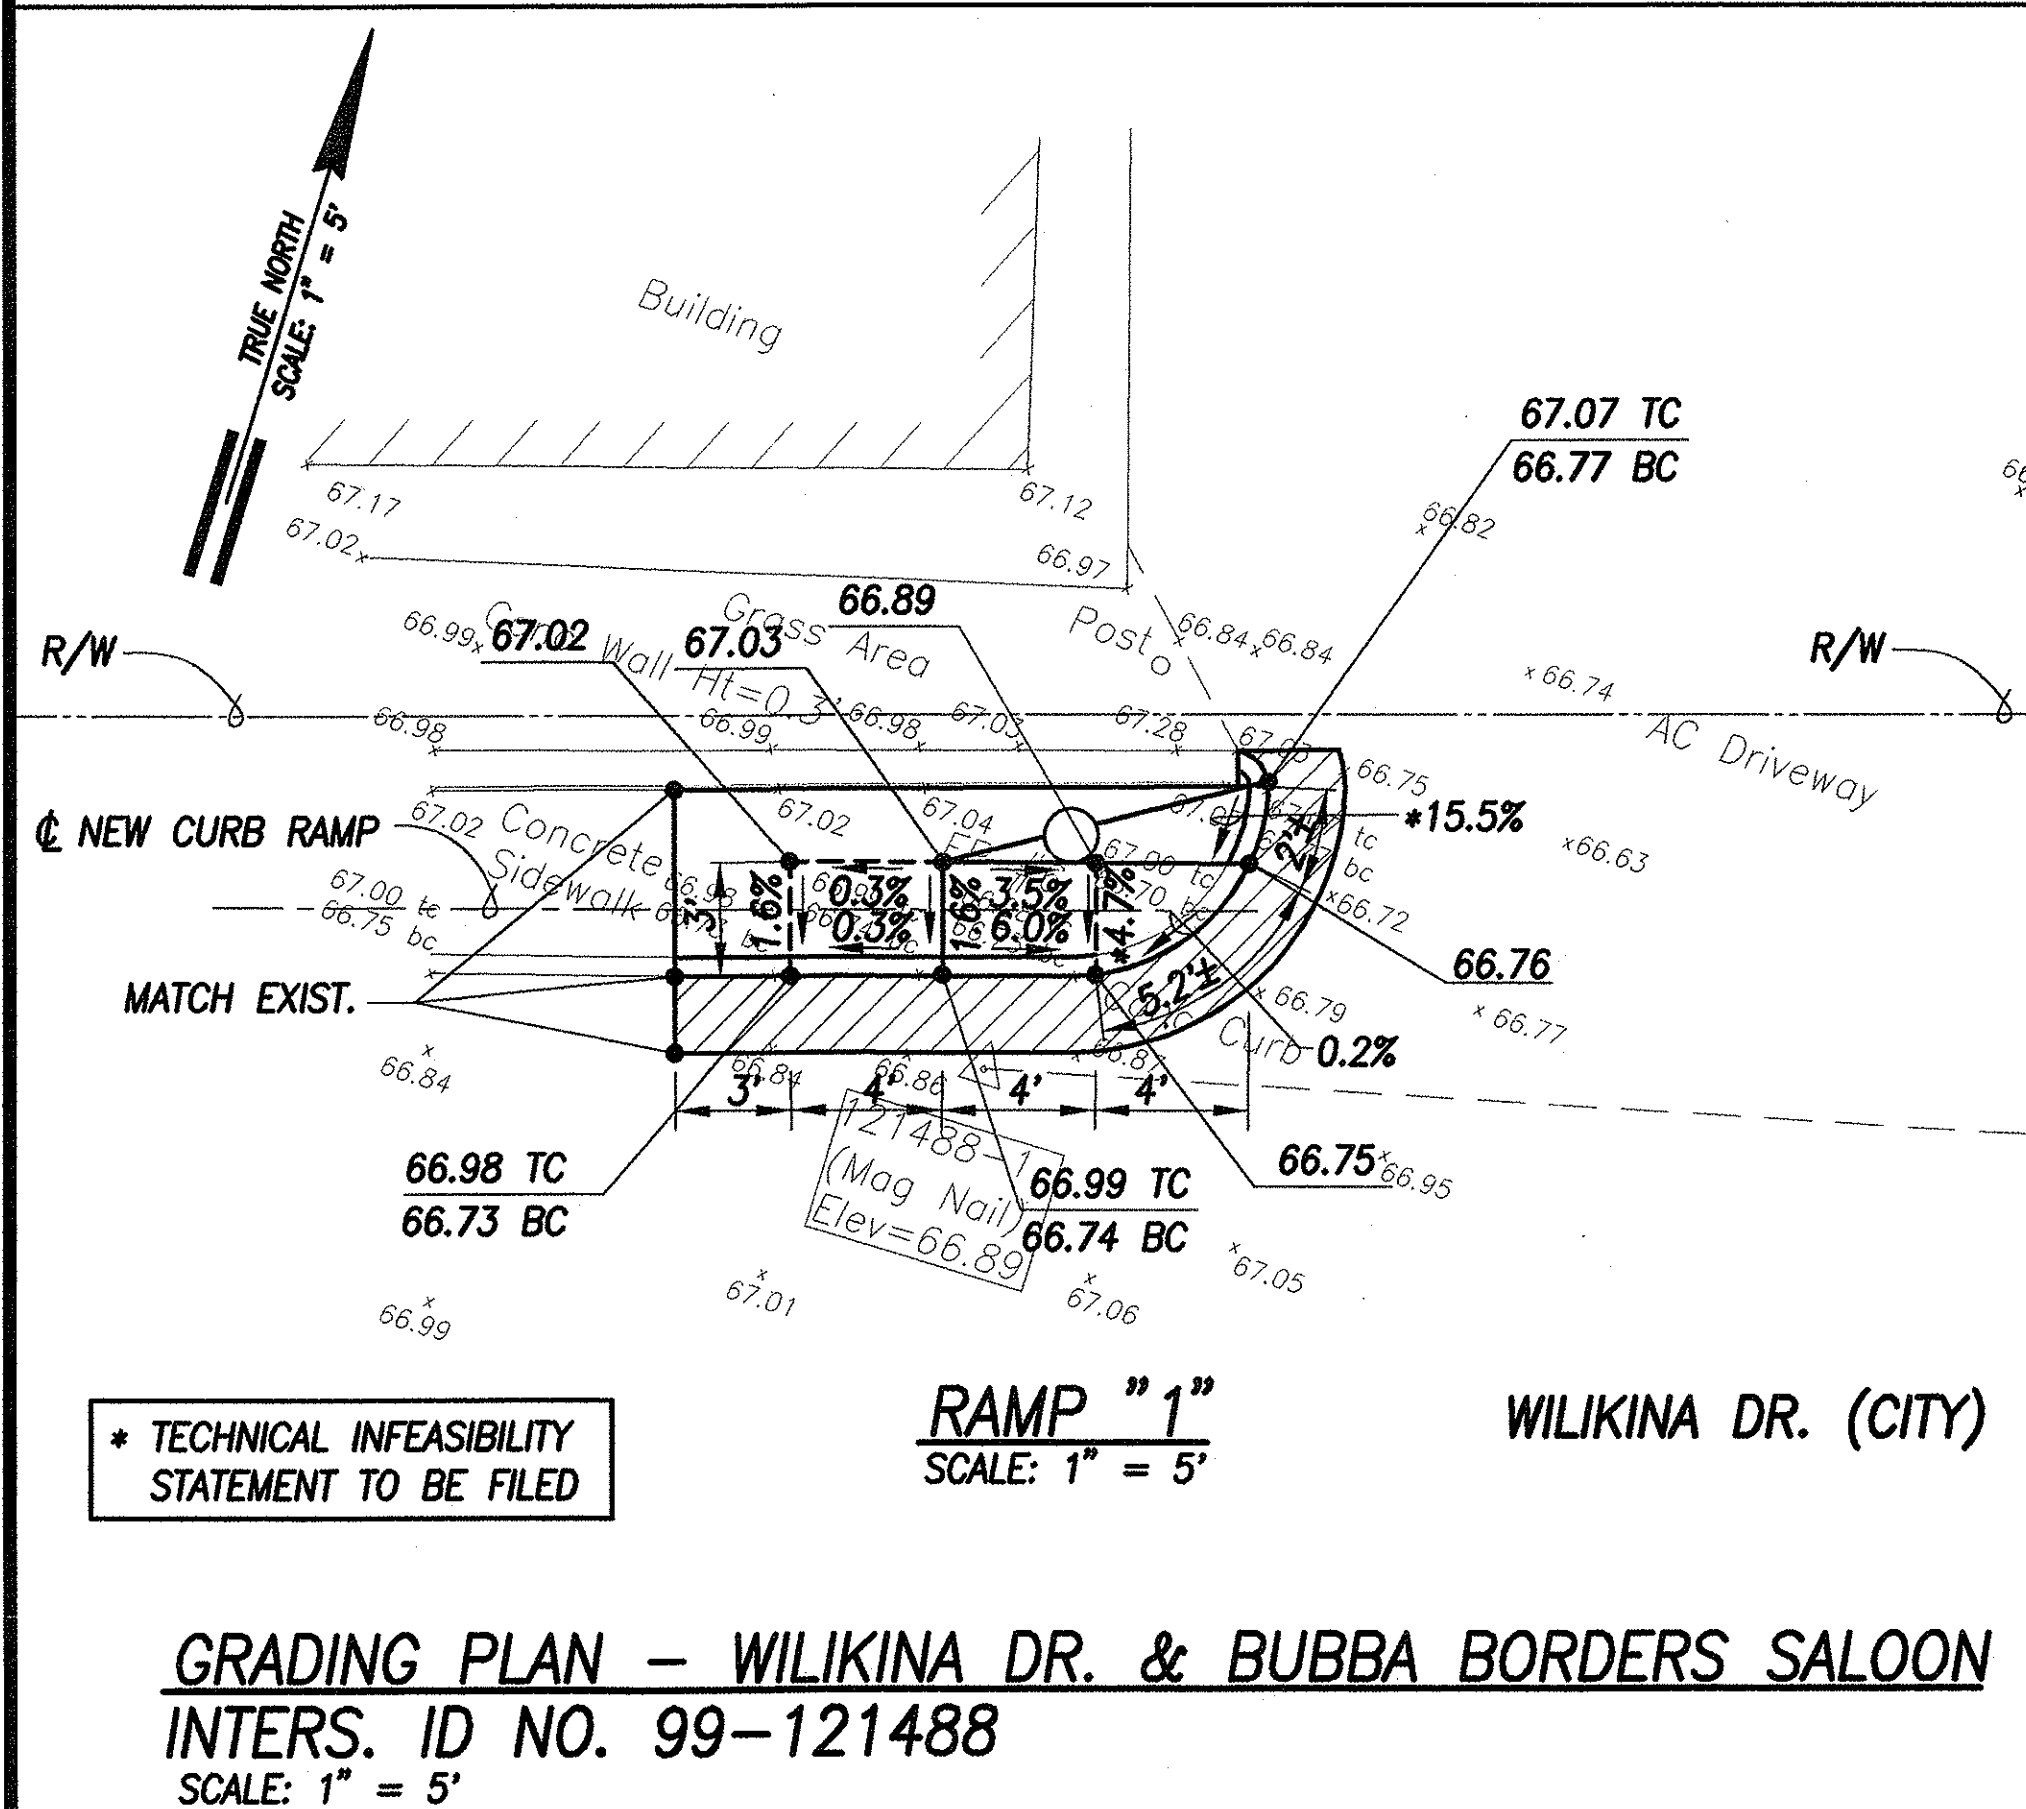

FED. ROAD DIST. NO.	STATE	FED. AID PROJ. NO.	FISCAL YEAR	SHEET NO.	TOTAL SHEETS
HAWAII	HAW.	CMAQ-0300(198)	2004	103	153

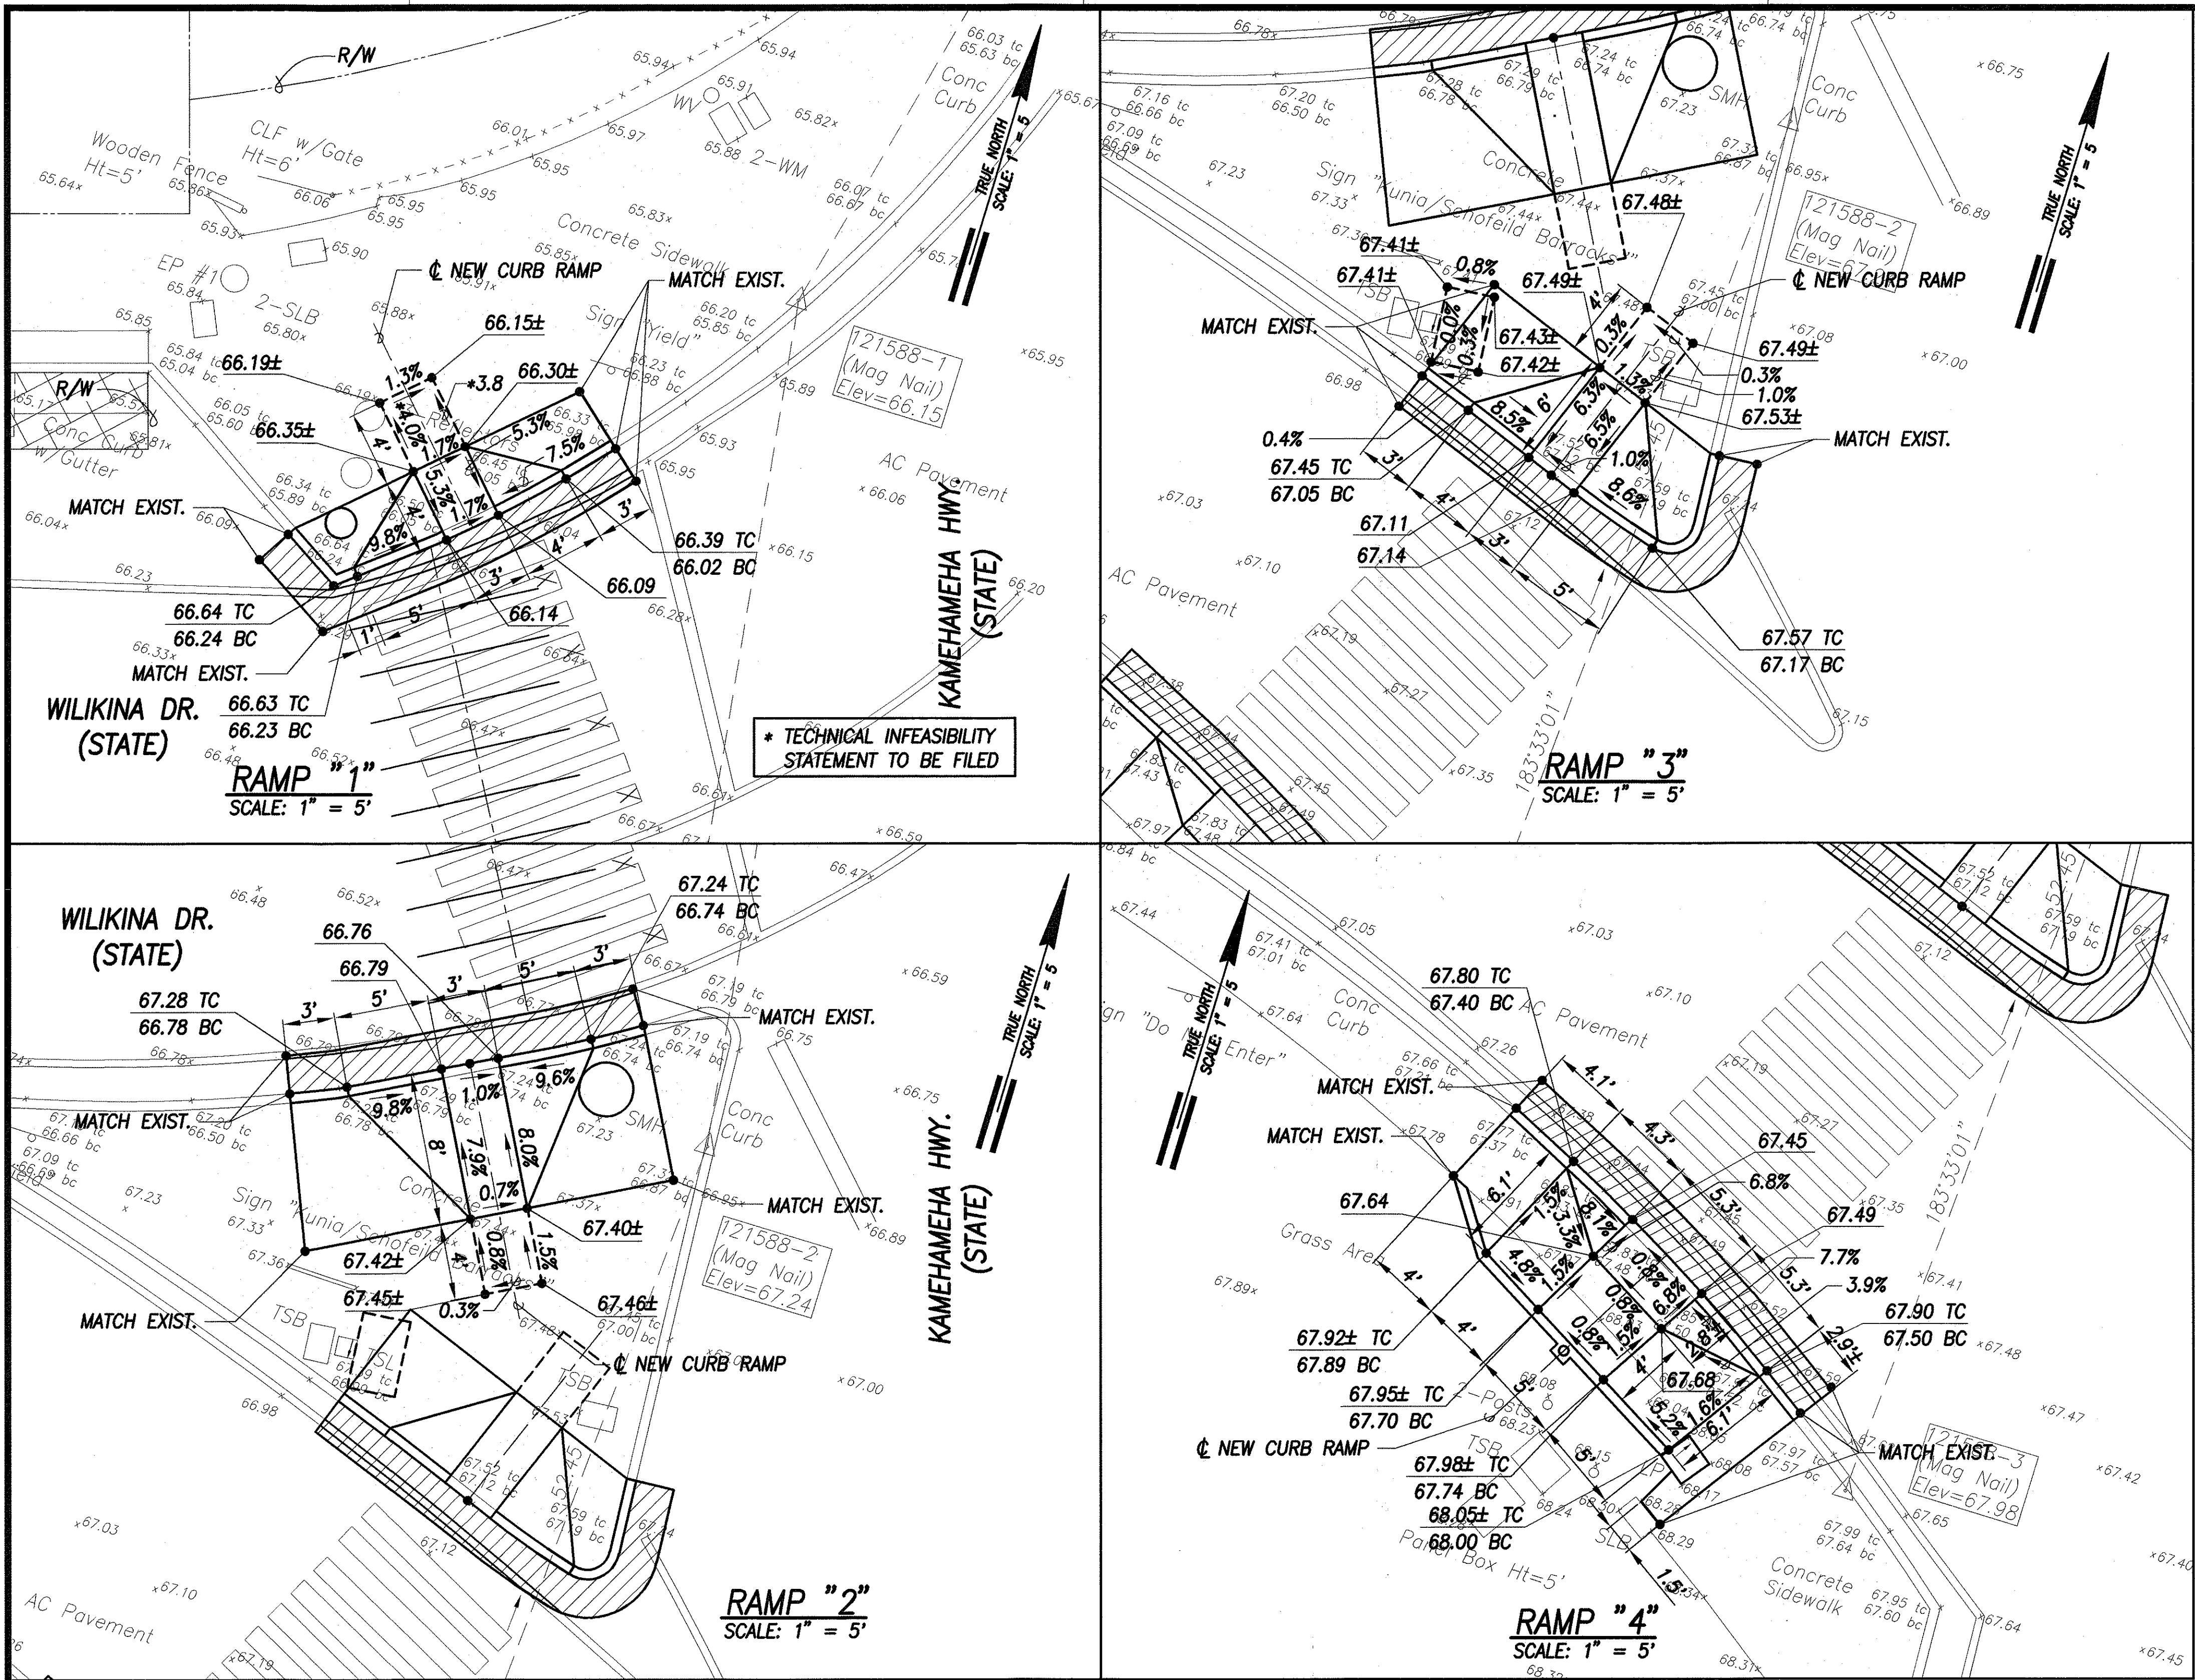

DATE	_____
SURVEY PLOTTED BY	_____
DRAWN BY	_____
TRACED BY	_____
QUANTITIES BY	_____
CHECKED BY	_____
ORIGINAL PLAN	_____
NOTE BOOK	_____
No.	_____

GRADING PLAN - WILIKINA DR. & KAMEHAMEHA HWY.
 INTERS. ID NO. 99-121588
 SCALE: 1" = 5'



THIS WORK WAS PREPARED BY ME OR UNDER MY SUPERVISION AND CONSTRUCTION OF THIS PROJECT WILL BE UNDER MY OBSERVATION.

Signature: *Greg H. Hiyakumoto* April 30, 2006
 SIGNATURE DATE

"OBSERVATION OF CONSTRUCTION" IS DEFINED IN CHAPTER 16-115, HAWAII ADMINISTRATIVE RULES ENTITLED "PROFESSIONAL ENGINEERS, ARCHITECTS, SURVEYORS AND LANDSCAPE ARCHITECTS."

STATE OF HAWAII
 DEPARTMENT OF TRANSPORTATION
 HIGHWAYS DIVISION



GRADING PLAN - WILIKINA DR. & KAMEHAMEHA HWY. - 1

Pedestrian Facilities & ADA Compliance at Various Locations on Oahu, Unit 5
 Fed. Aid Proj. No. CMAQ-0300(96)

Scale: 1" = 5'-0" Date: August 2004


SHEET No. C-102 OF 153 SHEETS

FED. ROAD DIST. NO.	STATE	FED. AID PROJ. NO.	FISCAL YEAR	SHEET NO.	TOTAL SHEETS
HAWAII	HAW.	CMAQ-0300(96)	2004	105	153

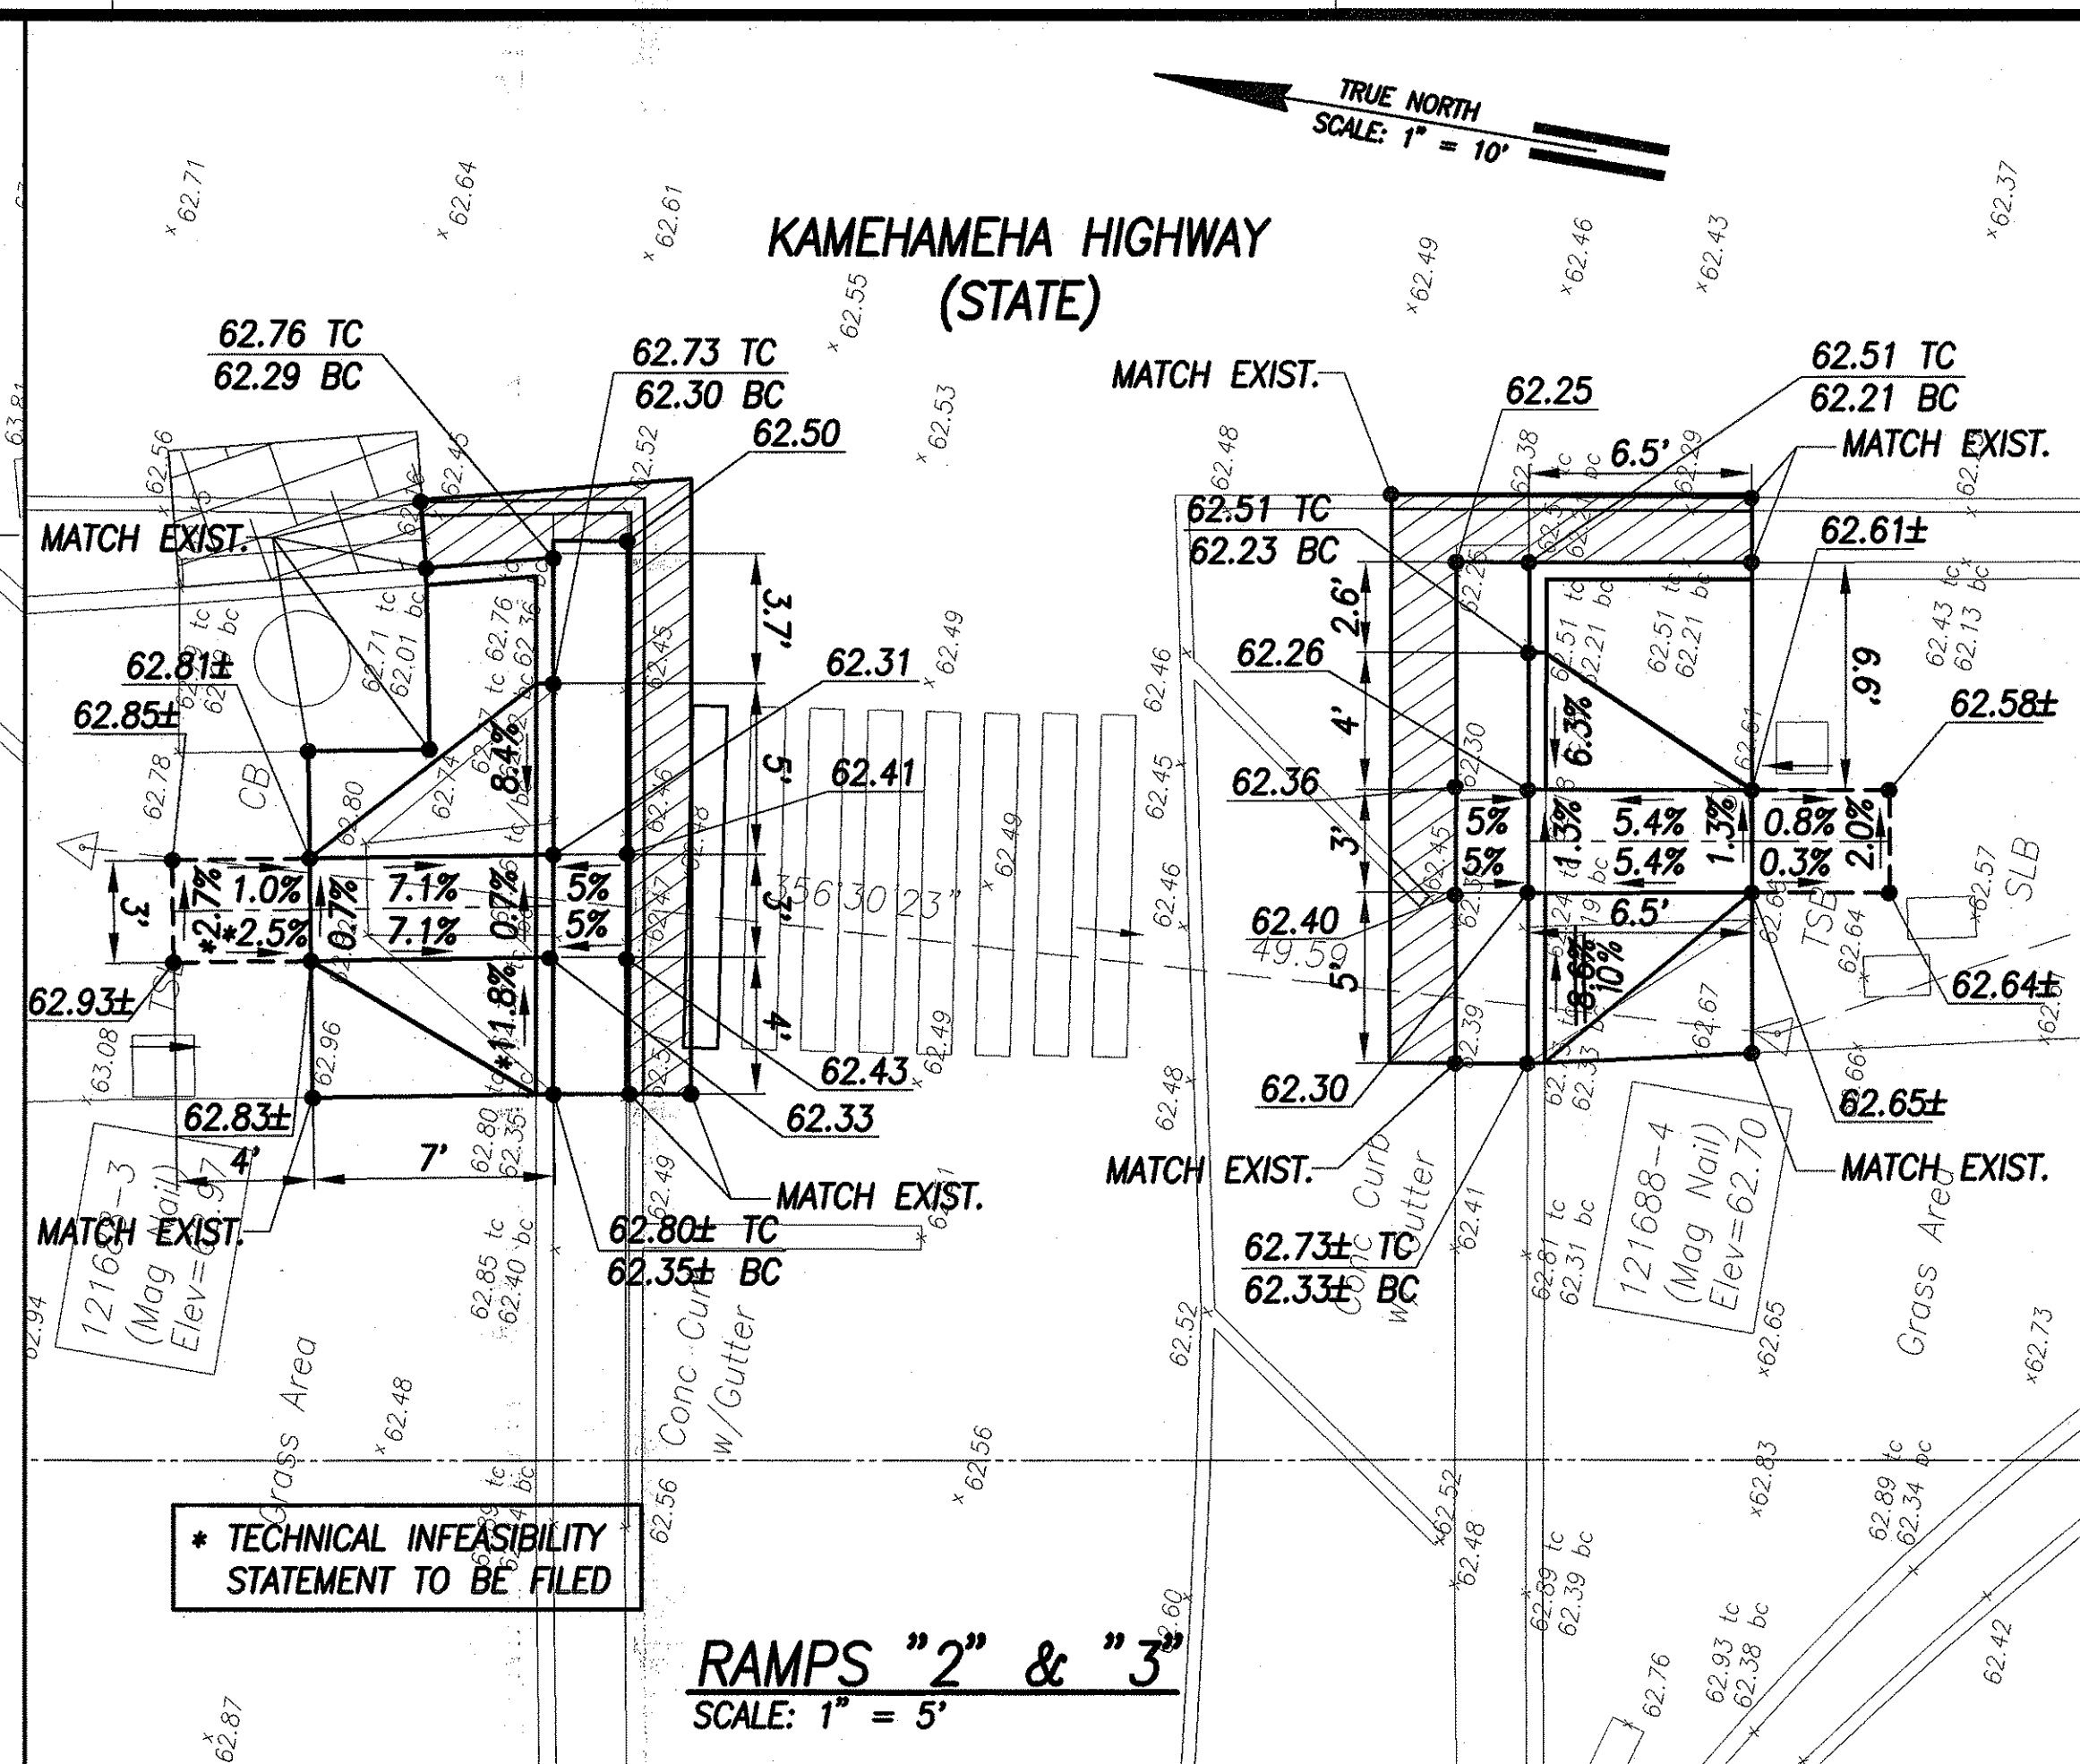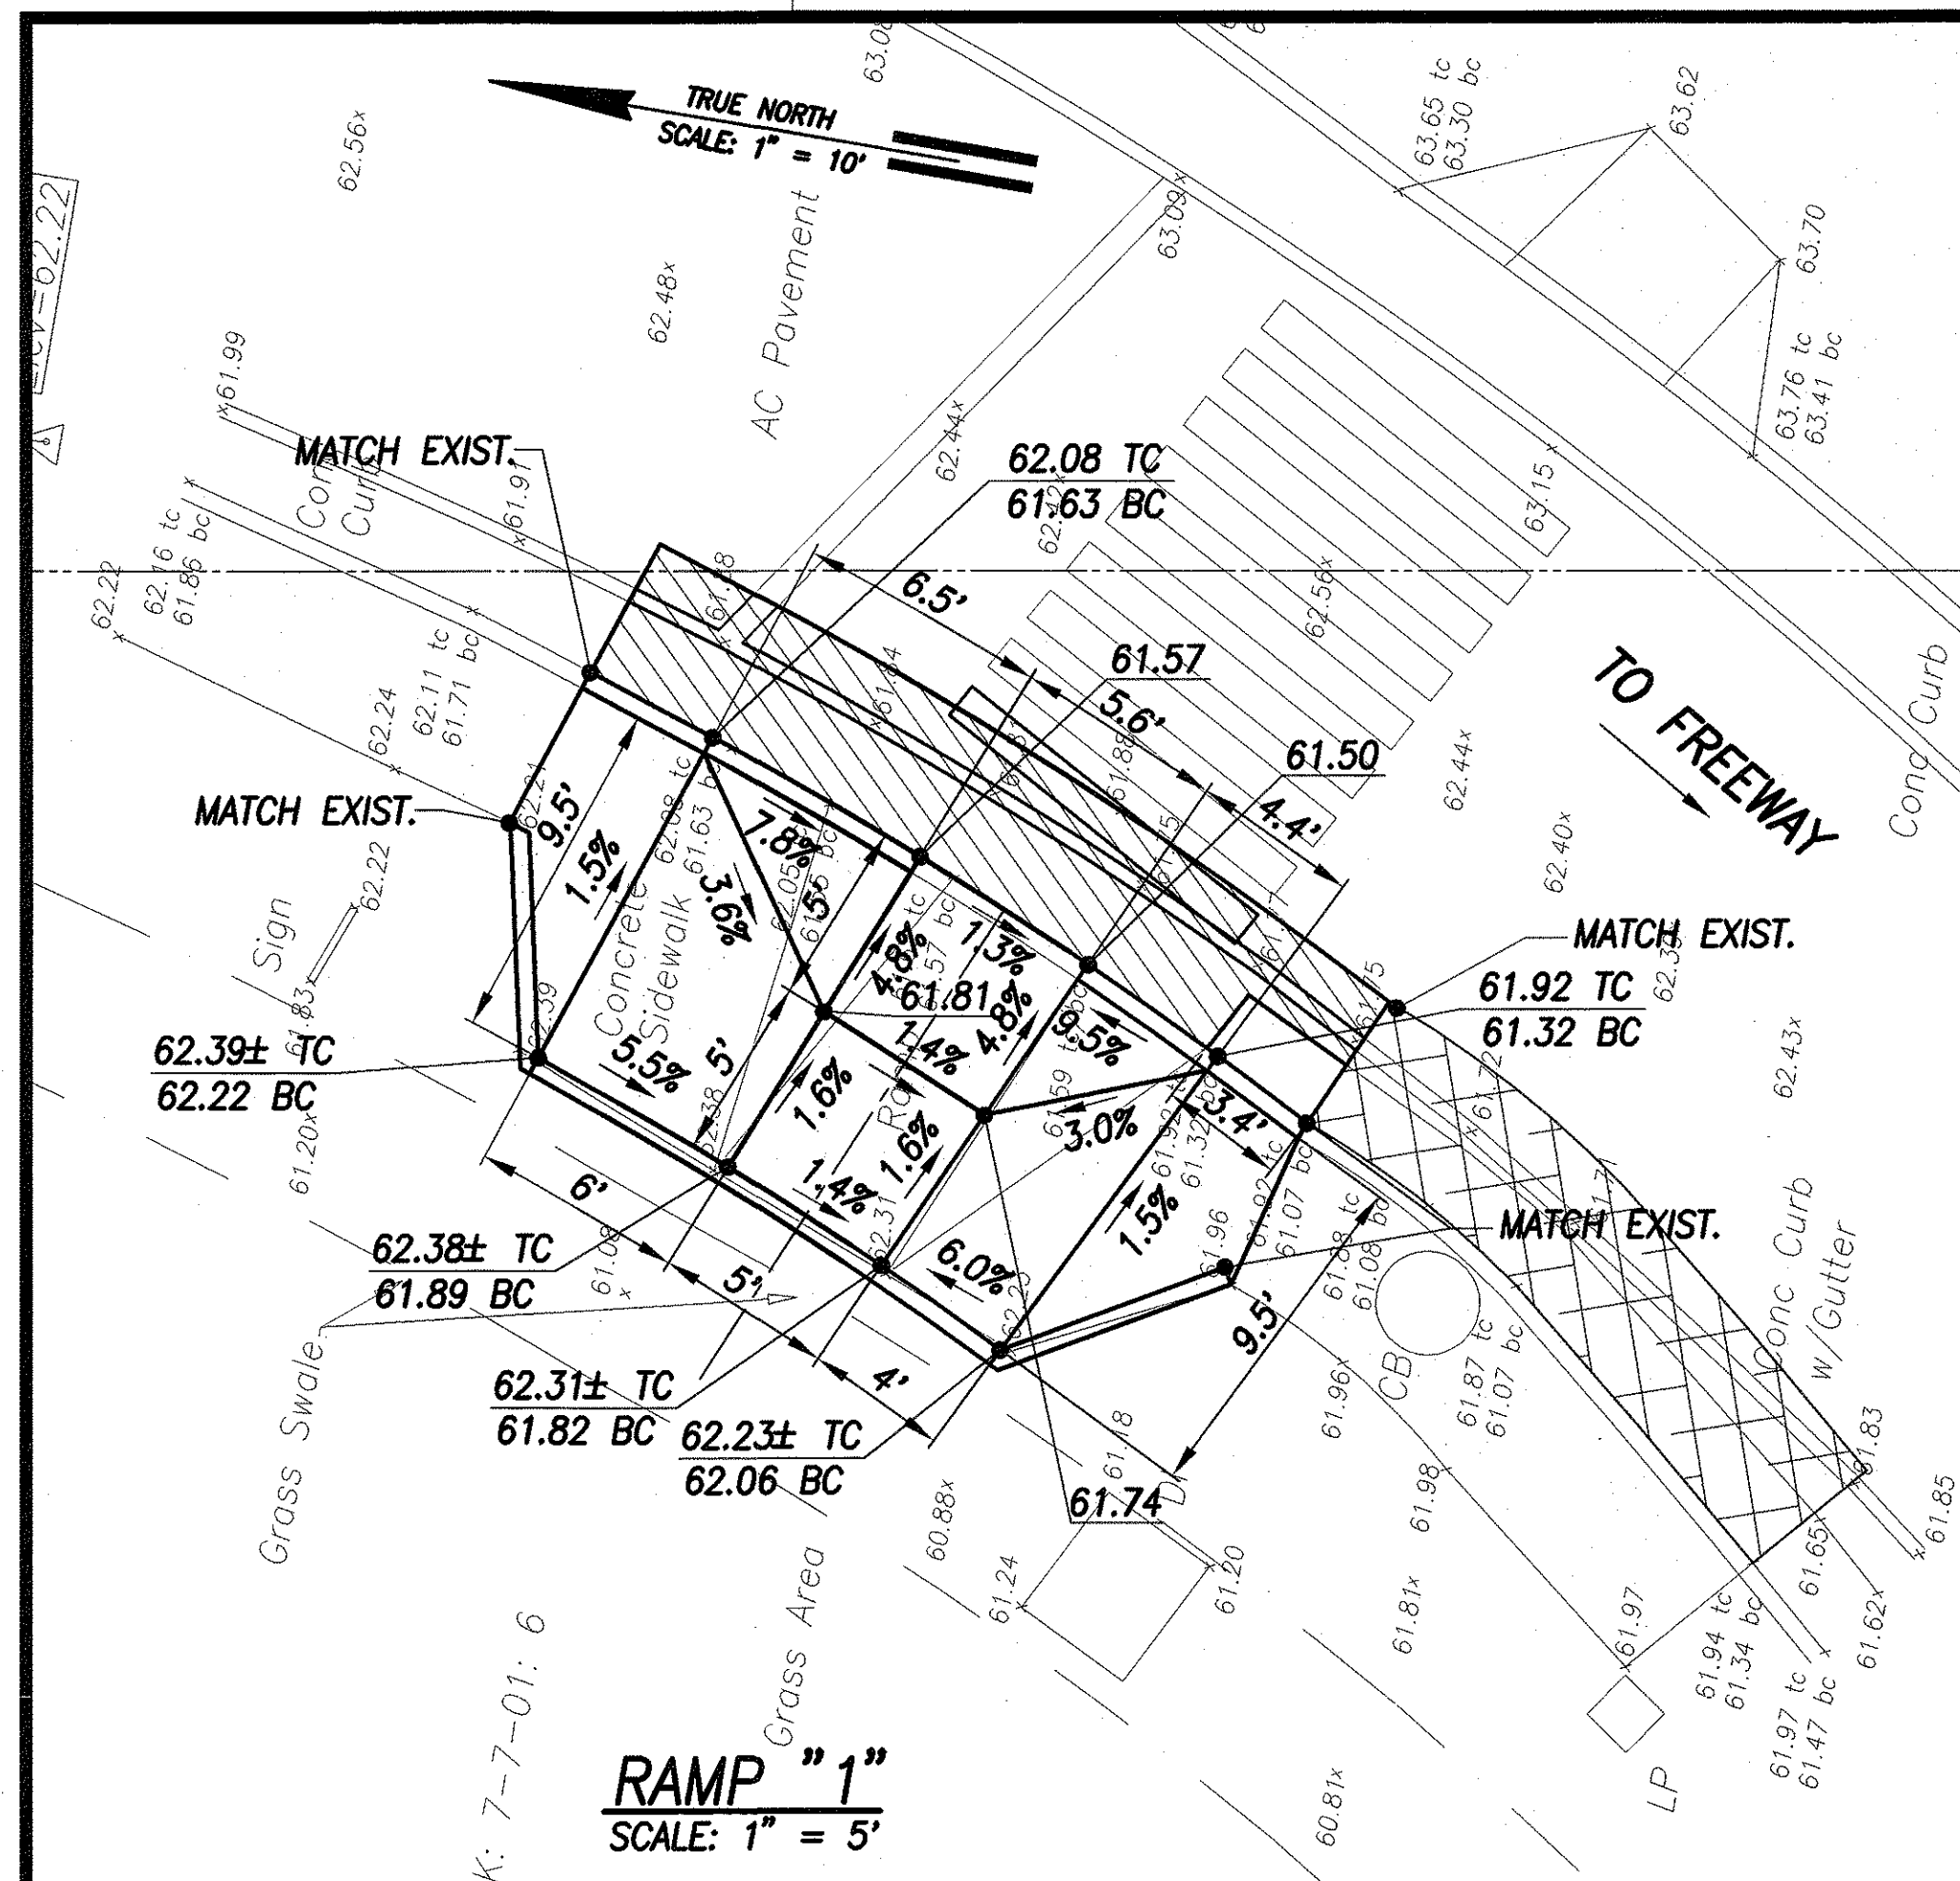


LEGEND

- x 49.52 EXIST. SPOT ELEVATION
- 52.58 FINISHED SPOT GRADE
- 51.50 TC FINISHED TOP OF CURB
- 51.00 BC FINISHED BOTTOM OF CURB

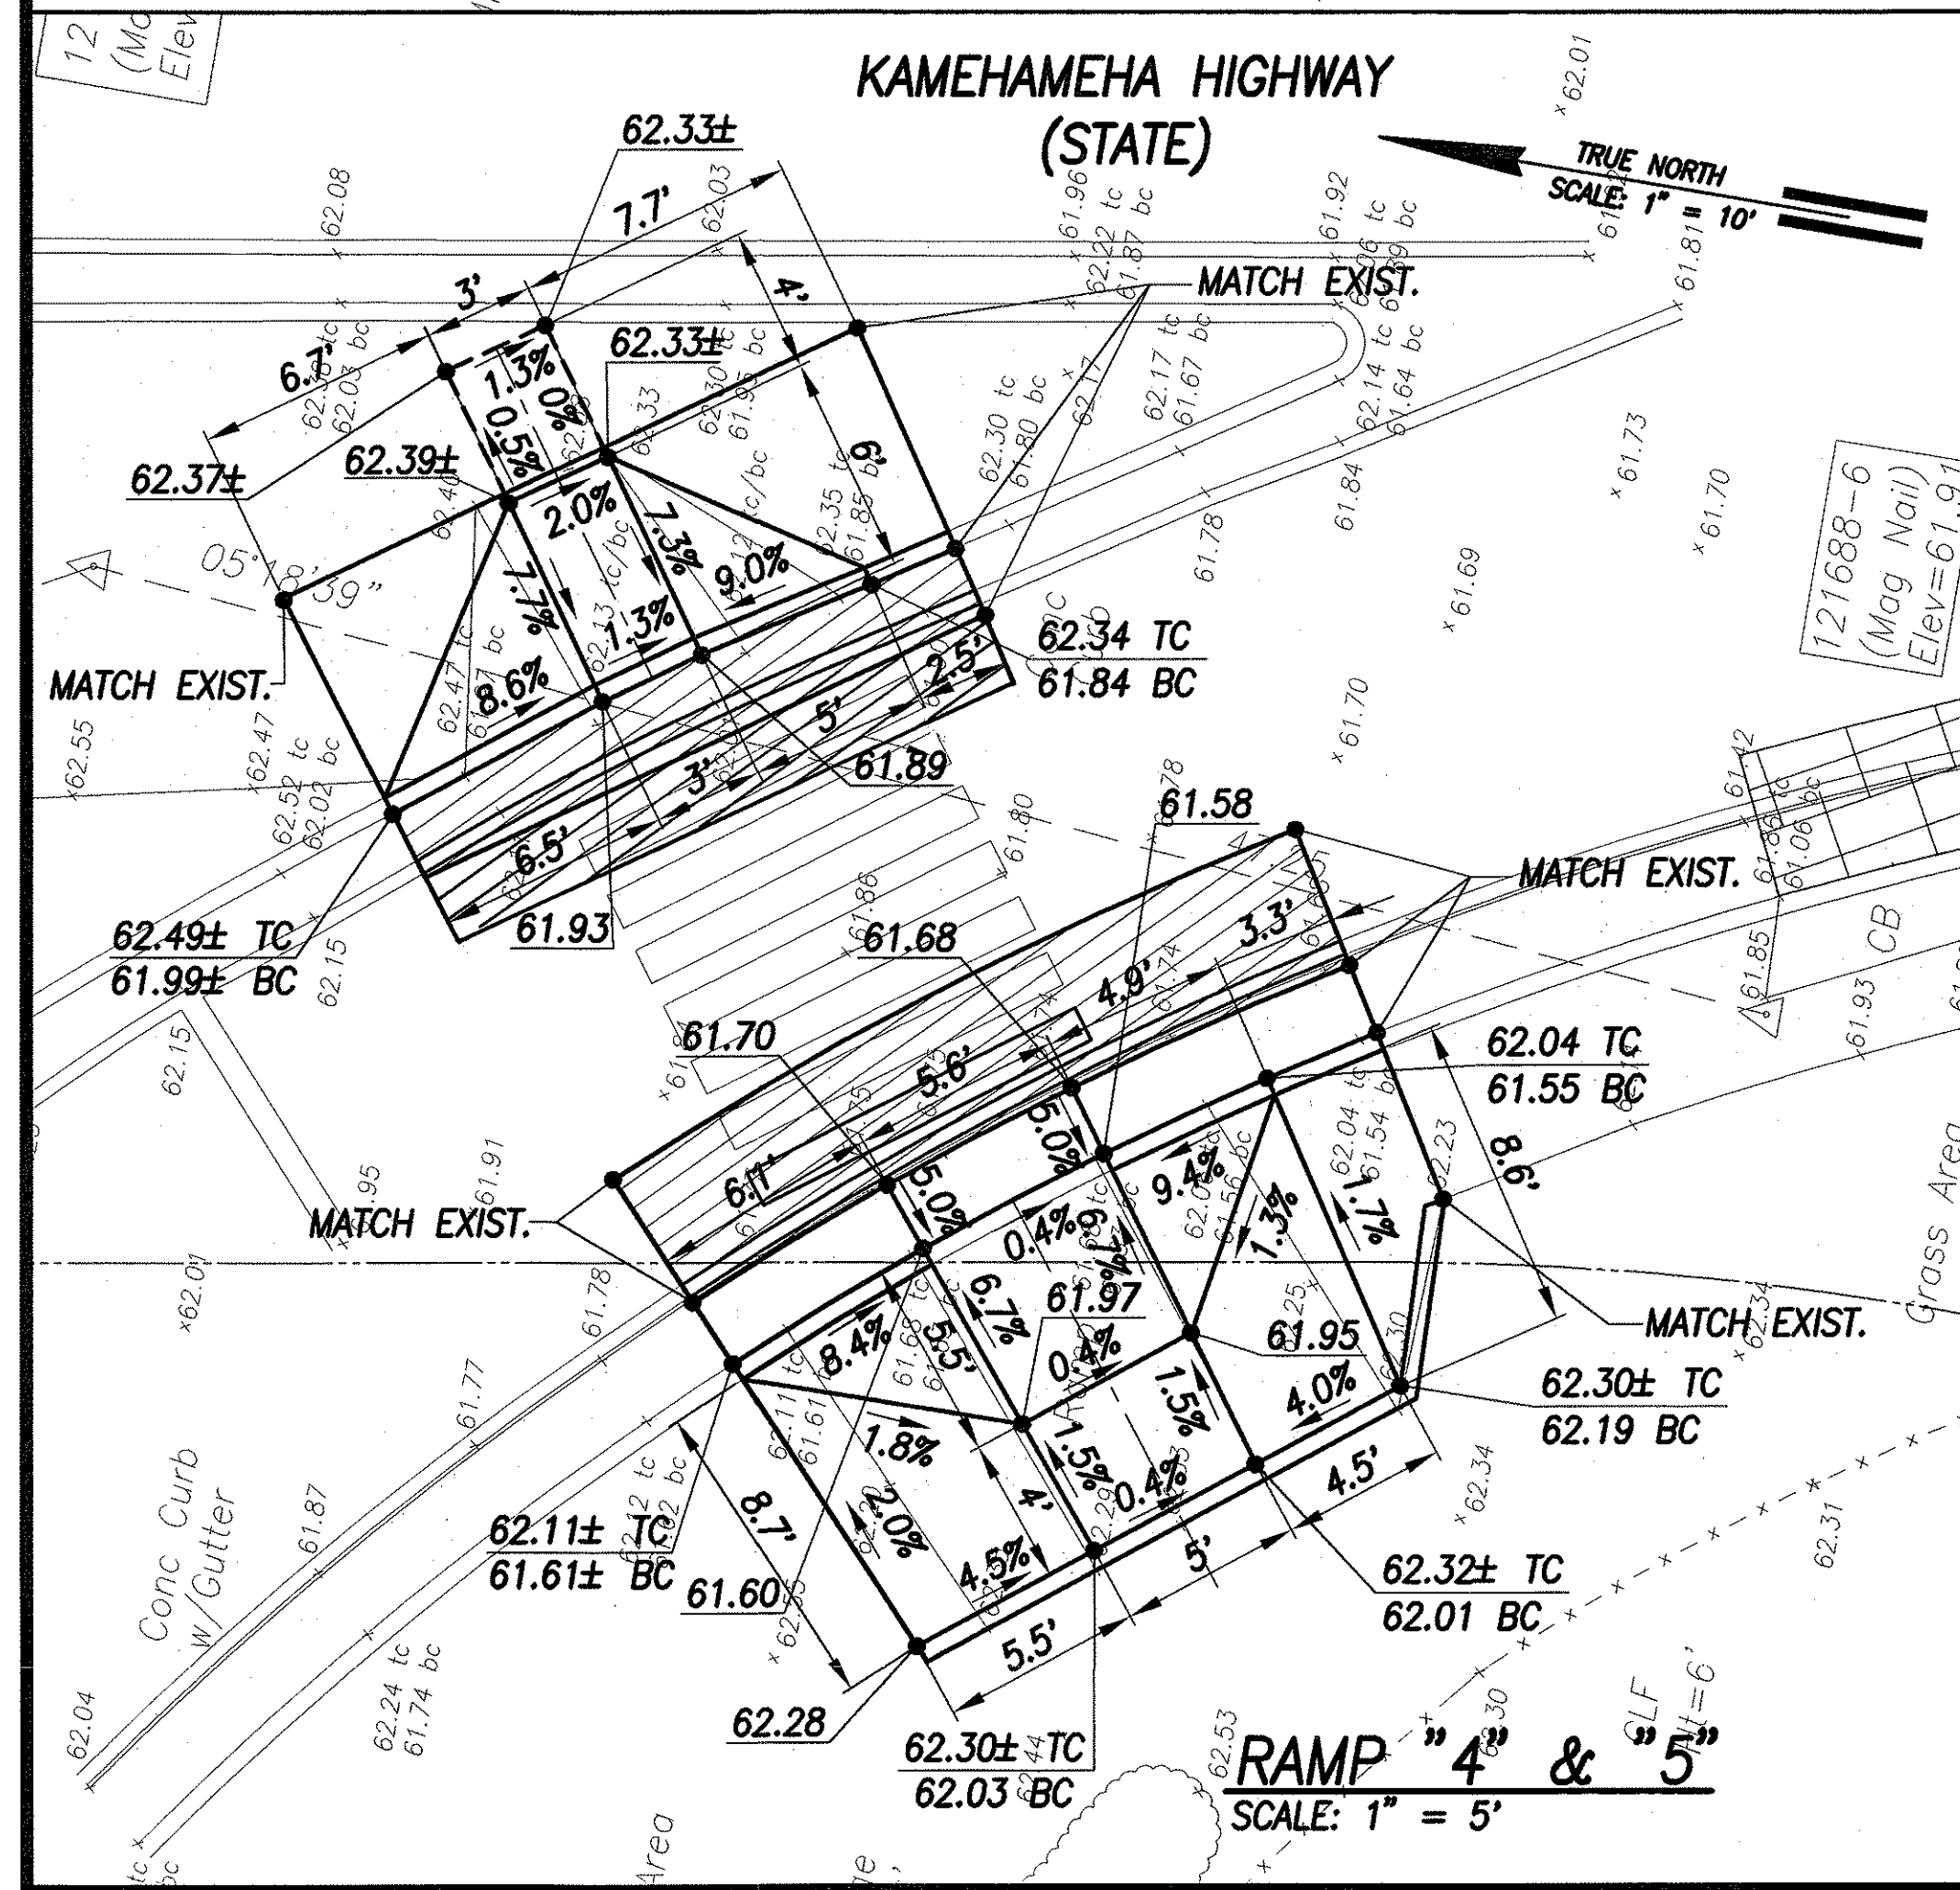

GRADING PLAN - WILIKINA DR. & KAMEHAMEHA HWY. - 2
INTERS. ID NO. 99-121688
 SCALE: 1" = 5'


DATE	_____
SURVEY PLOTTED BY	_____
DRAWN BY	_____
DESIGNED BY	_____
QUANTITIES BY	_____
CHECKED BY	_____
ORIGINAL PLAN	_____
NOTE BOOK	_____
NO.	_____

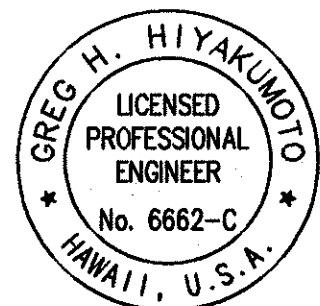

THIS WORK WAS PREPARED BY ME OR UNDER MY SUPERVISION AND CONSTRUCTION OF THIS PROJECT WILL BE UNDER MY OBSERVATION.


SIGNATURE: *Greg H. Hiyakunio* DATE: April 30, 2006

"OBSERVATION OF CONSTRUCTION" IS DEFINED IN CHAPTER 16-115, HAWAII ADMINISTRATIVE RULES ENTITLED "PROFESSIONAL ENGINEERS, ARCHITECTS, SURVEYORS AND LANDSCAPE ARCHITECTS".

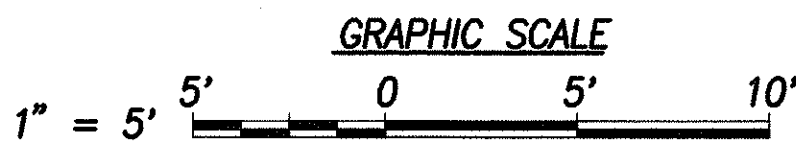

STATE OF HAWAII
 DEPARTMENT OF TRANSPORTATION
 HIGHWAYS DIVISION
GRADING PLAN - WILIKINA DR. & KAMEHAMEHA HWY. - 2
Pedestrian Facilities & ADA Compliance at Various Locations on Oahu, Unit 5
 Fed. Aid Proj. No. CMAQ-0300(96)
 Scale: 1" = 5'-0" Date: August 2004
SHEET No. C-104 OF 153 SHEETS

FED. ROAD DIST. NO.	STATE	FED. AID PROJ. NO.	FISCAL YEAR	SHEET NO.	TOTAL SHEETS
HAWAII	HAW.	CMAQ-0300(98)	2004	106	153

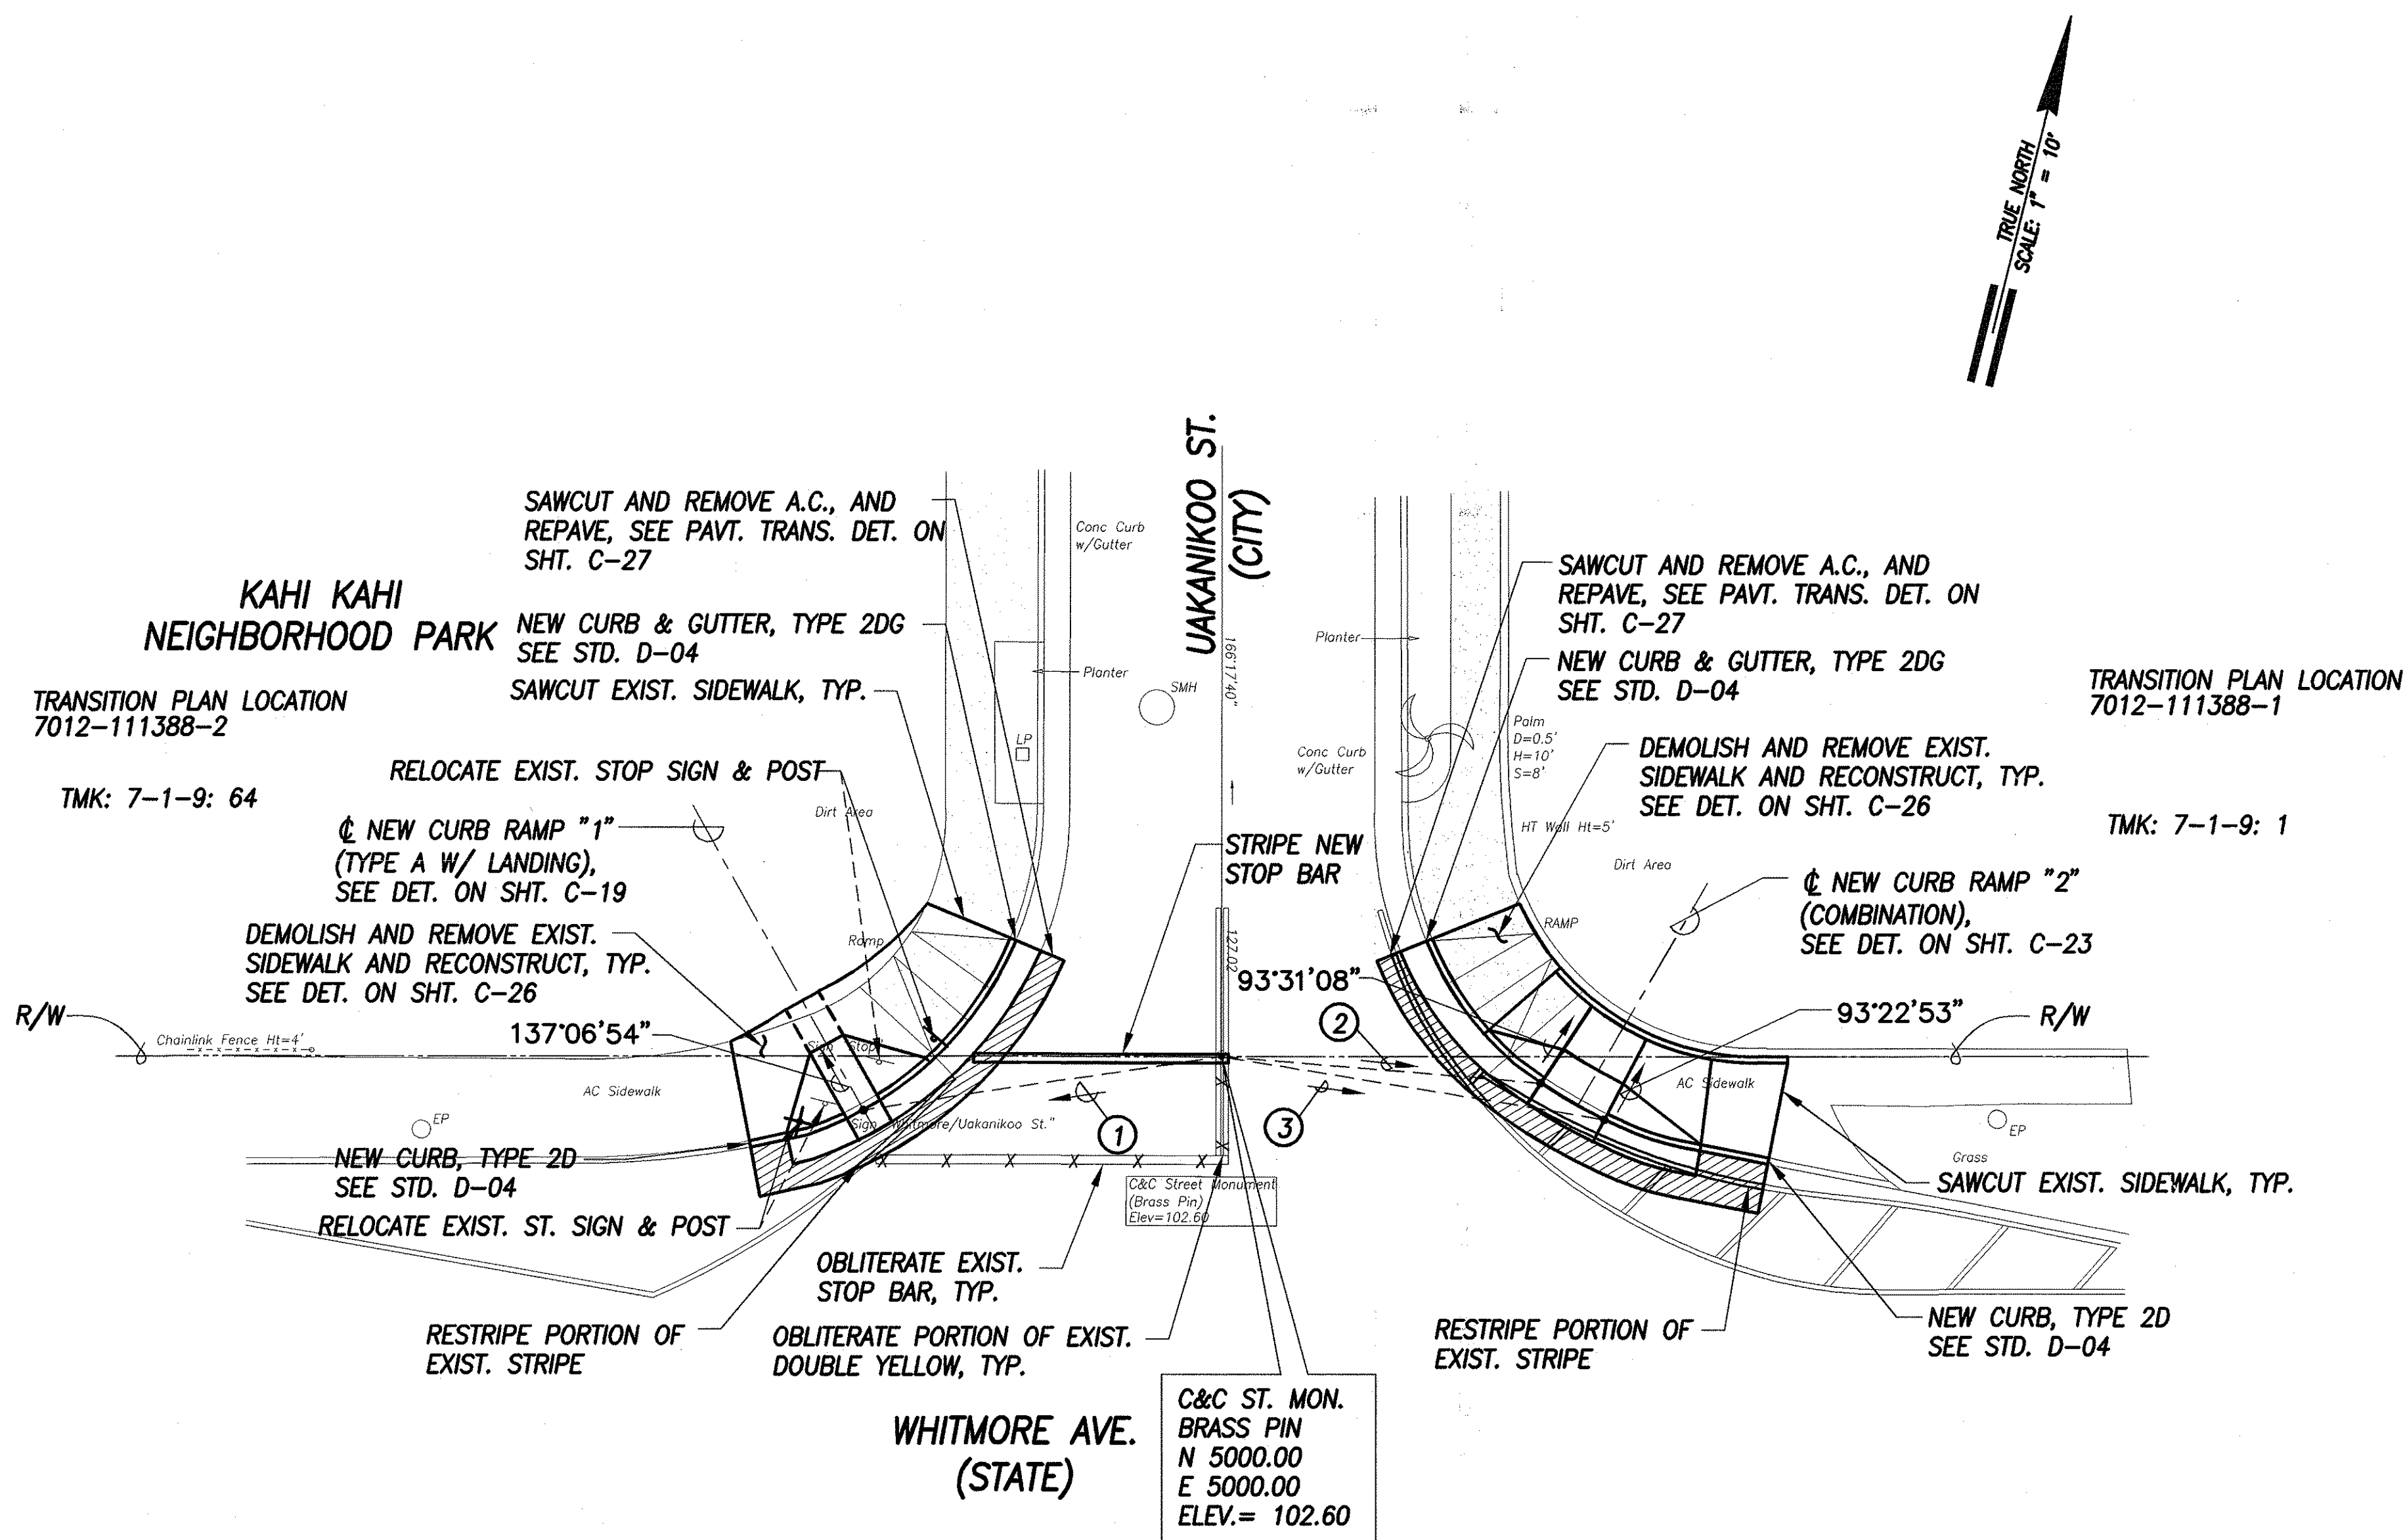

- ① 67°38'21" 28.75'
TIE: BM TO INTERSECTION OF RAMP AND CURB FACE
- ② 261°07'01" 25.42'
TIE: BM TO INTERSECTION OF RAMP EDGE AND CURB FACE
- ③ 265°45'29" 30.80'
TIE: BM TO INTERSECTION OF RAMP EDGE AND CURB FACE

SURVEY PLOTTED BY	DATE
DRAWN BY	
DESIGNED BY	
QUANTITIES BY	
CHECKED BY	

SITE PLAN - WHITMORE AVE. & UKANIKOO ST.
INTERS. ID NO. 7012-111388
 SCALE: 1" = 10'




THIS WORK WAS PREPARED BY ME OR UNDER MY SUPERVISION AND CONSTRUCTION OF THIS PROJECT WILL BE UNDER MY OBSERVATION.

SIGNATURE: *Greg H. Hiakumoto* DATE: April 30, 2006

"OBSERVATION OF CONSTRUCTION" IS DEFINED IN CHAPTER 16-115, HAWAII ADMINISTRATIVE RULES ENTITLED "PROFESSIONAL ENGINEERS, ARCHITECTS, SURVEYORS AND LANDSCAPE ARCHITECTS".

STATE OF HAWAII
 DEPARTMENT OF TRANSPORTATION
 HIGHWAYS DIVISION
SITE PLAN
WHITMORE AVE & UAKANIKOO ST.
Pedestrian Facilities & ADA Compliance at Various Locations on Oahu, Unit 5
 Fed. Aid Proj. No. CMAQ-0300(96)
 Scale: 1" = 10'-0" Date: August 2004
SHEET No. C-105 OF 153 SHEETS

FED. ROAD DIST. NO.	STATE	FED. AID PROJ. NO.	FISCAL YEAR	SHEET NO.	TOTAL SHEETS
HAWAII	HAW.	CMAQ-0300(96)	2004	107	153

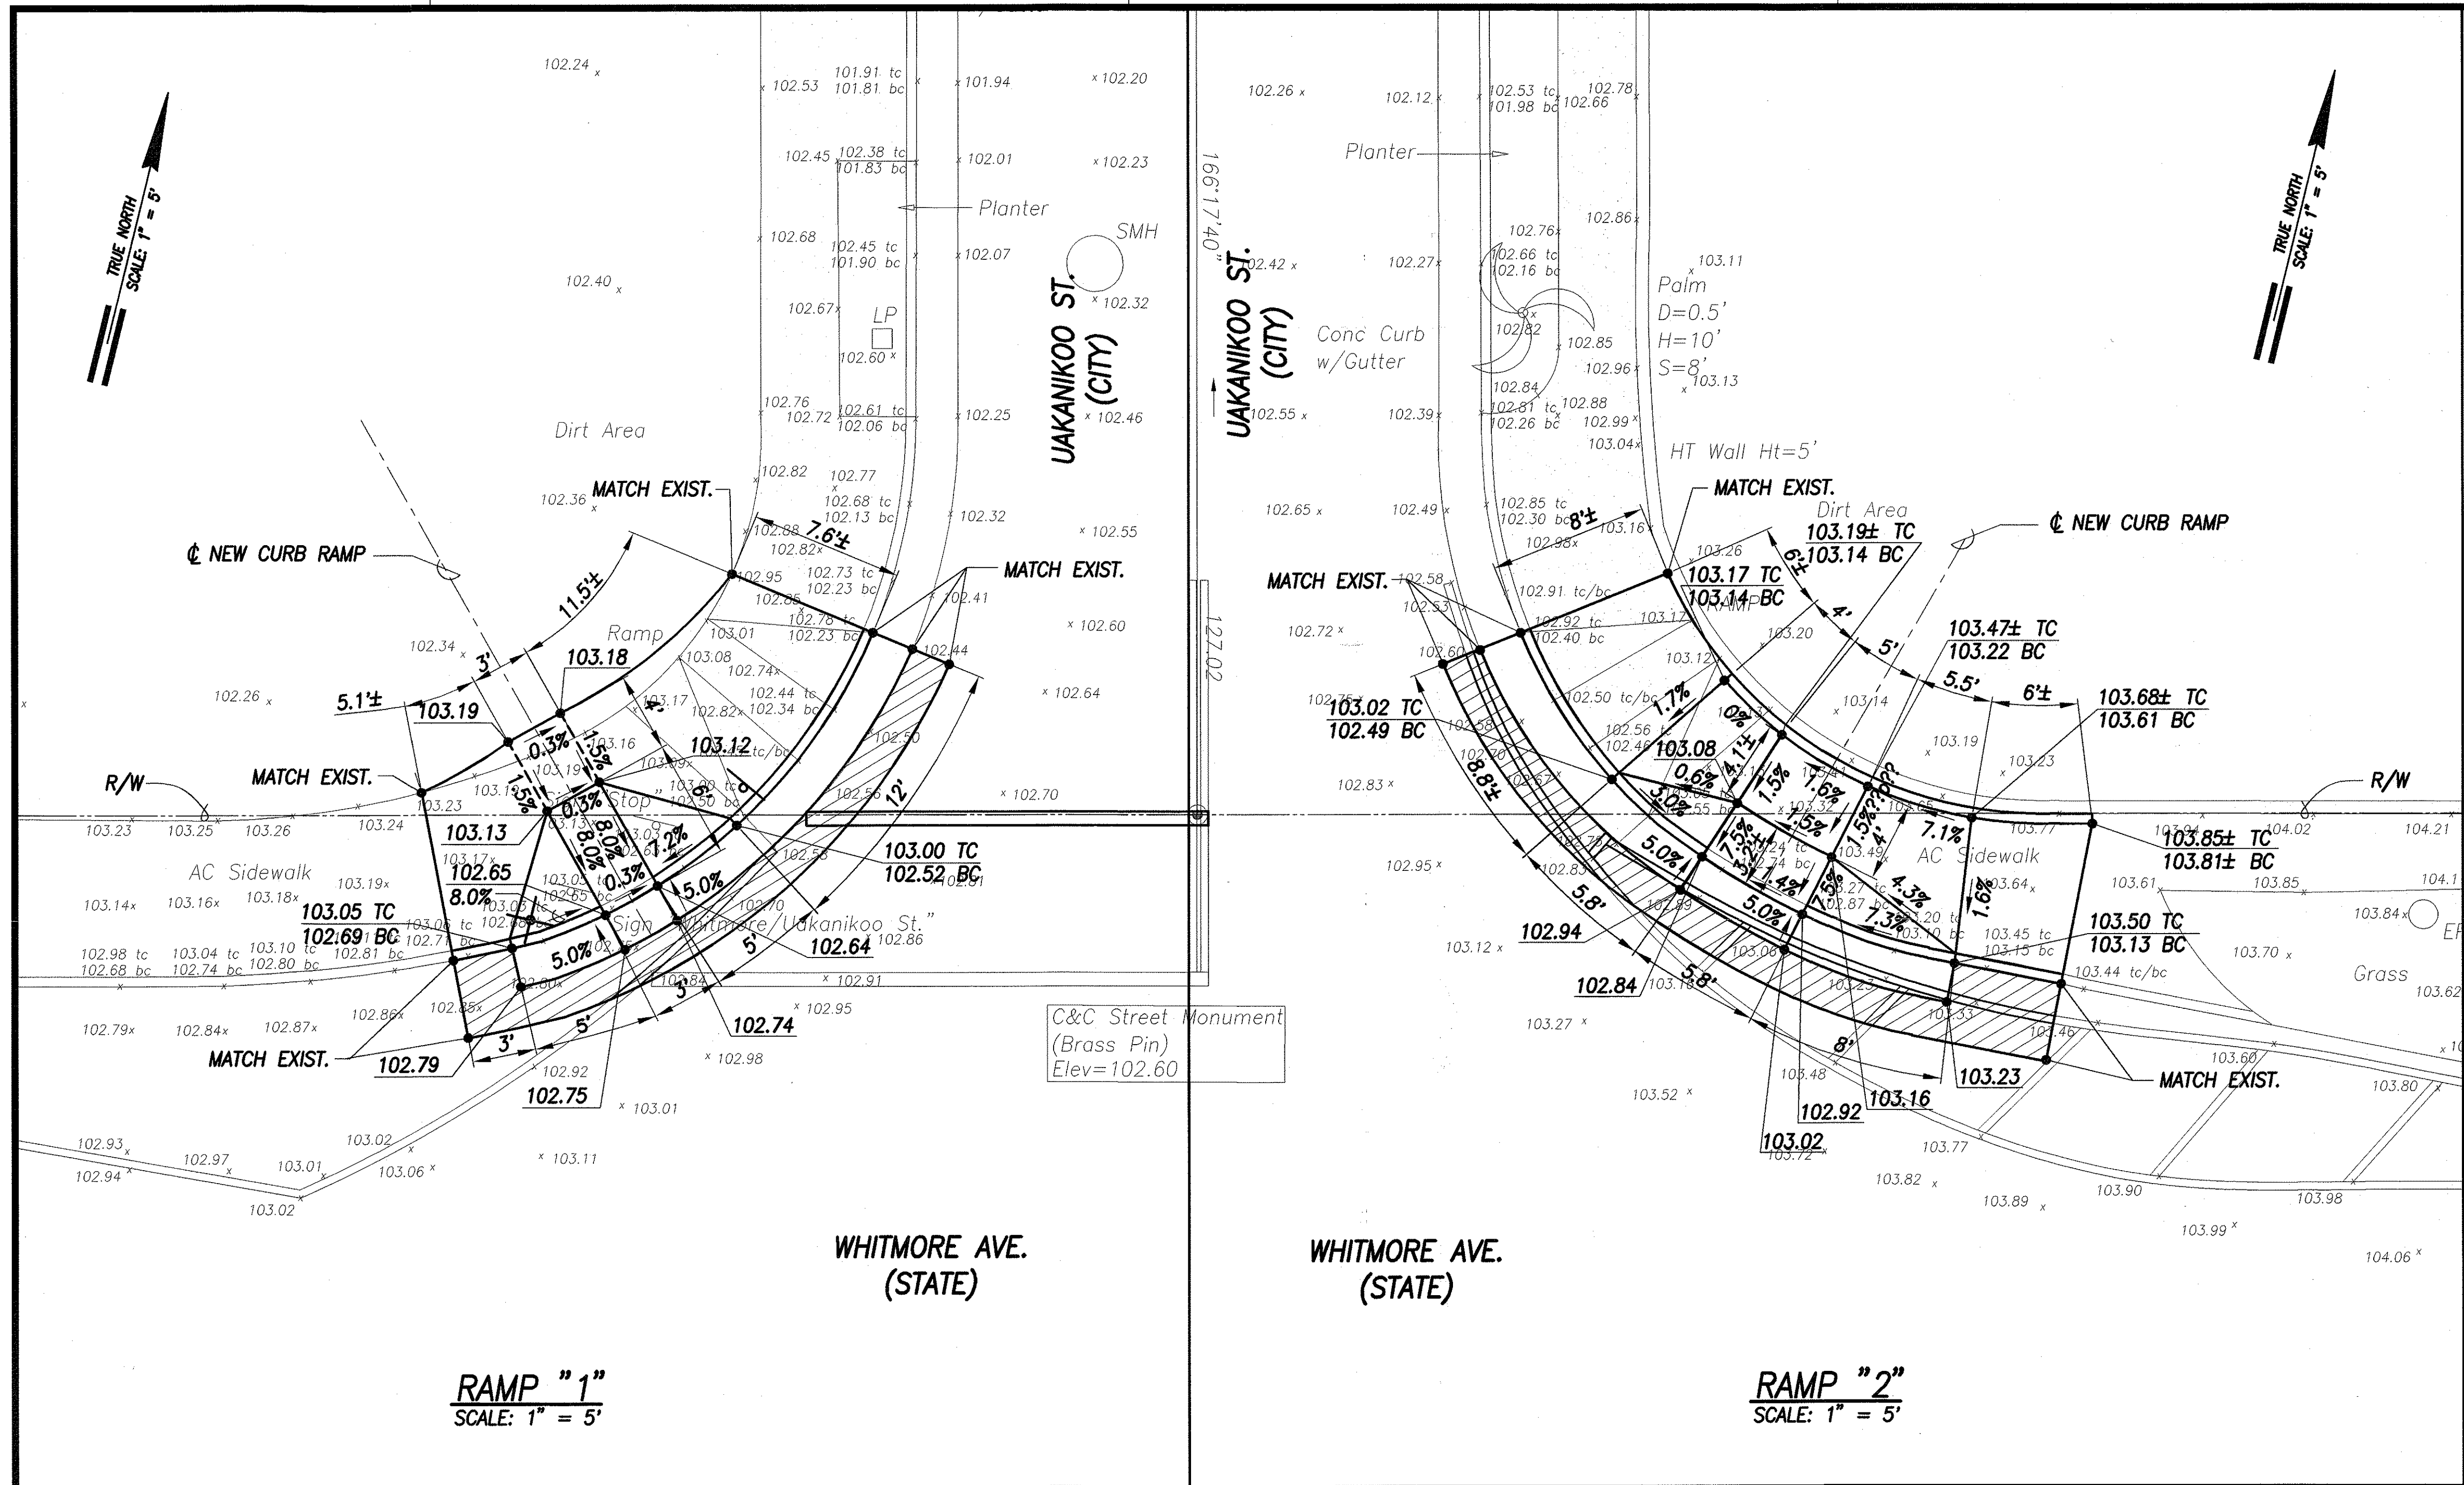

GRADING PLAN - WHITMORE AVE. & UAKANIKOO ST.
INTERS. ID NO. 7012-111388
SCALE: 1" = 5'

LEGEND

- x 49.52 EXIST. SPOT ELEVATION
- 52.58 FINISHED SPOT GRADE
- 51.50 TC FINISHED TOP OF CURB
- 51.00 BC FINISHED BOTTOM OF CURB

DATE	_____
SURVEY PLATTED BY	_____
DESIGNED BY	_____
TRACED BY	_____
NOTE BOOK	_____
QUANTITIES BY	_____
CHECKED BY	_____



THIS WORK WAS PREPARED BY ME OR UNDER MY SUPERVISION AND CONSTRUCTION OF THIS PROJECT WILL BE UNDER MY OBSERVATION.


Signature: _____ DATE: April 30, 2006

"OBSERVATION OF CONSTRUCTION" IS DEFINED IN CHAPTER 16-115, HAWAII ADMINISTRATIVE RULES ENTITLED "PROFESSIONAL ENGINEERS, ARCHITECTS, SURVEYORS AND LANDSCAPE ARCHITECTS".



STATE OF HAWAII
DEPARTMENT OF TRANSPORTATION
HIGHWAYS DIVISION
GRADING PLAN
WHITMORE AVE. & UAKANIKOO ST.
Pedestrian Facilities & ADA Compliance
at Various Locations on Oahu, Unit 5
Fed. Aid Proj. No. CMAQ-0300(96)
Scale: 1" = 5'-0" Date: August, 2004
SHEET No. C-106 OF 153 SHEETS


FED. ROAD DIST. NO.	STATE	FED. AID PROJ. NO.	FISCAL YEAR	SHEET NO.	TOTAL SHEETS
HAWAII	HAW.	CMAQ-0300(96)	2004	109	153

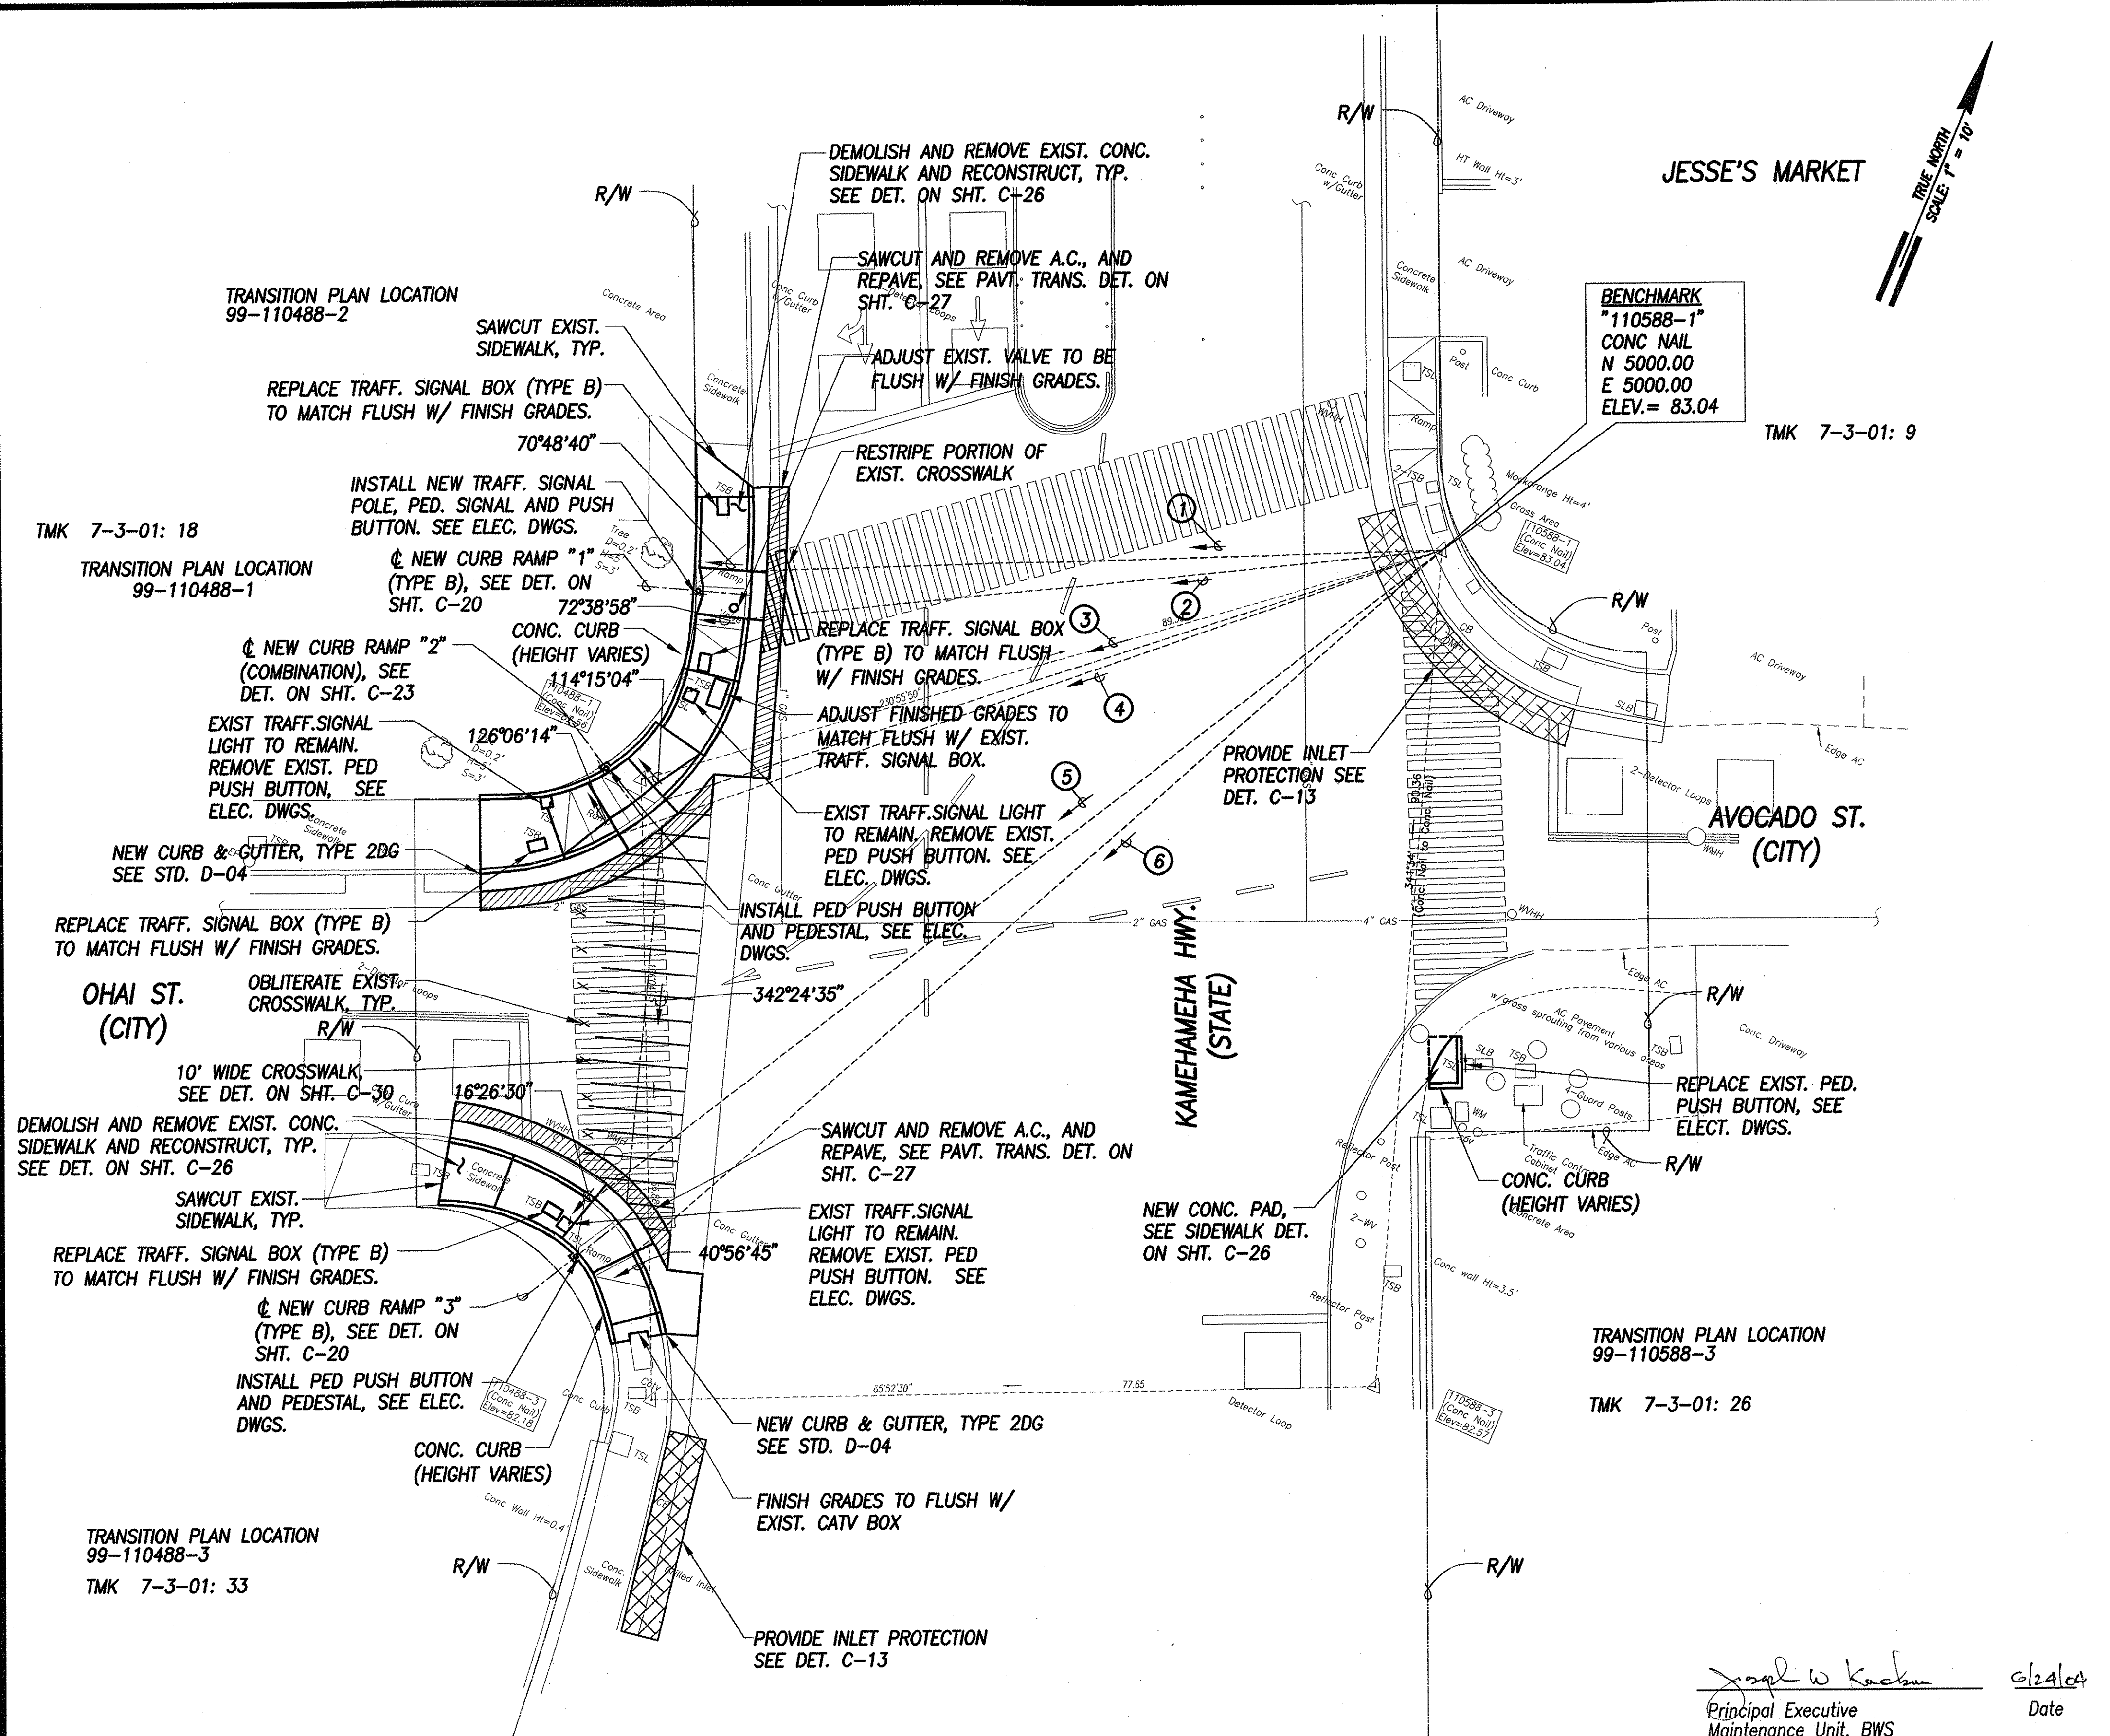

- ① 65°14'06" 74.12'
TIE: BM TO INTERSECTION OF RAMP
EDGE AND CURB FACE
- ② 61°16'05" 74.79'
TIE: BM TO INTERSECTION OF RAMP
EDGE AND CURB FACE
- ③ 49°05'45" 87.53'
TIE: BM TO INTERSECTION OF RAMP
EDGE AND CURB FACE
- ④ 47°51'00" 93.47'
TIE: BM TO INTERSECTION OF RAMP
EDGE AND CURB FACE
- ⑤ 29°26'45" 114.70'
TIE: BM TO INTERSECTION OF RAMP
EDGE AND CURB FACE
- ⑥ 25°49'46" 114.83'
TIE: BM TO INTERSECTION OF RAMP
EDGE AND CURB FACE

DATE	_____
DESIGNED BY	_____
CHECKED BY	_____
NOTED BY	_____
NO.	_____

SITE PLAN - KAMEHAMEHA HWY., OHAI ST. & AVOCADO ST.
INTERS. ID NO. 80-110488 & 80-110588
 SCALE: 1" = 10'

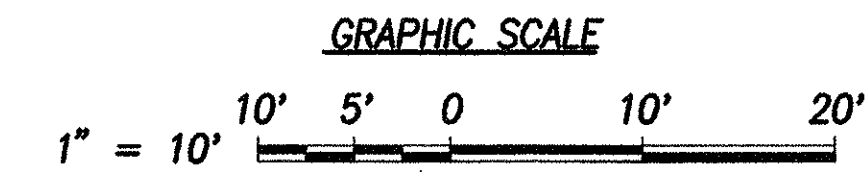



[Signature]
 Principal Executive
 Maintenance Unit, BWS
 Date: 6/24/04



THIS WORK WAS PREPARED BY ME OR UNDER MY SUPERVISION AND CONSTRUCTION OF THIS PROJECT WILL BE UNDER MY OBSERVATION.
[Signature] April 30, 2006
 SIGNATURE DATE
 "OBSERVATION OF CONSTRUCTION" IS DEFINED IN CHAPTER 16-115, HAWAII ADMINISTRATIVE RULES ENTITLED "PROFESSIONAL ENGINEERS, ARCHITECTS, SURVEYORS AND LANDSCAPE ARCHITECTS".


STATE OF HAWAII
 DEPARTMENT OF TRANSPORTATION
 HIGHWAYS DIVISION
SITE PLAN - KAMEHAMEHA HWY., OHAI ST. & AVOCADO ST.
Pedestrian Facilities & ADA Compliance
at Various Locations on Oahu, Unit 5
Fed. Aid Proj. No. CMAQ-0300(96)
 Scale: 1" = 10'-0" Date: August 2004
SHEET No. C-108 OF 153 SHEETS

FED. ROAD DIST. NO.	STATE	FED. AID PROJ. NO.	FISCAL YEAR	SHEET NO.	TOTAL SHEETS
HAWAII	HAW.	CMAQ-0300(96)	2004	110	153

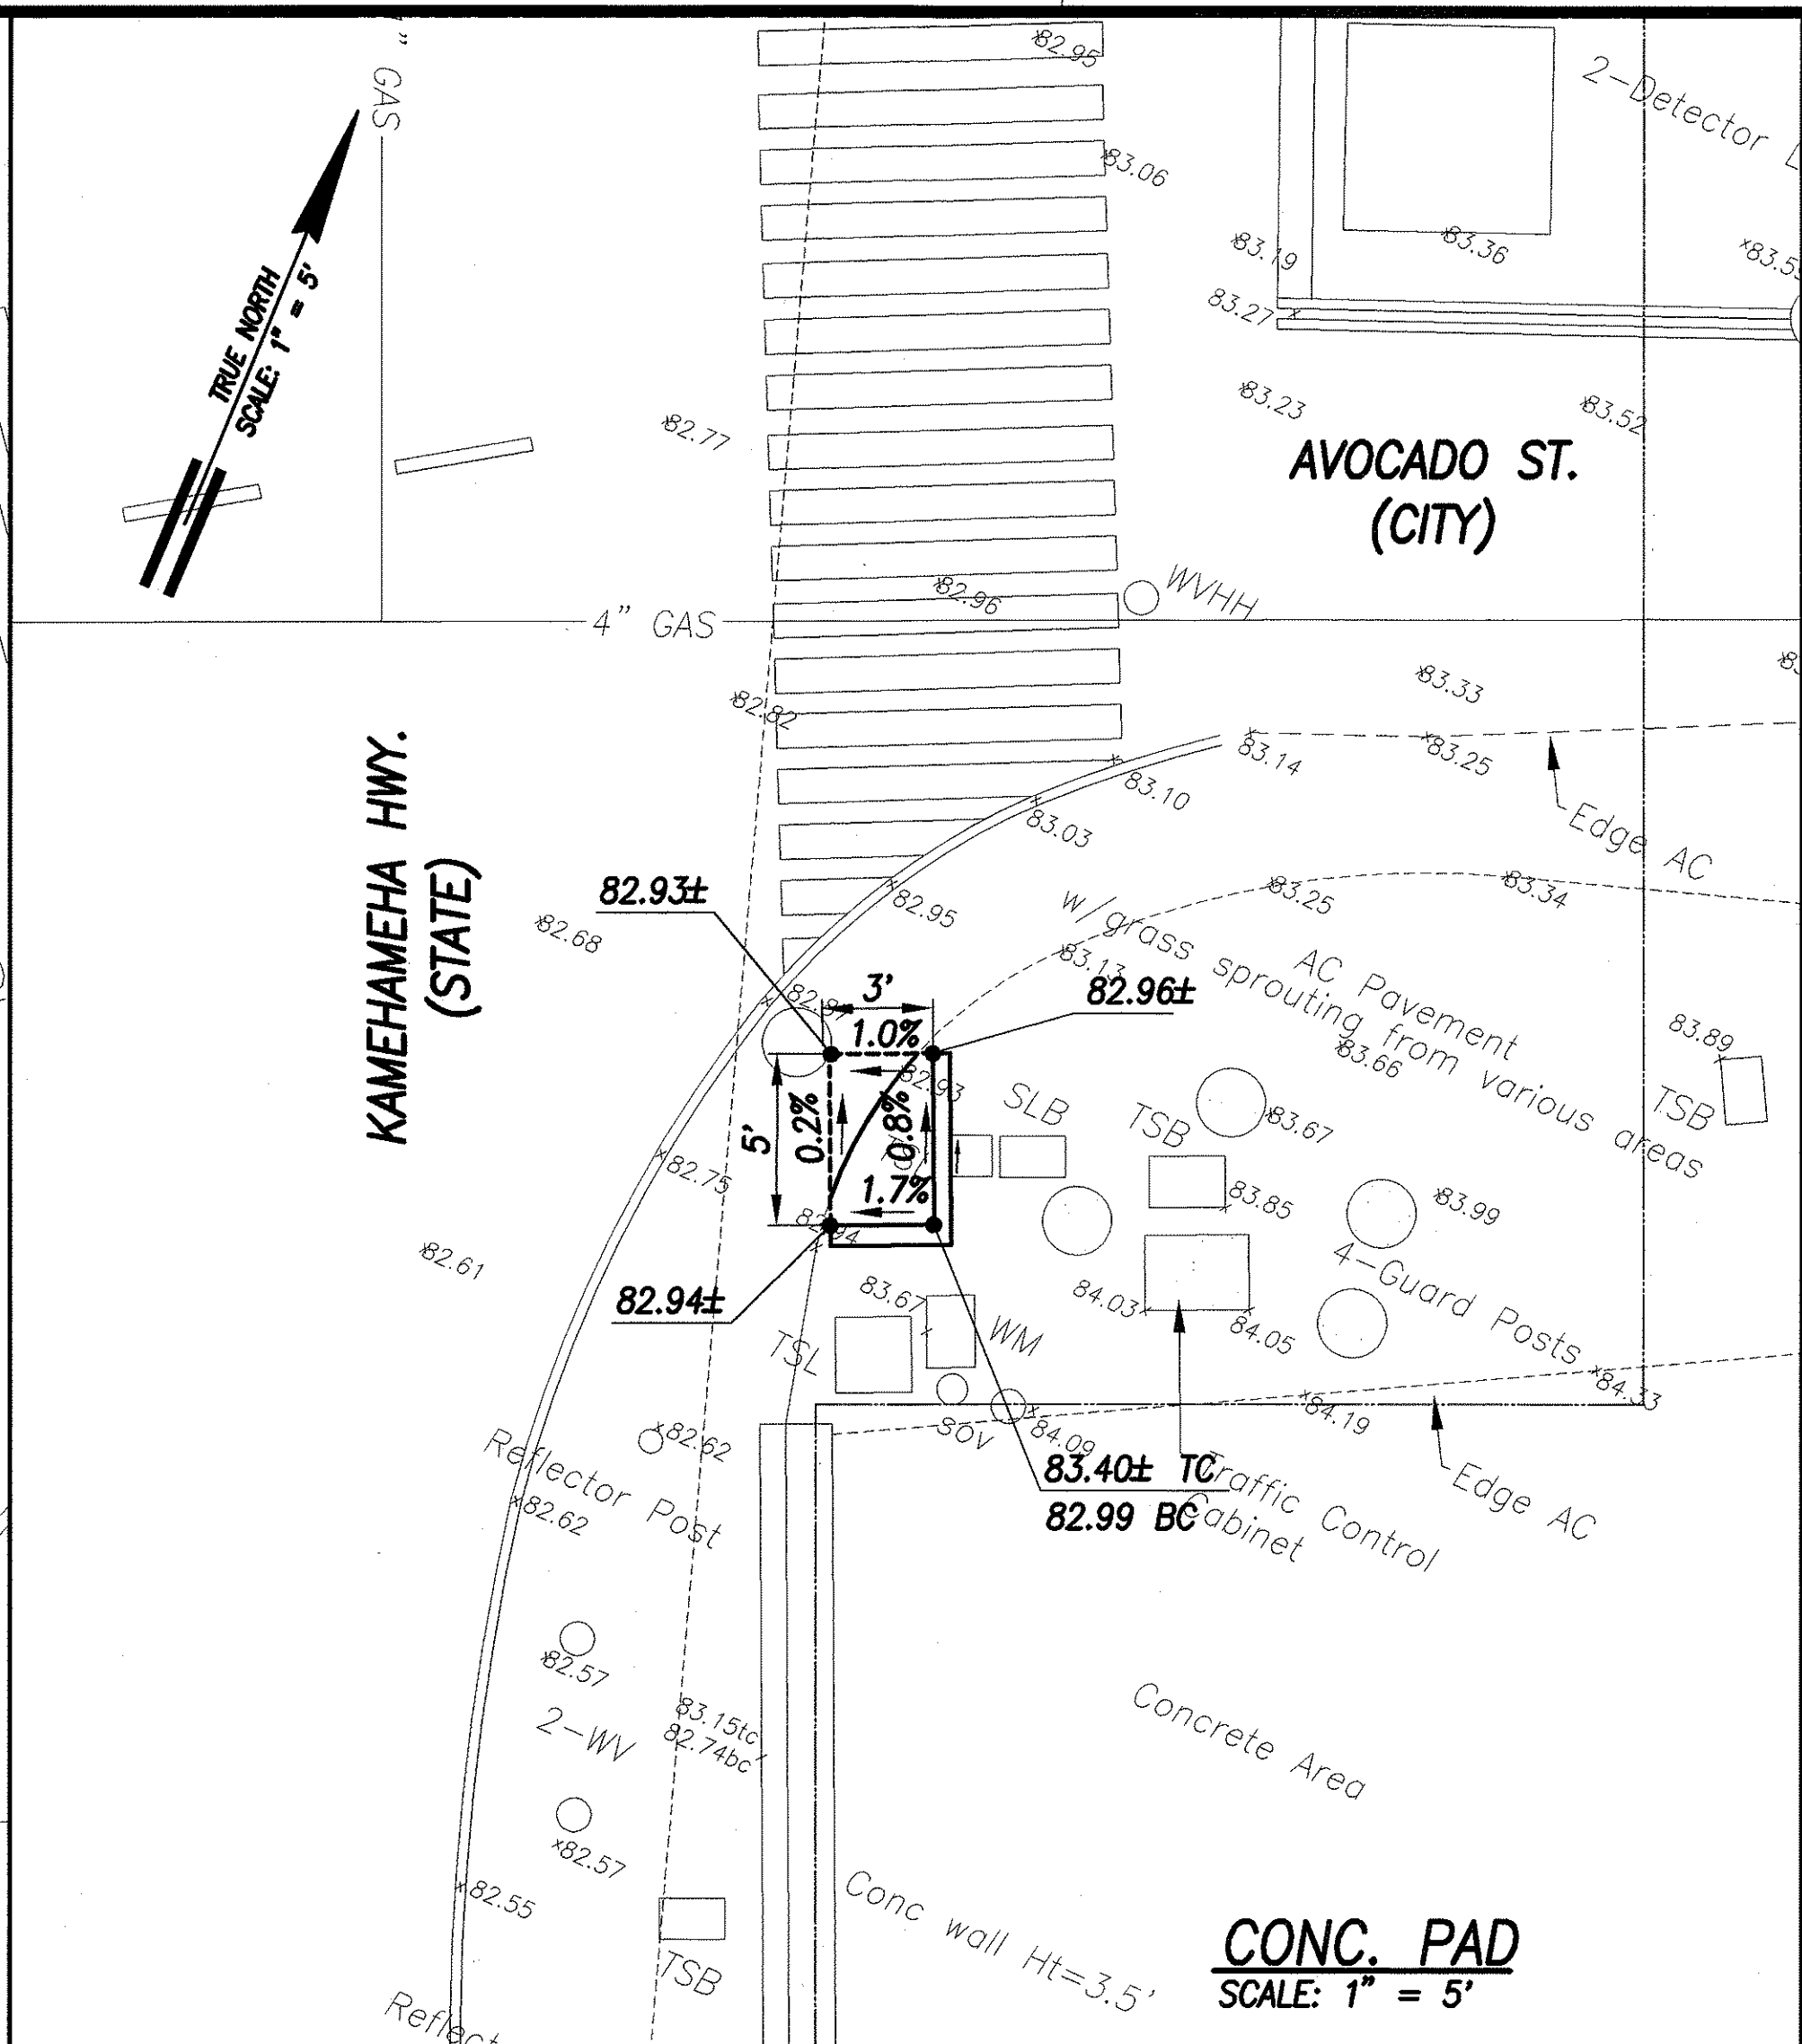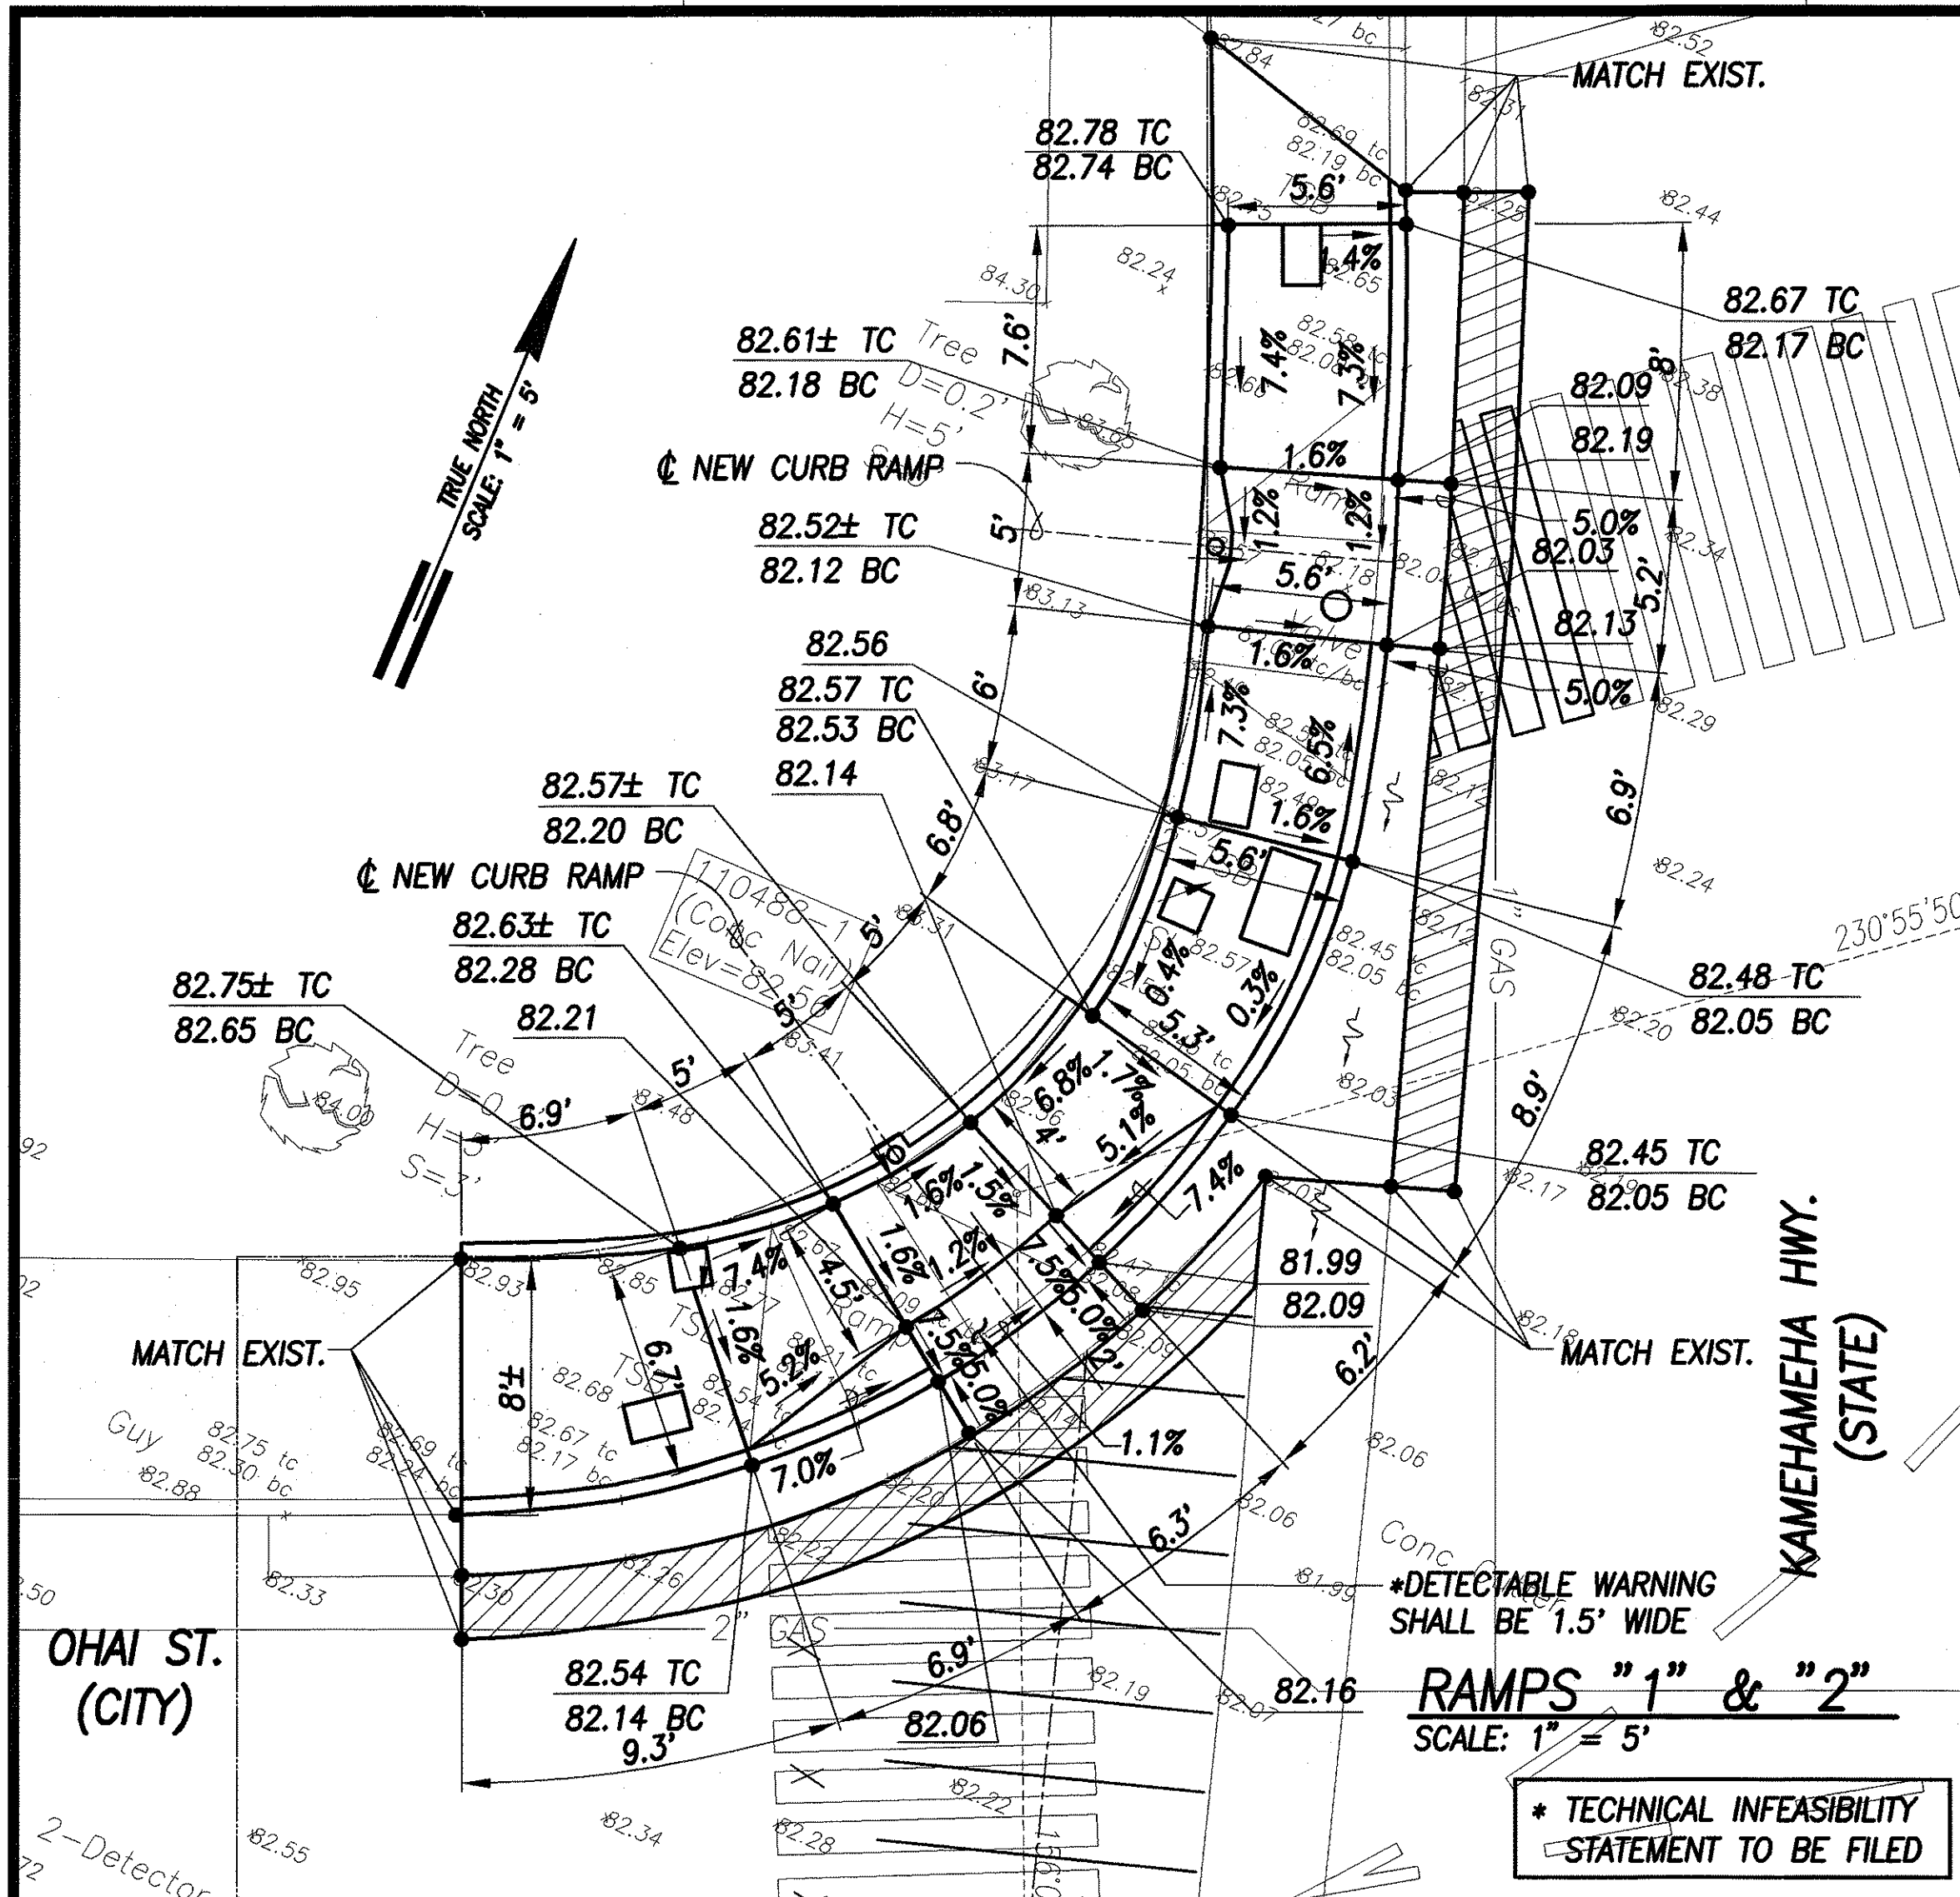

LEGEND

- x 49.52 EXIST. SPOT ELEVATION
- 52.58 FINISHED SPOT GRADE
- 51.50 TC FINISHED TOP OF CURB
- 51.00 BC FINISHED BOTTOM OF CURB

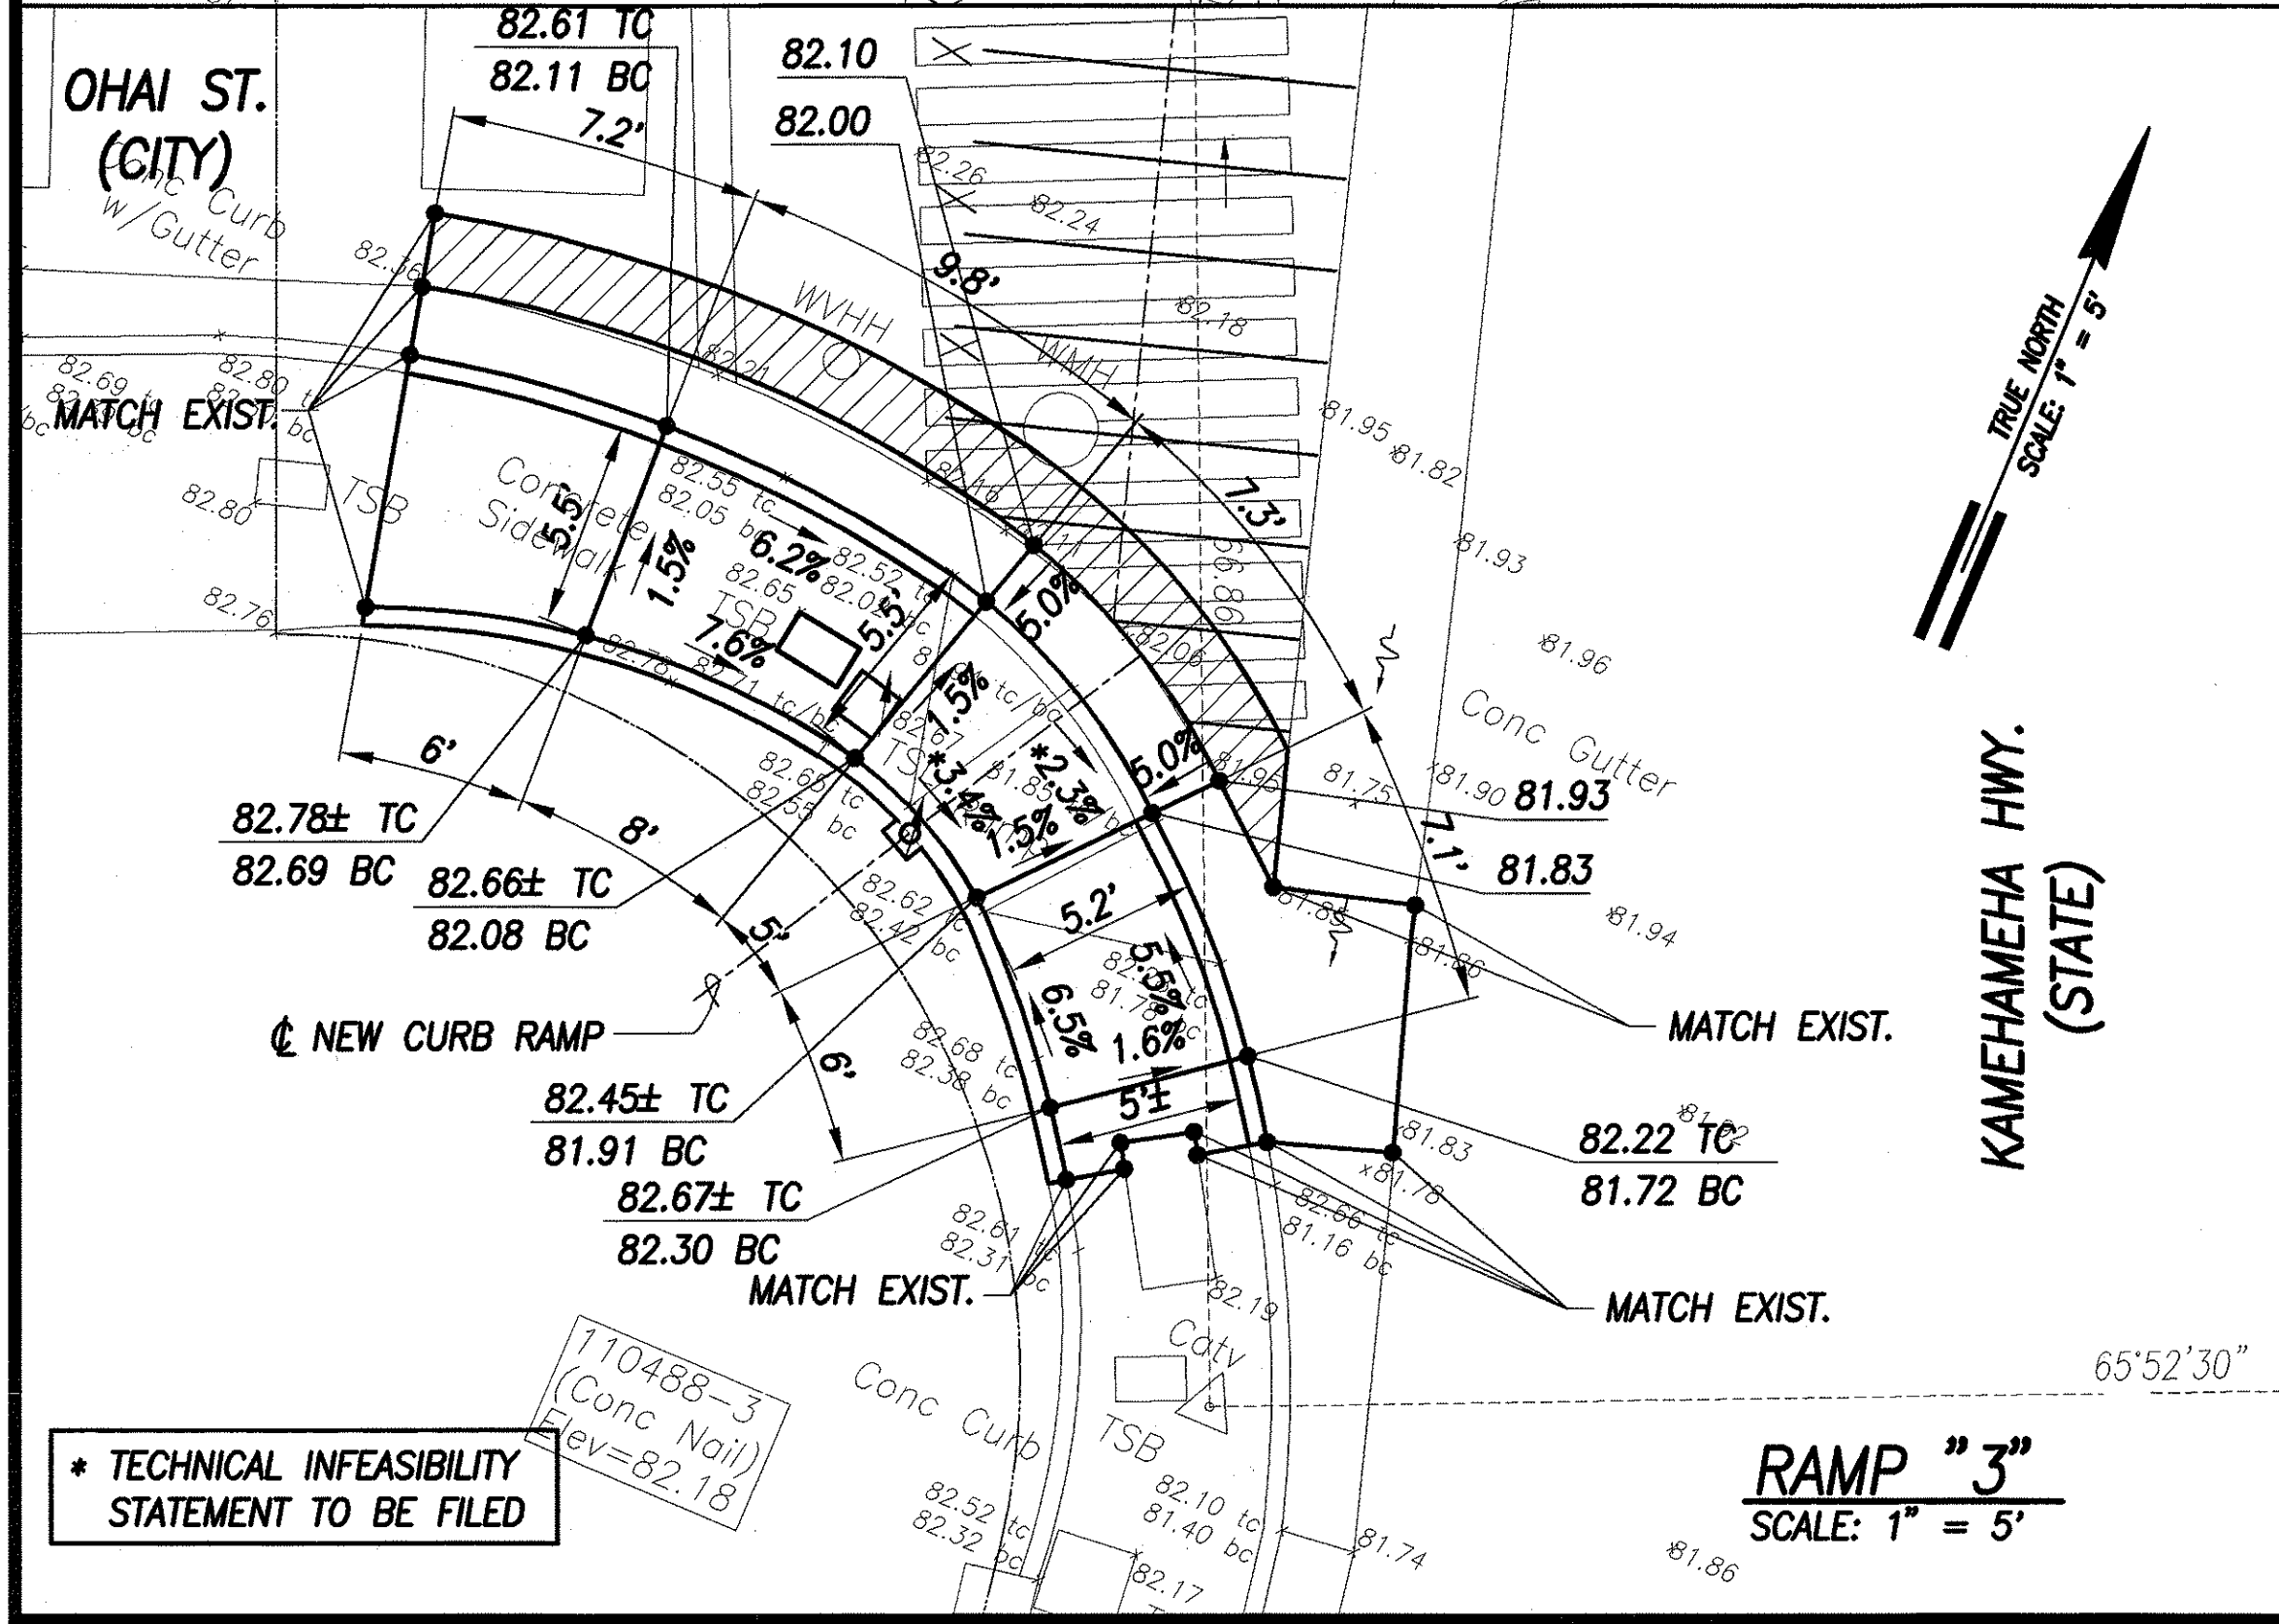

**GRADING PLAN - KAMEHAMEHA HWY.,
OHAI ST. & AVOCADO ST.
INTERS. ID NO. 80-110488 & 80-110588
SCALE: 1" = 5'**



THIS WORK WAS PREPARED BY ME OR UNDER MY SUPERVISION AND CONSTRUCTION OF THIS PROJECT WILL BE UNDER MY OBSERVATION.

SIGNATURE: *Greg H. Hiyaunono* DATE: April 30, 2006

"OBSERVATION OF CONSTRUCTION" IS DEFINED IN CHAPTER 16-115, HAWAII ADMINISTRATIVE RULES ENTITLED "PROFESSIONAL ENGINEERS, ARCHITECTS, SURVEYORS AND LANDSCAPE ARCHITECTS".

STATE OF HAWAII
DEPARTMENT OF TRANSPORTATION
HIGHWAYS DIVISION

GRADING PLAN - KAMEHAMEHA HWY., OHAI ST. & AVOCADO ST.

Pedestrian Facilities & ADA Compliance at Various Locations on Oahu, Unit 5
Fed. Aid Proj. No. CMAQ-0300(96)

Scale: 1" = 5'-0" Date: August, 2004

SHEET No. C-109 OF 153 SHEETS

SURVEY PLOTTED BY	DATE
DRAWN BY	
DESIGNED BY	
QUANTITIES BY	
CHECKED BY	
ORIGINAL PLAN	
NOTE BOOK	
No.	

FED. ROAD DIST. NO.	STATE	FED. AID PROJ. NO.	FISCAL YEAR	SHEET NO.	TOTAL SHEETS
HAWAII	HAW.	CMAQ-0300(96)	2004	113	153

TRANSITION PLAN LOCATION
80-110788-2

TMK 7-4-04: 31

TROPICAL CAR SALES

NEW CURB RAMP "1" (TYPE A),
SEE DET. ON SHT. C-19

REPLACE EXIST. PED.
PUSH BUTTONS (2),
SEE ELEC. DWGS.

DEMOLISH AND REMOVE EXIST. CONC.
SIDEWALK AND RECONSTRUCT, TYP.
SEE DET. ON SHT. C-26

RESTRIPE PORTION
OF CROSSWALK, TYP.

SAWCUT EXIST.
SIDEWALK, TYP.

PROVIDE INLET
PROTECTION
SEE DET. C-13

NEW CURB & GUTTER, TYPE 2DG
SEE STD. D-04

SAWCUT EXIST.
SIDEWALK, TYP.

RESTRIPE PORTION
OF CROSSWALK, TYP.

SAWCUT AND REMOVE A.C., AND
REPAVE, SEE PAVT. TRANS. DET. ON
SHT. C-27

KAMEHAMEHA HWY. (STATE)

BENCHMARK
"TR 110788-1"
CROSS CUT
5000.00 N
5000.00 E
ELEV.= 92.23

INSTALL NEW
PED. PUSH BUTTONS (2),
SEE ELEC. DWGS.

Right of Way on Tax Map and
DOT Right of Way Map do not
match, DOT line is shown.

NORTH STAR PAWN SHOP

TRANSITION PLAN LOCATION
80-110788-1

TMK 7-3-04: 29

SITE PLAN - KAMEHAMEHA HWY. & CALIFORNIA AVE.

INTERS. ID NO. 80-110788

SCALE: 1" = 10'

CALIFORNIA AVE. (CITY)

TRANSITION PLAN LOCATION
80-110788-3

TMK 7-4-03: 48

M.A.S.H.

REPLACE EXIST.
PED. PUSH BUTTON,
SEE ELEC. DWGS.

DEMOLISH AND REMOVE EXIST. CONC.
SIDEWALK AND RECONSTRUCT, TYP.
SEE DET. ON SHT. C-26

NEW CURB RAMP "2" (TYPE A),
SEE DET. ON SHT. C-19

INSTALL NEW
PED. PUSH BUTTON,
SEE ELEC. DWGS.

NEW CURB & GUTTER, TYPE 2DG
SEE STD. D-04

RESTRIPE PORTION
OF CROSSWALK, TYP.

101.47'
TIE: BM TO INTERSECTION OF
RAMP AND CURB FACE

REMOVE EXIST.
PED. PUSH BUTTON,
SEE ELEC. DWGS.

REMOVE EXIST.
PED. PUSH BUTTON,
SEE ELEC. DWGS.

REMOVE EXIST.
PED. PUSH BUTTON,
SEE ELEC. DWGS.

REPLACE EXIST.
PED. PUSH BUTTONS,
SEE ELEC. DWGS.

INSTALL NEW
PED. PUSH BUTTON,
SEE ELEC. DWGS.

JACK IN THE BOX

TRANSITION PLAN LOCATION
80-110788-4

TMK 7-3-02: 92

GRAPHIC SCALE

1" = 10' 10' 5' 0' 10' 20'



THIS WORK WAS PREPARED BY ME OR UNDER
MY SUPERVISION AND CONSTRUCTION OF THIS
PROJECT WILL BE UNDER MY OBSERVATION.

SIGNATURE DATE

"OBSERVATION OF CONSTRUCTION" IS DEFINED
IN CHAPTER 16-115, HAWAII ADMINISTRATIVE
RULES ENTITLED "PROFESSIONAL ENGINEERS,
ARCHITECTS, SURVEYORS AND LANDSCAPE
ARCHITECTS".

STATE OF HAWAII
DEPARTMENT OF TRANSPORTATION
HIGHWAYS DIVISION

SITE PLAN - KAMEHAMEHA
HWY. & CALIFORNIA AVE.


Pedestrian Facilities & ADA Compliance
at Various Locations on Oahu, Unit 5
Fed. Aid Proj. No. CMAQ-0300(96)

Scale: 1" = 10'-0"

Date: August 2004

SHEET No. C-112 OF 153 SHEETS

FED. ROAD DIST. NO.	STATE	FED. AID PROJ. NO.	FISCAL YEAR	SHEET NO.	TOTAL SHEETS
HAWAII	HAW.	CMAQ-0300(96)	2004	114	153

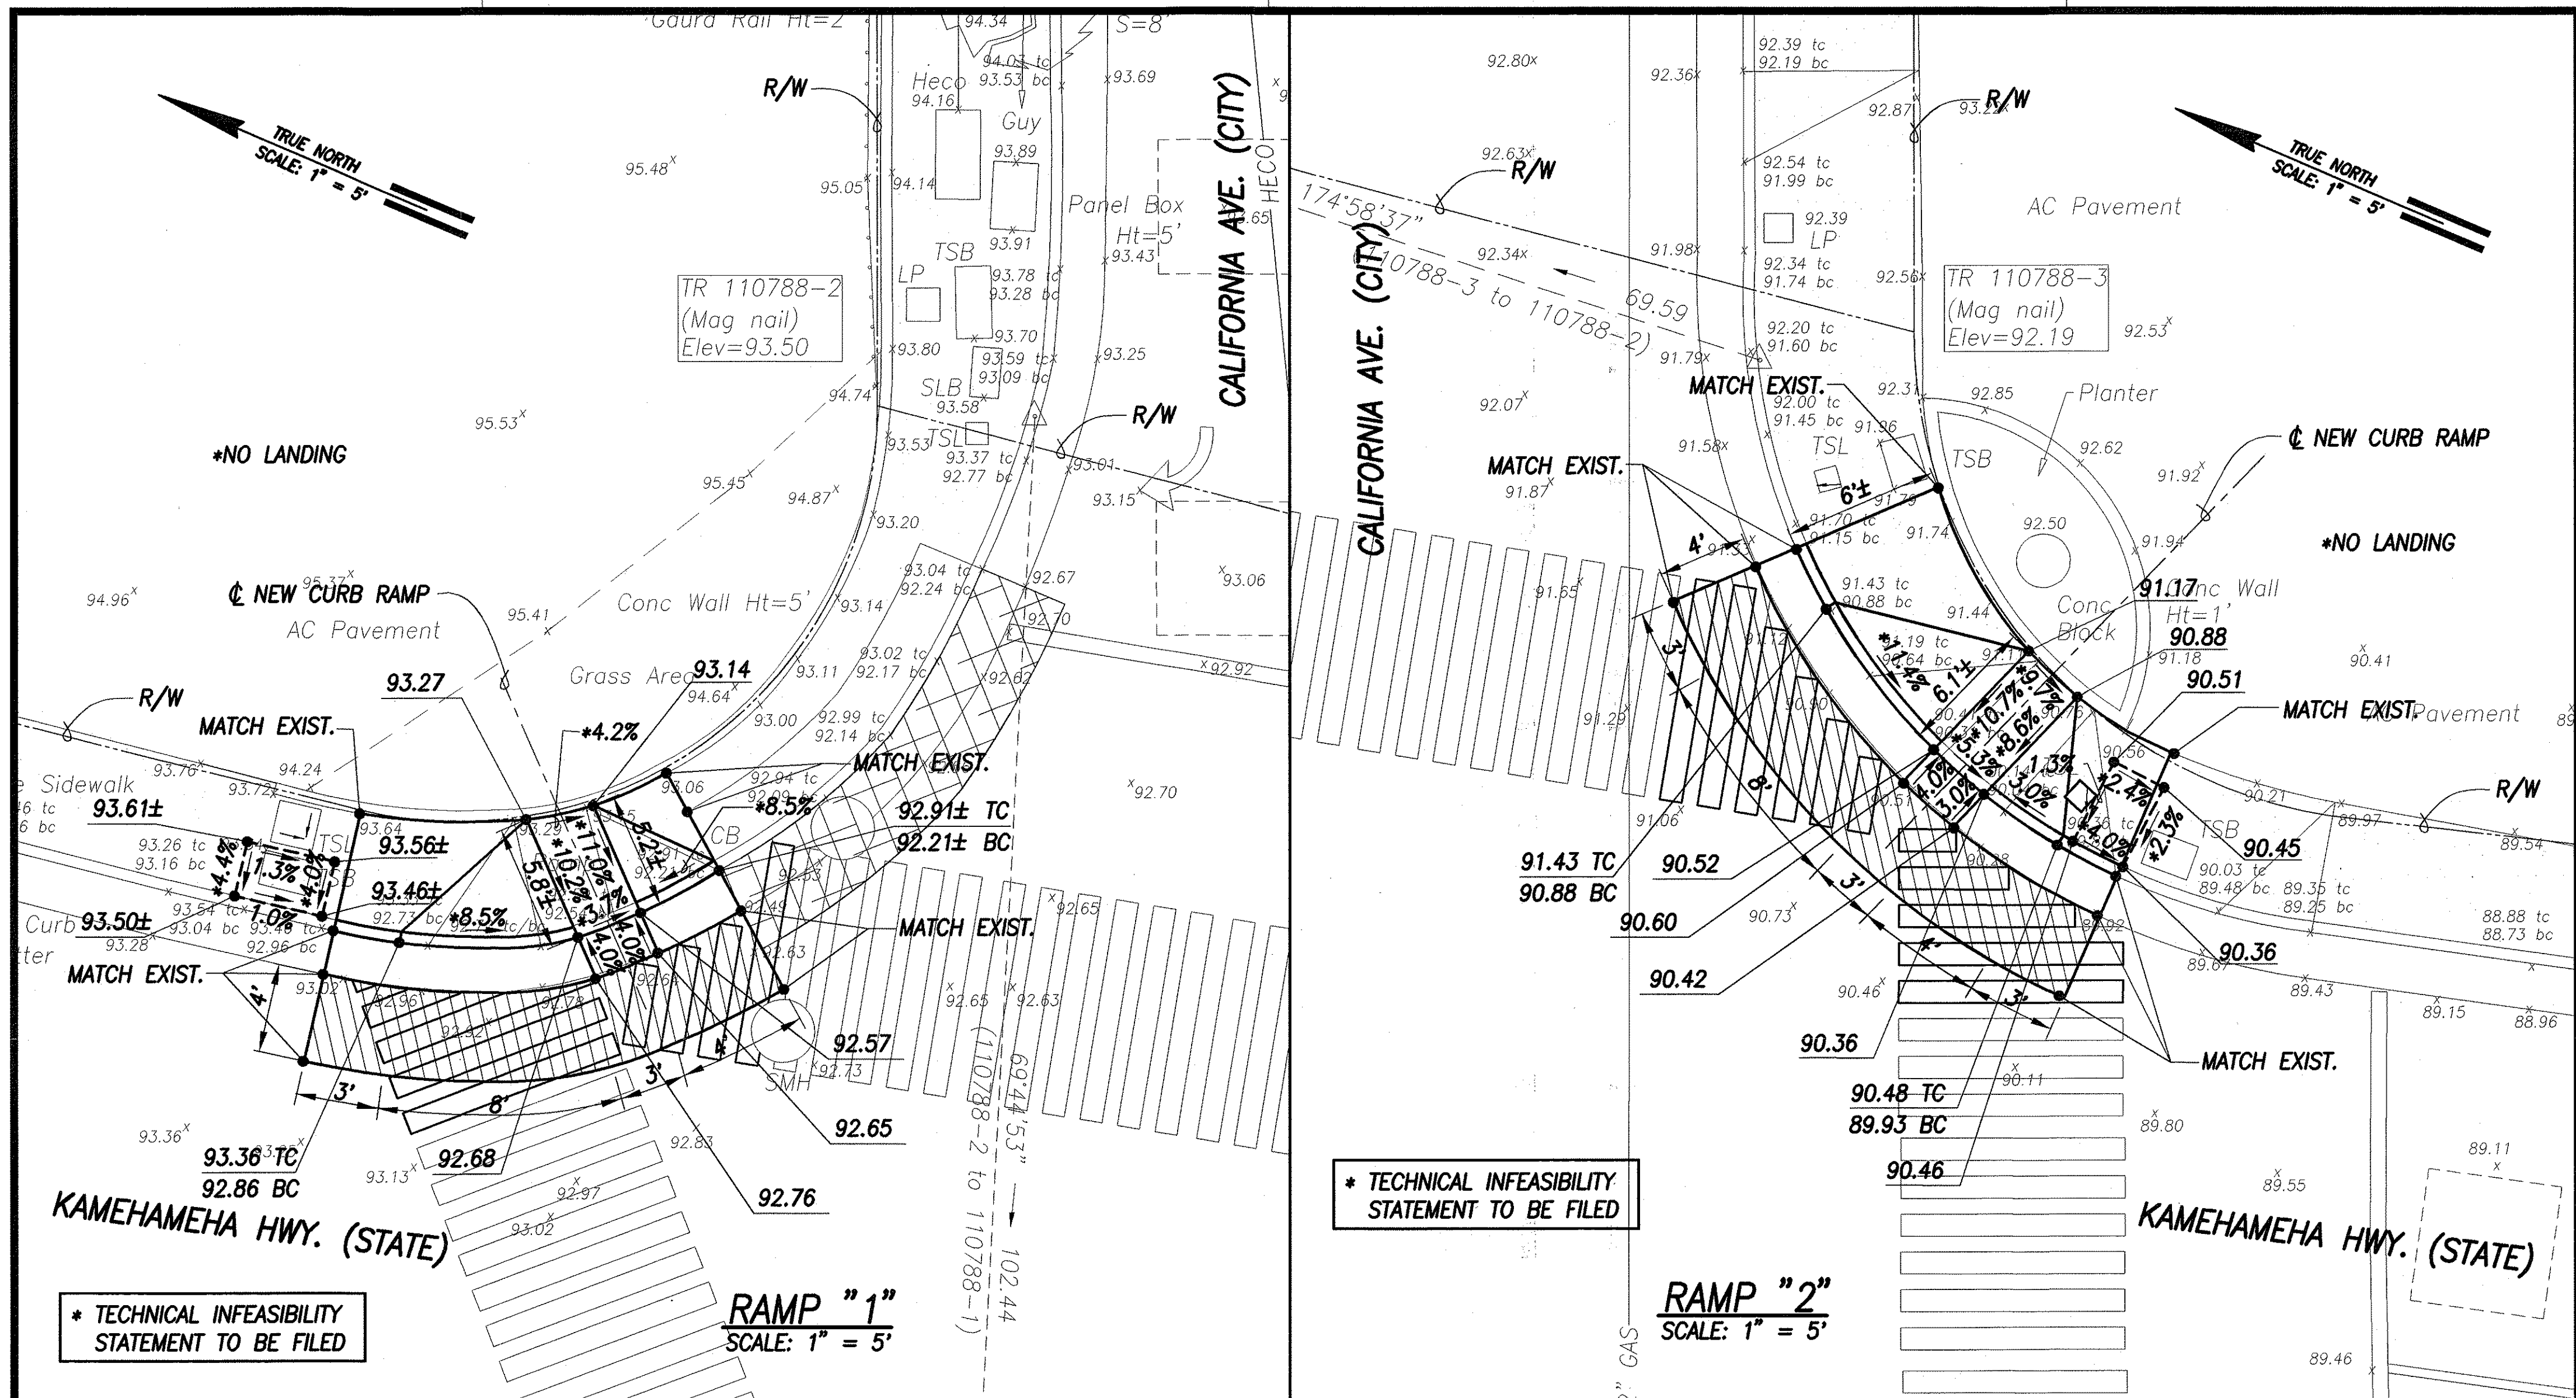

LEGEND

x 49.52	EXIST. SPOT ELEVATION
52.58	FINISHED SPOT GRADE
51.50 TC	FINISHED TOP OF CURB
51.00 BC	FINISHED BOTTOM OF CURB

GRADING PLAN - KAMEHAMEHA HWY. & CALIFORNIA AVE.
INTERS. ID NO. 80-110788
 SCALE: 1" = 5'


DATE	_____
SURVEY PLOTTED BY	_____
DRAWN BY	_____
DESIGNED BY	_____
NOTED BY	_____
CHECKED BY	_____
ORIGINAL PLAN	_____
NOTE BOOK	_____
No.	_____



THIS WORK WAS PREPARED BY ME OR UNDER MY SUPERVISION AND CONSTRUCTION OF THIS PROJECT WILL BE UNDER MY OBSERVATION.



SIGNATURE *Greg H. Hiyakundo* DATE *April 30, 2006*

"OBSERVATION OF CONSTRUCTION" IS DEFINED IN CHAPTER 16-115, HAWAII ADMINISTRATIVE RULES ENTITLED "PROFESSIONAL ENGINEERS, ARCHITECTS, SURVEYORS AND LANDSCAPE ARCHITECTS."

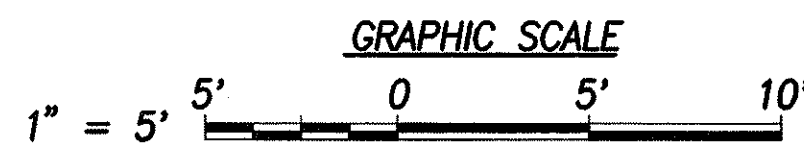


STATE OF HAWAII
 DEPARTMENT OF TRANSPORTATION
 HIGHWAYS DIVISION
GRADING PLAN - KAMEHAMEHA HWY. & CALIFORNIA AVE.
Pedestrian Facilities & ADA Compliance at Various Locations on Oahu, Unit 5
 Fed. Aid Proj. No. CMAQ-0300(96)
 Scale: 1" = 5'-0" Date: August, 2004
SHEET No. C-113 OF 153 SHEETS

FED. ROAD DIST. NO.	STATE	FED. AID PROJ. NO.	FISCAL YEAR	SHEET NO.	TOTAL SHEETS
HAWAII	HAW.	CMAQ-0300(96)	2004	115	153

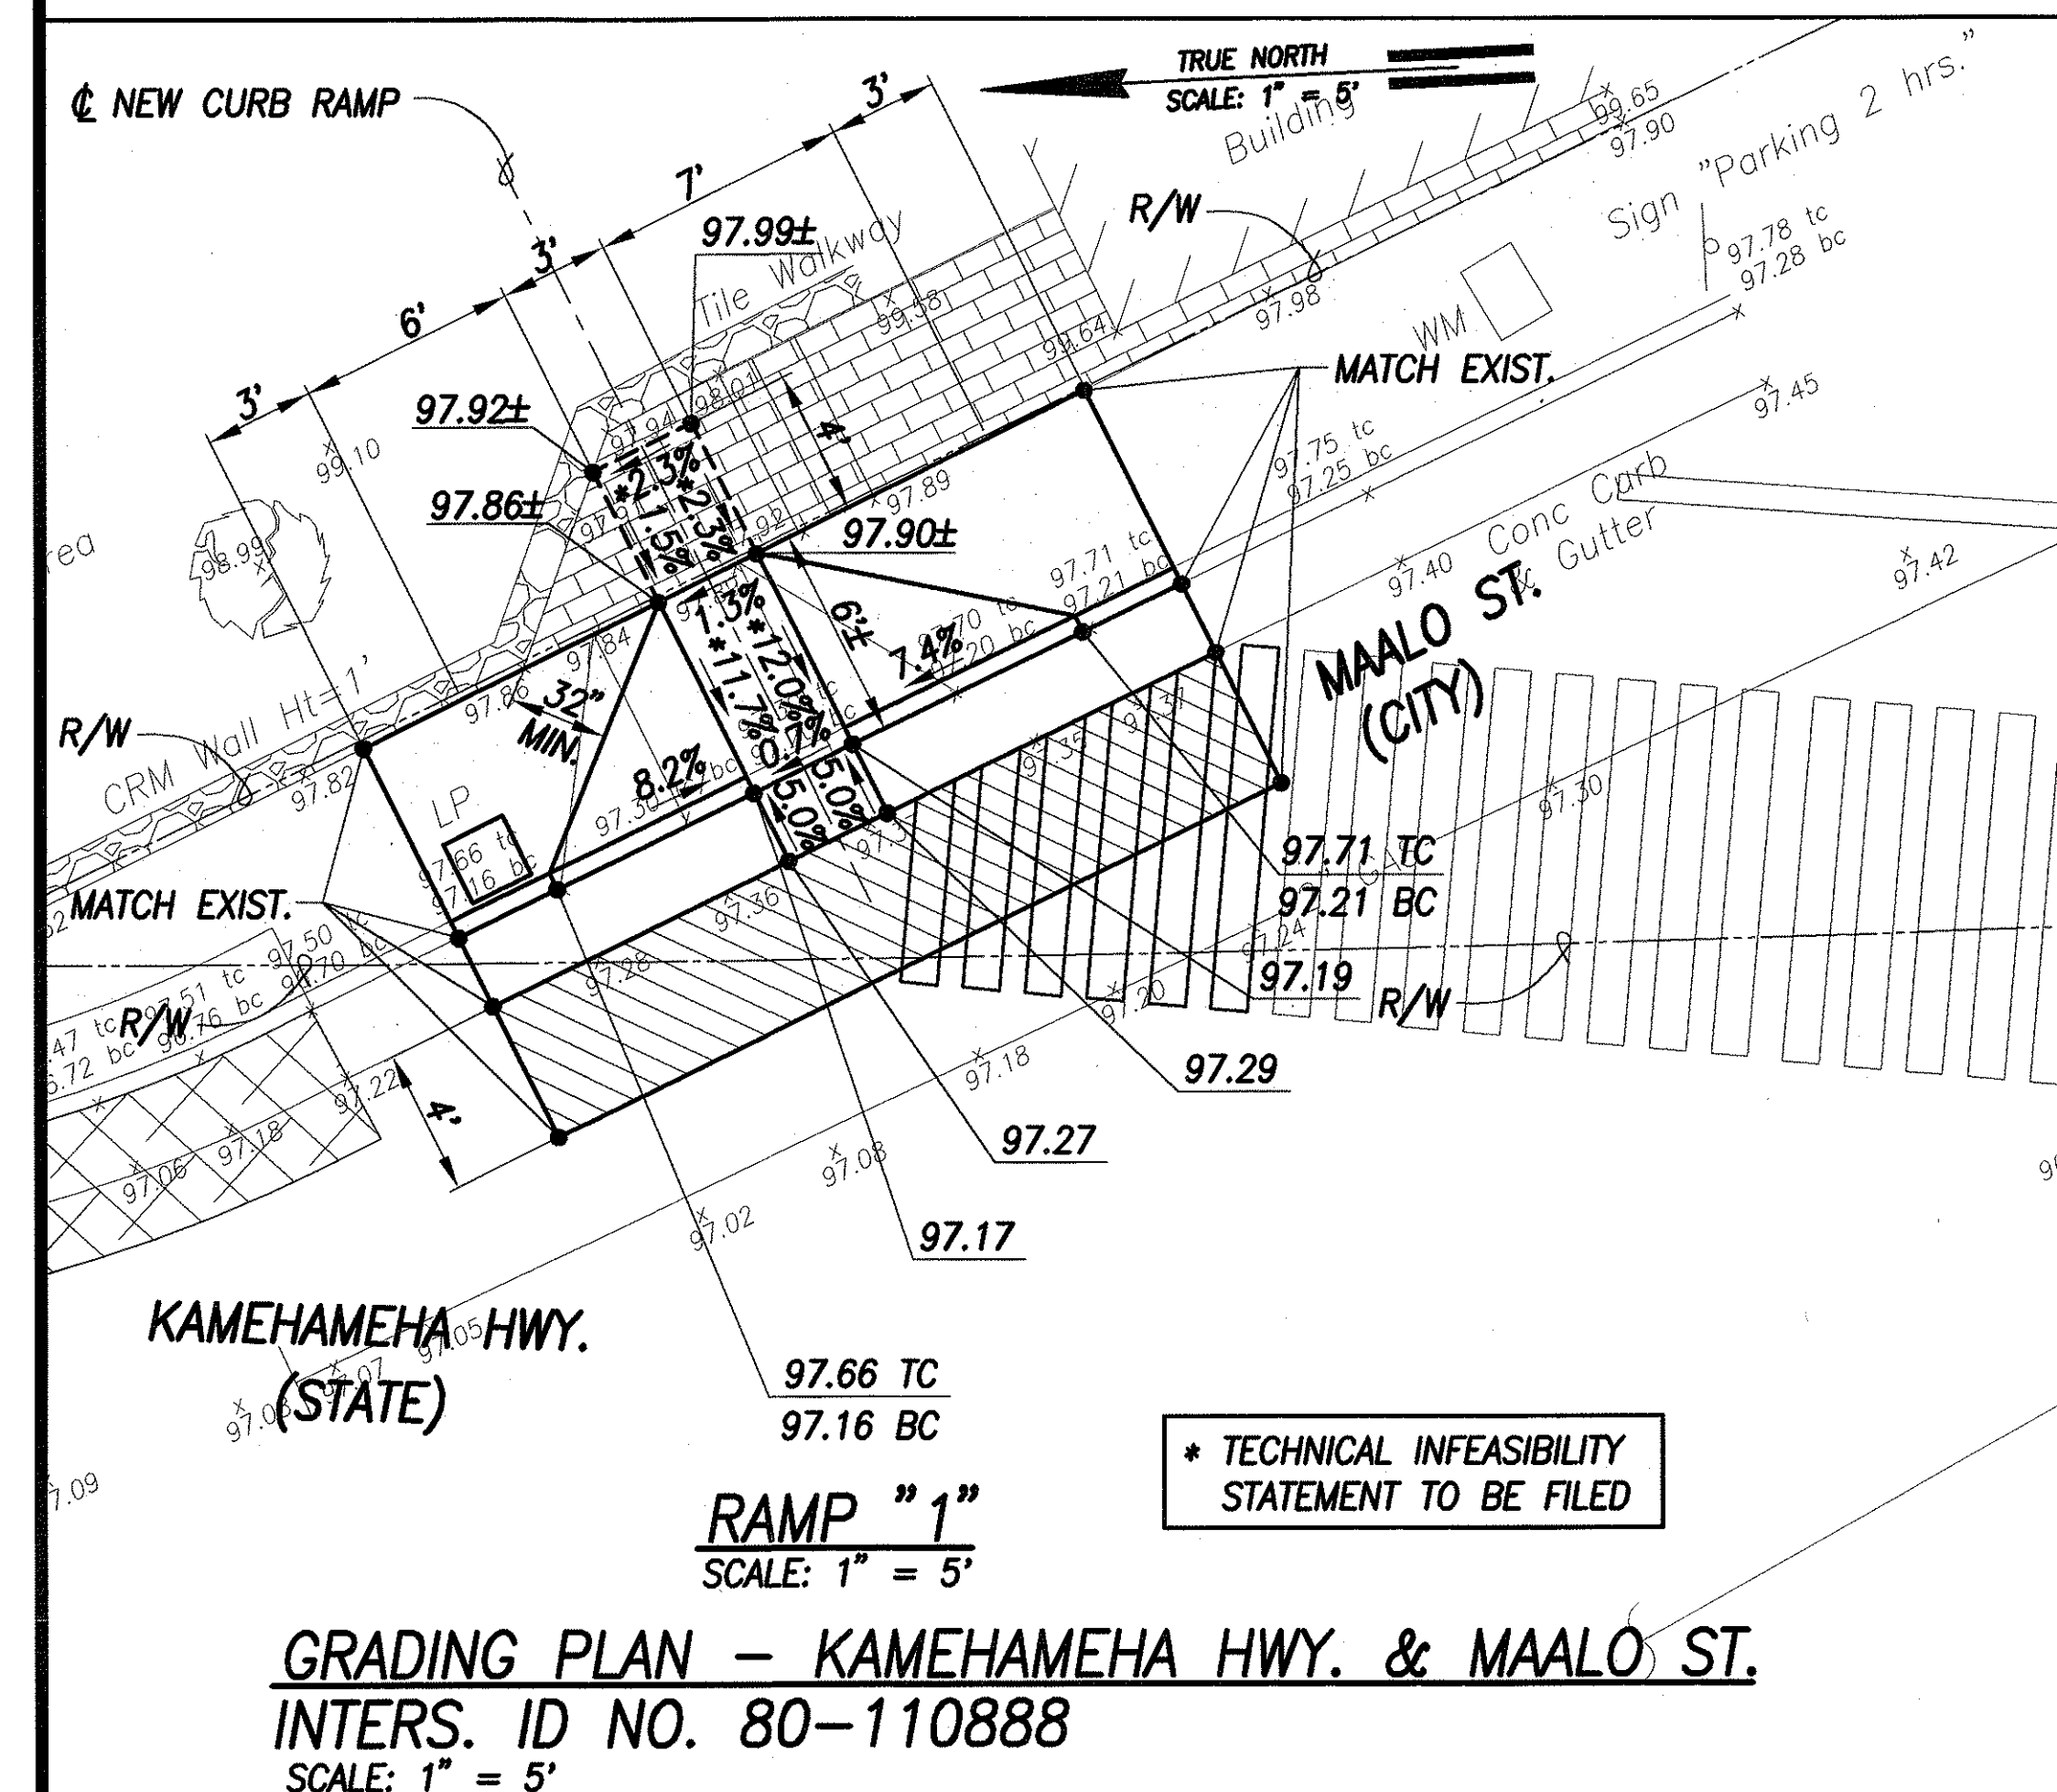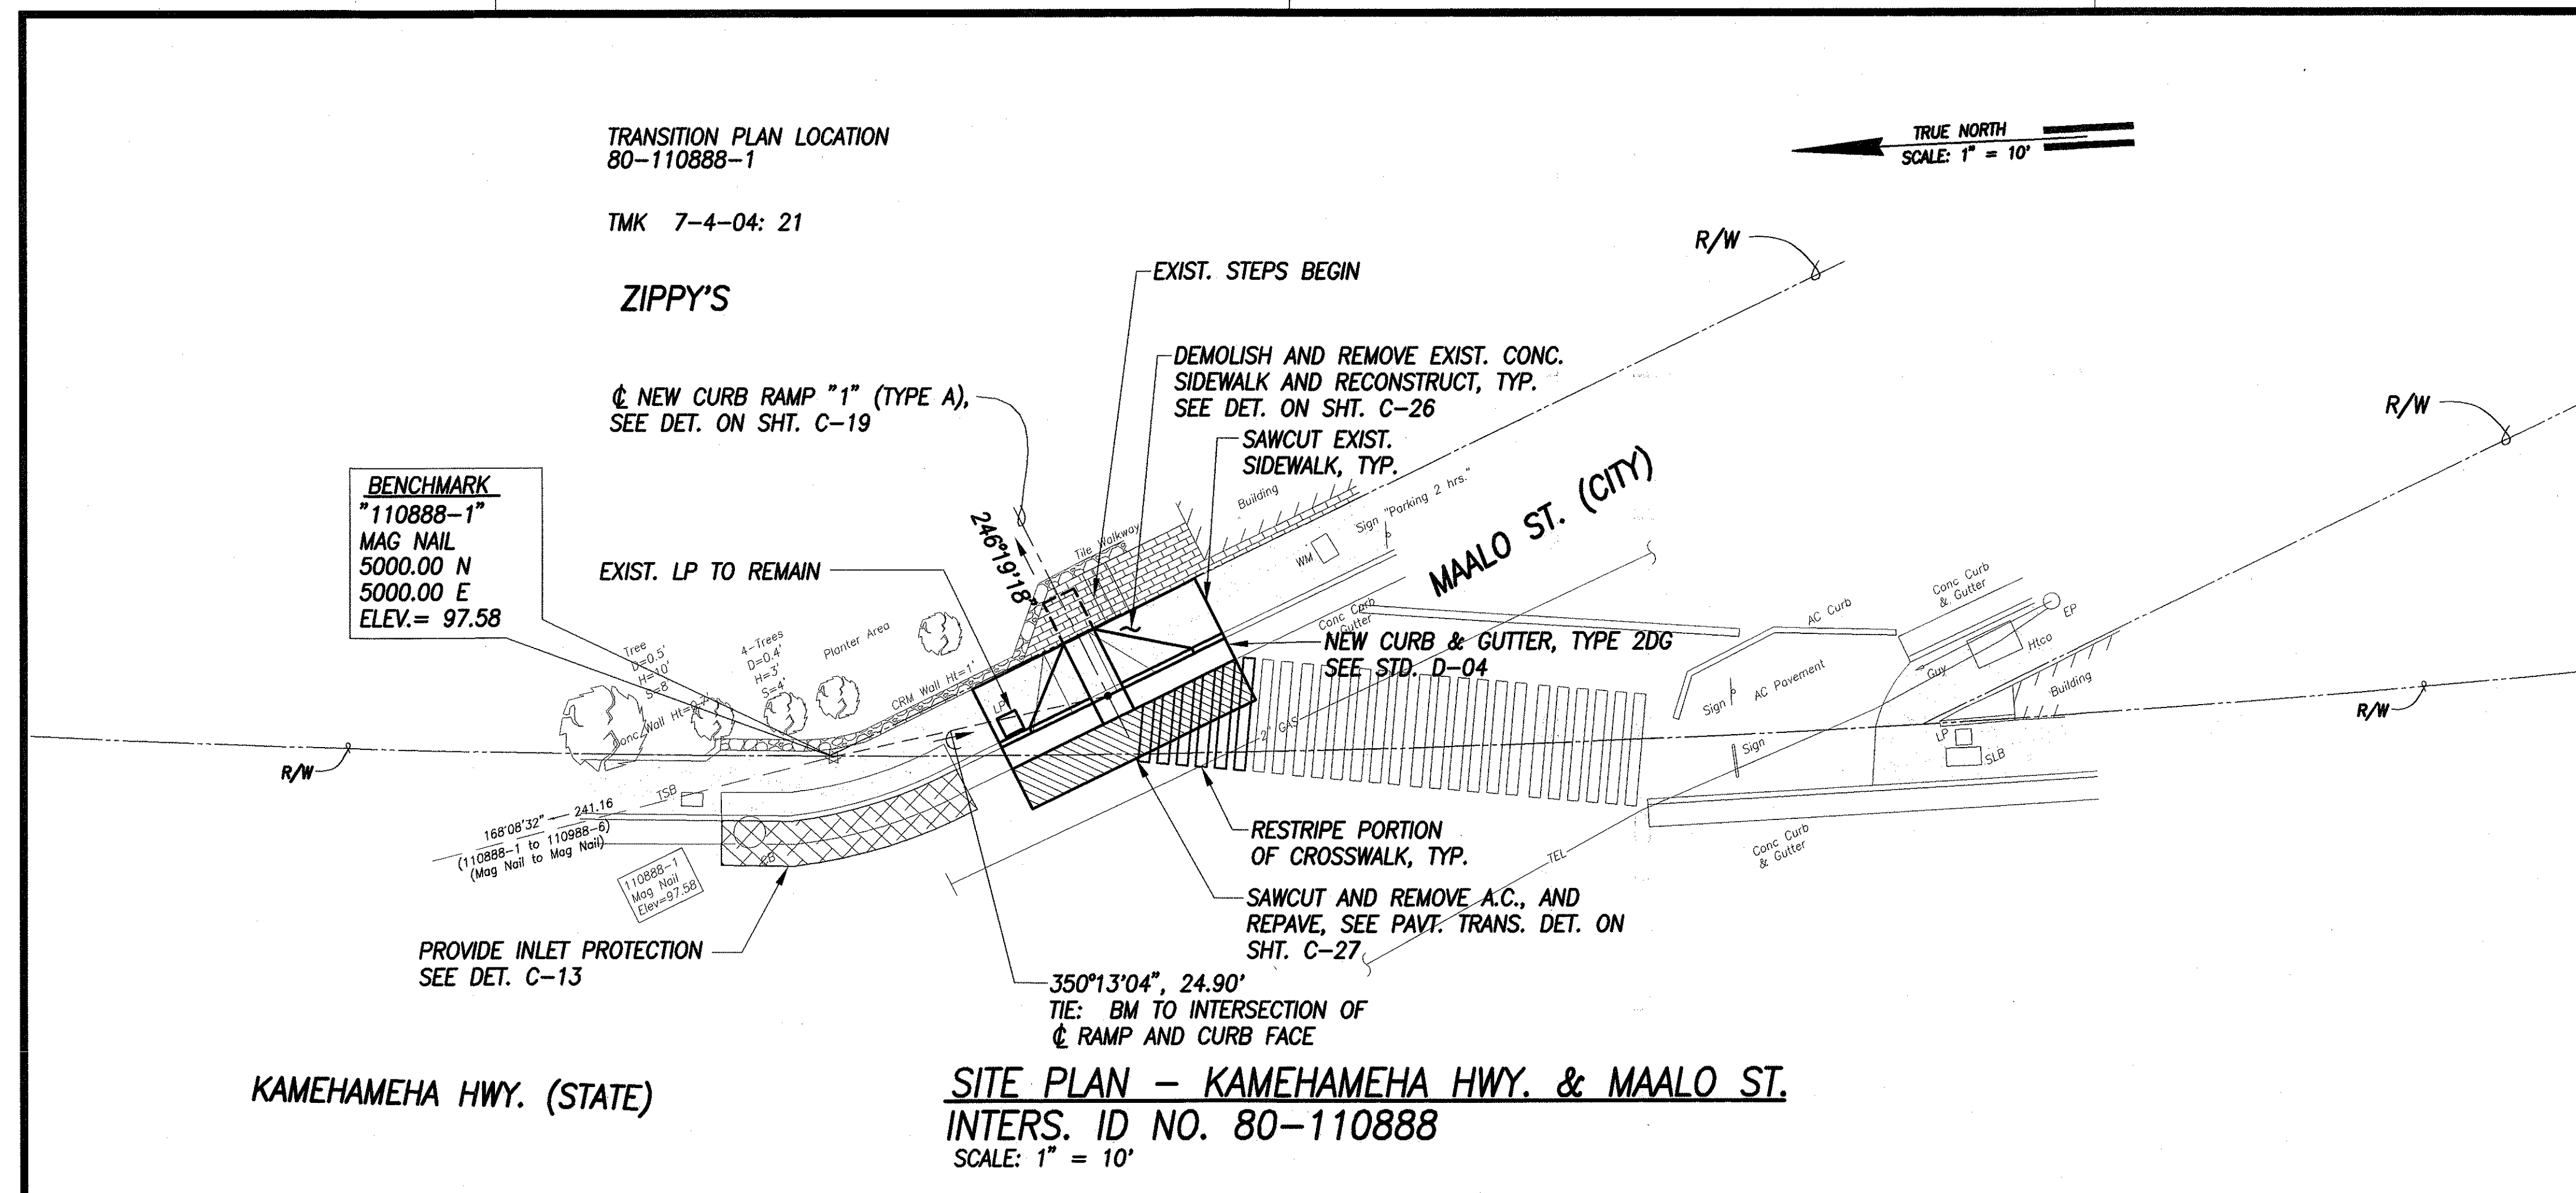

- LEGEND**
- × 49.52 EXIST. SPOT ELEVATION
 - 52.58 FINISHED SPOT GRADE
 - 51.50 TC FINISHED TOP OF CURB
 - 51.00 BC FINISHED BOTTOM OF CURB

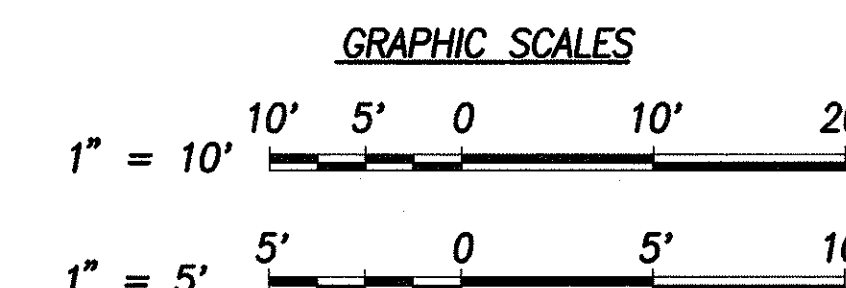

THIS WORK WAS PREPARED BY ME OR UNDER
MY SUPERVISION AND CONSTRUCTION OF THIS
PROJECT WILL BE UNDER MY OBSERVATION.

SIGNATURE *Greg H. Hiakunio* DATE April 30, 2006

"OBSERVATION OF CONSTRUCTION" IS DEFINED
IN CHAPTER 16-115, HAWAII ADMINISTRATIVE
RULES ENTITLED "PROFESSIONAL ENGINEERS,
ARCHITECTS, SURVEYORS AND LANDSCAPE
ARCHITECTS".

STATE OF HAWAII
DEPARTMENT OF TRANSPORTATION
HIGHWAYS DIVISION


SITE & GRADING PLAN
KAMEHAMEHA HWY. & MAALO ST.

*Pedestrian Facilities & ADA Compliance
at Various Locations on Oahu, Unit 5*
Fed. Aid Proj. No. CMAQ-0300(96)

Scale: AS SHOWN Date: August 2004


SHEET No. C-114 OF 153 SHEETS

FED. ROAD DIST. NO.	STATE	FED. AID PROJ. NO.	FISCAL YEAR	SHEET NO.	TOTAL SHEETS
HAWAII	HAW.	CMAQ-0300(96)	2004	116	153

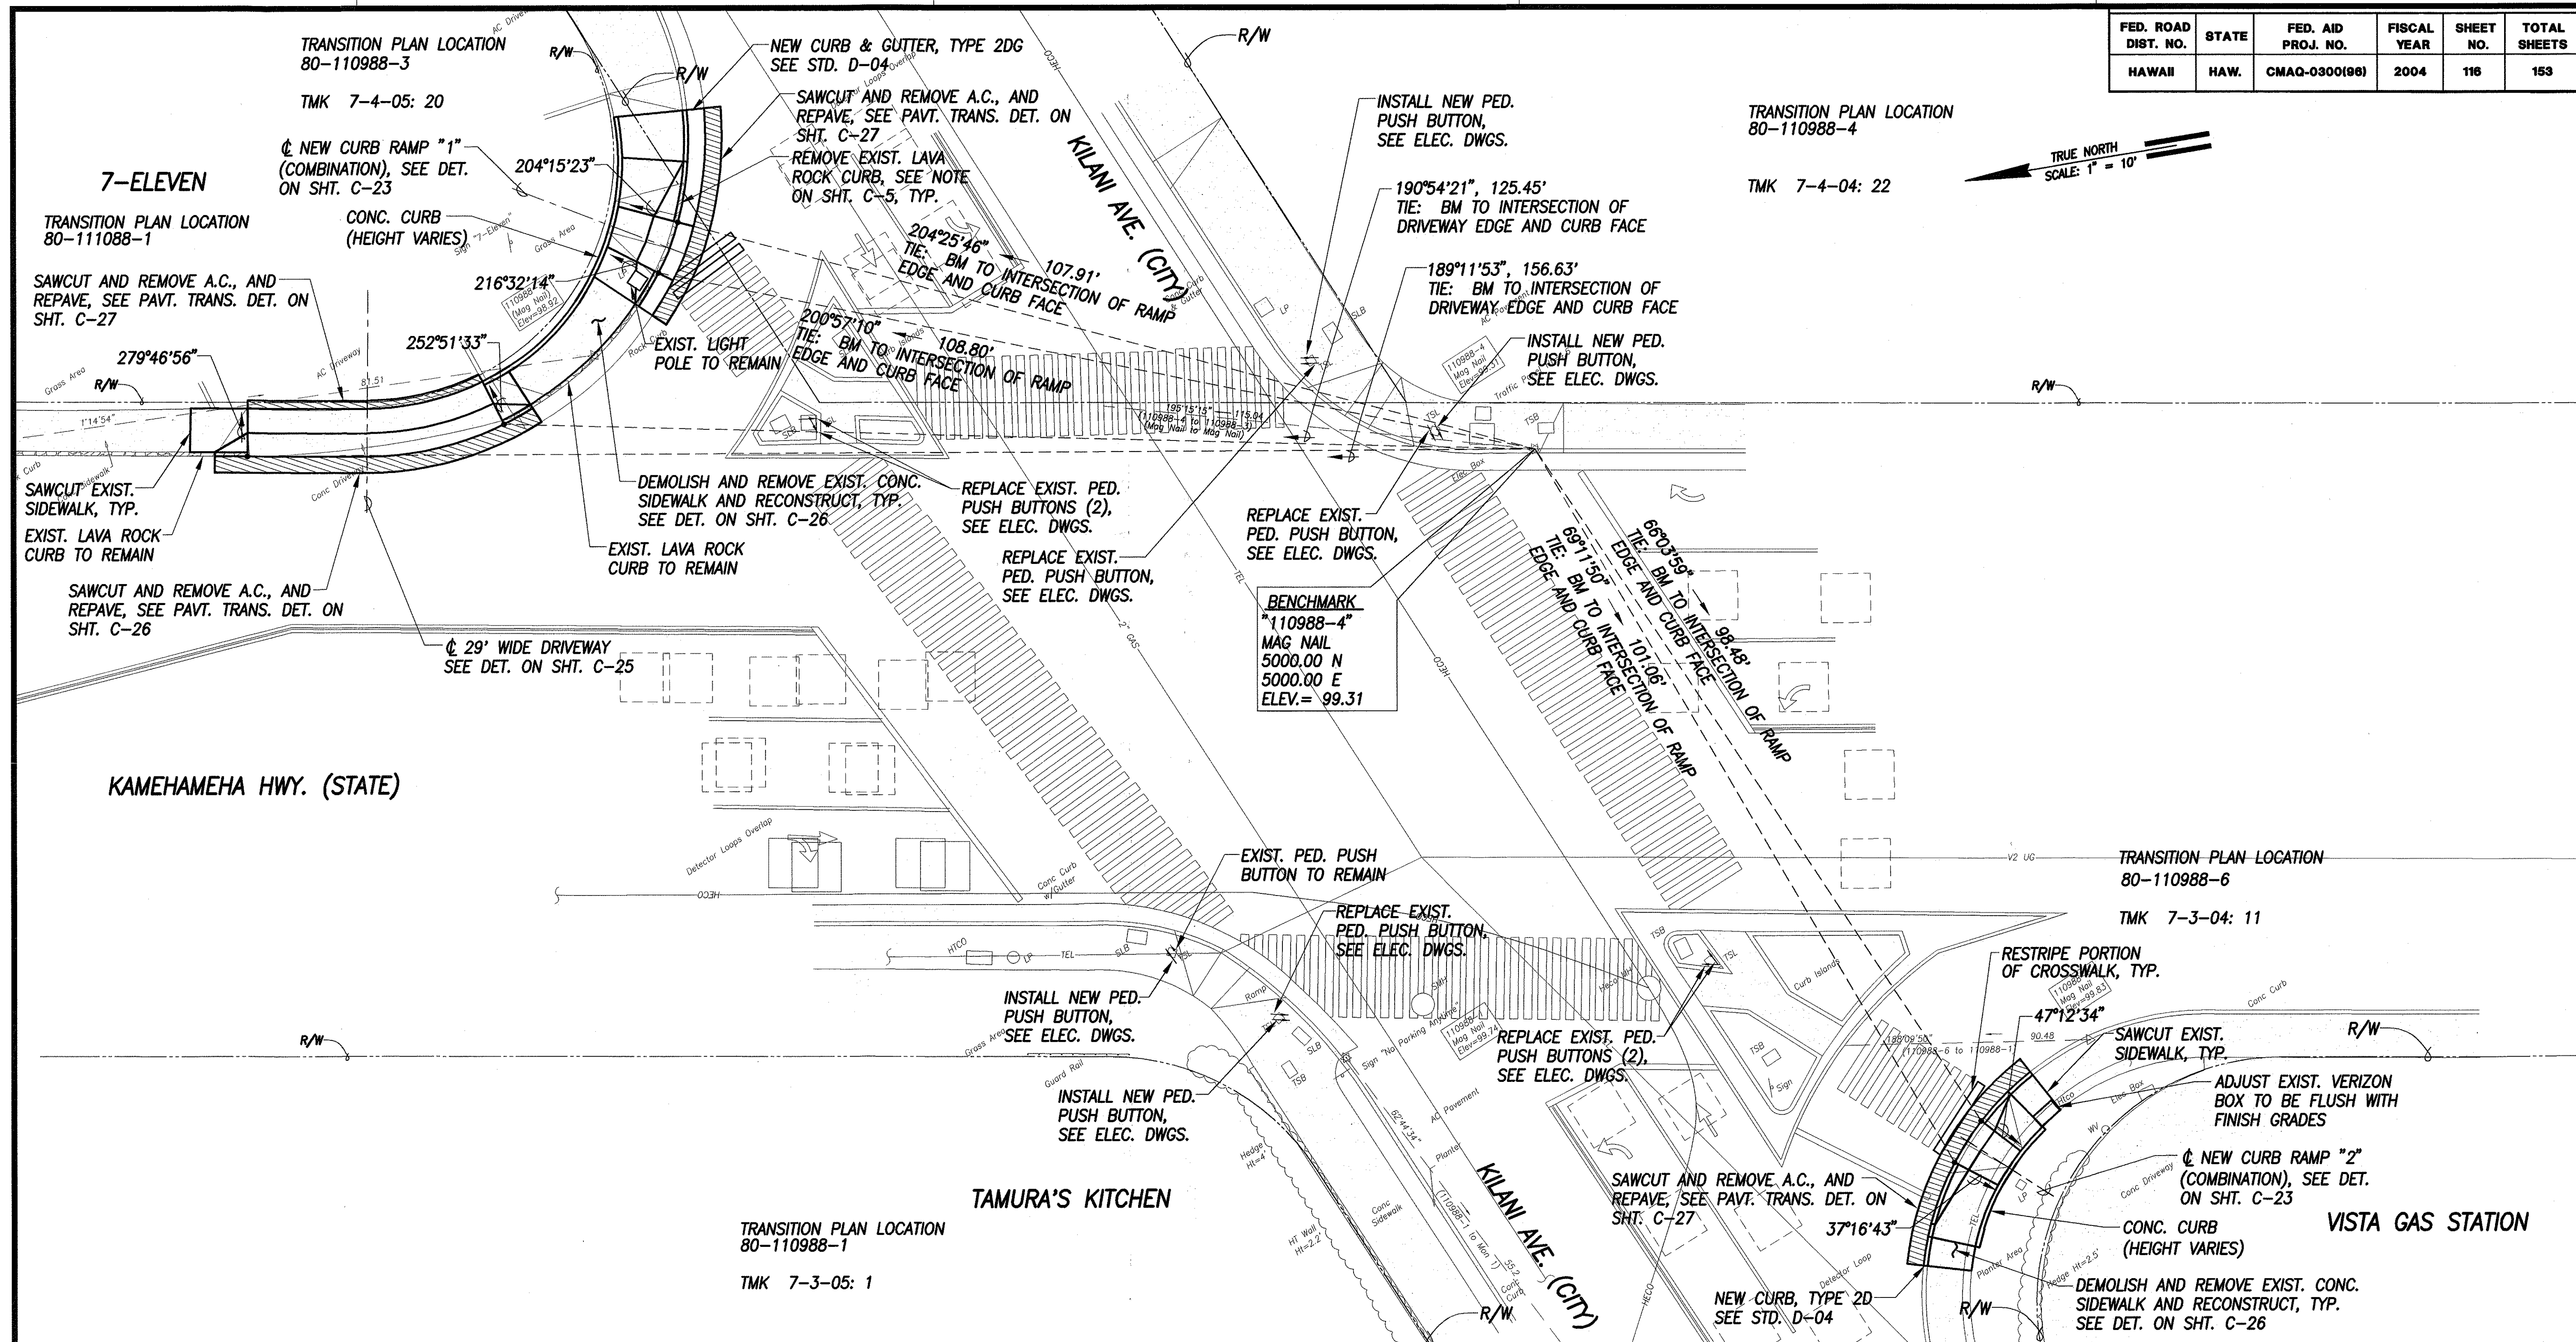

ORIGINAL PLAN	DATE
NOTE BOOK	
DESIGNED BY	
QUANTITIES BY	
CHECKED BY	

SITE PLAN - KAMEHAMEHA HWY., KILANI AVE. & 7-ELEVEN
INTERS. ID NO. 80-110988 & 80-111088
 SCALE: 1" = 10'

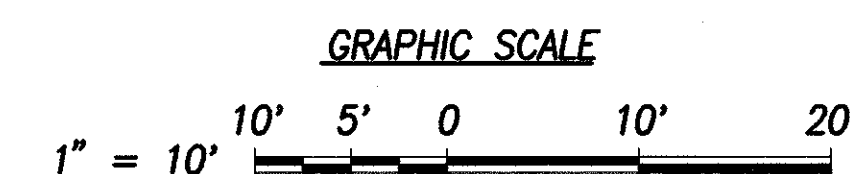

THIS WORK WAS PREPARED BY ME OR UNDER MY SUPERVISION AND CONSTRUCTION OF THIS PROJECT WILL BE UNDER MY OBSERVATION.

SIGNATURE: *Greg H. Hiyaunono* DATE: April 30, 2006

"OBSERVATION OF CONSTRUCTION" IS DEFINED IN CHAPTER 16-115, HAWAII ADMINISTRATIVE RULES ENTITLED "PROFESSIONAL ENGINEERS, ARCHITECTS, SURVEYORS AND LANDSCAPE ARCHITECTS".

STATE OF HAWAII
 DEPARTMENT OF TRANSPORTATION
 HIGHWAYS DIVISION

SITE PLAN - KAMEHAMEHA HWY., KILANI AVE. & 7-ELEVEN

Pedestrian Facilities & ADA Compliance at Various Locations on Oahu, Unit 5
 Fed. Aid Proj. No. CMAQ-0300(96)

Scale: 1" = 10'-0" Date: August 2004

SHEET No. C-115 OF 153 SHEETS

