


INDEX TO DRAWINGS	
SHEET NO.	DESCRIPTION
1	TITLE SHEET
2-3	DETAILED INDEX
4	STANDARD PLANS SUMMARY
5-13	GENERAL NOTES
14-15	LOCATION PLAN
16-37	DETAILS
38-137	CURB RAMP SITE, GRADING & TRAFFIC SIGNAL PLANS
138-139	DETECTABLE WARNING SCHEDULE
139-143	TYPICAL TRAFFIC CONTROL PLANS

TOTAL SHEET COUNT after Addendum & "As-Built" posting is 143 sheets.


STATE OF HAWAII
DEPARTMENT OF TRANSPORTATION
HIGHWAYS DIVISION
HONOLULU, HAWAII
"AS- BUILT"
PLANS FOR
PEDESTRIAN FACILITIES & ADA COMPLIANCE AT
VARIOUS LOCATIONS ON OAHU, UNIT 7
FEDERAL AID PROJECT NO. CMAQ-0300 (98)
DISTRICTS OF EWA AND WAHIAWA
ISLAND OF OAHU

FED. ROAD DIST. NO.	STATE	PROJ. NO.	FISCAL YEAR	SHEET NO.	TOTAL SHEETS
HAWAII	HAW.	CMAQ-0300(98)	2004	1	143

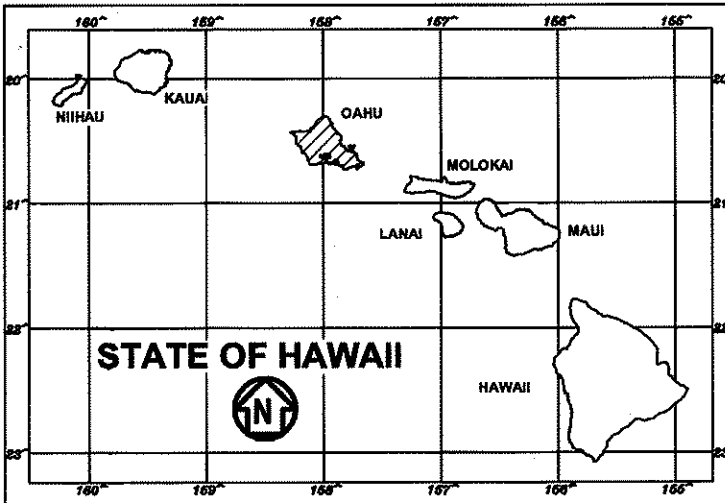

PROJECT SITES

- ① Farrington Hwy. (Route 7101)
MILE POST 20.10 TO MILE POST 0.00
- ② Fort Weaver Rd. (Route 76)
MILE POST 4.87 TO MILE POST 0.96
- ③ Kunia Rd. (Route 750)
MILE POST 7.93 TO MILE POST 0.04

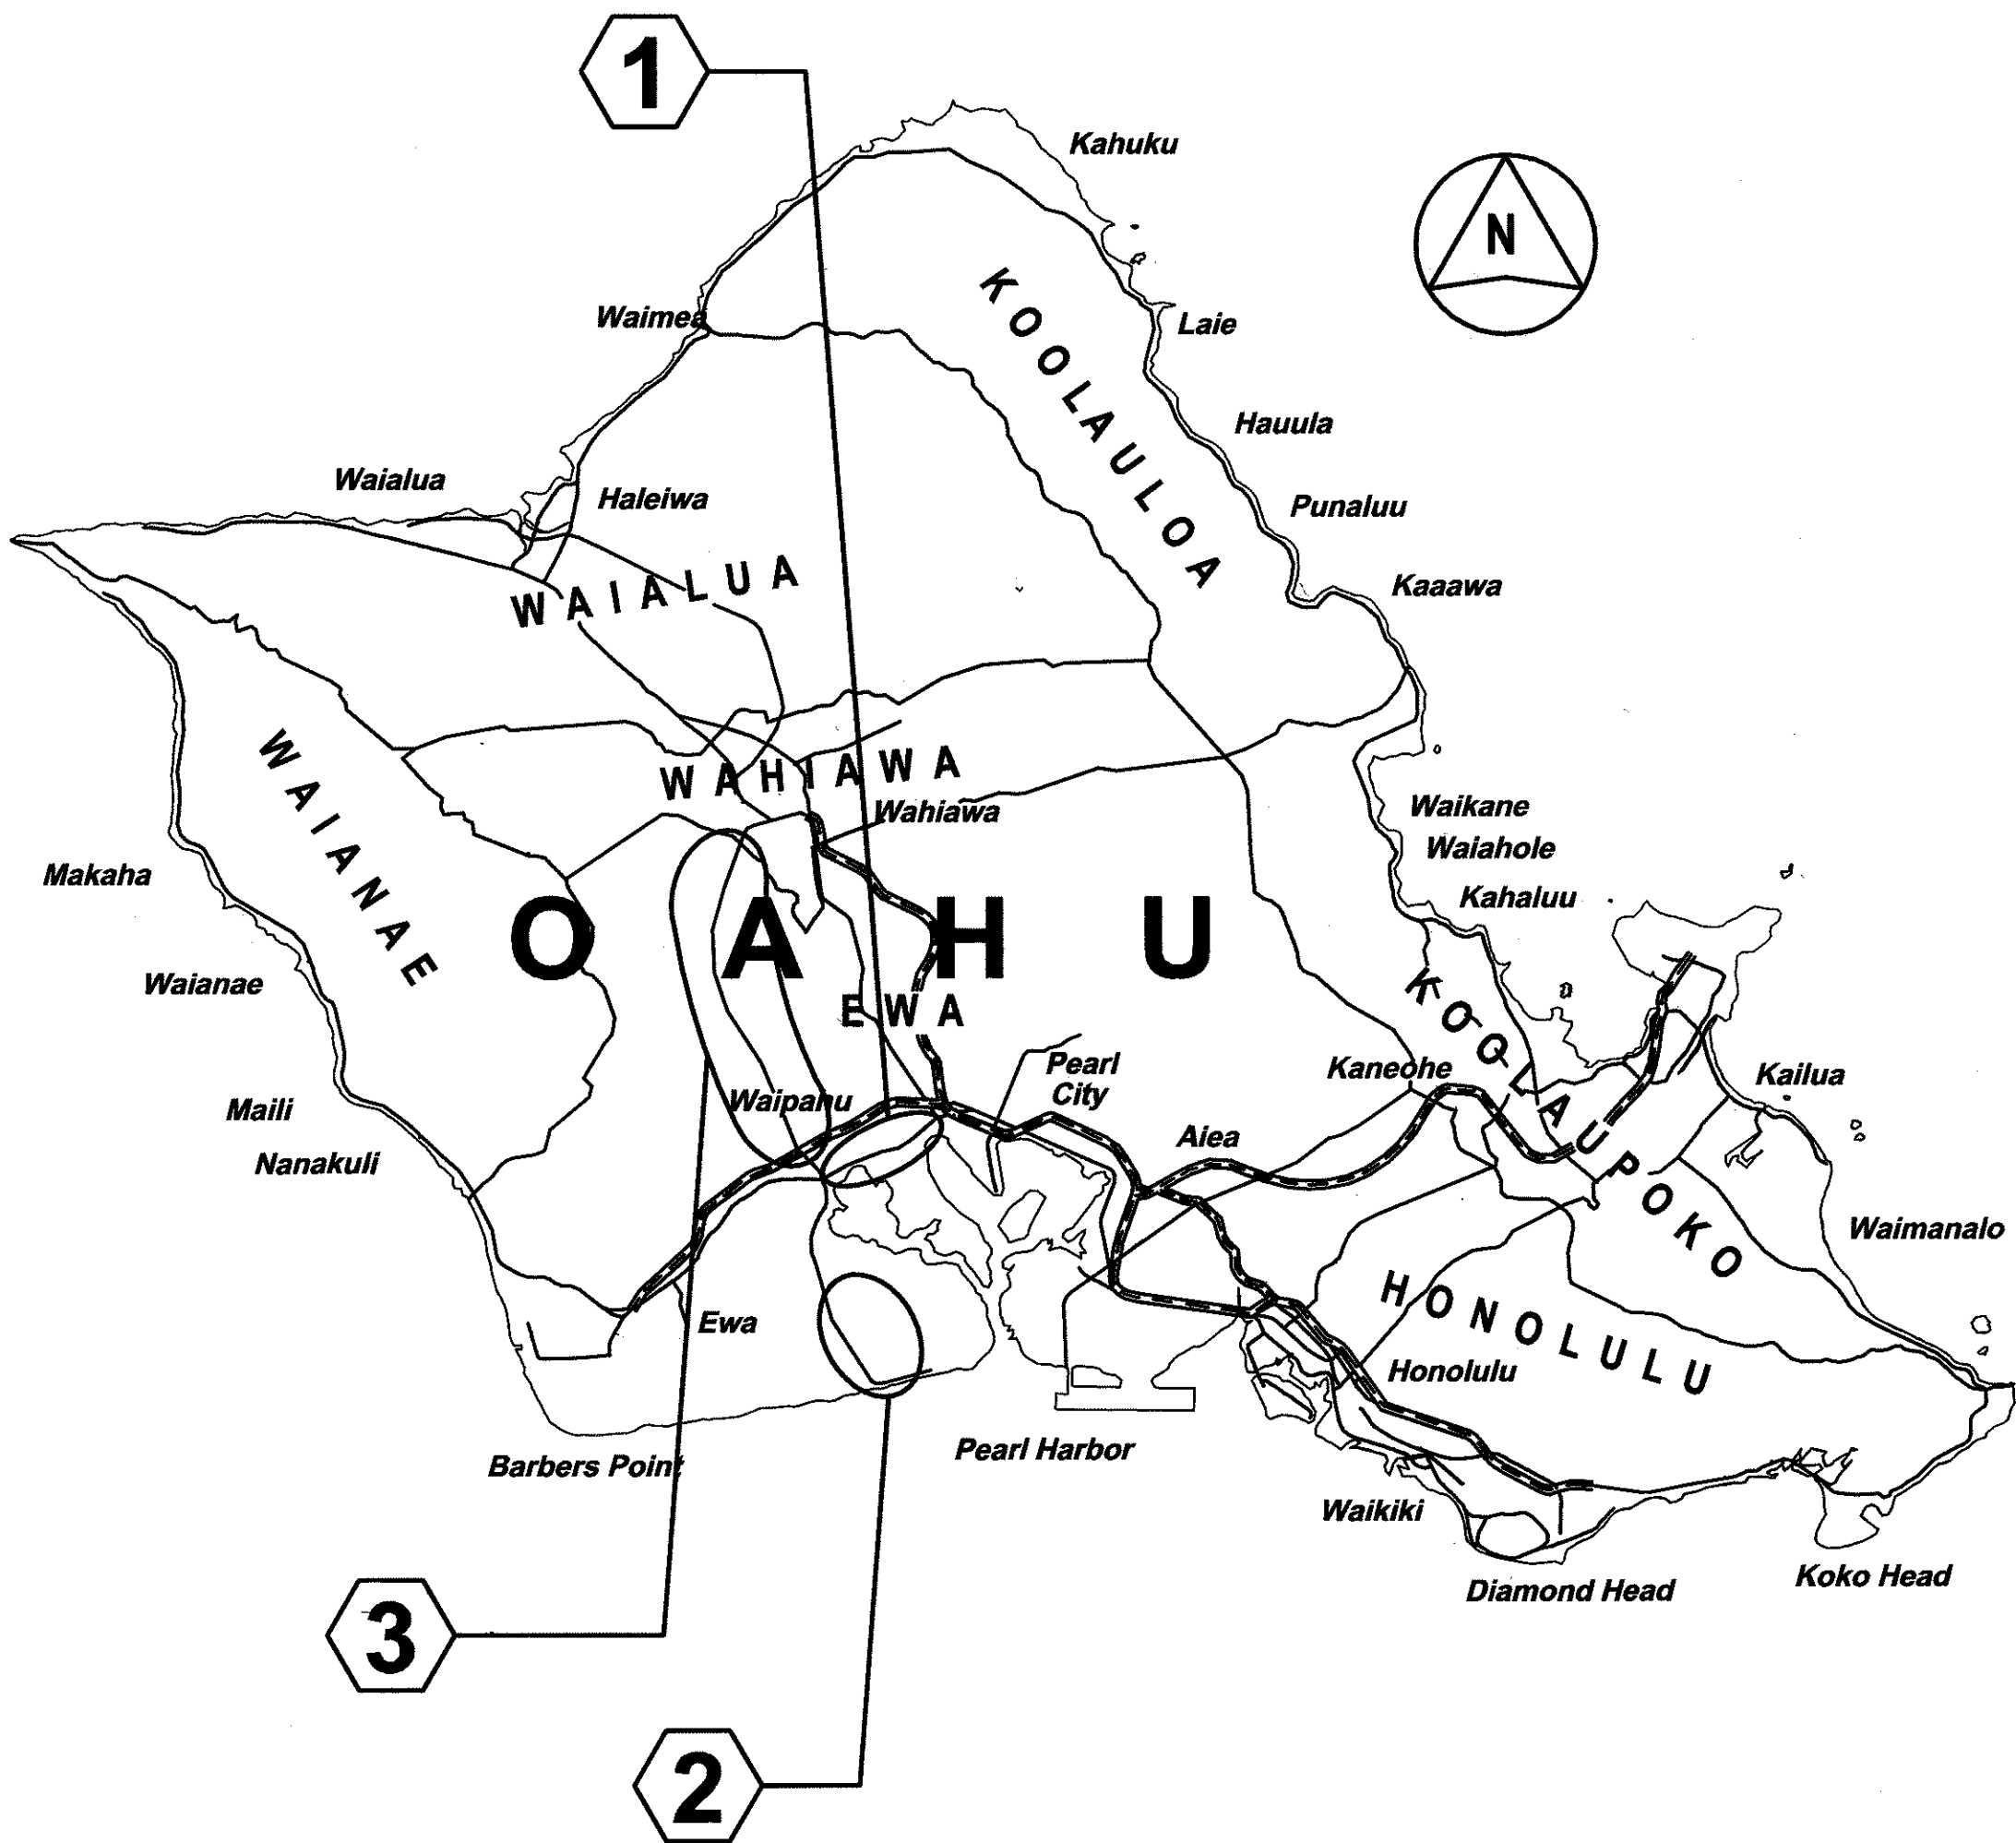

FEDERAL AID INTERSTATE PROJECTS PREVIOUSLY
CONSTRUCTED OR UNDER CONSTRUCTION

CHANGES MADE DURING CONSTRUCTION HAVE BEEN
INCORPORATED ON THESE PLANS EXCEPT CHANGES
IN THE ORIGINAL THEORETICAL QUANTITIES. FOR
ACTUAL QUANTITIES, REFER TO PROJECT LEDGER
AND/OR COMPUTATION BOOK.

RESIDENT ENGINEER DATE

DEPARTMENT OF TRANSPORTATION STATE OF HAWAII	
APPROVED:	
DIR. OF TRANSPORTATION	8-27-04 DATE

"AS-BUILT" 1