
′
<u>)6</u>
PLANS
SANDAR WOOD OF THE STREET
n = 1 - 1 - 1 - 1 - 1 - 1 - 1 - 1 - 1 - 1

Plan Sht, Nos. 1 ADD. 56, 2 ADD. III,
3 ADD. 120, 4 ADD. 154, 5 ADD. 160 S-1,
and 6 ADD. 178 are supplementary sheets to this project, added during Addendum &

TOTAL SHEET COUNT after Addendum & "AS-BUILT" postings is 183 sheets.

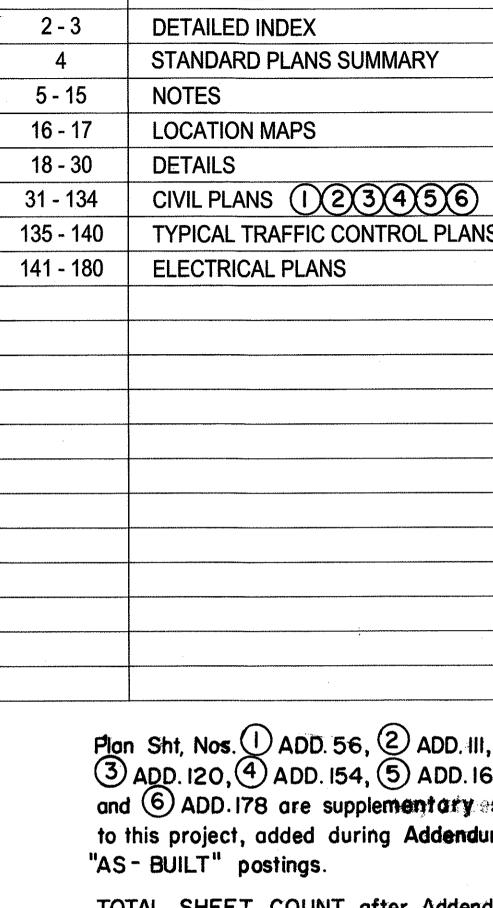


STATE OF HAWAII

DEPARTMENT OF TRANSPORTATION

HIGHWAYS DIVISION HONOLULU, HAWAII "AS-BUILT" PLANS FOR





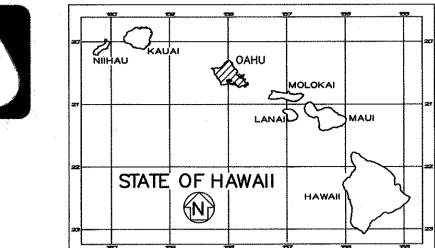


FEDERAL AID PROJ. NO.

CMAQ-0300(99)

PEDESTRIAN FACILITIES & ADA COMPLIANCE

AT VARIOUS LOCATIONS ON OAHU, UNIT 8 FEDERAL AID PROJECT NO. CMAQ-0300(99)

> DISTRICT OF HONOLULU ISLAND OF OAHU

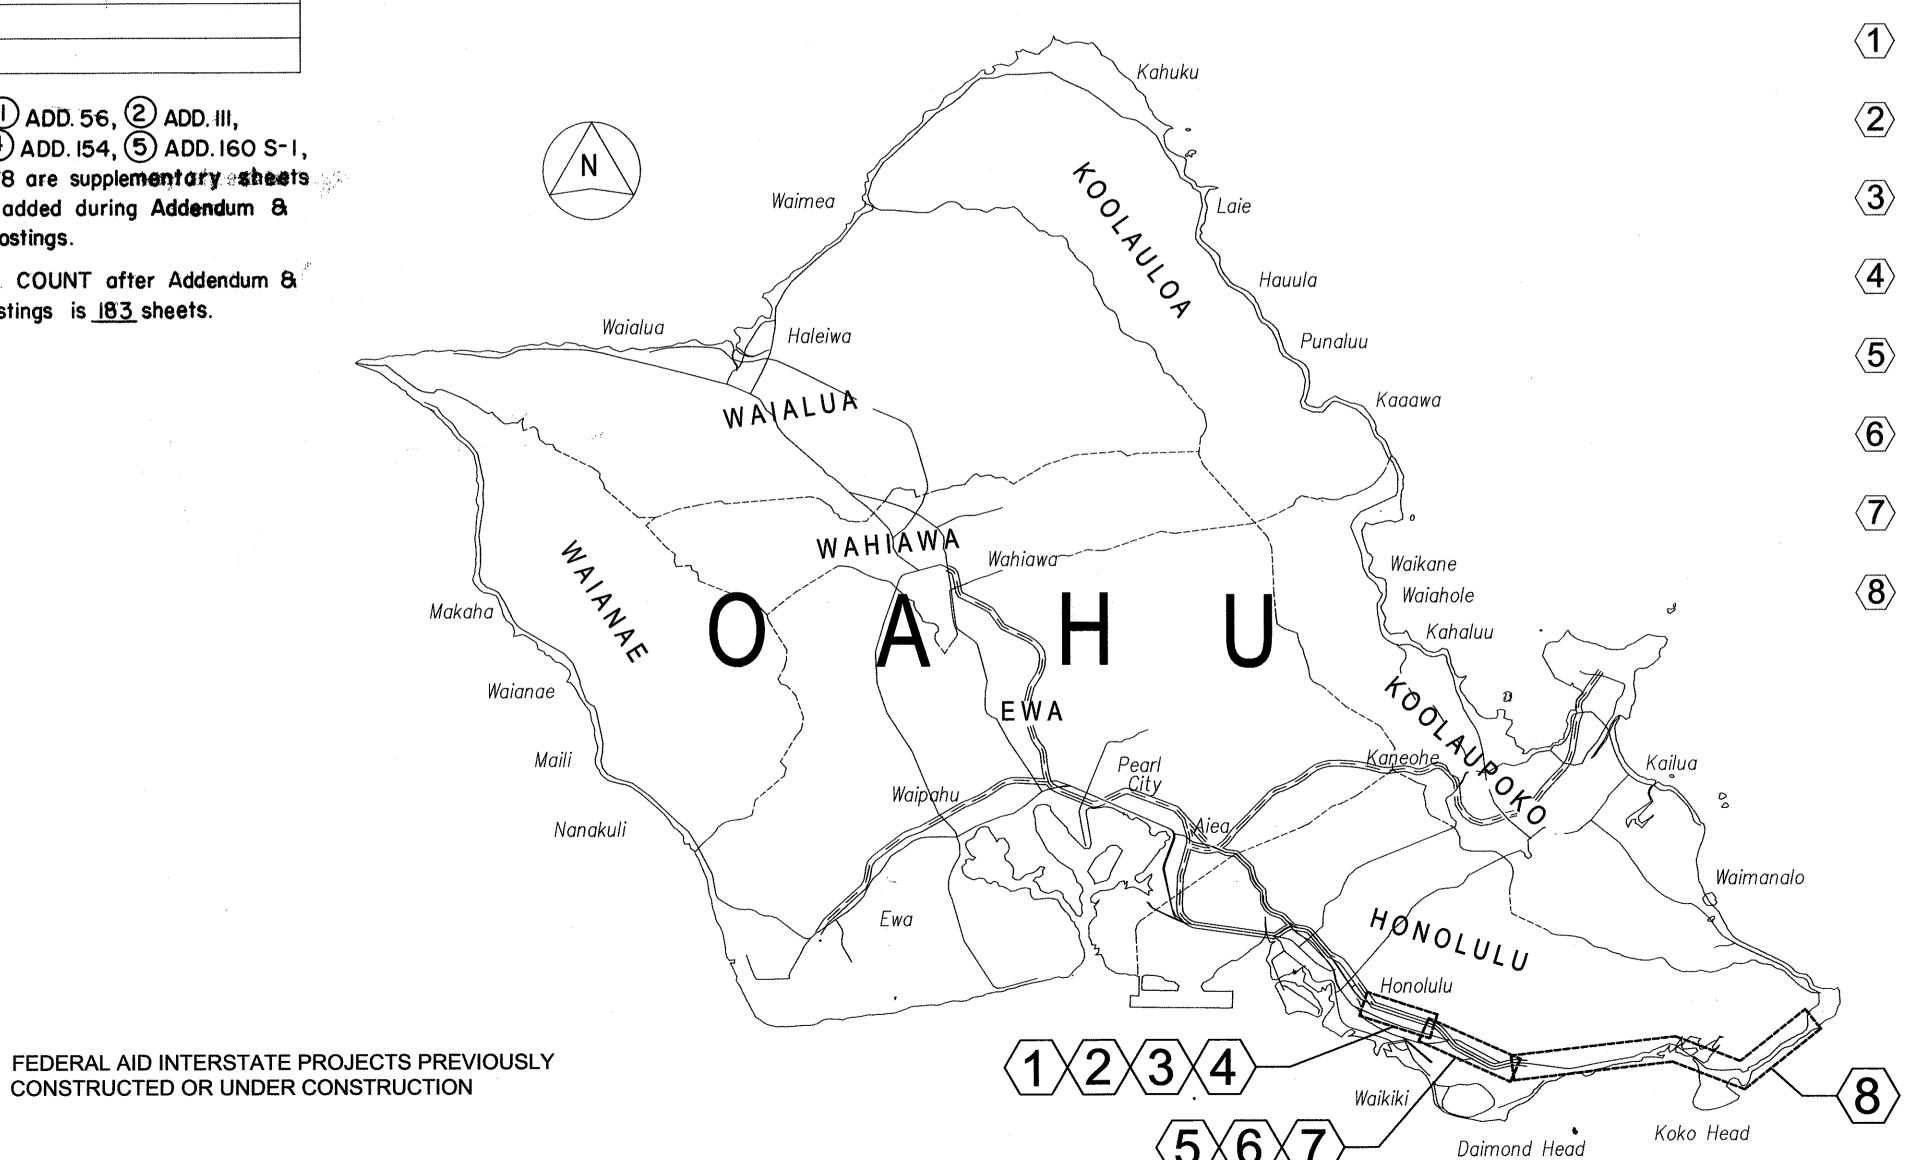

PROJECTS SITES

- Lunalilo Street, Route H-1 MILE POST 22.46
- Keeaumoku Street, Route H-1 MILE POST 21.88
- Bingham Street, Route H-1 MILE POST 23.05 TO MILE POST 23.61
- McCully Street, Route H-1 MILE POST 23.71
- Waiaka Road, Route H-1 MILE POST 24.56 TO MILE POST 24.70
- Harding Avenue, Route H-1 MILE POST 24.70 TO MILE POST 24.83
- Koko Head Avenue, Route H-1 MILE POST <u>26.85</u>
- Kalanianaole Highway, Route 72 MILE POST 13.26 TO MILE POST 18.46

CHANGES MADE DURING CONSTRUCTION HAVE BEEN INCORPORATED ON THESE PLANS EXCEPT CHANGES IN THE ORIGINAL THEORETICAL QUANTITIES. FOR ACTUAL QUANTITIES, REFER TO PROJECT LEDGER AND/OR COMPUTATION BOOK.

Maryn C. H. Judgedd RESIDENT ENGINEER

11-08-2007 DATE

DEPARTMENT OF TRANSPORTATION STATE OF HAWAII APPROVED: DIR. OF TRANSPORTATION 8.27.04 DATE