
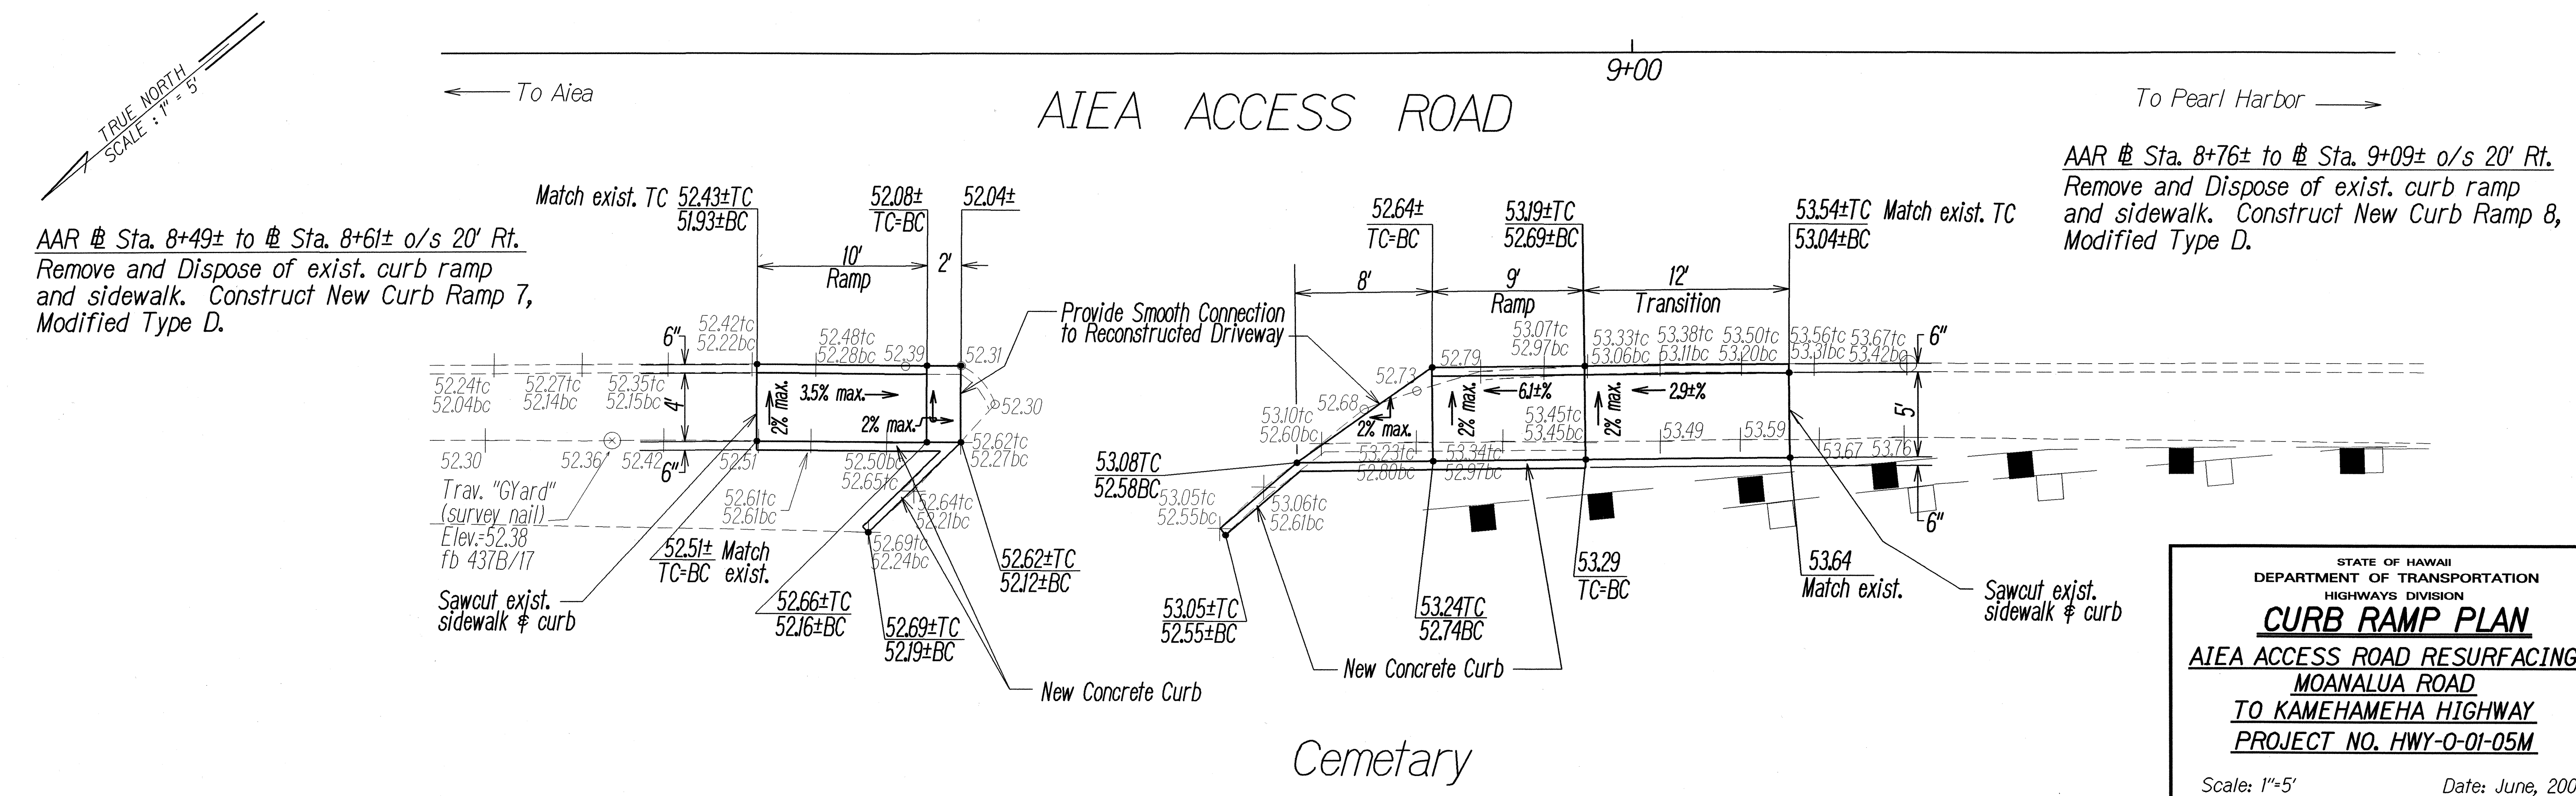


FED. ROAD DIST. NO.	STATE	PROJ. NO.	FISCAL YEAR	SHEET NO.	TOTAL SHEETS
HAWAII	HAW.	HWY-0-01-05M	2006	22	106

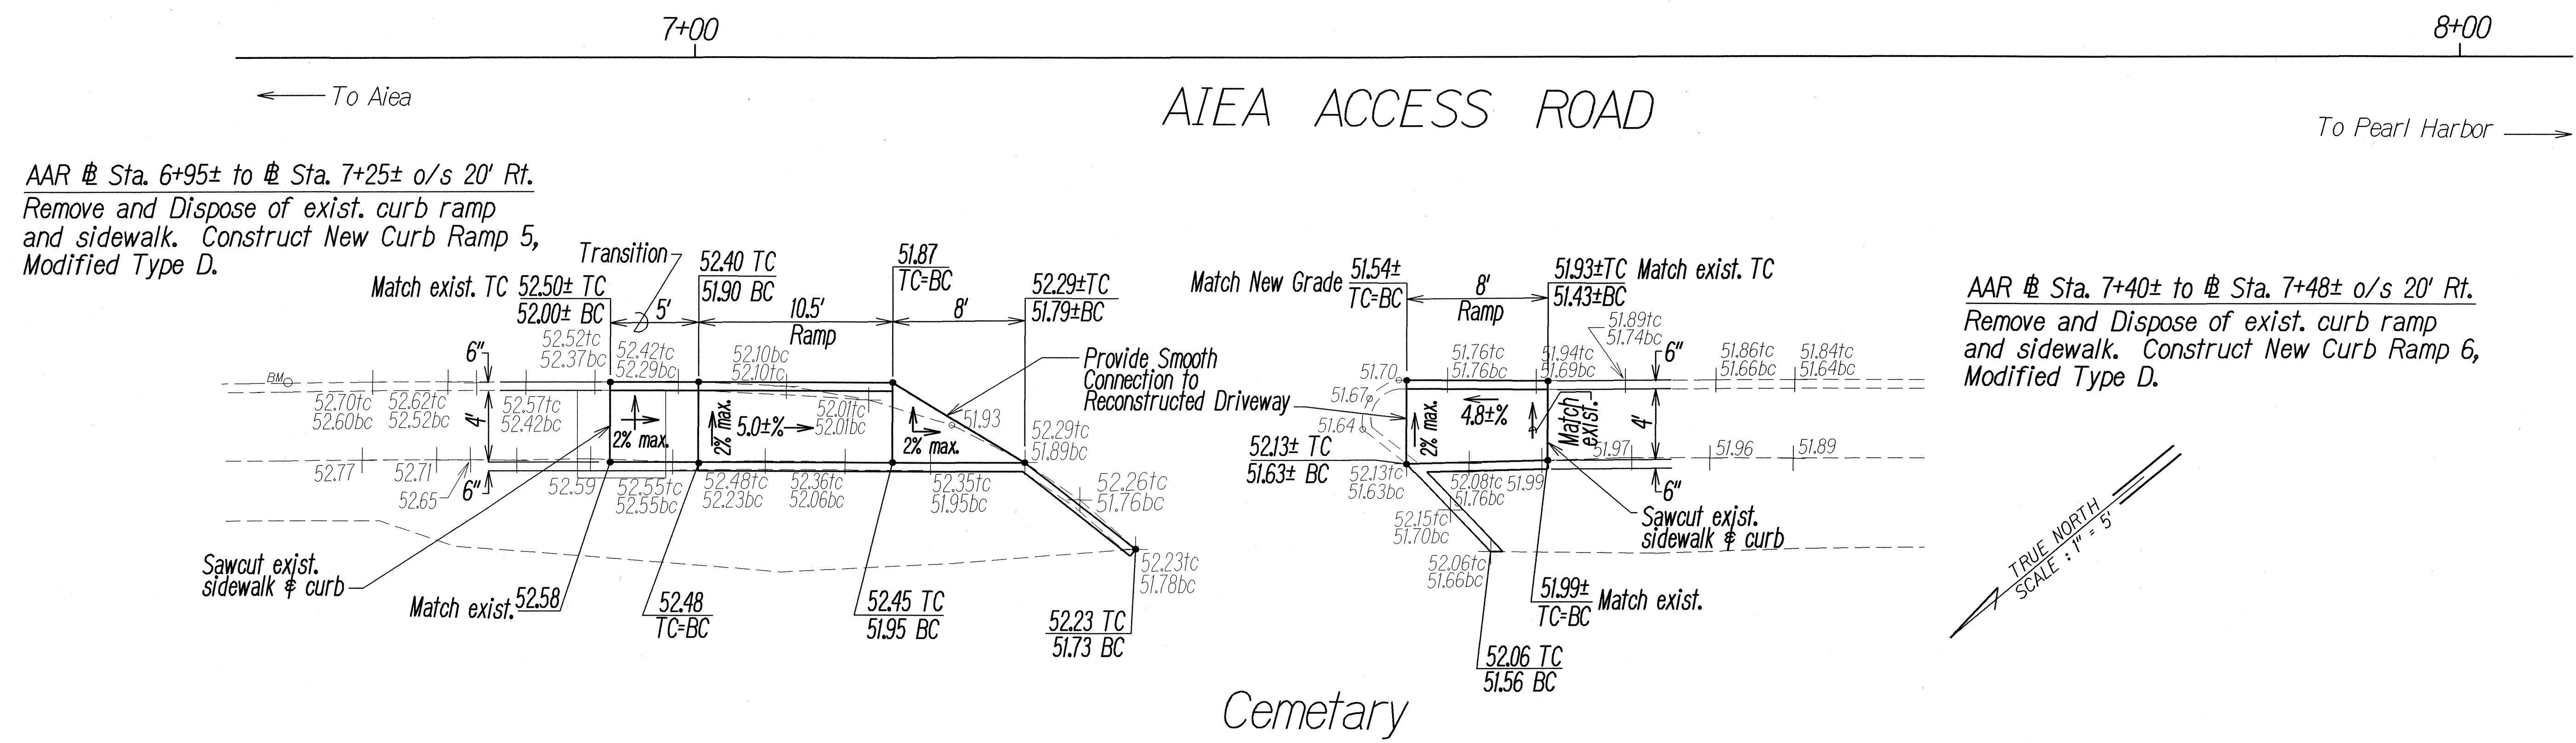

SURVEY PLOTTED BY	DATE
DESIGNED BY	
QUANTITIES BY	
CHECKED BY	

STATE OF HAWAII
DEPARTMENT OF TRANSPORTATION
HIGHWAYS DIVISION

CURB RAMP PLAN

AIEA ACCESS ROAD RESURFACING
MOANALUA ROAD
TO KAMEHAMEHA HIGHWAY
PROJECT NO. HWY-0-01-05M

Scale: 1"=5' Date: June, 2005

SHEET No. 2 OF 2 SHEETS