




FED. ROAD DIST. NO.	STATE	PROJ. NO.	FISCAL YEAR	SHEET NO.	TOTAL SHEETS
HAWAII	HAW.	HWY-0-01-05M	2006	45	105

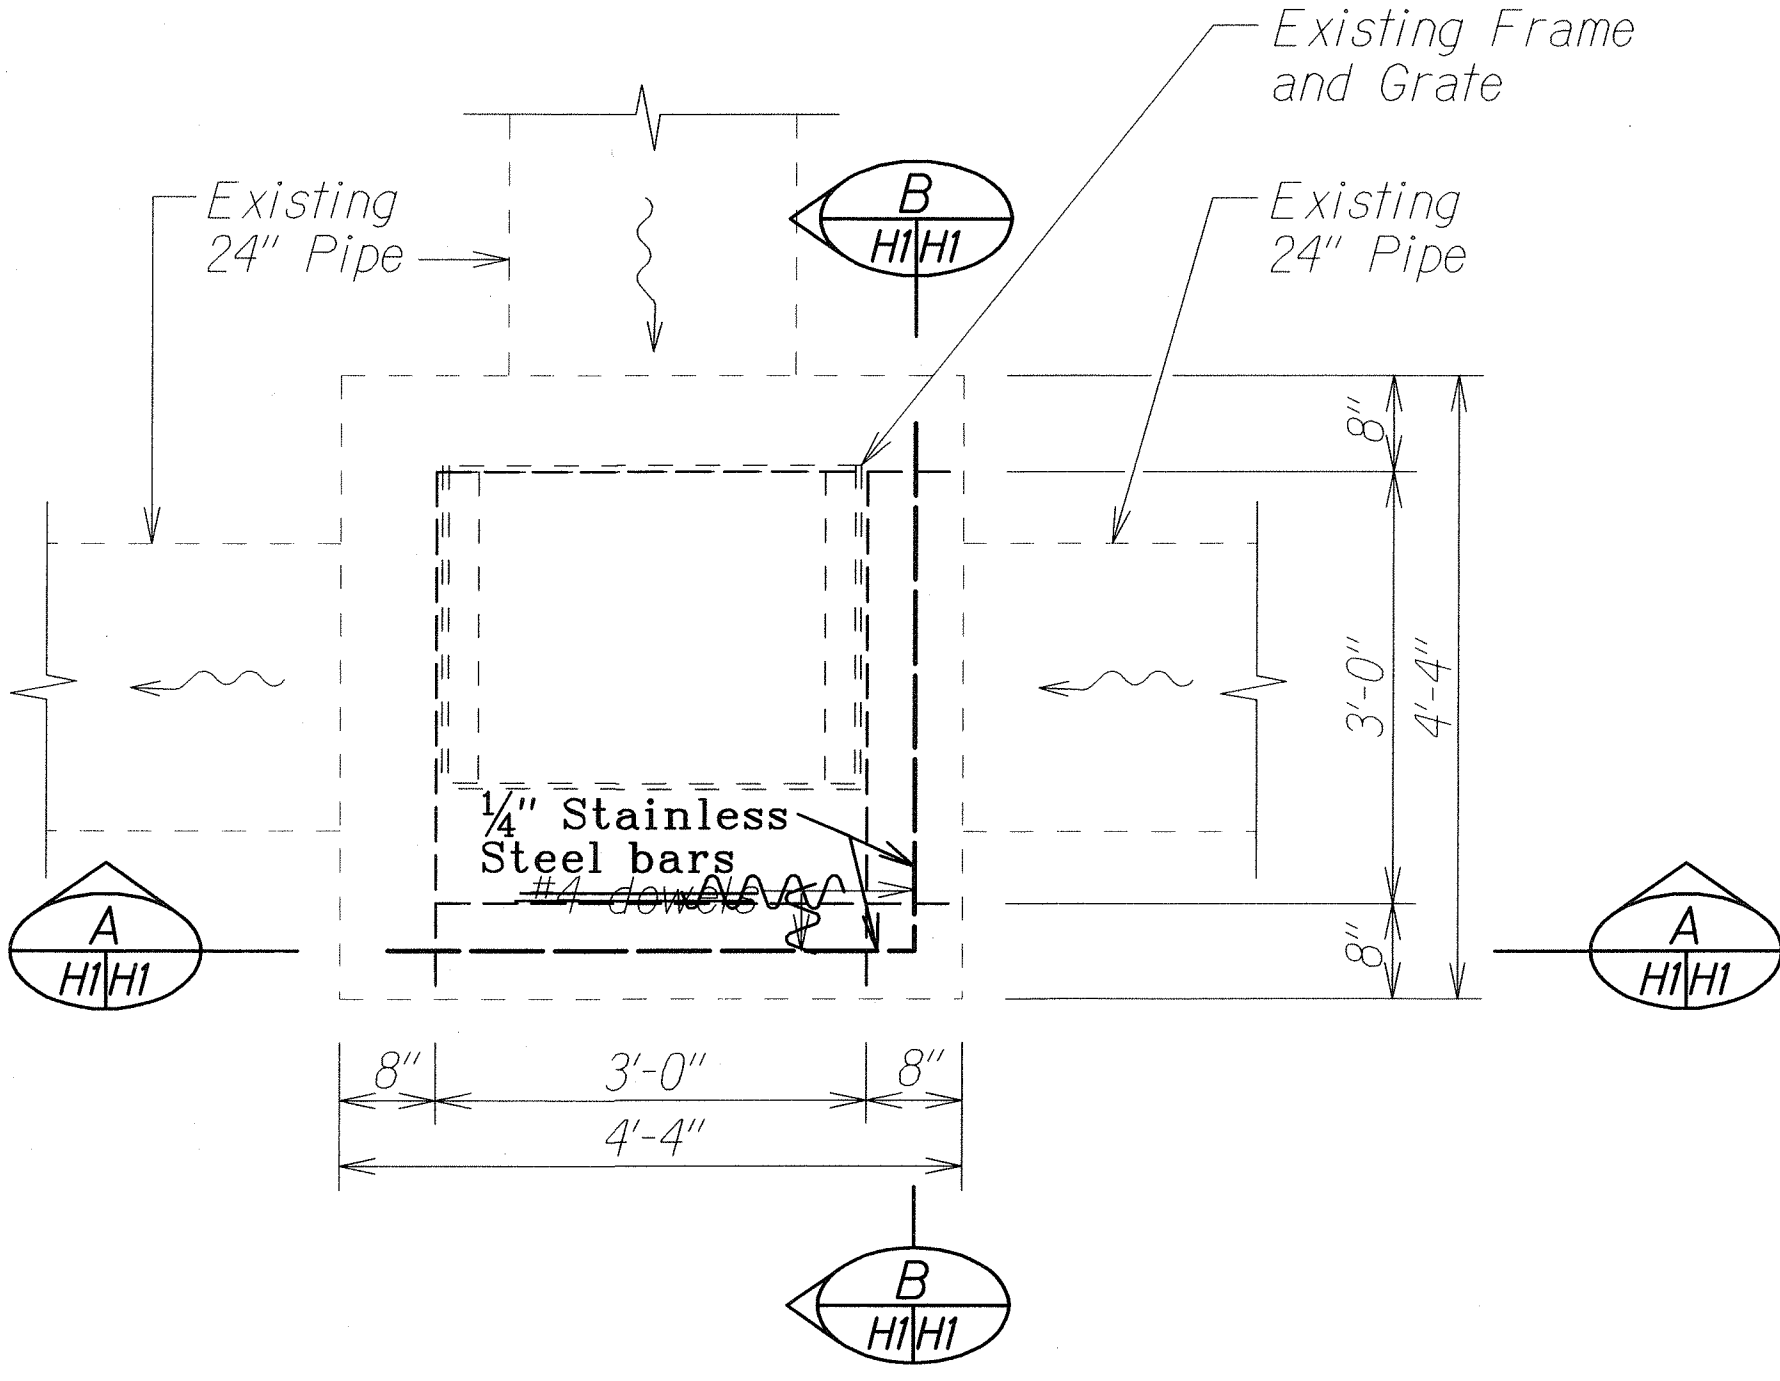

PLAN

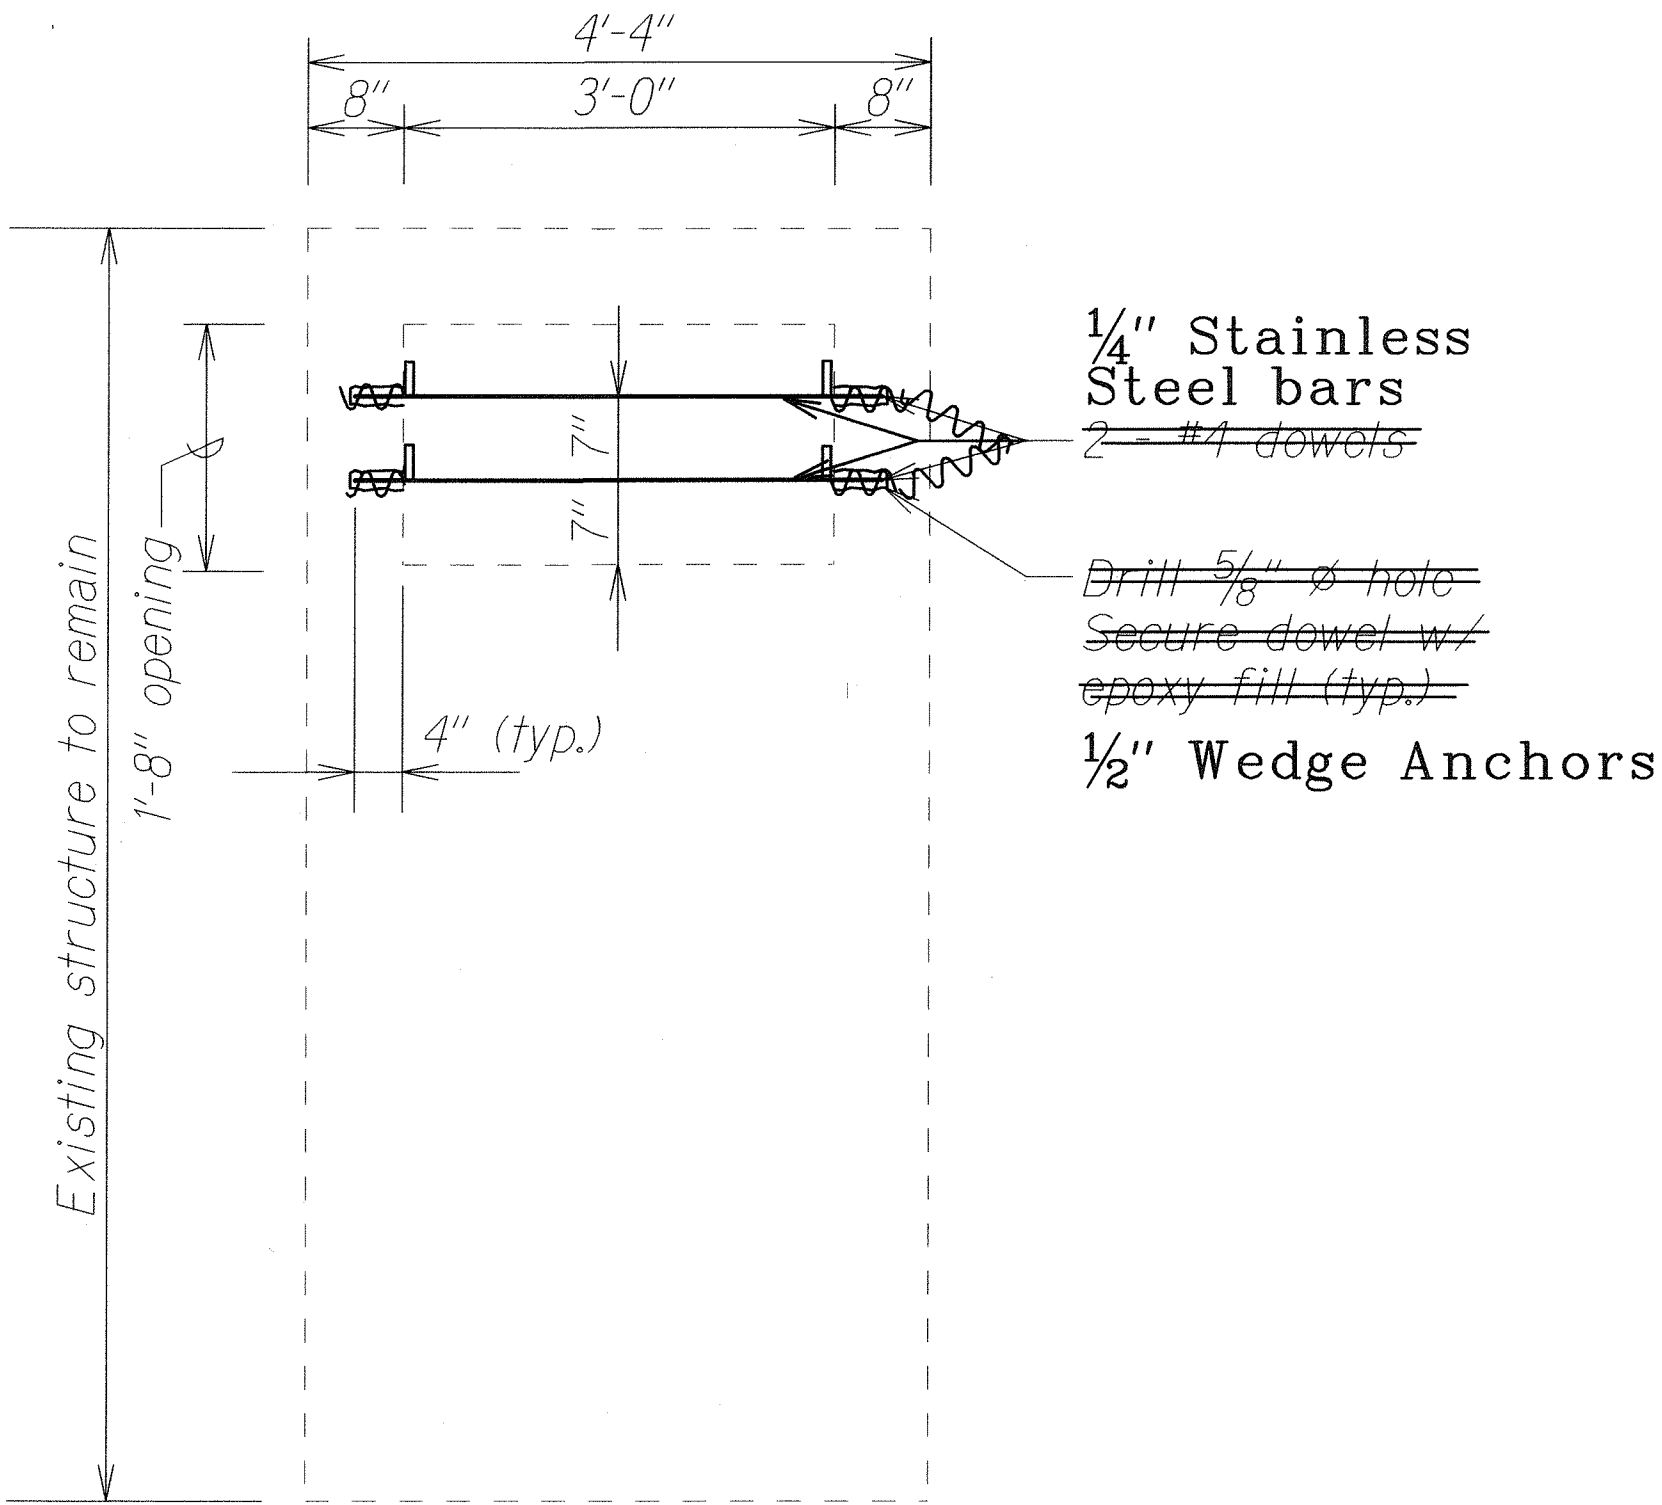

SECTION A

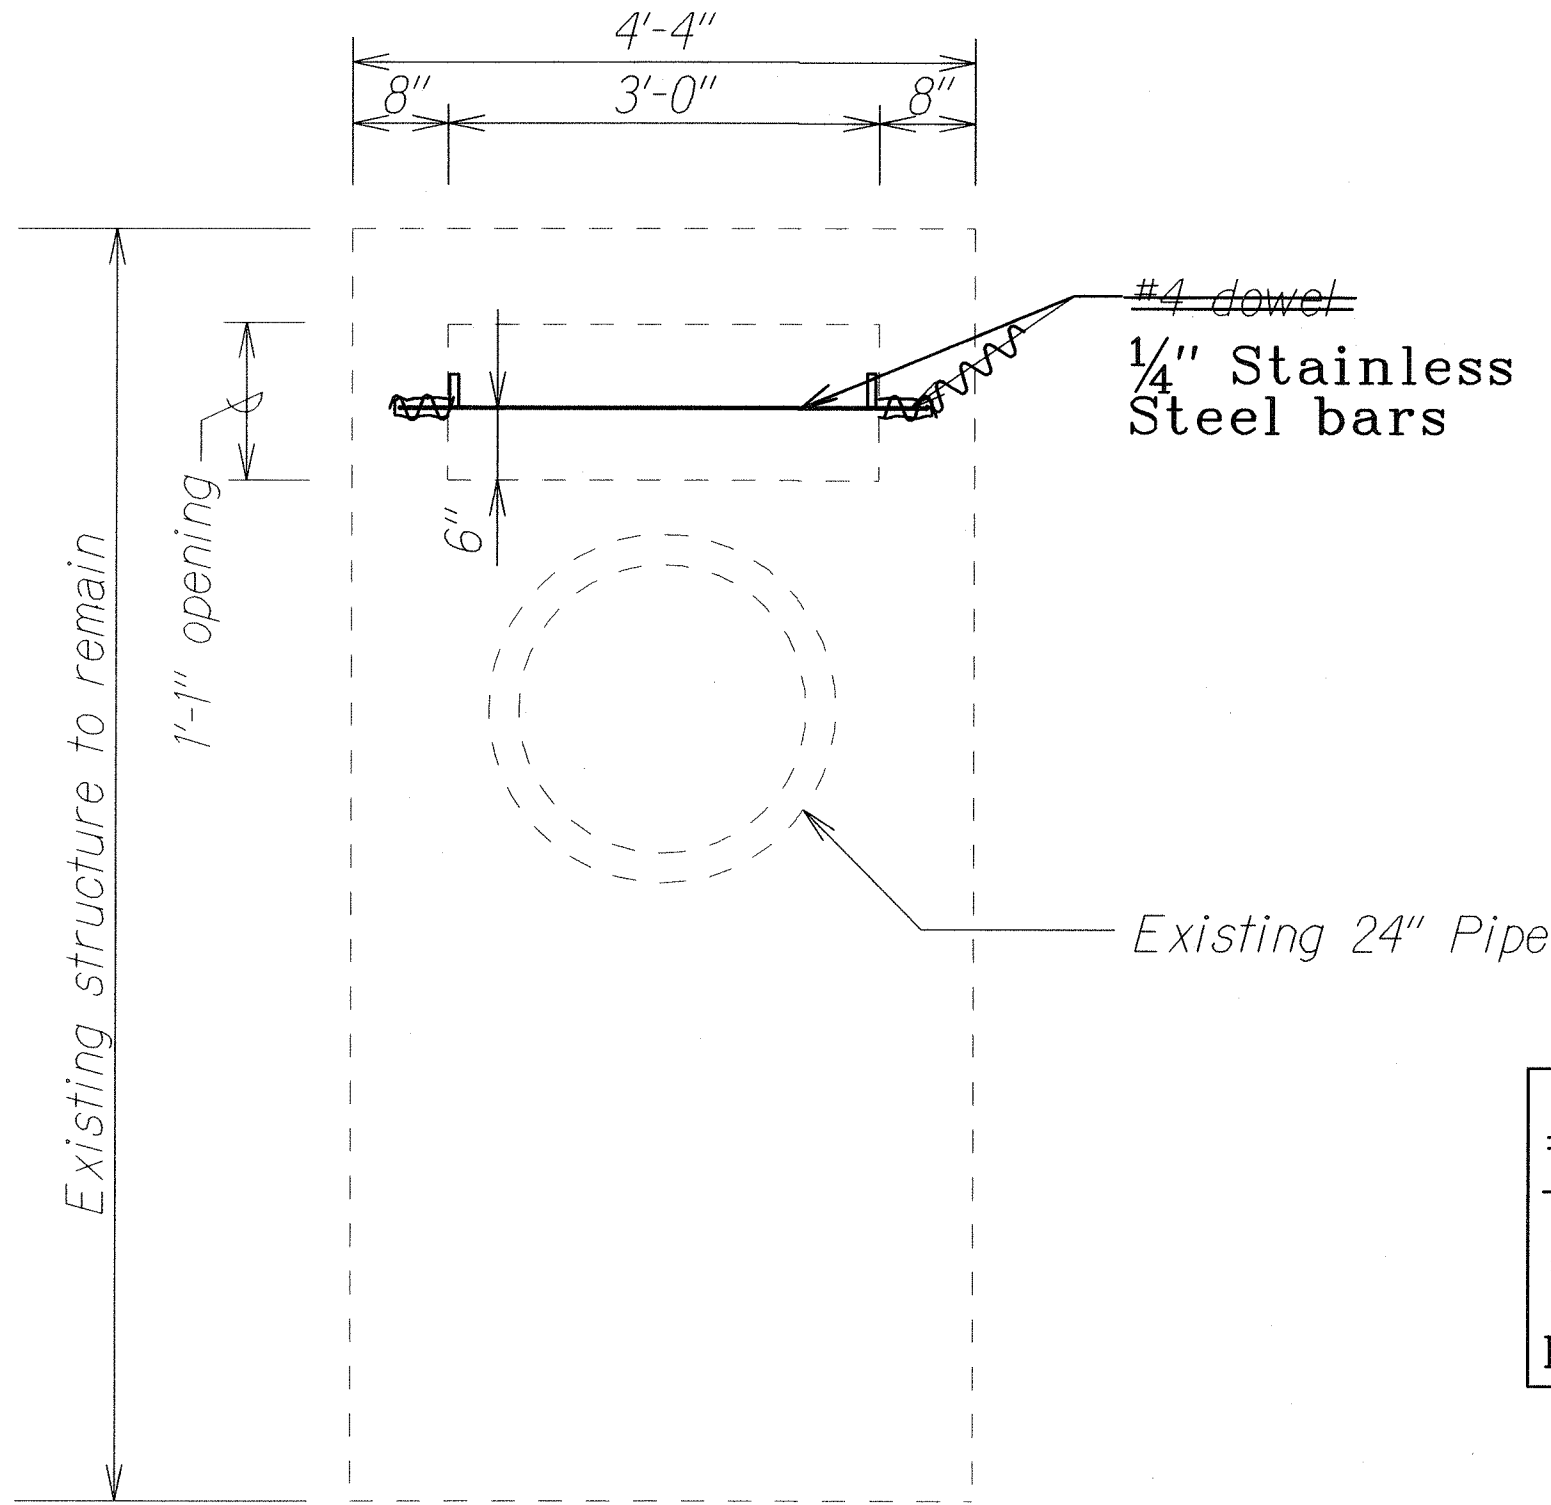

SECTION B

DETAIL OF TYPE "1" INLET STRUCTURE

LEGEND FOR AS-BUILT POSTINGS	
	Squiggly line for as-built deletion
	Double line for as-built deletion
Roadway	Text for as-built posting

STATE OF HAWAII
DEPARTMENT OF TRANSPORTATION
HIGHWAYS DIVISION


DRAINAGE DETAILS

AIEA ACCESS ROAD RESURFACING
Moanalua Road to Kamehameha Hwy.
Project No. HWY-0-01-05M


Scale: 3/4"=1'-0" Date: June, 2005

ORIGINAL PLAN	SURVEY PLOTTED BY	DATE
NOTE BOOK	DRAWN BY	6/20/05
REVISIONS	CHECKED BY	
1. 6/20/05	1. 6/20/05	

FED. ROAD DIST. NO.	STATE	PROJ. NO.	FISCAL YEAR	SHEET NO.	TOTAL SHEETS
HAWAII	HAW.	HWY-0-01-05M	2006	46	105

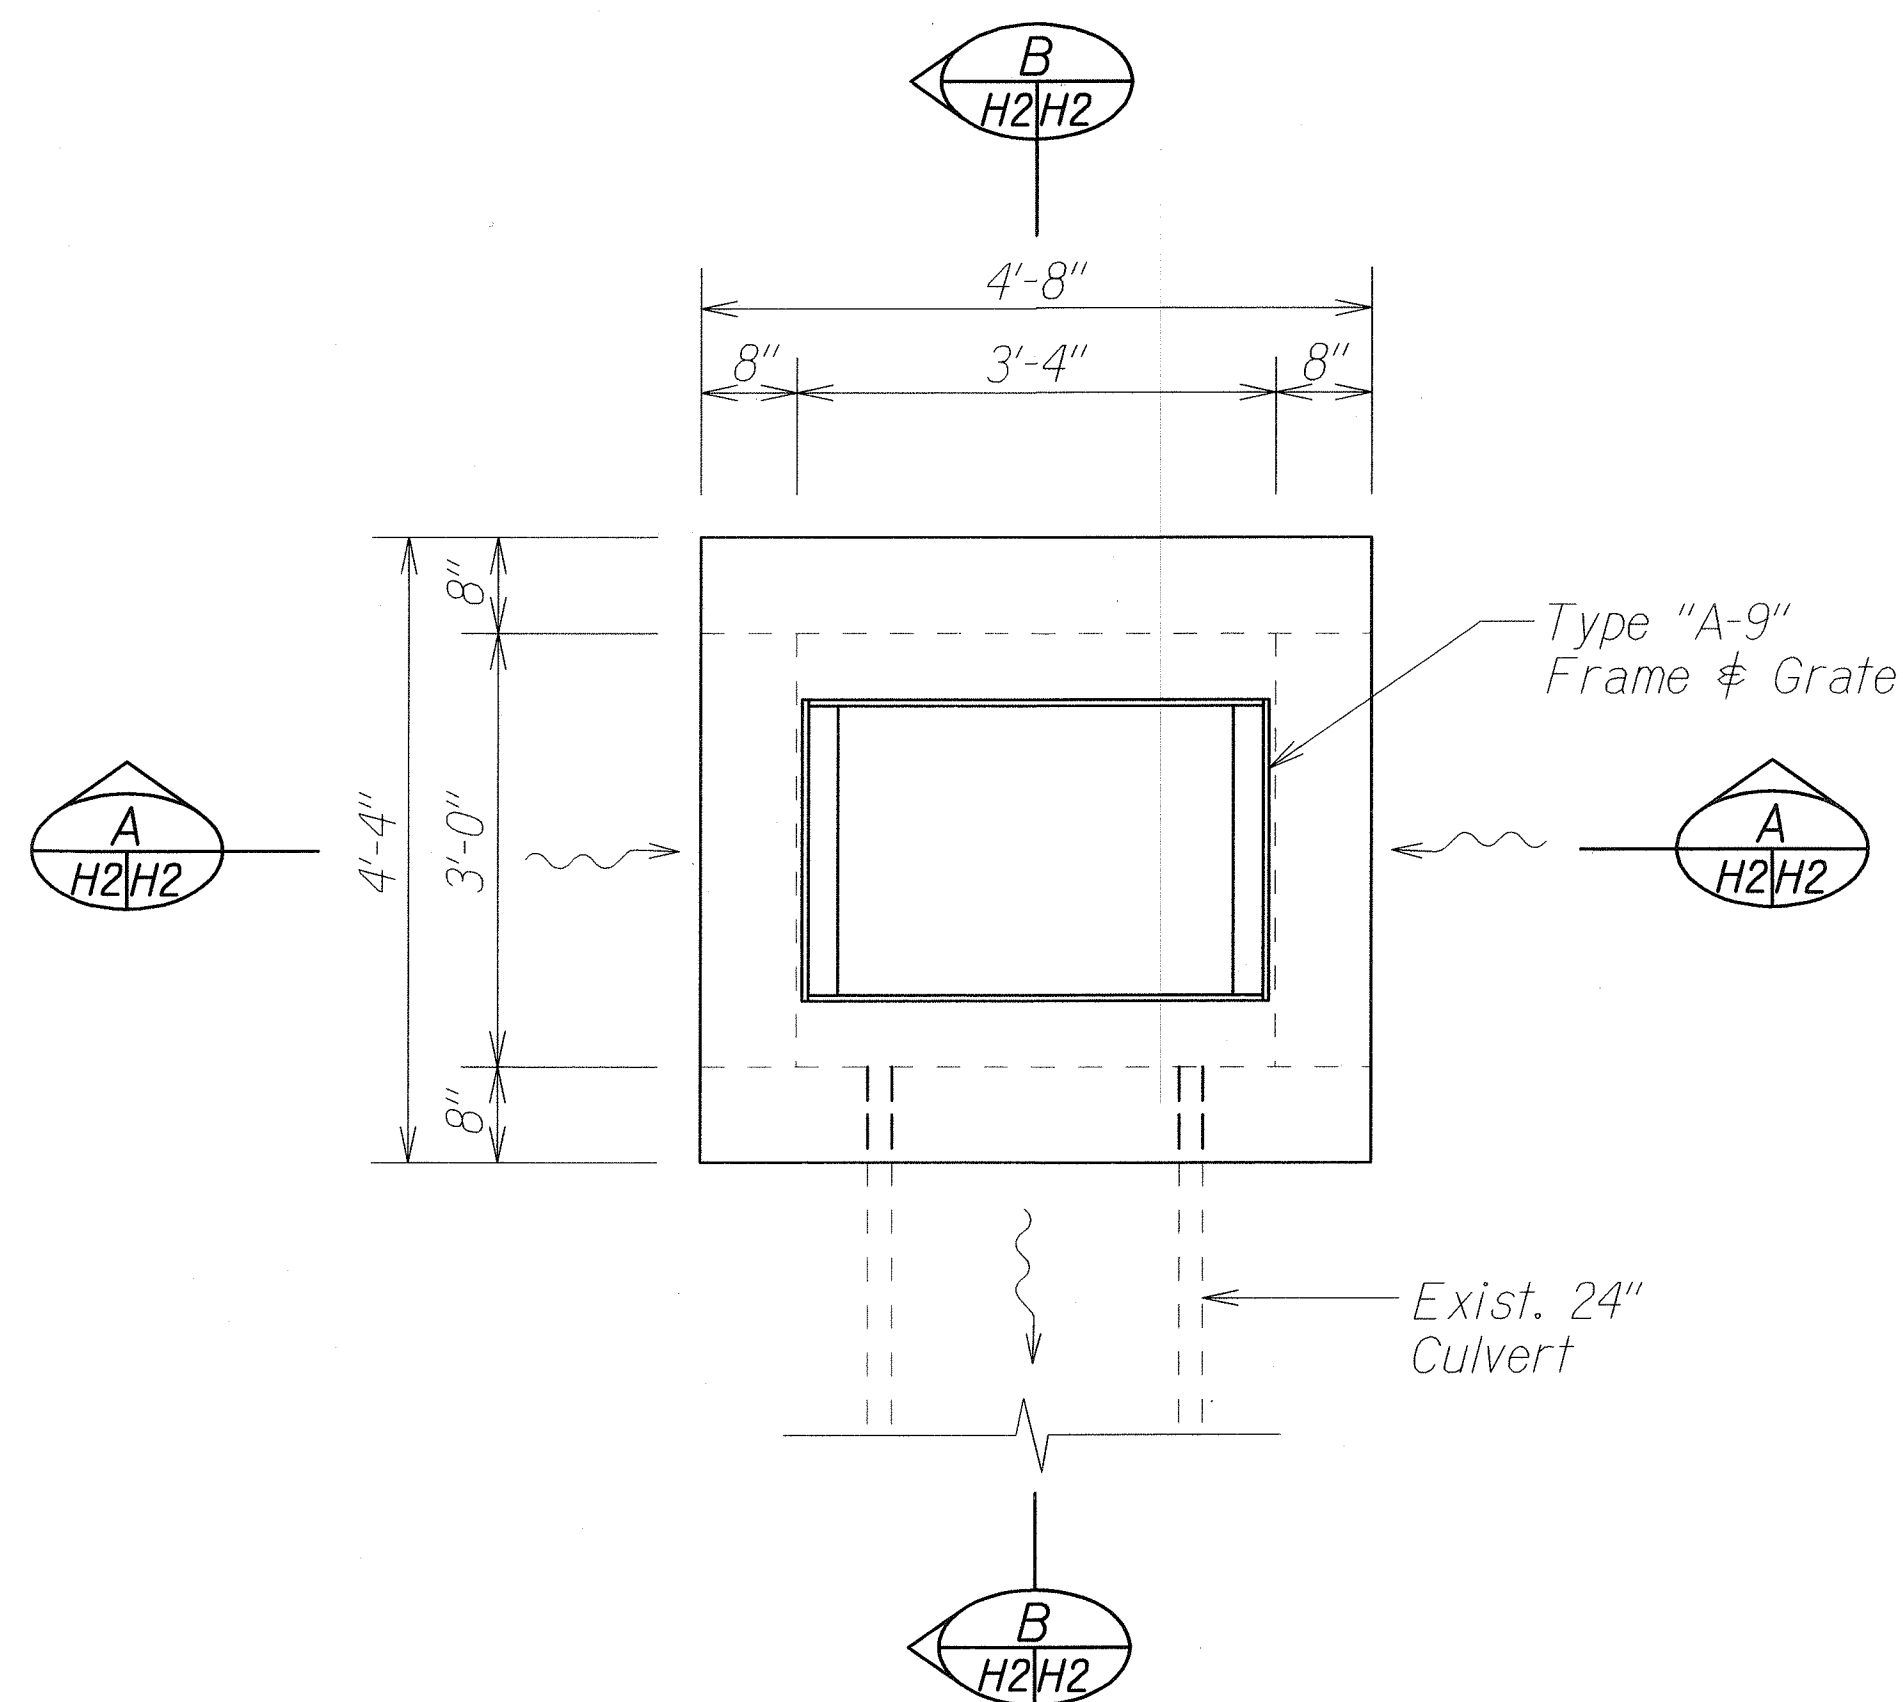


PLAN

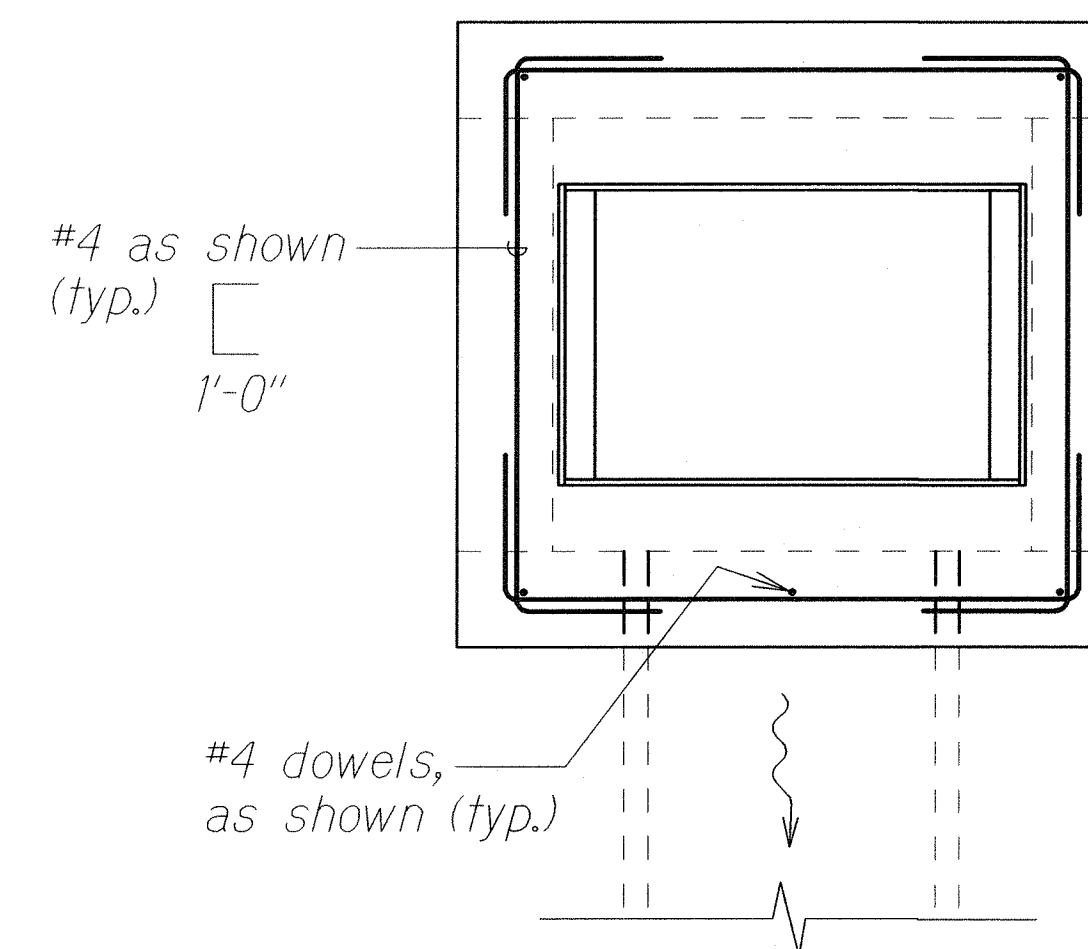


TOP SLAB REINFORCING

LEGEND FOR AS-BUILT POSTINGS

	Squiggly line for as-built deletion
	Double line for as-built deletion
Roadway	Text for as-built posting

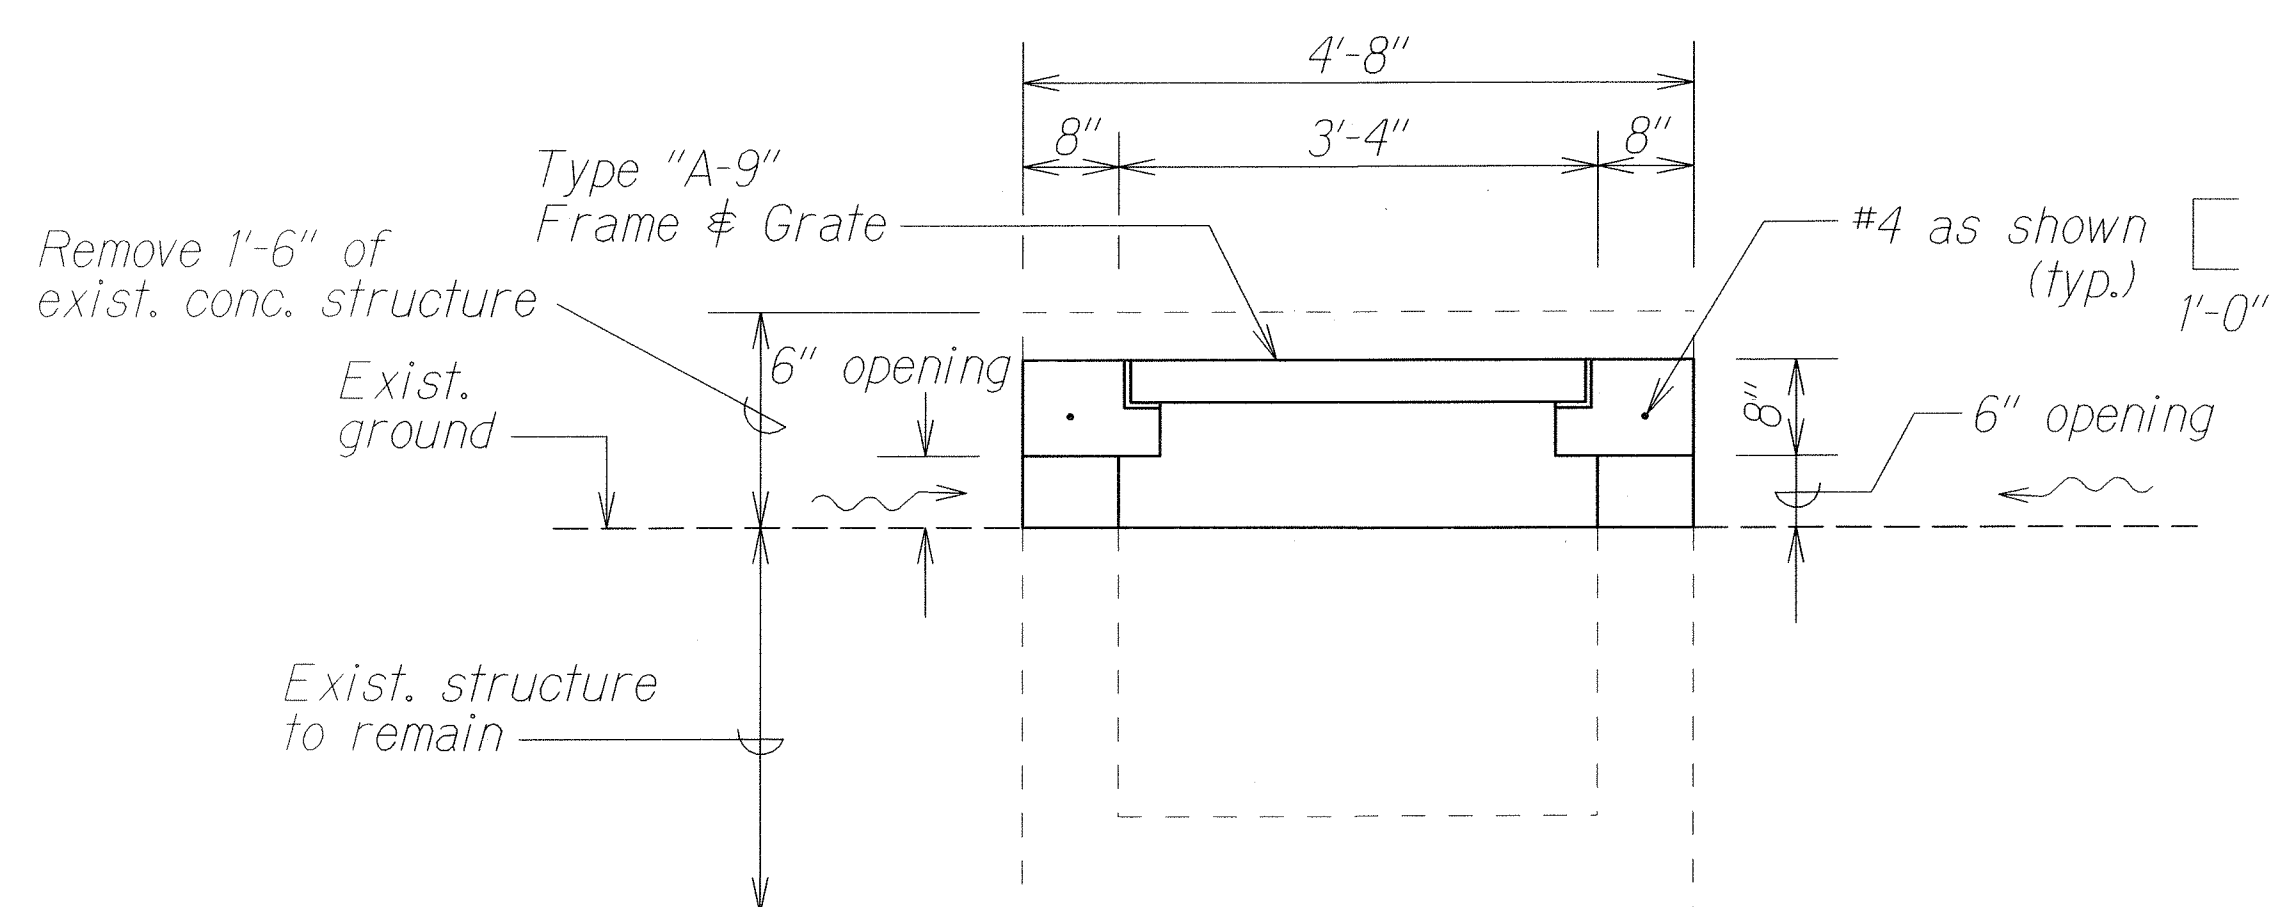


SECTION A-A

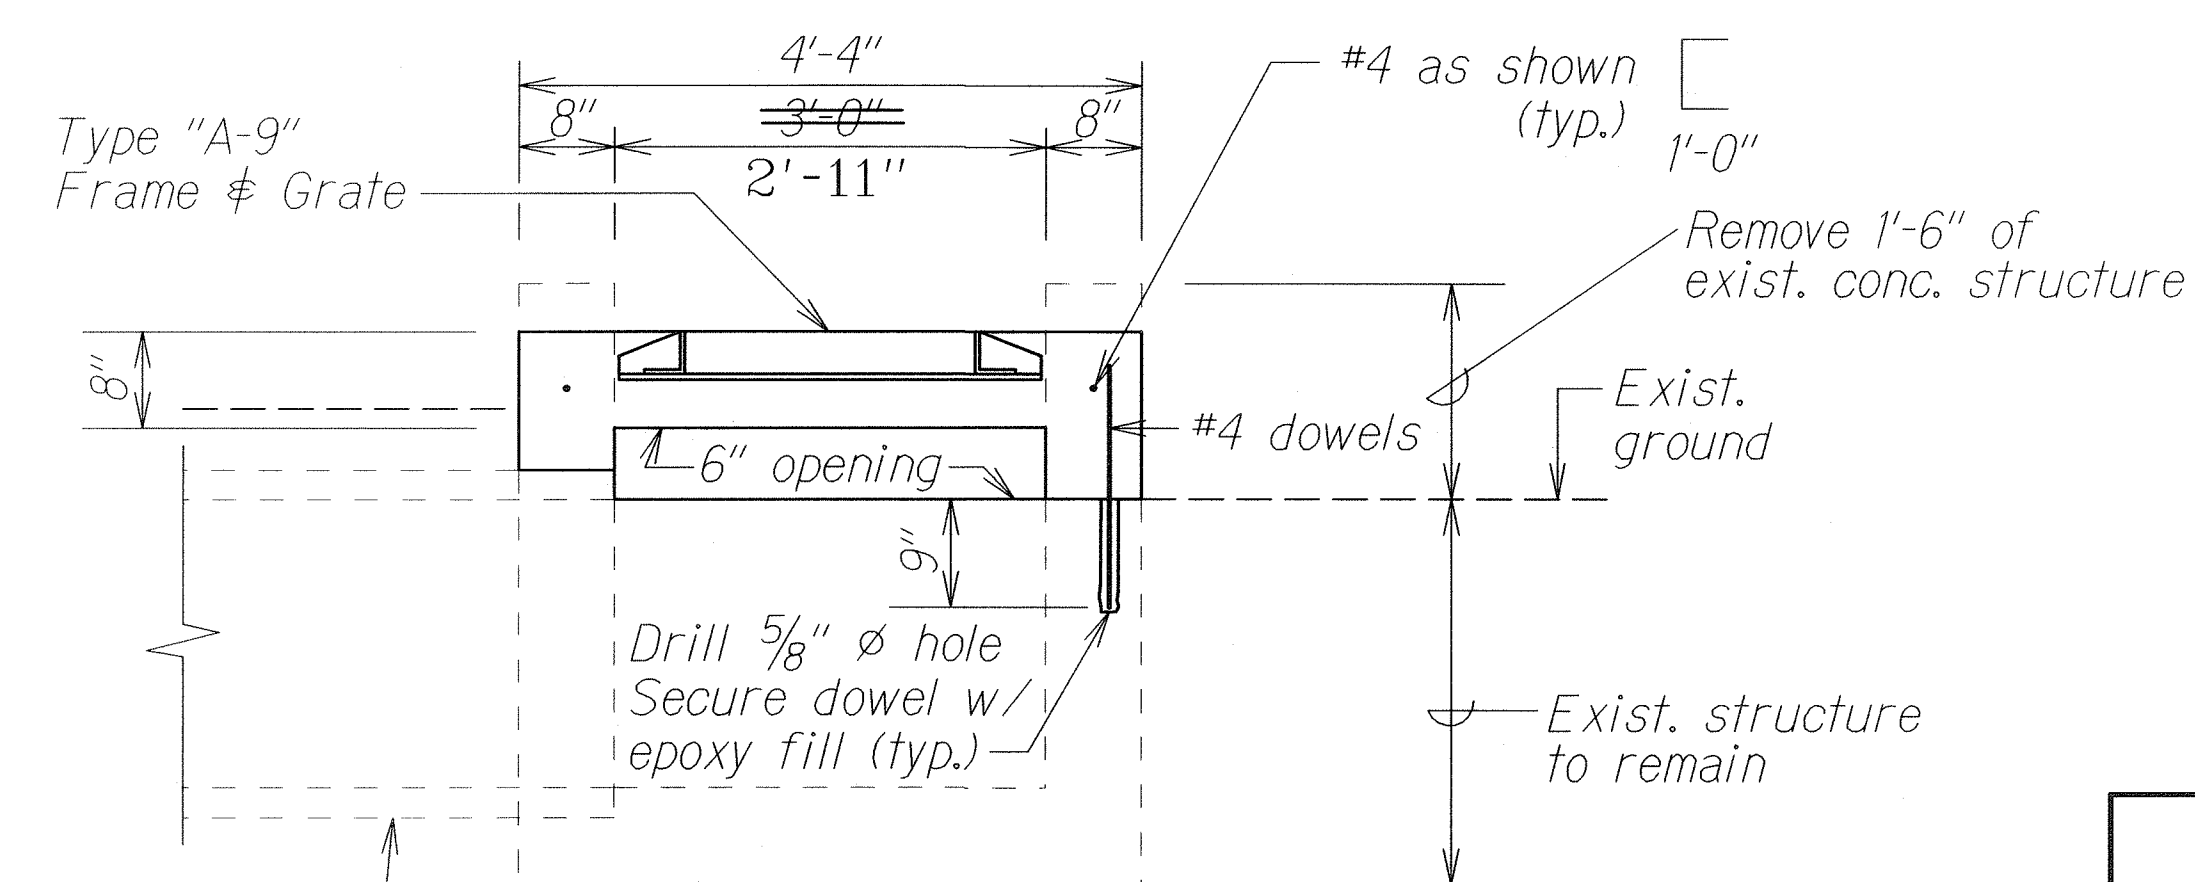

SECTION B-B

DETAIL OF TYPE "2" INLET STRUCTURE

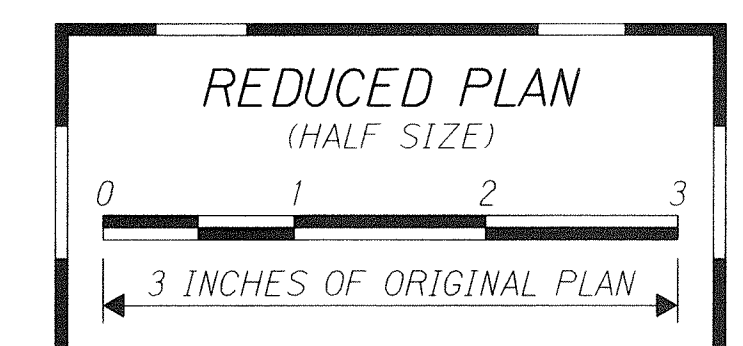

STATE OF HAWAII
DEPARTMENT OF TRANSPORTATION
HIGHWAYS DIVISION

DRAINAGE DETAILS

AIEA ACCESS ROAD RESURFACING
Moanalua Road to Kamehameha Hwy.
Project No. HWY-0-01-05M

Scale: 3/4"=1'-0" Date: June, 2005

SHEET No. H2 OF 2 SHEETS

"AS-BUILT"