


FED. ROAD DIST. NO.	STATE	PROJ. NO.	FISCAL YEAR	SHEET NO.	TOTAL SHEETS
HAWAII	HAW.	HWY-0-01-05M	2006	104	106

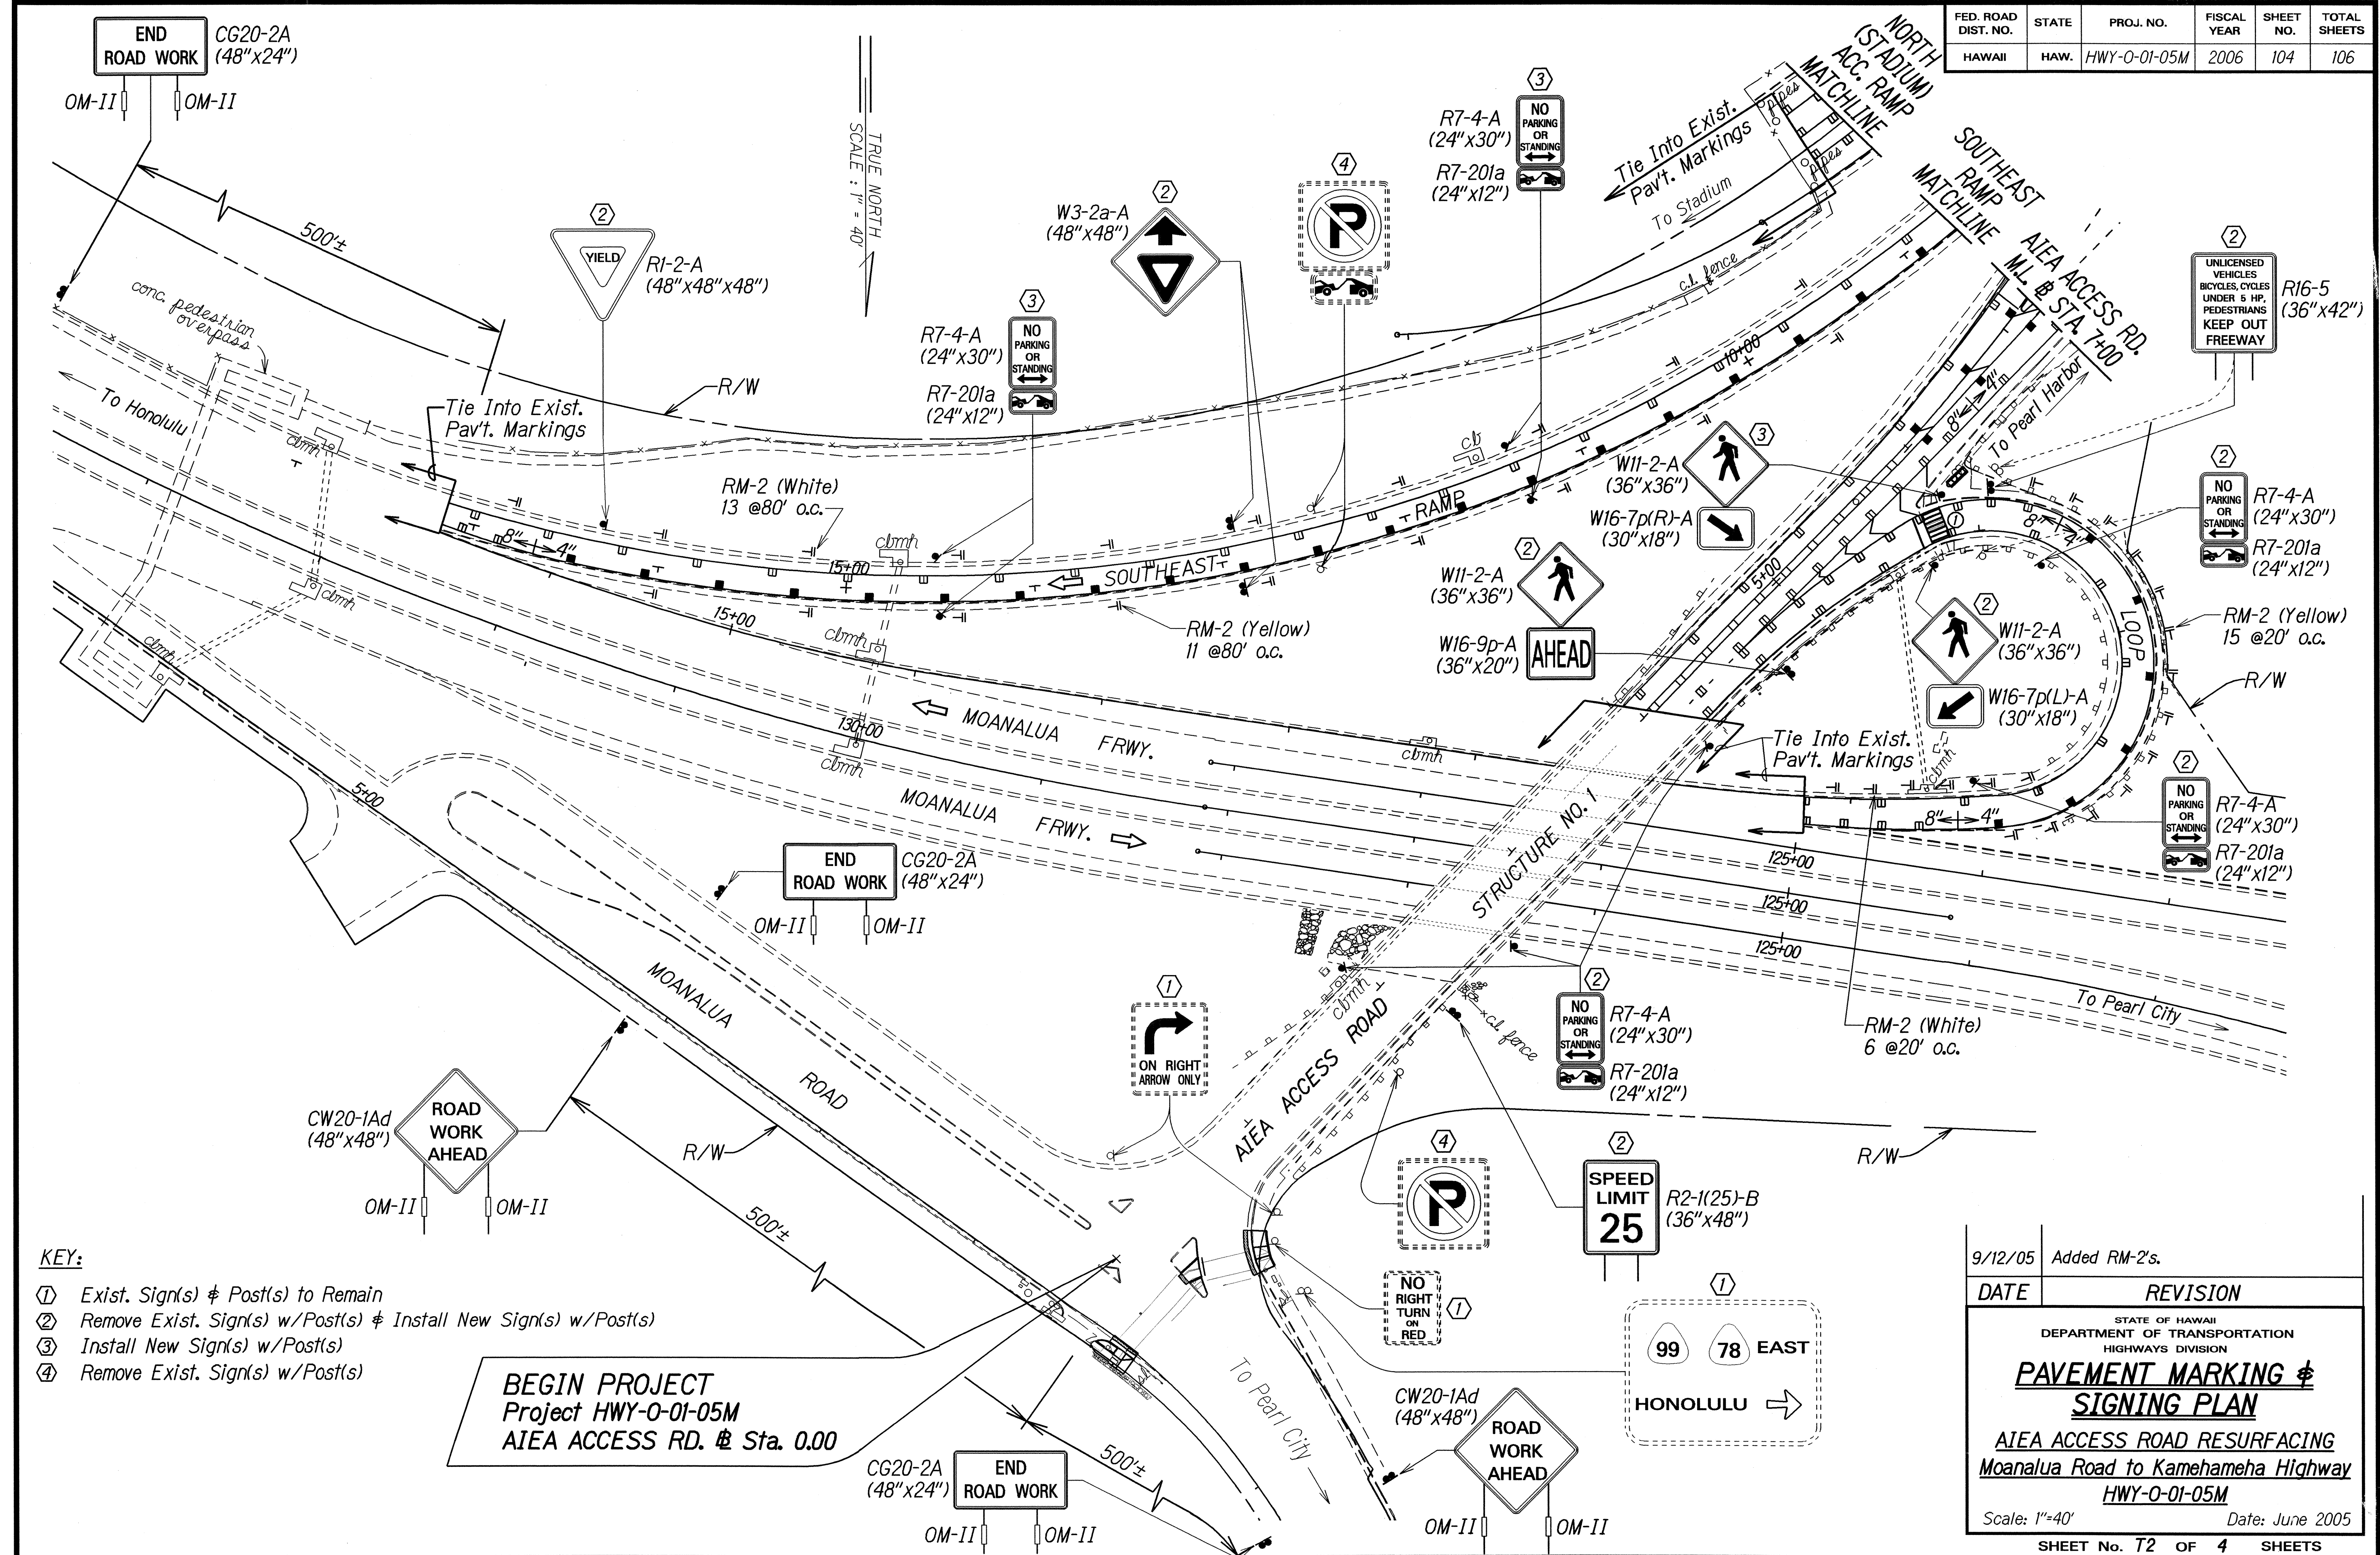


- KEY:**
- ① Exist. Sign(s) & Post(s) to Remain
 - ② Remove Exist. Sign(s) w/Post(s) & Install New Sign(s) w/Post(s)
 - ③ Install New Sign(s) w/Post(s)
 - ④ Remove Exist. Sign(s) w/Post(s)

BEGIN PROJECT
 Project HWY-0-01-05M
 AIEA ACCESS RD. @ Sta. 0.00

9/12/05	Added RM-2's.
DATE	REVISION
STATE OF HAWAII DEPARTMENT OF TRANSPORTATION HIGHWAYS DIVISION PAVEMENT MARKING & SIGNING PLAN AIEA ACCESS ROAD RESURFACING Moanalua Road to Kamehameha Highway HWY-0-01-05M Scale: 1"=40' Date: June 2005 SHEET No. T2 OF 4 SHEETS	

DESIGNED BY	DATE
TRACED BY	10/5
NOTED BY	
CHECKED BY	
ORIGINAL	

FED. ROAD DIST. NO.	STATE	PROJ. NO.	FISCAL YEAR	SHEET NO.	TOTAL SHEETS
HAWAII	HAW.	HWY-O-01-05M	2006	105	106

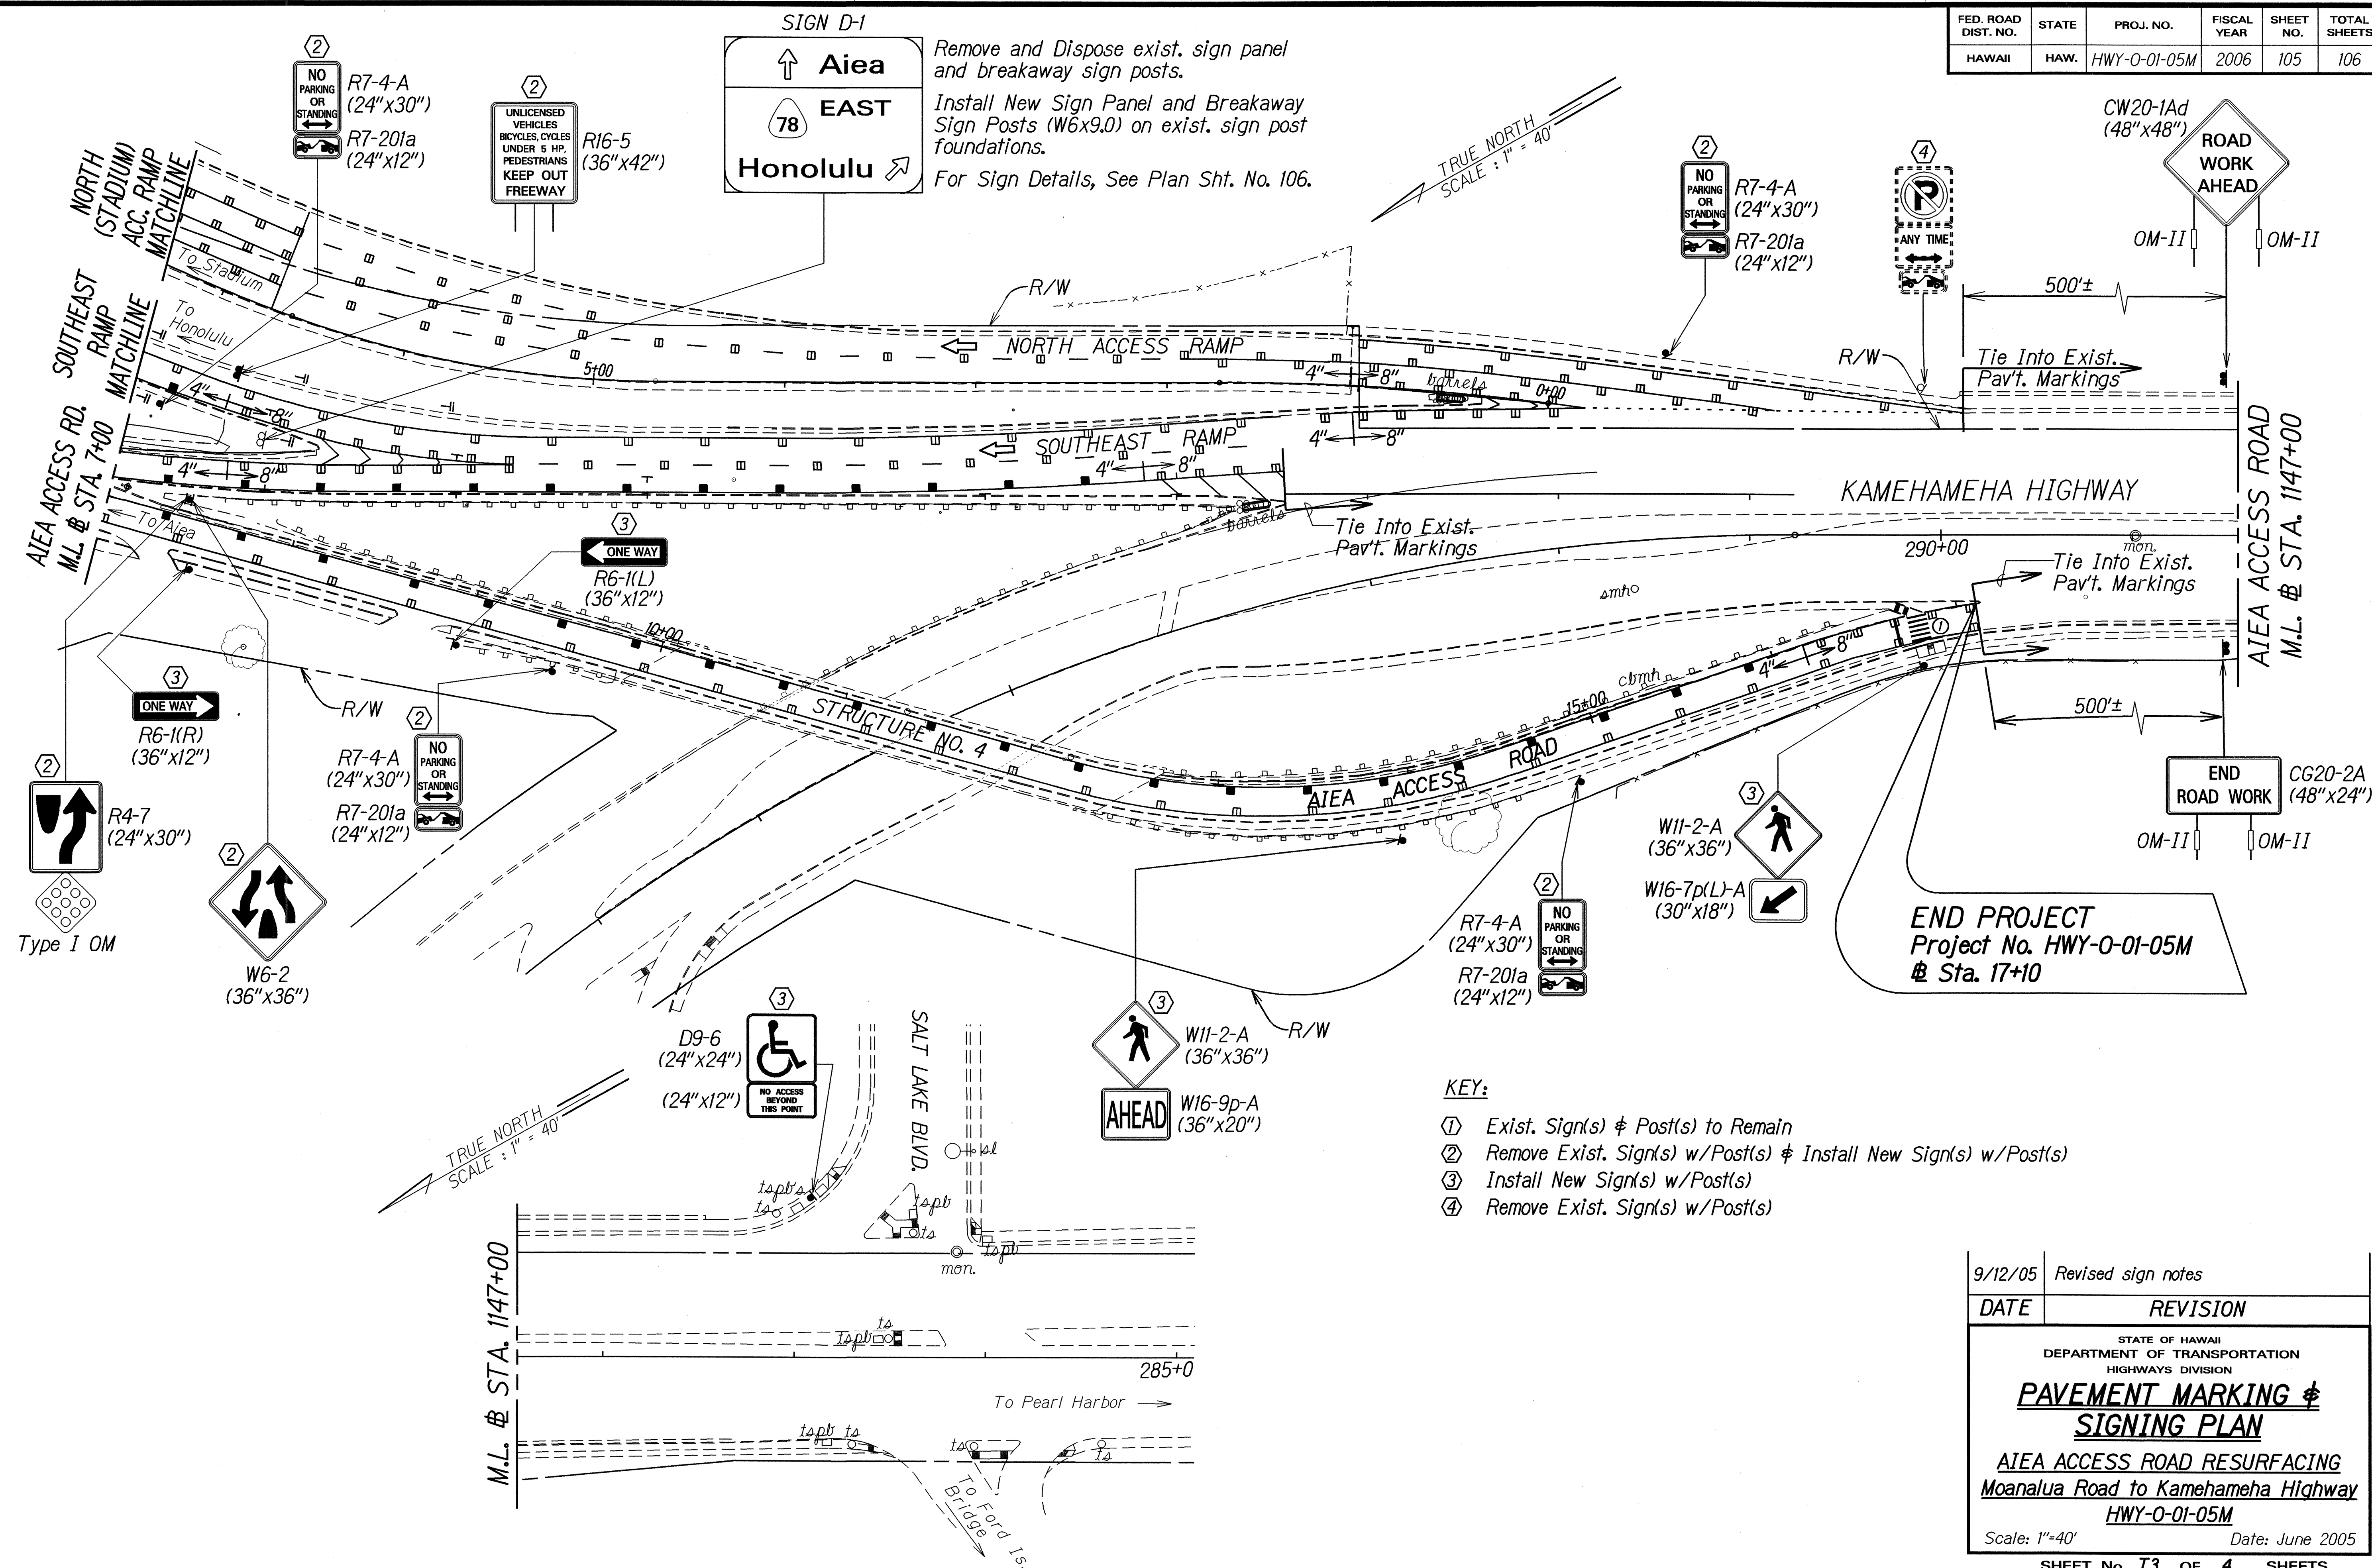

SURVEY PLOTTED BY	DATE
DESIGNED BY	1/05
TRACED BY	
NOTE BOOK	
DESIGNED BY	
QUANTITIES BY	
CHECKED BY	
ORIGINAL PLAN	
NO. 105	105-100102-1001