



FED. ROAD DIST. NO.	STATE	PROJ. NO.	FISCAL YEAR	SHEET NO.	TOTAL SHEETS
HAWAII	HAW.	HWY-0-01-05M	2006	8R	106

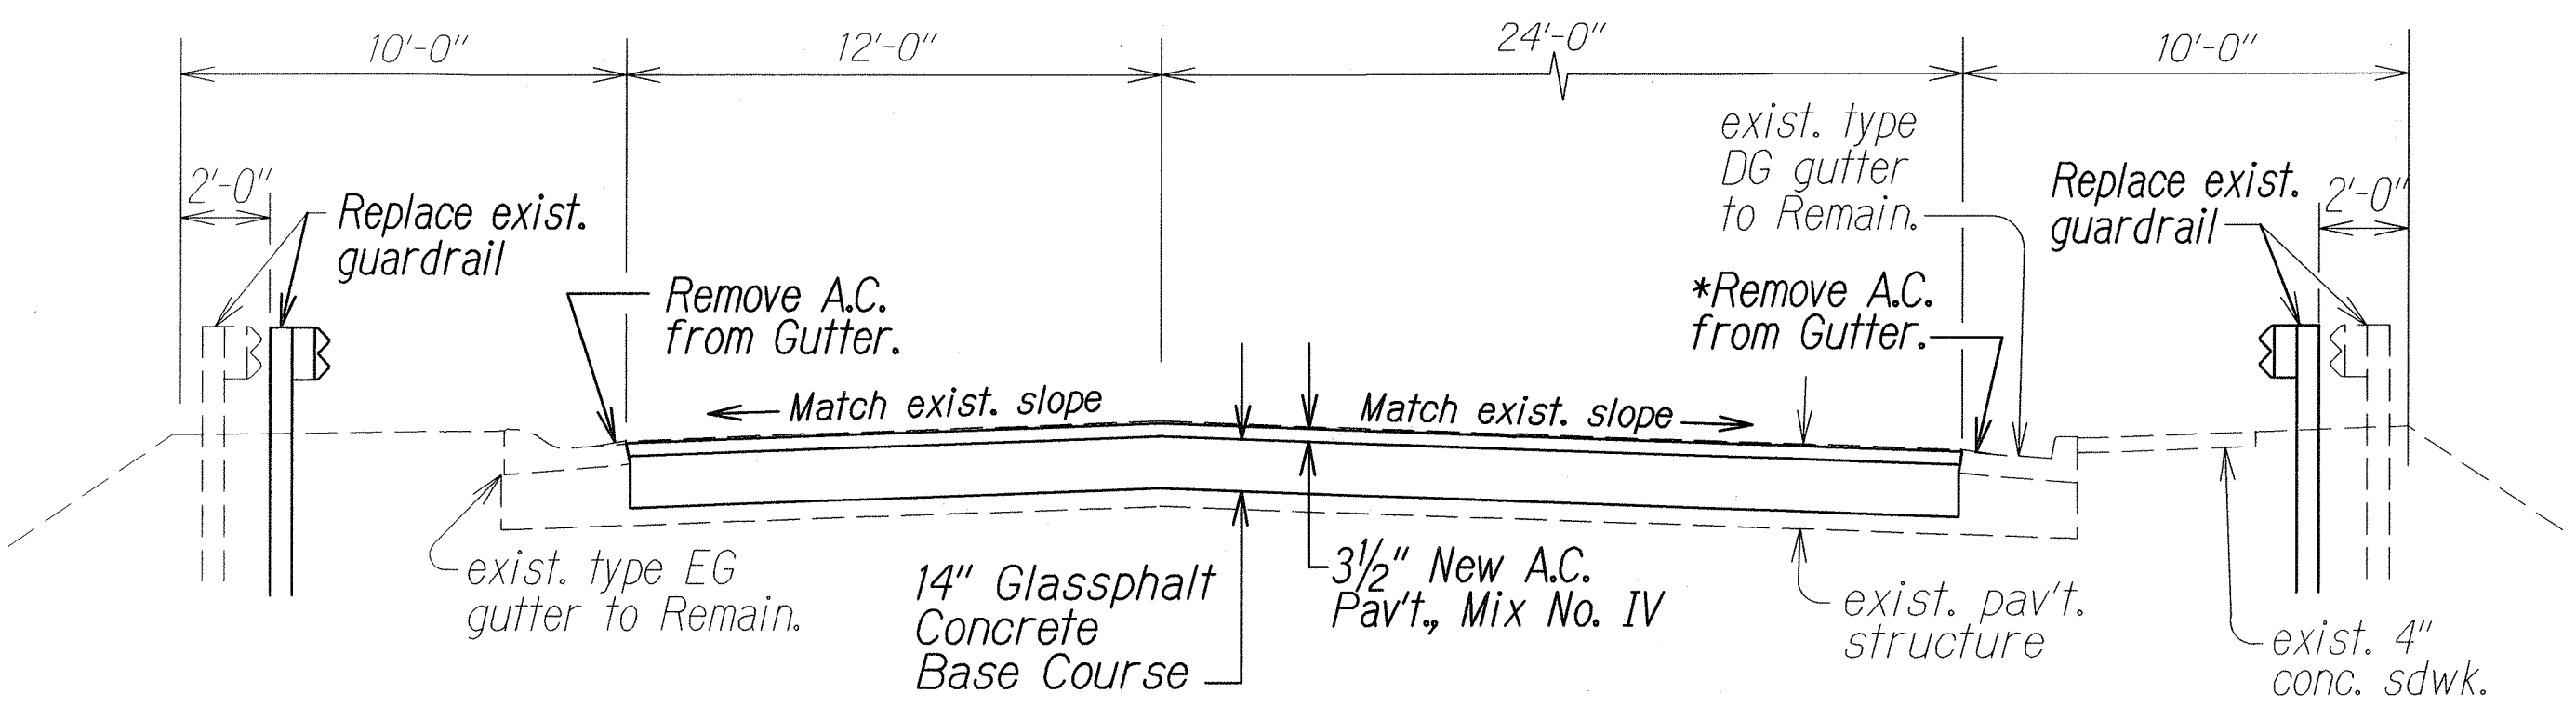


TYPICAL SECTION
AIEA ACCESS RD # STA. 4+05 TO # STA. 6+92
 Scale: 1/4" = 1'-0"

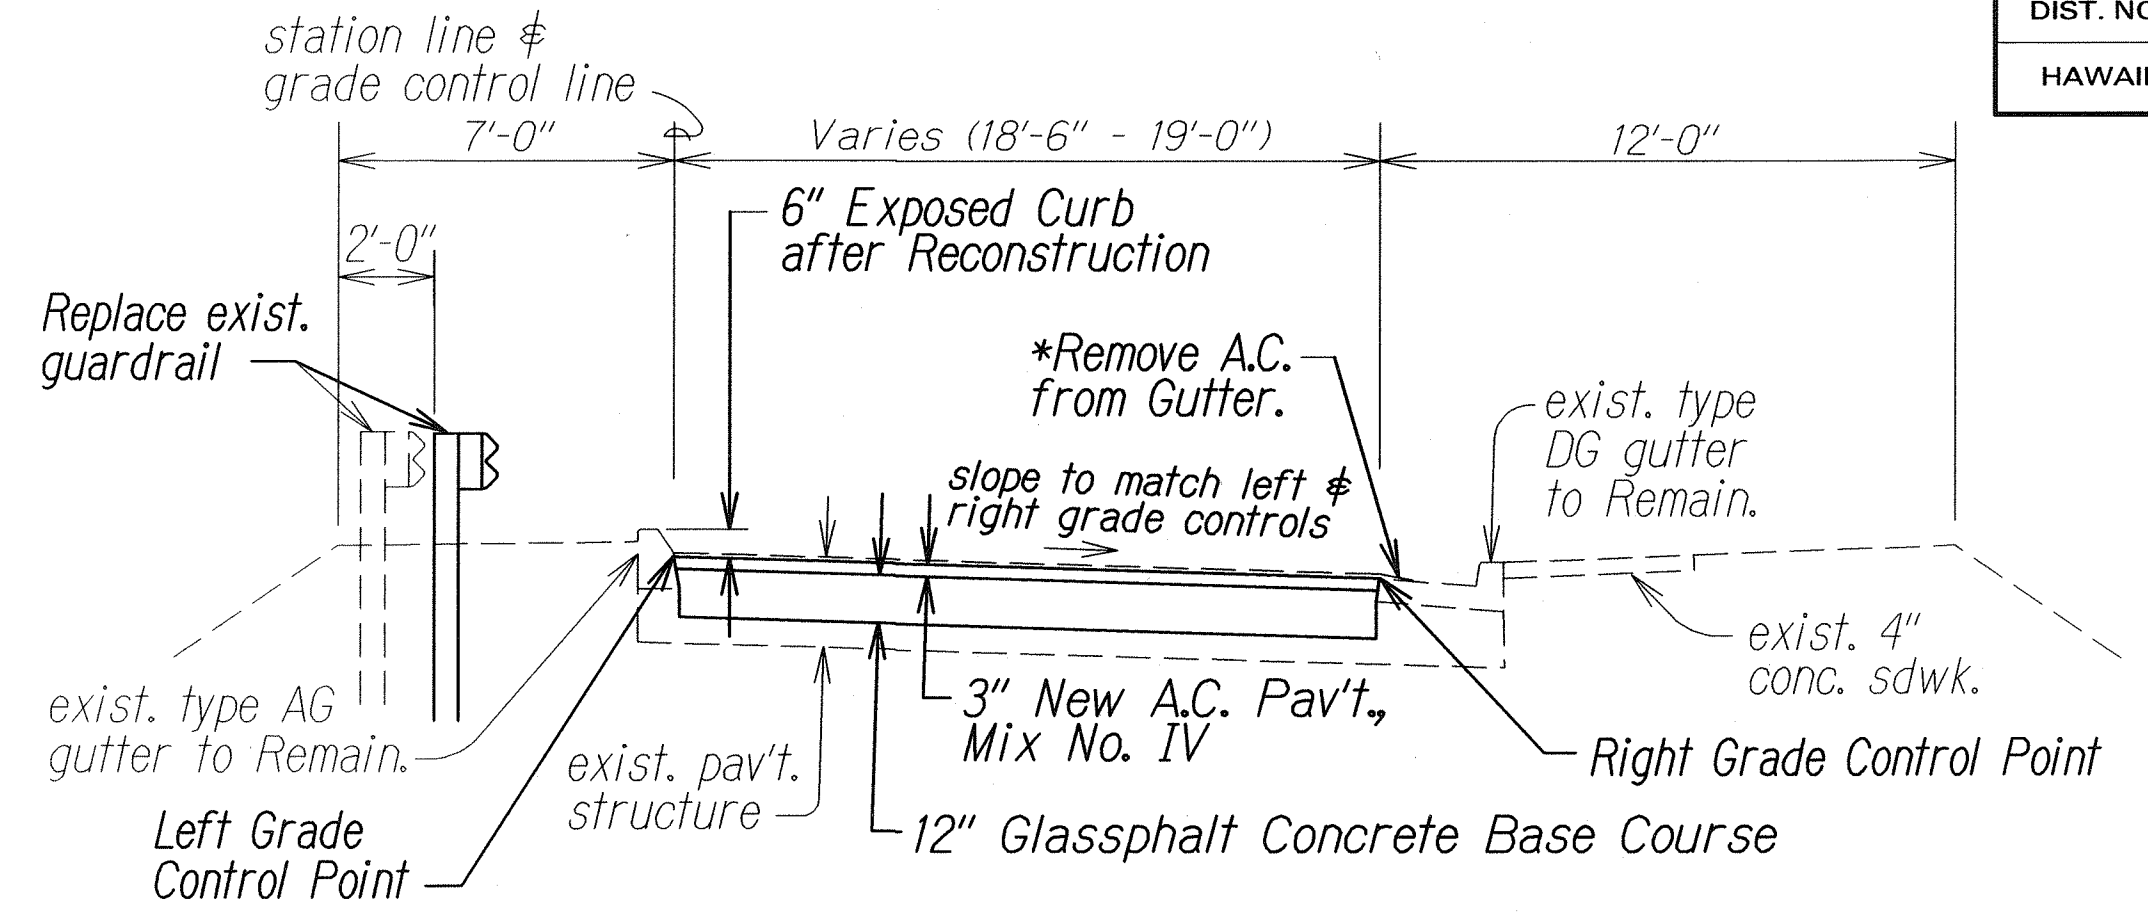


TYPICAL SECTION
AIEA ACCESS RD # STA. 15+50 TO # STA. 16+00
 Scale: 1/4" = 1'-0"


LEGEND FOR AS-BUILT POSTINGS	
	Squiggly line for as-built deletion
	Double line for as-built deletion
	Text for as-built posting

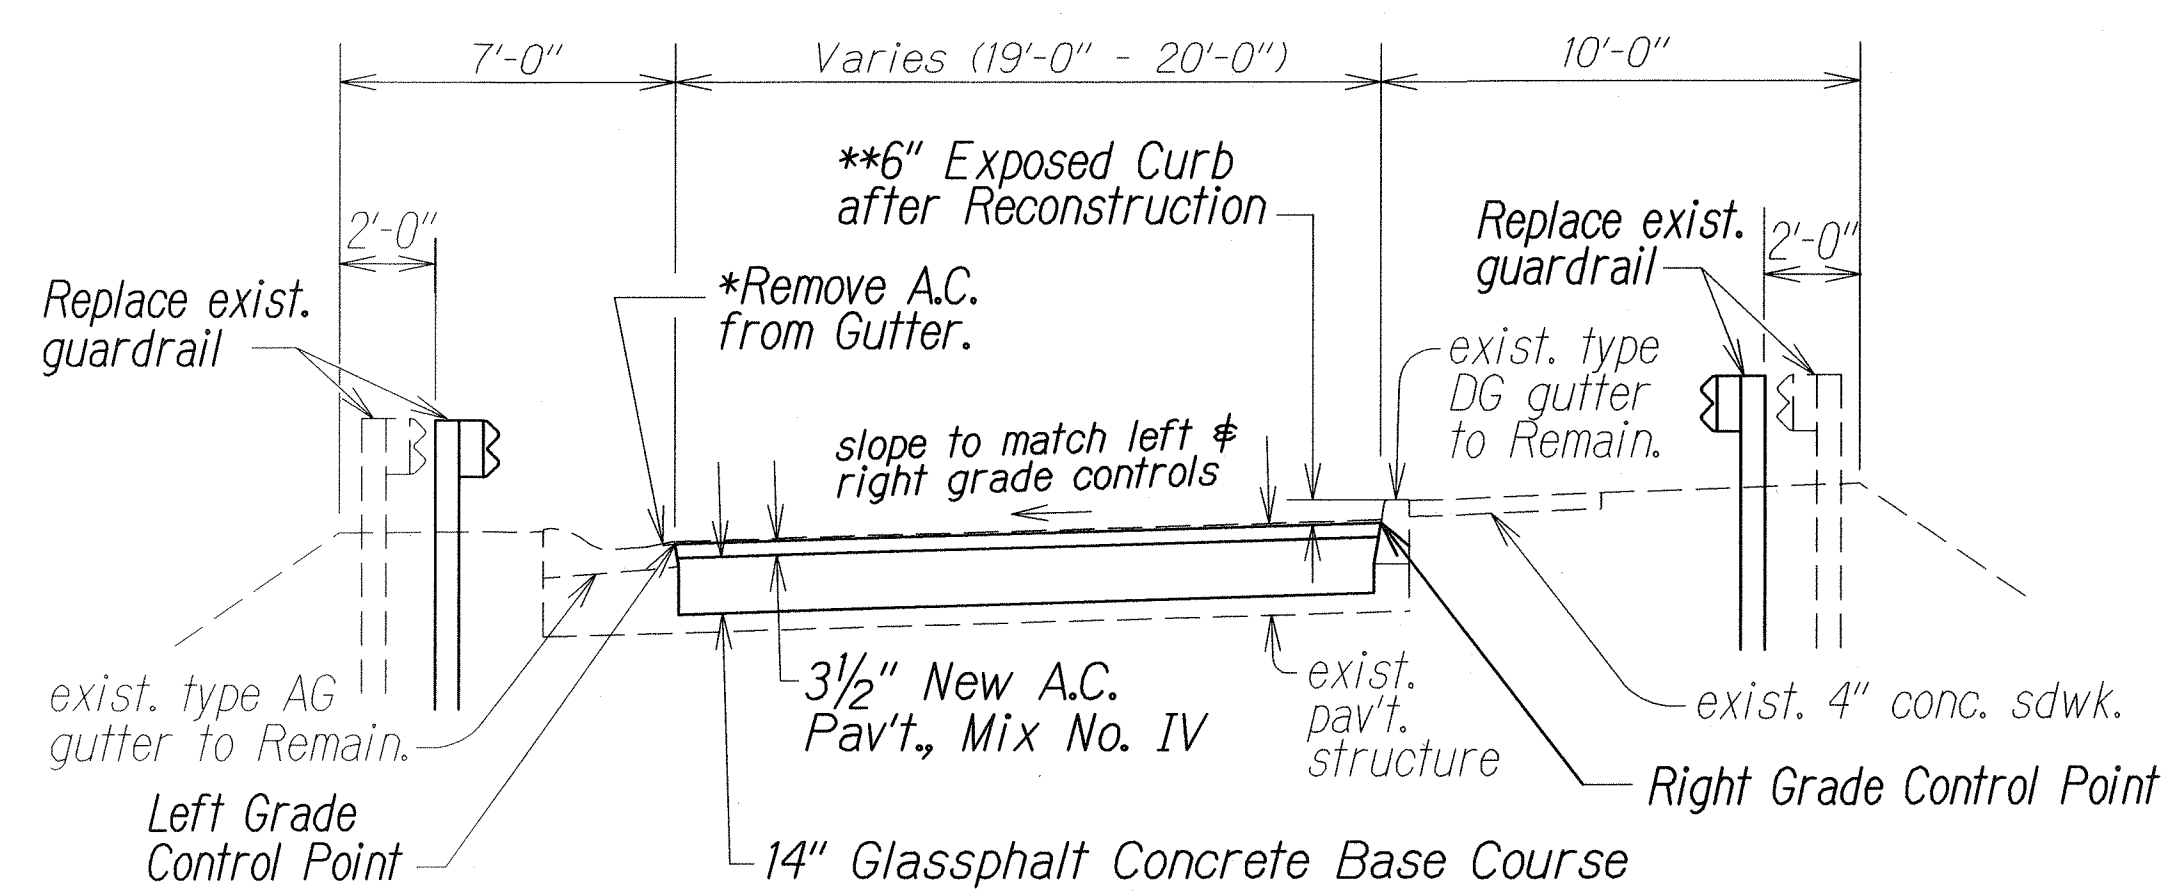


TYPICAL SECTION
AIEA ACCESS RD # STA. 6+92 TO # STA. 10+00
 Scale: 1/4" = 1'-0"

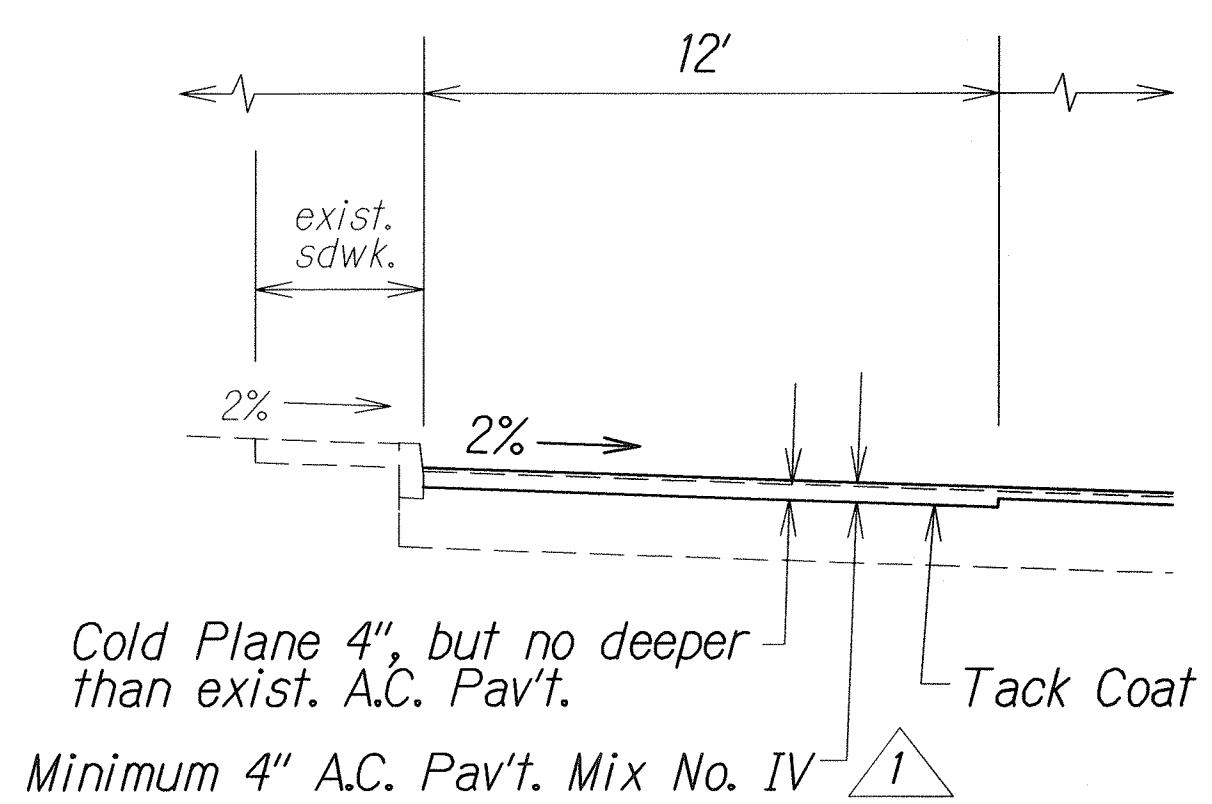


PARTIAL TYPICAL - N. ACCESS RAMP
STA. 2+30± TO # STA. 3+00± o/s 0' TO 12' Rt.
 Scale: 1/4" = 1'-0"

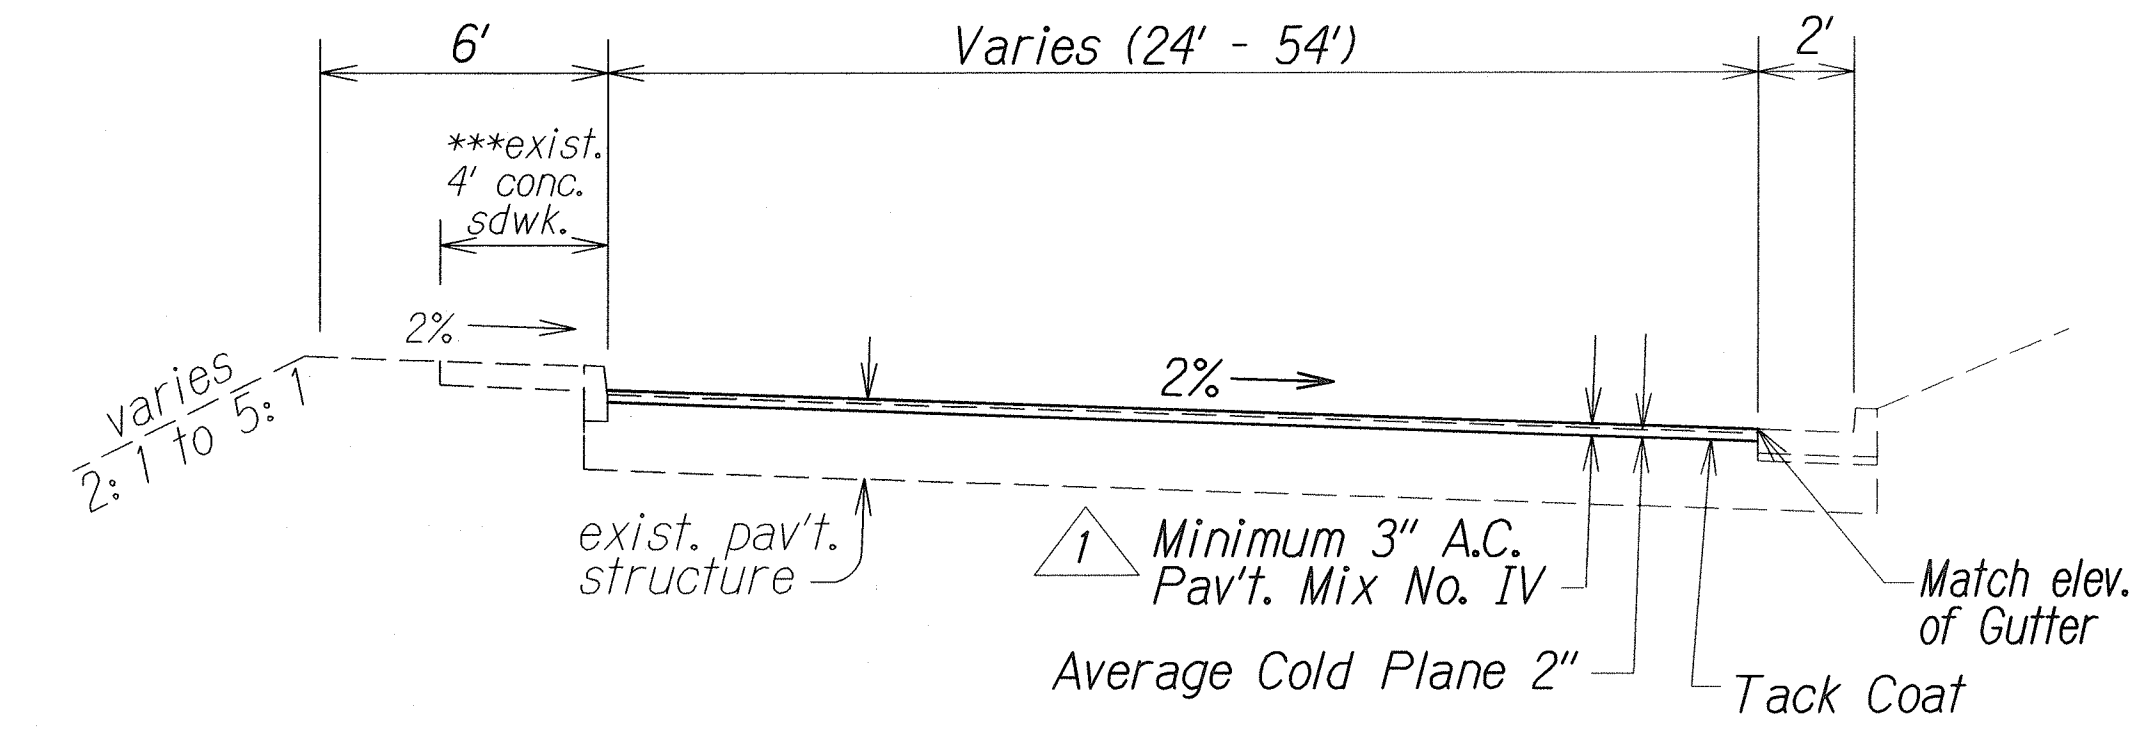


TYPICAL SECTION-NORTH ACCESS RAMP
 Scale: 1/4" = 1'-0"

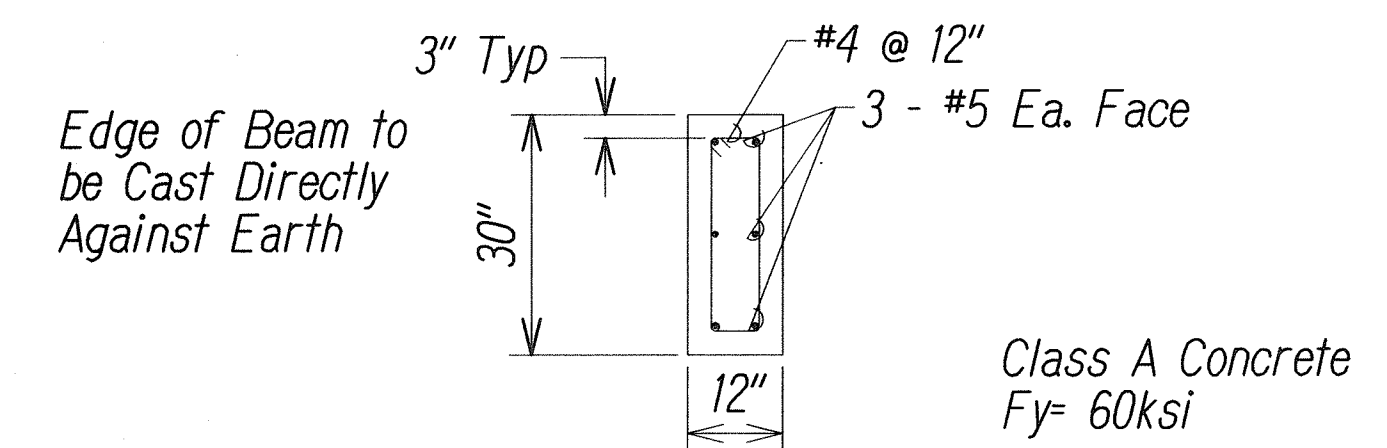

THICKENED EDGE DETAIL
 Scale: 1/2" = 1'-0"
 CONSTRUCT FROM LOOP RAMP # STA. 4+92 TO # STA. 8+49±

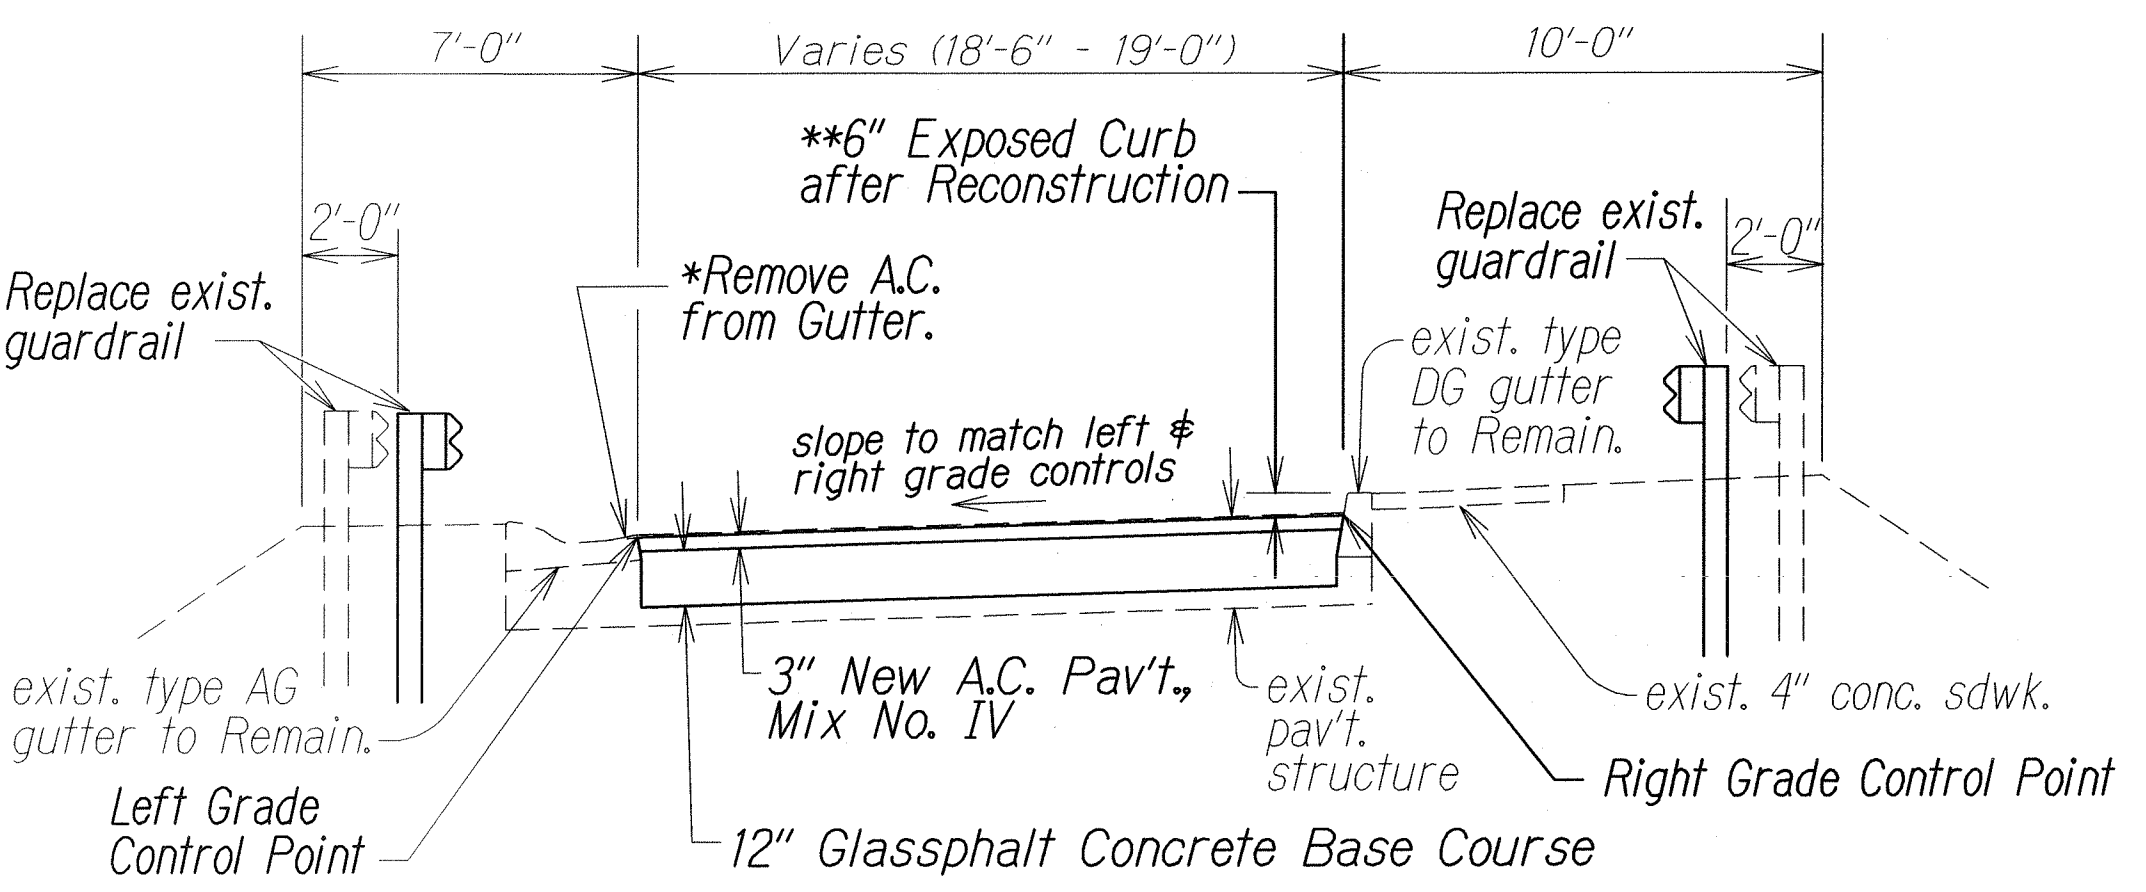

TYPICAL SECTION
AIEA ACCESS RD # STA. 12+55 TO # STA. 15+50
 Scale: 1/4" = 1'-0"

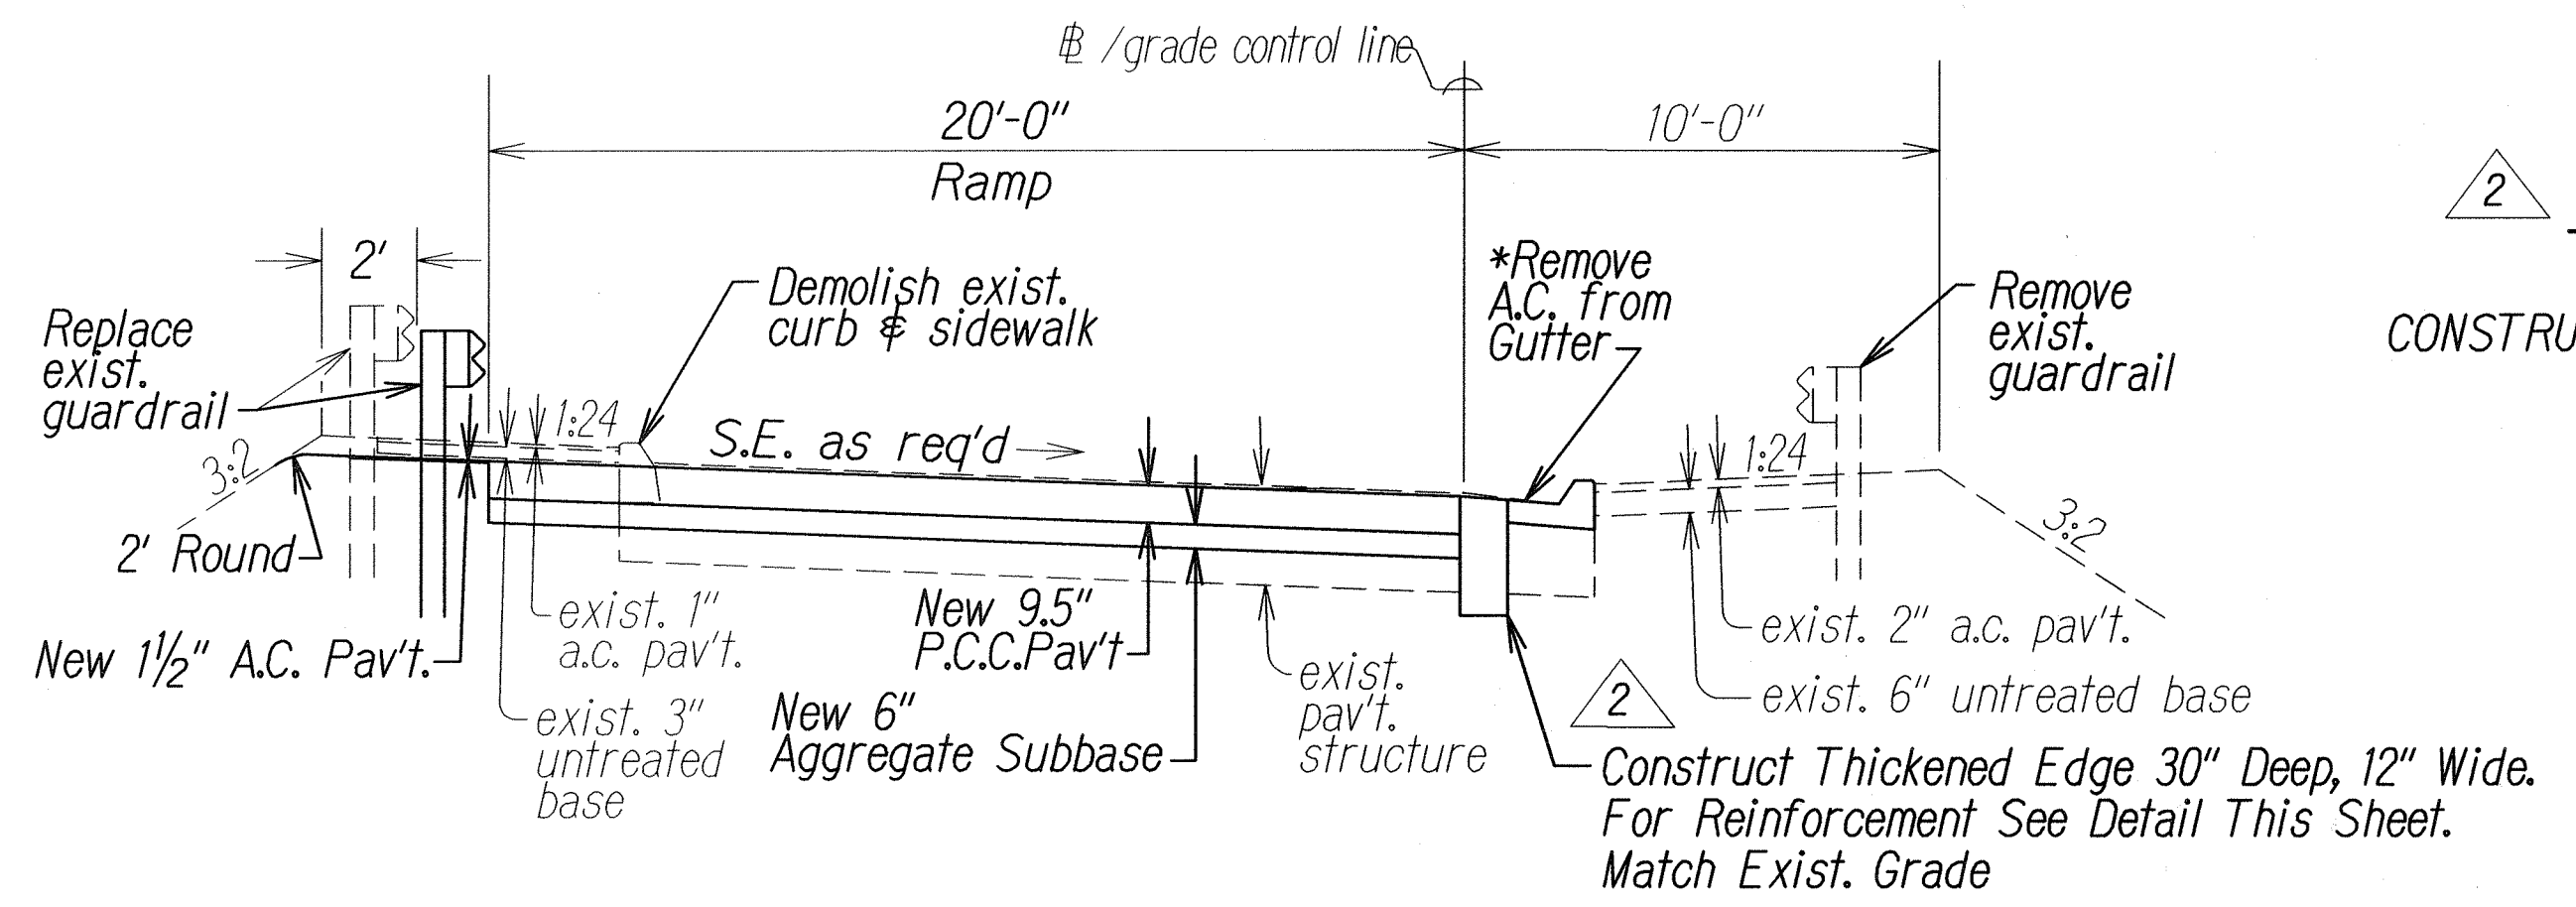

TYPICAL SECTION - LOOP RAMP
 Scale: 1/4" = 1'-0"

Note: See Pln. Sht. 13B for reinforced section of loop ramp


- Notes:
- * Removal of A.C. from Gutter is considered incidental to various contract items.
 - ** For sidewalk transitions at structures, see Plan Sht. No. 18.
 - *** For location of reconstructed concrete sidewalk, see Plan Shts. 11, 17.
 - + Where AC is exposed, no compaction of subgrade is required. Where base course materials are encountered, compact with a minimum of 12 passes with a vibratory compactor.

SURVEY PLOTTED BY	DATE
DRAWN BY	4/2/03
TRACED BY	
DESIGNED BY	
CHECKED BY	


2	Added Detail; Revised Loop Ramp Typical Section
1	Revised Per Addendum No. 1.
DATE	REVISION

STATE OF HAWAII DEPARTMENT OF TRANSPORTATION HIGHWAYS DIVISION	
TYPICAL SECTIONS	
AIEA ACCESS ROAD RESURFACING	
MOANALUA ROAD TO KAMEHAMEHA HIGHWAY	
Project No. HWY-0-01-05M	
Scale: As Noted	Date: June, 2005
SHEET NO. 1 OF 2 SHEETS	


FED. ROAD DIST. NO.	STATE	PROJ. NO.	FISCAL YEAR	SHEET NO.	TOTAL SHEETS
HAWAII	HAW.	HWY-0-01-05M	2006	9	106

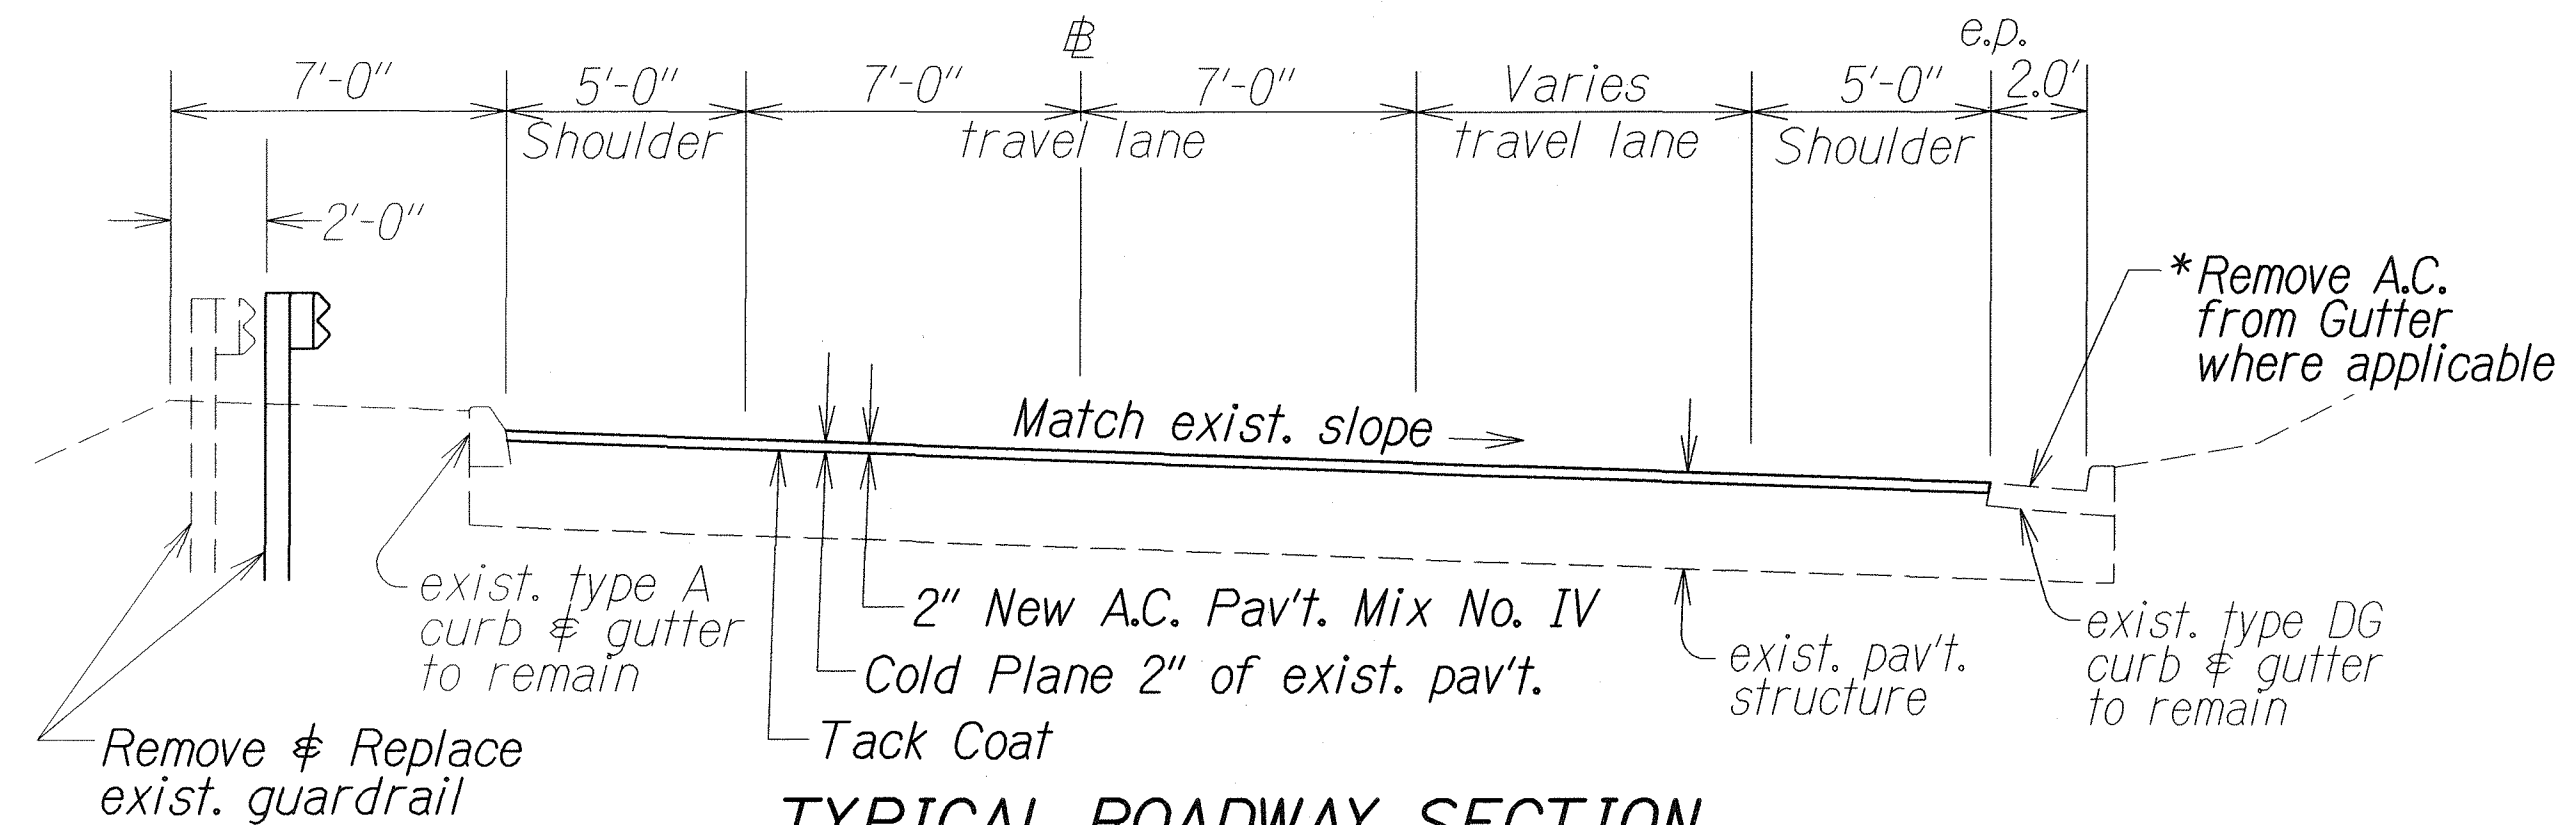


TYPICAL ROADWAY SECTION
S.E. RAMP STA. 293+44 TO STA. 5+25.70
 Scale: 1/4" = 1'-0"

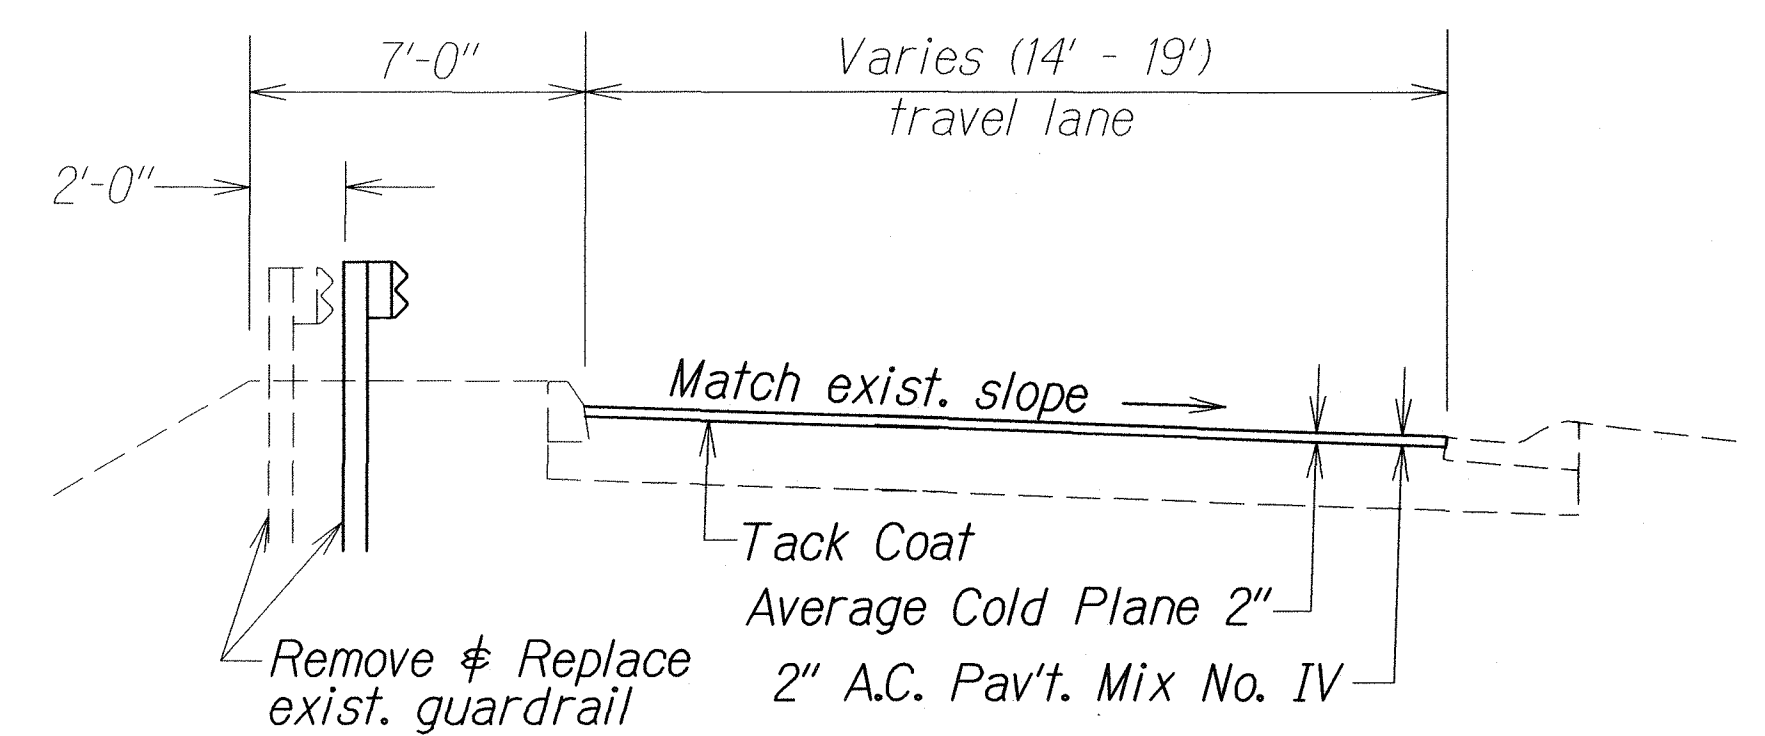


TYPICAL ROADWAY SECTION-OUTBOUND AIEA ACCESS ROAD
 Scale: 1/4" = 1'-0"

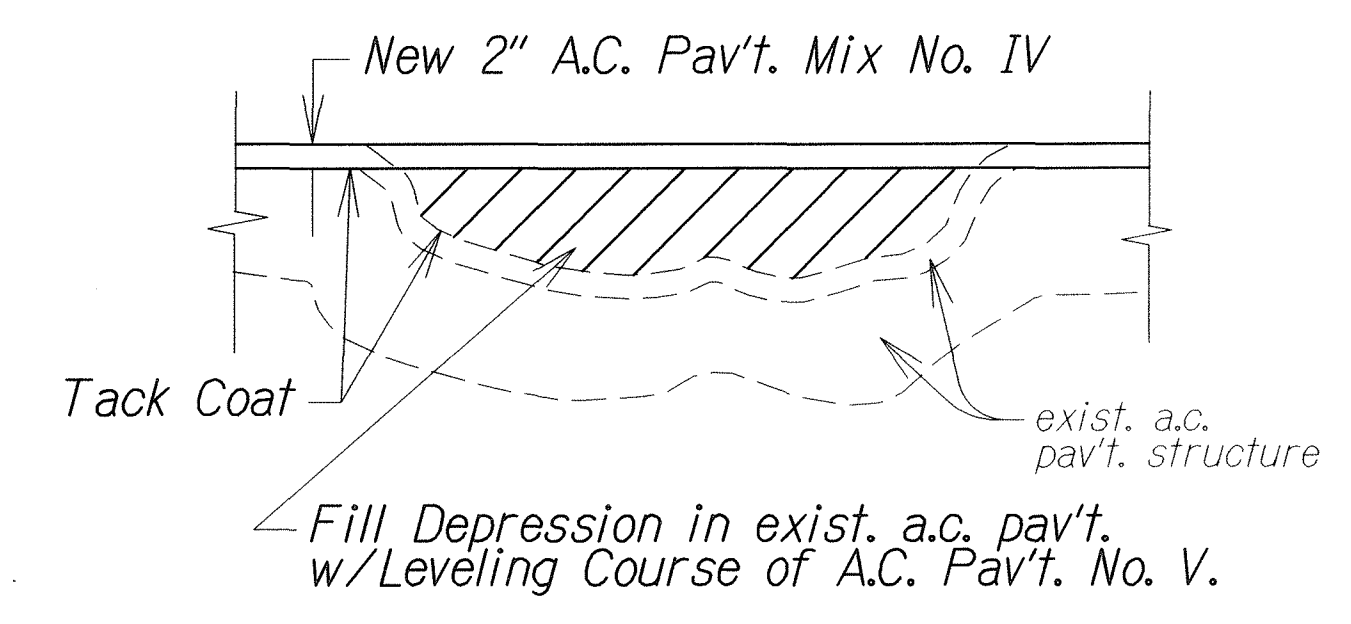


LEVELING COURSE DETAIL
 Not to Scale

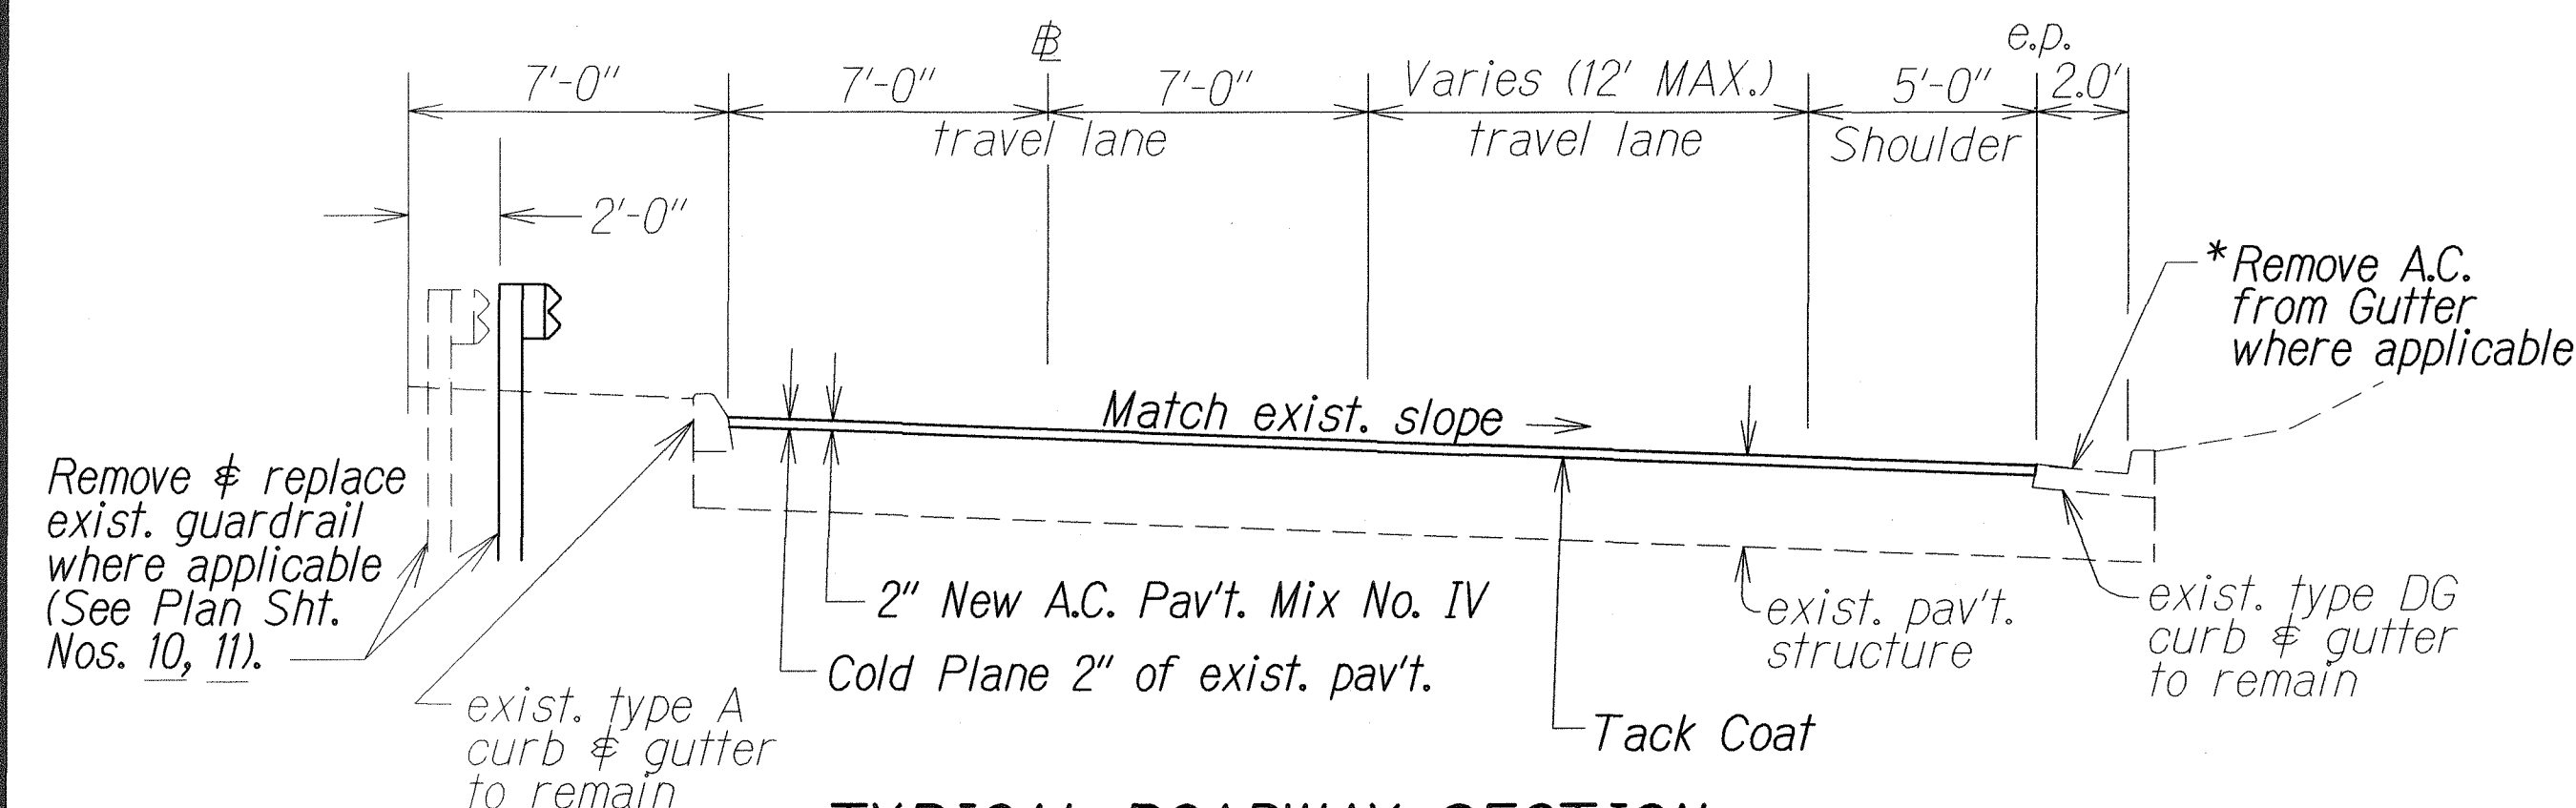

TYPICAL ROADWAY SECTION
S.E. RAMP STA. 5+25.70 TO STA. 9+65
 Scale: 1/4" = 1'-0"

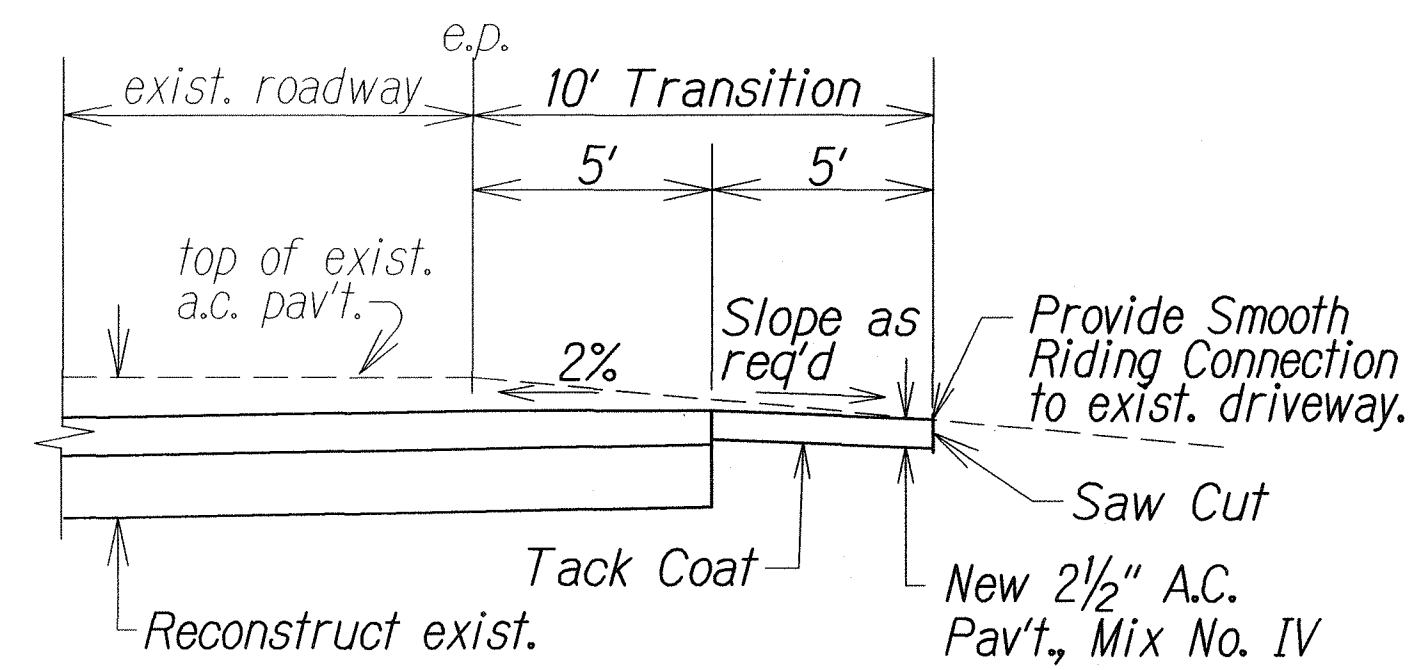


DRIVEWAY TRANSITION DETAIL
 Not to Scale

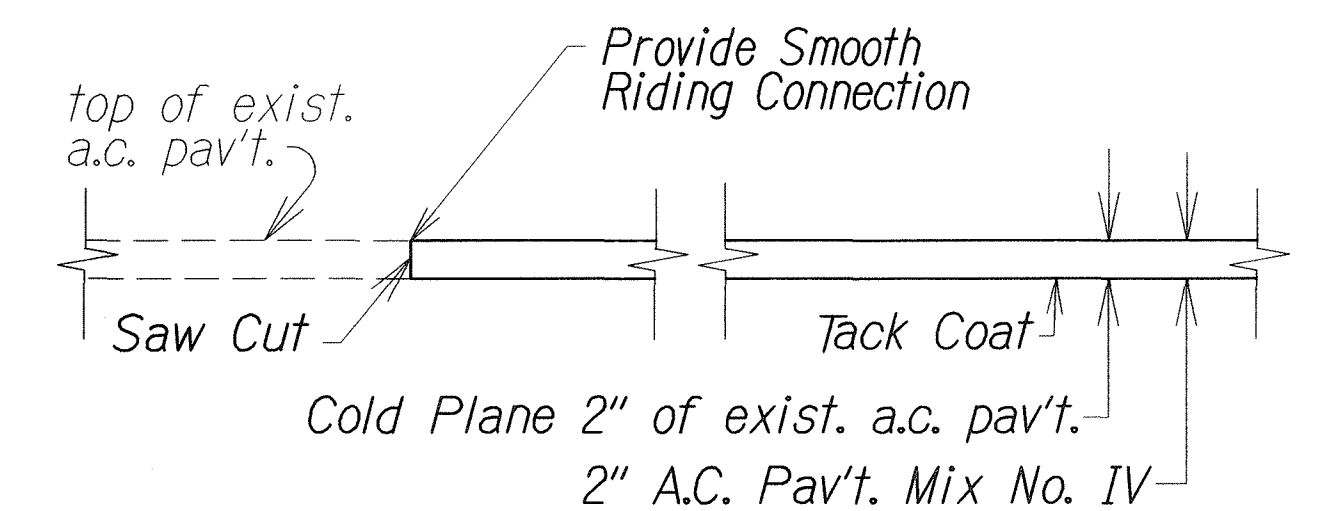


CONNECTION TO EXIST. A.C. PAVEMENT AT LIMITS OF RESURFACING
 Not to Scale

DATE	4/2/03
SURVEY PLOTTED BY	...
DRAWN BY	...
DESIGNED BY	...
CHECKED BY	...
ORIGINAL PLAN	...
NOTE BOOK	...
DESIGNED BY	...
CHECKED BY	...

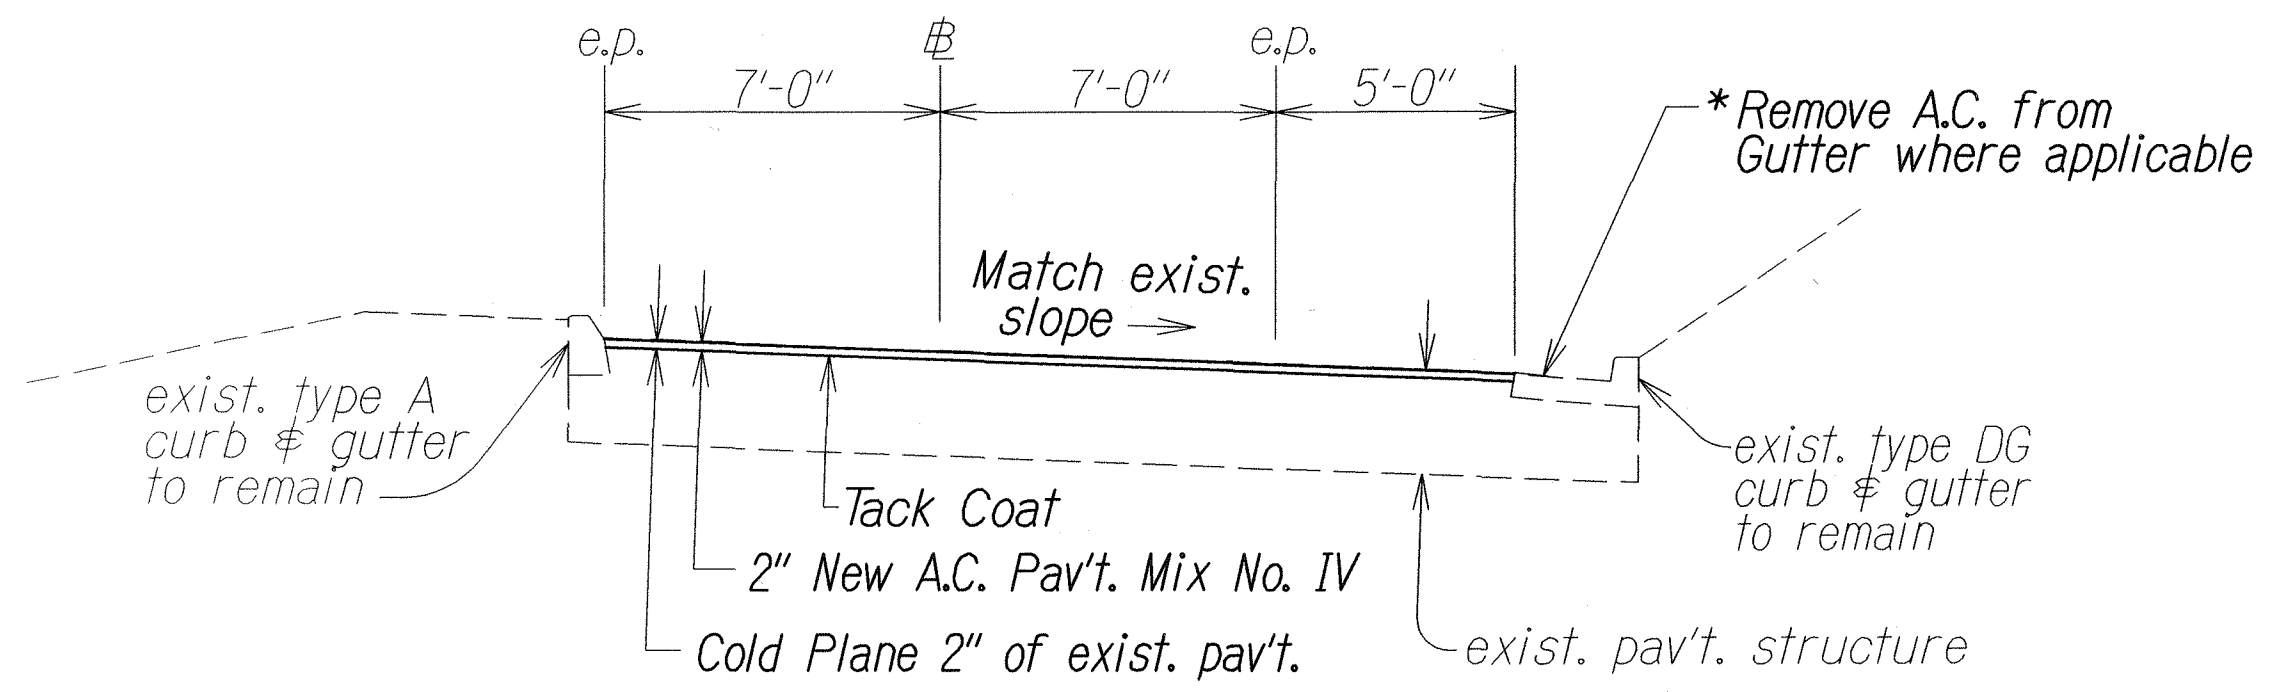

TYPICAL ROADWAY SECTION
S.E. RAMP STA. 9+65 TO STA. 17+50.30
 Scale: 1/4" = 1'-0"

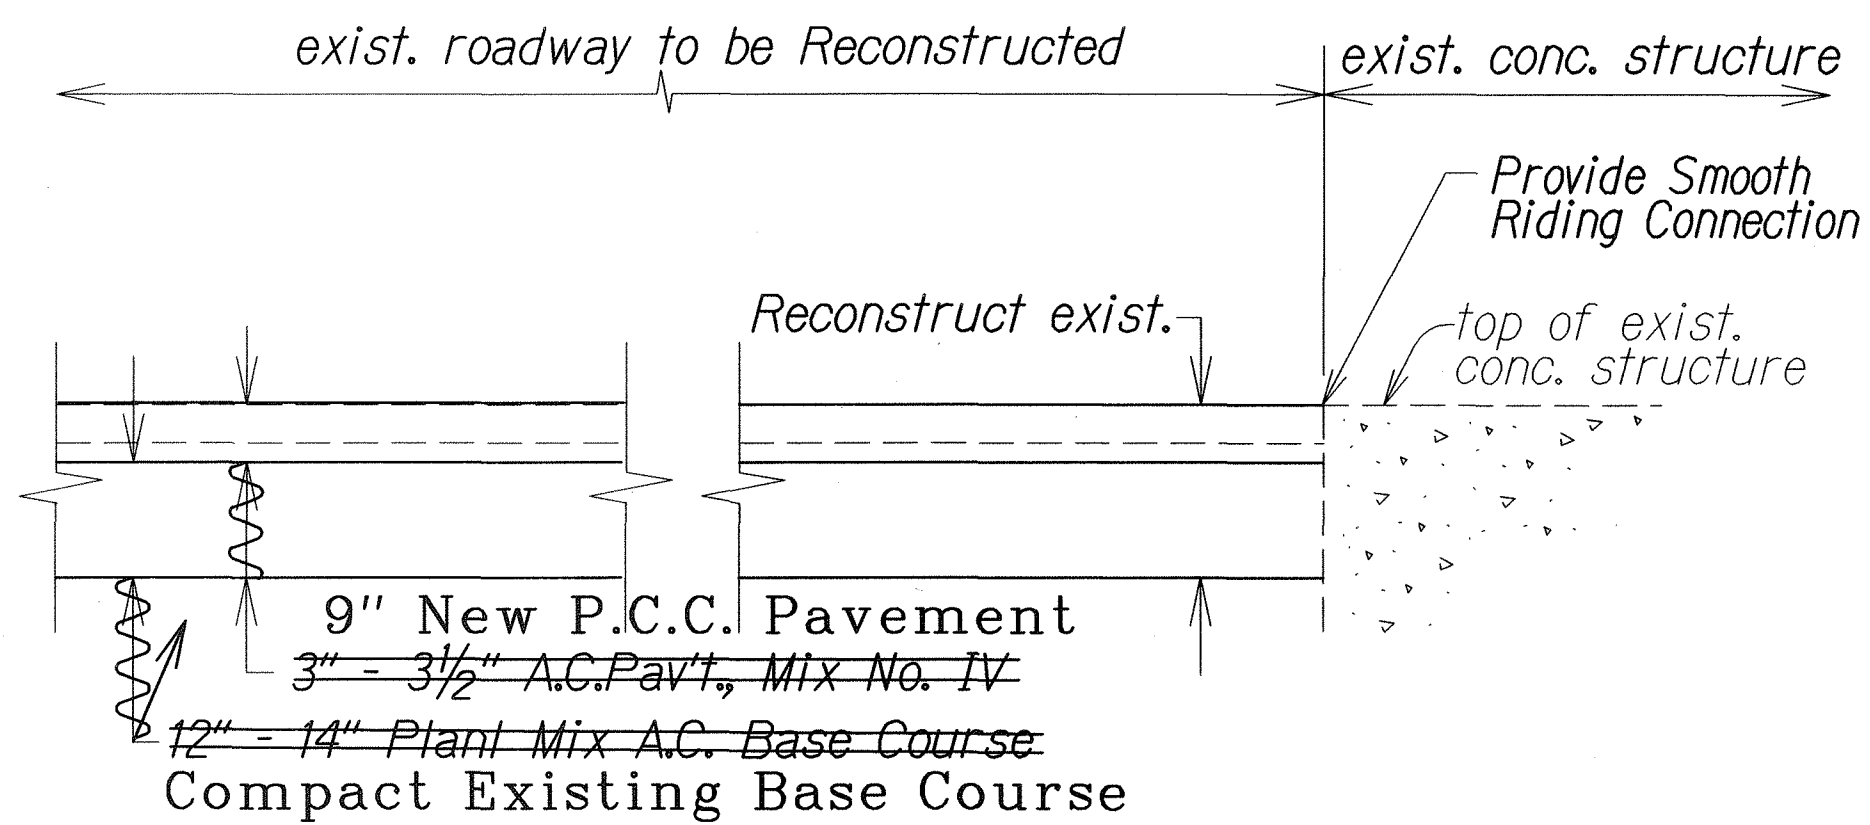

TYPICAL DETAIL
TRANSITION AT CONCRETE STRUCTURE
 Not to Scale

LEGEND FOR AS-BUILT POSTINGS	
	Squiggly line for as-built deletion
	Double line for as-built deletion
Roadway	Text for as-built posting

***Note:**
 Removal of A.C. from Gutter is considered incidental to various contract items.

STATE OF HAWAII
DEPARTMENT OF TRANSPORTATION
HIGHWAYS DIVISION

TYPICAL SECTIONS AND DETAILS
AIEA ACCESS ROAD RESURFACING
MOANALUA ROAD
TO KAMEHAMEHA HIGHWAY
Project No. HWY-0-01-05M
Scale: As Noted
Date: June, 2005
SHEET No. 2 OF 2 SHEETS