


FED. ROAD DIST. NO.	STATE	PROJ. NO.	FISCAL YEAR	SHEET NO.	TOTAL SHEETS
HAWAII	HAW.	HWY-0-04-07M	2007	14	57

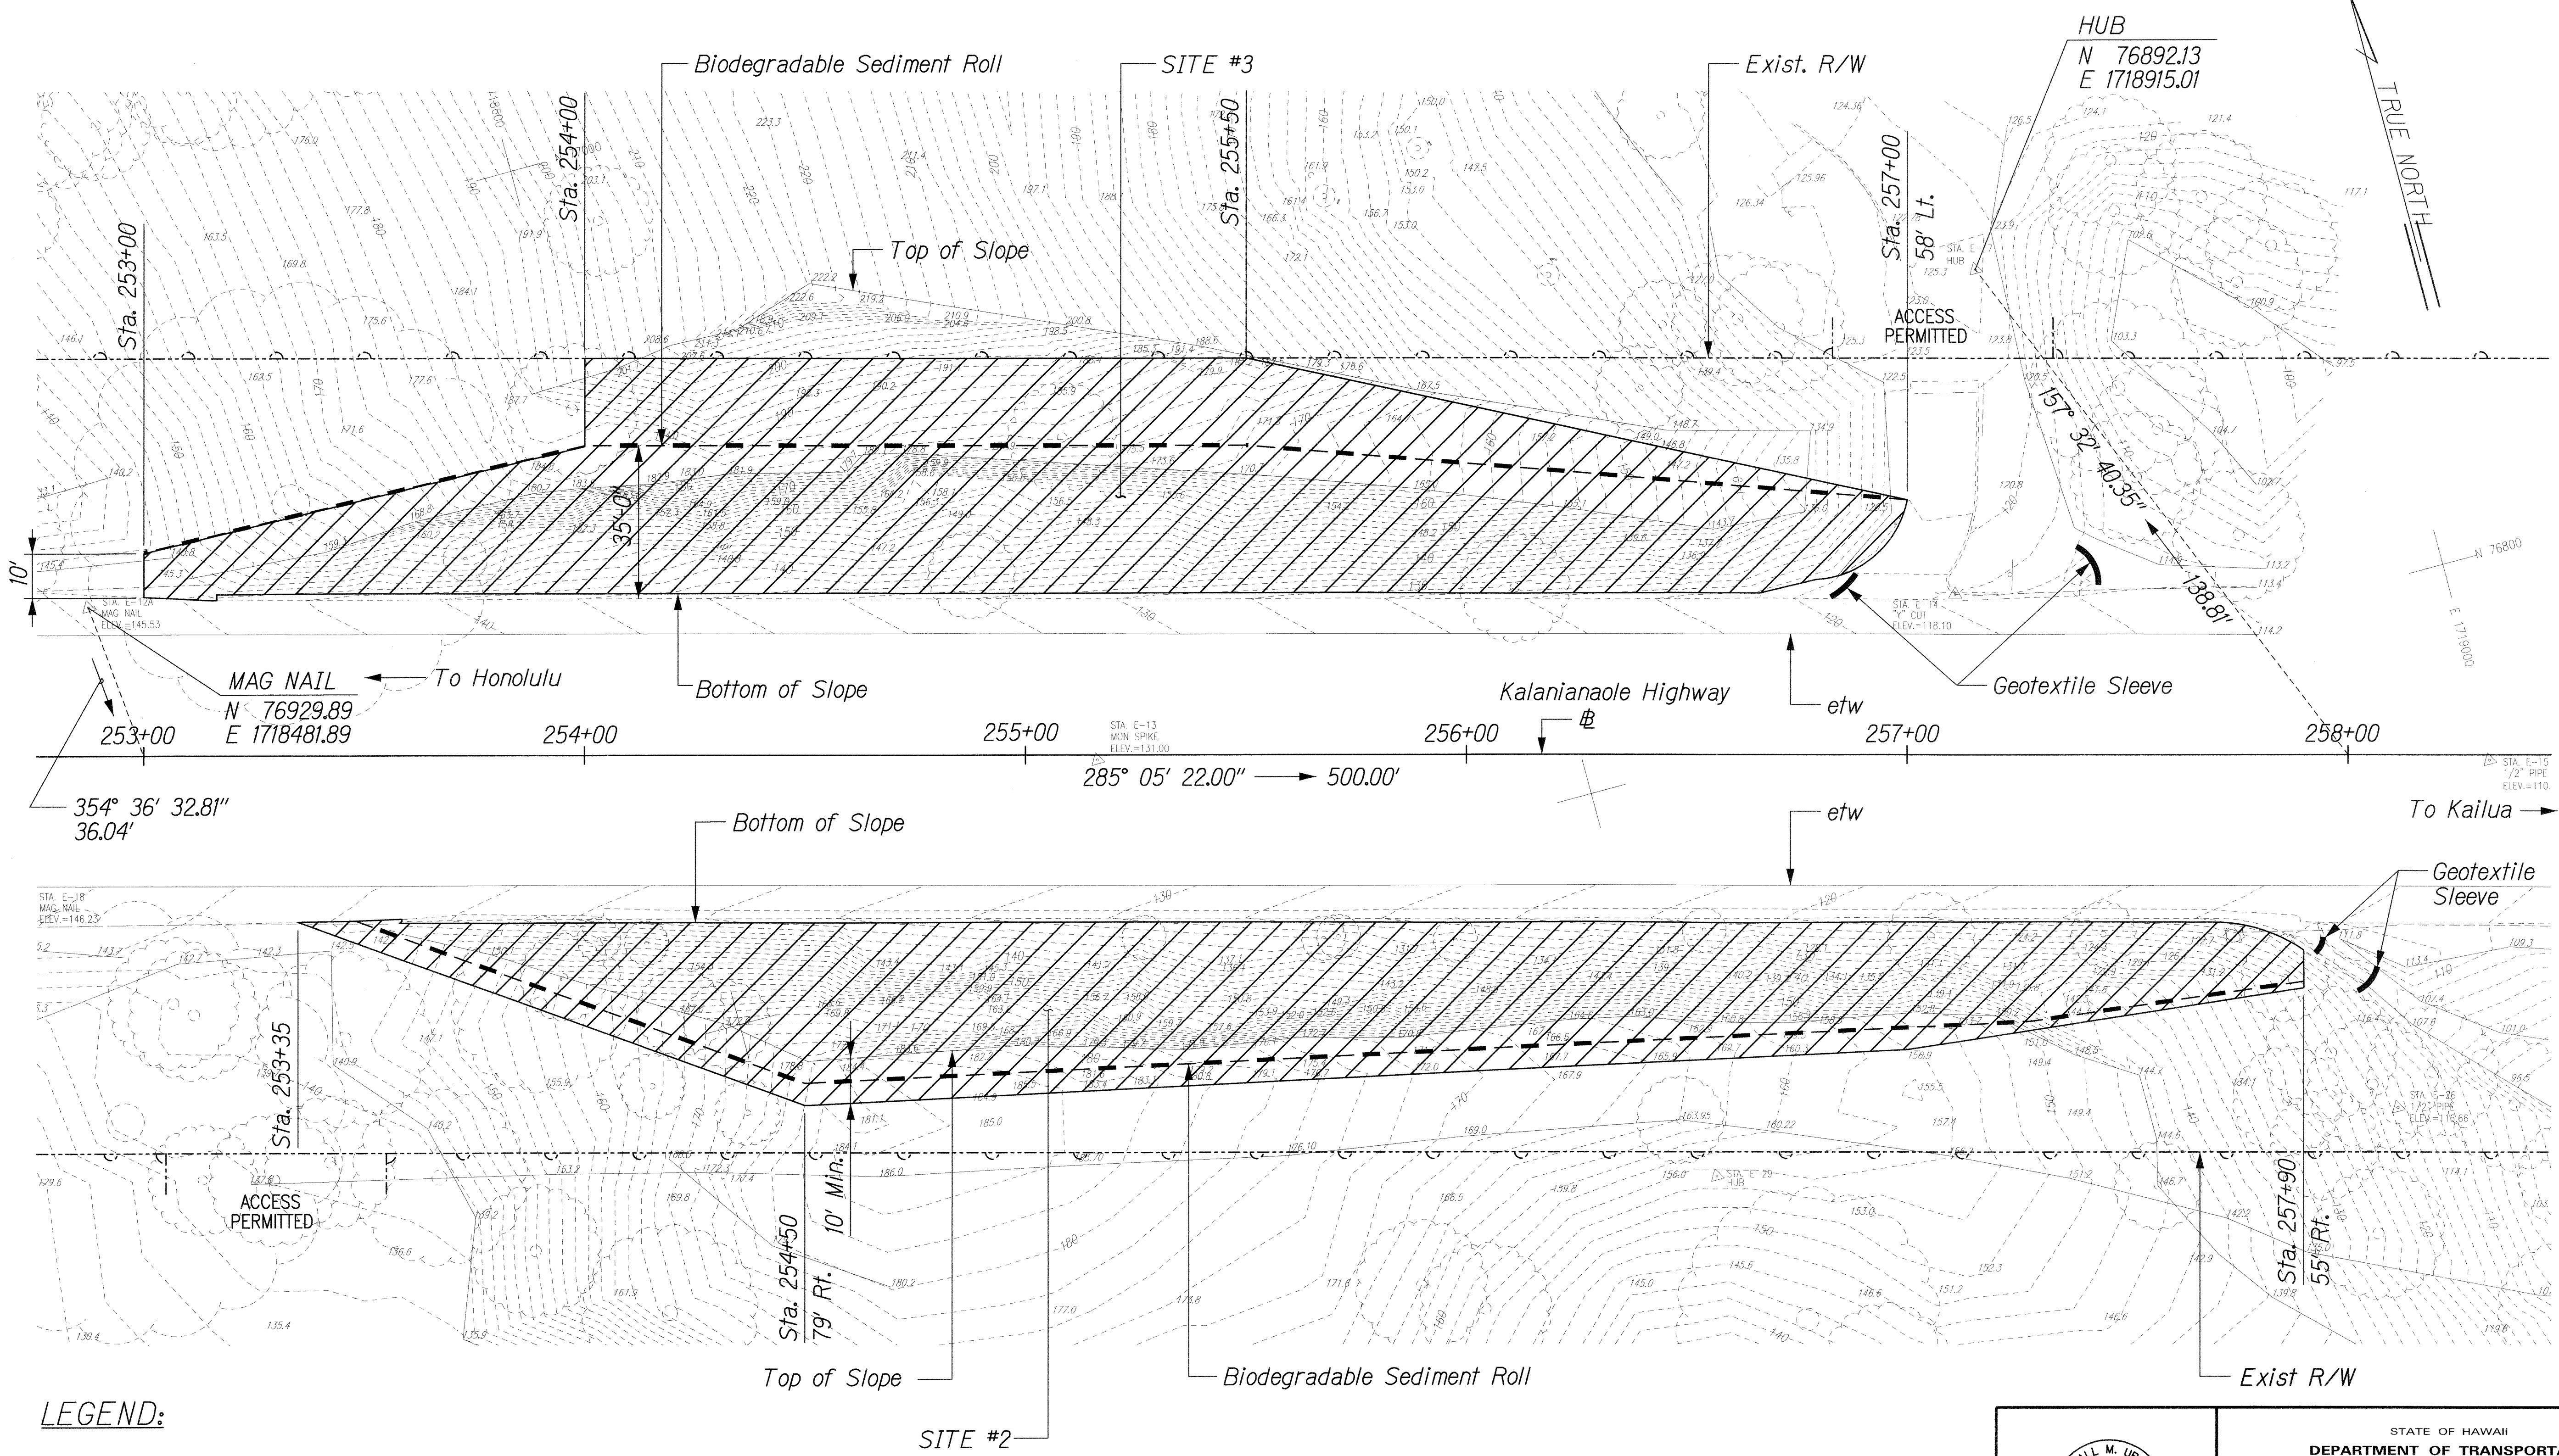

LEGEND:


Hydraulic Blanket Mixture

Geotextile Sleeve
See Detail on Sht. N-4

Biodegradable Sediment Roll

NOTE:

Existing vegetation coverage may vary at time of construction. Contractor shall apply hydraulic blanket mixture on areas with no vegetation or as directed by the Engineer. Existing trees and vegetation shall remain unless otherwise directed by the Engineer for removal.

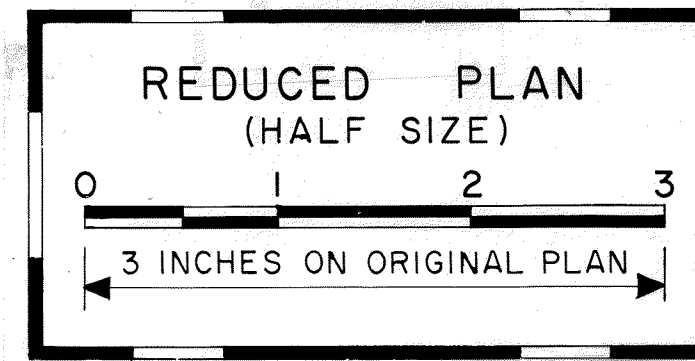

THIS WORK WAS PREPARED BY ME OR UNDER MY SUPERVISION.
SIGNATURE: *[Signature]* EXPIRATION DATE: 4-30-08

STATE OF HAWAII
DEPARTMENT OF TRANSPORTATION
HIGHWAYS DIVISION

EROSION CONTROL PLAN
KALANIANA'OLE HWY. - SITES #2 & #3

SLOPE MAINTENANCE FOR EROSION CONTROL
AT VARIOUS SITES ON OAHU, PHASE 2
Project No. HWY-0-04-07M

Scale: 1"=20' Date: April 2007