DESCRIPTION HEET RD PLAN SUMMARY
RD PLAN SUMMARY
L NOTES & LEGEND
POLLUTION & EROSION L NOTES
URAL PLANS

STATE OF HAWAII

DEPARTMENT OF TRANSPORTATION

HIGHWAYS DIVISION HONOLULU, HAWAII


"AS-BUILT"

PLANS FOR

FED. ROAD DIST. NO. STATE PROJ. NO. FISCAL SHEET TOTAL SHEETS HAWAII HAW. HWY-O-02-03M 2008 1 10





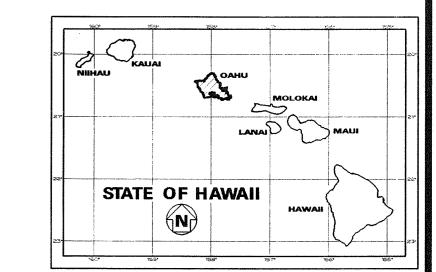


ALA MOANA BOULEVARD/FARRINGTON HIGHWAY

BRIDGE REPAIRS AT VARIOUS LOCATIONS PROJECT NO. HWY-O-02-03M

DISTRICTS OF WAIANAE AND HONOLULU ISLAND OF OAHU

PROJECT SITES

- 1) Mailiilii Stream Bridge MILE POST 9.70
- 2 Ala Wai Stream Bridge MILE POST 8.64

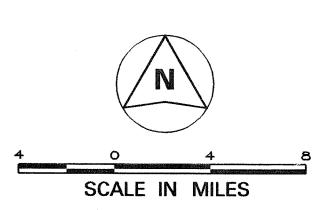

FEDERAL AID INTERSTATE PROJECTS PREVIOUSLY CONSTRUCTED OR UNDER CONSTRUCTION

MANUE SHADE DURING CONSTRUCTION MAKE BEEN BICORPORATED ON THESE PLANS EXCEPT CHANGES BY THE ORIGINAL THEORETICAL QUANTITIES, FOR ACTUAL QUANTITIES, REFER TO PROJECT LEDGER AND/OR COMPUTATION SCOK.

Mayun C. H. Ludad 2-8-ZOII

Marin C. H. Lufell 2-8-ZOII

DEPARTMENT OF TRANSPO STATE OF HAWAII	
APPROVED:	
Che m. Jami	5.22.08
DIR. OF TRANSPORTATION	DATE

