
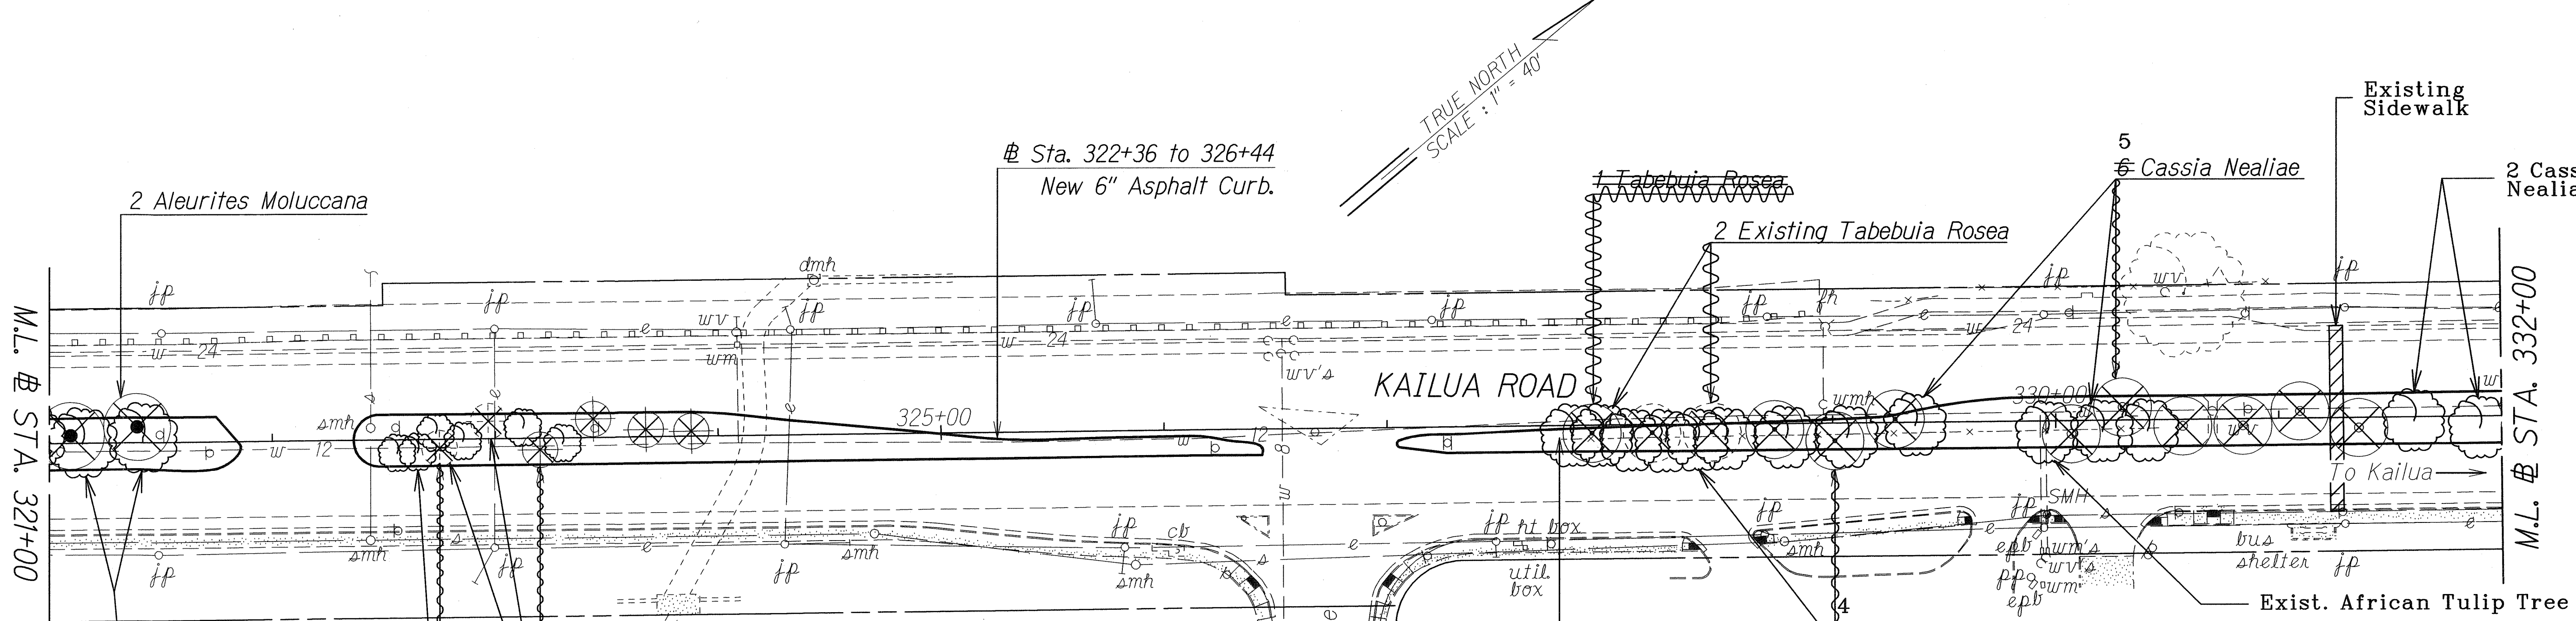


FED. ROAD DIST. NO.	STATE	FED. AID PROJ. NO.	FISCAL YEAR	SHEET NO.	TOTAL SHEETS
HAWAII	HAW.	HWY-0-03-09M	2009	7	11

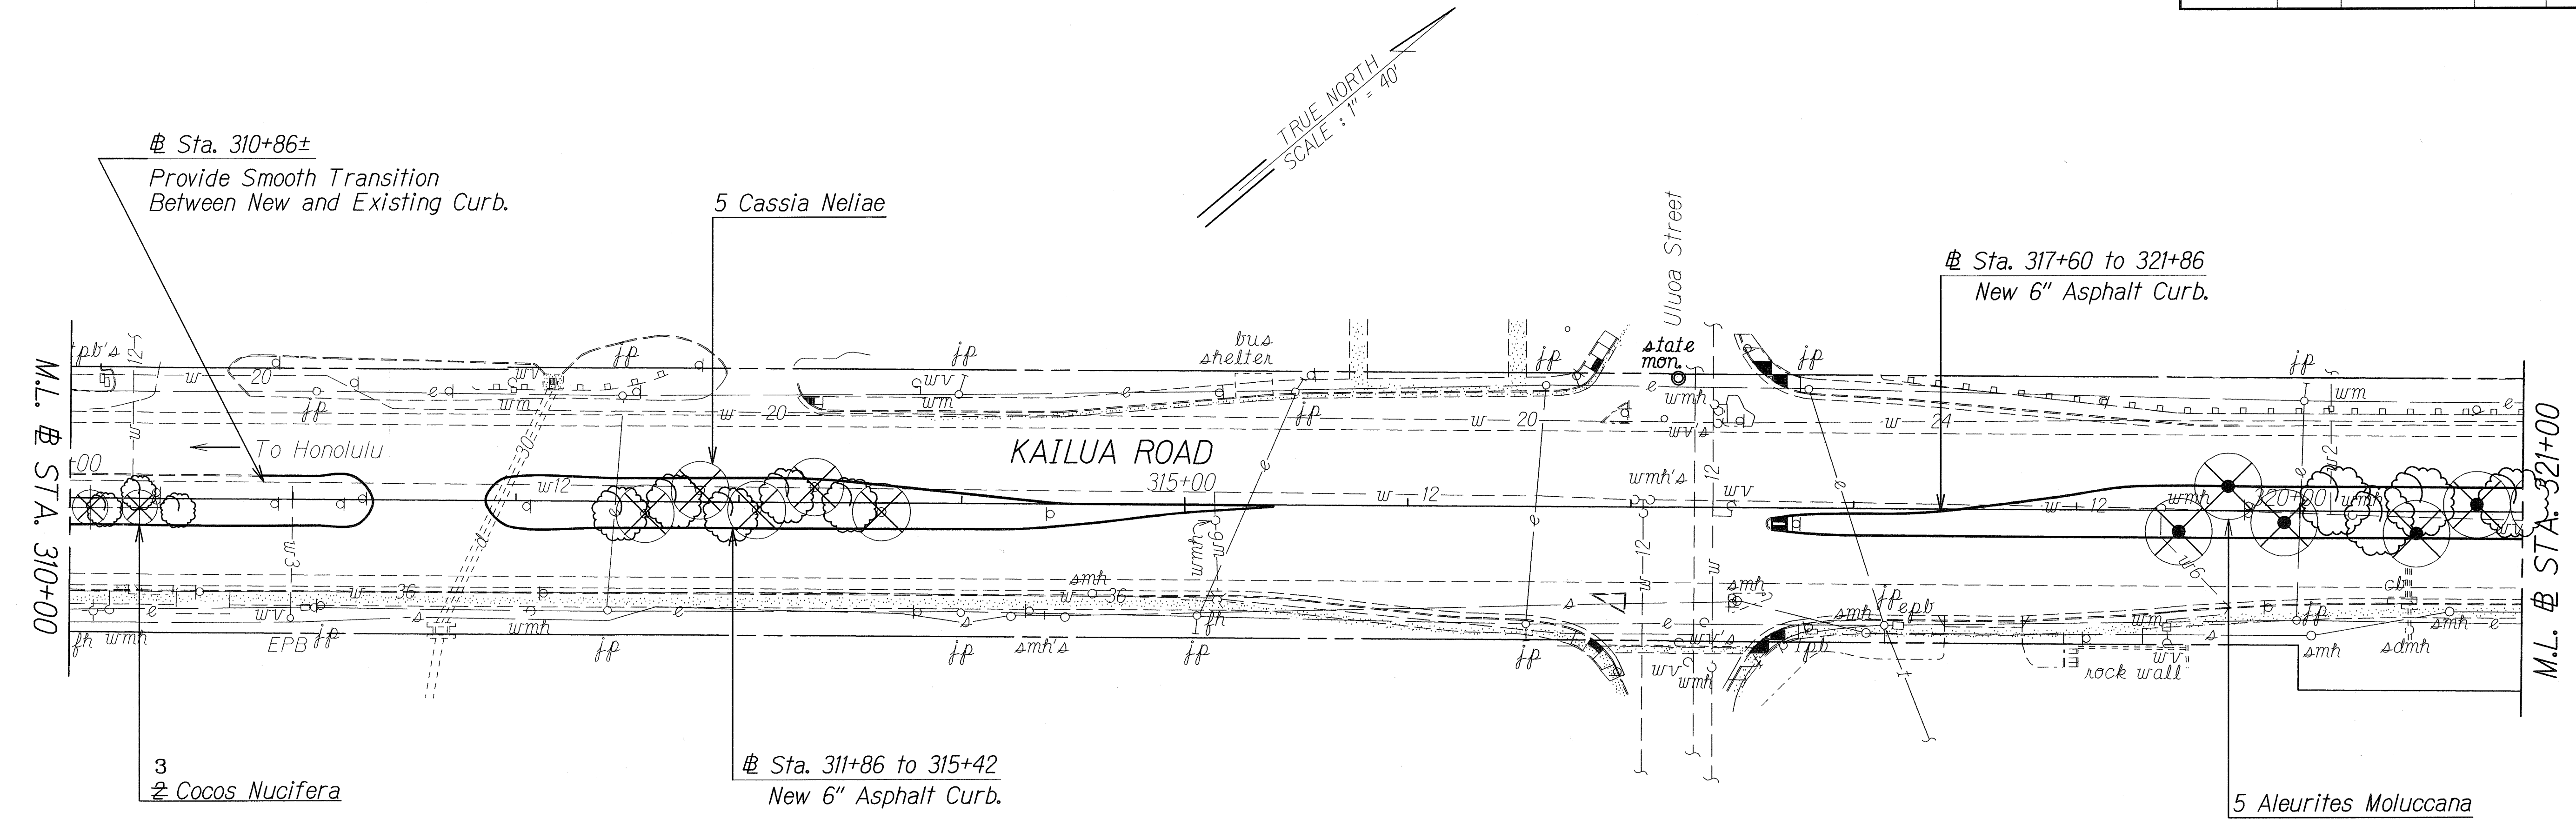

LEGEND FOR AS-BUILT POSTINGS	
	Squiggly line for as-built deletion
	Double line for as-built deletion
Roadway	Text for as-built posting

STATE OF HAWAII
DEPARTMENT OF TRANSPORTATION
HIGHWAYS DIVISION

LANDSCAPE PLANS

Kailua Rd, Castle Hospital to Kawainui Bridge
Kalanianaʻole Hwy, Kailua Rd. to Ulupuni St.
Median Erosion Control
Project No. HWY-0-03-09M



Scale: 1" = 40' Date: April, 2009

SHEET No. 2 OF 4 SHEETS

ORIGINAL PLAN	SURVEY PLOTTED BY	DATE
NOTE BOOK	DRAWN BY	
DATE	CHECKED BY	
DATE	CHECKED BY	

"AS-BUILT"

FED. ROAD DIST. NO.	STATE	FED. AID PROJ. NO.	FISCAL YEAR	SHEET NO.	TOTAL SHEETS
HAWAII	HAW.	HWY-0-03-09M	2009	8	11

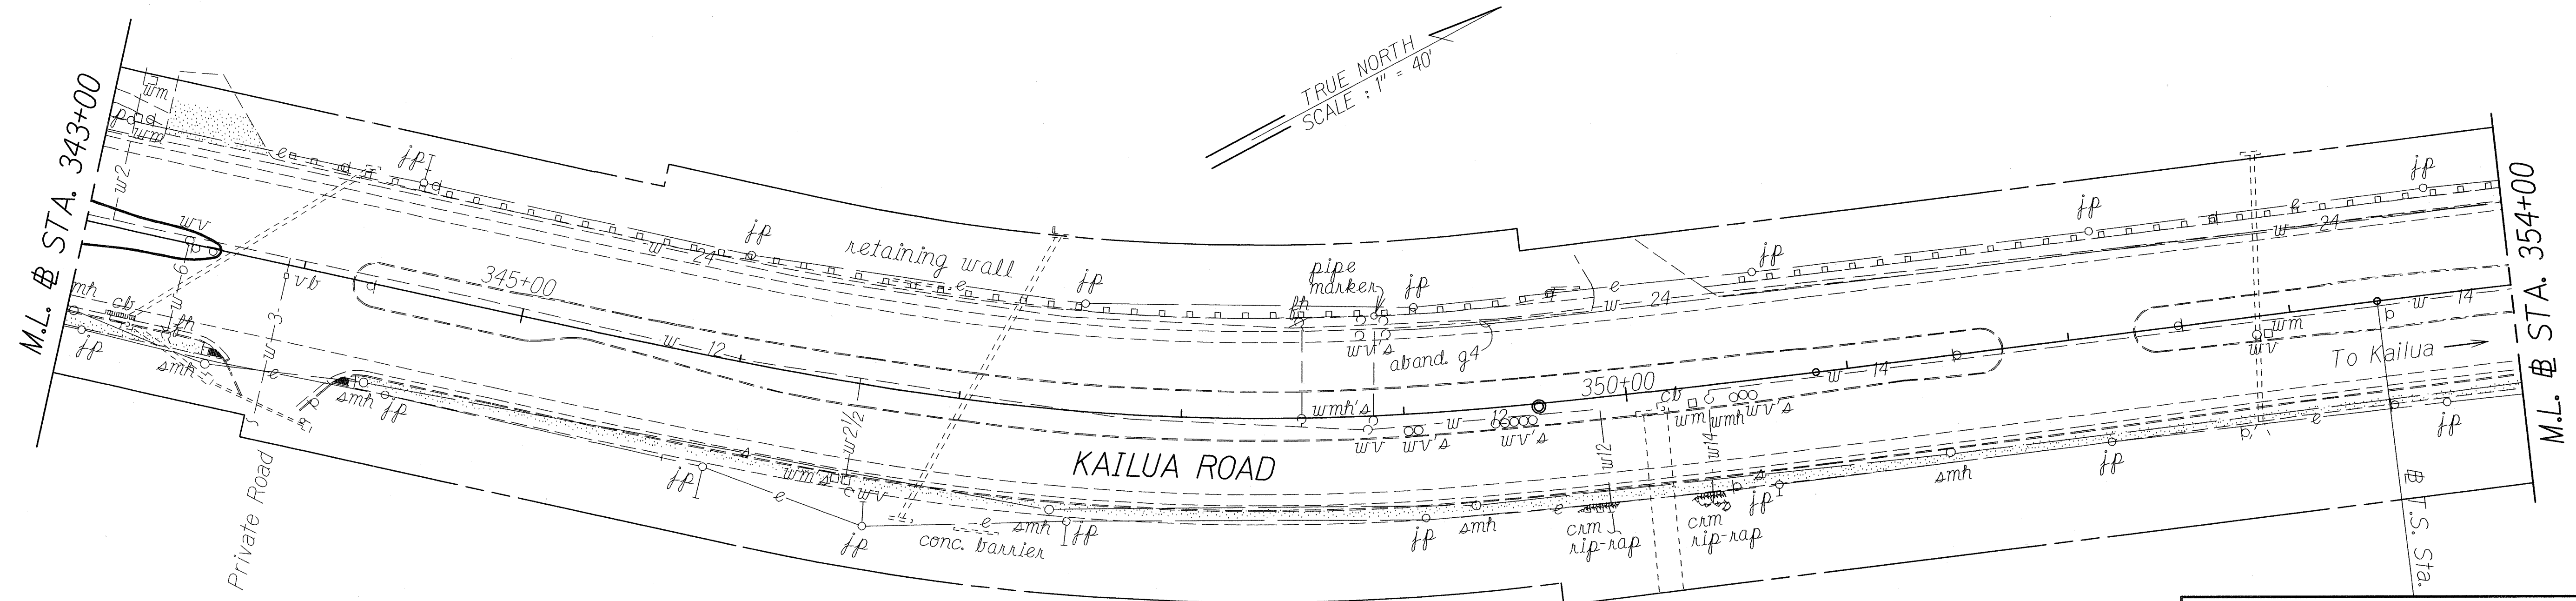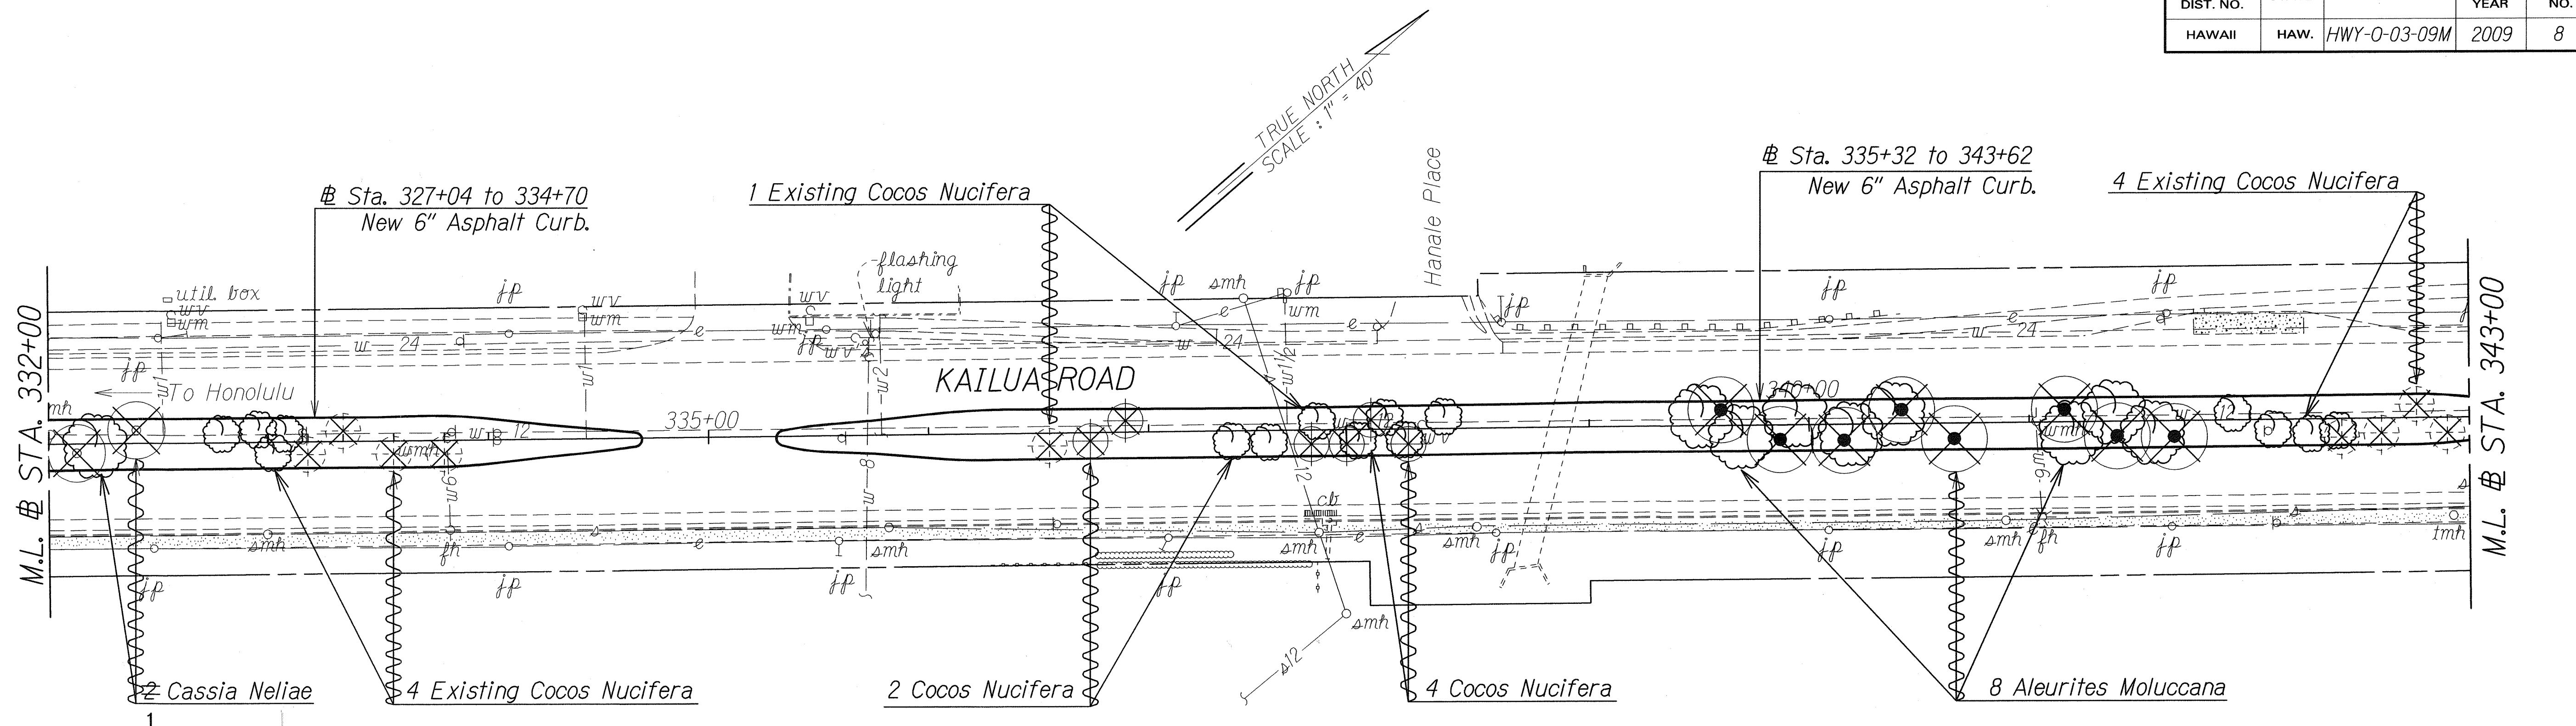

ORIGINAL PLAN	SURVEY PLOTTED BY	DATE
NOTE BOOK	DRAWN BY	
3/10/2009	DESIGNED BY	
	CHECKED BY	

LEGEND FOR AS-BUILT POSTINGS	
	Squiggly line for as-built deletion
	Double line for as-built deletion
Roadway	Text for as-built posting

STATE OF HAWAII
DEPARTMENT OF TRANSPORTATION
HIGHWAYS DIVISION

LANDSCAPE PLANS


Kailua Rd, Castle Hospital to Kawainui Bridge
Kalaniana'ole Hwy, Kailua Rd. to Ulupuni St.
Median Erosion Control
Project No. HWY-0-03-09M

Scale: 1" = 40' Date: April, 2009

SHEET No. 3 OF 4 SHEETS

"AS-BUILT"

FED. ROAD DIST. NO.	STATE	FED. AID PROJ. NO.	FISCAL YEAR	SHEET NO.	TOTAL SHEETS
HAWAII	HAW.	HWY-0-03-09M	2009	9	11

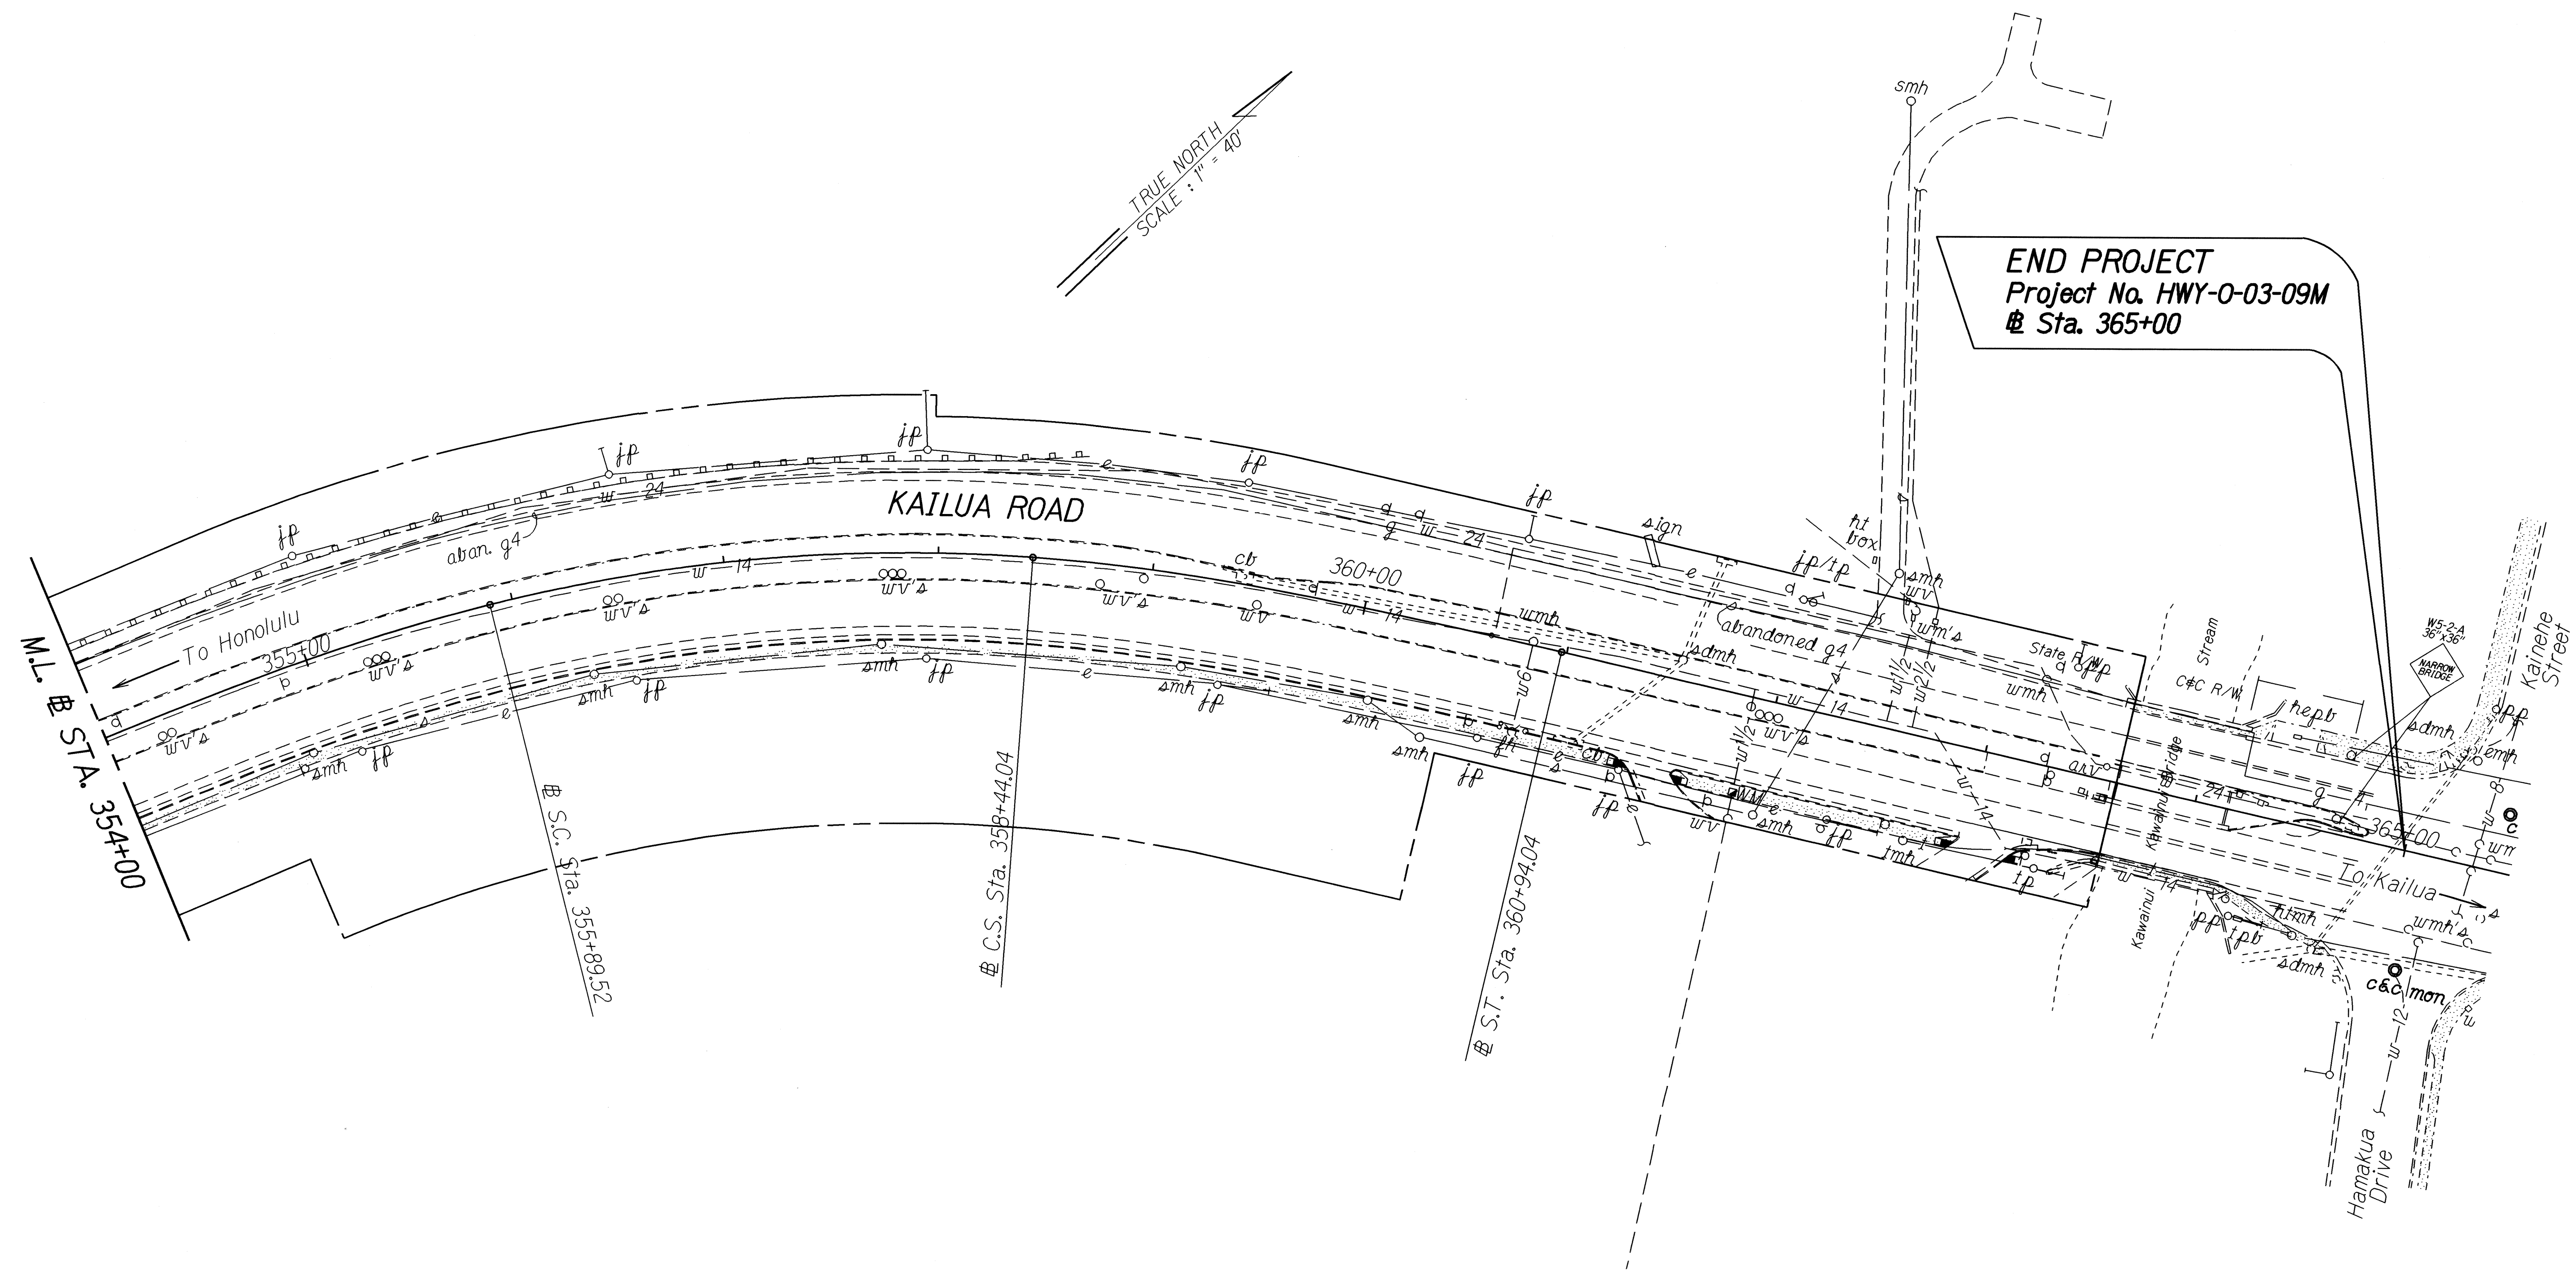

ORIGINAL PLAN	DATE
NOTES BOOK	
DESIGNED BY	
QUANTITIES BY	
CHECKED BY	

STATE OF HAWAII
DEPARTMENT OF TRANSPORTATION
HIGHWAYS DIVISION

LANDSCAPE PLANS

Kailua Rd., Castle Hospital to Kawaiunui Bridge
Kalaniana'ole Hwy., Kailua Rd. to Ulupuni St.
Median Erosion Control
Project No. HWY-0-03-09M

Scale: 1" = 40' Date: March, 2009

SHEET No. 4 OF 4 SHEETS