
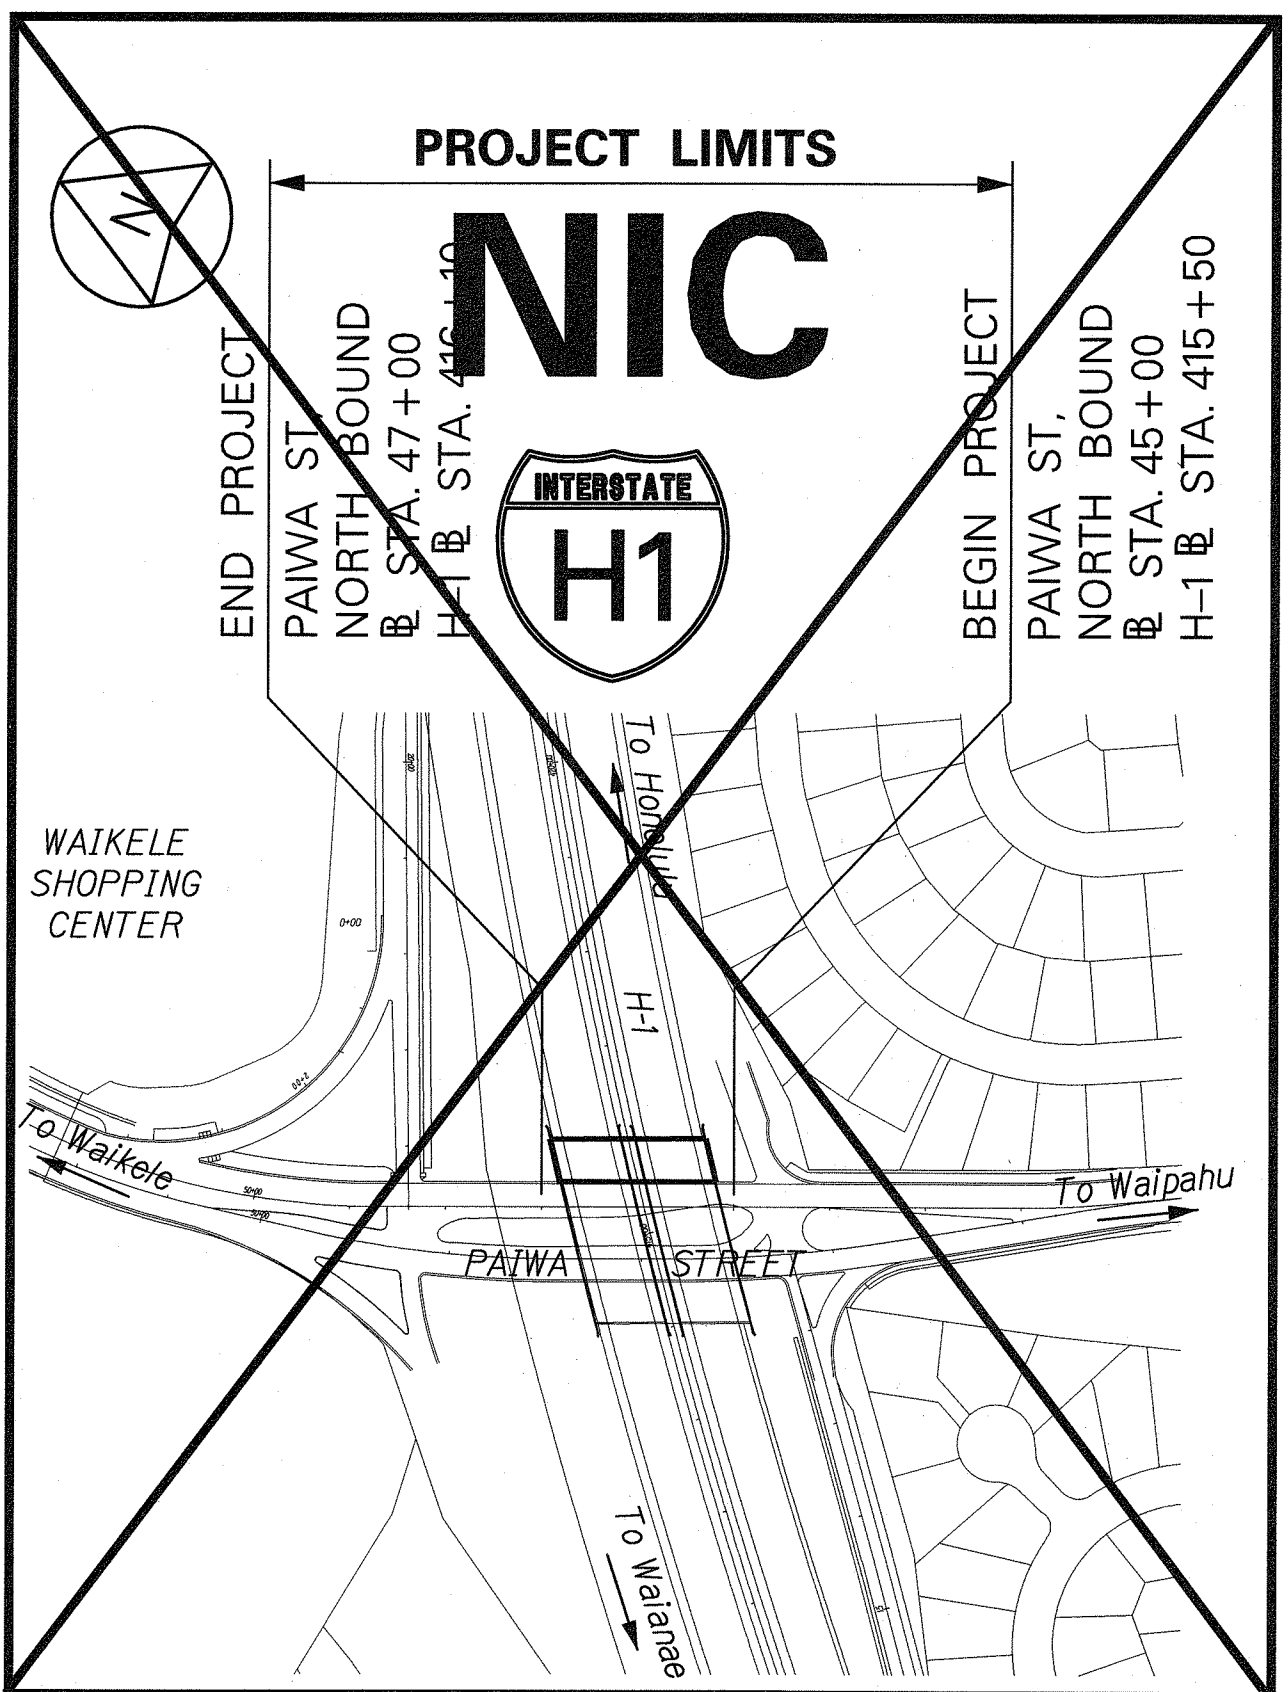
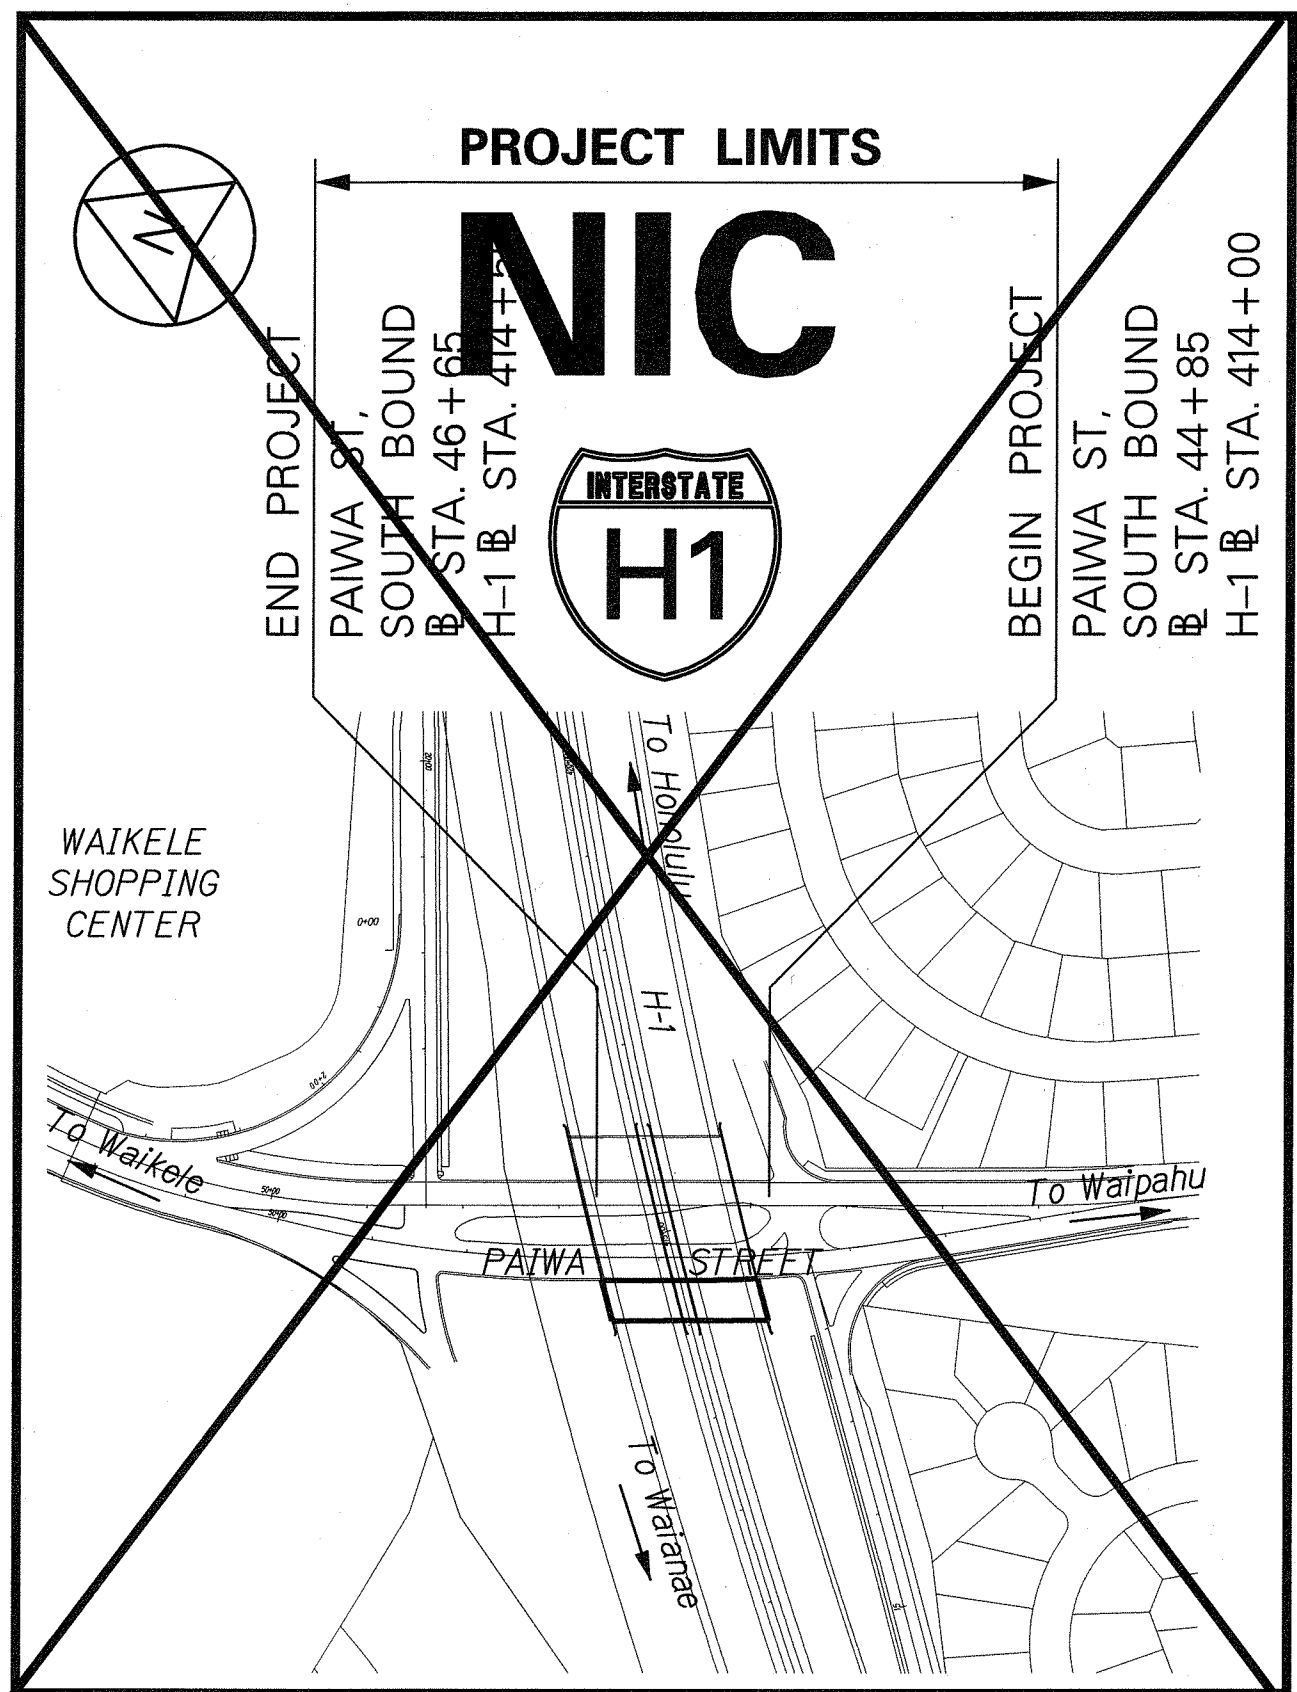
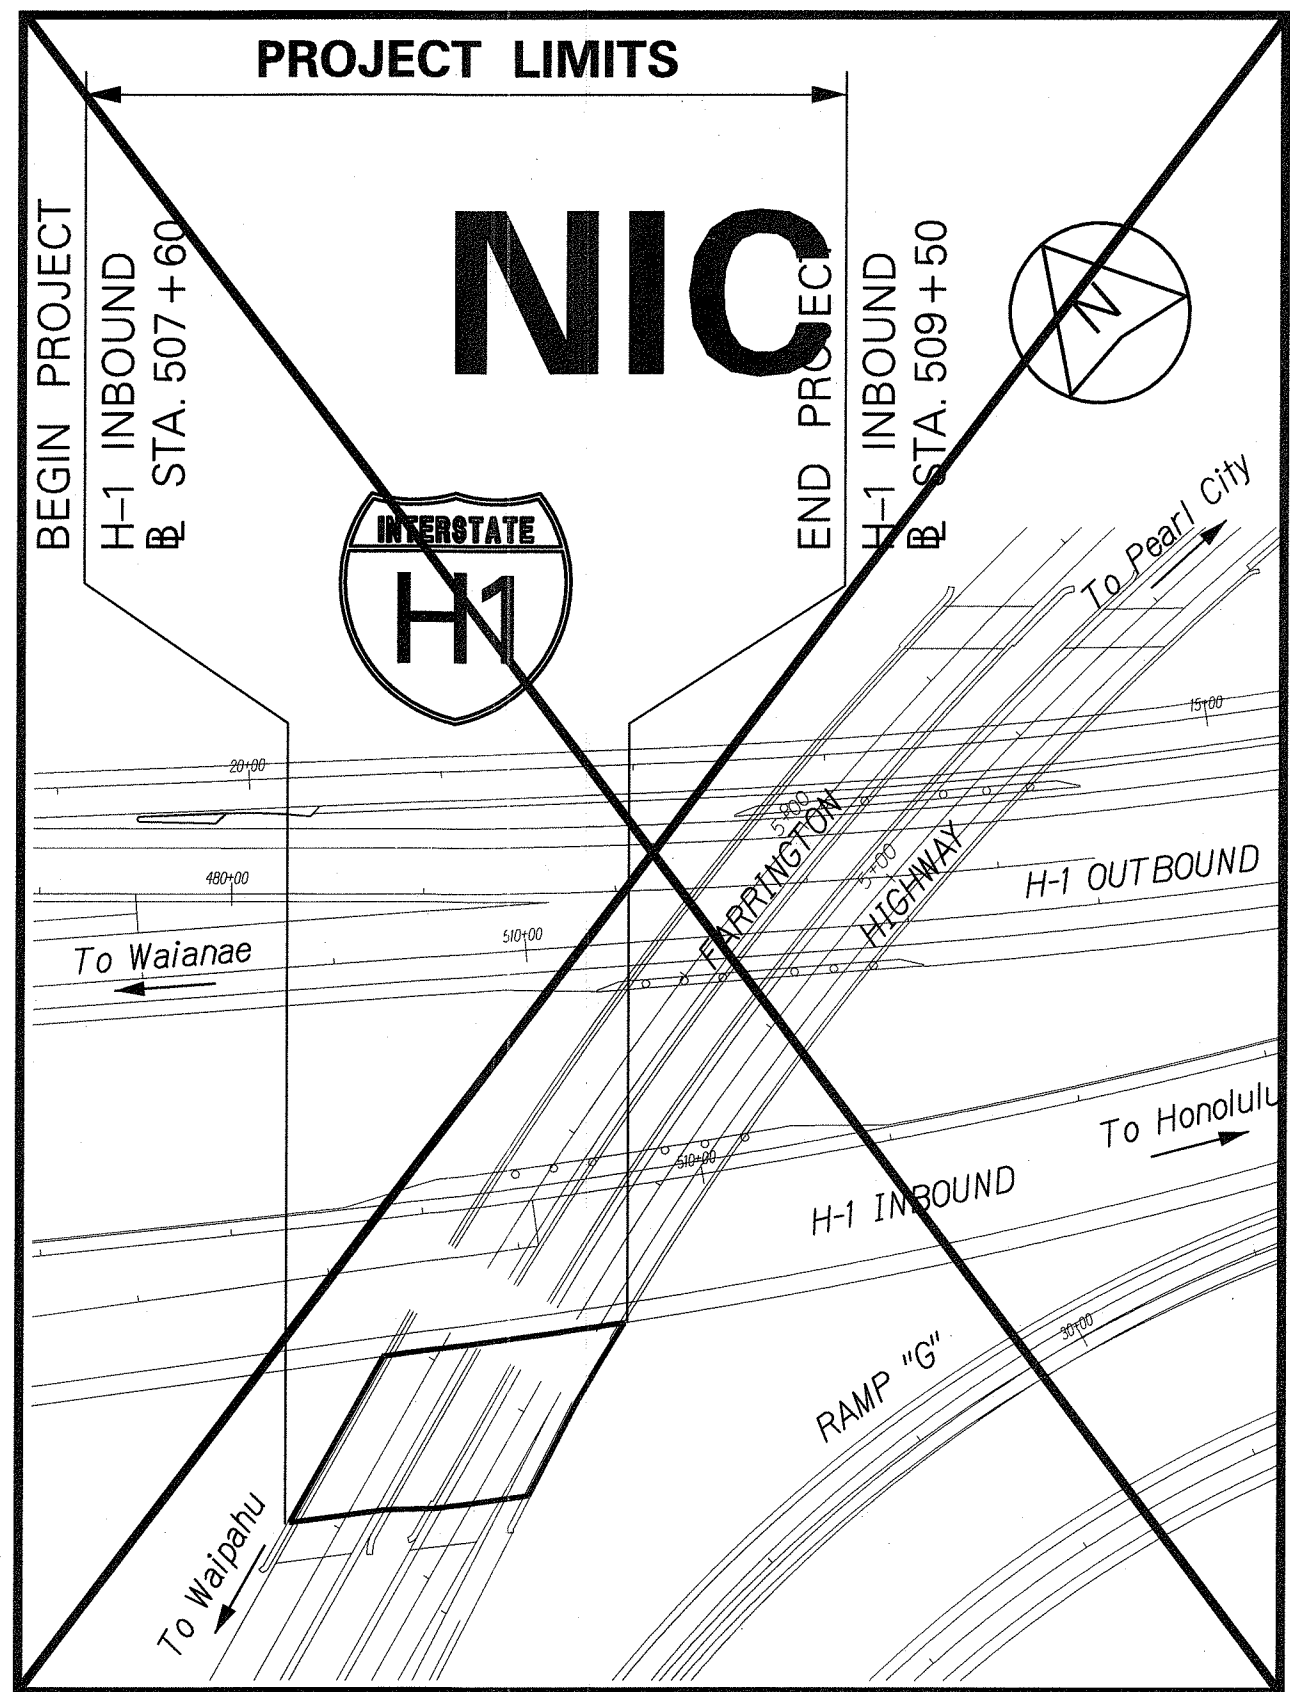
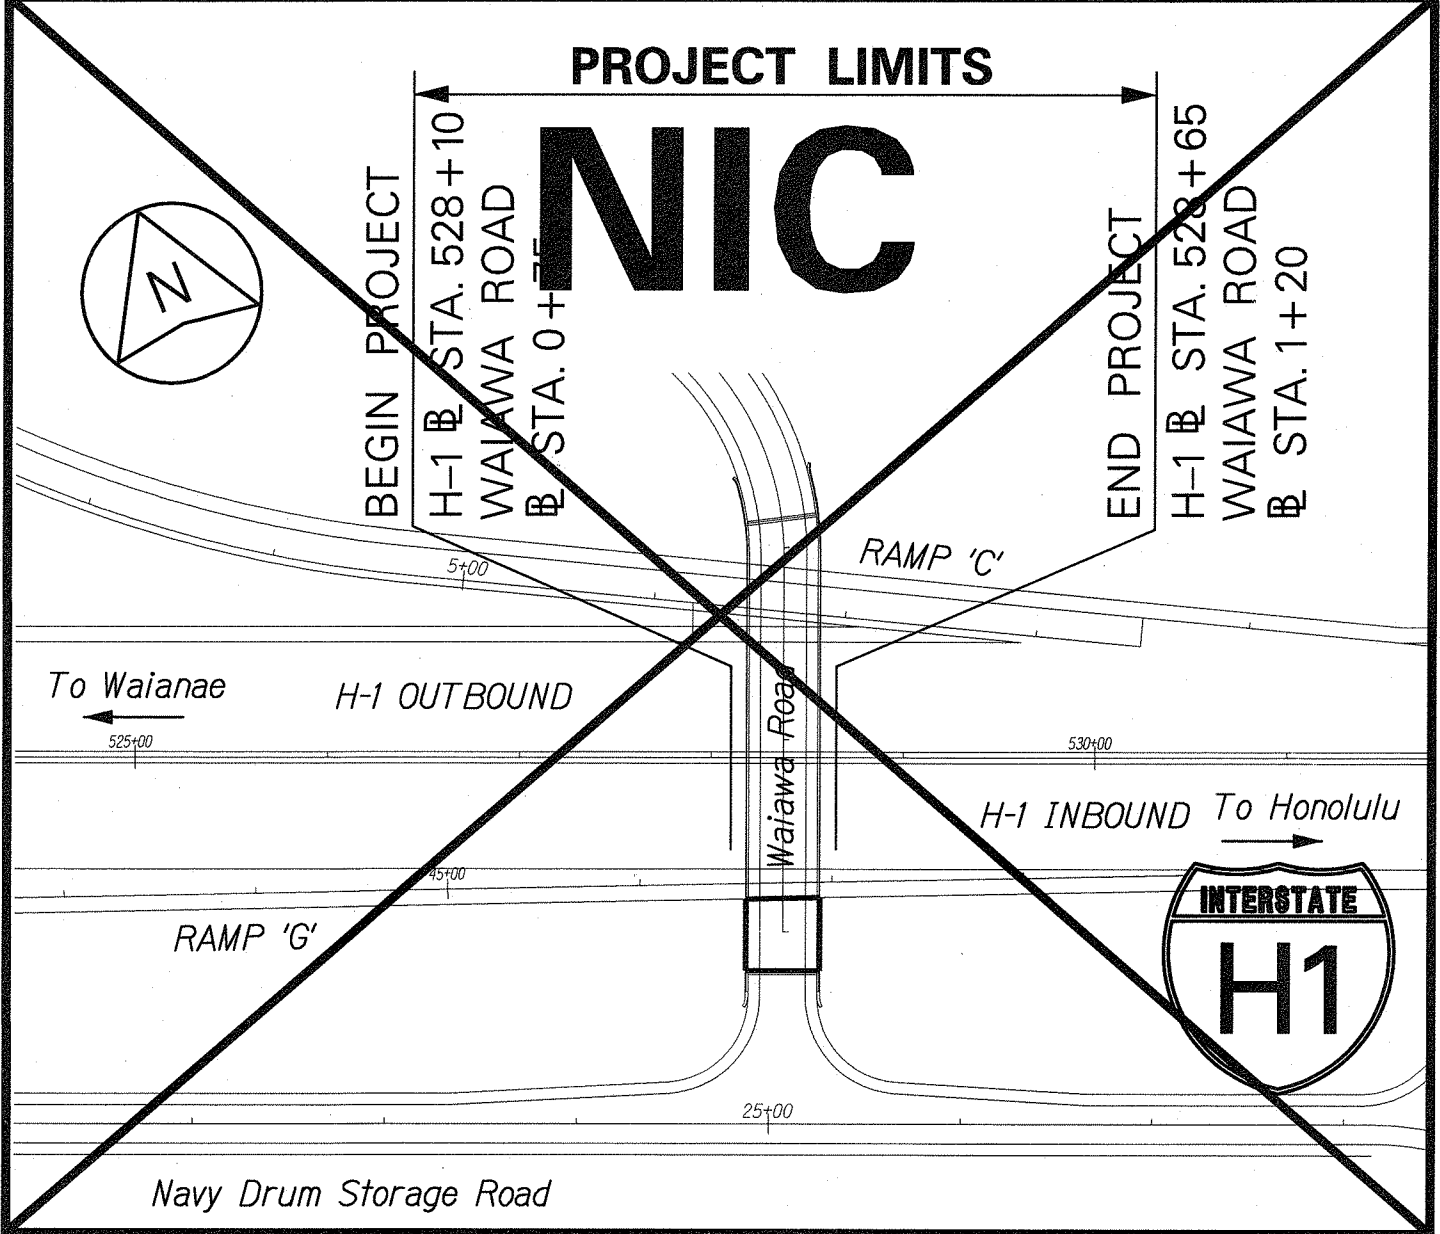
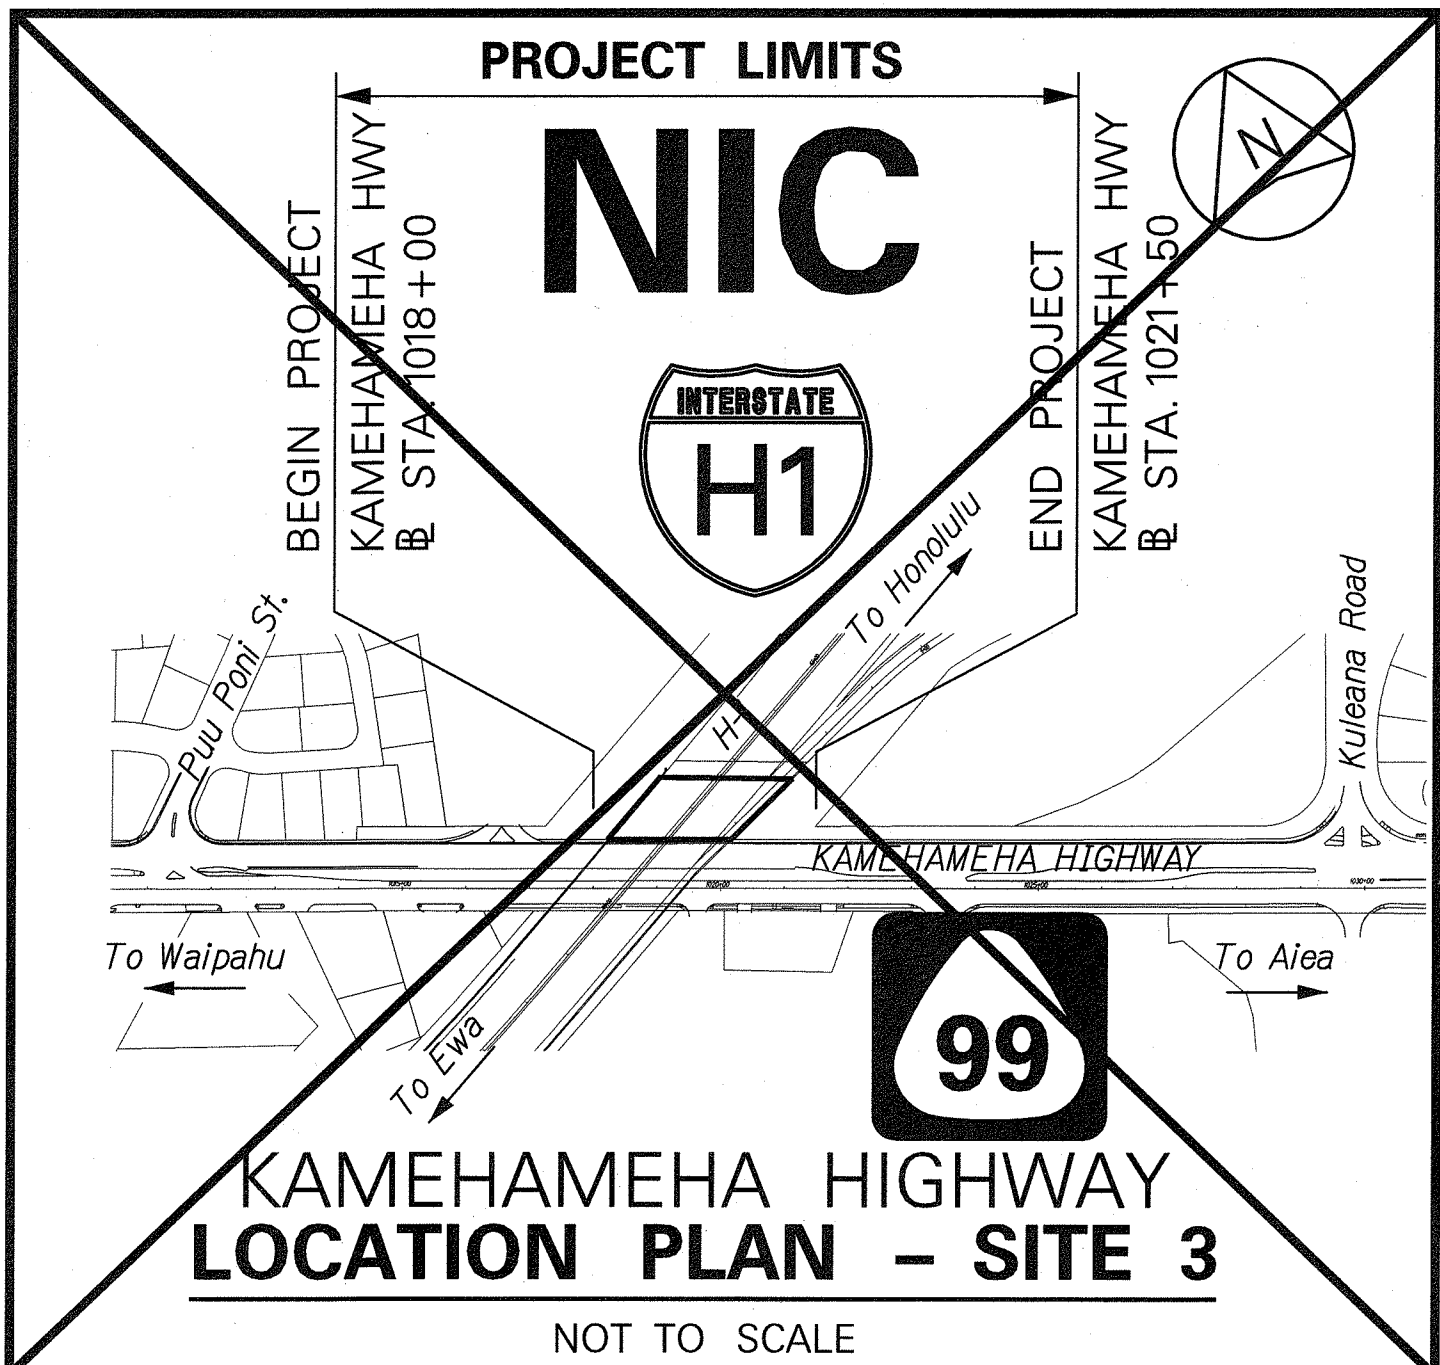


FED. ROAD DIST. NO.	STATE	PROJ. NO.	FISCAL YEAR	SHEET NO.	TOTAL SHEETS
HAWAII	HAW.	HWY-0-04-09M	2009	C.O. 2	65

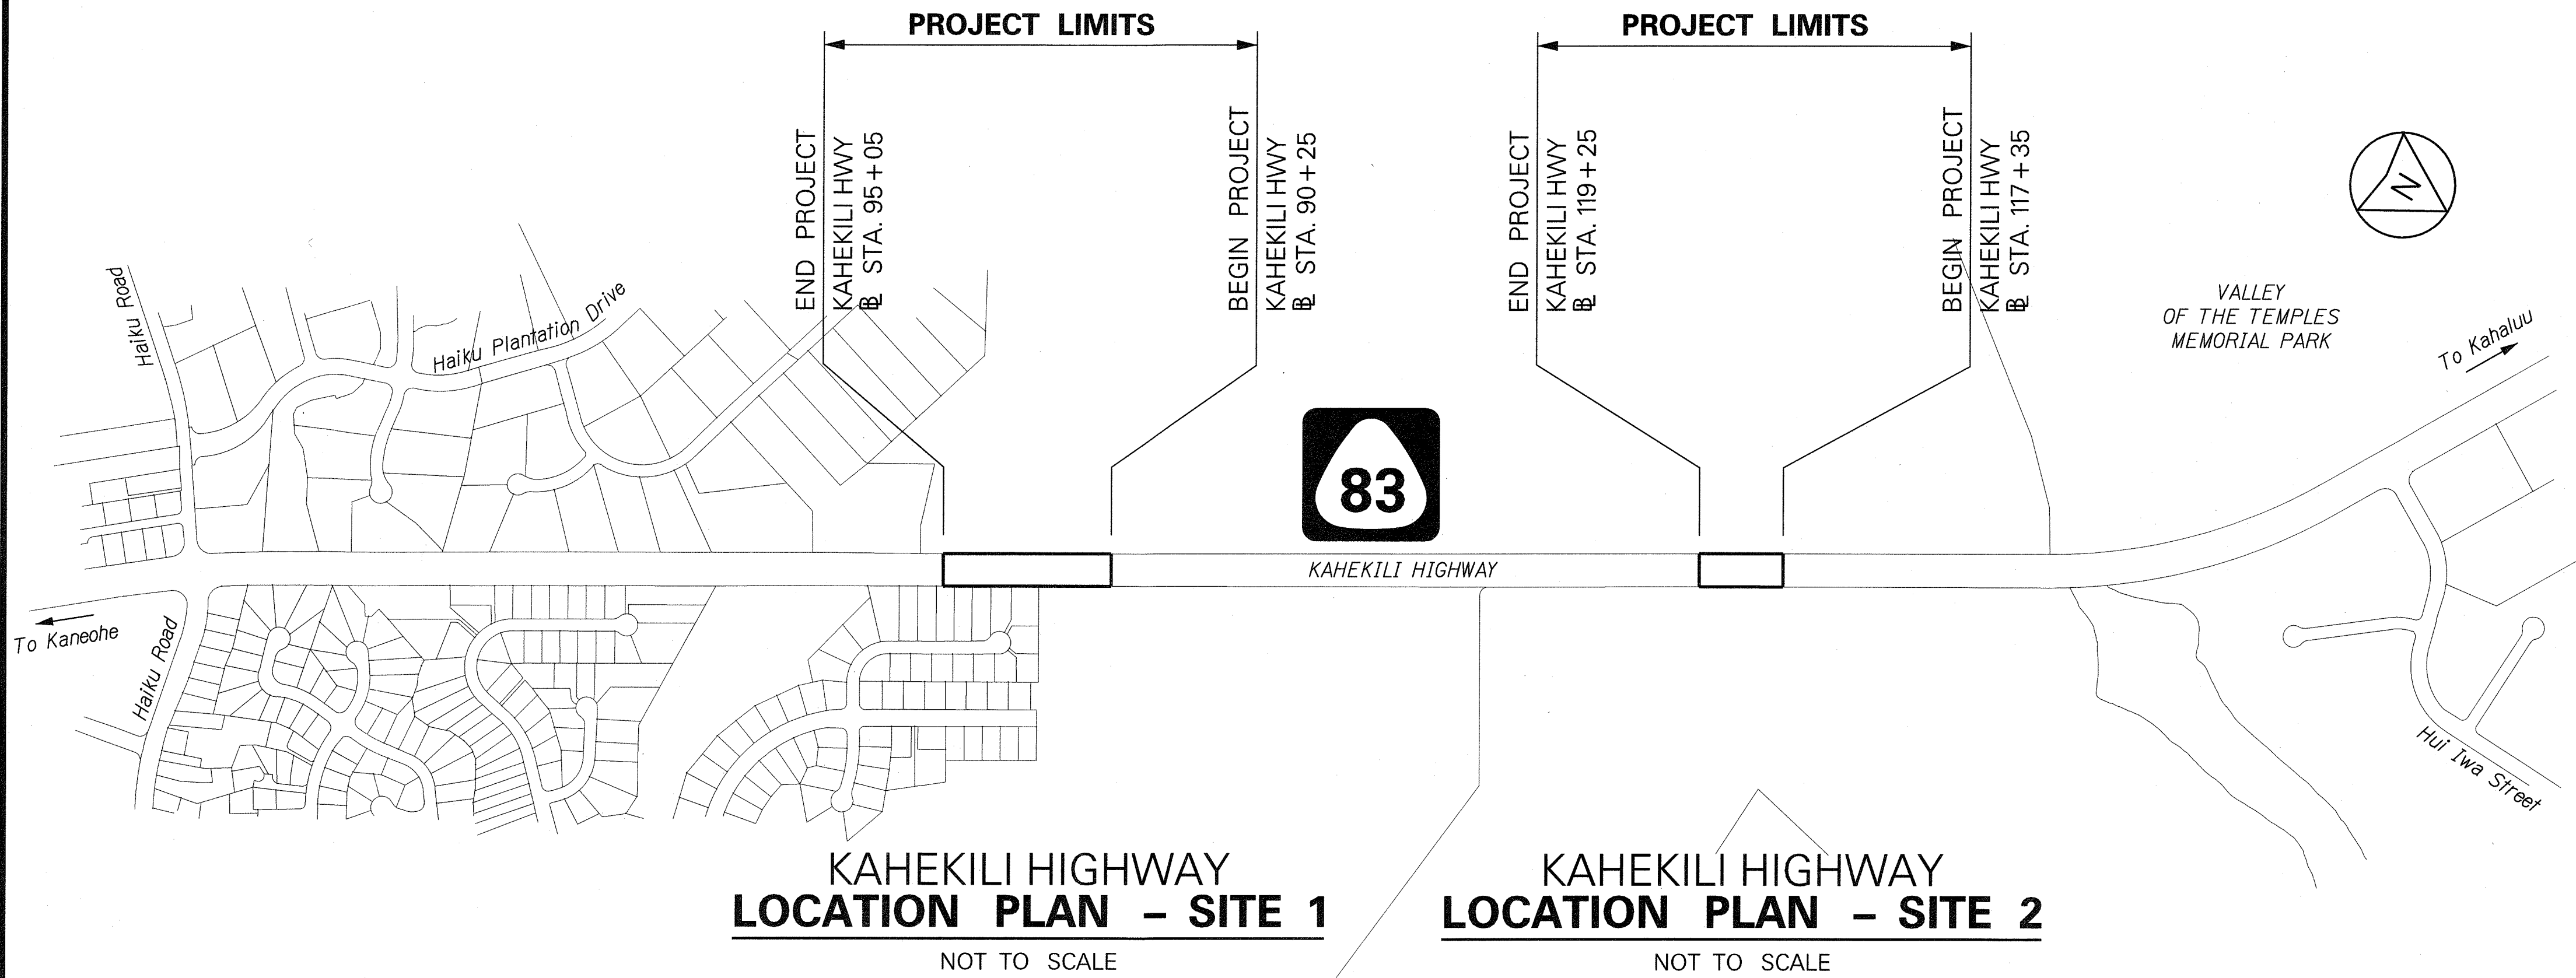

SURVEY PLOTTED BY	DATE
DESIGNED BY	
TRACED BY	
NOTE BOOK	
QUANTITIES BY	
CHECKED BY	

THIS WORK WAS PREPARED BY ME
OR UNDER MY SUPERVISION.

Jaime M. Saavedra
SIGNATURE

04/30/10
EXPIRATION DATE
OF THE LICENSE

STATE OF HAWAII
DEPARTMENT OF TRANSPORTATION
HIGHWAYS DIVISION

LOCATION PLAN

*SLOPE MAINTENANCE FOR EROSION CONTROL
AT VARIOUS SITES ON OAHU, PHASE 3*
Project No. HWY-0-04-09M

Scale: None Date: April 2009