


FED. ROAD DIST. NO.	STATE	PROJ. NO.	FISCAL YEAR	SHEET NO.	TOTAL SHEETS
HAWAII	HAW.	HWY-O-01-15	2016	18	52

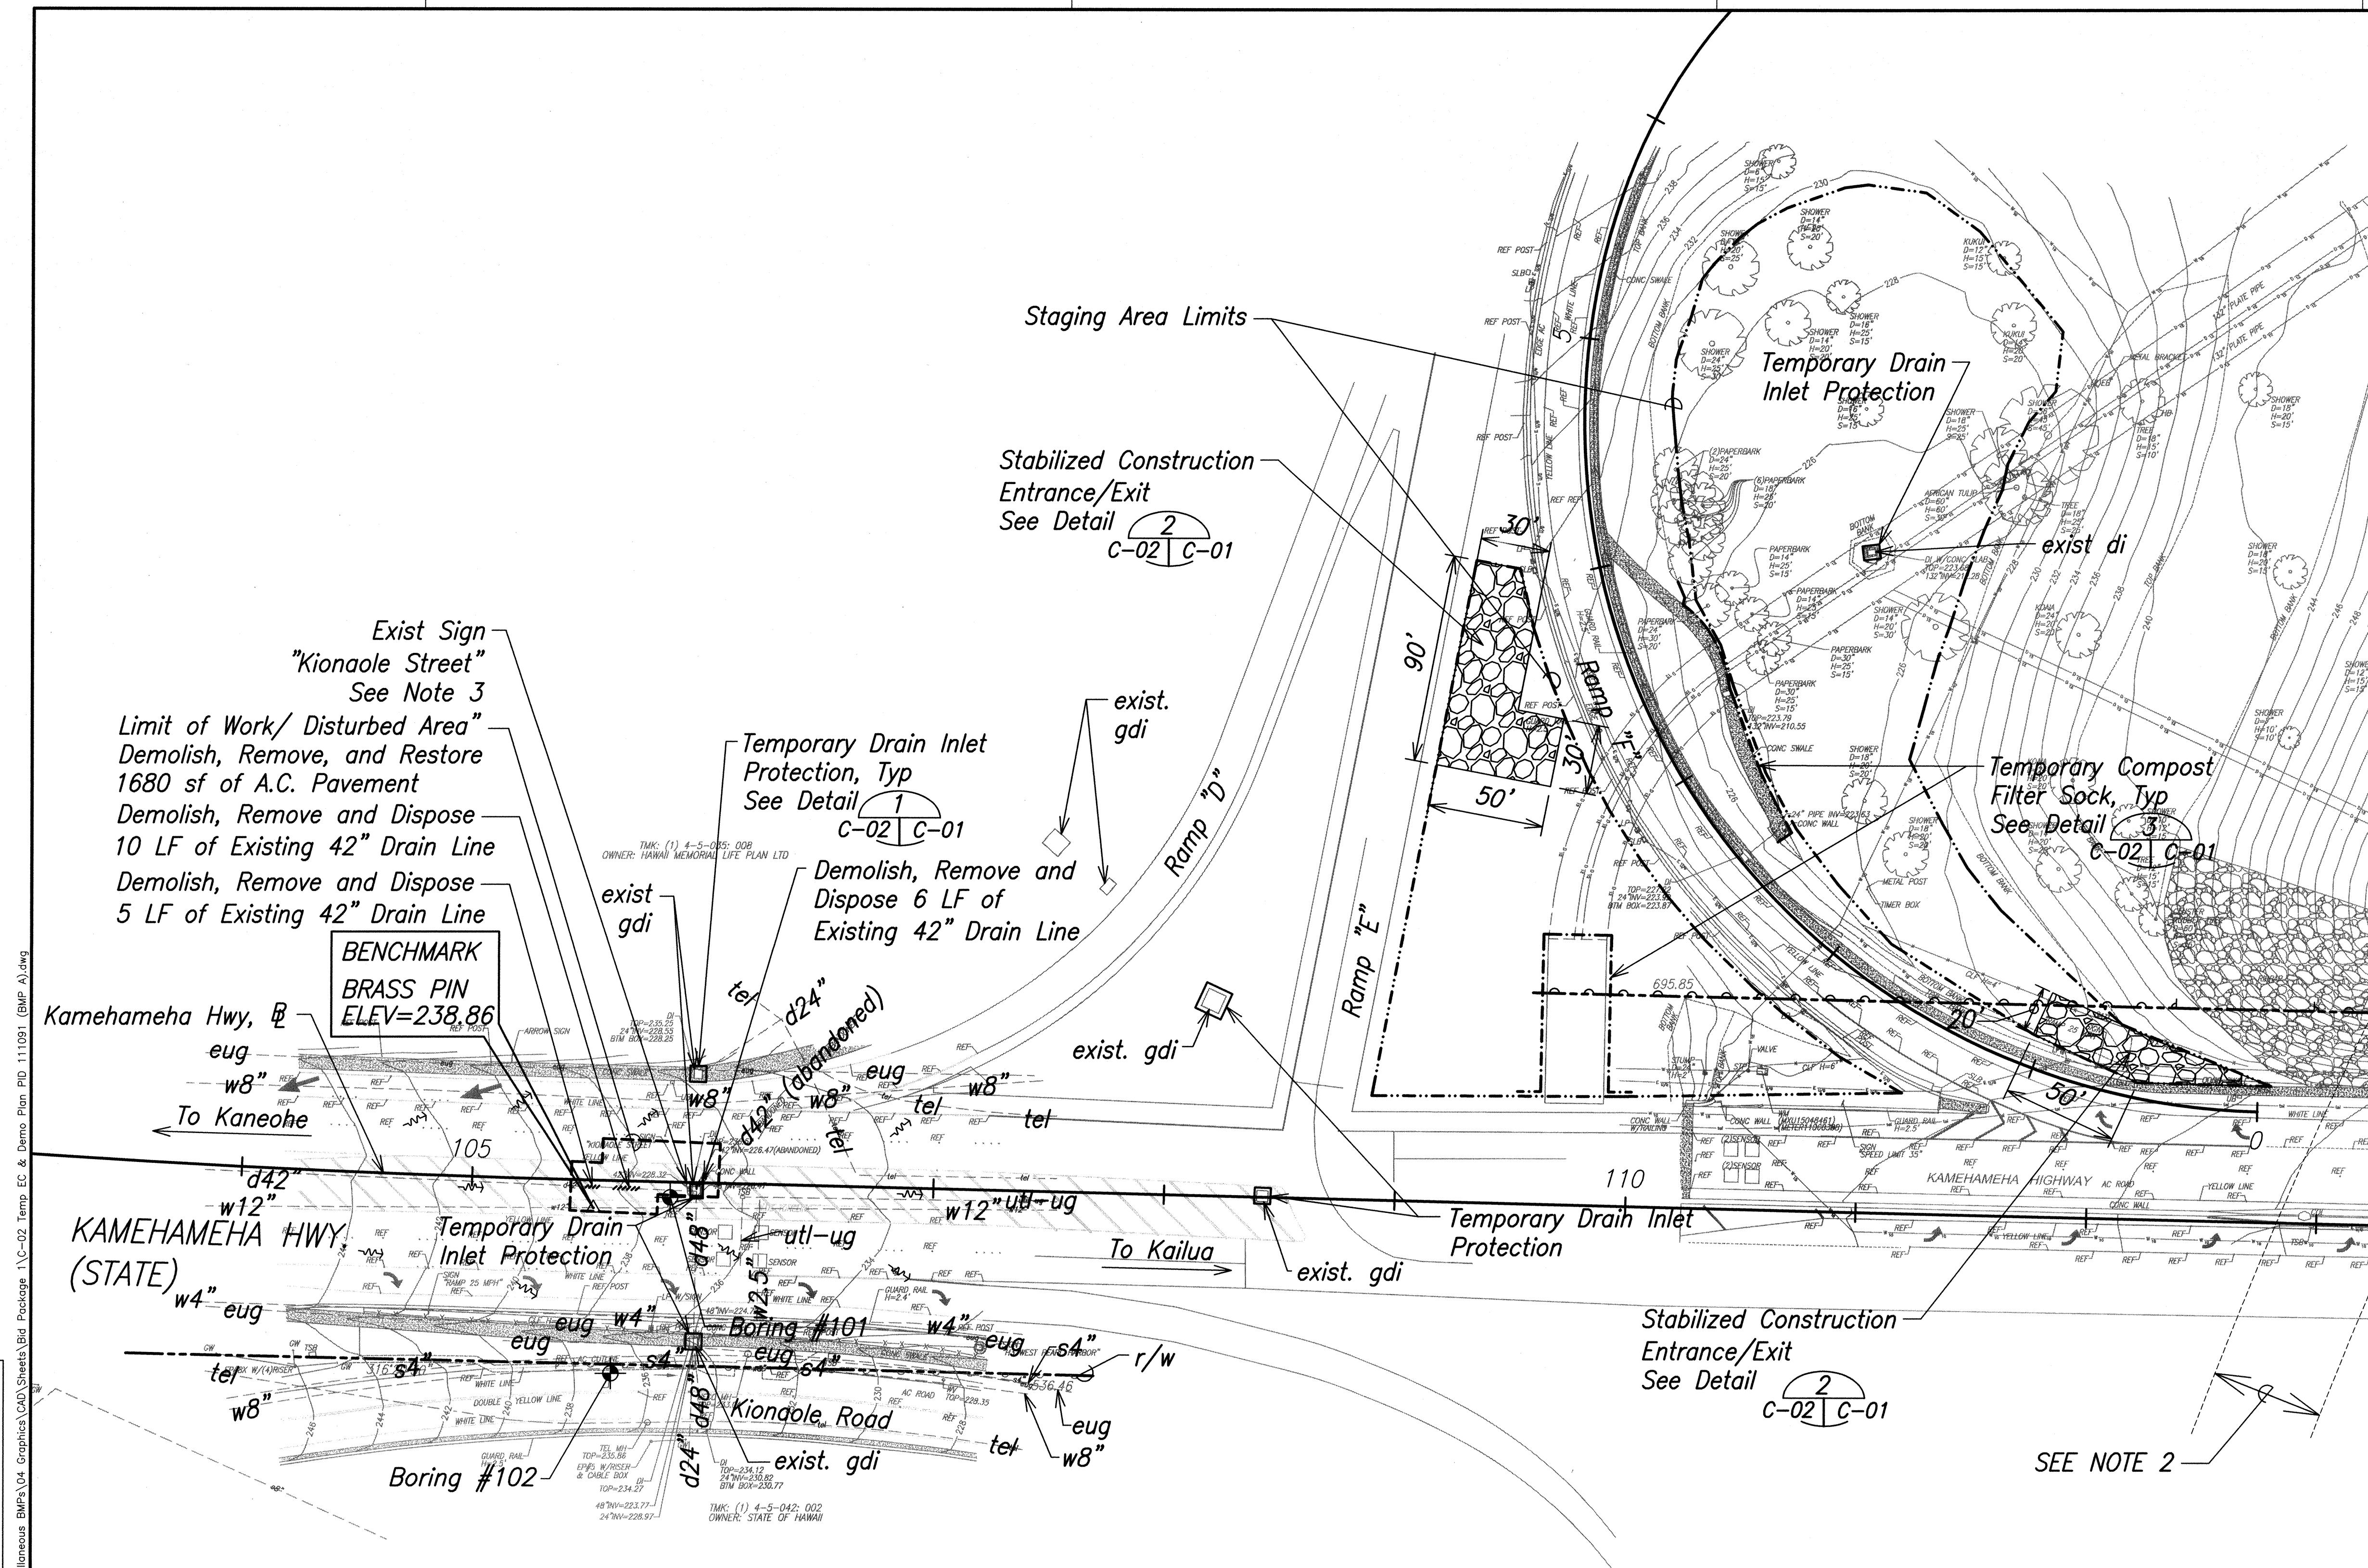

- Notes:**
1. For Erosion Control Notes and Details, see Sheets N-08 thru N-11 and C-01.
 2. Approximate limits of H-3 deck above.
 3. Remove sign during construction. Replace upon completion of work or as ordered by the Engineer.


Legend:

----- Demolish, remove, and dispose of existing drain line

Baseline Note:
Kamehameha Hwy. To Kaneohe information from "Construction Plans for a Portion of Interstate Route H-3 Halekou Interchange", Project No. I-IR-H3-1(24)11.

DATE	_____
SURVEY PLOTTED BY	_____
DESIGNED BY	_____
CHECKED BY	_____
NOTE BOOK	_____
No.	_____

TEMPORARY EROSION CONTROL AND DEMOLITION PLAN
PID 111091 (PBMP A)
Scale: 1"=40'-0"

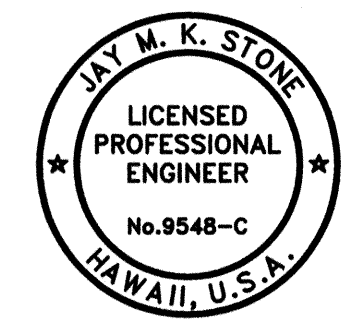 4/30/18 EXP DATE THIS WORK WAS PREPARED BY ME OR UNDER MY SUPERVISION	STATE OF HAWAII DEPARTMENT OF TRANSPORTATION HIGHWAYS DIVISION TEMPORARY EROSION CONTROL DEMOLITION PLAN PID 111091 (PBMP A) MISCELLANEOUS PERMANENT BEST MANAGEMENT PRACTICES, PHASE 2A Project No. HWY-O-01-15 Scale: 1"=40' Date: April 2016 SHEET No. C-02 OF 22 SHEETS
---	--