
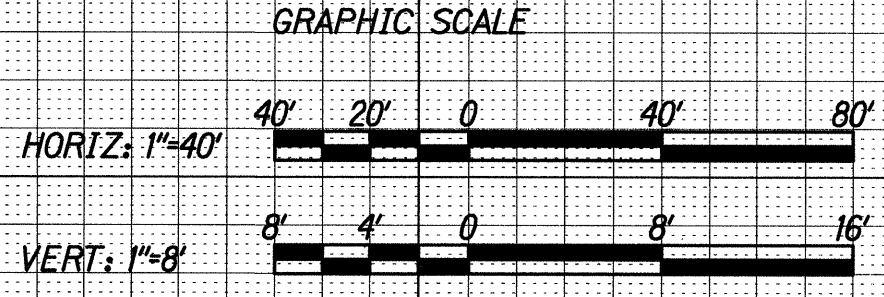
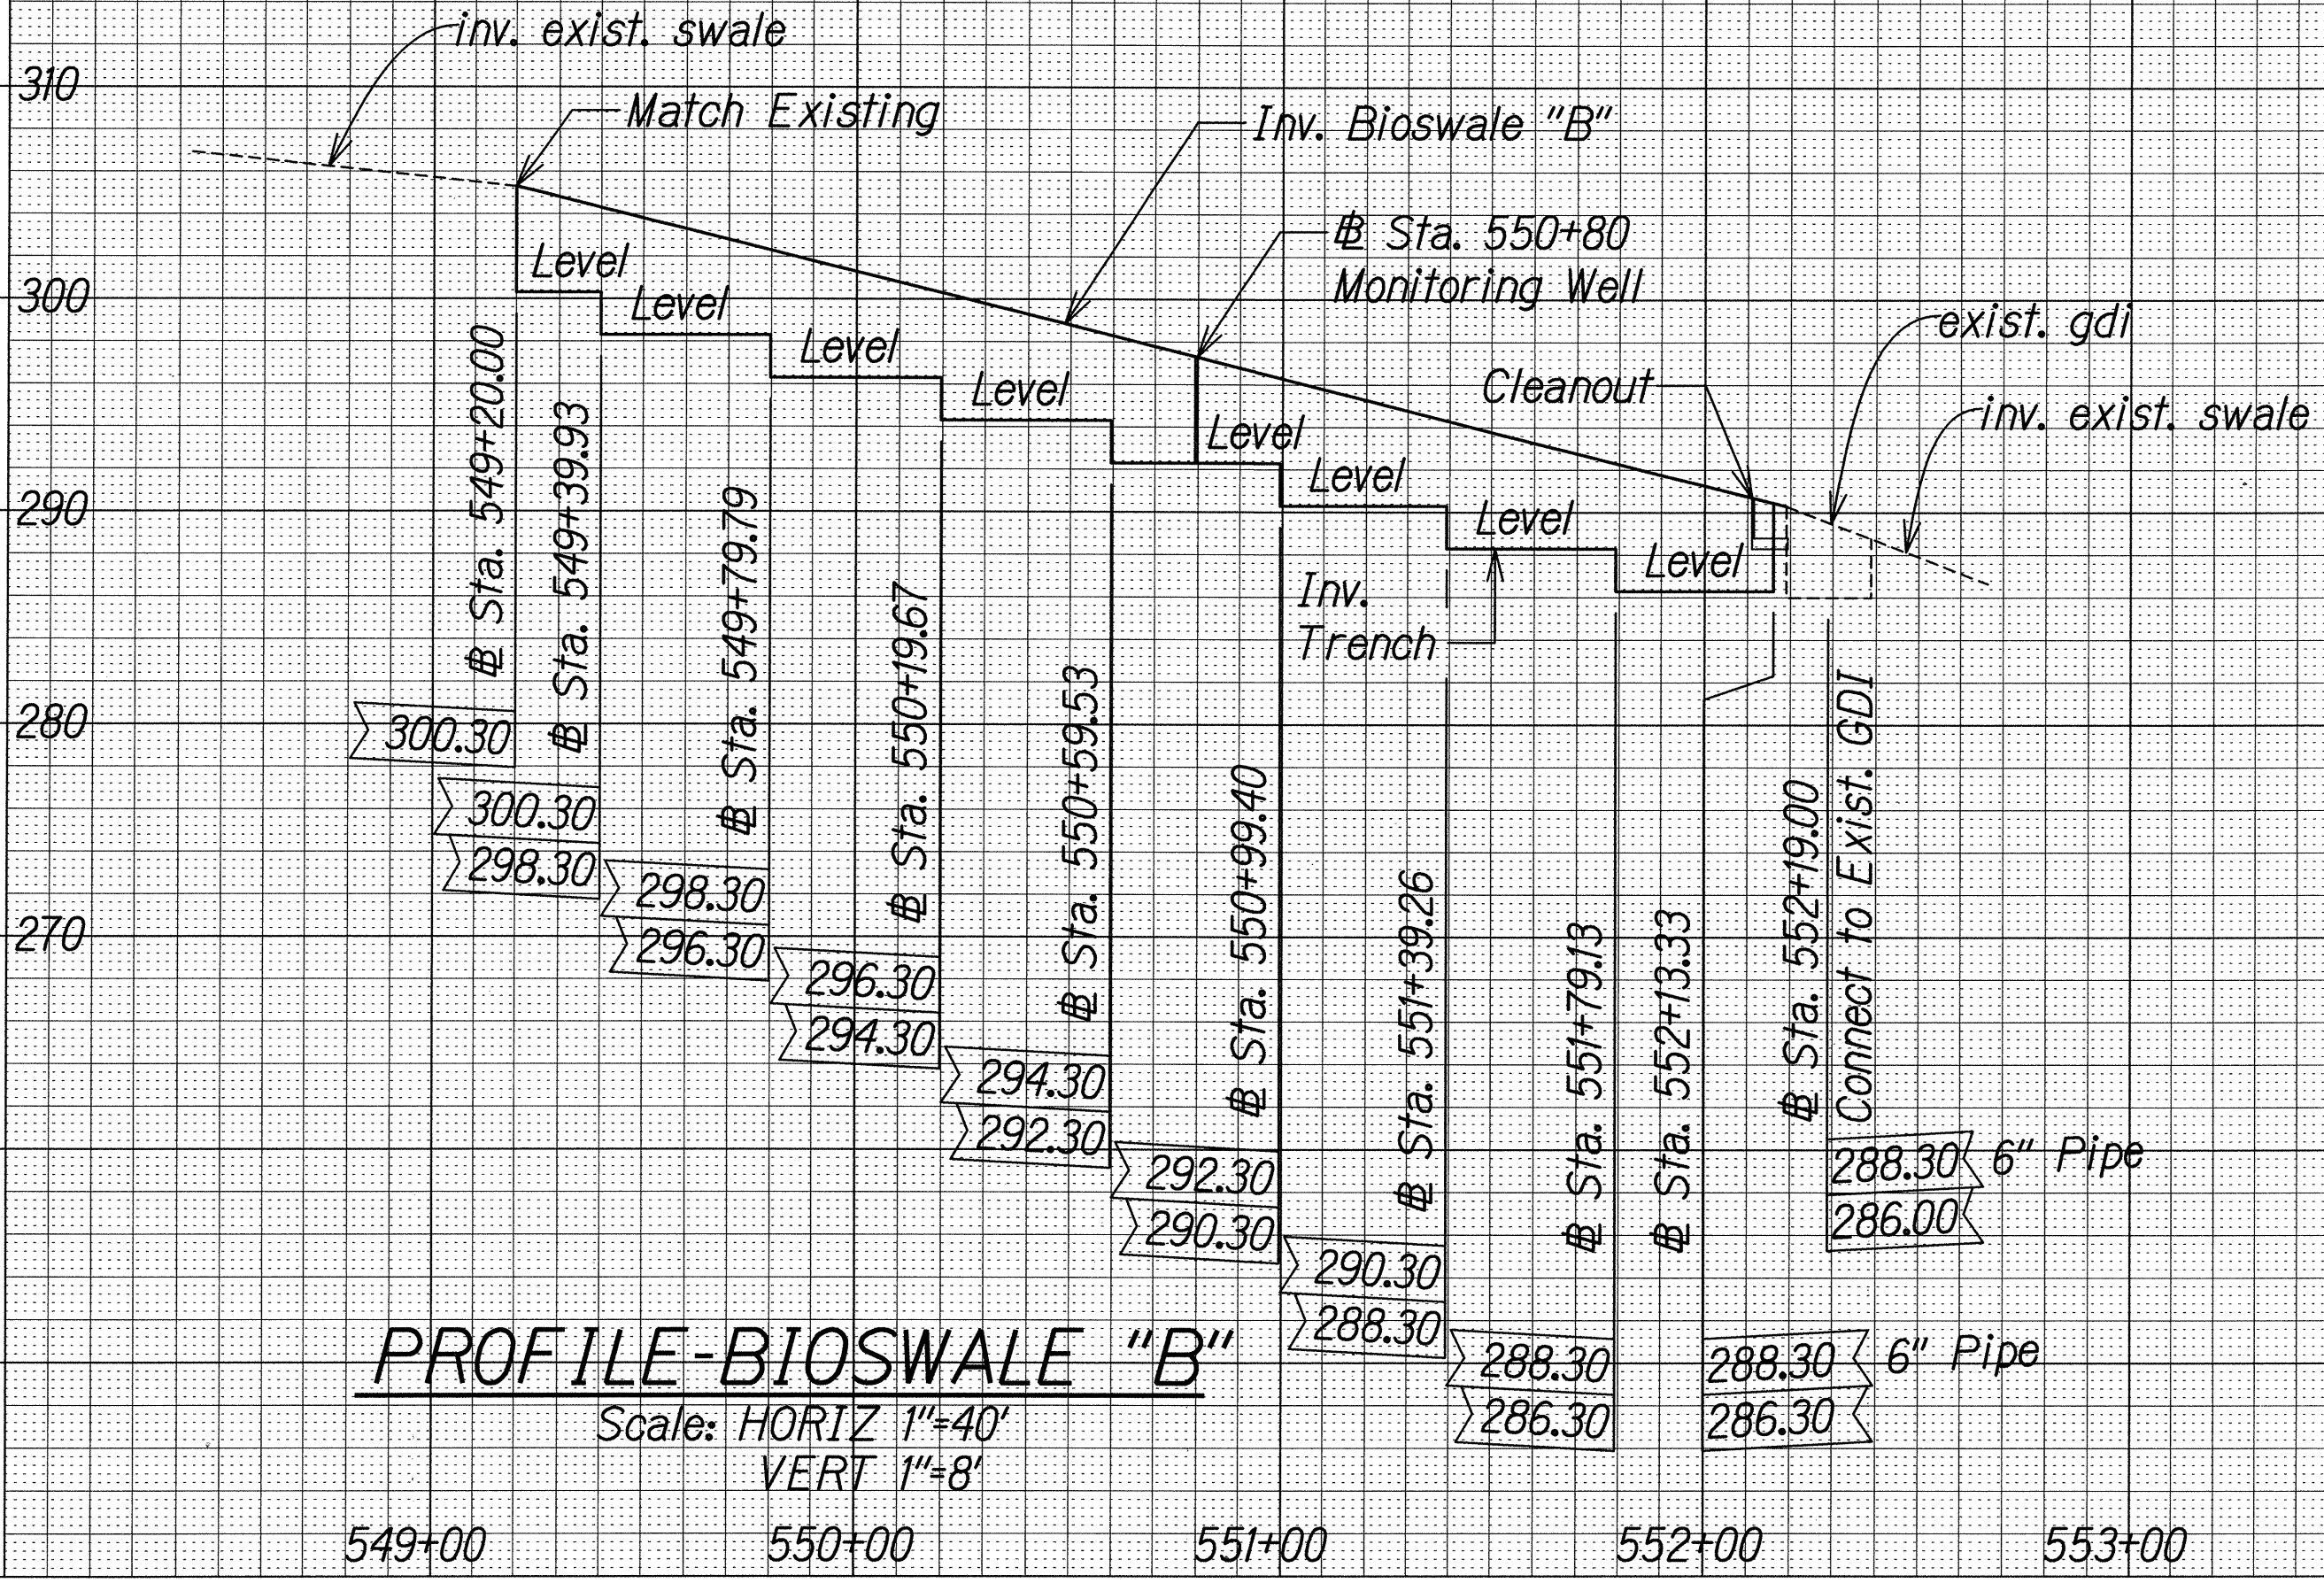


FED. ROAD DIST. NO.	STATE	PROJ. NO.	FISCAL YEAR	SHEET NO.	TOTAL SHEETS
HAWAII	HAW.	HWY-0-02-11R	2014	22	43

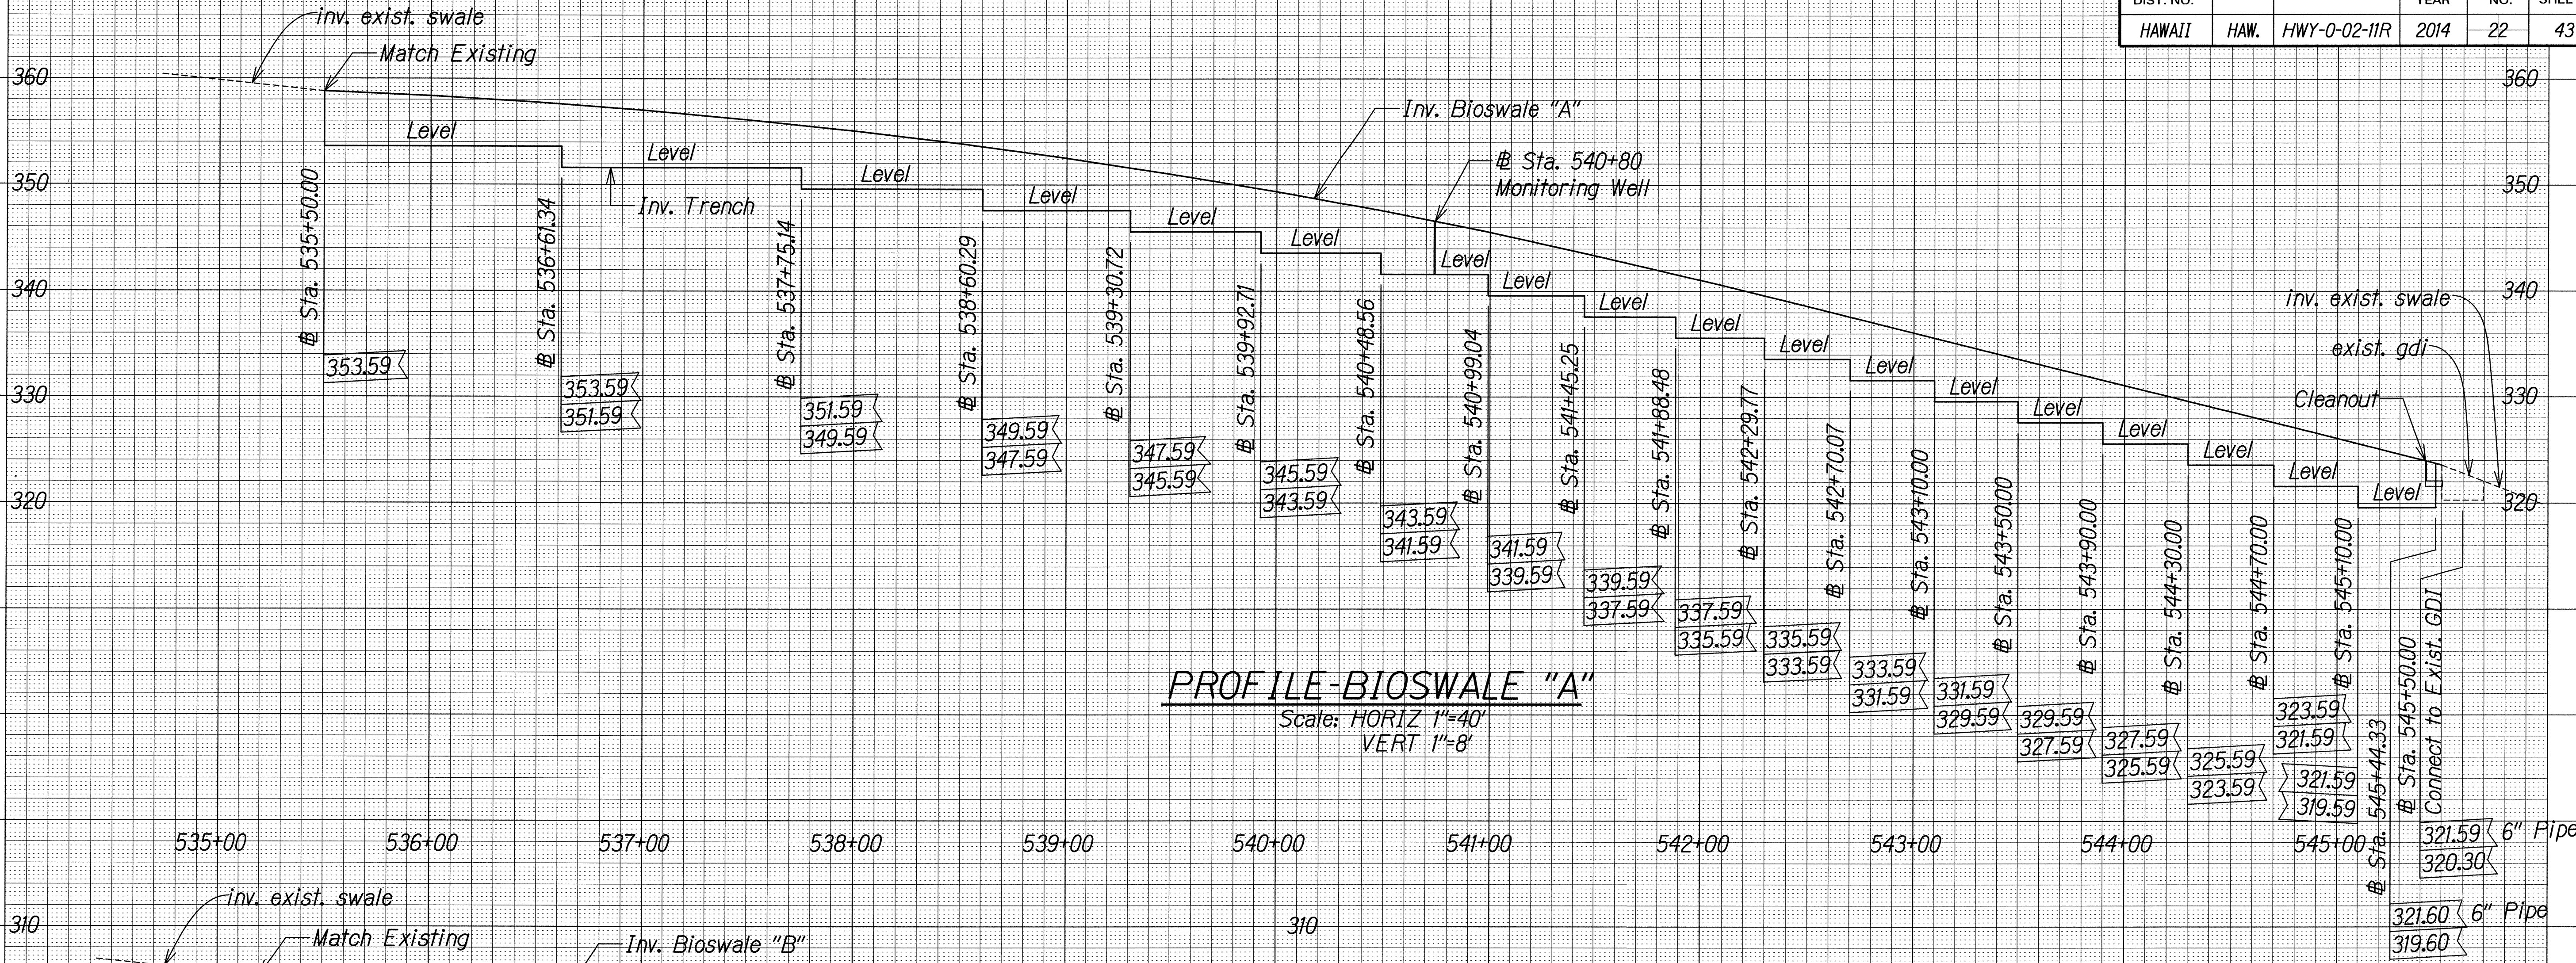


GERALD D. ANDRADE
LICENSED PROFESSIONAL ENGINEER
No. 10377-C
HAWAII, U.S.A.

THIS WORK WAS PREPARED BY ME OR UNDER MY SUPERVISION.
SIGNATURE: *Gerald D. Andrade* EXPIRATION DATE: 04/30/14 OF THE LICENSE


ORIGINAL PLAN	DATE
DRAWN BY	
TRACED BY	
DESIGNED BY	
QUANTITIES BY	
CHECKED BY	

FED. ROAD DIST. NO.	STATE	PROJ. NO.	FISCAL YEAR	SHEET NO.	TOTAL SHEETS
HAWAII	HAW.	HWY-0-02-11R	2014	24	43

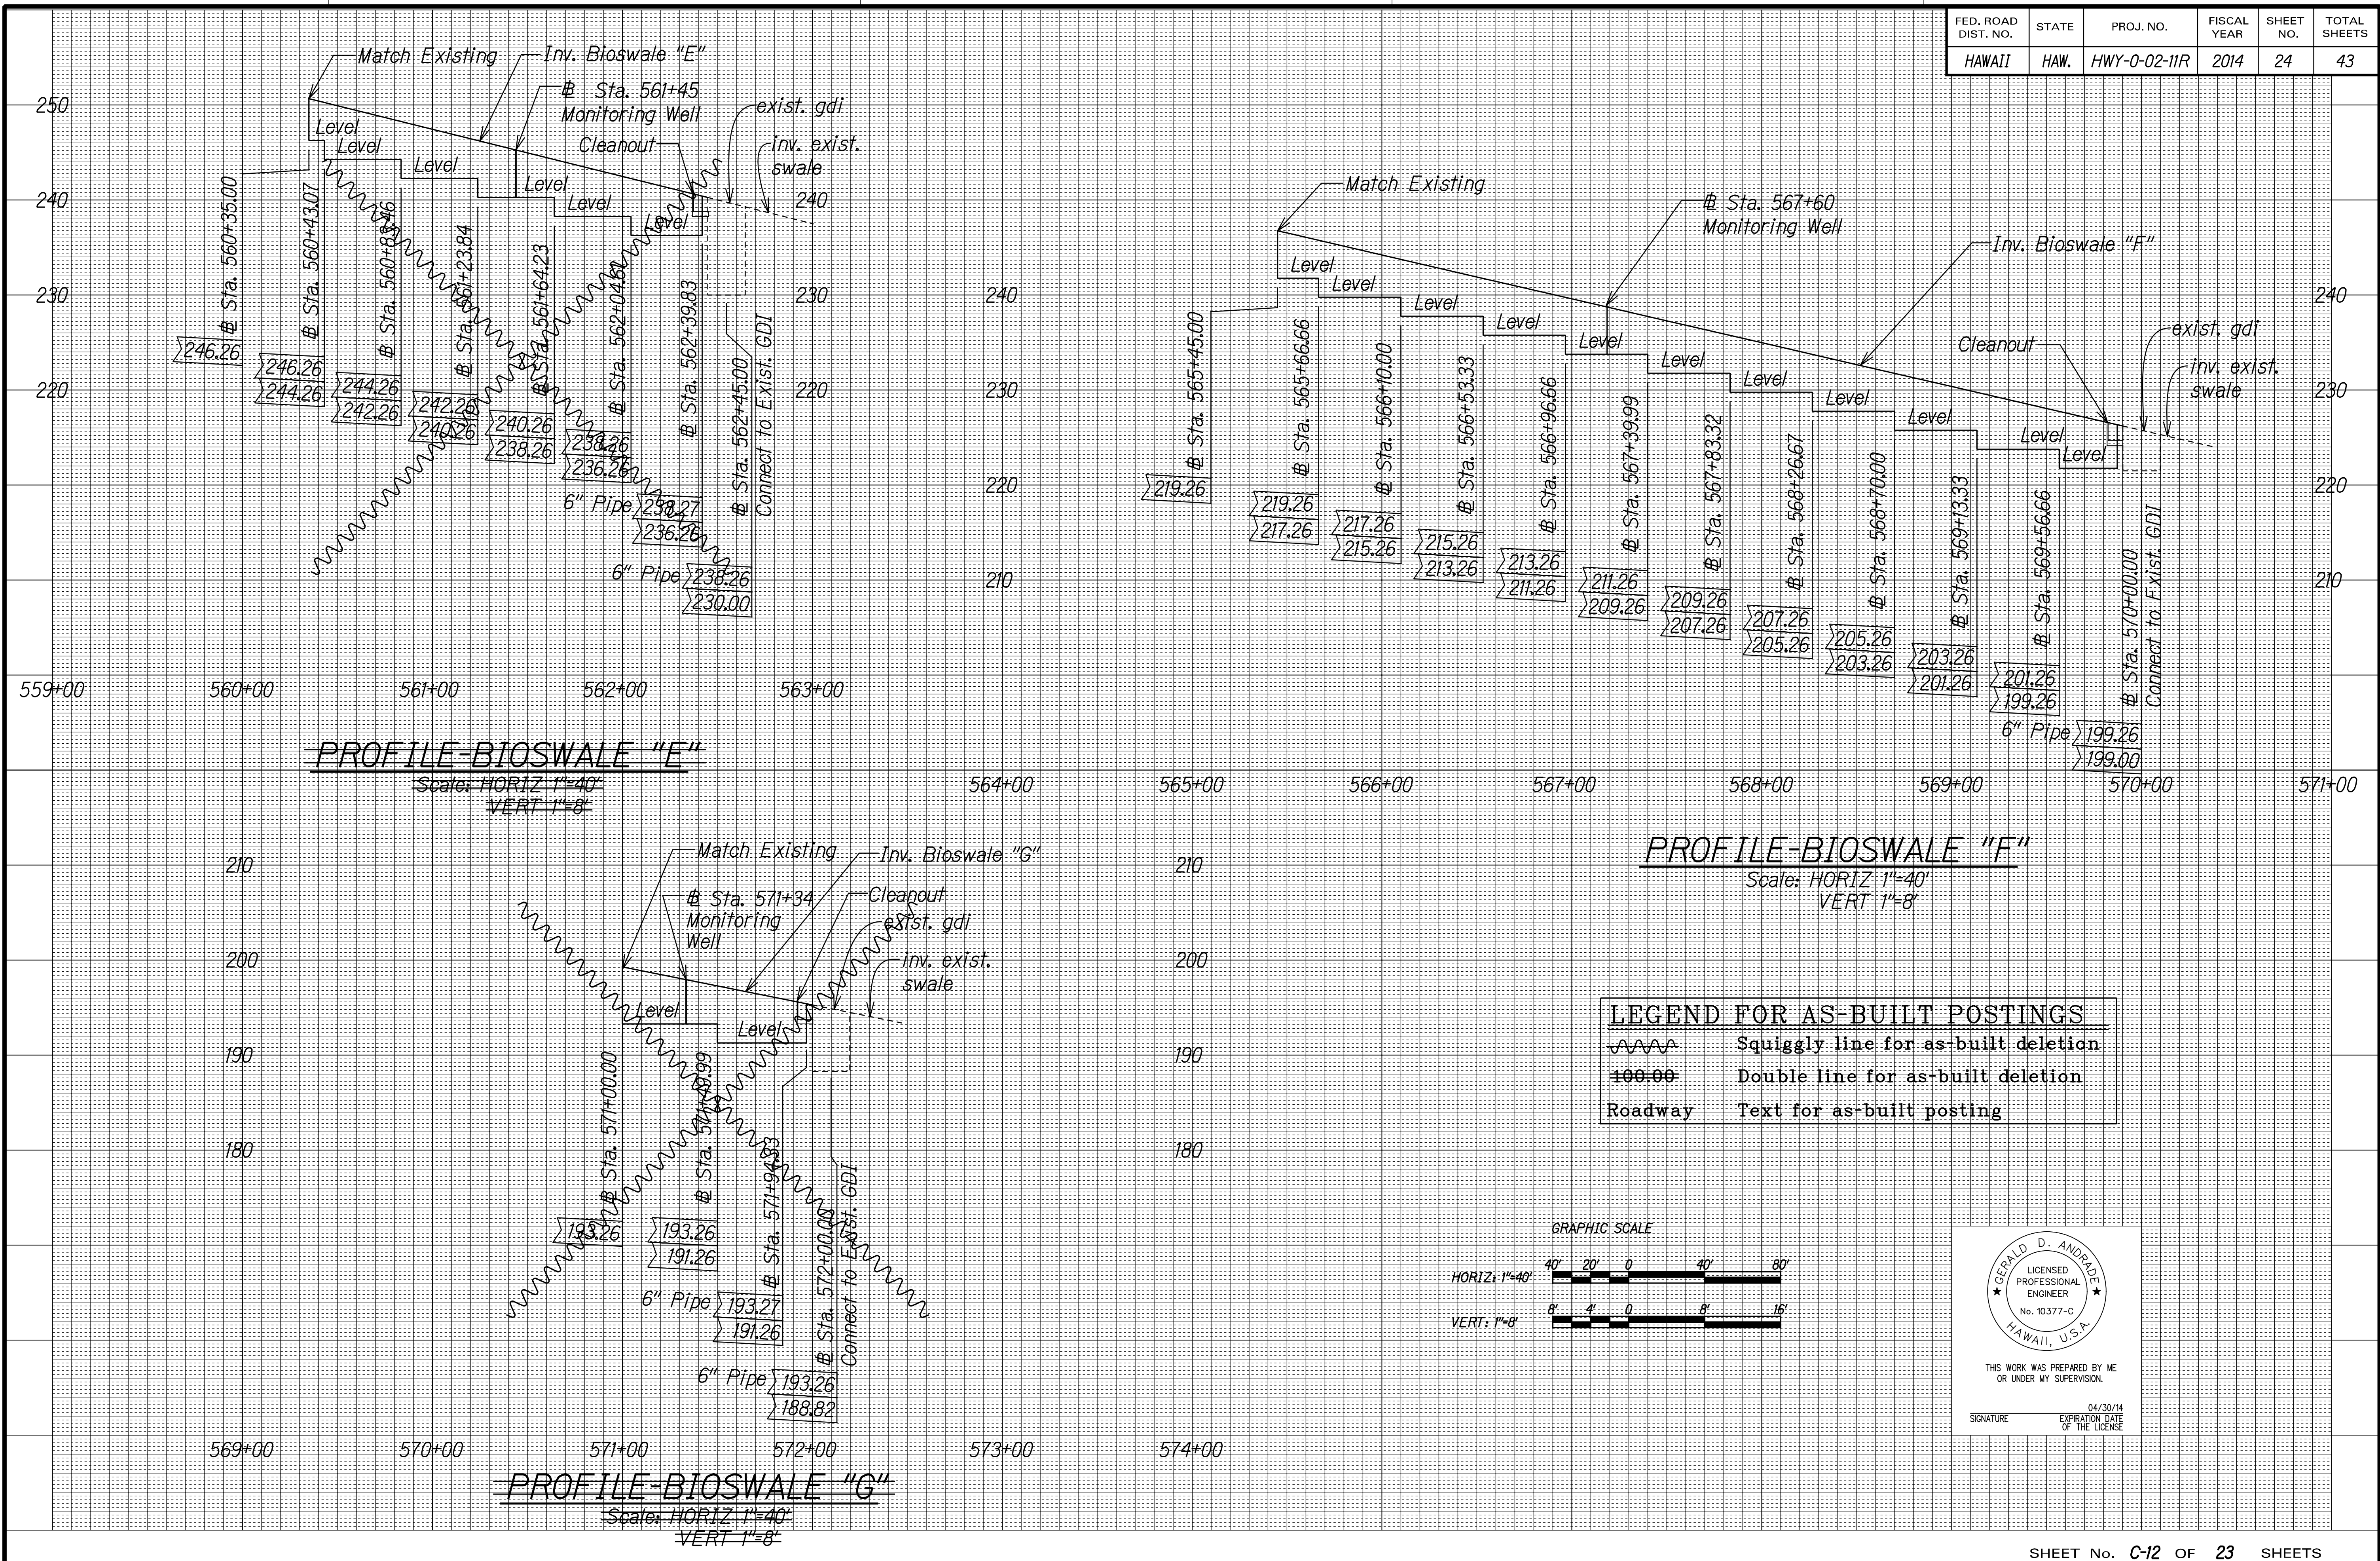


"AS-BUILT"


FED. ROAD DIST. NO.	STATE	PROJ. NO.	FISCAL YEAR	SHEET NO.	TOTAL SHEETS
HAWAII	HAW.	HWY-0-02-11R	2014	25	43

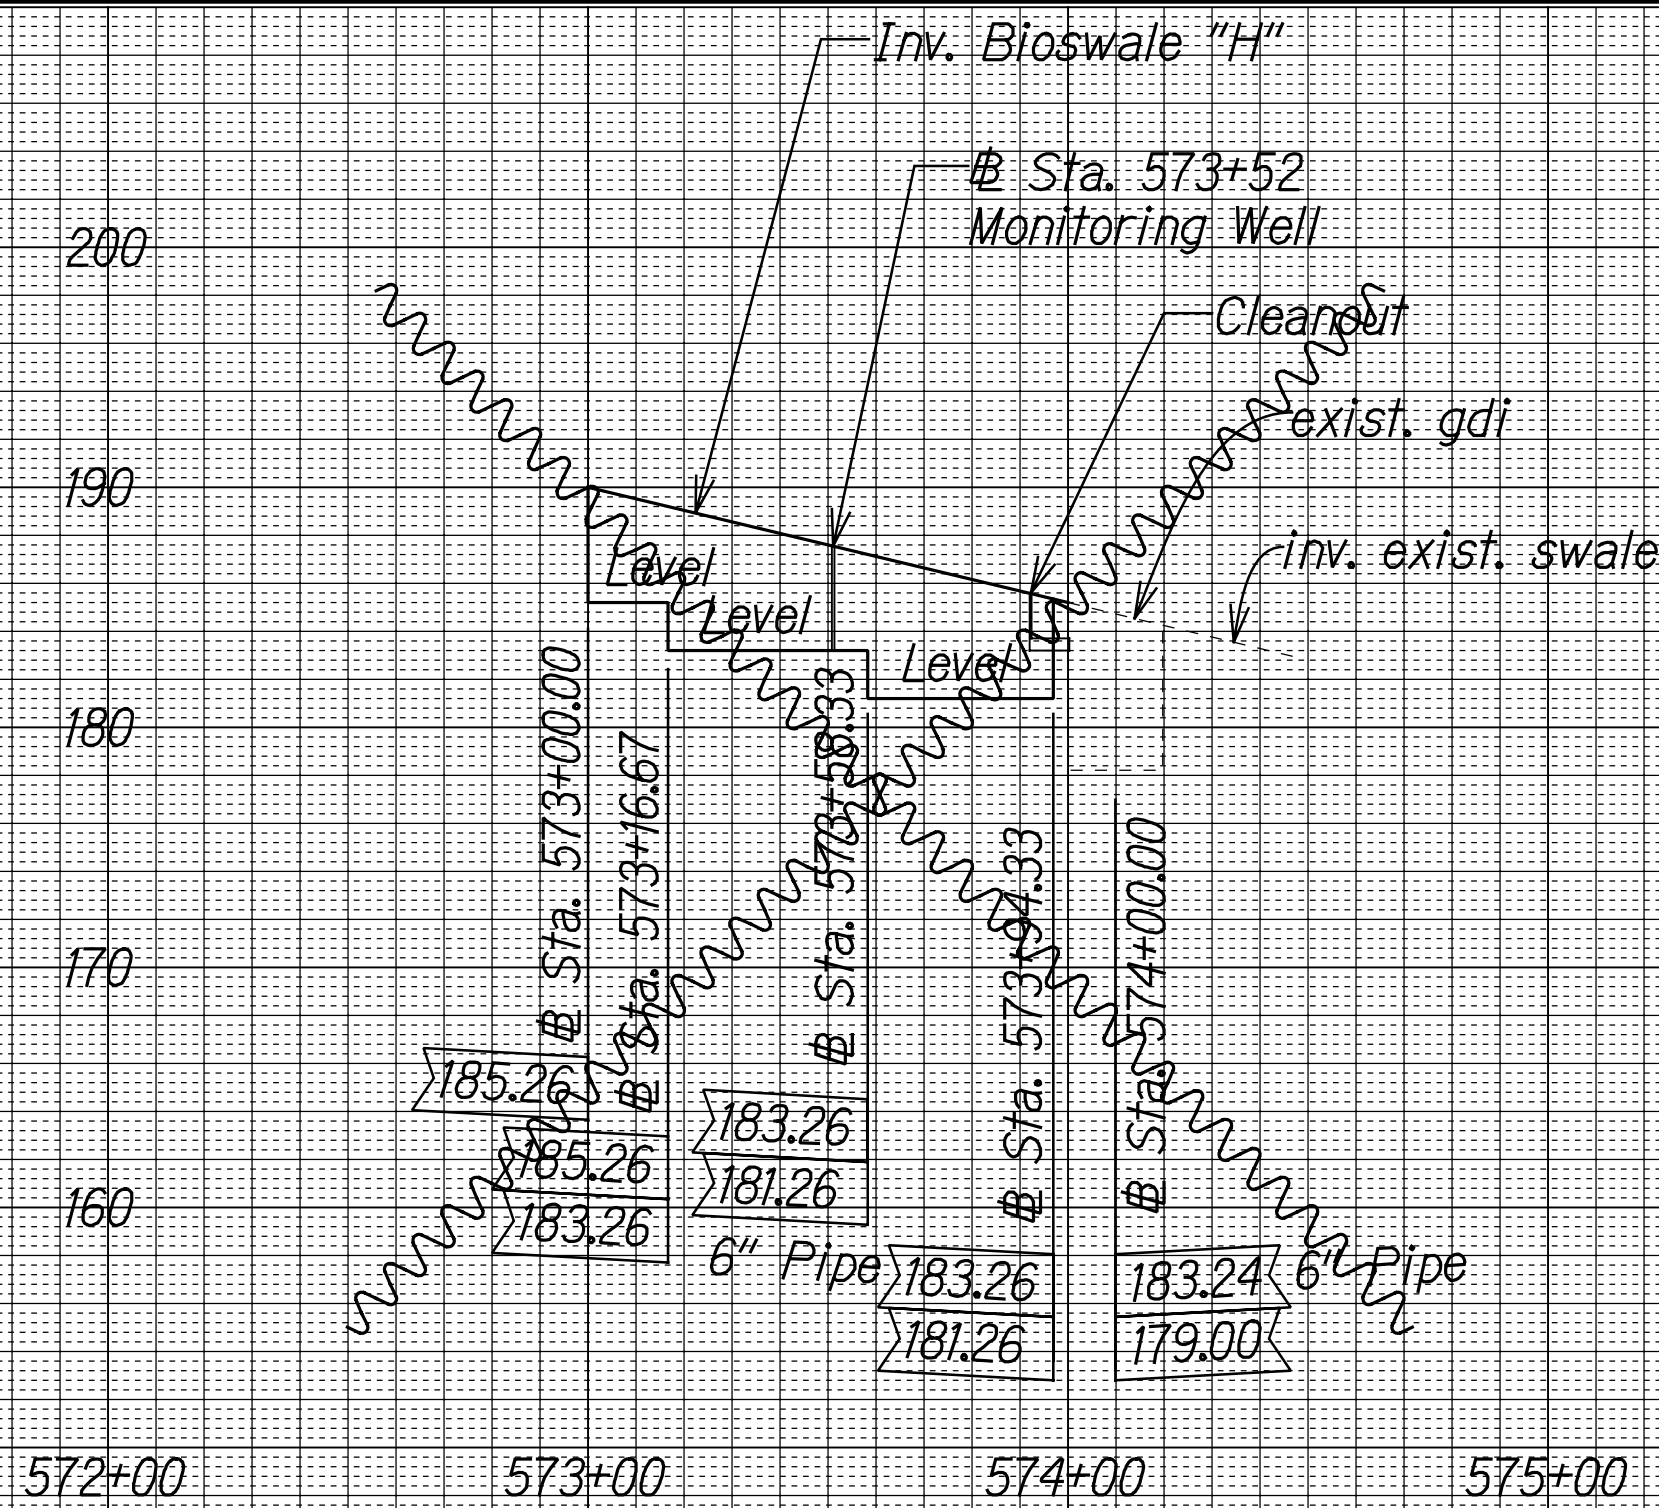

PROFILE-BIOSWALE "H"
Scale: HORIZ 1"=40'
VERT 1"=8'


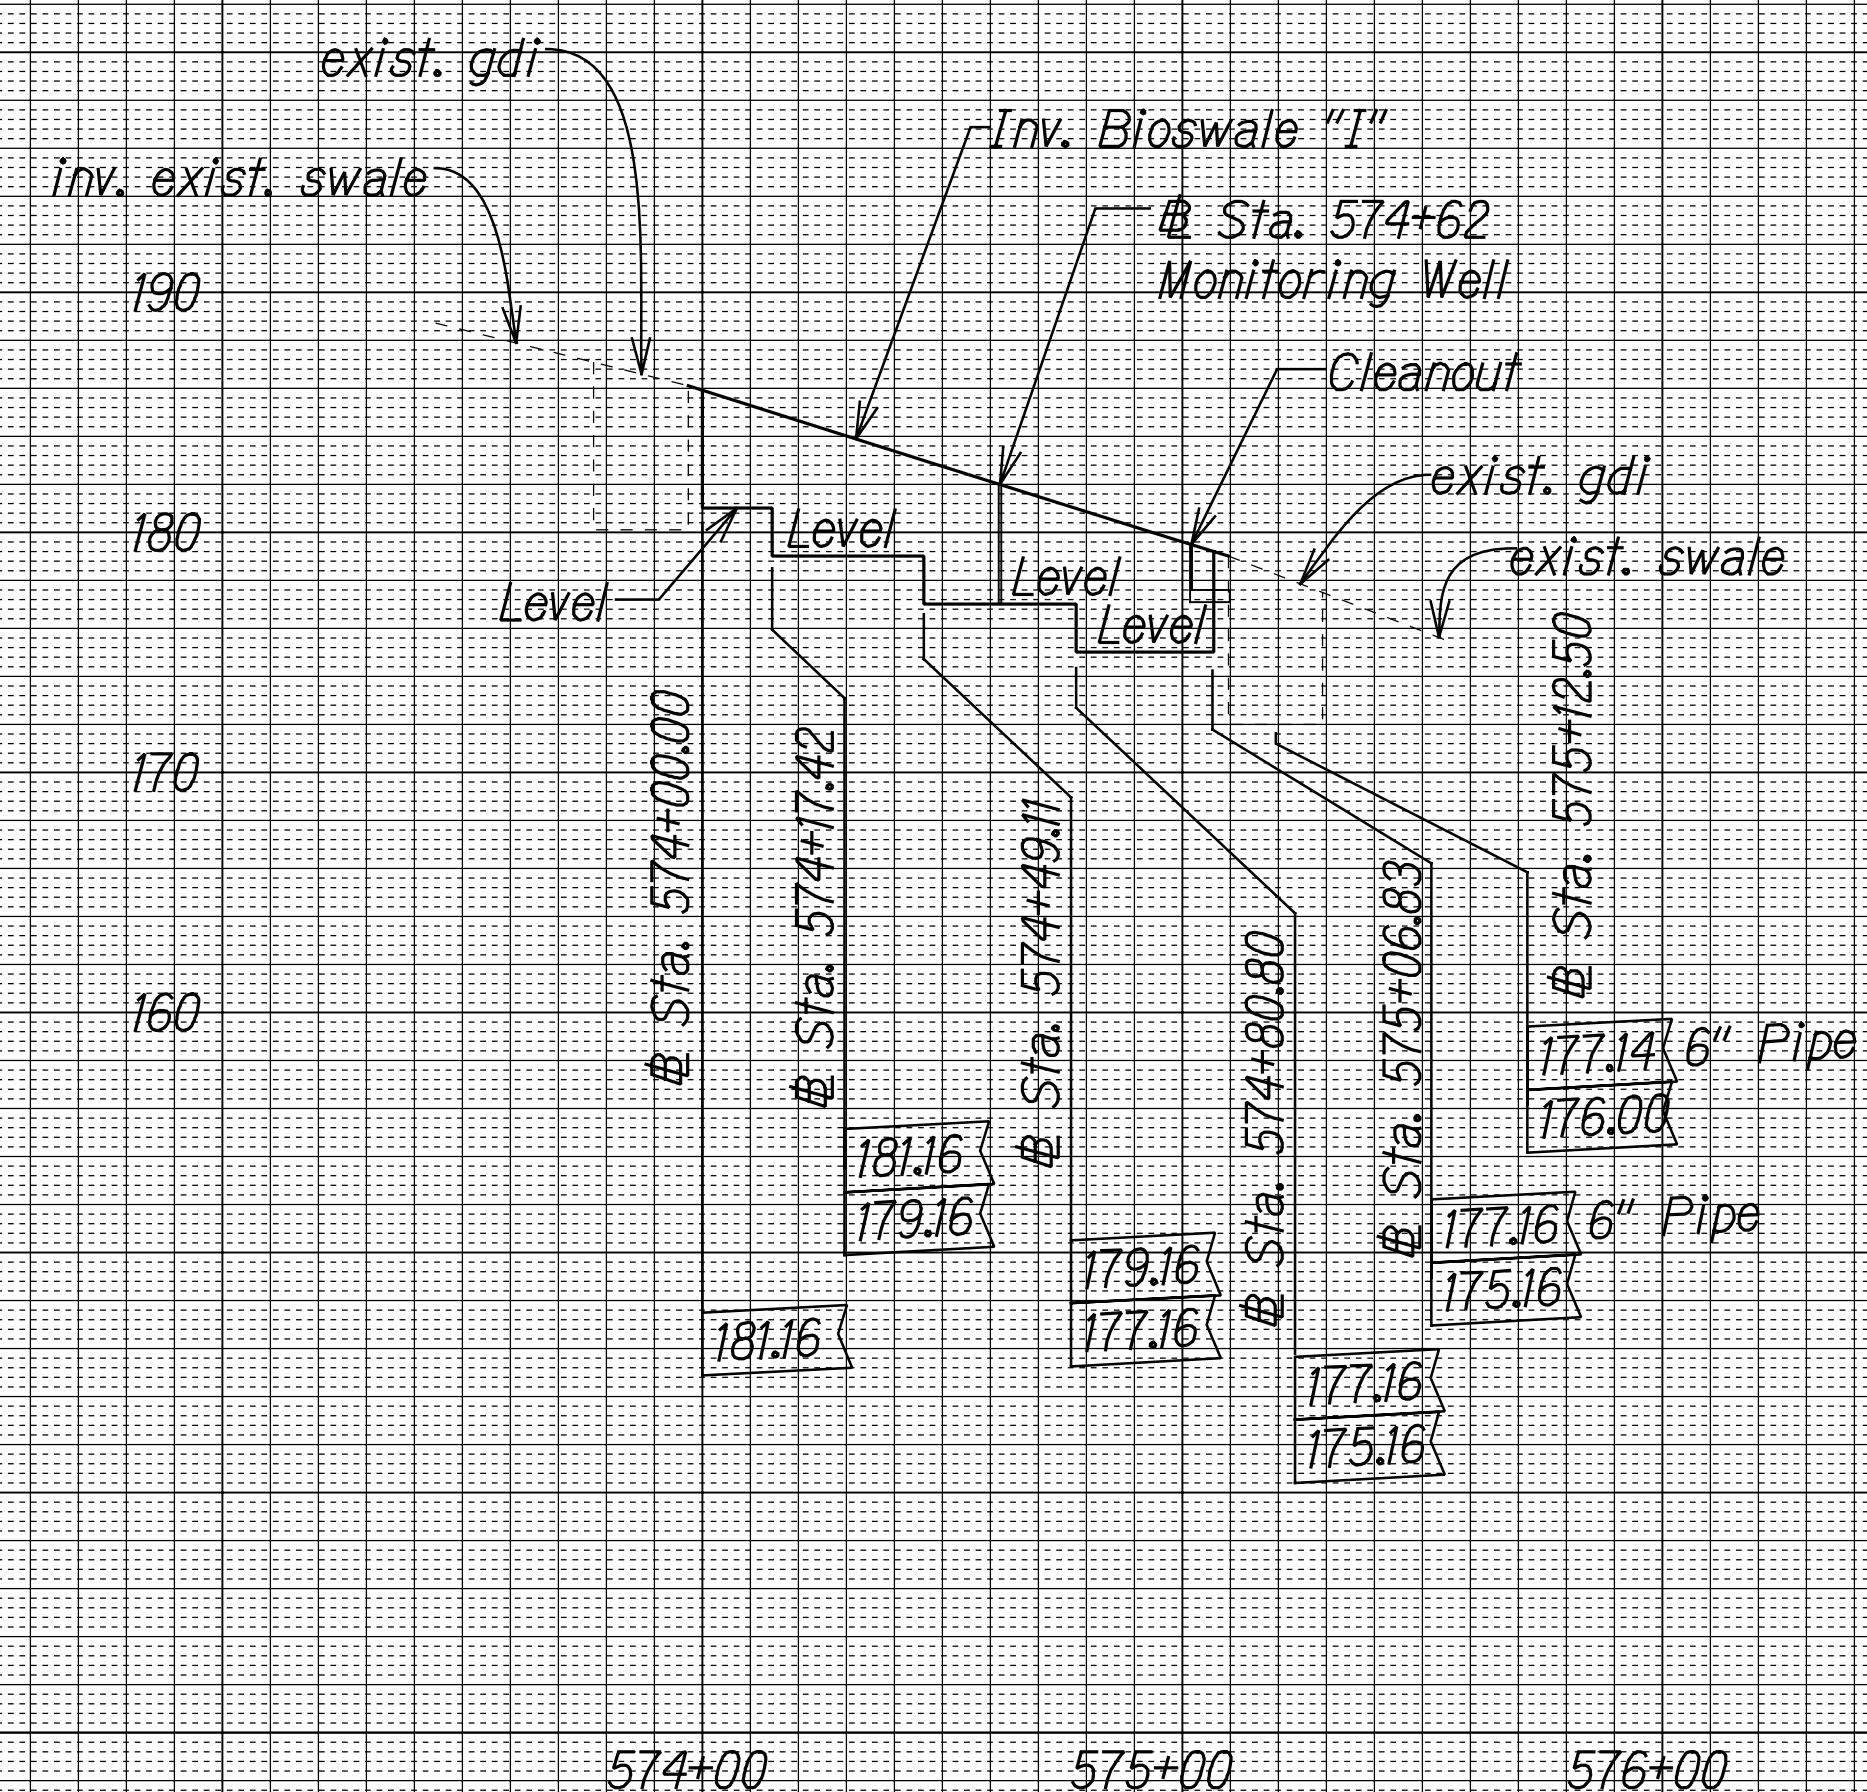


PROFILE-BIOSWALE "I"
Scale: HORIZ 1"=40'
VERT 1"=8'

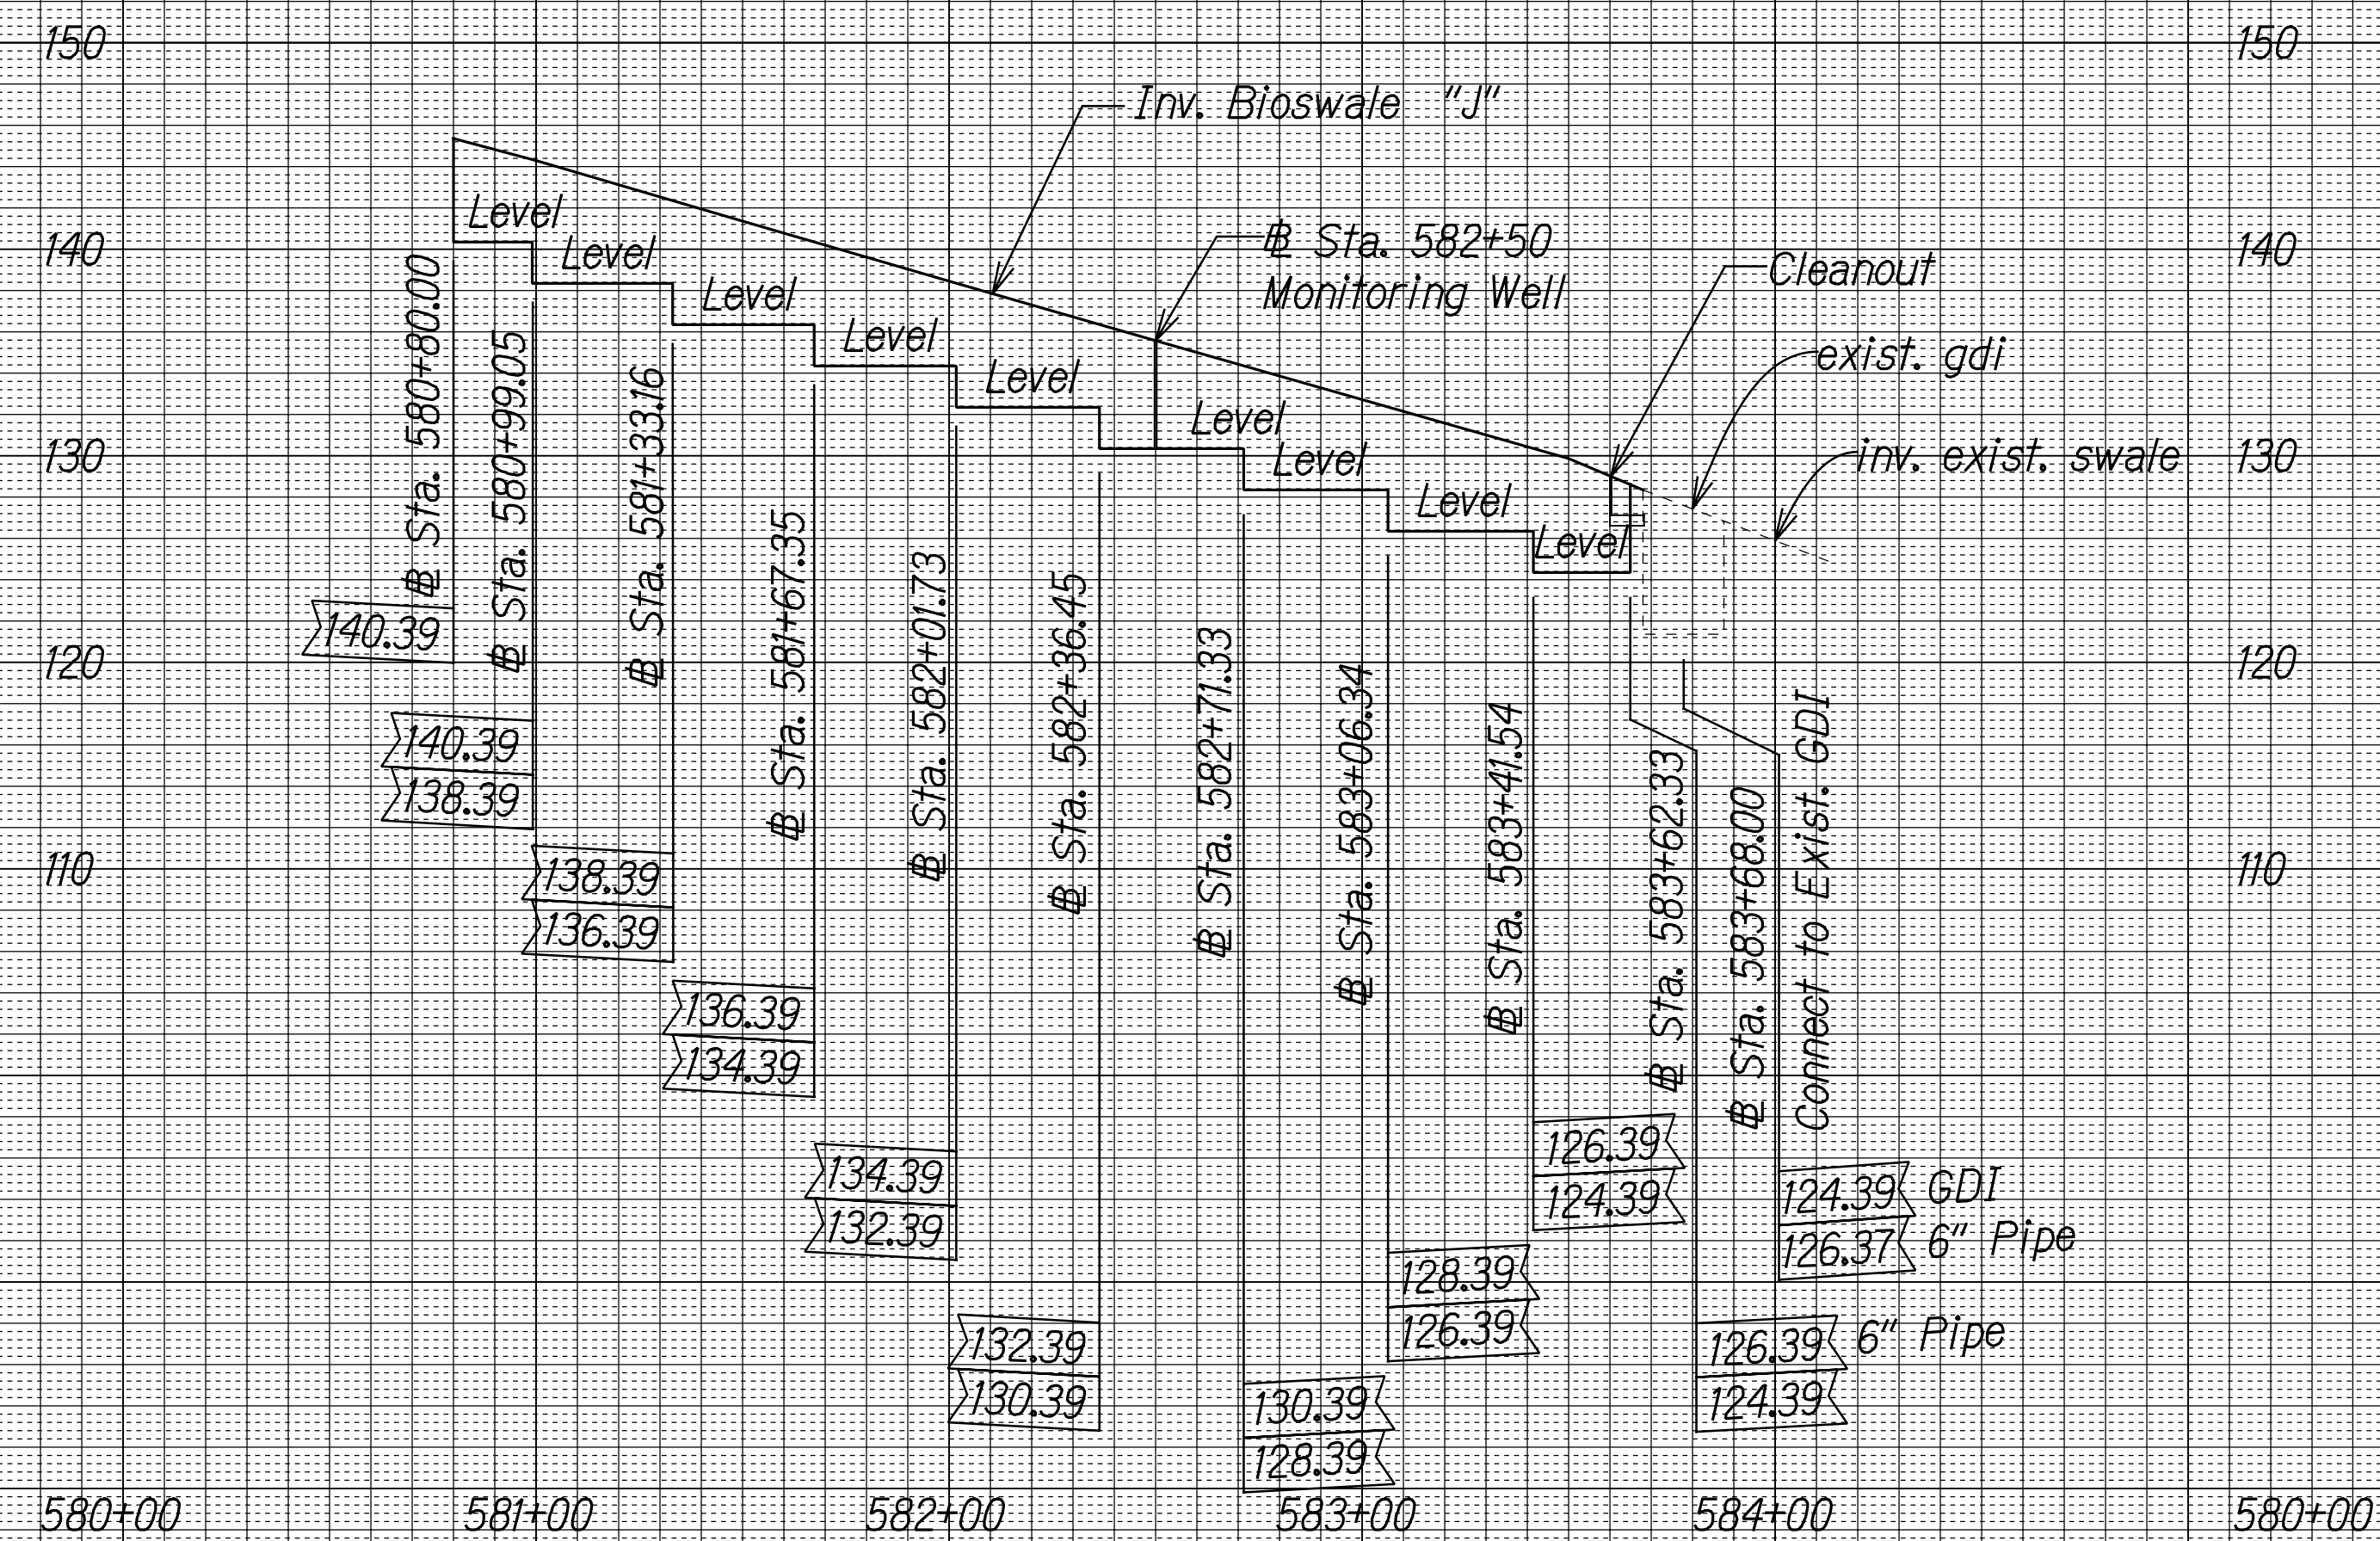


PROFILE-BIOSWALE "J"
Scale: HORIZ 1"=40'
VERT 1"=8'

LEGEND FOR AS-BUILT POSTINGS	
	Squiggly line for as-built deletion
	Double line for as-built deletion
Roadway	Text for as-built posting

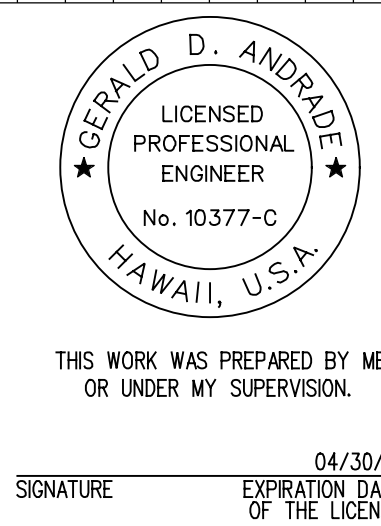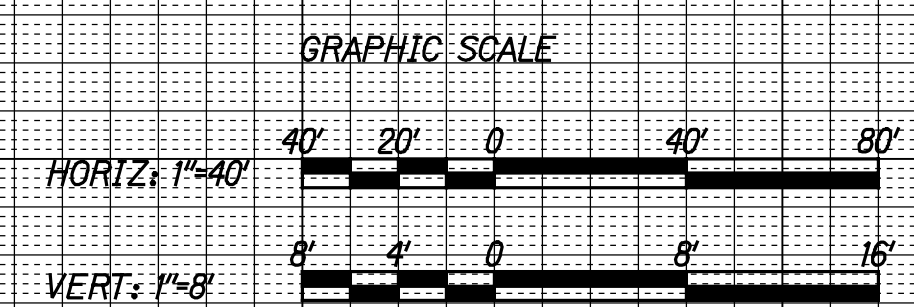



ORIGINAL PLAN	SURVEY PLOTTED BY	DATE
NOTE BOOK	DRAWN BY	
	DESIGNED BY	
	QUANTITIES BY	
	CHECKED BY	

FED. ROAD DIST. NO.	STATE	PROJ. NO.	FISCAL YEAR	SHEET NO.	TOTAL SHEETS
HAWAII	HAW.	HWY-0-02-11R	2014	26	43

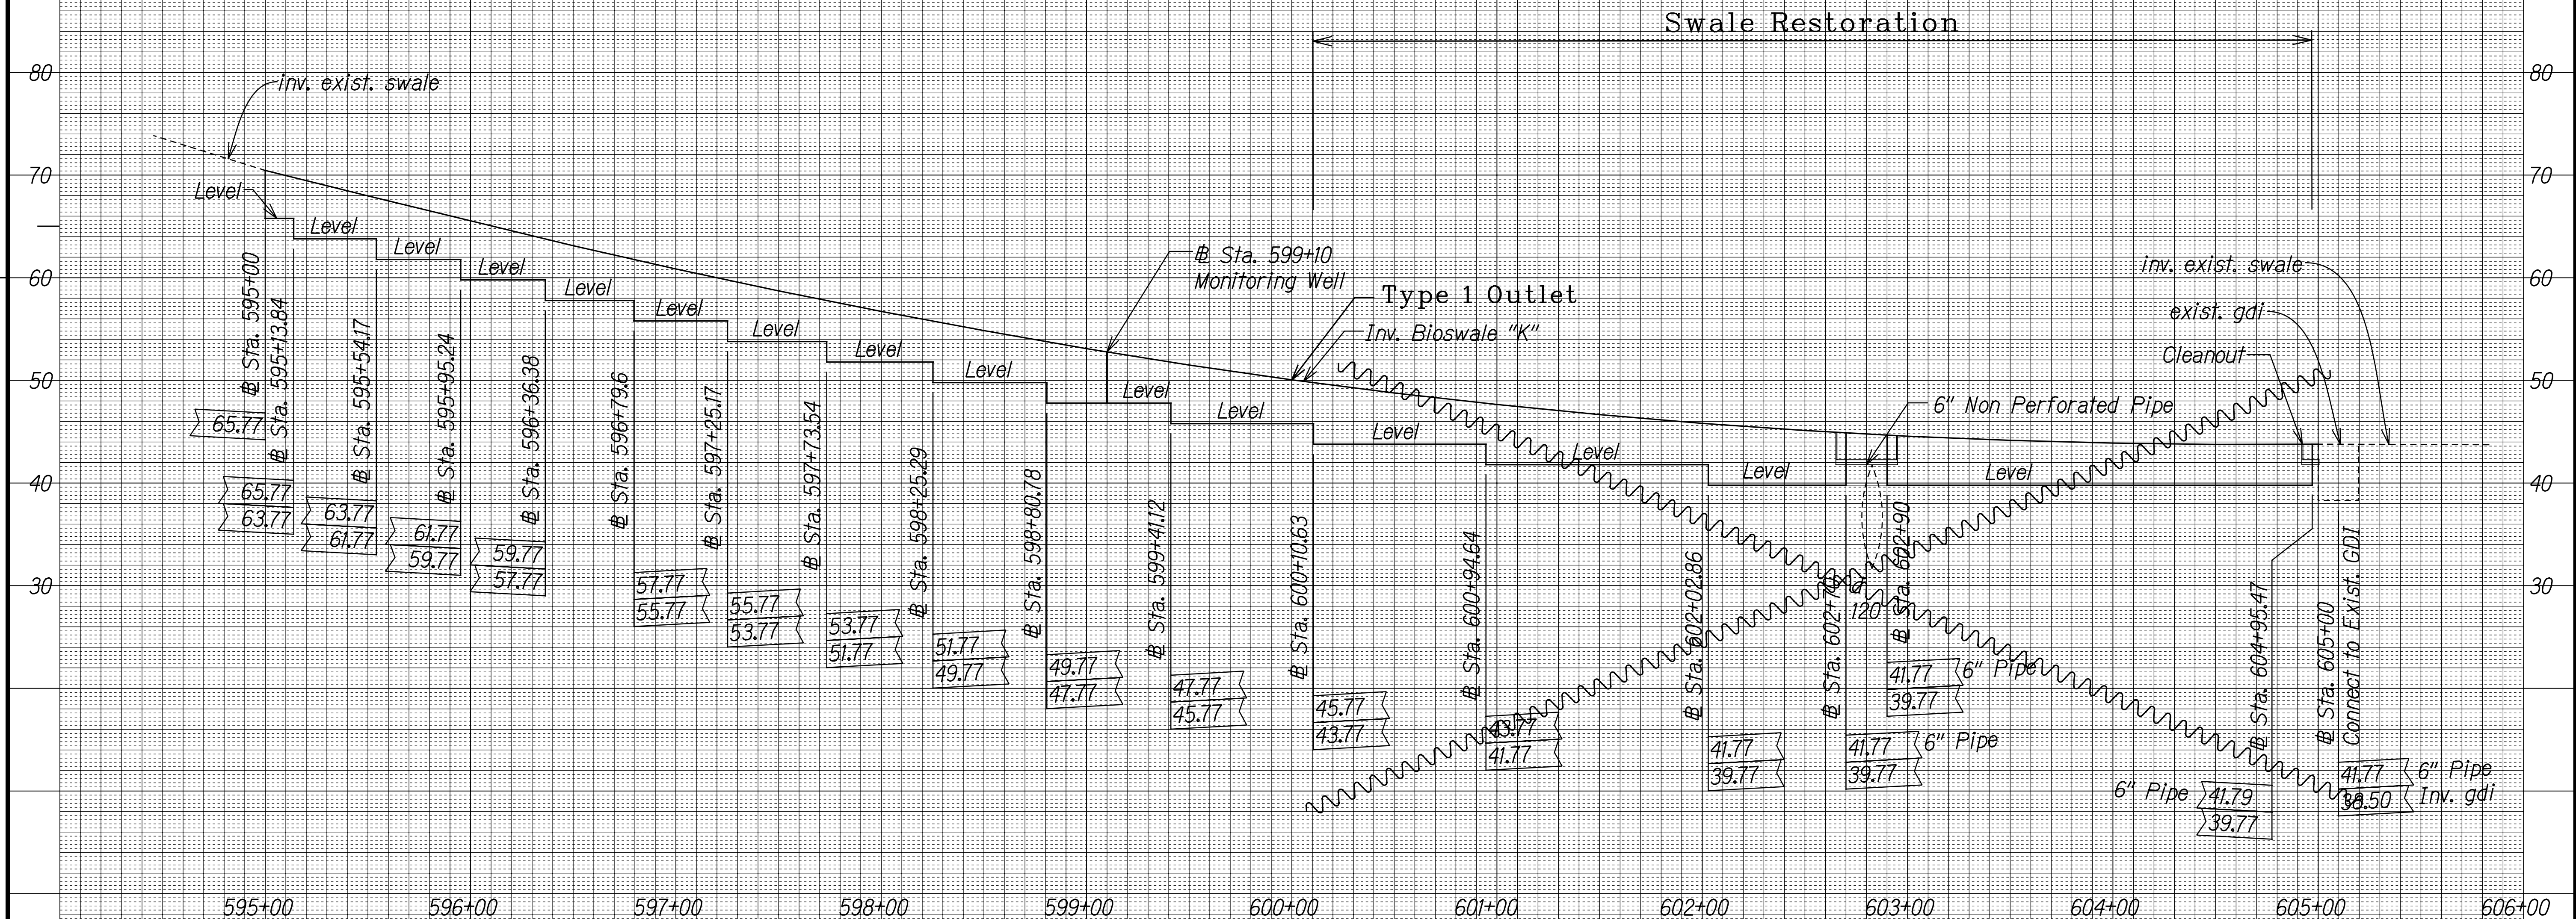


PROFILE-BIOSWALE "K"
Scale: HORIZ 1"=40'
VERT 1"=8'

LEGEND FOR AS-BUILT POSTINGS	
	Squiggly line for as-built deletion
	Double line for as-built deletion
Roadway	Text for as-built posting

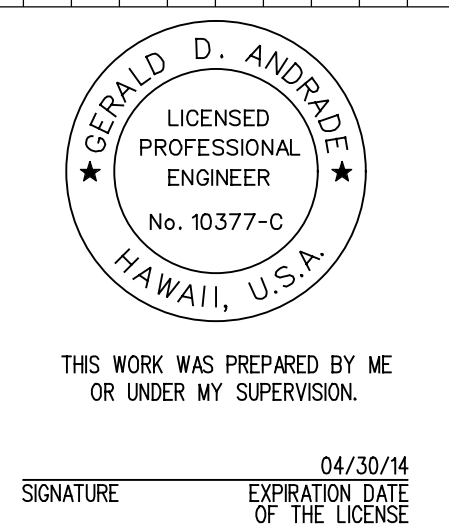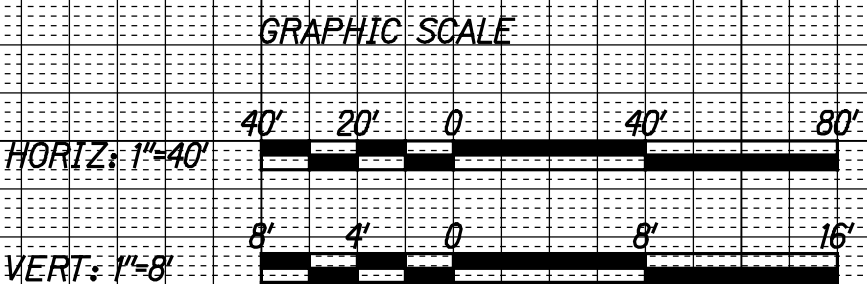


THIS WORK WAS PREPARED BY ME
OR UNDER MY SUPERVISION.
SIGNATURE _____ EXPIRATION DATE OF THE LICENSE 04/30/14

FED. ROAD DIST. NO.	STATE	PROJ. NO.	FISCAL YEAR	SHEET NO.	TOTAL SHEETS
HAWAII	HAW.	HWY-0-02-11R	2014	27	43

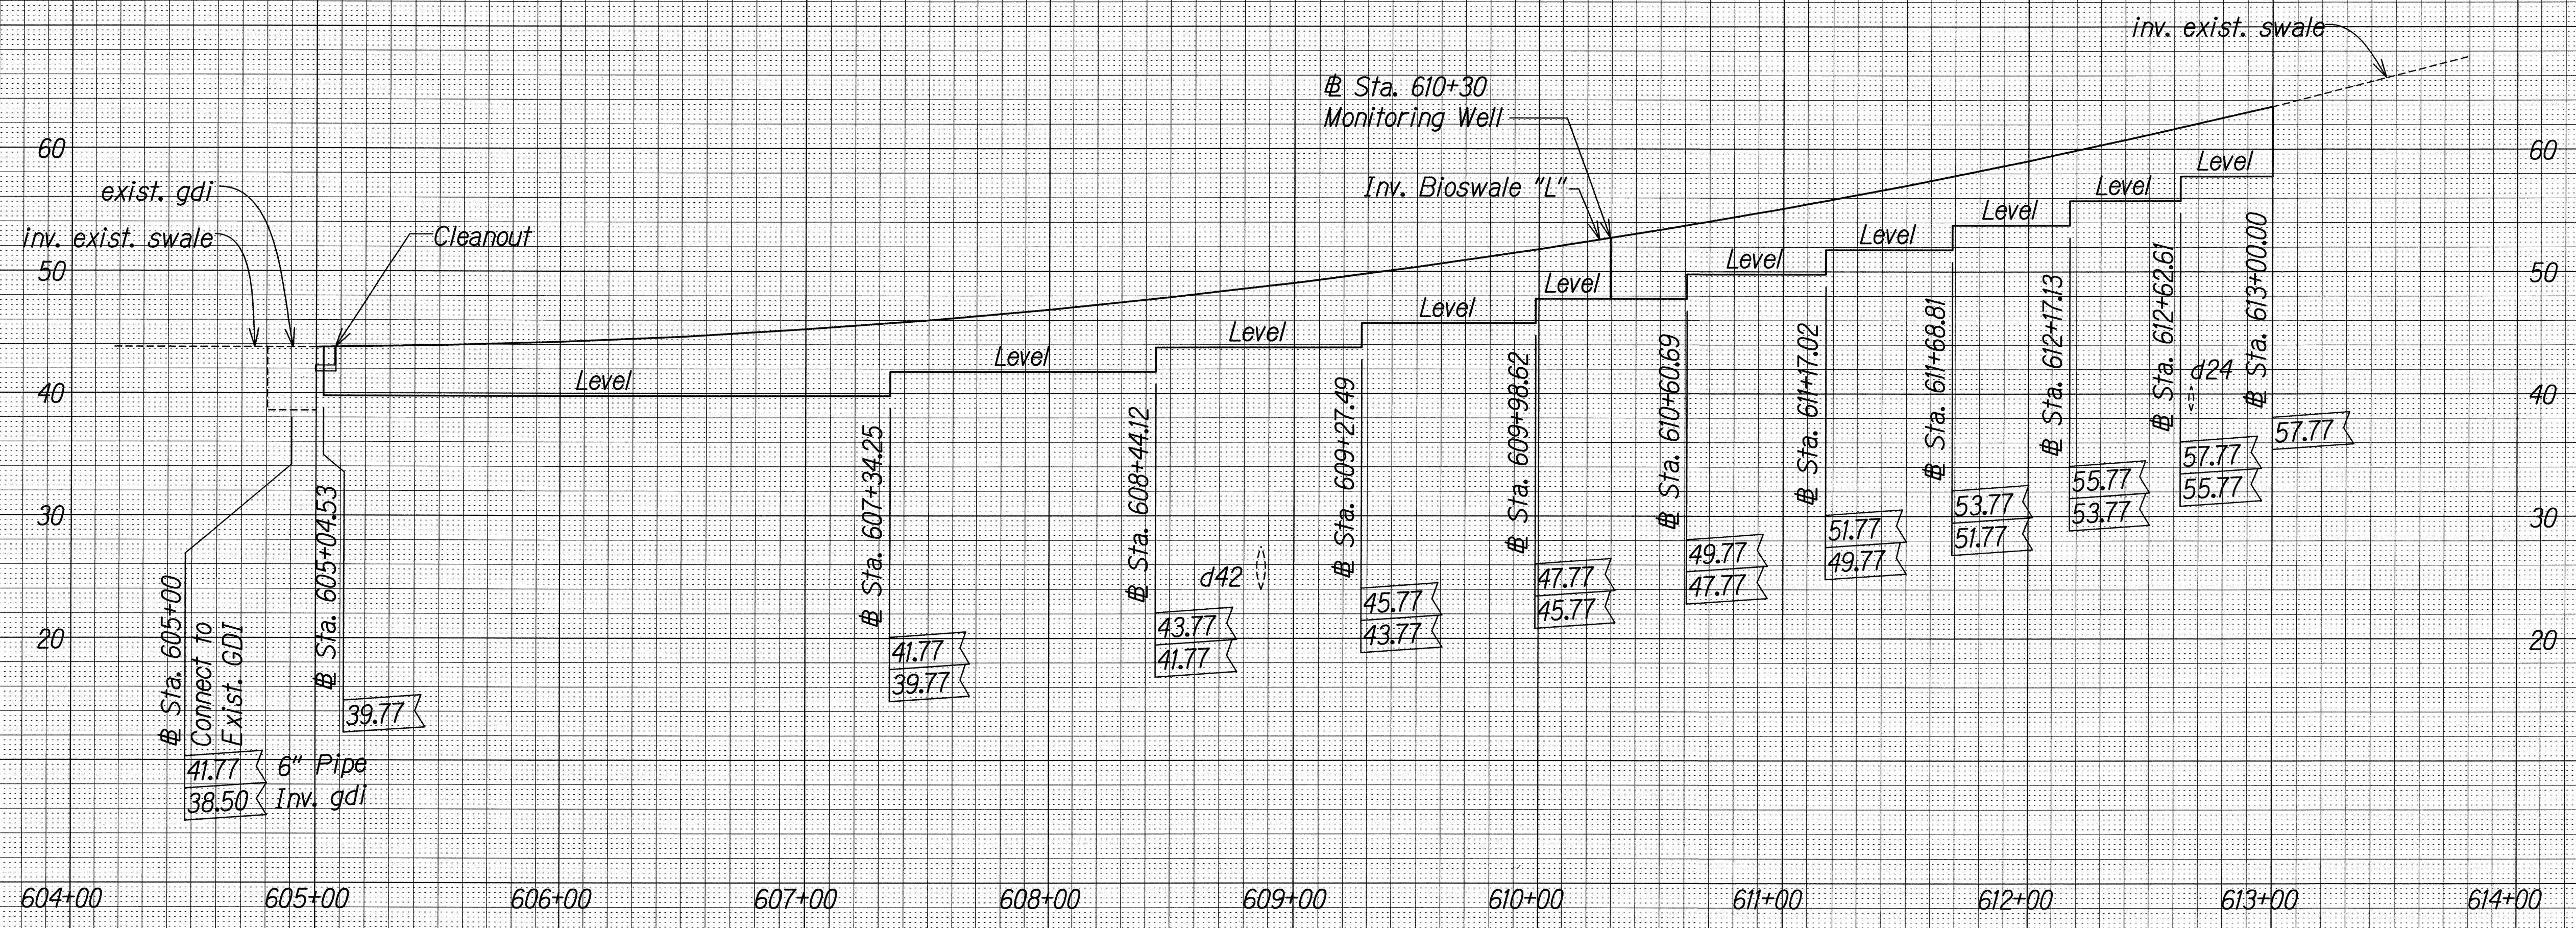

PROFILE-BIOSWALE "L"
 Scale: HORIZ 1"=40'
 VERT 1"=8'

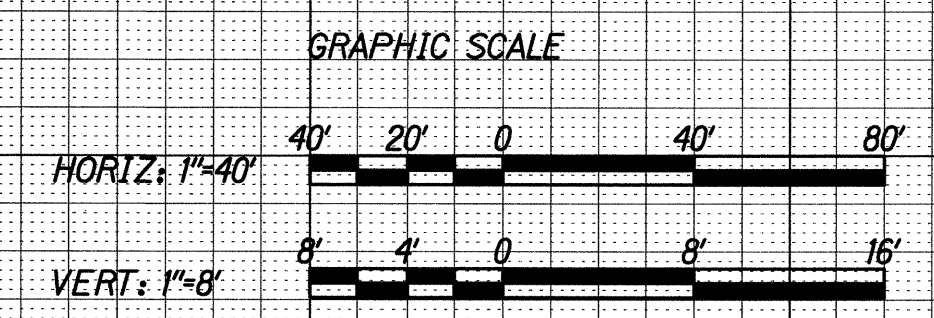


GERALD D. ANDRUS
 LICENSED PROFESSIONAL ENGINEER
 No. 10377-C
 HAWAII, U.S.A.

THIS WORK WAS PREPARED BY ME OR UNDER MY SUPERVISION.





Signature: *Gerald D. Andrus*
 EXPIRATION DATE OF THE LICENSE: 04/30/14

ORIGINAL PLAN	SURVEY PLOTTED BY	DATE
NOTE BOOK	DRAWN BY	
	DESIGNED BY	
	CHECKED BY	

FED. ROAD DIST. NO.	STATE	PROJ. NO.	FISCAL YEAR	SHEET NO.	TOTAL SHEETS
HAWAII	HAW.	HWY-0-02-11R	2014	28	43

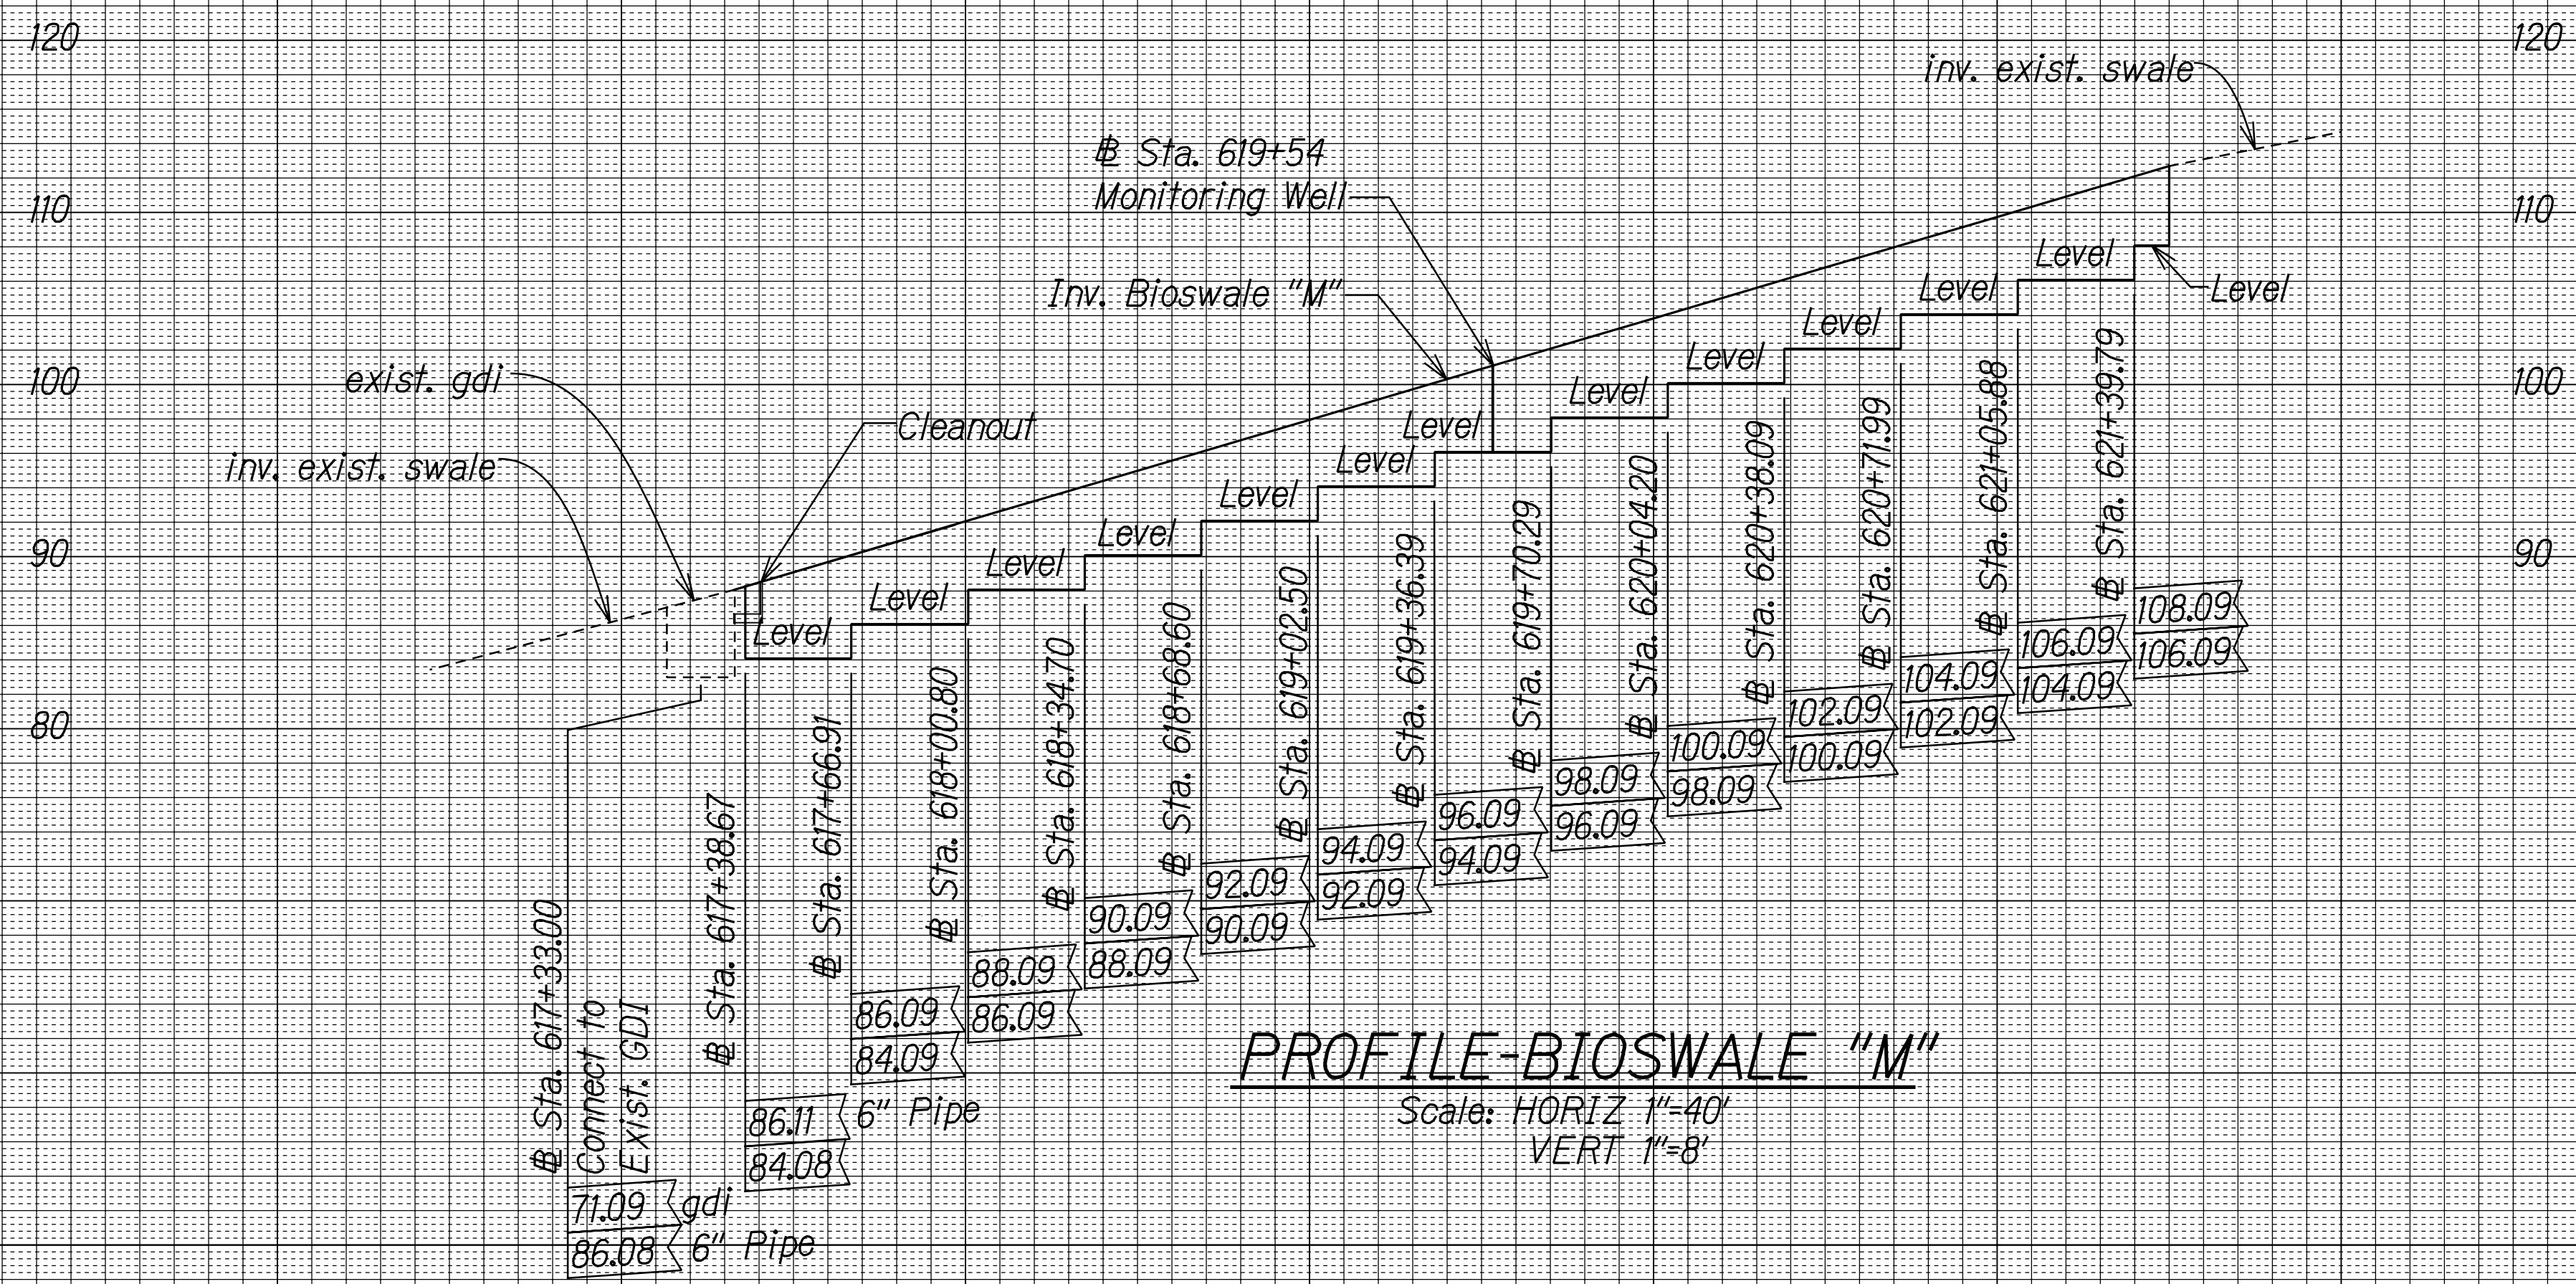


LEGEND FOR AS-BUILT POSTINGS	
	Squiggly line for as-built deletion
	Double line for as-built deletion
Roadway	Text for as-built posting

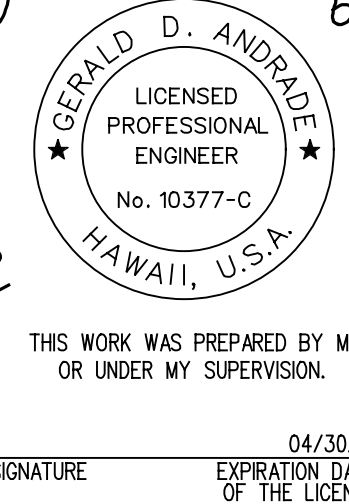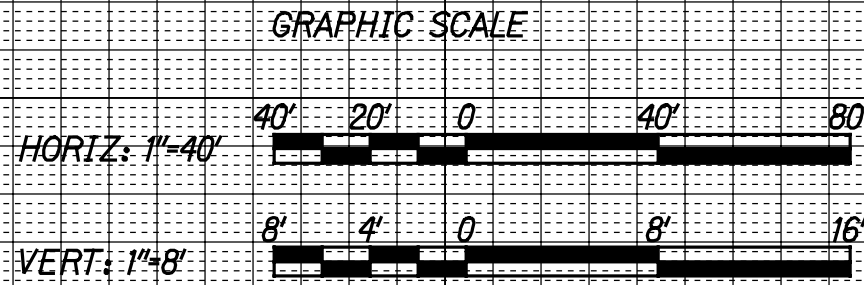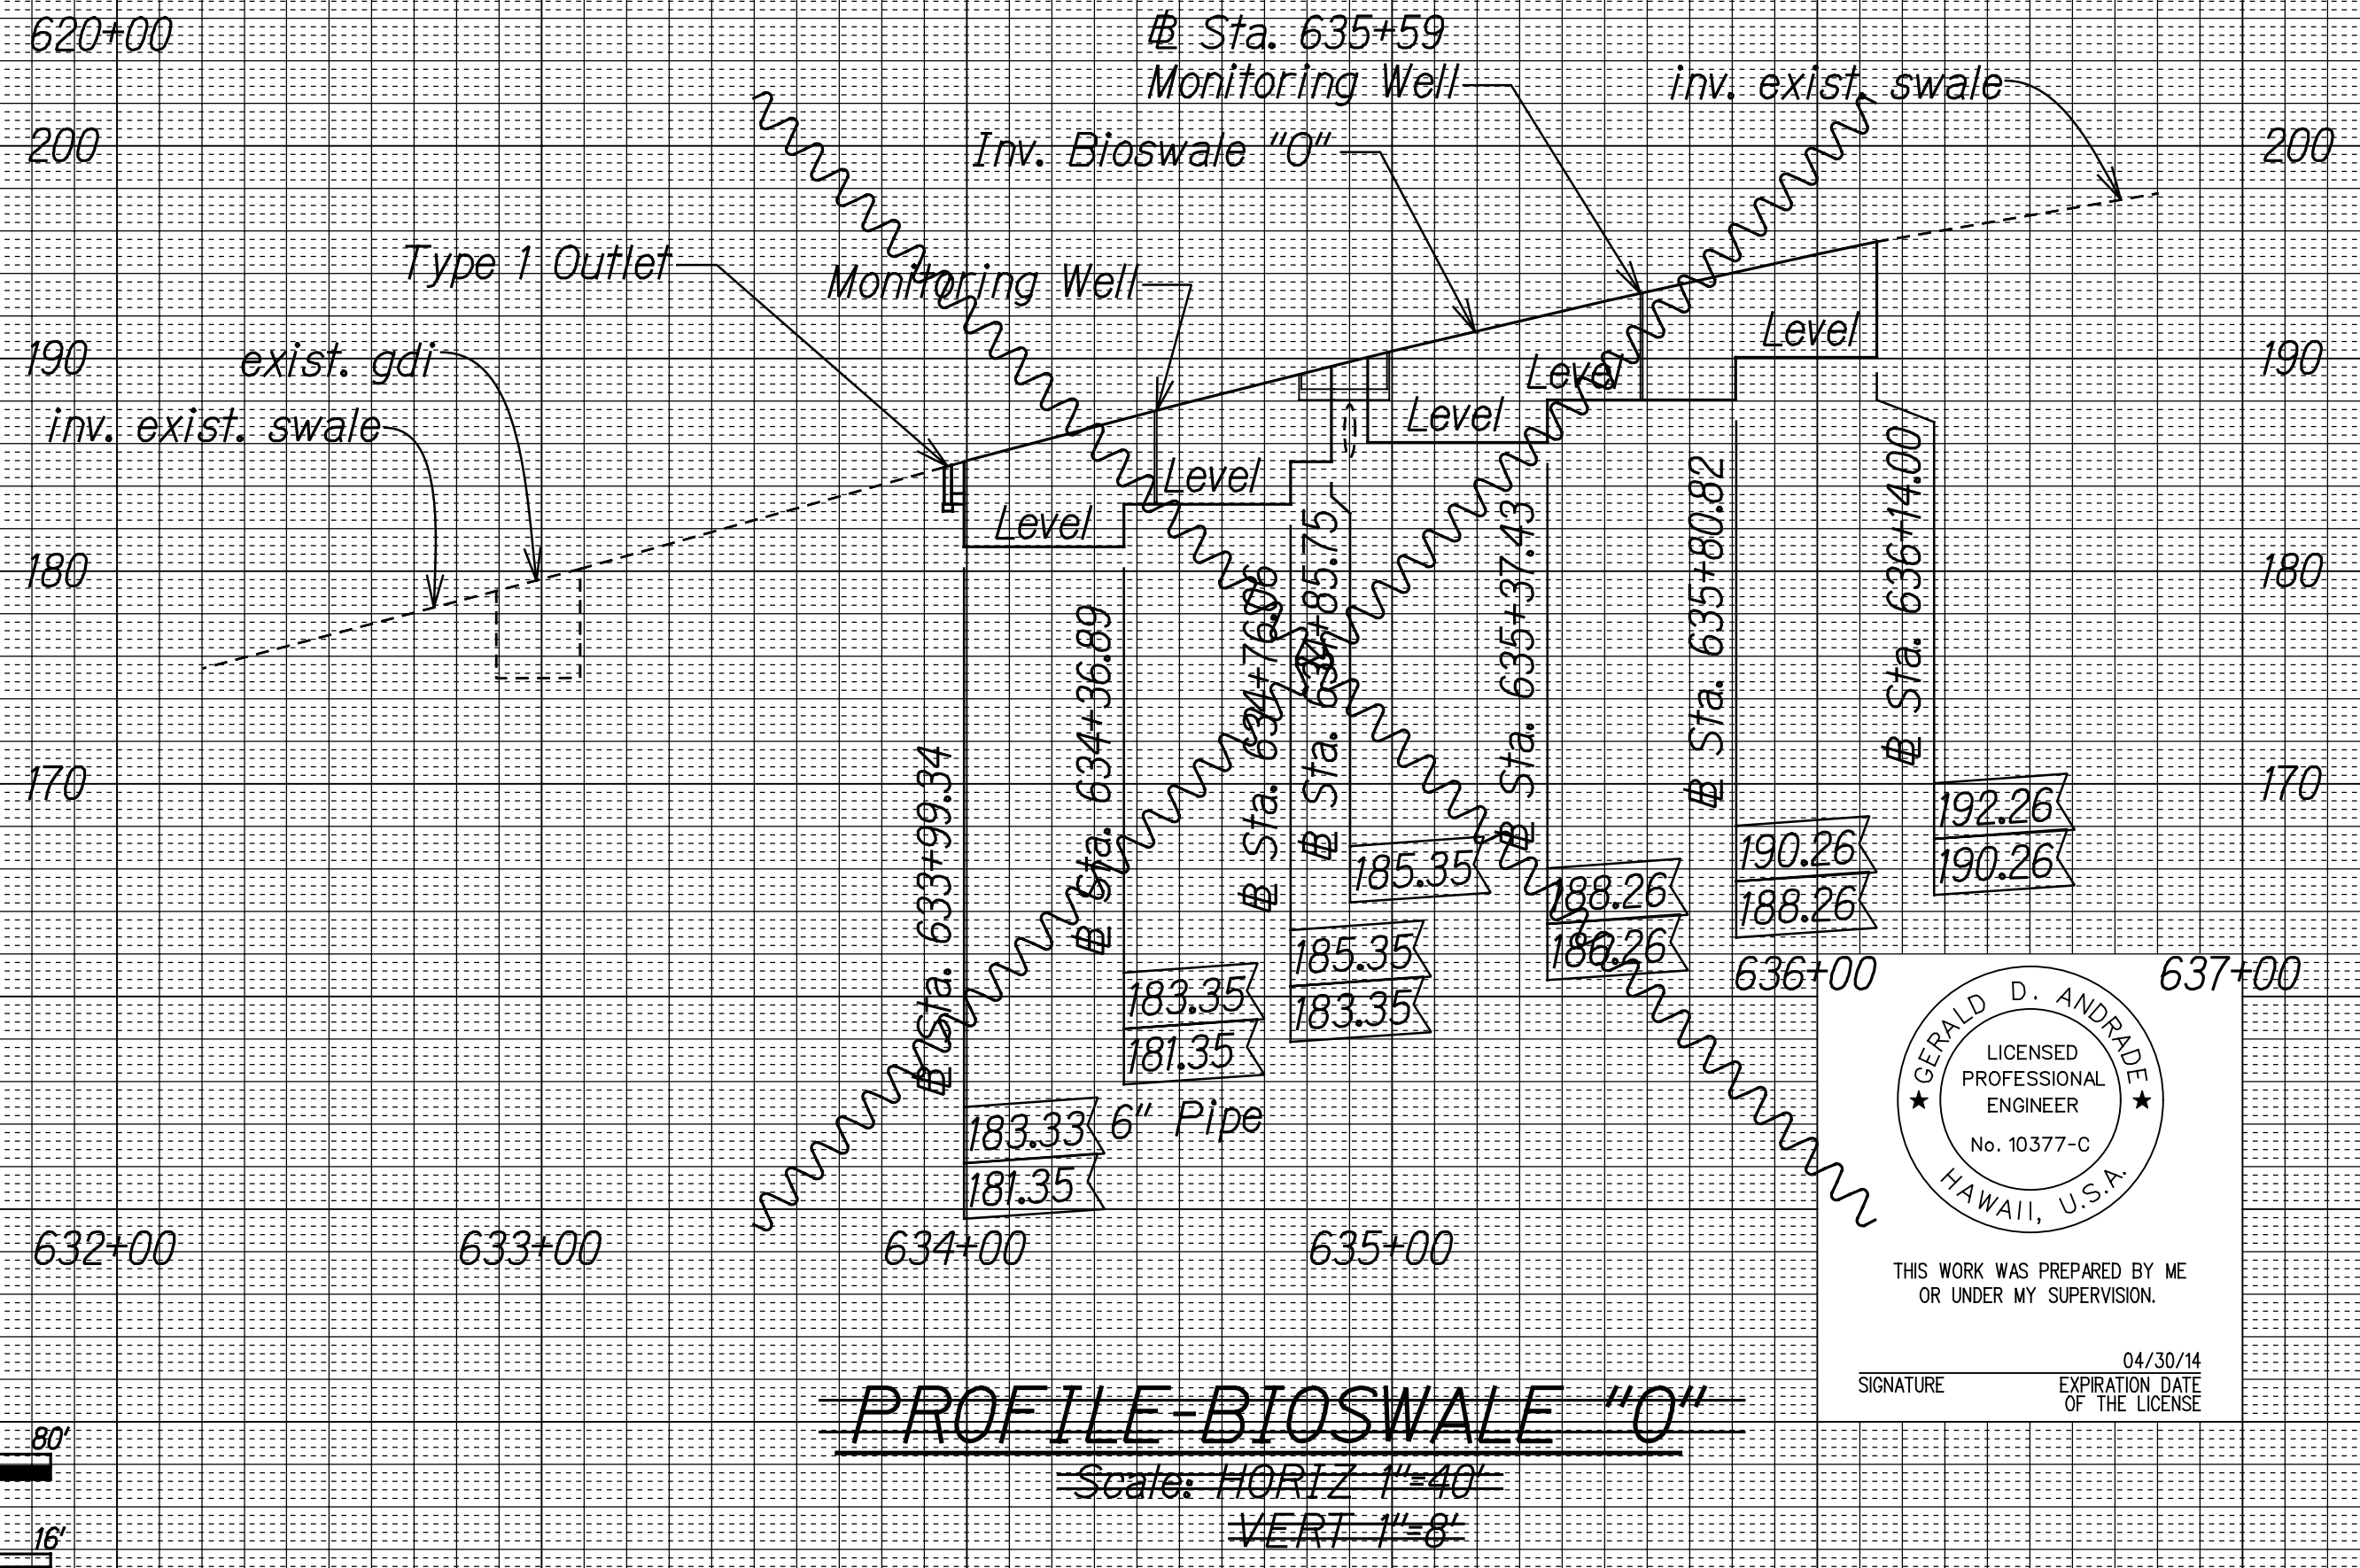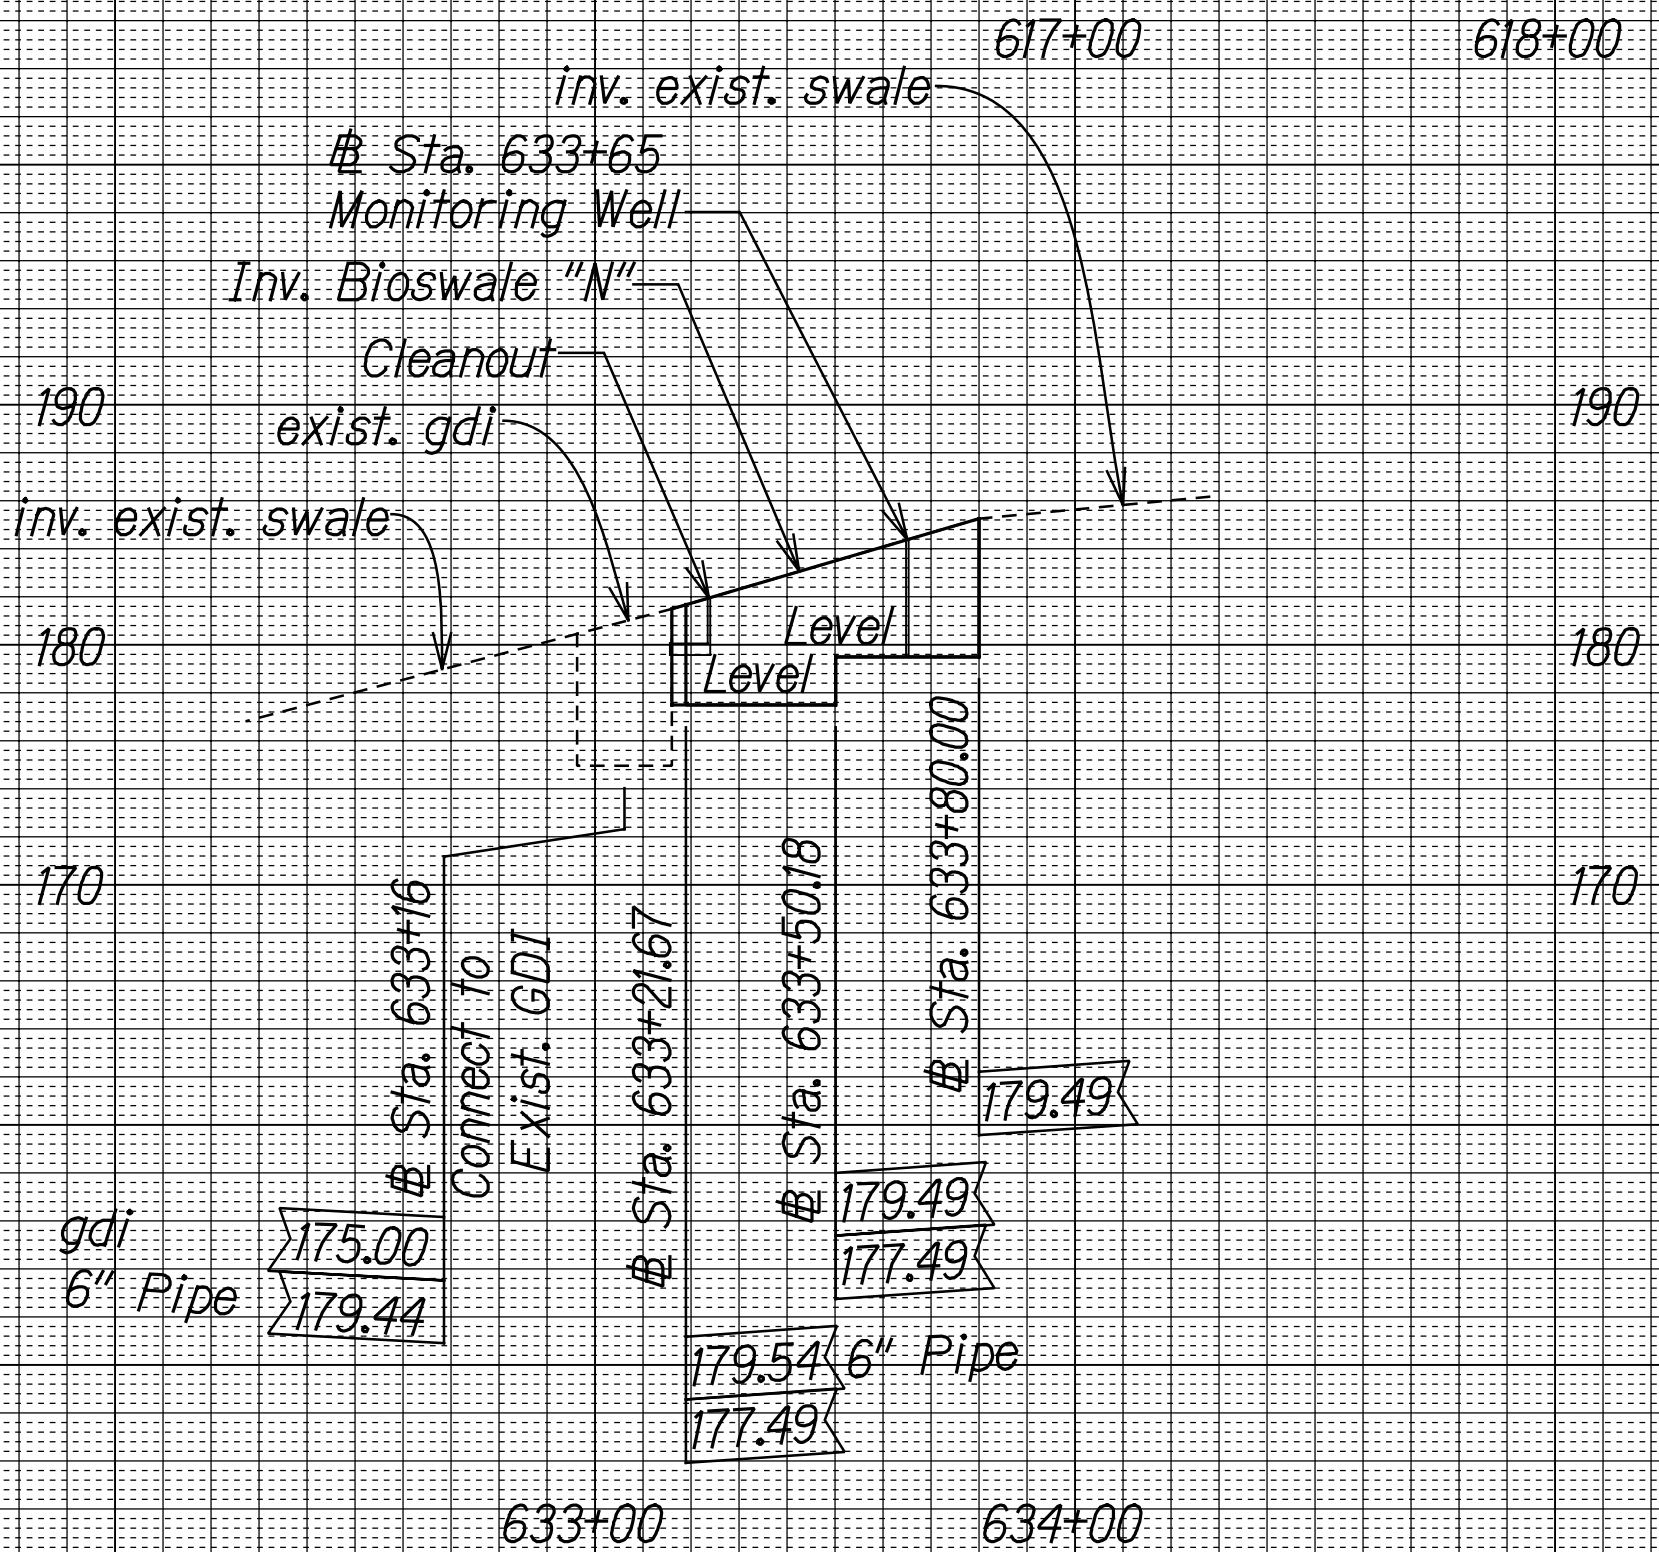


SURVEY PLOTTED BY	DATE
DRAWN BY	
TRACED BY	
DESIGNED BY	
QUANTITIES BY	
CHECKED BY	


FED. ROAD DIST. NO.	STATE	PROJ. NO.	FISCAL YEAR	SHEET NO.	TOTAL SHEETS
HAWAII	HAW.	HWY-0-02-11R	2014	29	43

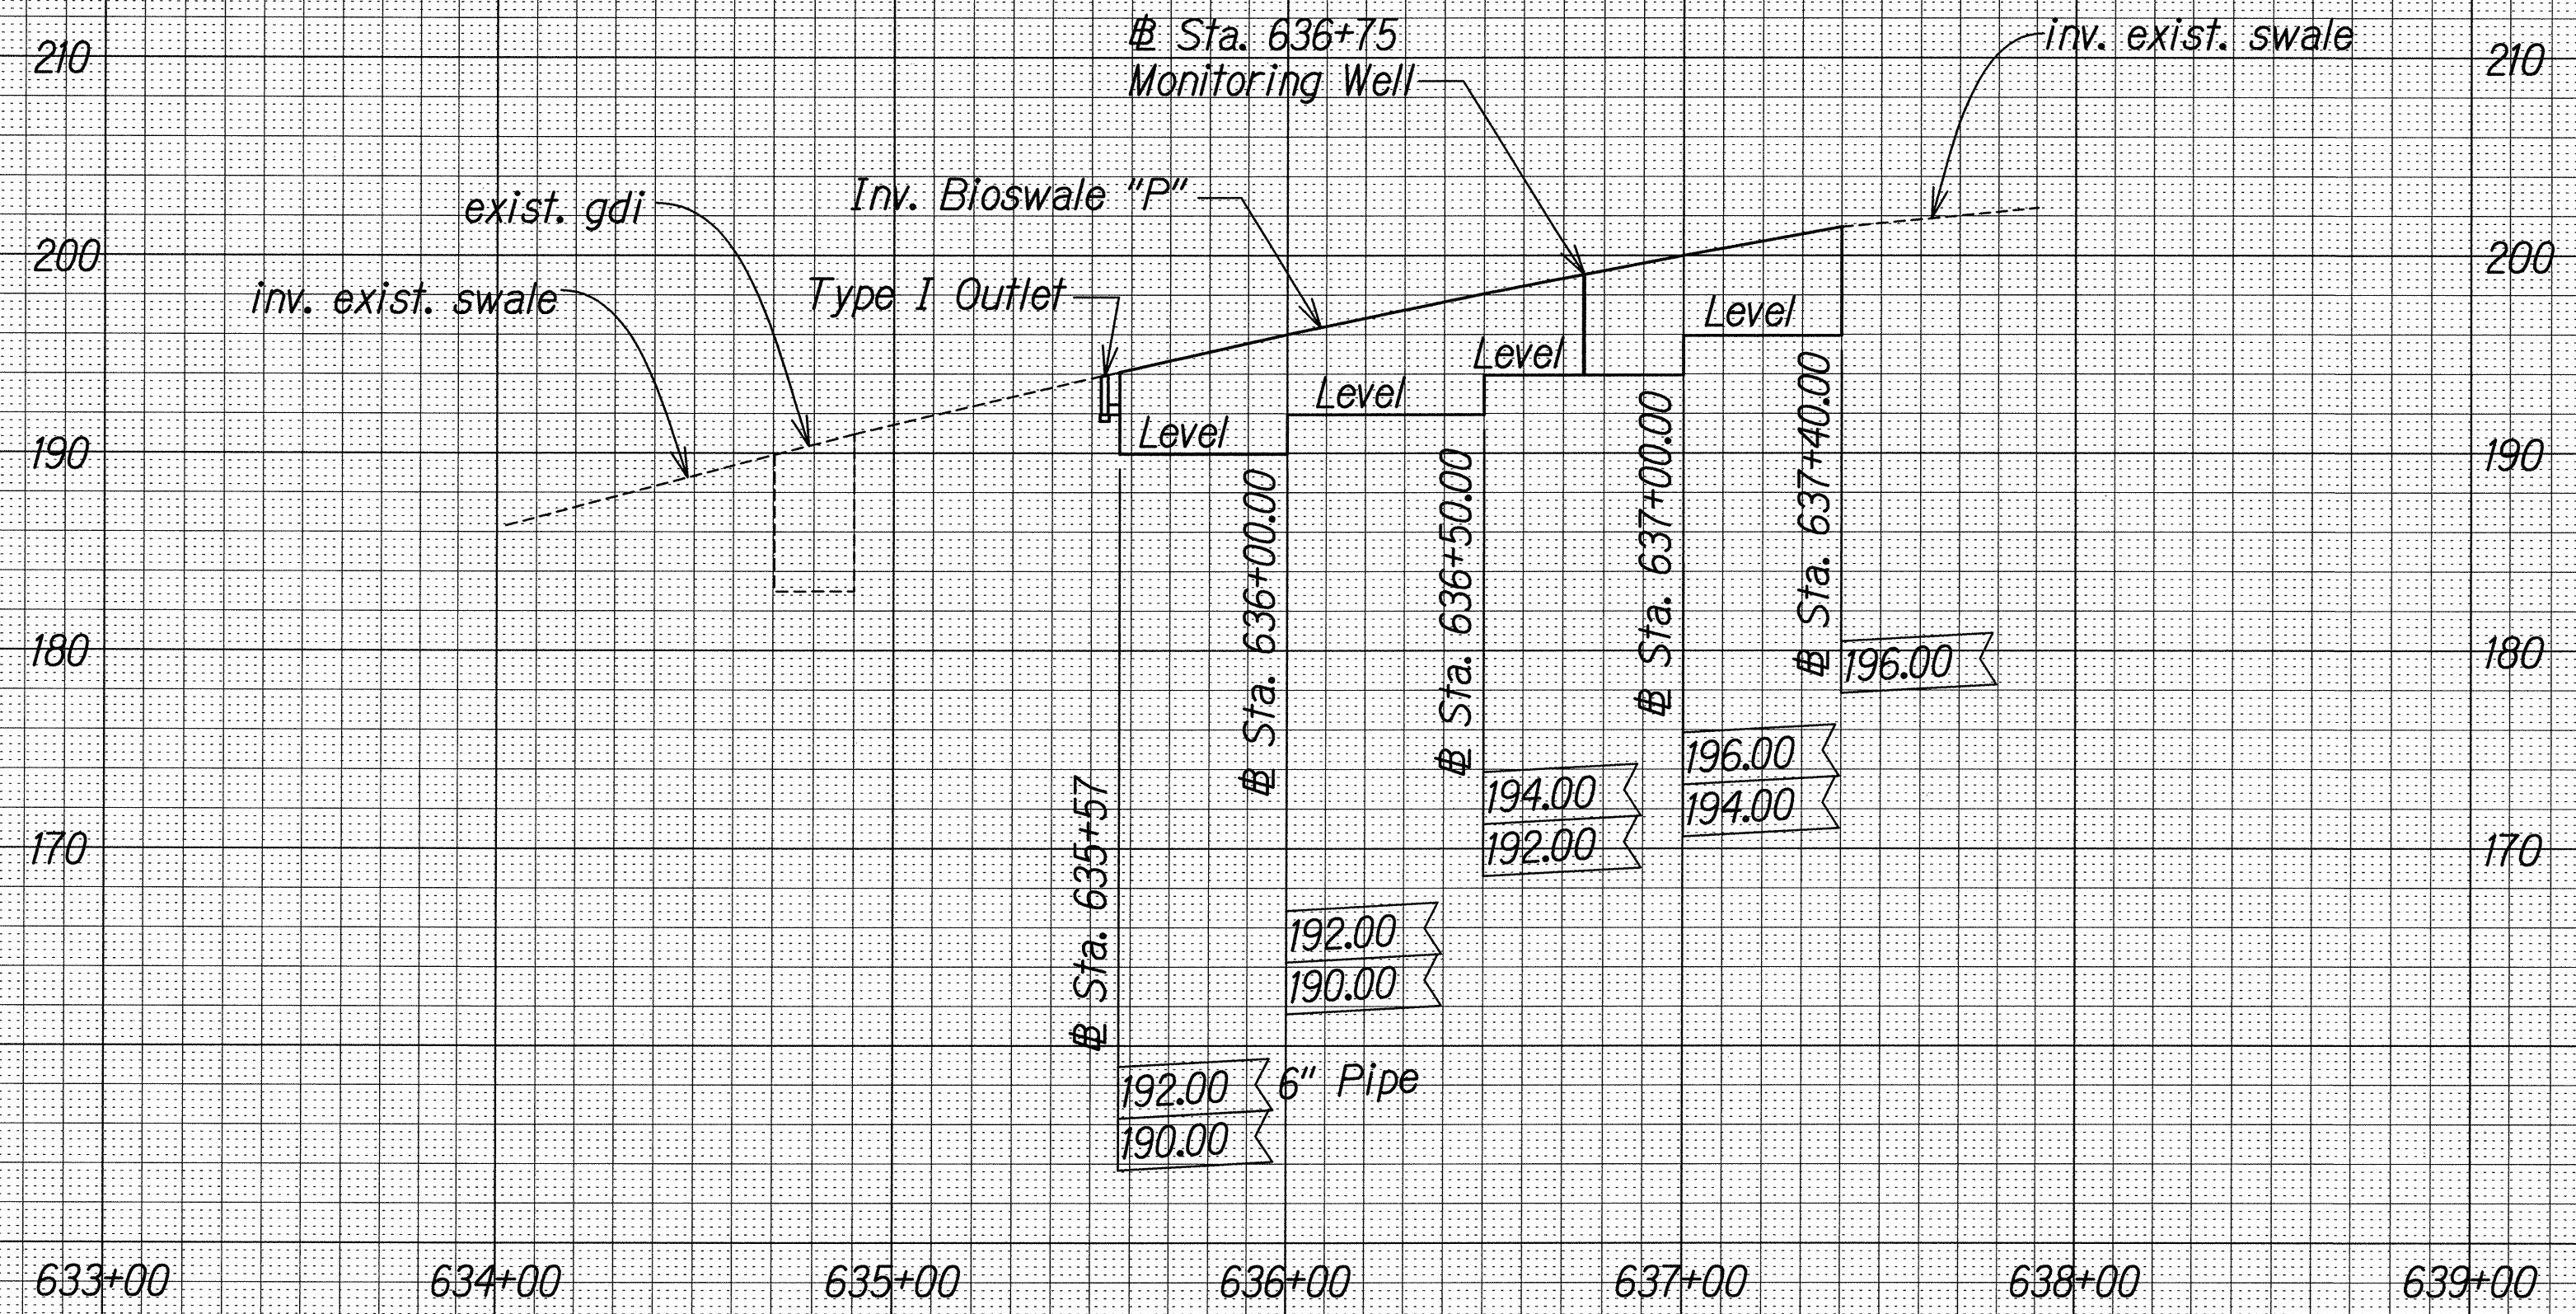

PROFILE-BIOSWALE "P"
Scale: HORIZ 1"=40'
VERT 1"=8'

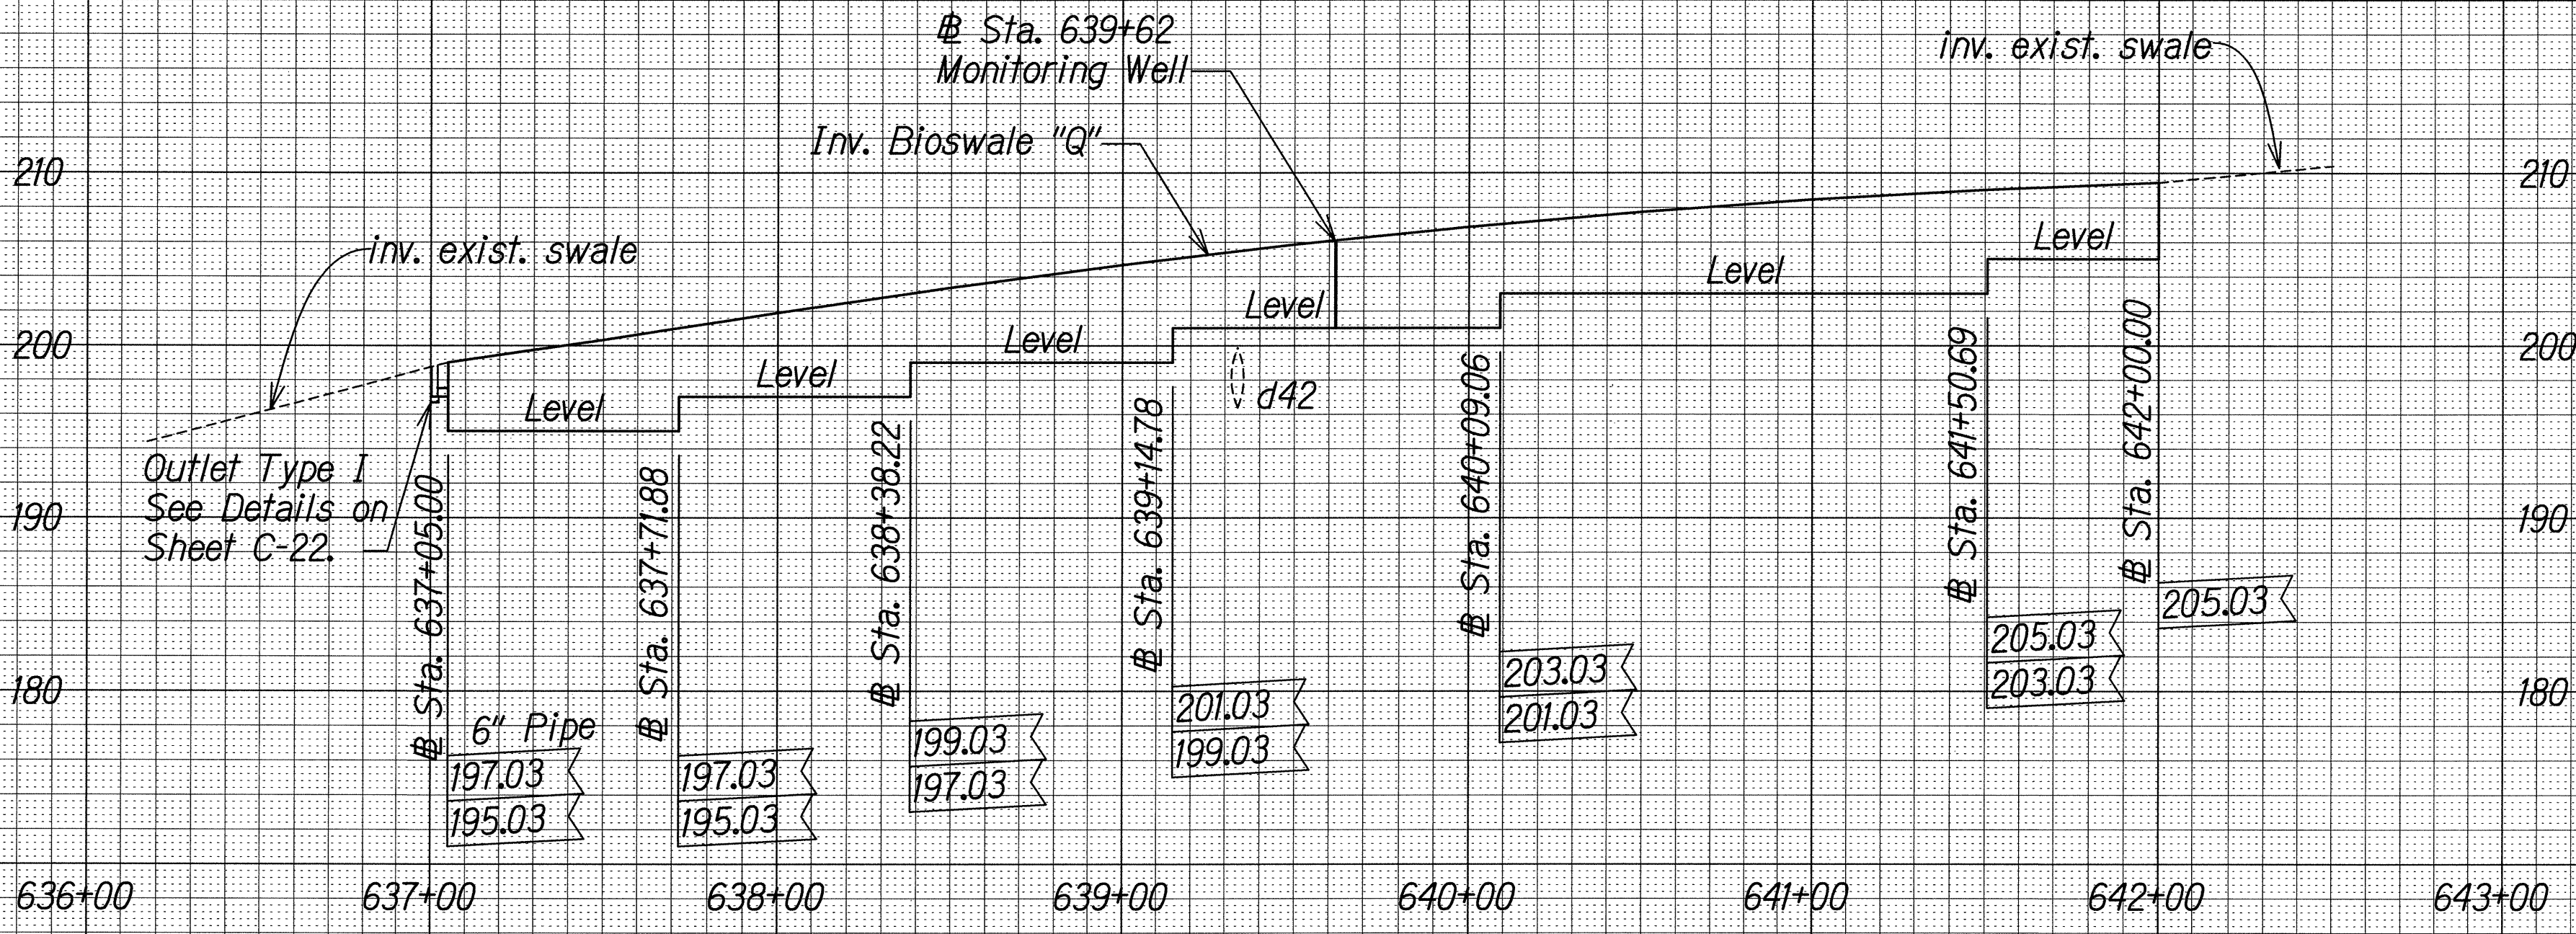

PROFILE-BIOSWALE "Q"
Scale: HORIZ 1"=40'
VERT 1"=8'

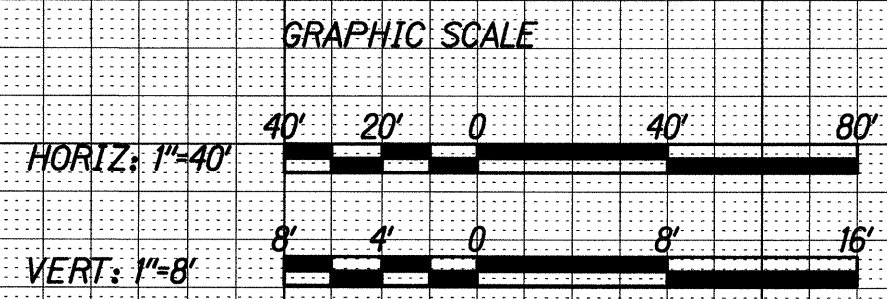

GERALD D. ANDRIDE
LICENSED PROFESSIONAL ENGINEER
No. 10377-C
HAWAII, U.S.A.
THIS WORK WAS PREPARED BY ME
OR UNDER MY SUPERVISION.
SIGNATURE: *Gerald D. Andride* 04/30/14
EXPIRATION DATE OF THE LICENSE

ORIGINAL PLAN	DATE
NOTED BY	
DESIGNED BY	
CHECKED BY	
IN CHARGE	