

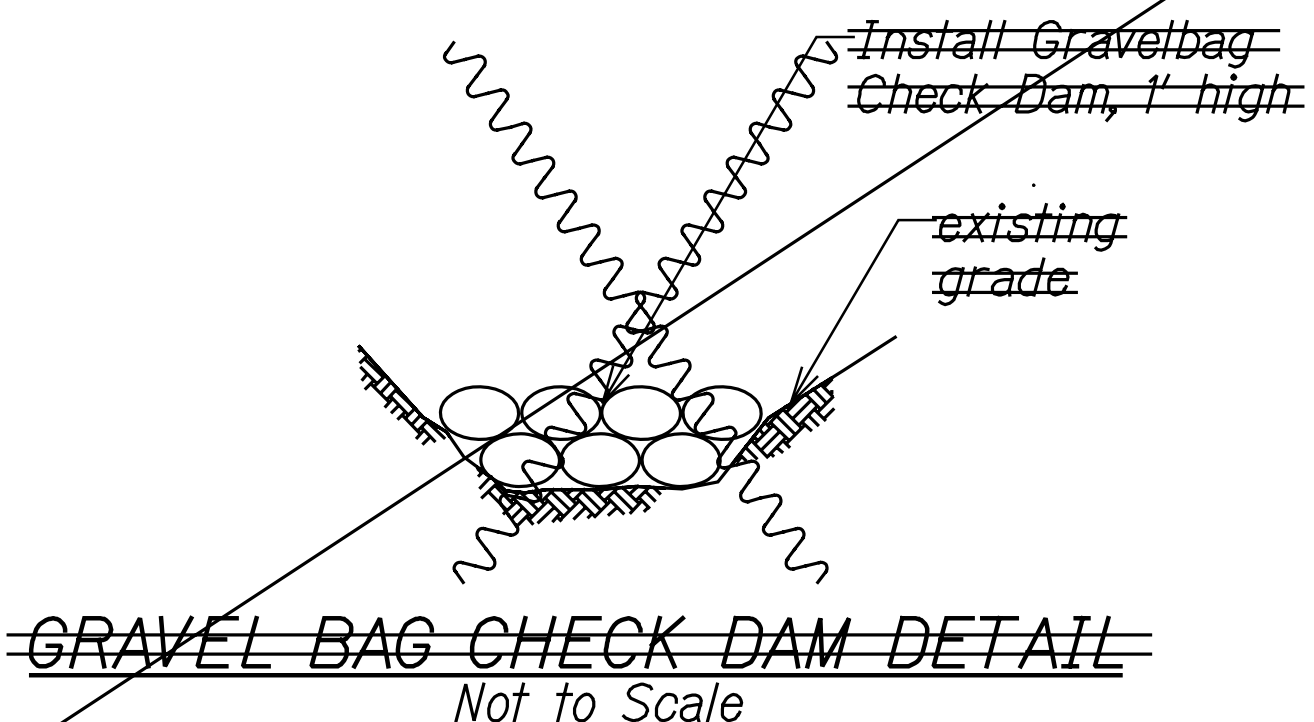


FED. ROAD DIST. NO.	STATE	PROJ. NO.	FISCAL YEAR	SHEET NO.	TOTAL SHEETS
HAWAII	HAW.	HWY-0-02-11R	2014	13	43

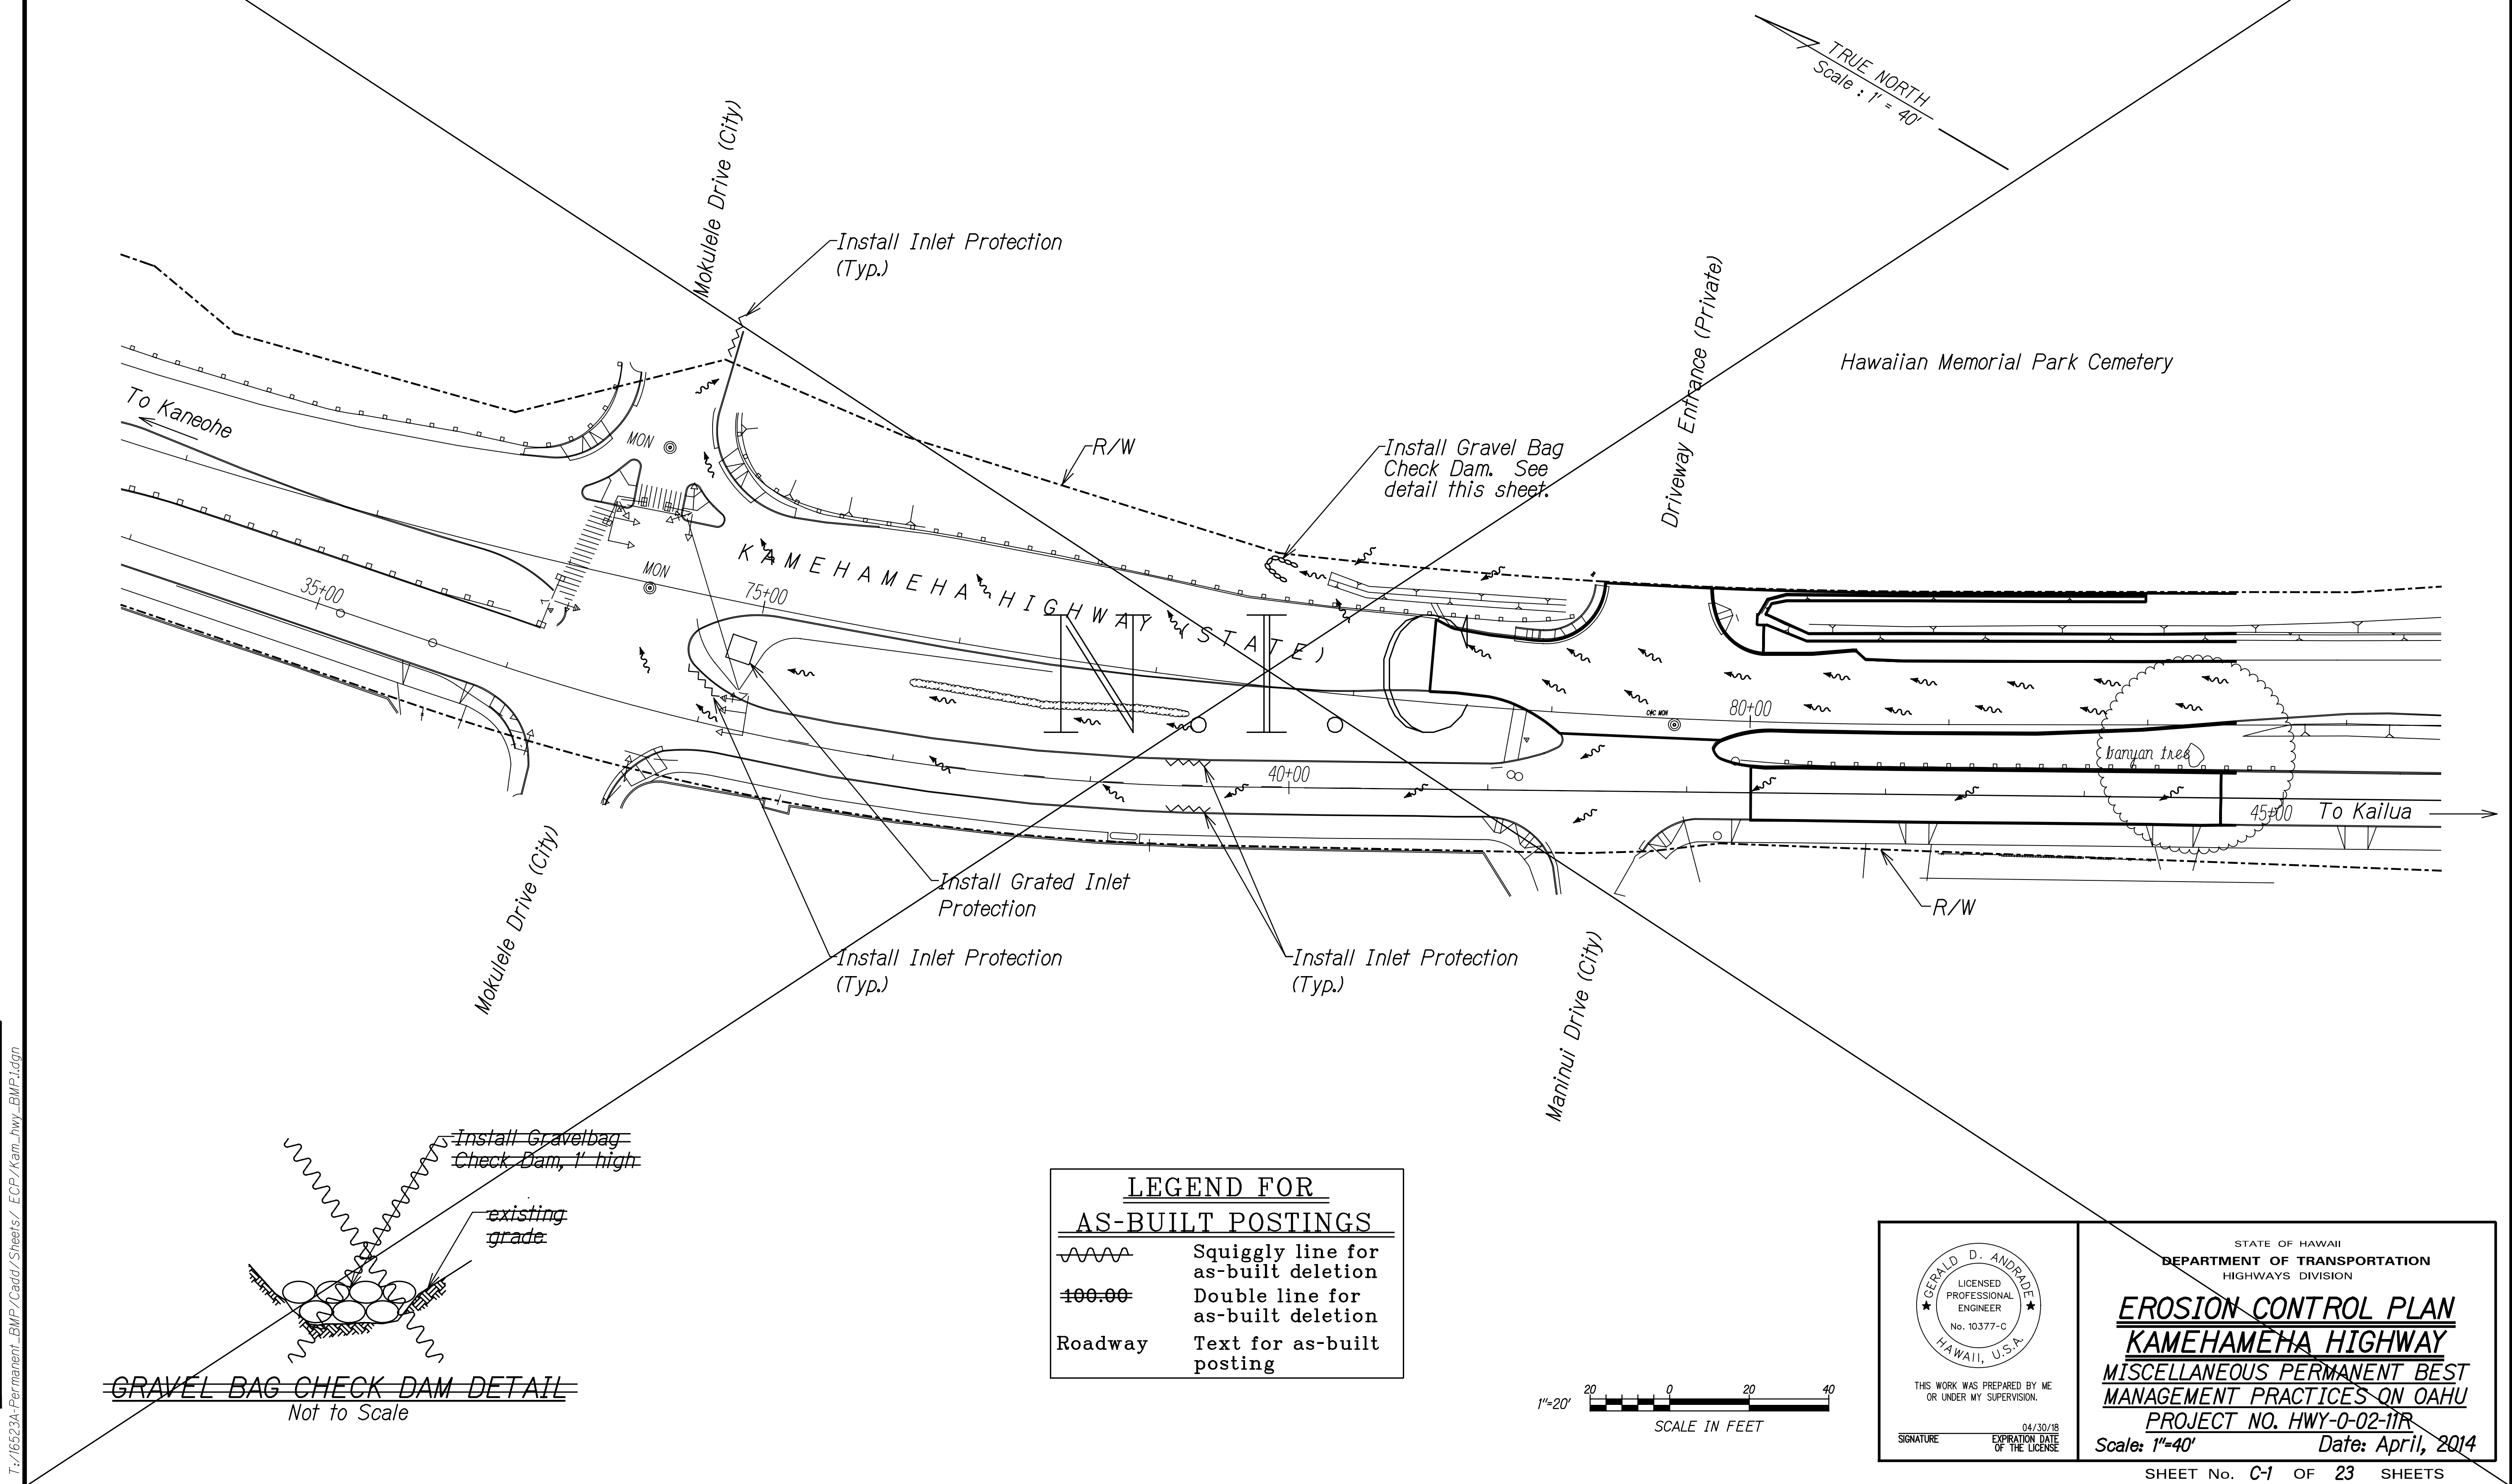

LEGEND FOR AS-BUILT POSTINGS	
	Squiggly line for as-built deletion
	Double line for as-built deletion
Roadway	Text for as-built posting

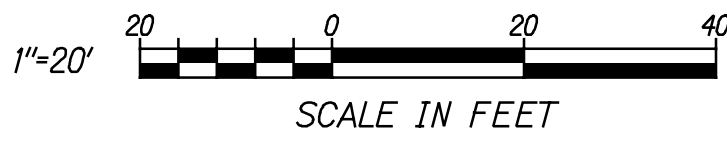

GERALD D. ANDRADE
LICENSED PROFESSIONAL ENGINEER
No. 10377-C
HAWAII, U.S.A.

THIS WORK WAS PREPARED BY ME OR UNDER MY SUPERVISION.
SIGNATURE: _____ EXPIRATION DATE OF THE LICENSE: 04/30/18

STATE OF HAWAII
DEPARTMENT OF TRANSPORTATION
HIGHWAYS DIVISION

EROSION CONTROL PLAN
KAMEHAMEHA HIGHWAY
MISCELLANEOUS PERMANENT BEST MANAGEMENT PRACTICES ON OAHU
PROJECT NO. HWY-0-02-11R
Scale: 1"=40' Date: April, 2014

SHEET No. C-1 OF 23 SHEETS

ORIGINAL PLAN	SURVEY PLOTTED BY	DATE
NOTE BOOK	DRAWN BY	
	DESIGNED BY	
	QUANTITIES BY	
	CHECKED BY	

T:\16523A-Permanent BMP\Cadd\Sheets\ ECP\Kam.hwy.BMP1.dgn