

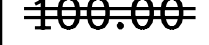
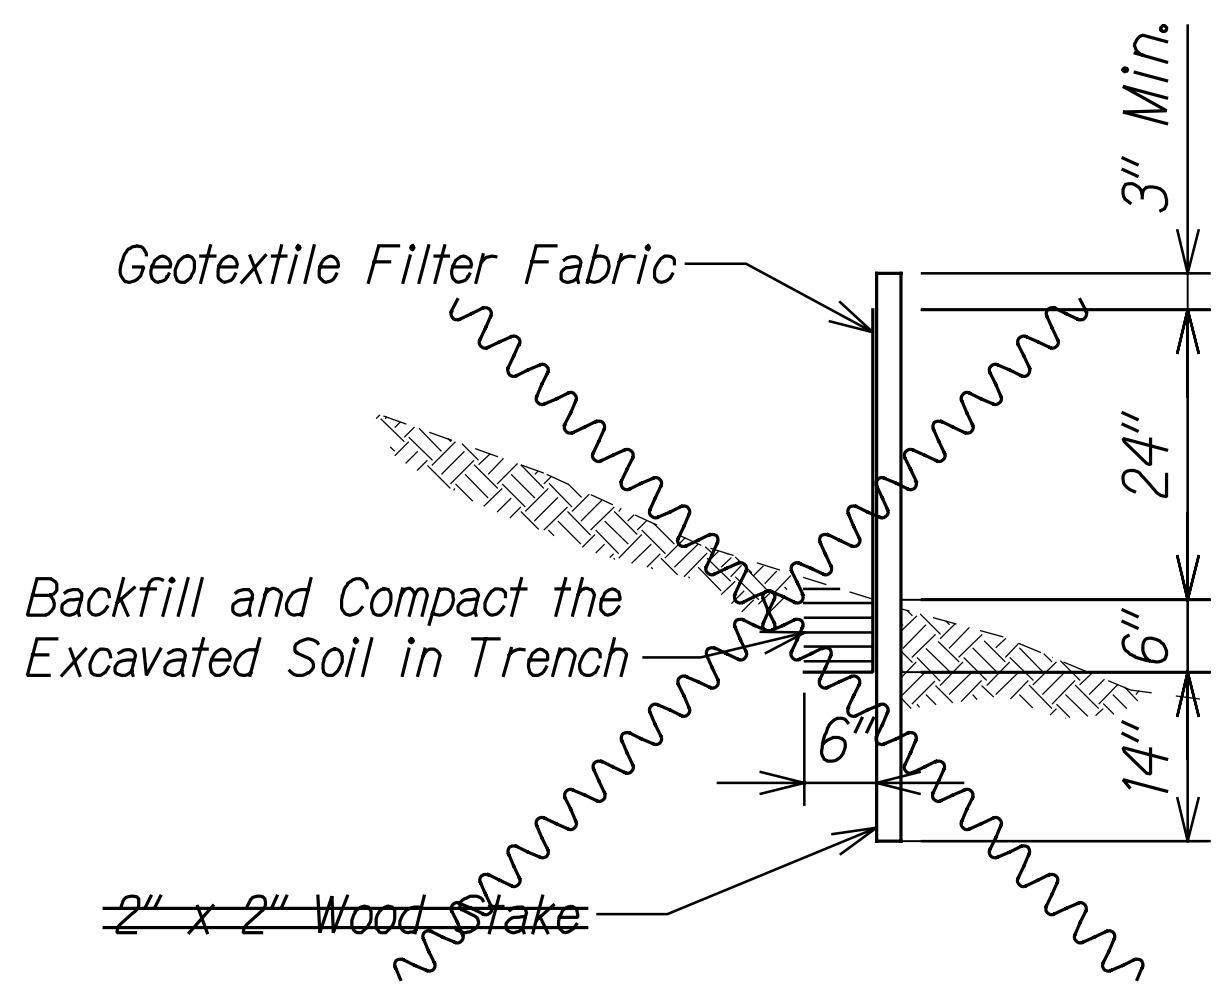


FED. ROAD DIST. NO.	STATE	PROJ. NO.	FISCAL YEAR	SHEET NO.	TOTAL SHEETS
HAWAII	HAW.	HWY-0-02-11R	2014	ADD. 14	43


LEGEND FOR AS-BUILT POSTINGS	
	Squiggly line for as-built deletion
	Double line for as-built deletion
Roadway	Text for as-built posting

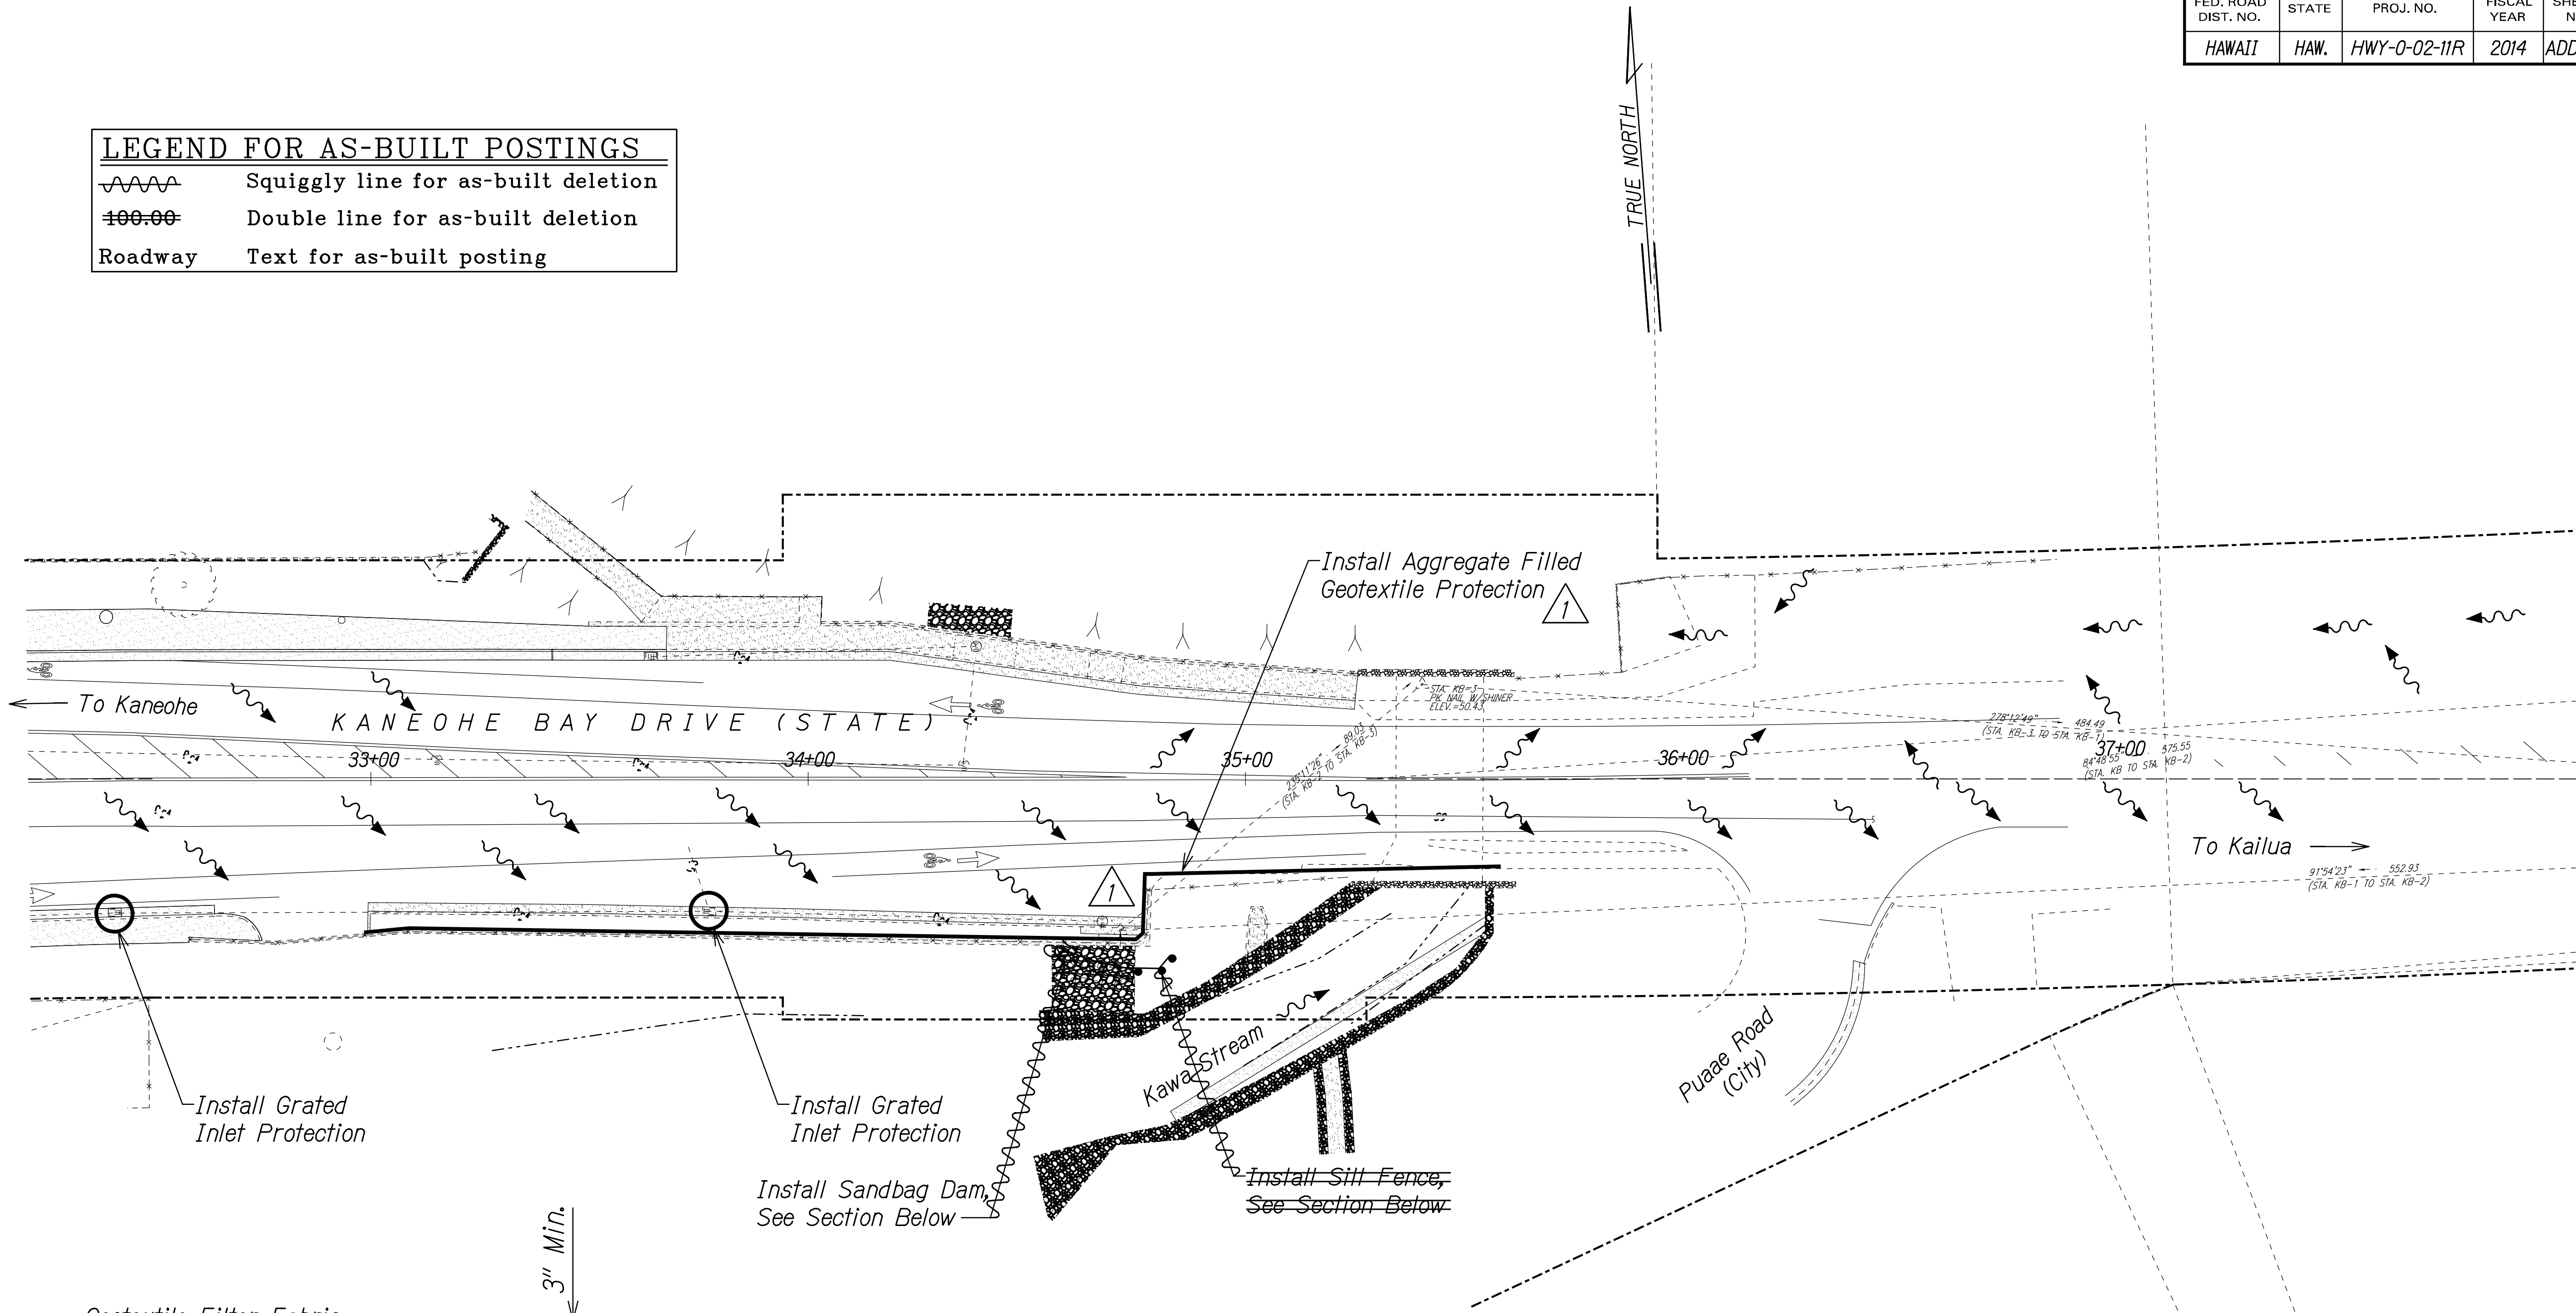


SILT FENCE SECTION
Scale: NTS

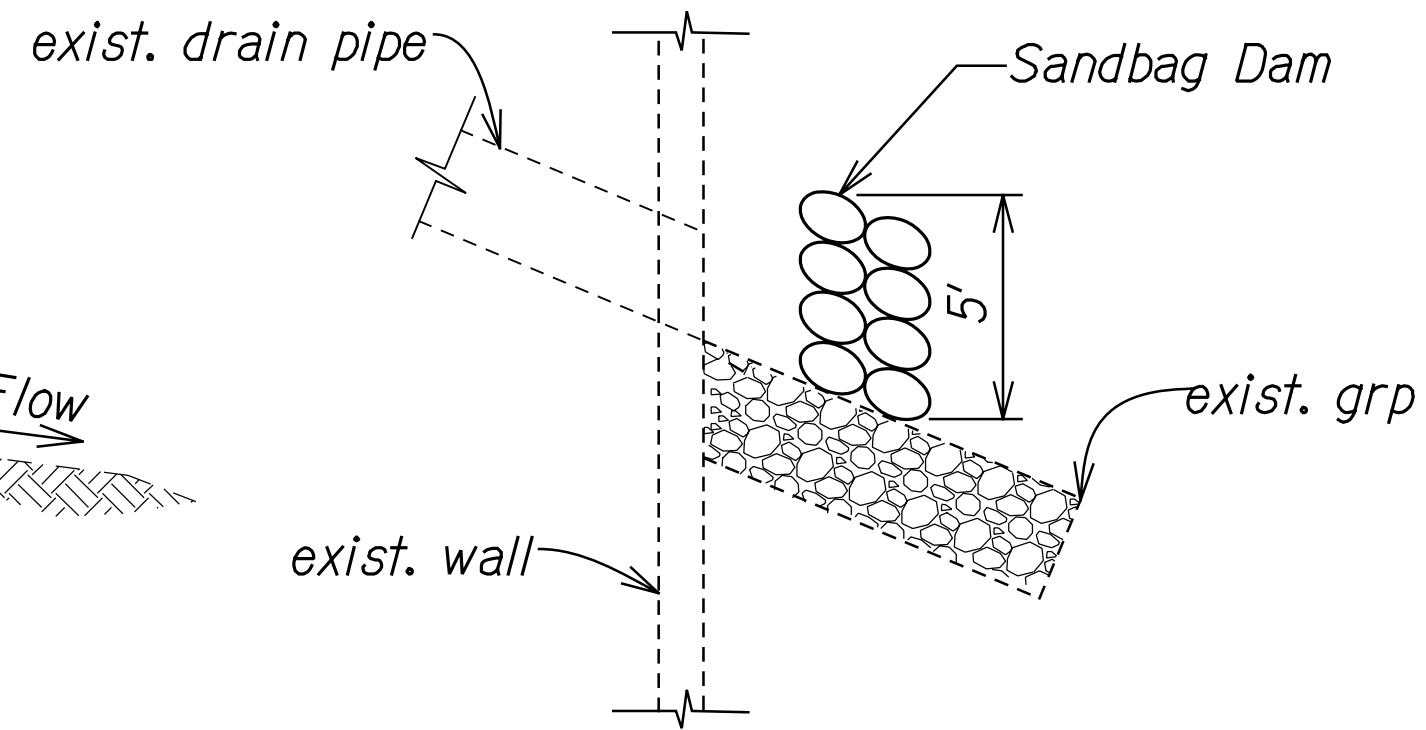

SANDBAG DAM SECTION
Scale: NTS

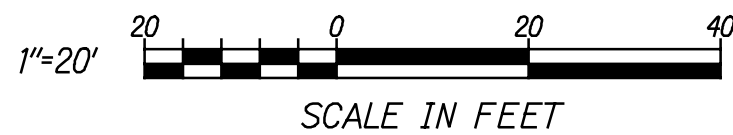

6/4/14	△ Revised Limits of Aggregate Filled Geotextile Protection
Date	Revision

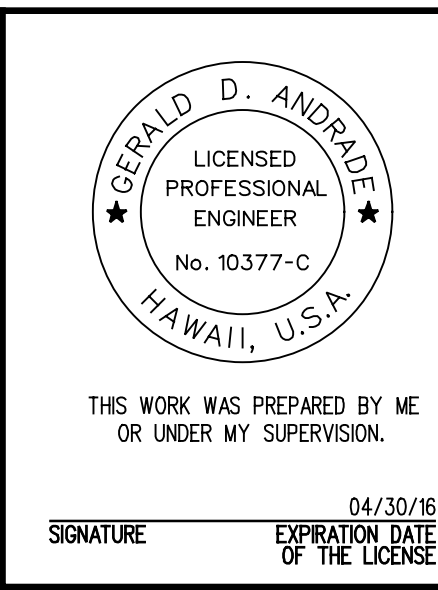

STATE OF HAWAII
DEPARTMENT OF TRANSPORTATION
HIGHWAYS DIVISION

EROSION CONTROL PLAN
KANEOHE BAY DRIVE
MISCELLANEOUS PERMANENT BEST
MANAGEMENT PRACTICES ON OAHU
PROJECT NO. HWY-0-02-11R

Scale: 1"=20' Date: April, 2014

SHEET No. C-2 OF 23 SHEETS

"AS-BUILT"

ADD. 14