
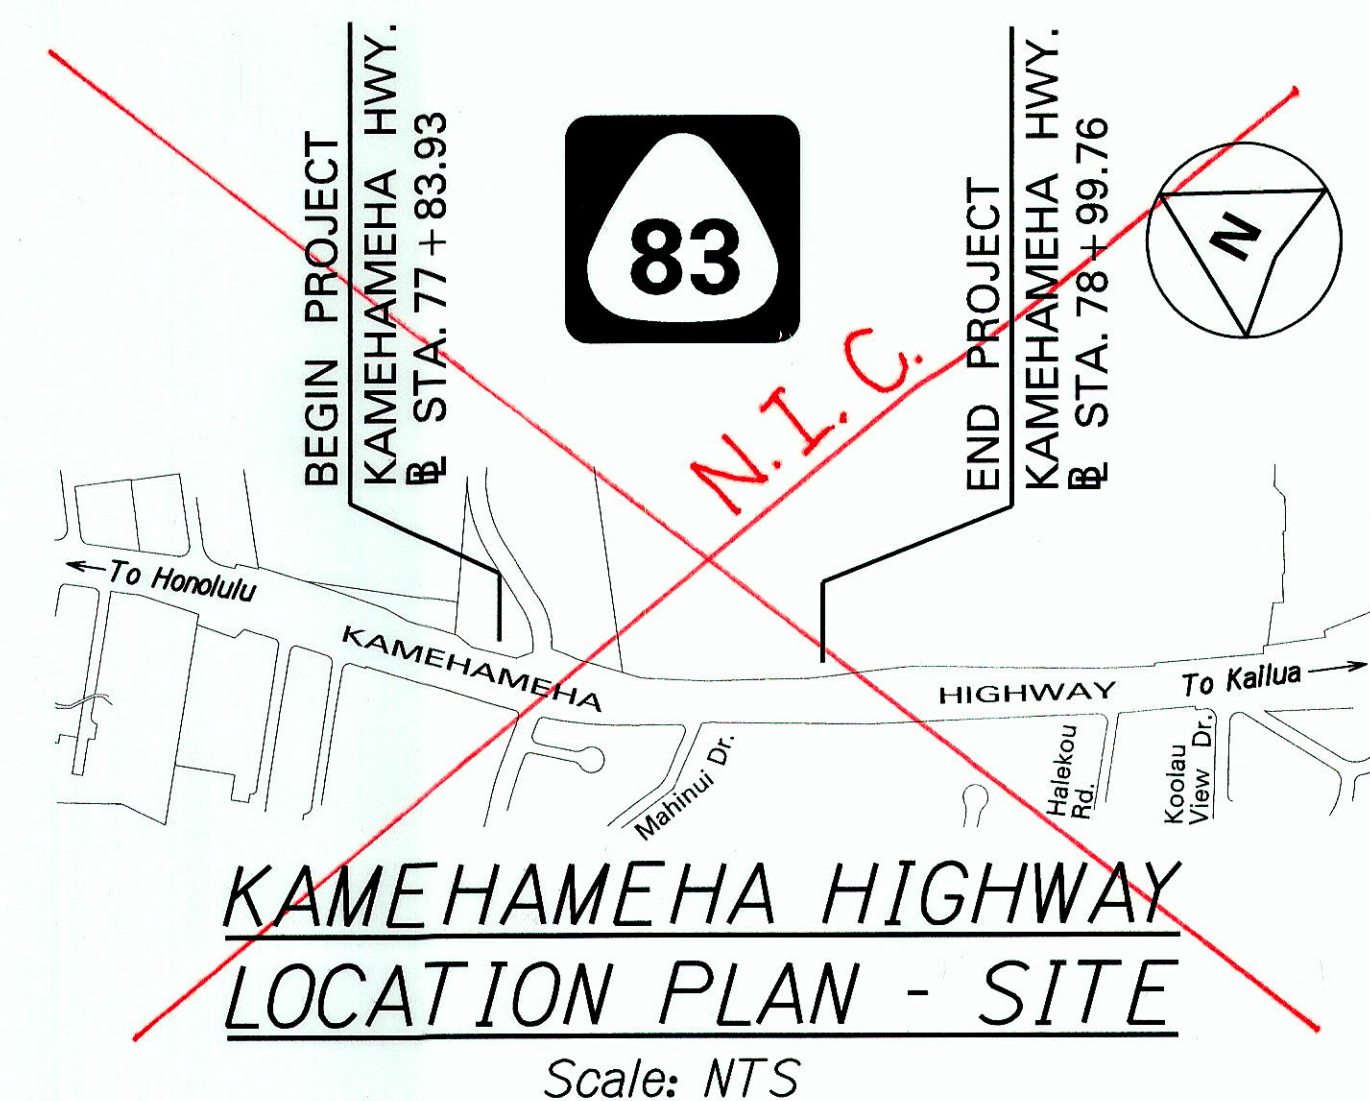
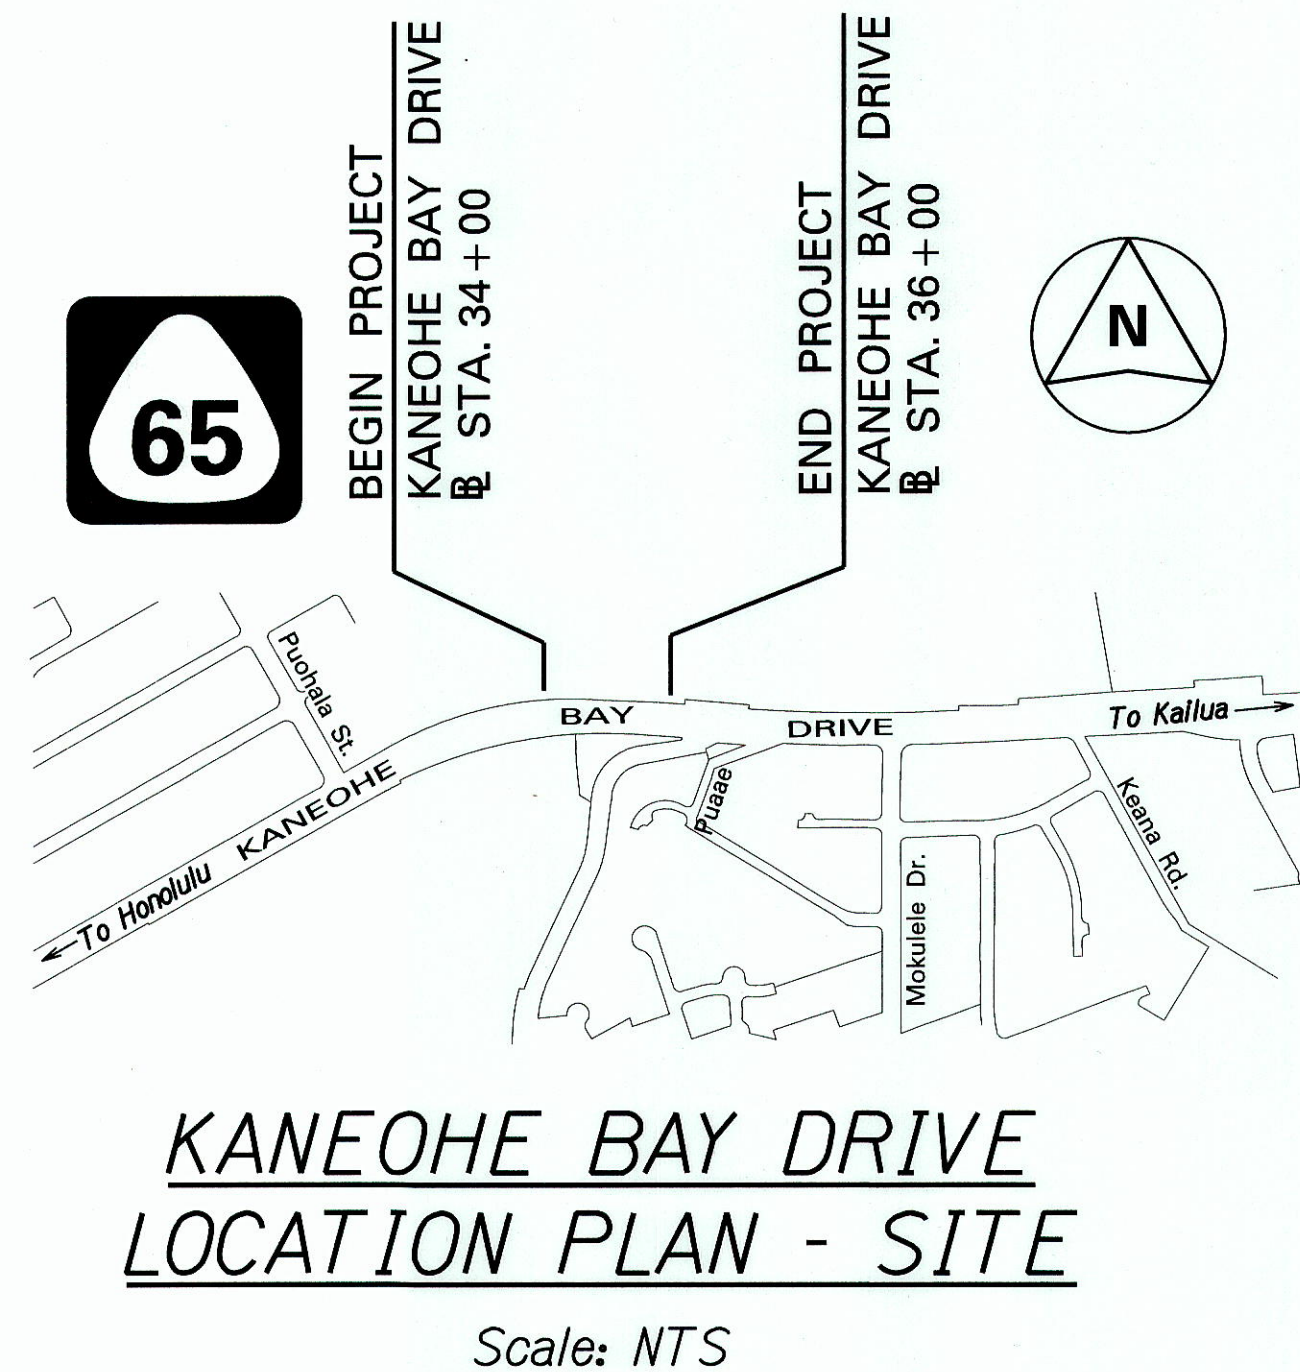


INDEX TO DRAWINGS	
SHEET NO.	DESCRIPTION
1	TITLE SHEET
2	STANDARD PLANS SUMMARY
3	GENERAL NOTES, LEGEND, AND ABBREVIATIONS
① 4	GRADING NOTES
5 - 8	UTILITY NOTES
9 - 11	WATER POLLUTION AND EROSION CONTROL NOTES
12	BEST MANAGEMENT PRACTICE NOTES AND DETAILS
② 13	EROSION CONTROL PLAN - KAMEHAMEHA HIGHWAY
③ 14	EROSION CONTROL PLAN - KANEOHE BAY DRIVE
④ 15 - 16	BIOSWALE TYPICAL SECTION
⑤ 17 - 21	BIOSWALE PLANS - INTERSTATE ROUTE H-3
⑥ 22 - 29	BIOSWALE PROFILES - INTERSTATE ROUTE H-3
⑦ 30	BIOSWALE PLAN AND PROFILE - KAMEHAMEHA HIGHWAY
⑧ 31	KAHEOHE BAY DRIVE BMP RETROFIT PLAN
⑨ 32	KAHEOHE BAY DRIVE BMP RETROFIT SECTIONS
33	KAHEOHE BAY DRIVE BMP RETROFIT DETAILS
⑩ 34 - 35	BIOSWALE DETAILS
36	FREEWAY WORK ZONE SIGNING PLAN, NOTES & DETAILS
37	LOW SPEED UNDIVIDED HIGHWAY WORK ZONE SIGNING PLAN, NOTES & DETAILS
38 - 39	TRAFFIC CONTROL PLANS INTERSTATE ROUTE H-3
40 - 42	TRAFFIC CONTROL PLANS - KAMEHAMEHA HIGHWAY
43	TRAFFIC CONTROL PLANS - KANEOHE BAY DRIVE

Sheet Nos. ① C.O. 4, ② 13, ③ ADD. 14, ④ C.O. 15 - C.O. 16, ⑤ C.O. 17 to C.O. 21, ⑥ 23-24, 25-26, 28-29, ⑦ 30, ⑧ C.O. 31, C.O. 31S-1 to C.O. 31S-5, ⑨ 32, ⑩ 34; are Supplementary Sheets to this Project. Total Sheet Count After AS-BUILT Pasting 49 Sheets.

ORIGINAL PLAN	SURVEY PLOTTED BY	DATE
NOTE BOOK	DRAWN BY	
	DESIGNED BY	
	CHECKED BY	

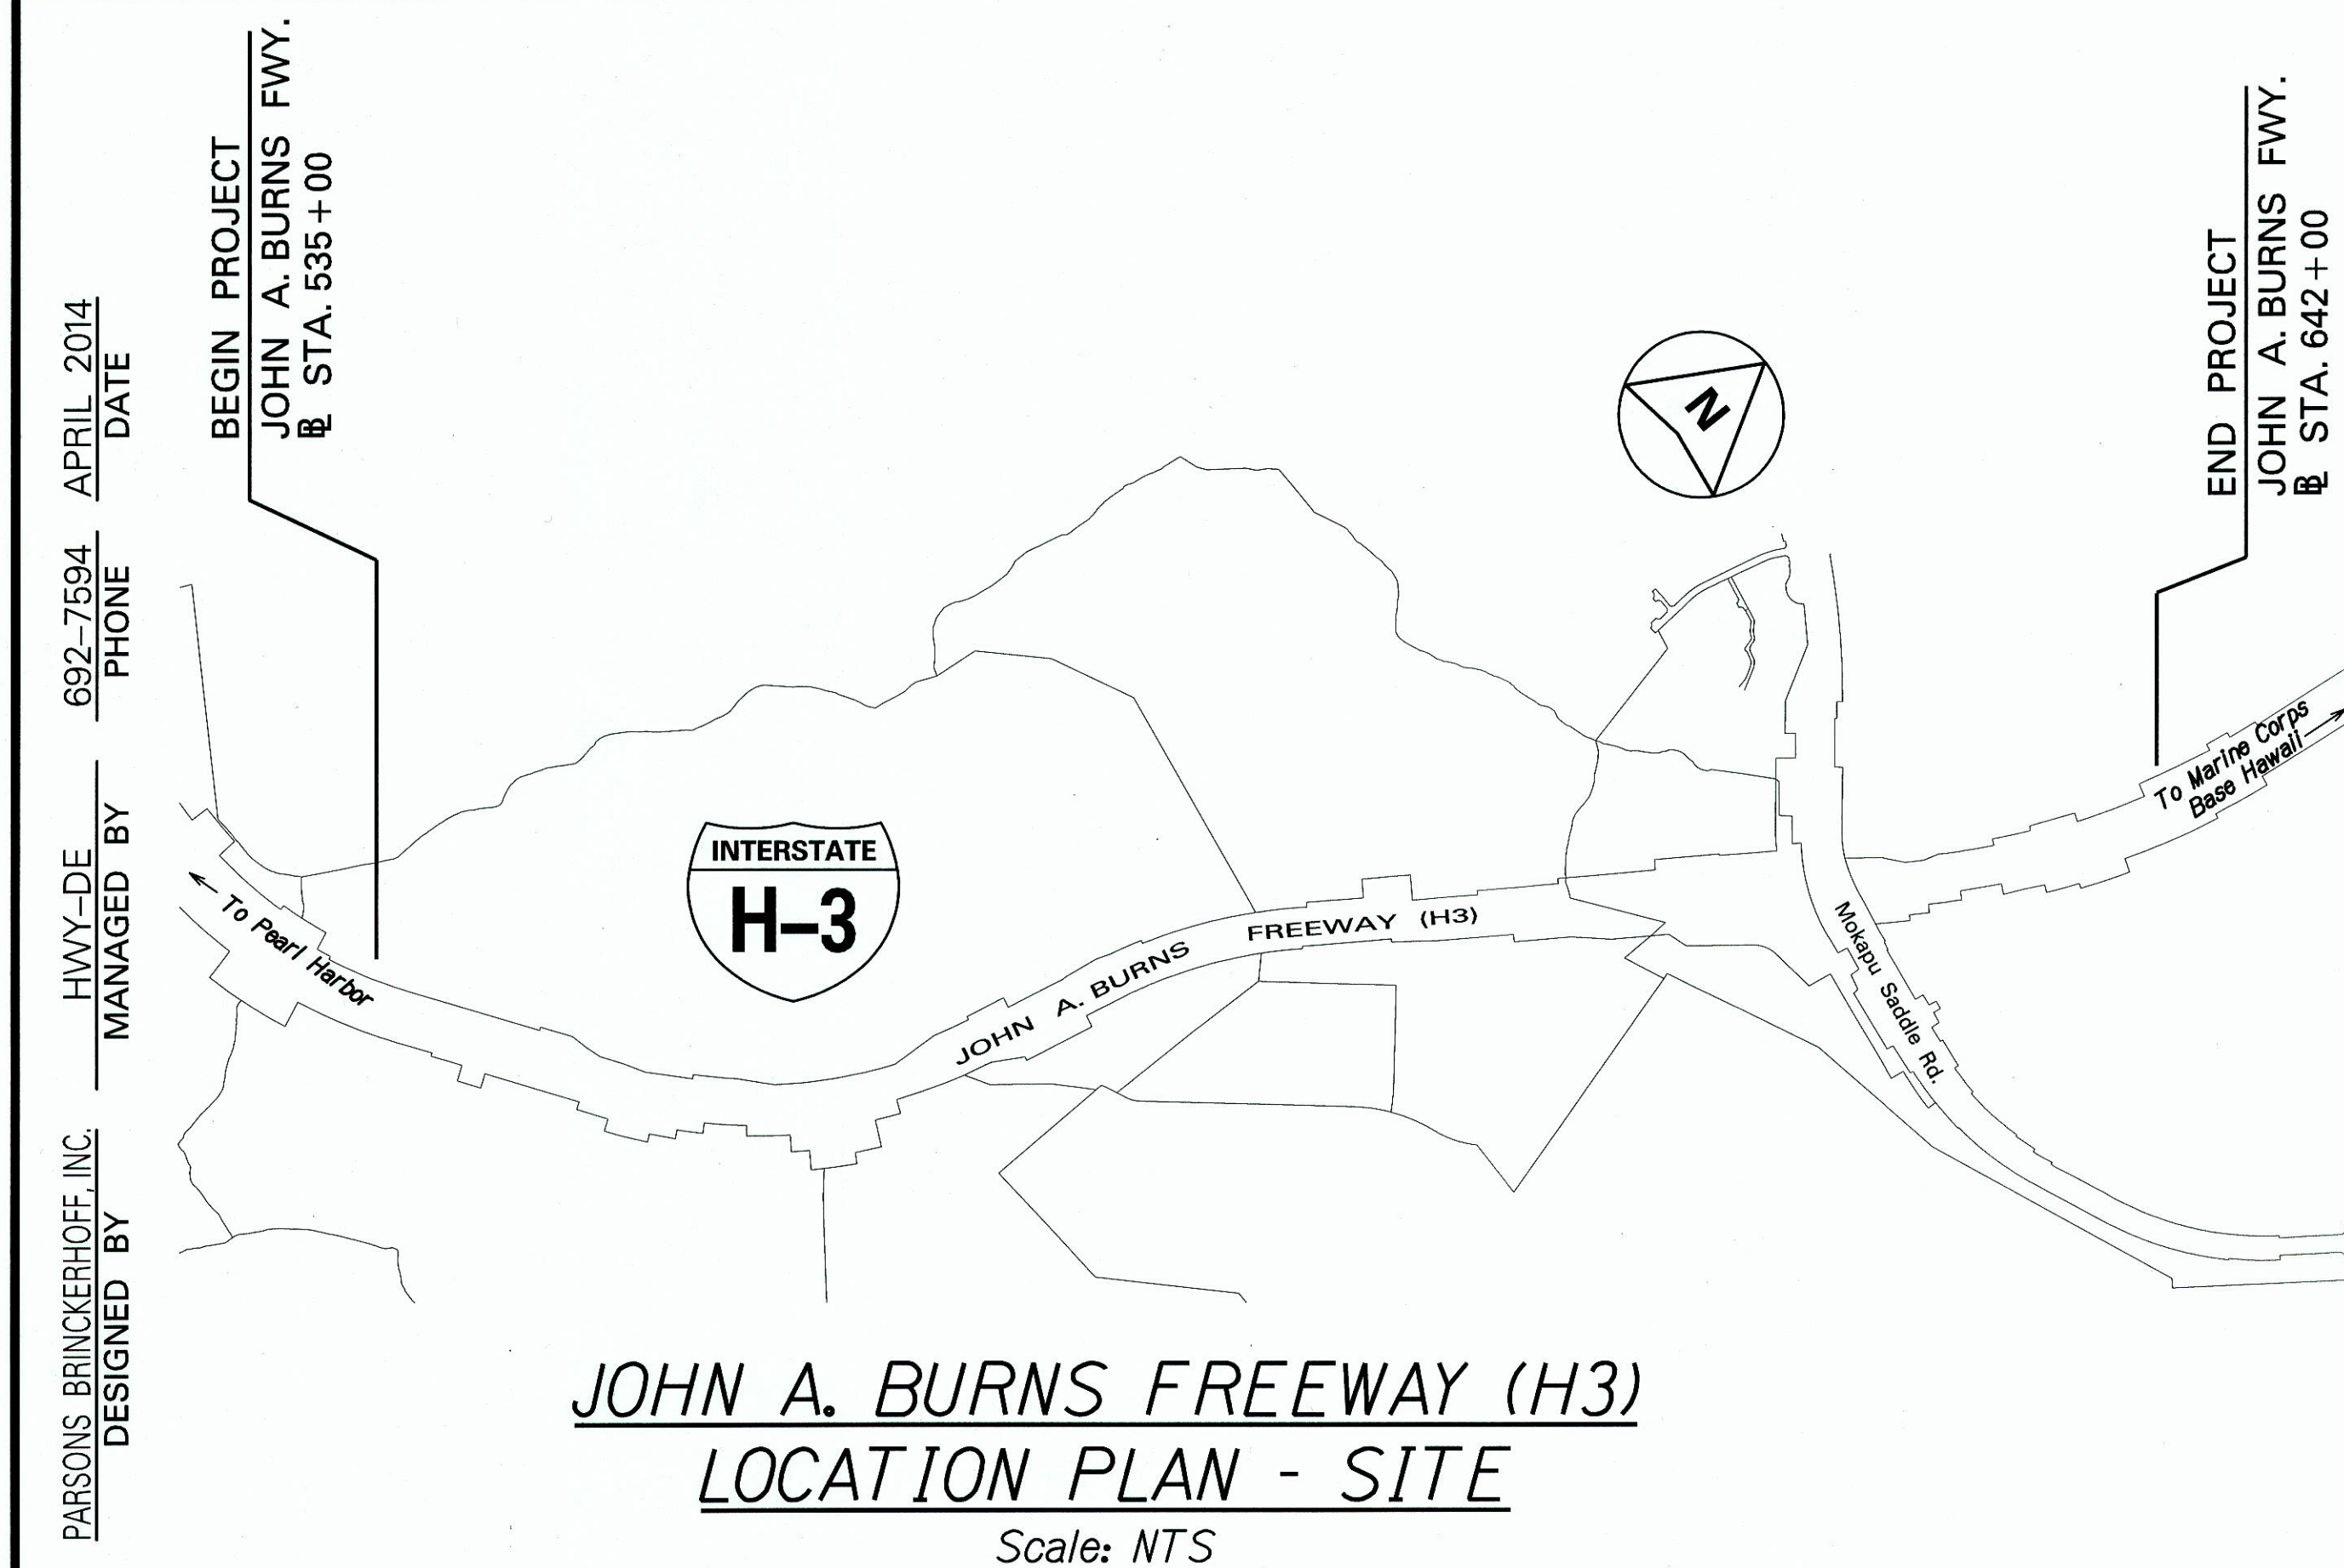


CHANGES MADE DURING CONSTRUCTION HAVE BEEN INCORPORATED ON THESE PLANS EXCEPT CHANGES IN THE ORIGINAL THEORETICAL QUANTITIES. FOR ACTUAL QUANTITIES, REFER TO PROJECT LEDGER AND/OR COMPUTATION BOOK.

RESIDENT ENGINEER
DATE 9/29/20

DEPARTMENT OF TRANSPORTATION
STATE OF HAWAII

APPROVED:
for DIR. OF TRANSPORTATION
DATE 4/03/14

STATE OF HAWAII
DEPARTMENT OF TRANSPORTATION
HIGHWAYS DIVISION
HONOLULU, HAWAII
"AS-BUILT"
PLANS FOR
**MISCELLANEOUS PERMANENT
BEST MANAGEMENT PRACTICES
ON OAHU**
PROJECT NO. HWY-O-02-11R
DISTRICT OF KOOLAUPOKO
ISLAND OF OAHU

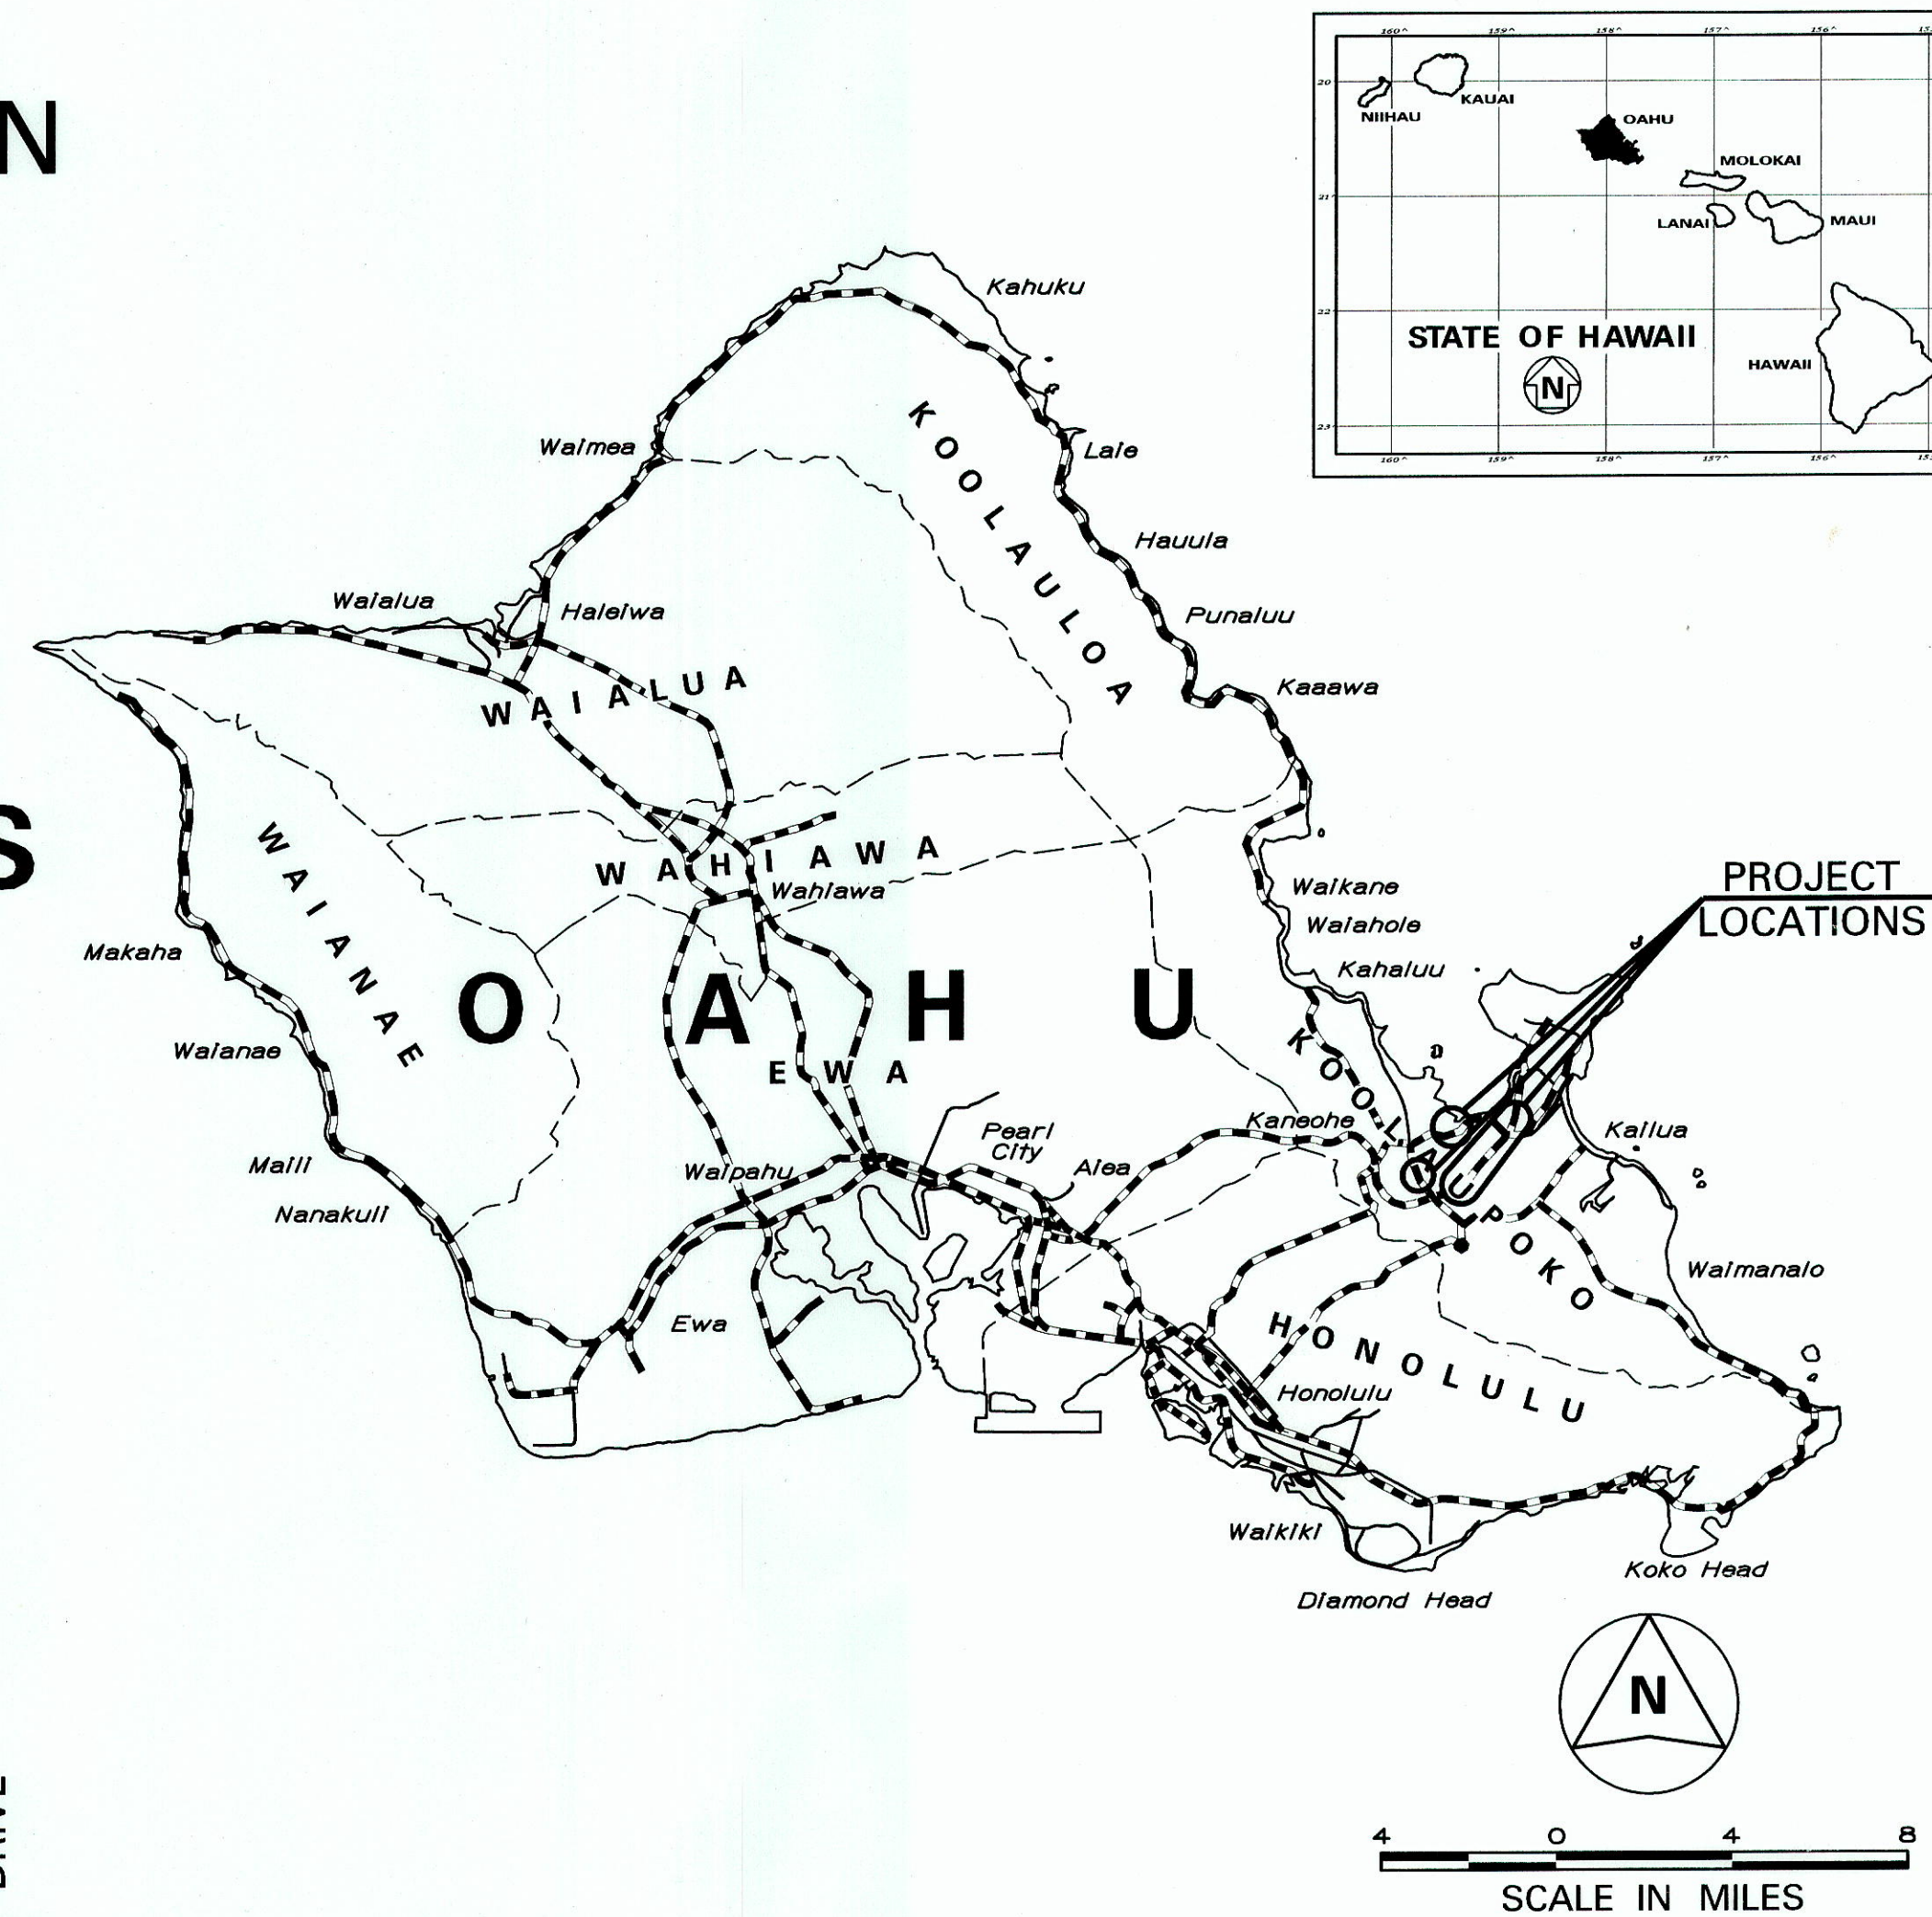

FED. ROAD DIST. NO.	STATE	PROJ. NO.	FISCAL YEAR	SHEET NO.	TOTAL SHEETS
HAWAII	HAW.	HWY-O-02-11R	2014	1	43

