

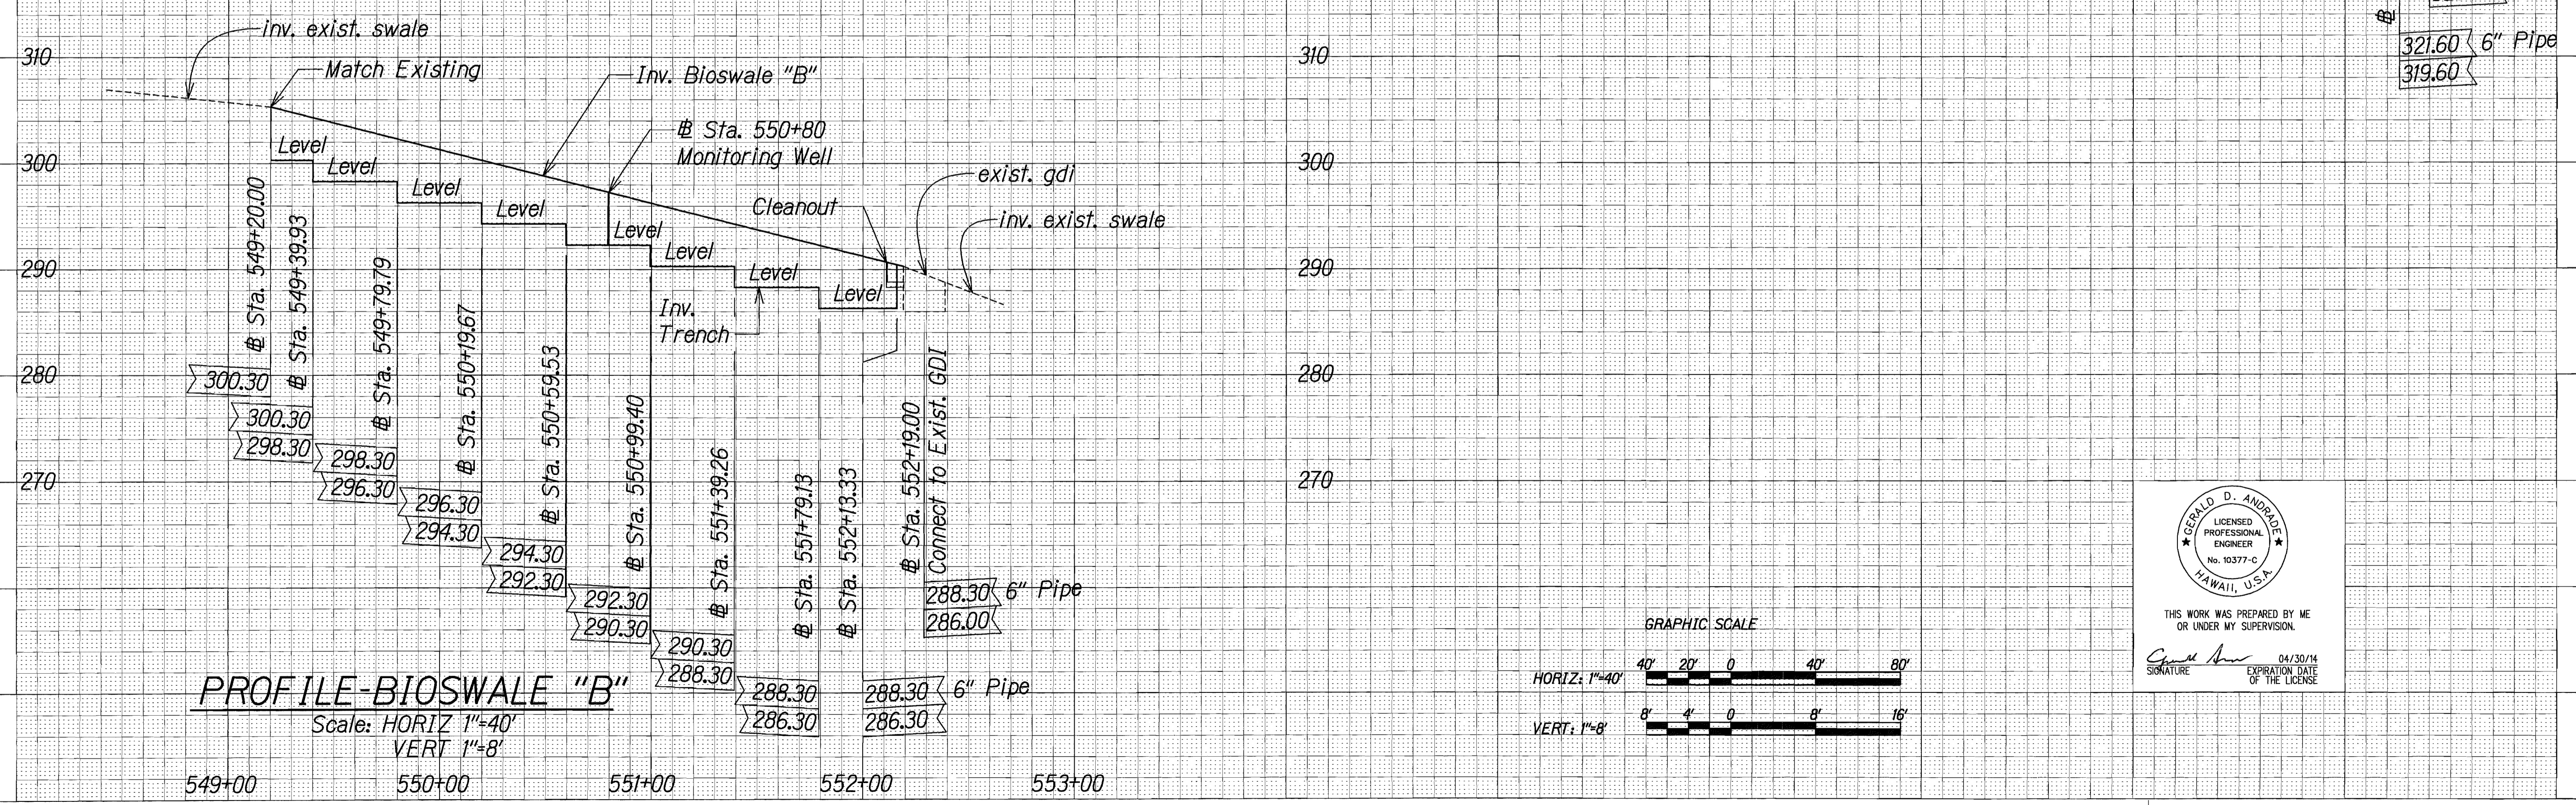


FED. ROAD DIST. NO.	STATE	PROJ. NO.	FISCAL YEAR	SHEET NO.	TOTAL SHEETS
HAWAII	HAW.	HWY-0-02-11	2012	22	43

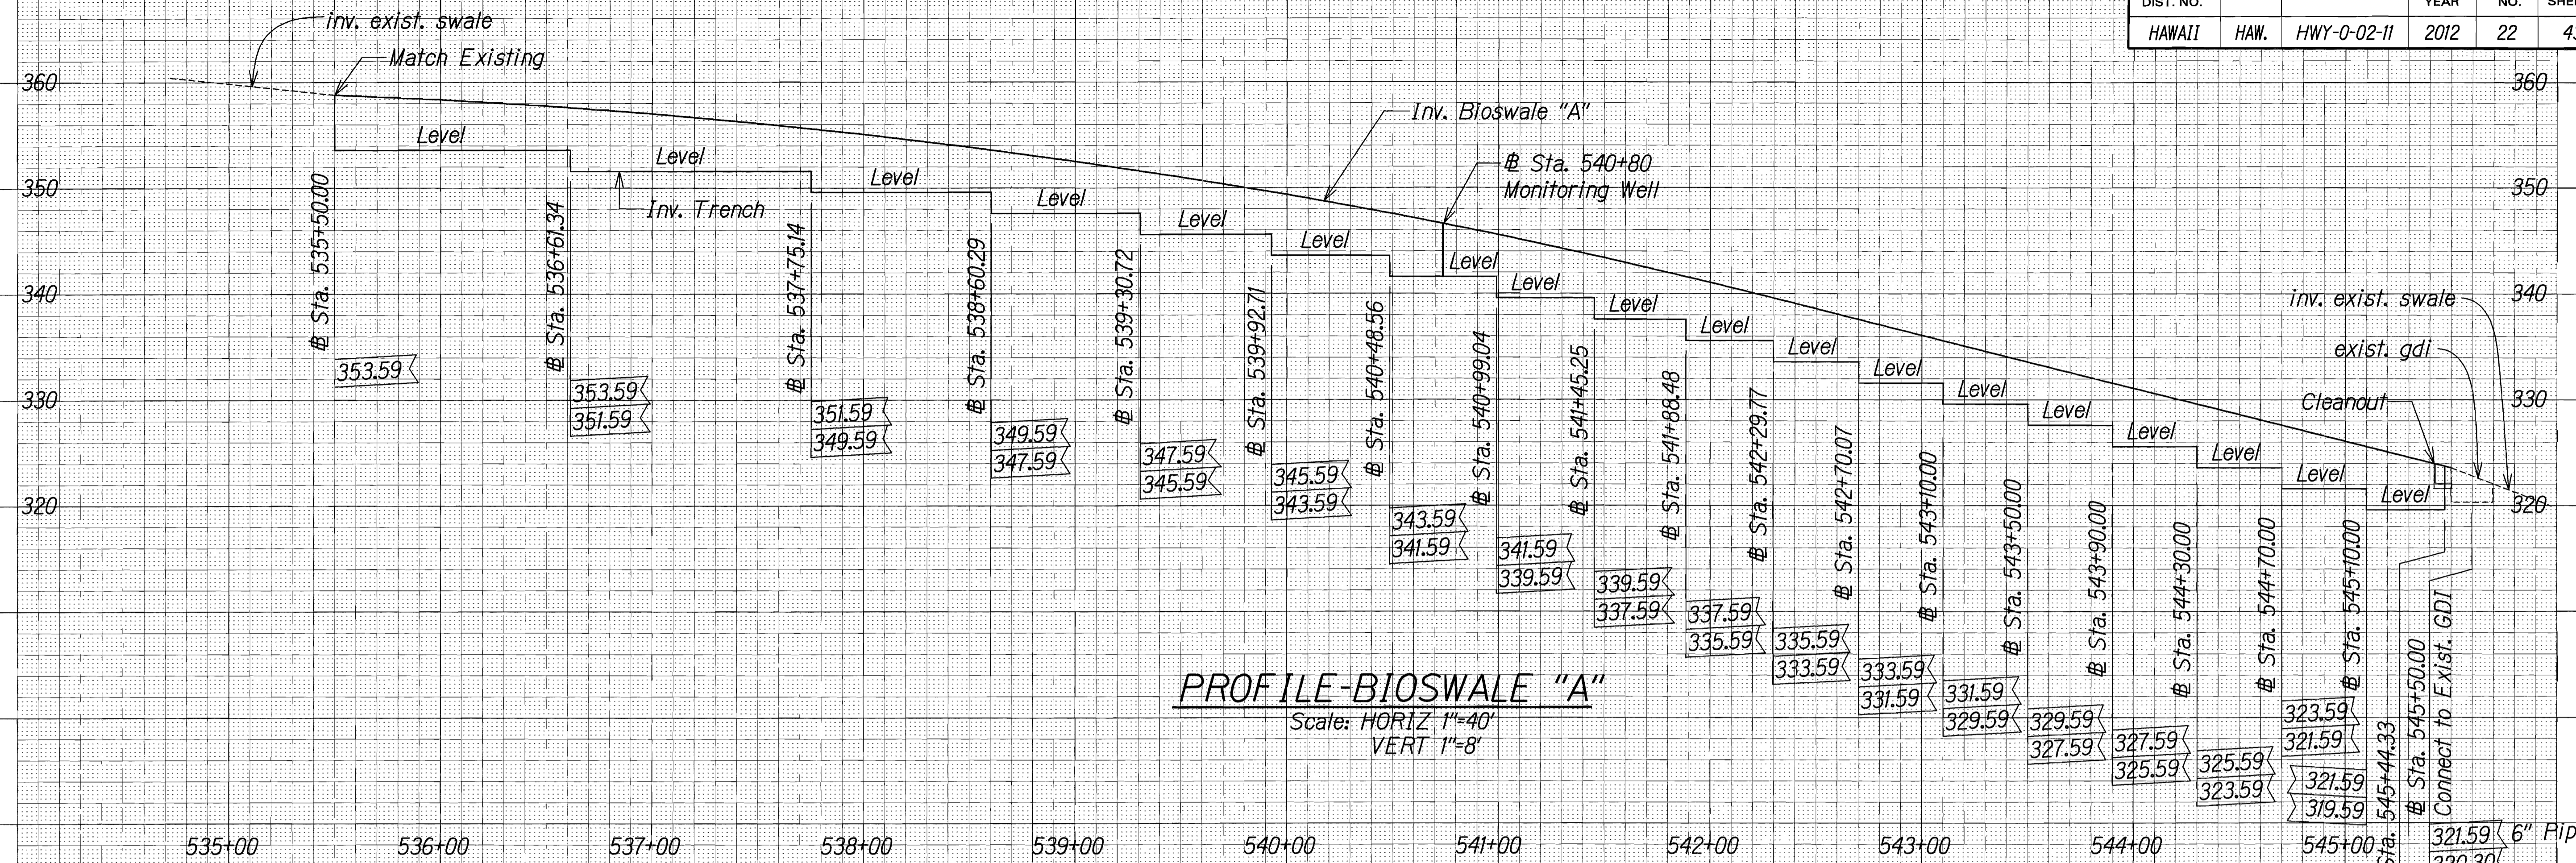

ORIGINAL PLAN	DATE
DRAWN BY	
TRACED BY	
DESIGNED BY	
QUANTITIES BY	
CHECKED BY	
NO.	




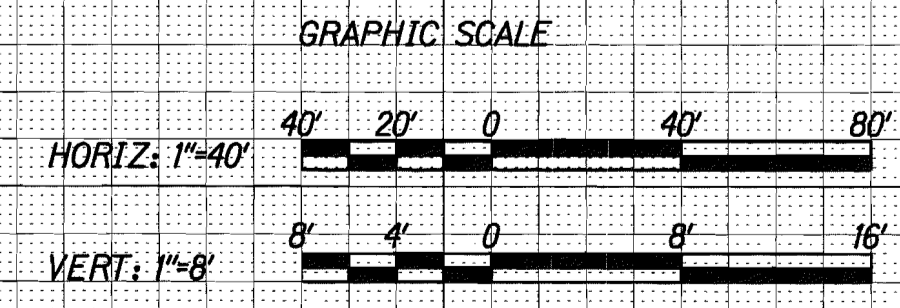


GERALD D. ANDRZEJ
LICENSED PROFESSIONAL ENGINEER
No. 10377-C
HAWAII, U.S.A.

THIS WORK WAS PREPARED BY ME OR UNDER MY SUPERVISION.

Signature: *Gerald D. Andrzej*
EXPIRATION DATE OF THE LICENSE: 04/30/14


FED. ROAD DIST. NO.	STATE	PROJ. NO.	FISCAL YEAR	SHEET NO.	TOTAL SHEETS
HAWAII	HAW.	HWY-0-02-11	2012	23	43

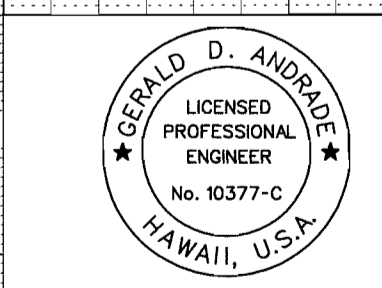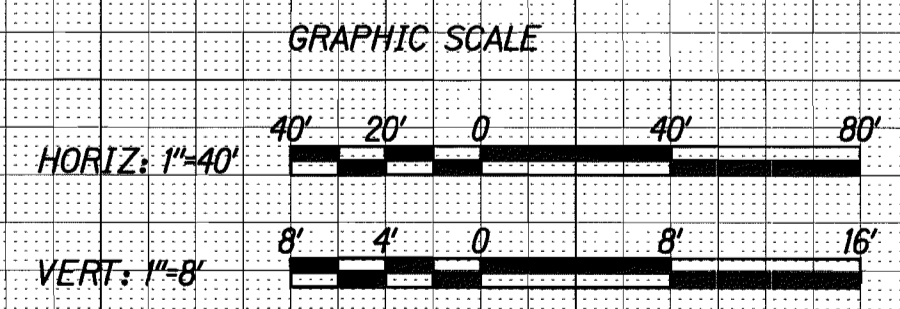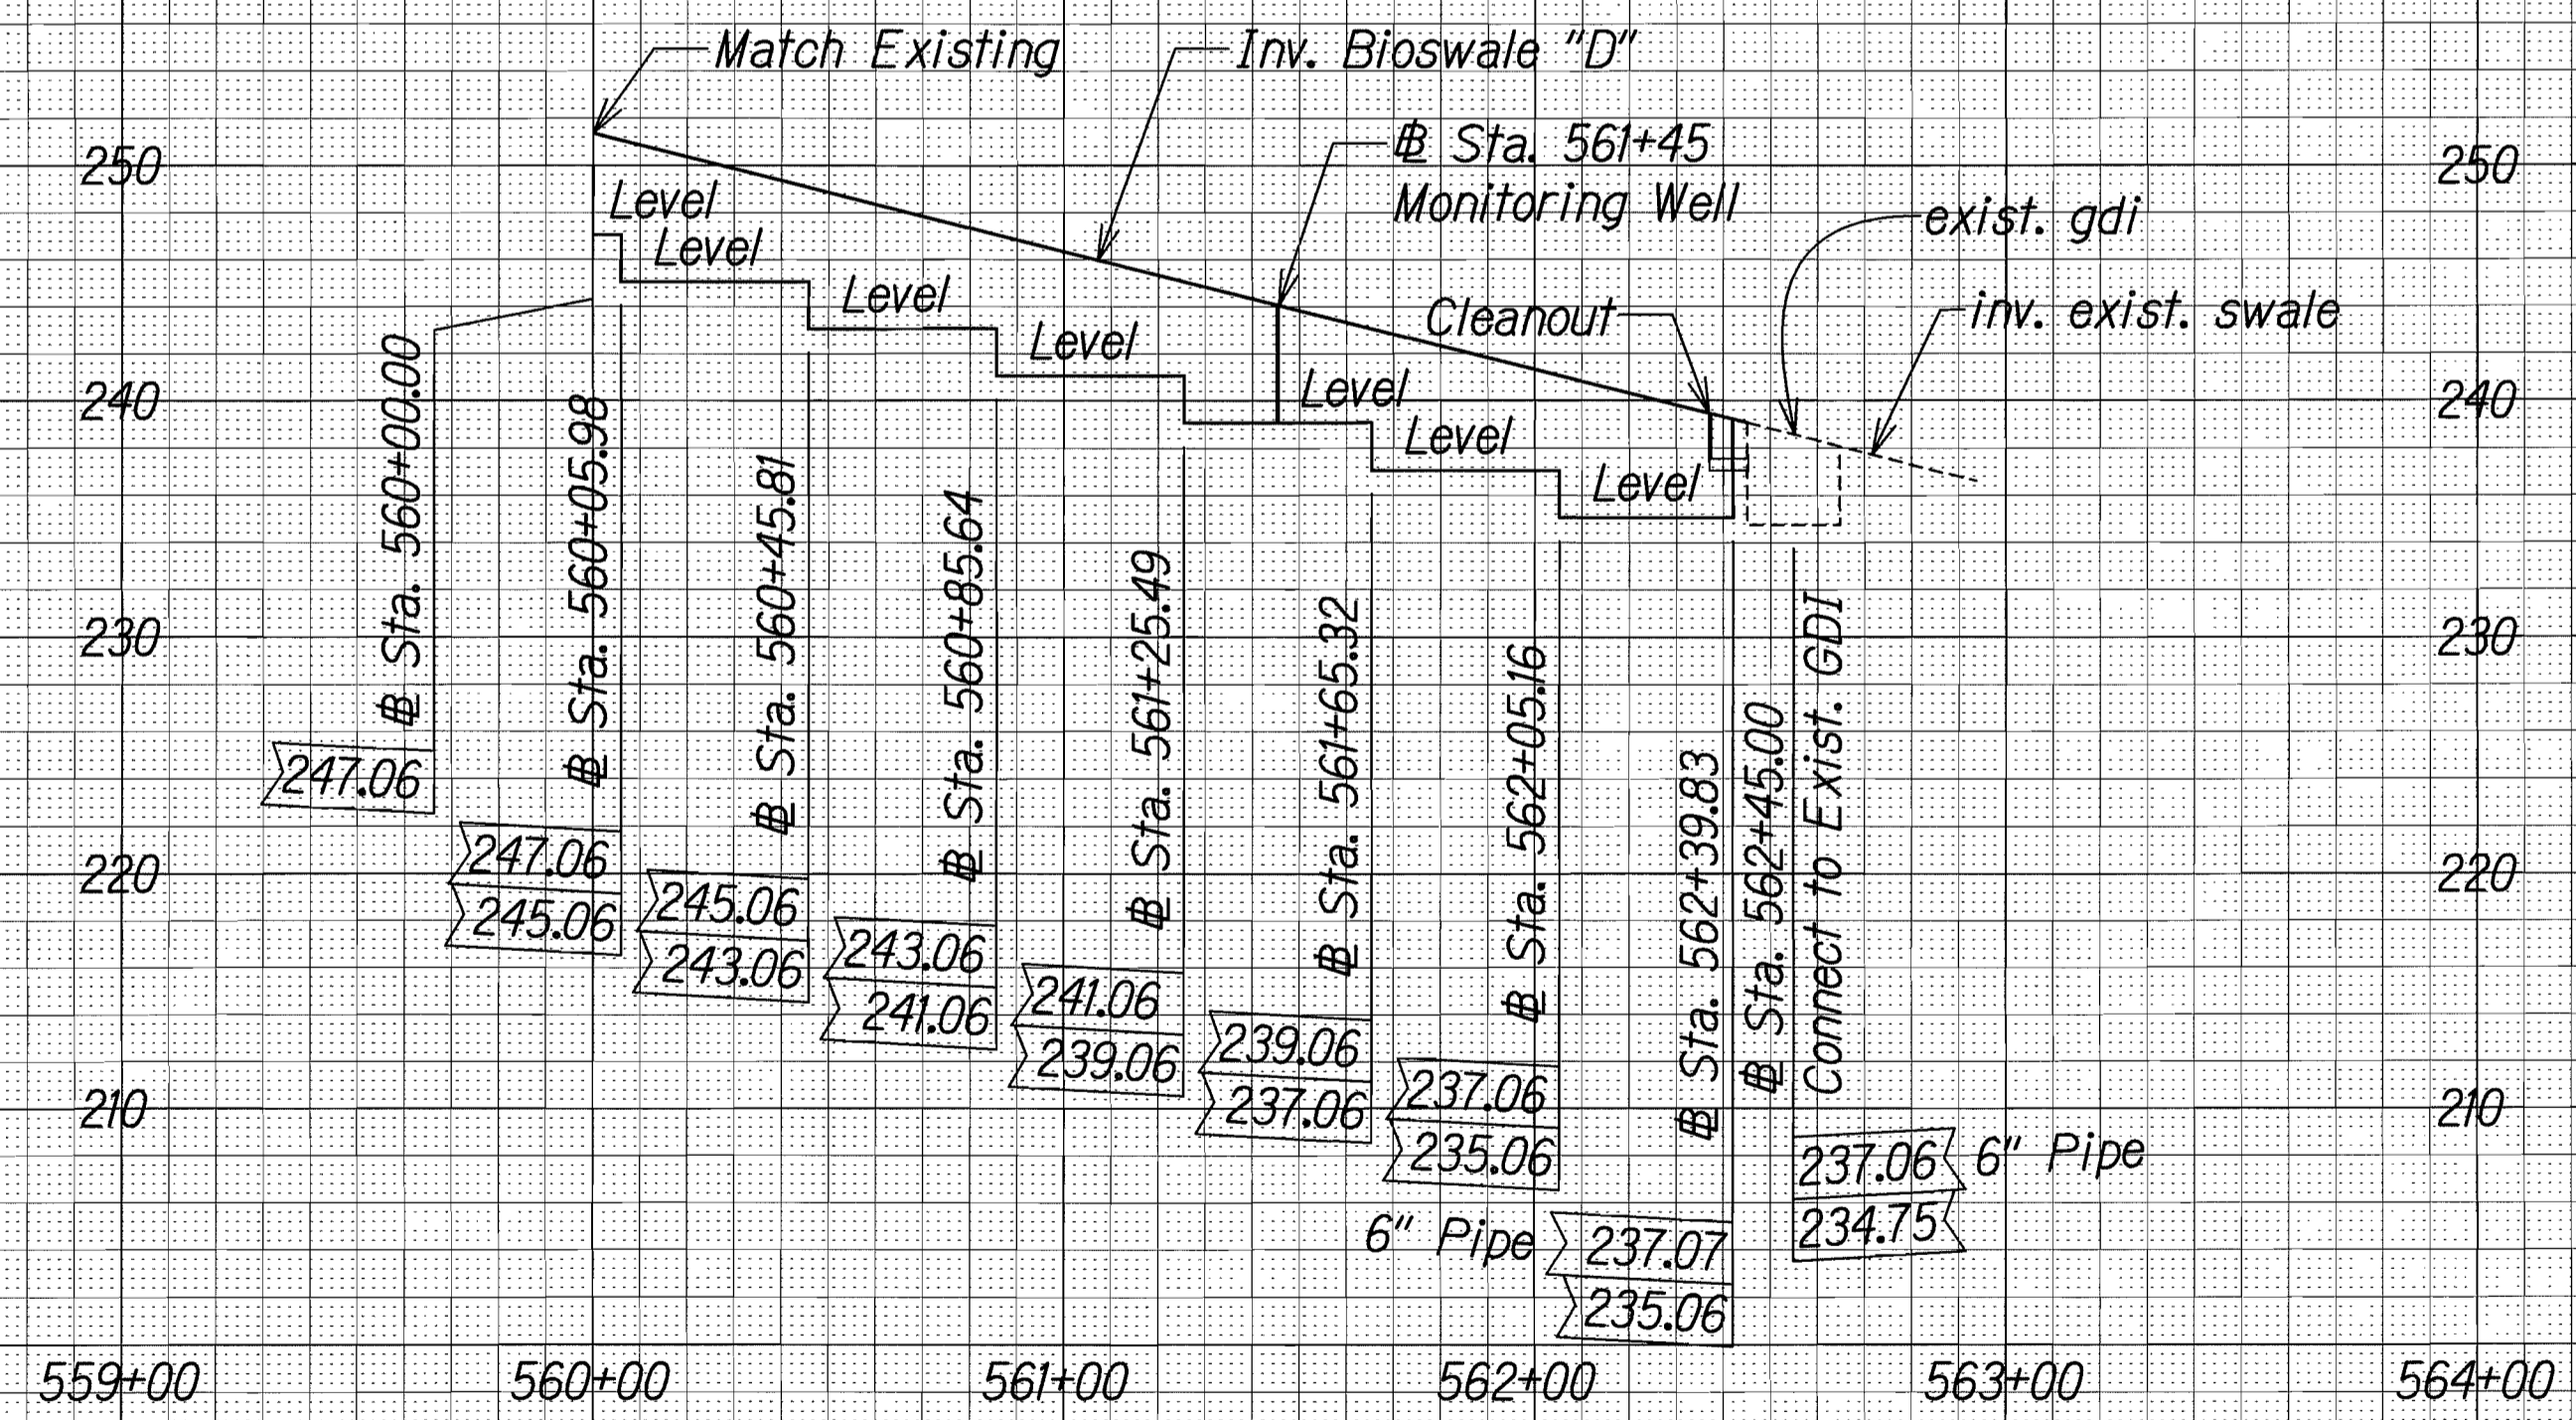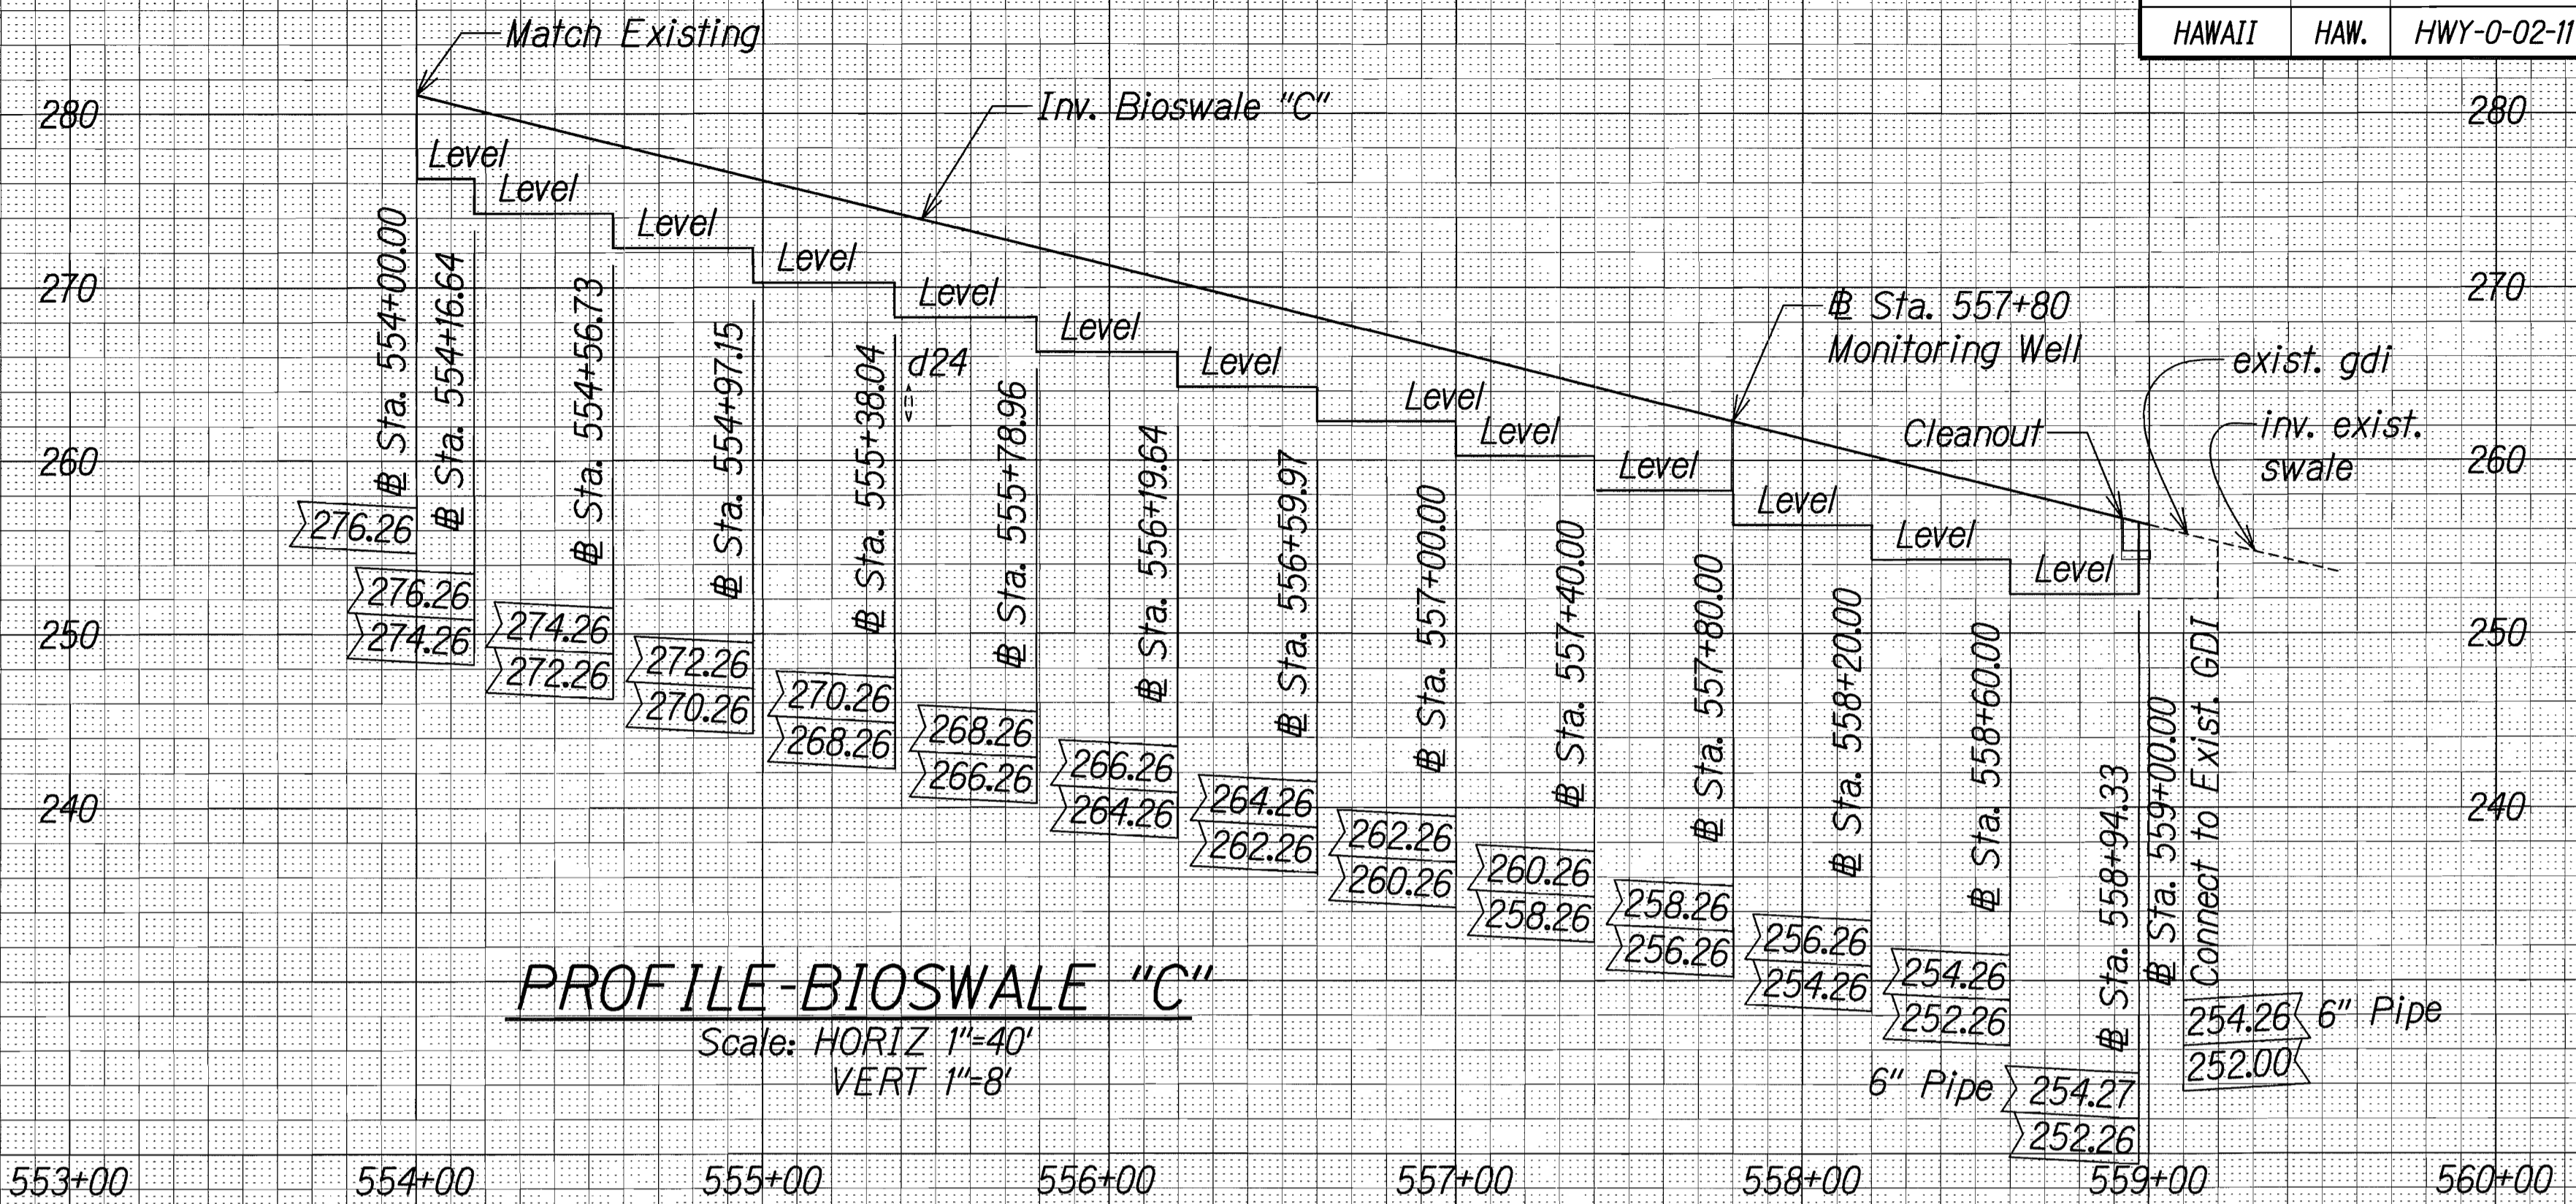

THIS WORK WAS PREPARED BY ME OR UNDER MY SUPERVISION.
SIGNATURE: *Gerald D. Andrade*
EXPIRATION DATE OF THE LICENSE: 04/30/14

SURVEY PLOTTED BY	DATE
DRAWN BY	
DESIGNED BY	
QUANTITIES BY	
CHECKED BY	
ORIGINAL PLAN	
NOTE BOOK	
N.	


FED. ROAD DIST. NO.	STATE	PROJ. NO.	FISCAL YEAR	SHEET NO.	TOTAL SHEETS
HAWAII	HAW.	HWY-0-02-11	2012	24	43

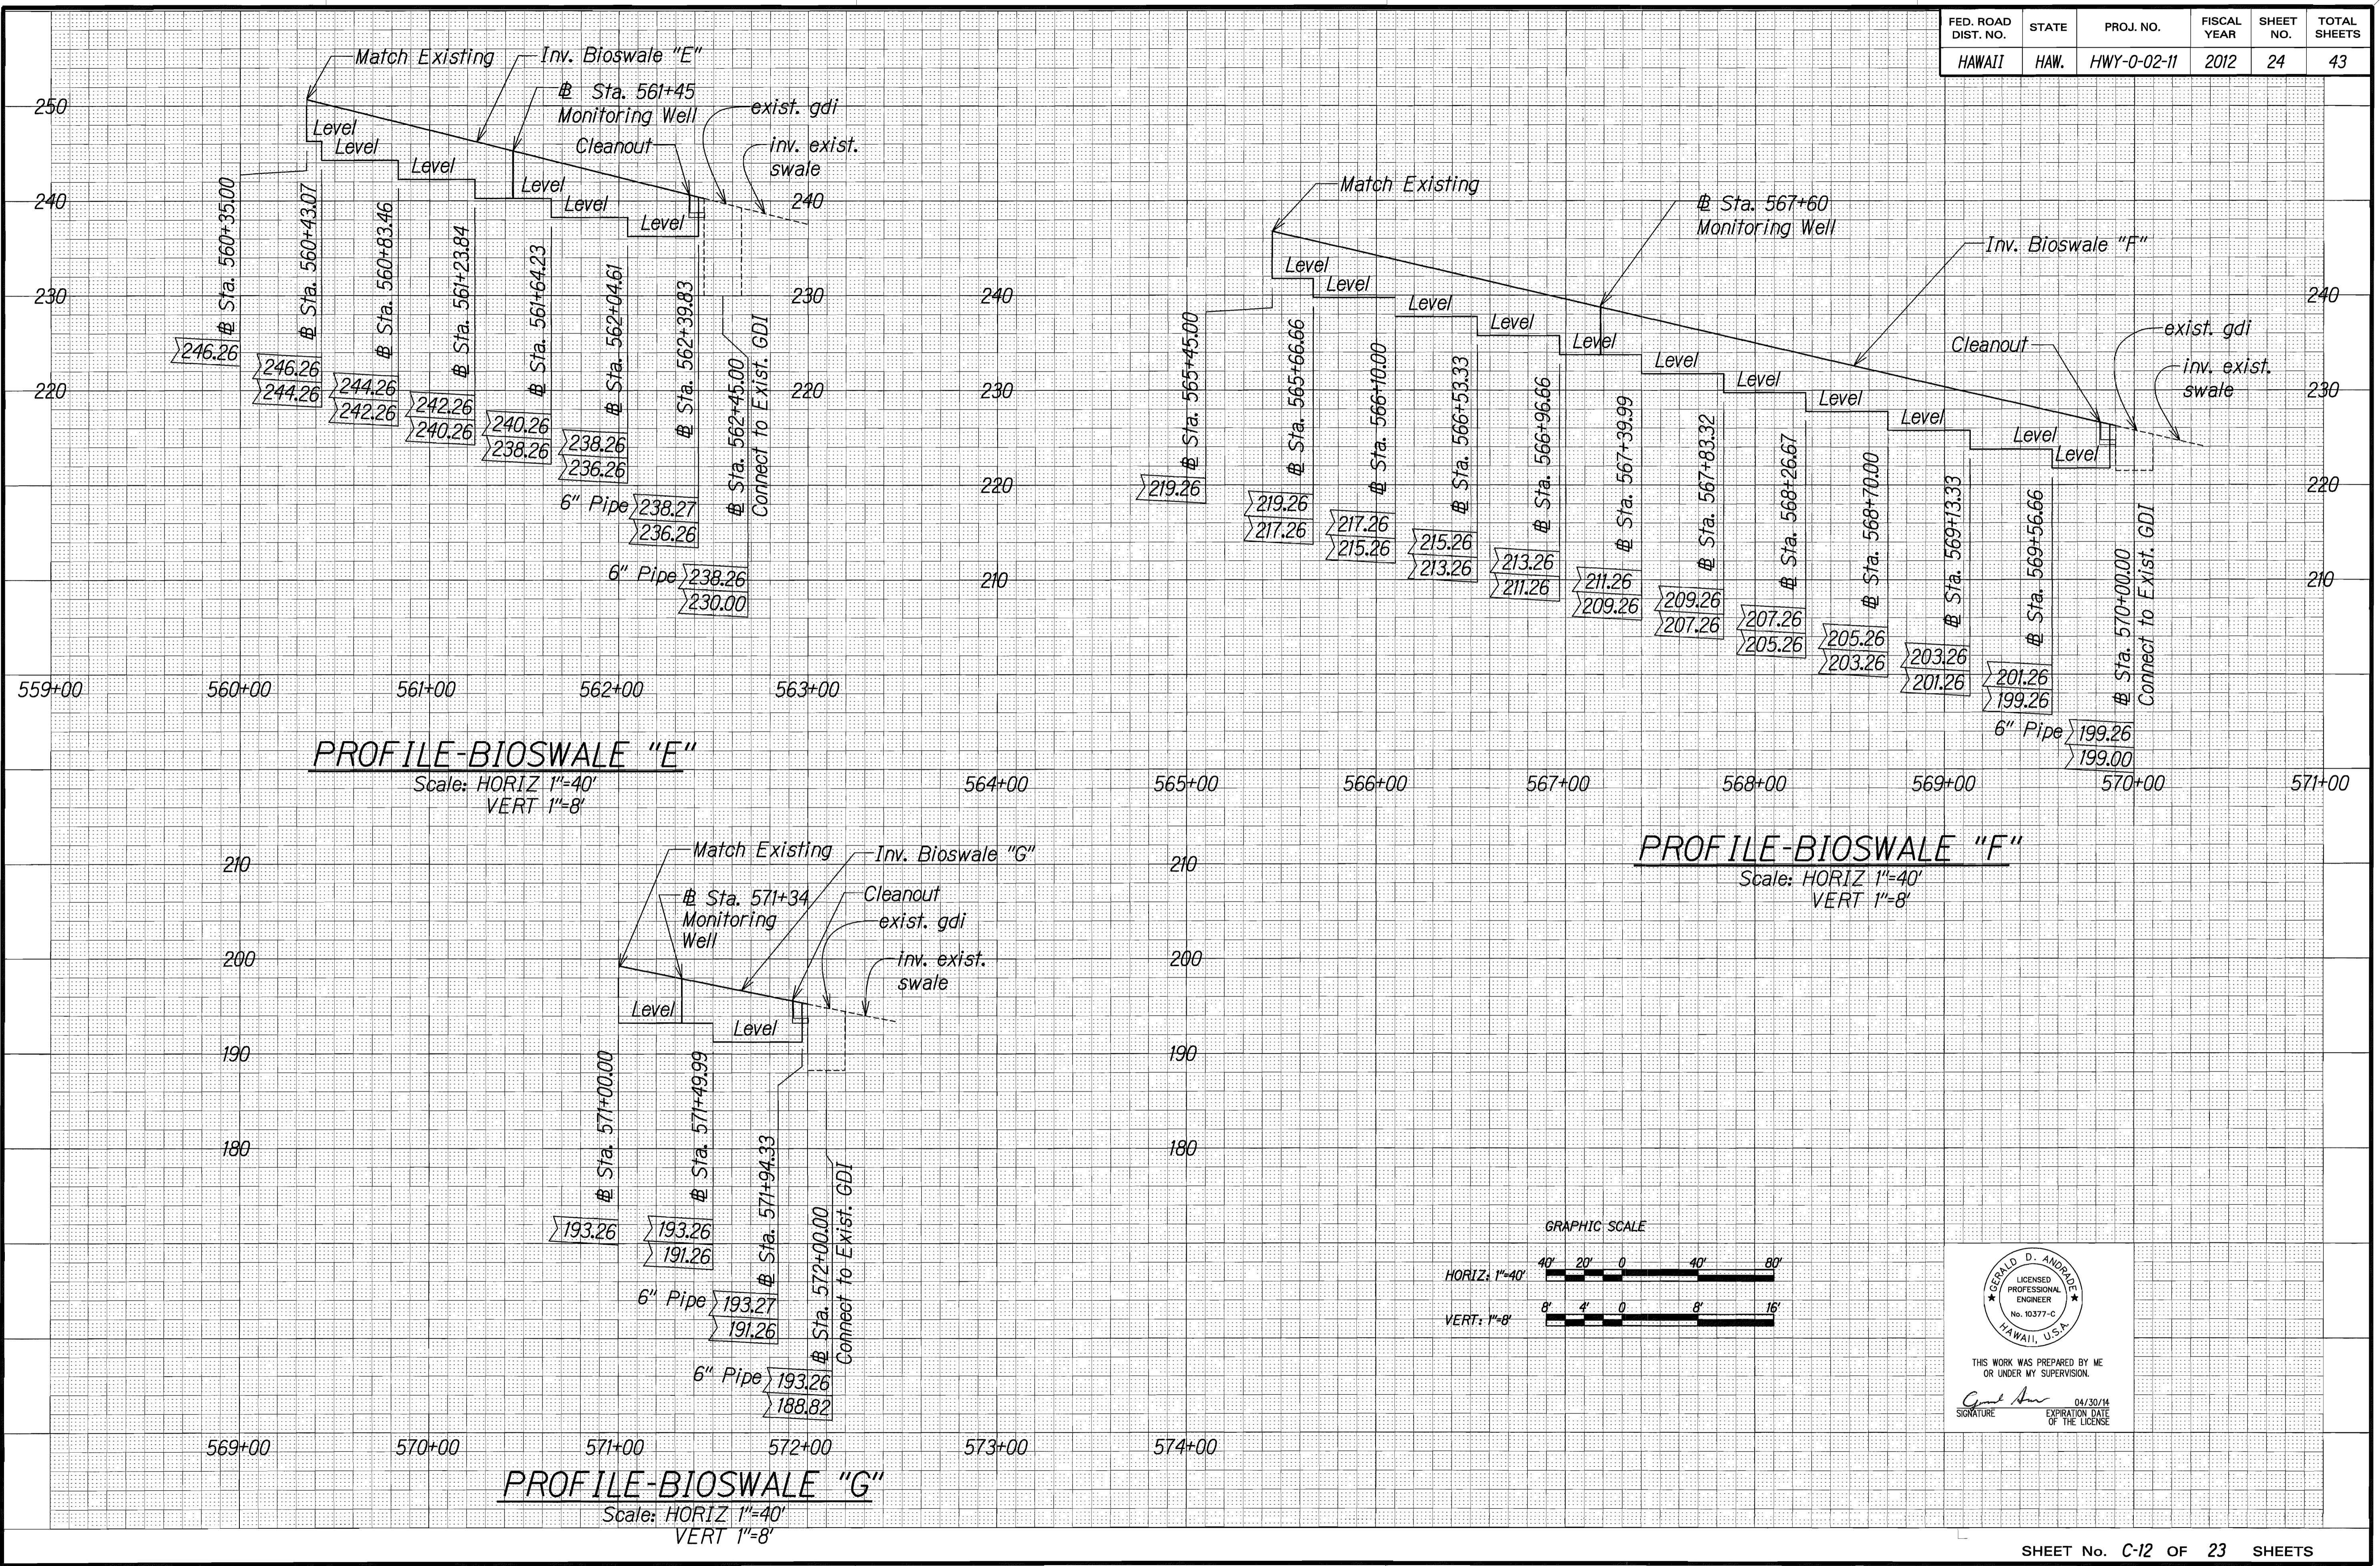

PROFILE-BIOSWALE "E"
 Scale: HORIZ 1"=40'
 VERT 1"=8'

PROFILE-BIOSWALE "F"
 Scale: HORIZ 1"=40'
 VERT 1"=8'


PROFILE-BIOSWALE "G"
 Scale: HORIZ 1"=40'
 VERT 1"=8'

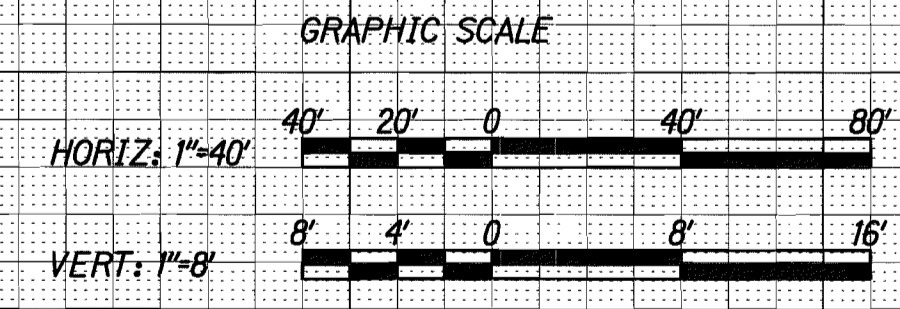


GERALD D. ANDRUE
 LICENSED PROFESSIONAL ENGINEER
 No. 10377-C
 HAWAII, U.S.A.
 THIS WORK WAS PREPARED BY ME OR UNDER MY SUPERVISION.
 SIGNATURE: *Gerald D. Andrue* 04/30/14
 EXPIRATION DATE OF THE LICENSE

ORIGINAL PLAN	DATE
DESIGNED BY	
NOTED BY	
CHECKED BY	
DATE	


FED. ROAD DIST. NO.	STATE	PROJ. NO.	FISCAL YEAR	SHEET NO.	TOTAL SHEETS
HAWAII	HAW.	HWY-0-02-11	2012	25	43

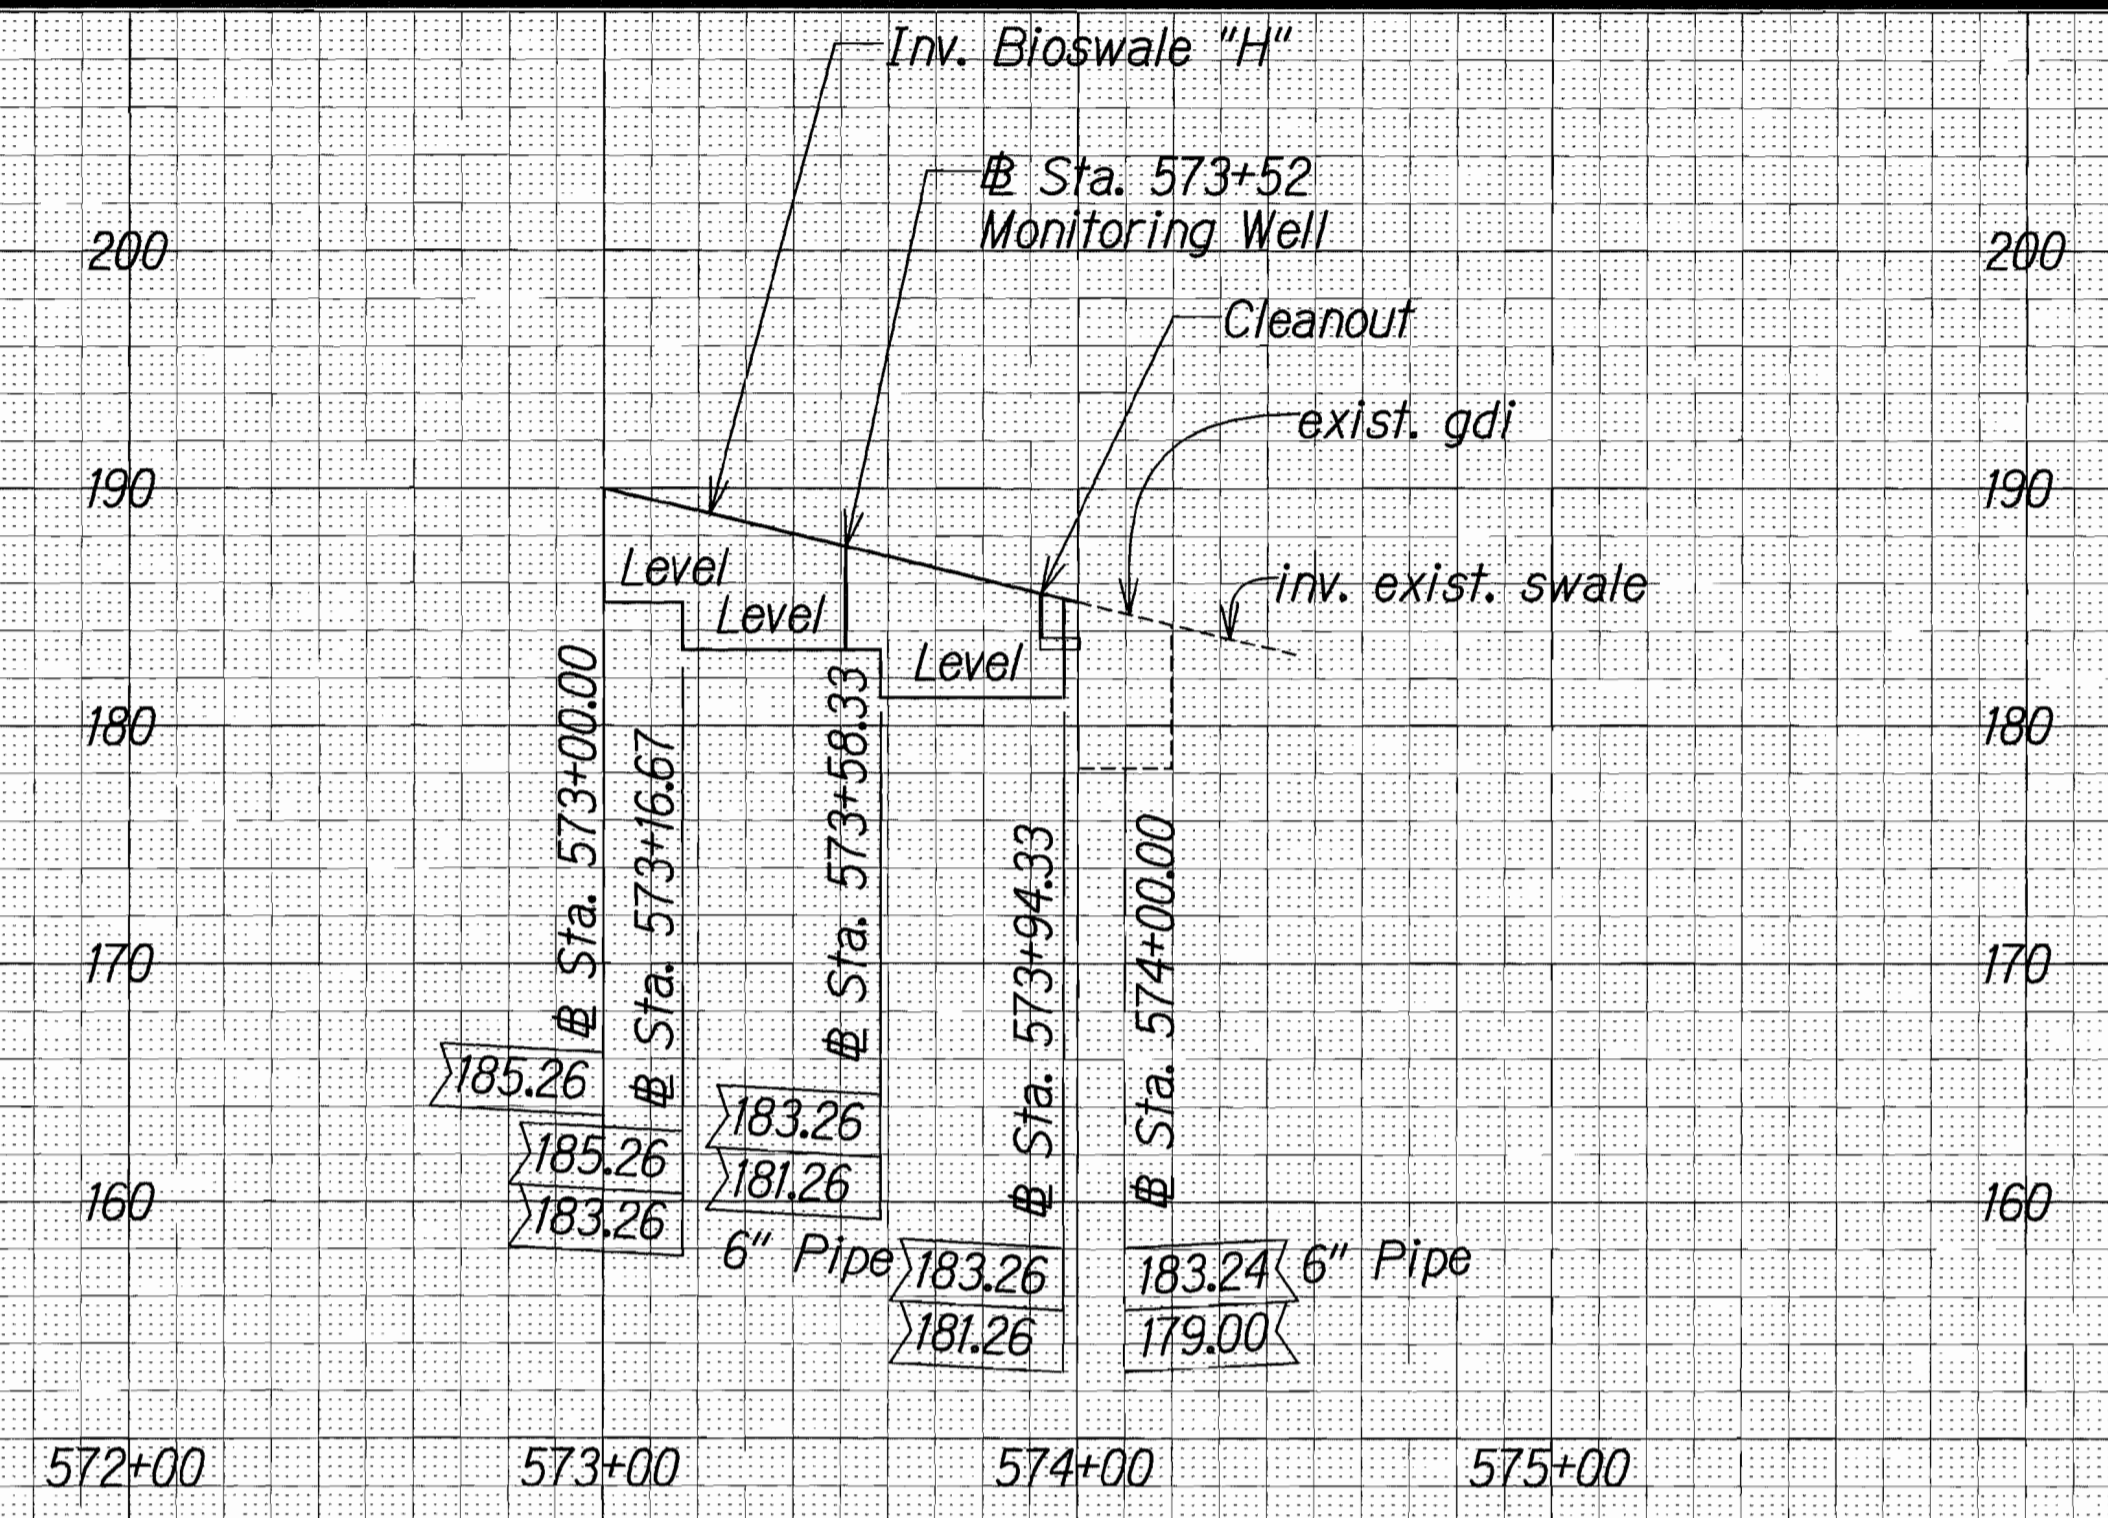



PROFILE-BIOSWALE "H"
Scale: HORIZ 1"=40'
VERT 1"=8'

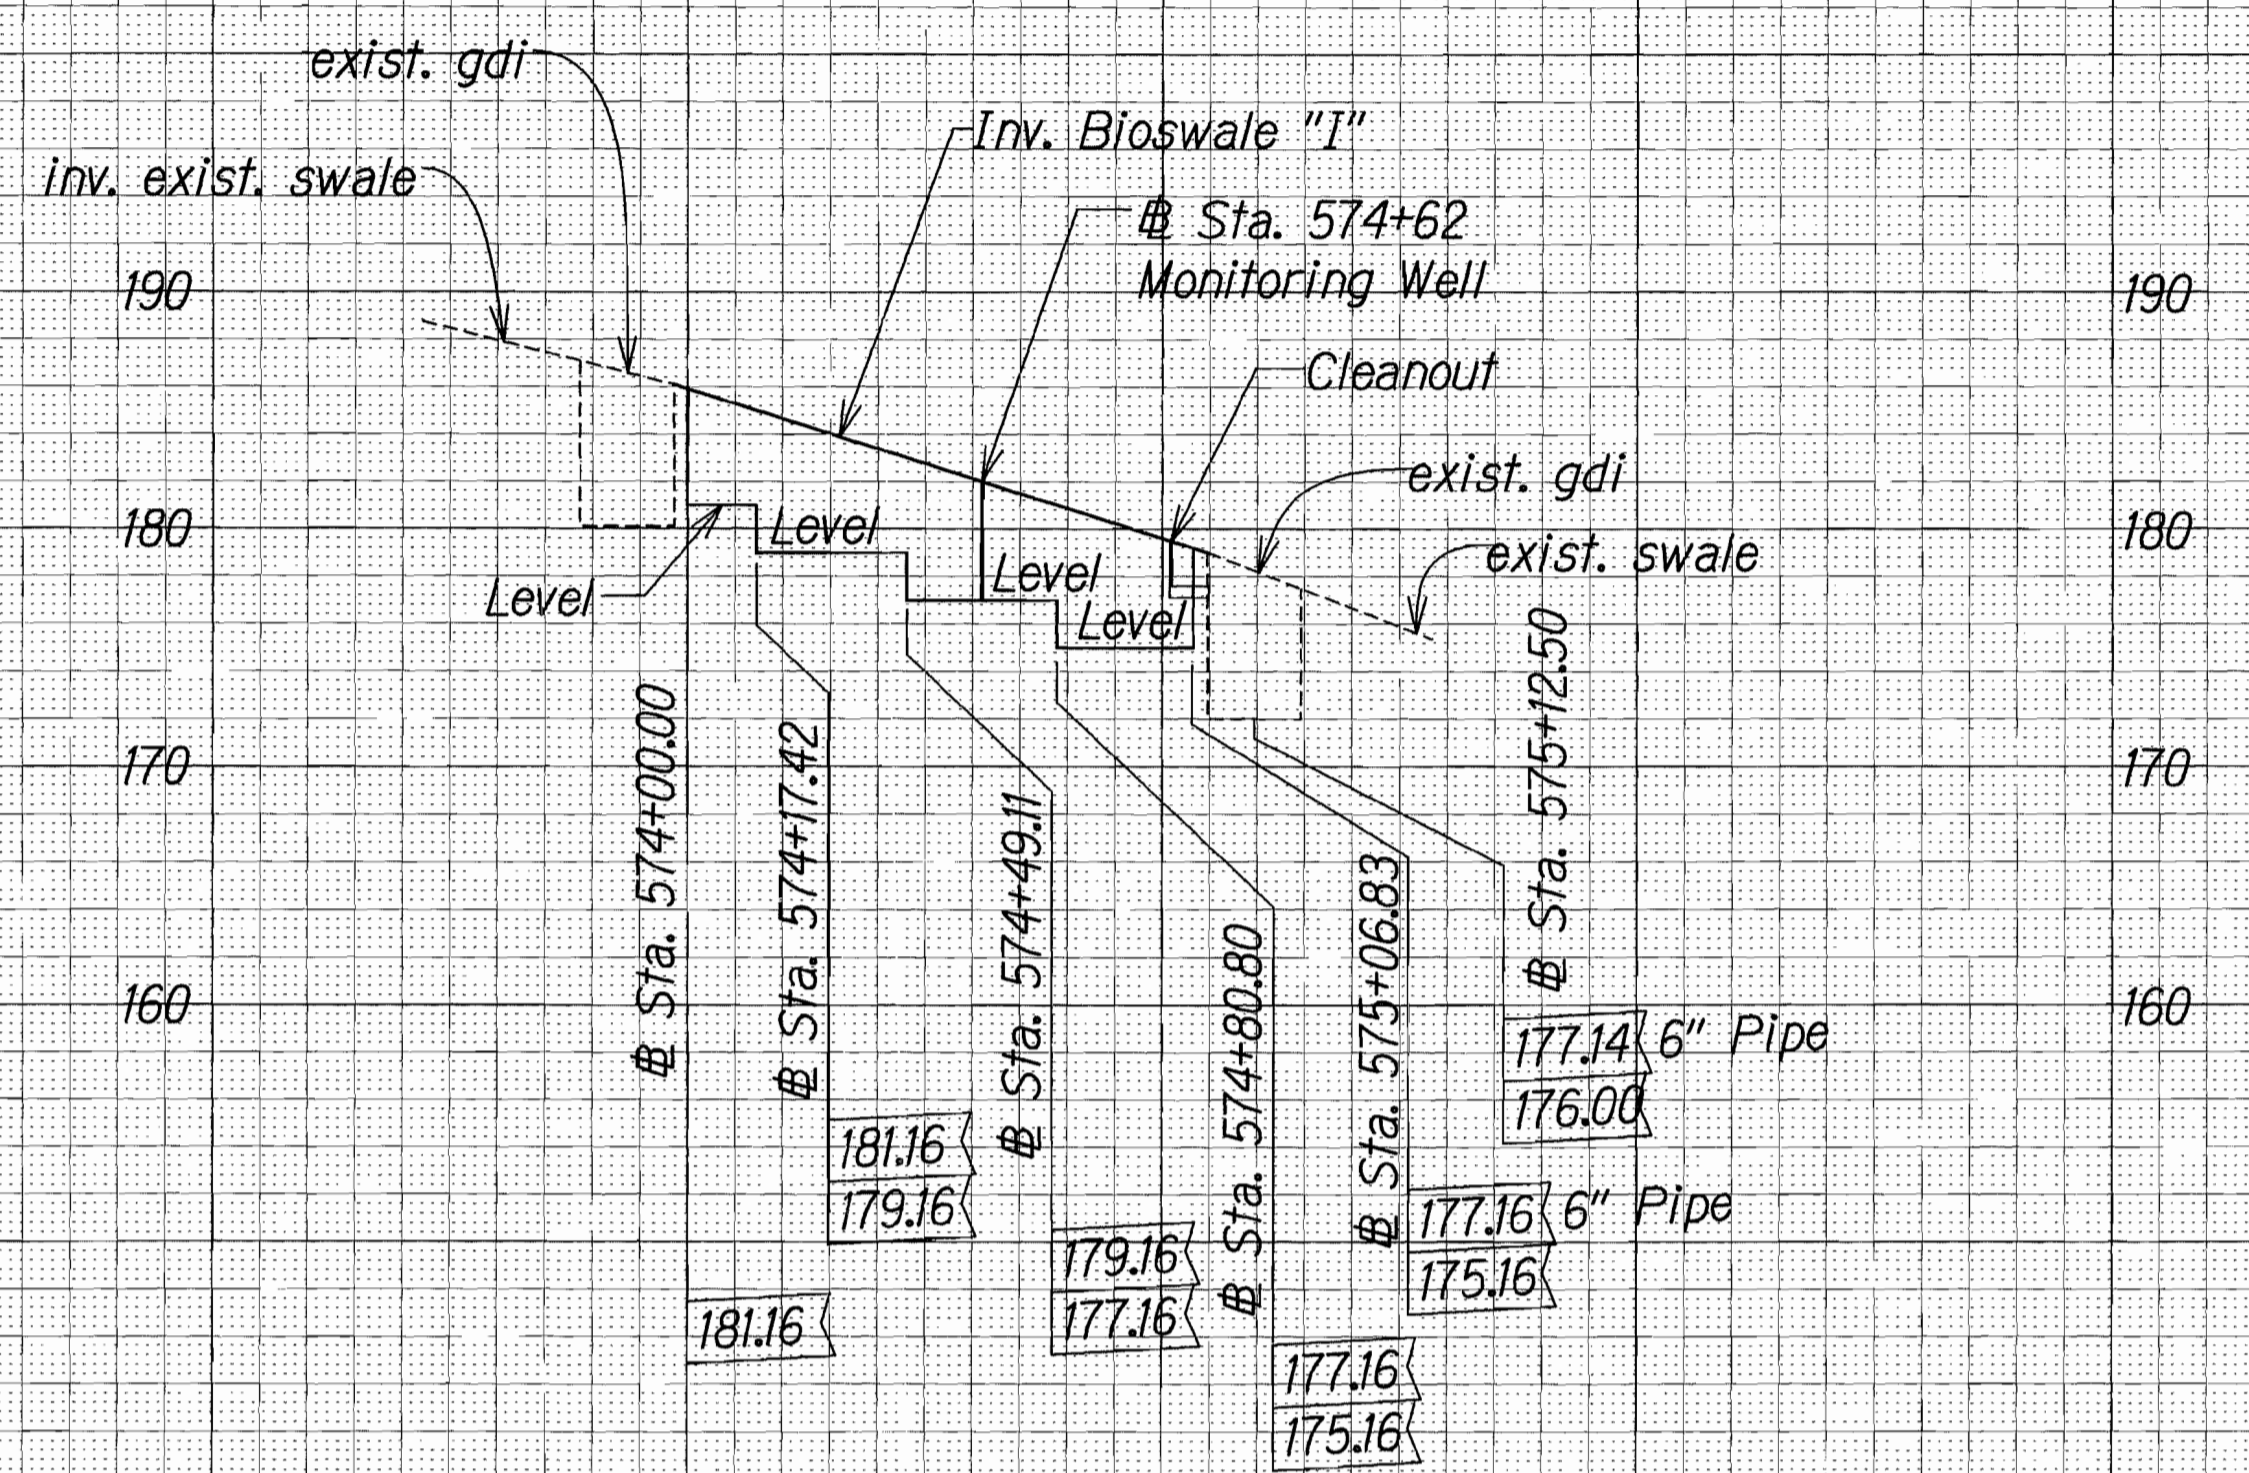

PROFILE-BIOSWALE "I"
Scale: HORIZ 1"=40'
VERT 1"=8'

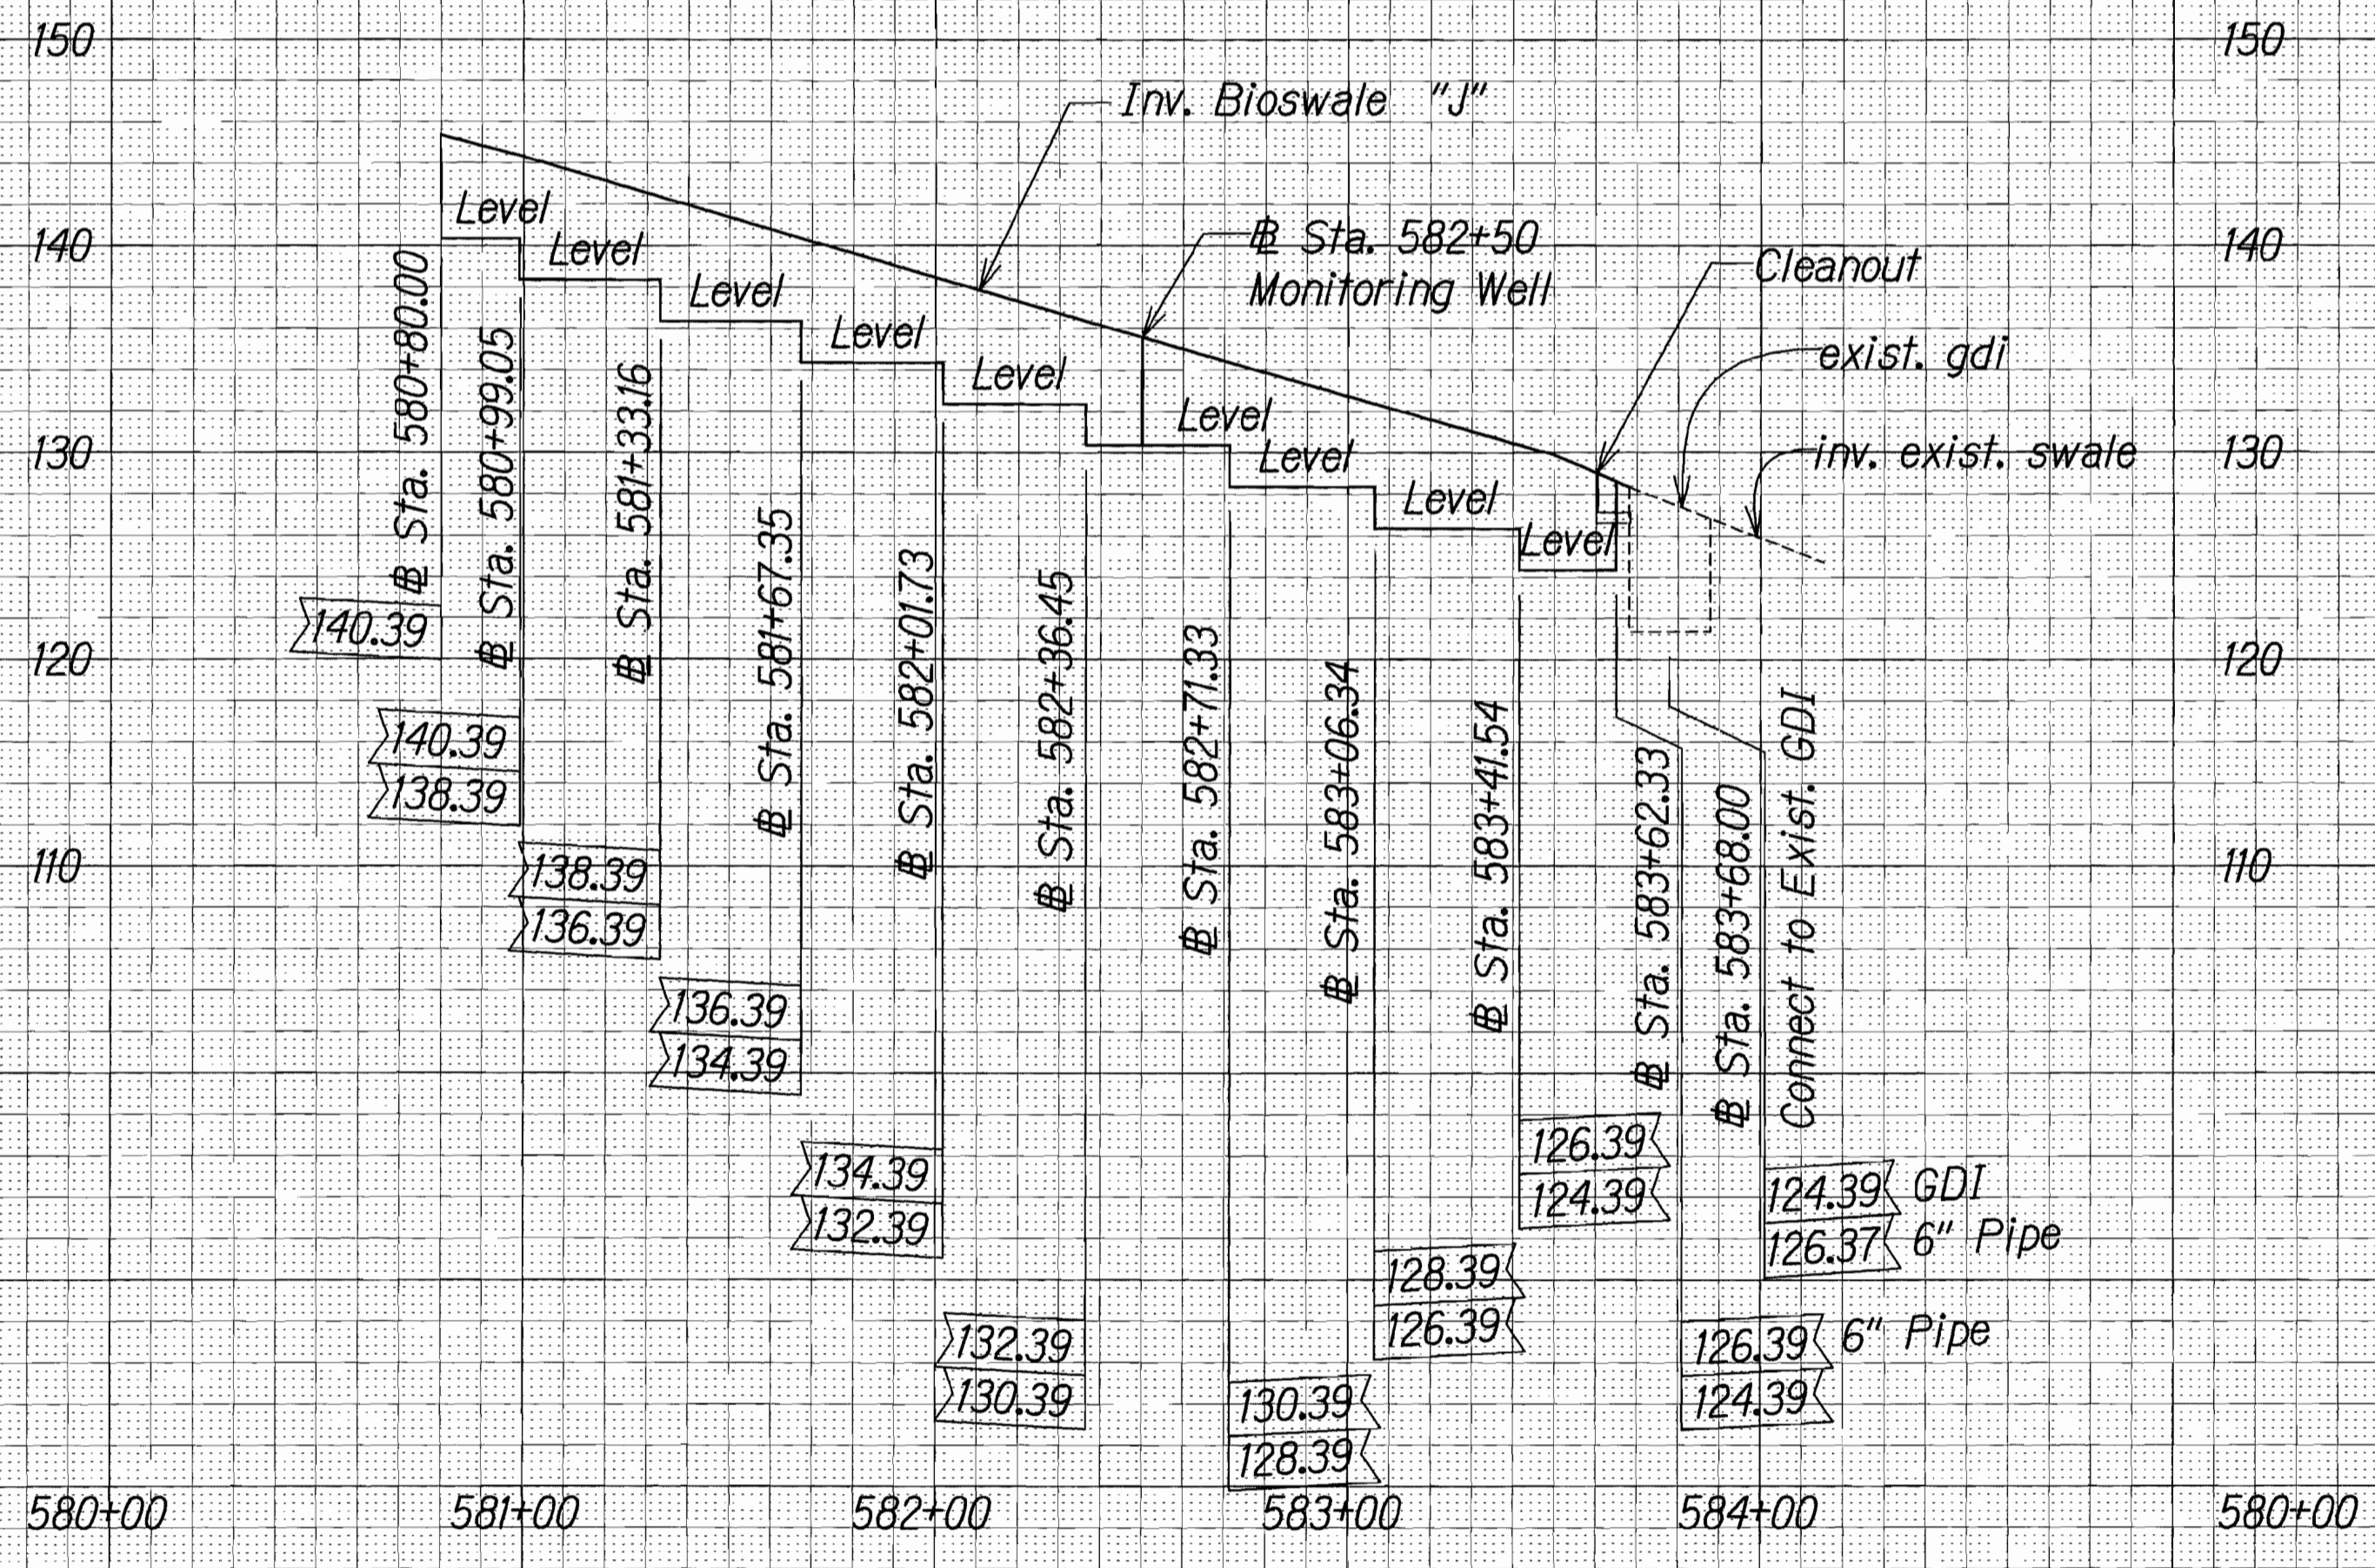


PROFILE-BIOSWALE "J"
Scale: HORIZ 1"=40'
VERT 1"=8'

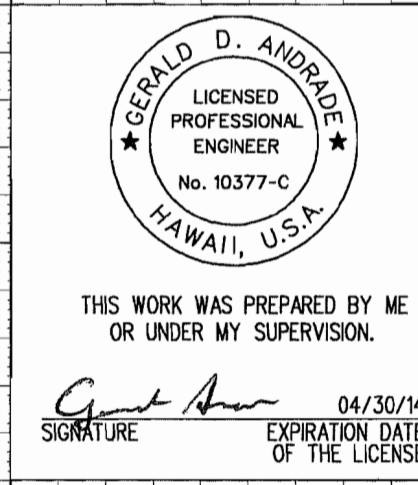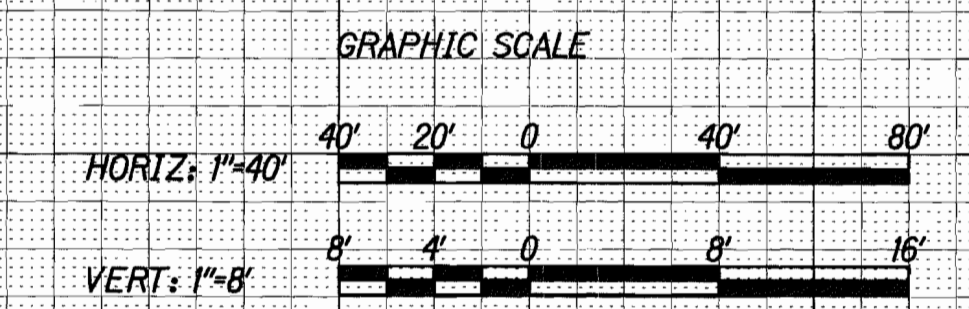


DATE: _____
SURVEY PLATTED BY: _____
DRAWN BY: _____
CHECKED BY: _____
NOTE BOOK: _____
QUANTITIES BY: _____
N.:

FED. ROAD DIST. NO.	STATE	PROJ. NO.	FISCAL YEAR	SHEET NO.	TOTAL SHEETS
HAWAII	HAW.	HWY-0-02-11	2012	26	43

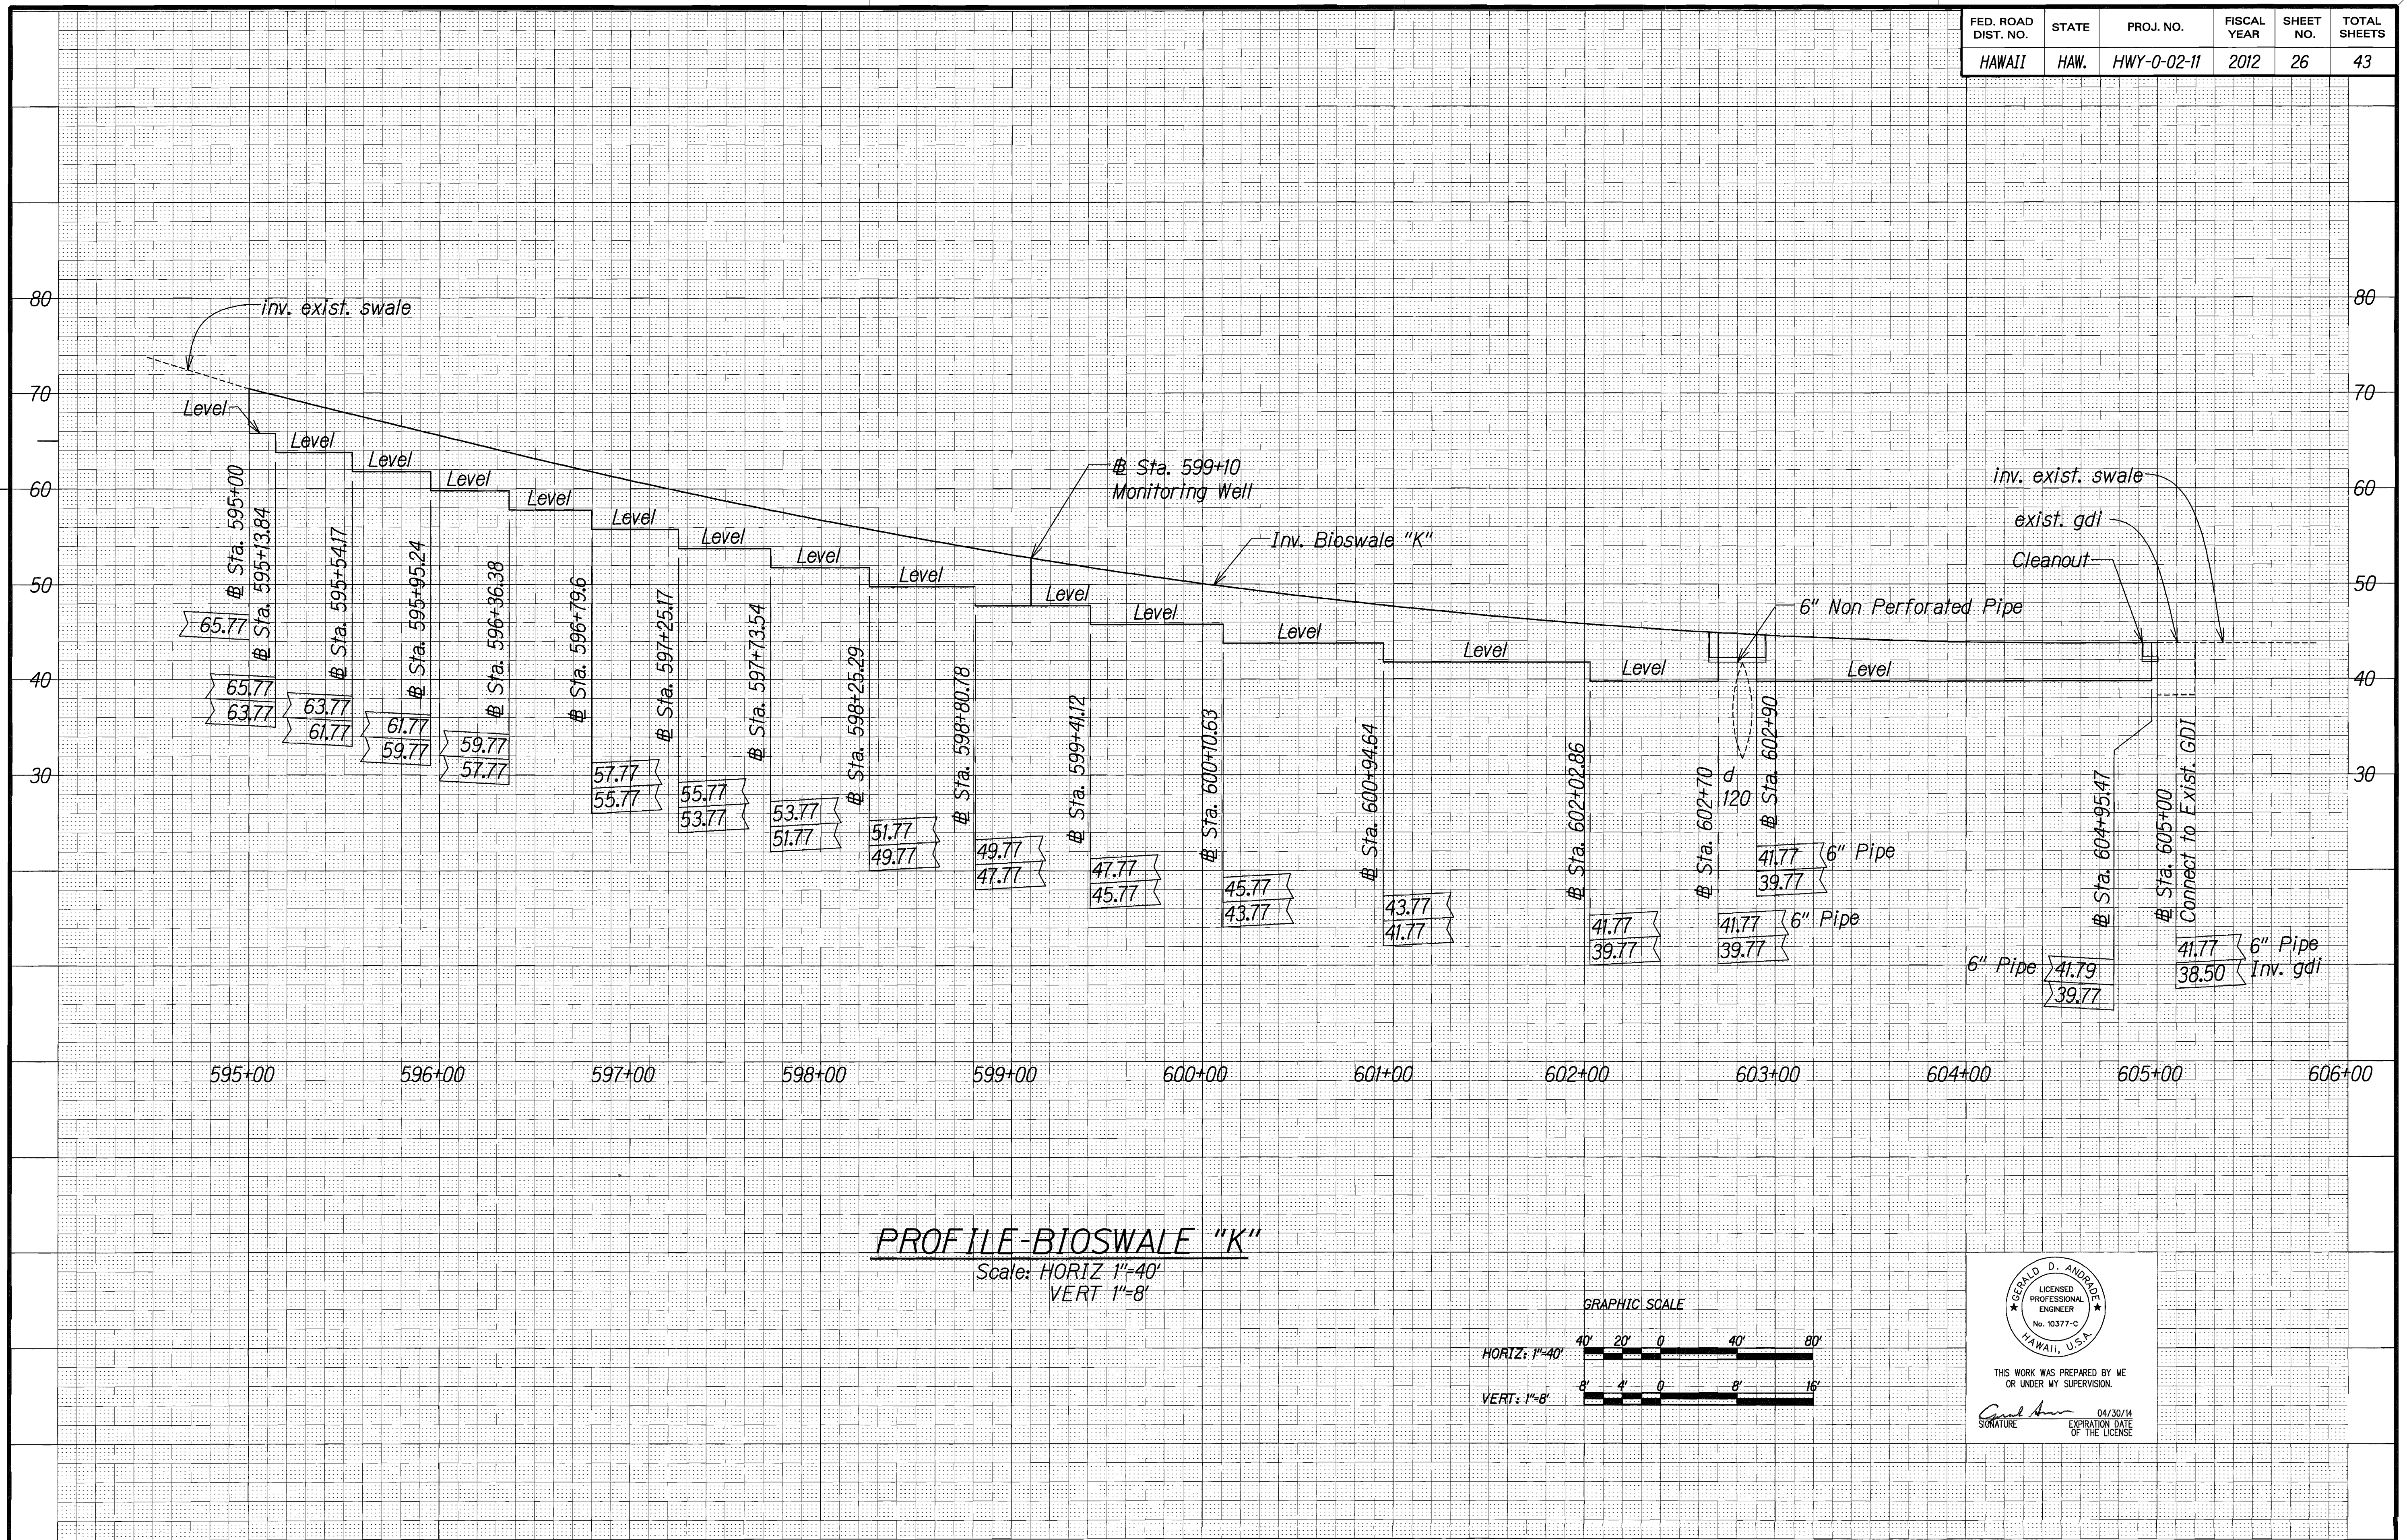

ORIGINAL PLAN	SURVEY PLOTTED BY	DATE
NOTE BOOK	DRAWN BY	
	DESIGNED BY	
	CHECKED BY	

PROFILE-BIOSWALE "K"
 Scale: HORIZ 1"=40'
 VERT 1"=8'

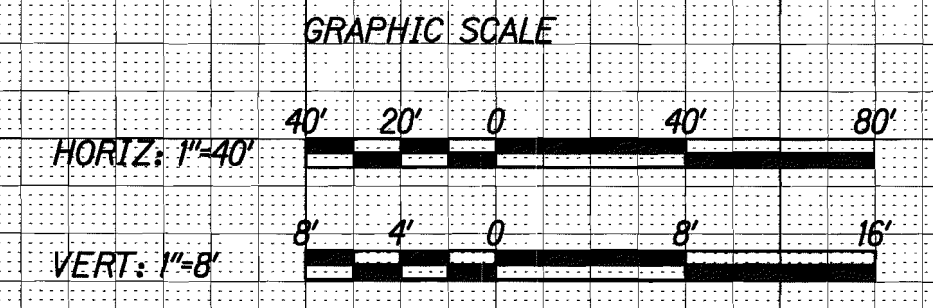


GERALD D. ANDRZEJCZAK
 LICENSED PROFESSIONAL ENGINEER
 No. 10377-C
 HAWAII, U.S.A.


THIS WORK WAS PREPARED BY ME OR UNDER MY SUPERVISION.

Gerald Andrzejczak 04/30/14
 SIGNATURE EXPIRATION DATE OF THE LICENSE

FED. ROAD DIST. NO.	STATE	PROJ. NO.	FISCAL YEAR	SHEET NO.	TOTAL SHEETS
HAWAII	HAW.	HWY-0-02-11	2012	27	43

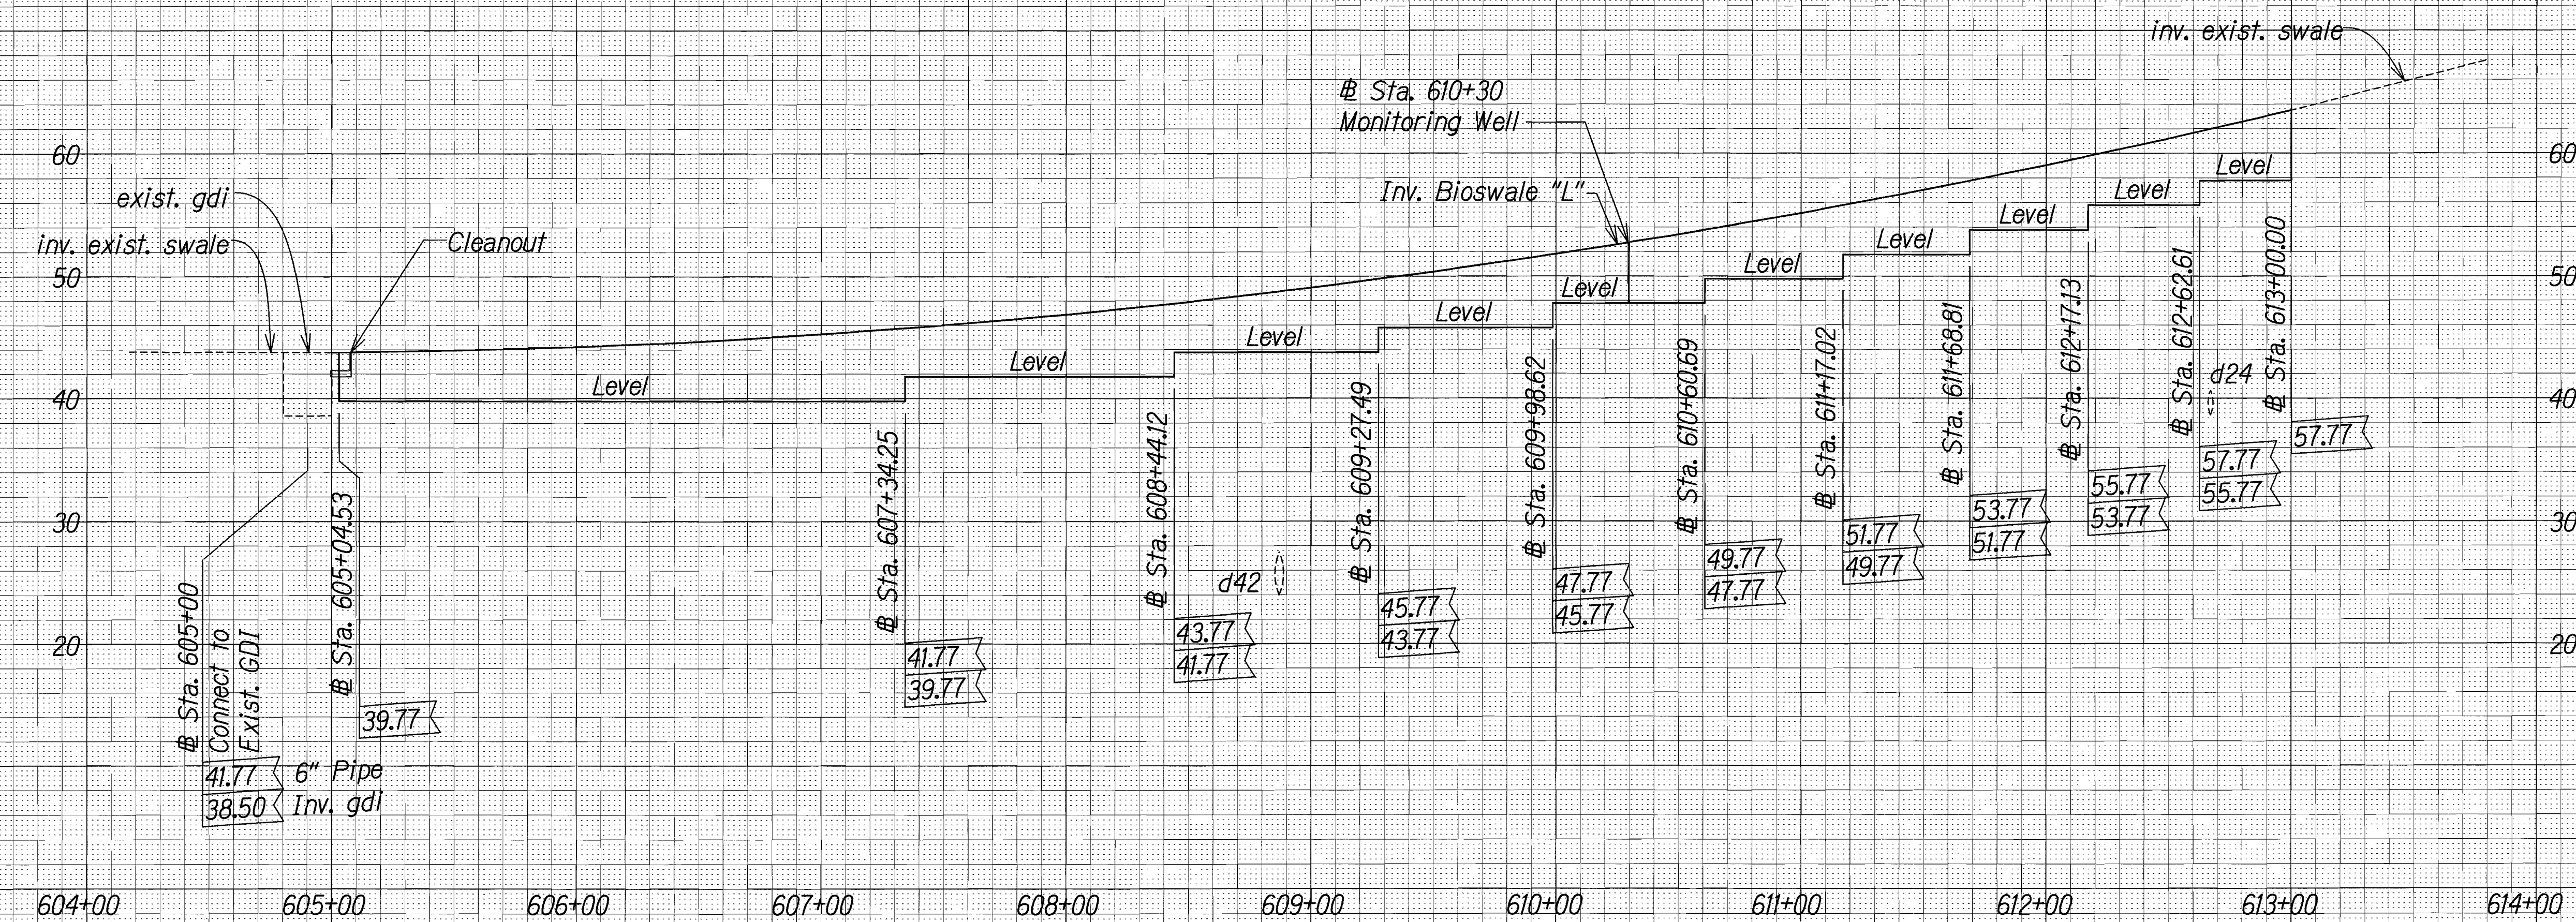






PROFILE-BIOSWALE "L"
 Scale: HORIZ 1"=40'
 VERT 1"=8'

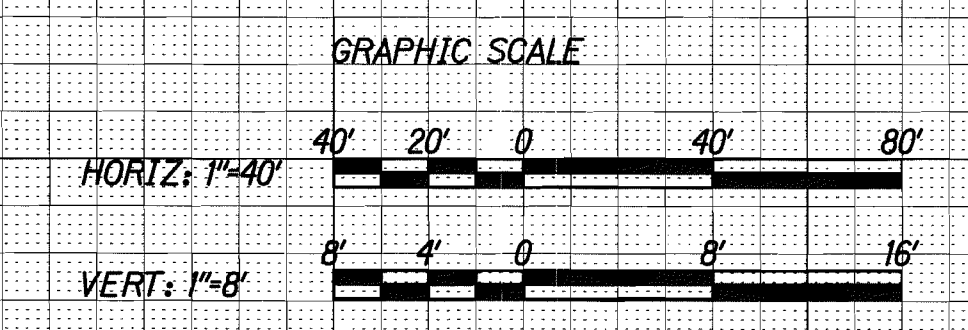

THIS WORK WAS PREPARED BY ME OR UNDER MY SUPERVISION.
 SIGNATURE: *Gerald Andrade* 04/30/14
 EXPIRATION DATE OF THE LICENSE

SURVEY PLOTTED BY _____ DATE _____
 ORIGINAL PLAN _____
 DRAWN BY _____
 DESIGNED BY _____
 CHECKED BY _____
 No. _____


FED. ROAD DIST. NO.	STATE	PROJ. NO.	FISCAL YEAR	SHEET NO.	TOTAL SHEETS
HAWAII	HAW.	HWY-0-02-11	2012	28	43

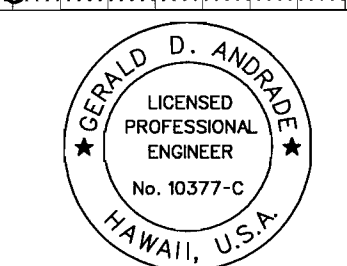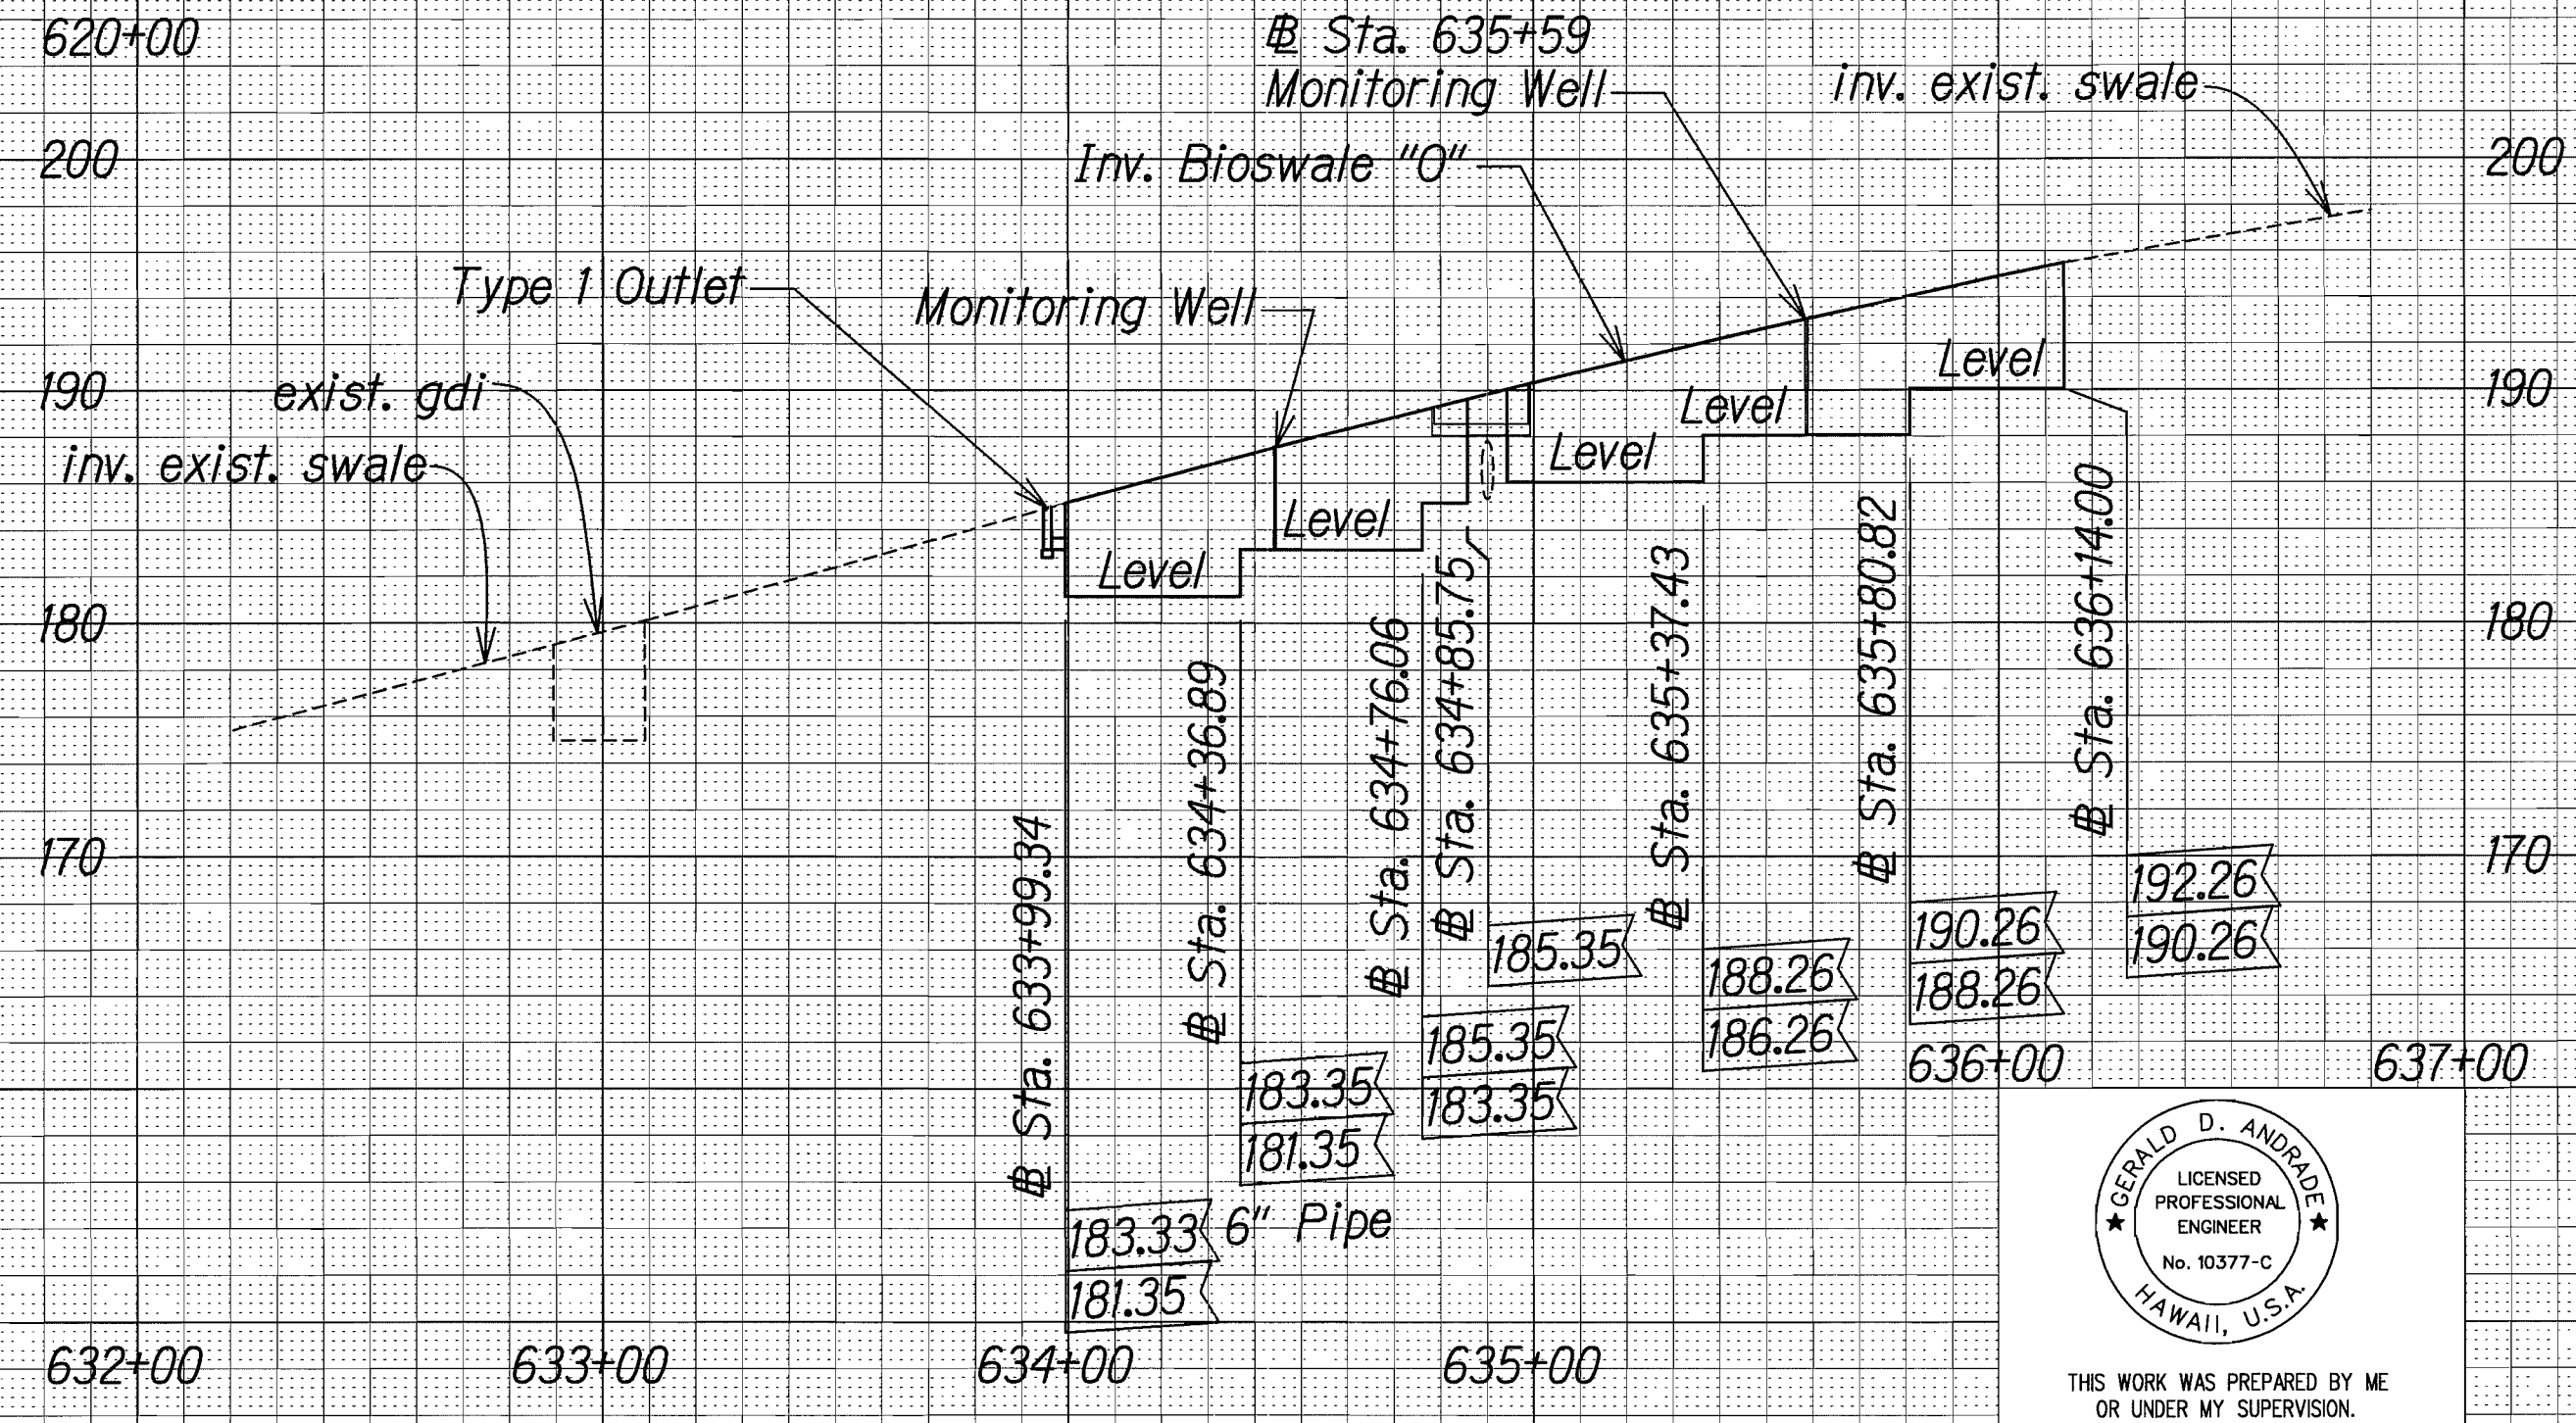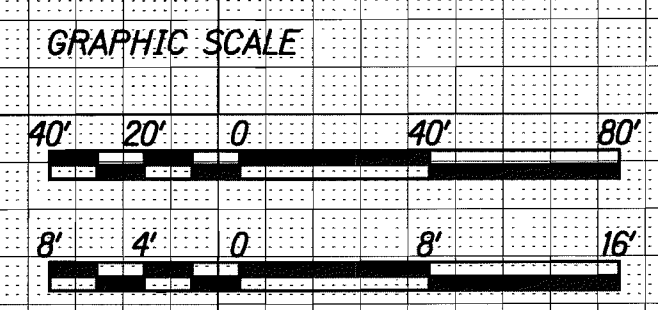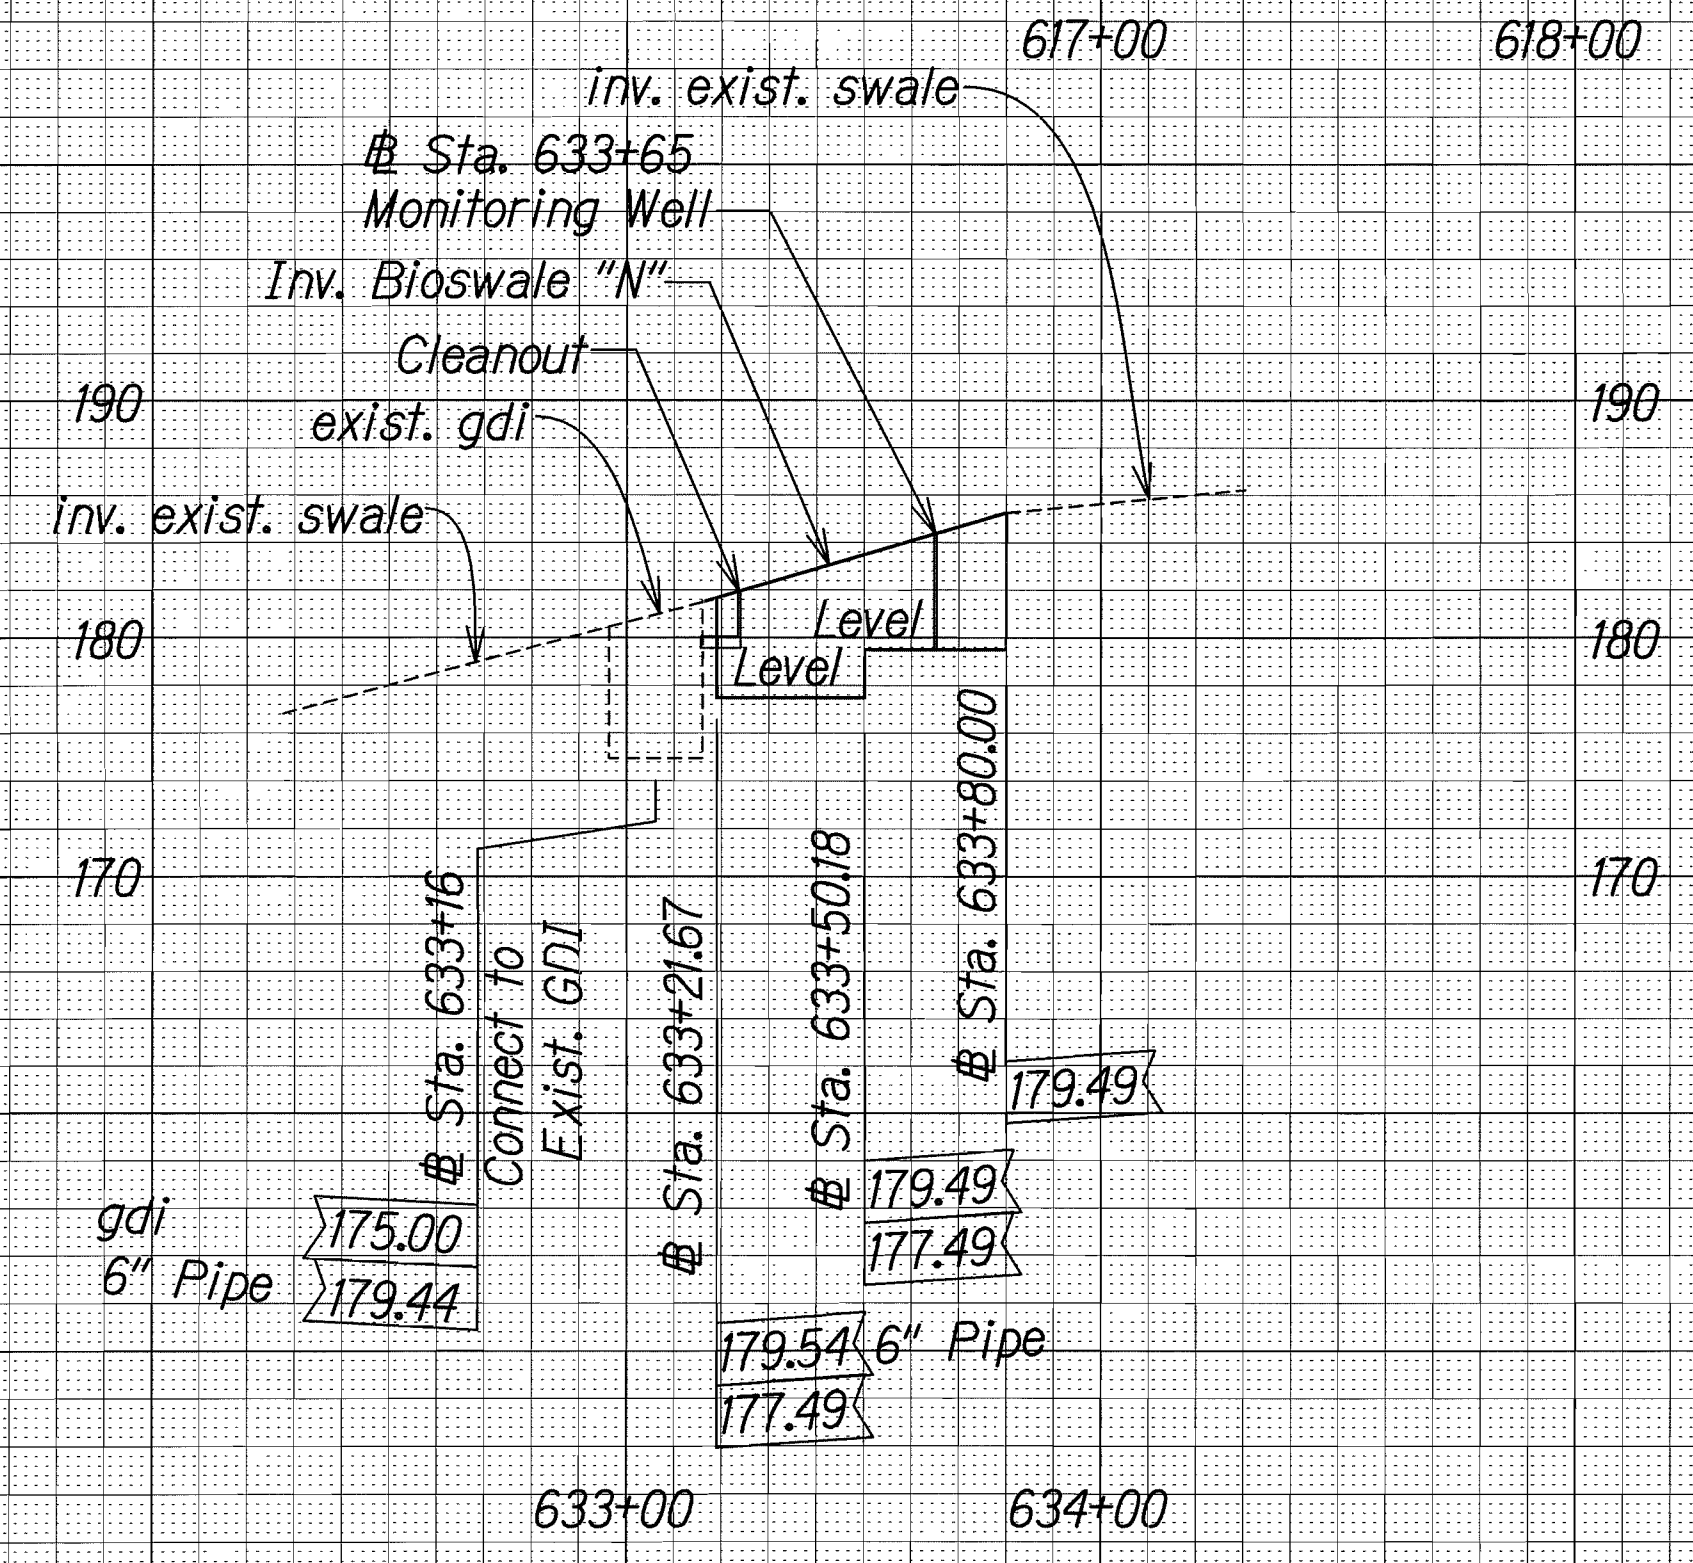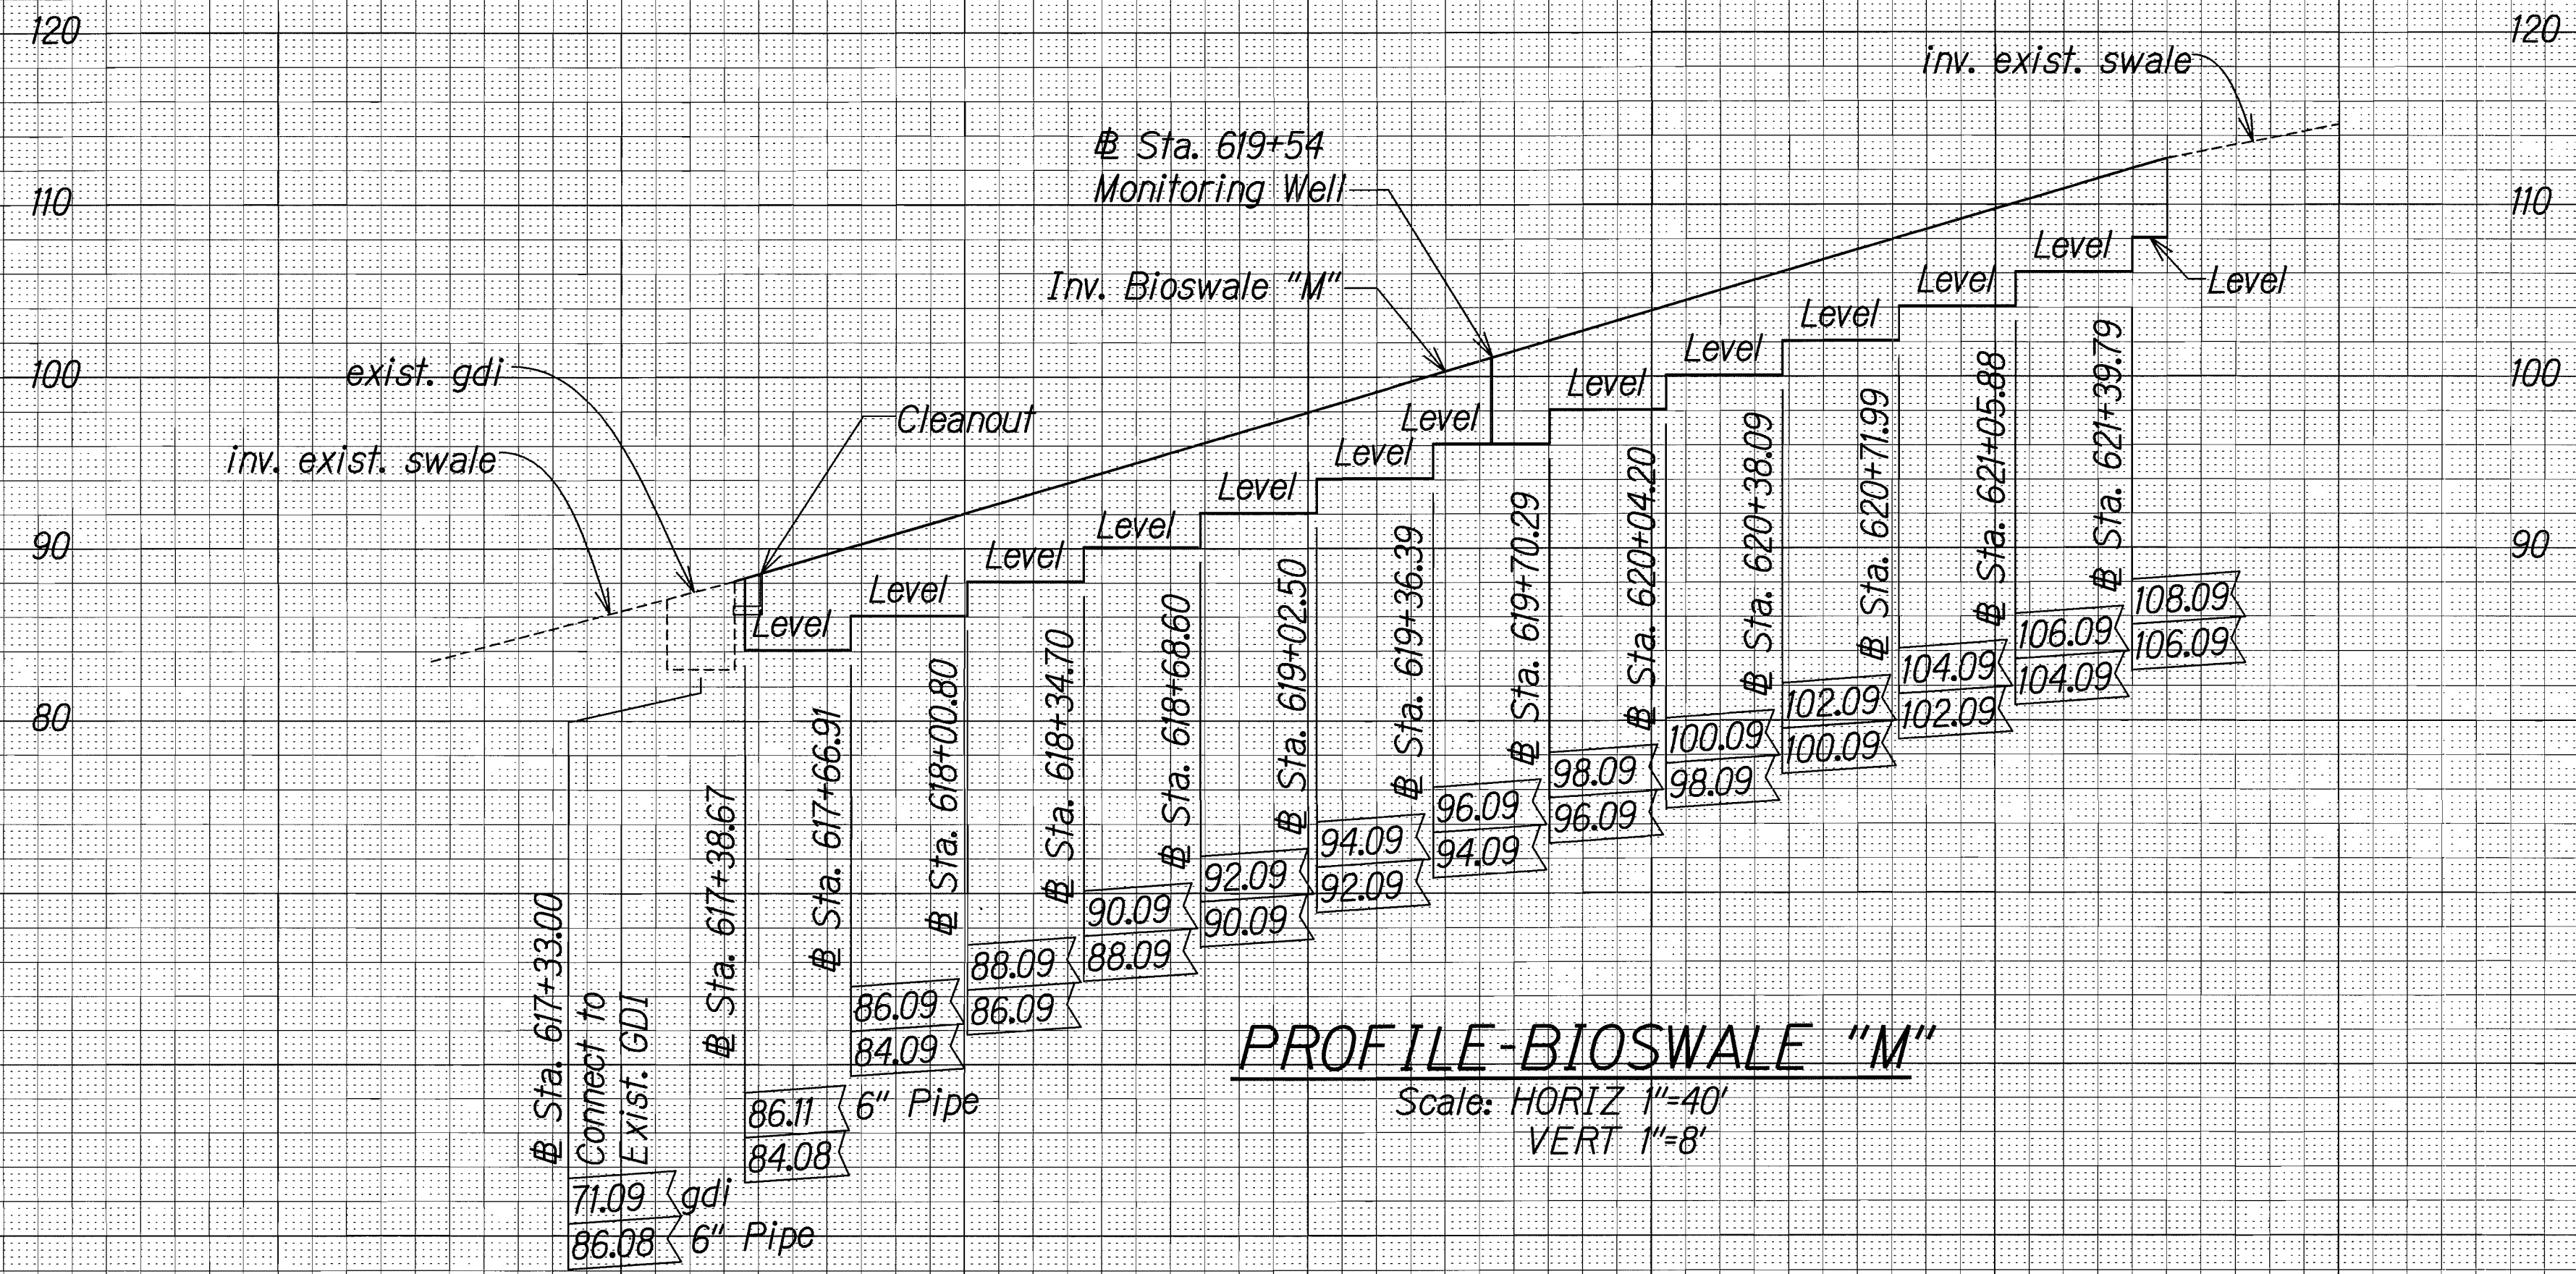


THIS WORK WAS PREPARED BY ME OR UNDER MY SUPERVISION.
Signature: *Gerald D. Andrade*
EXPIRATION DATE OF THE LICENSE: 04/30/14

ORIGINAL PLAN	DATE
DESIGNED BY	
NOTED BY	
CHECKED BY	
DATE	

FED. ROAD DIST. NO.	STATE	PROJ. NO.	FISCAL YEAR	SHEET NO.	TOTAL SHEETS
HAWAII	HAW.	HWY-0-02-11	2012	29	43


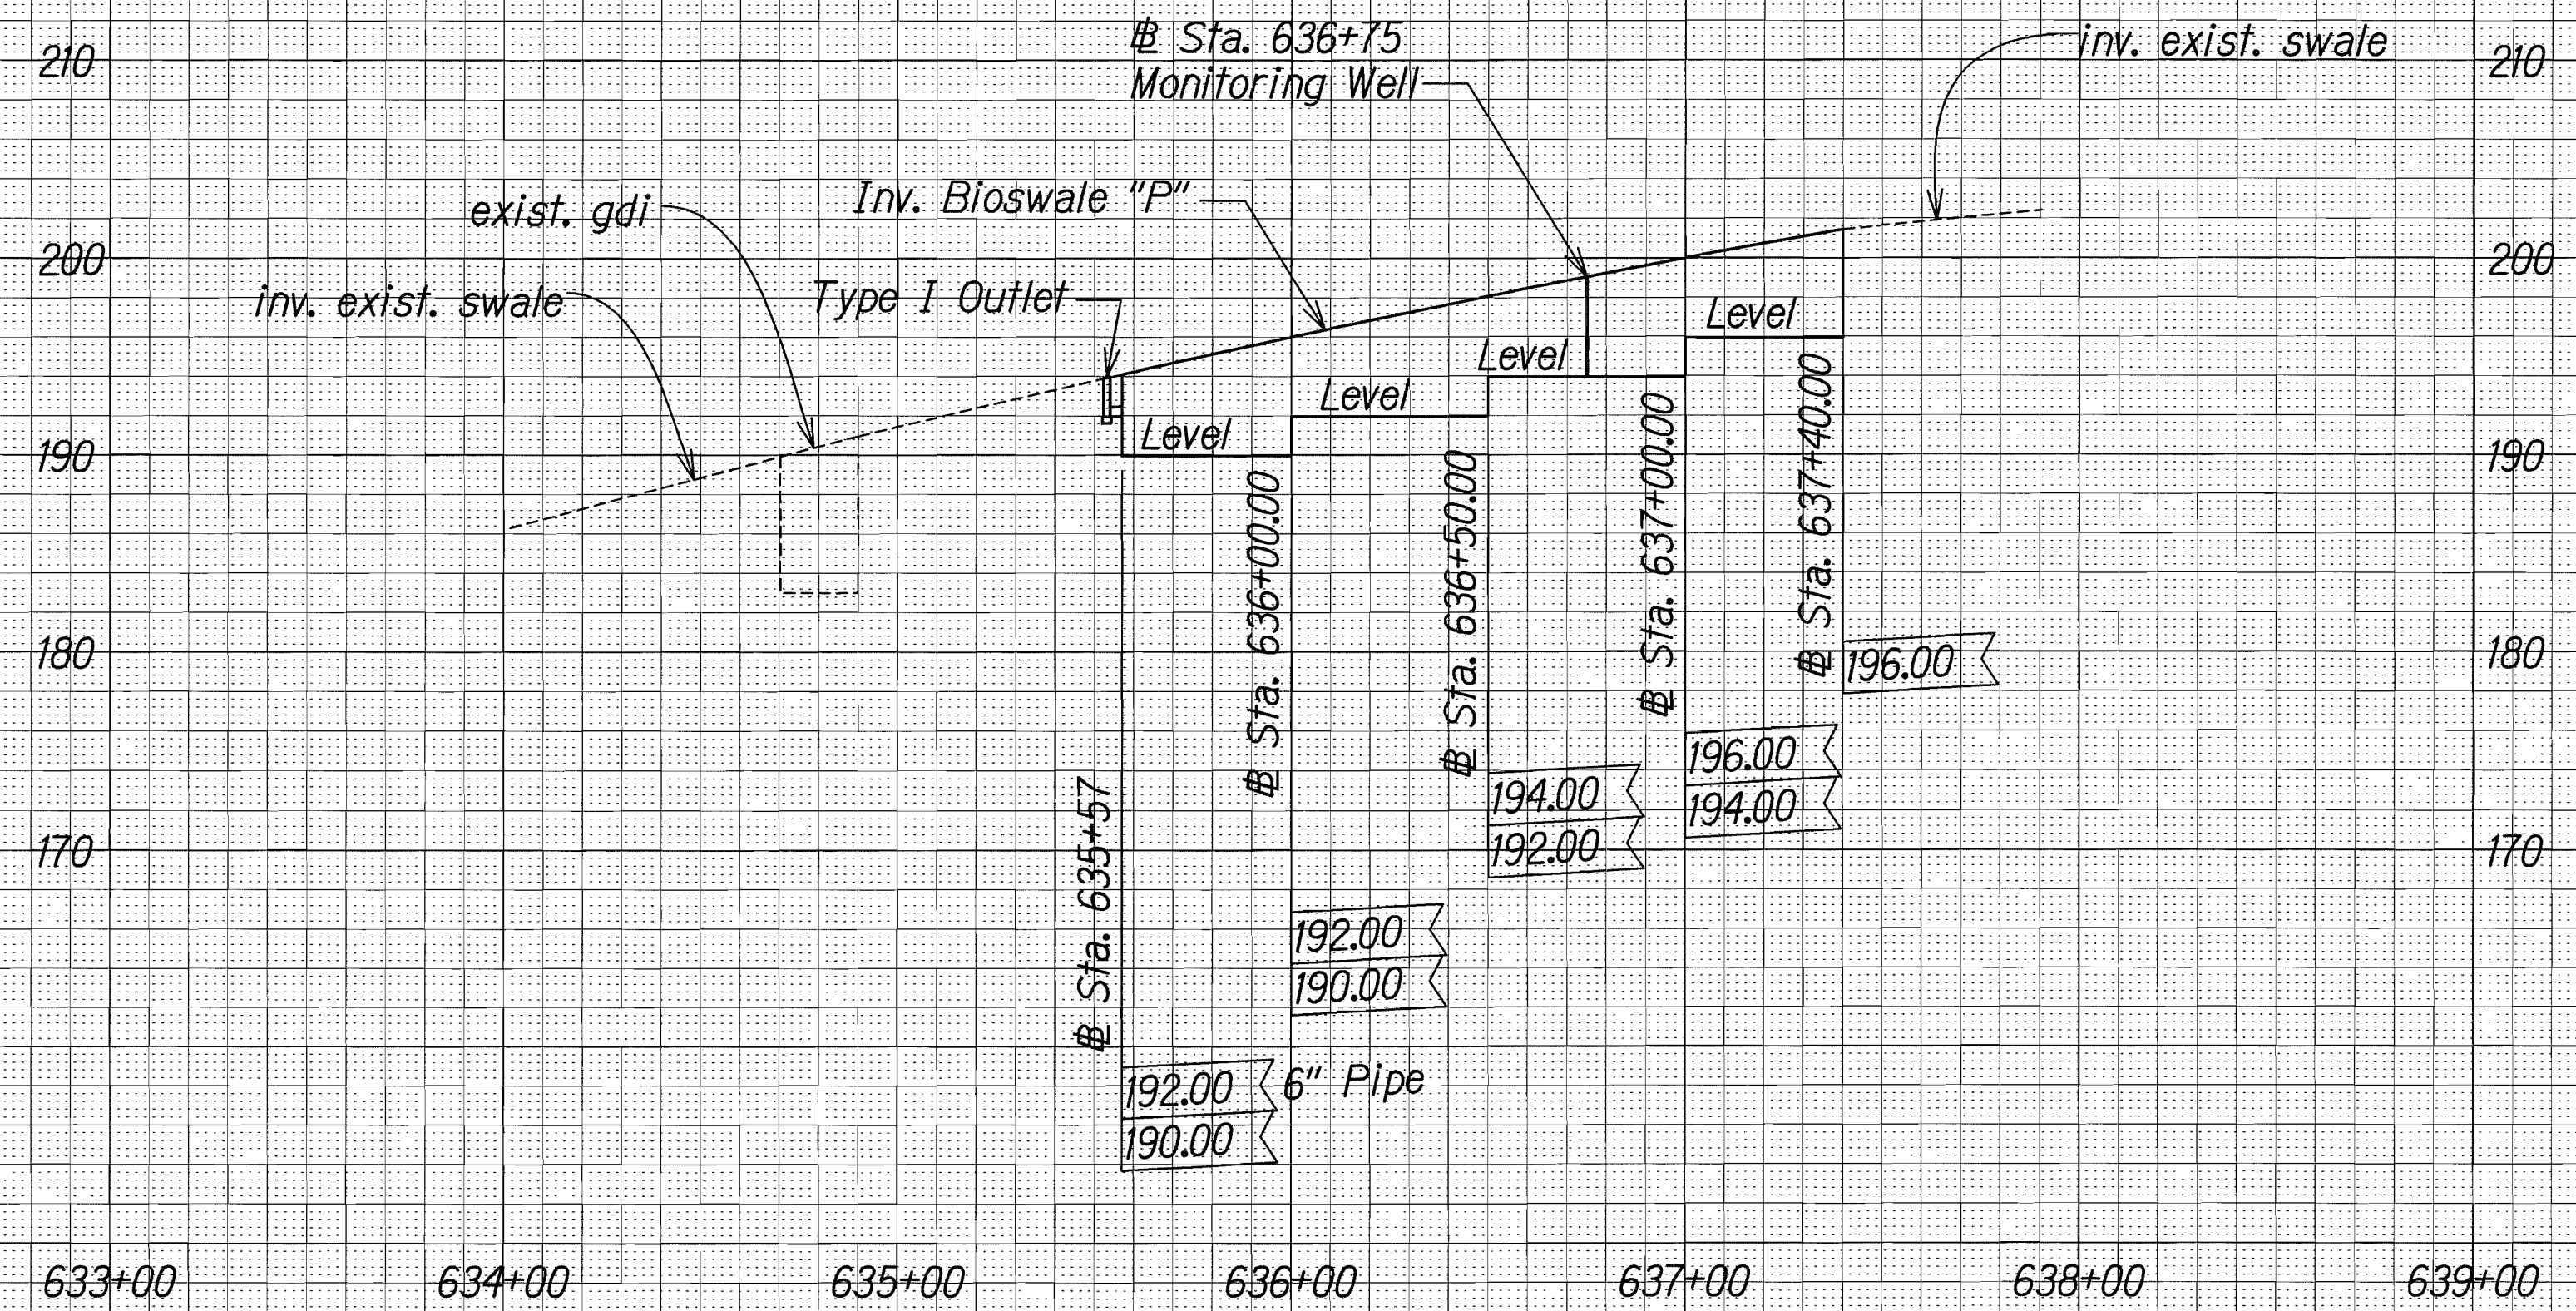


PROFILE-BIOSWALE "P"
 Scale: HORIZ 1"=40'
 VERT 1"=8'

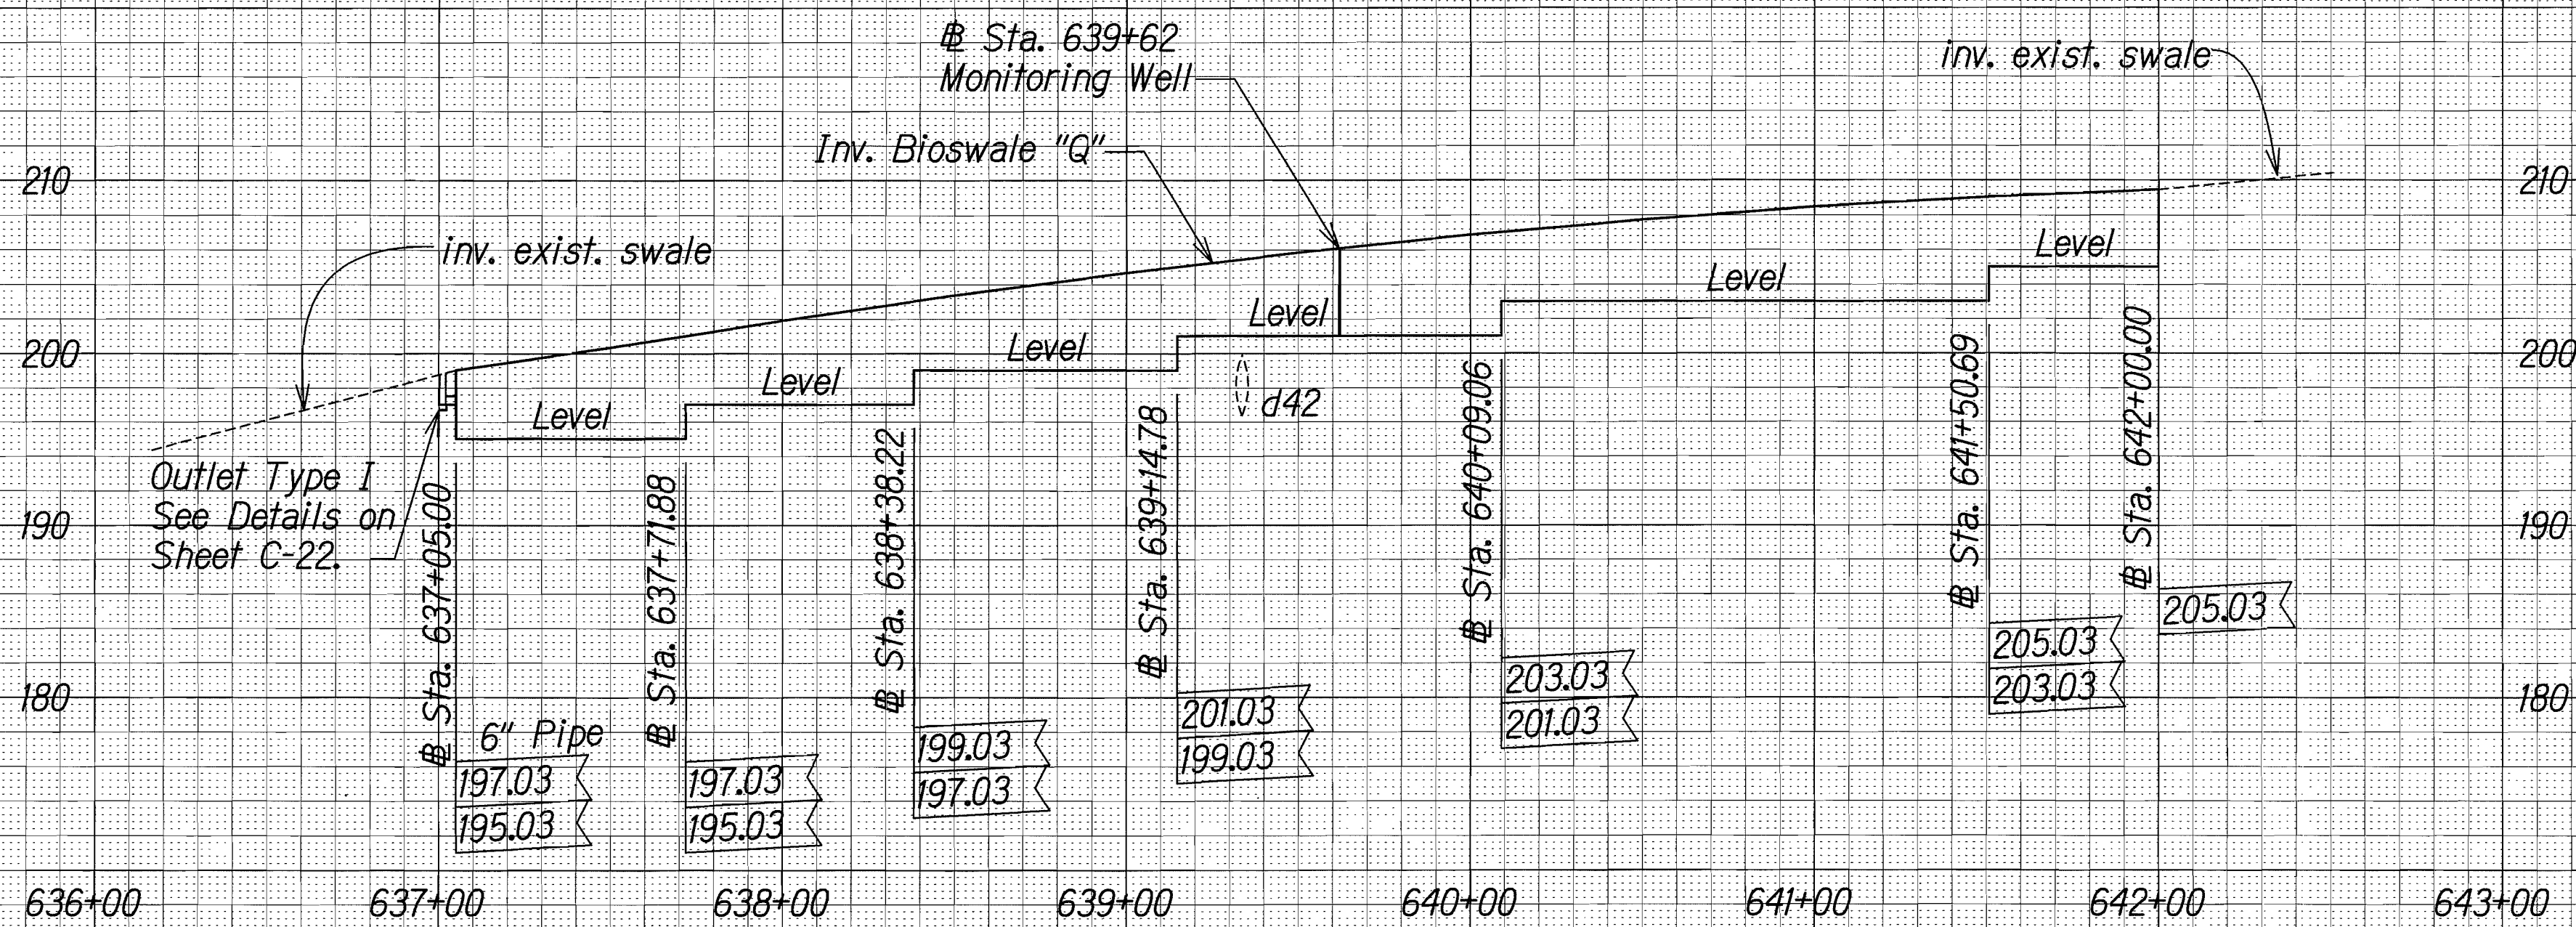

PROFILE-BIOSWALE "Q"
 Scale: HORIZ 1"=40'
 VERT 1"=8'

GRAPHIC SCALE

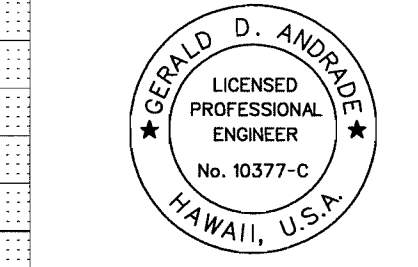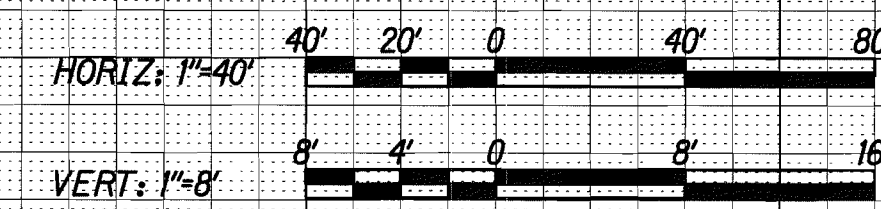

THIS WORK WAS PREPARED BY ME OR UNDER MY SUPERVISION.
 SIGNATURE: *Gerald D. Andrade* 04/30/14
 EXPIRATION DATE OF THE LICENSE

SURVEY PLOTTED BY	DATE
DRAWN BY	
DESIGNED BY	
QUANTITIES BY	
CHECKED BY	
ORIGINAL PLAN	
NOTE BOOK	
NO.	