
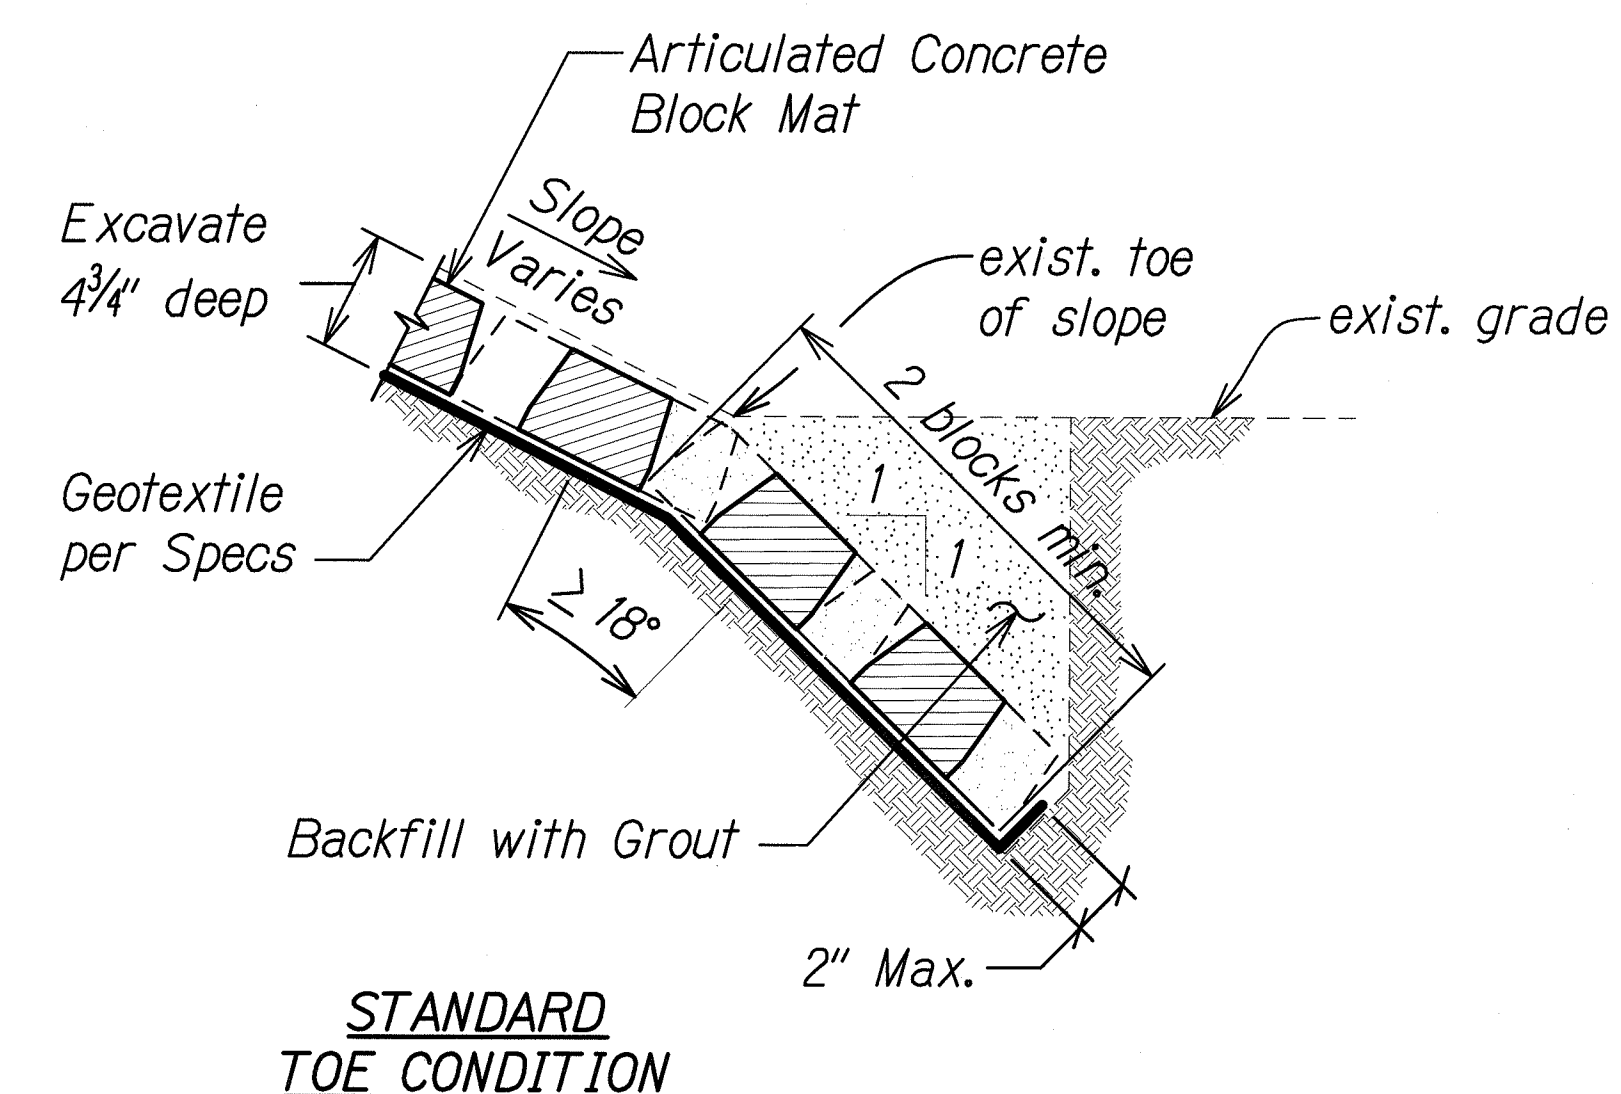
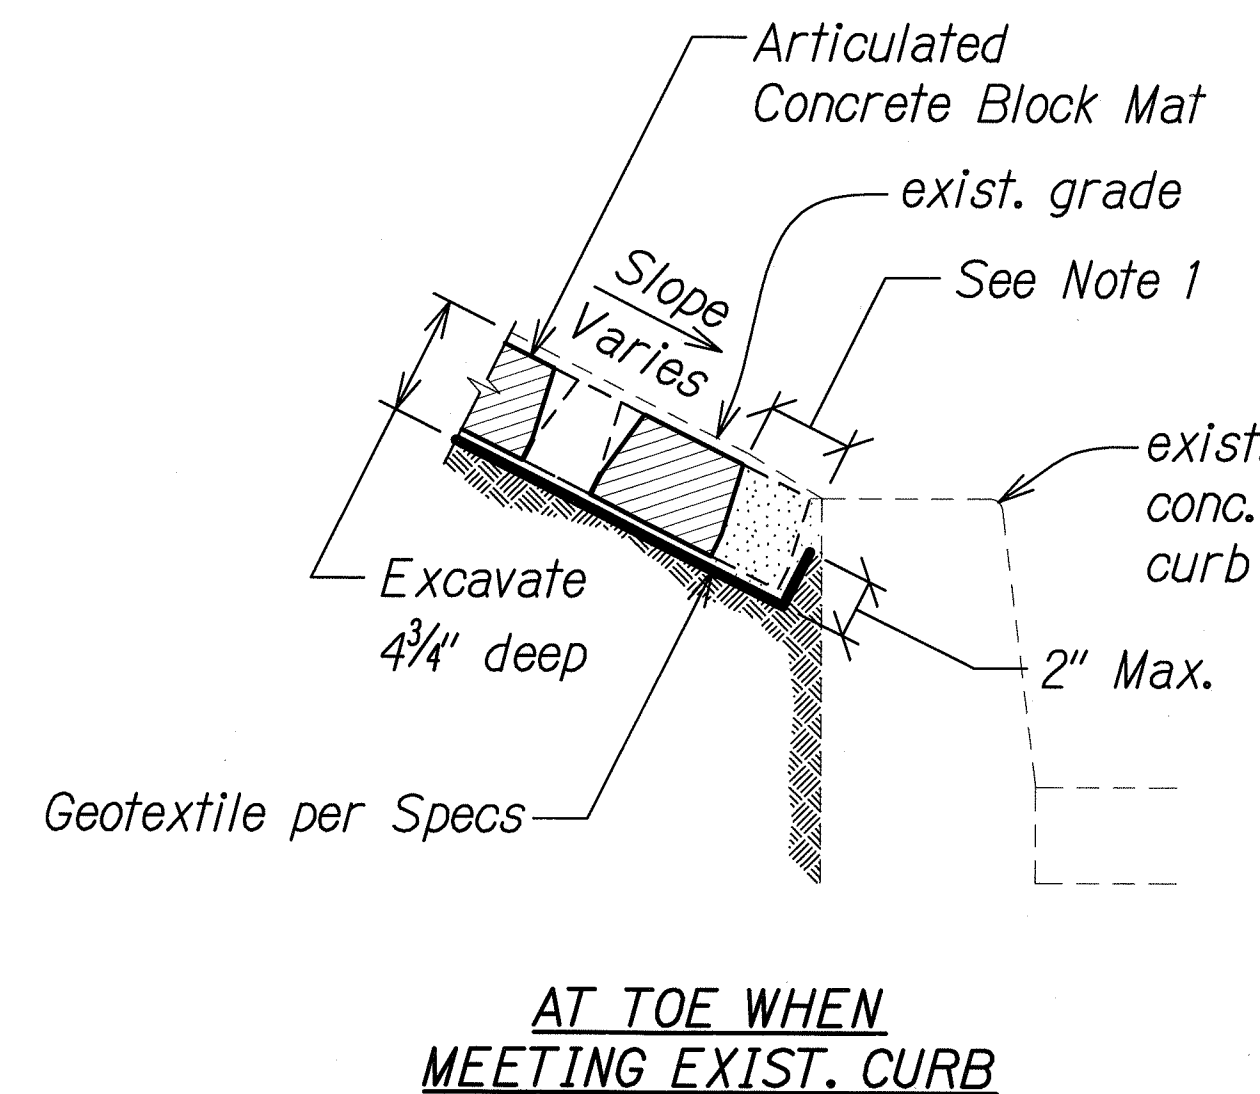
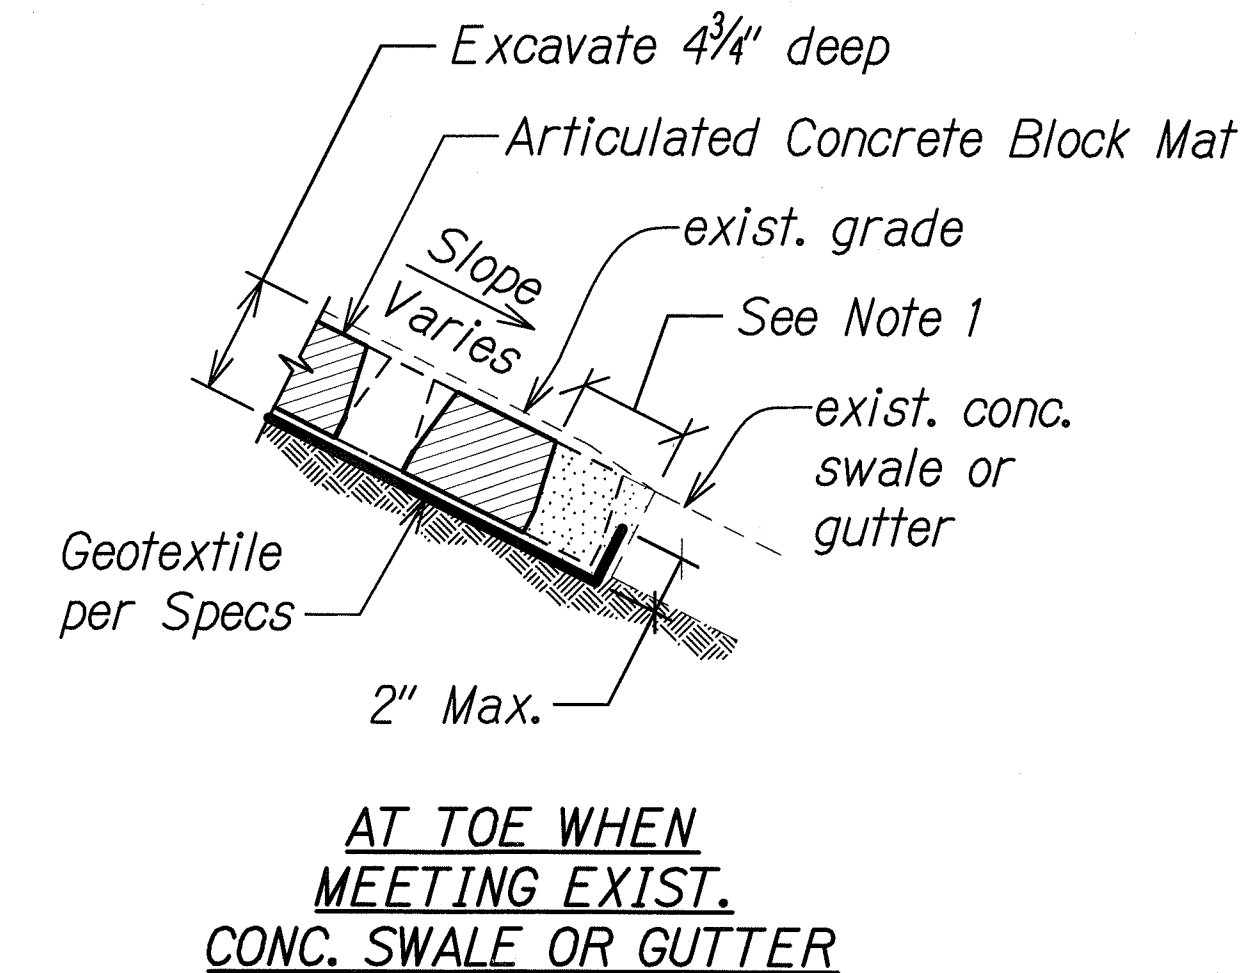
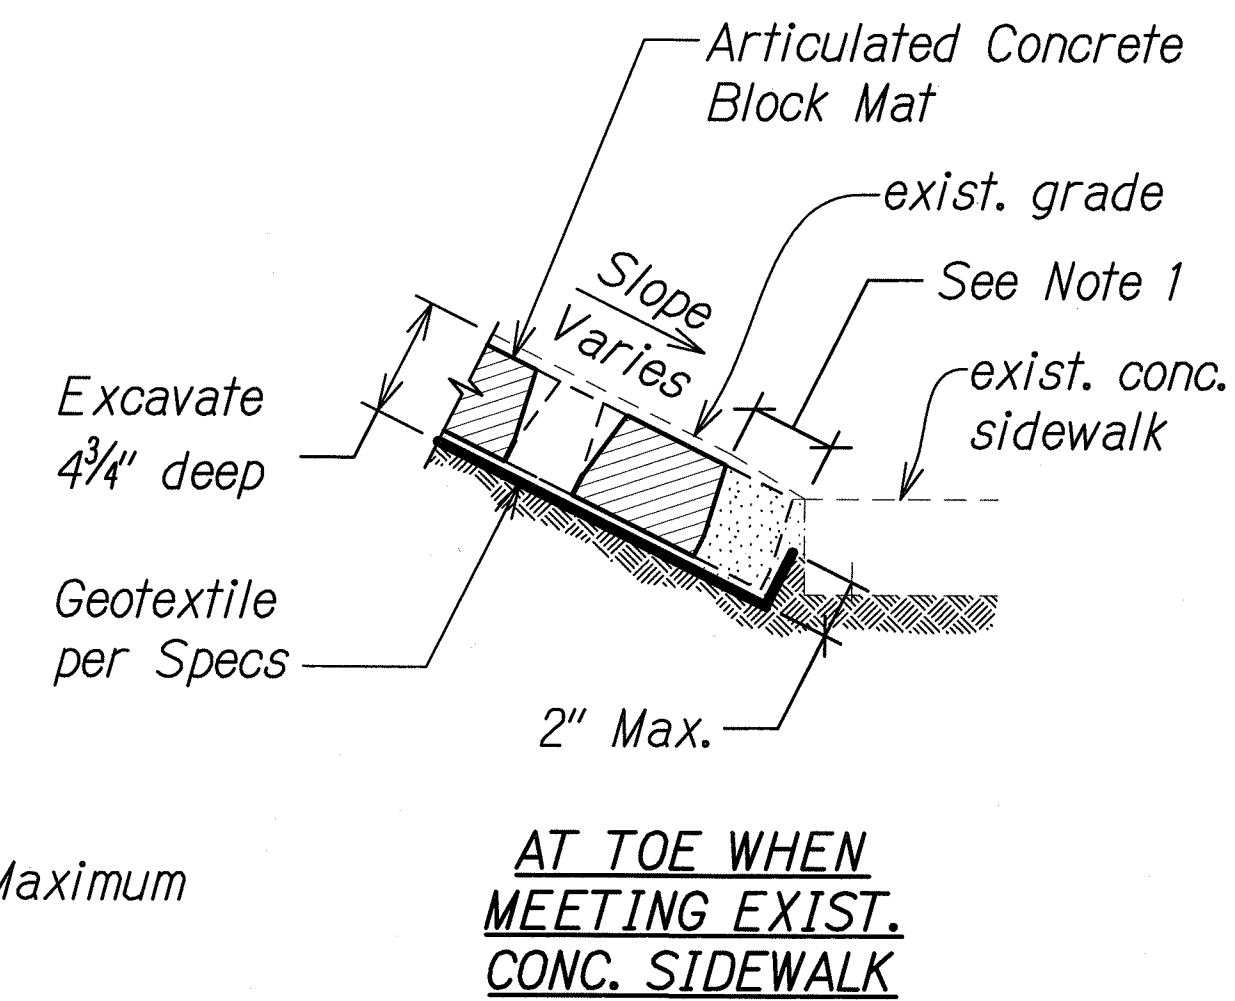
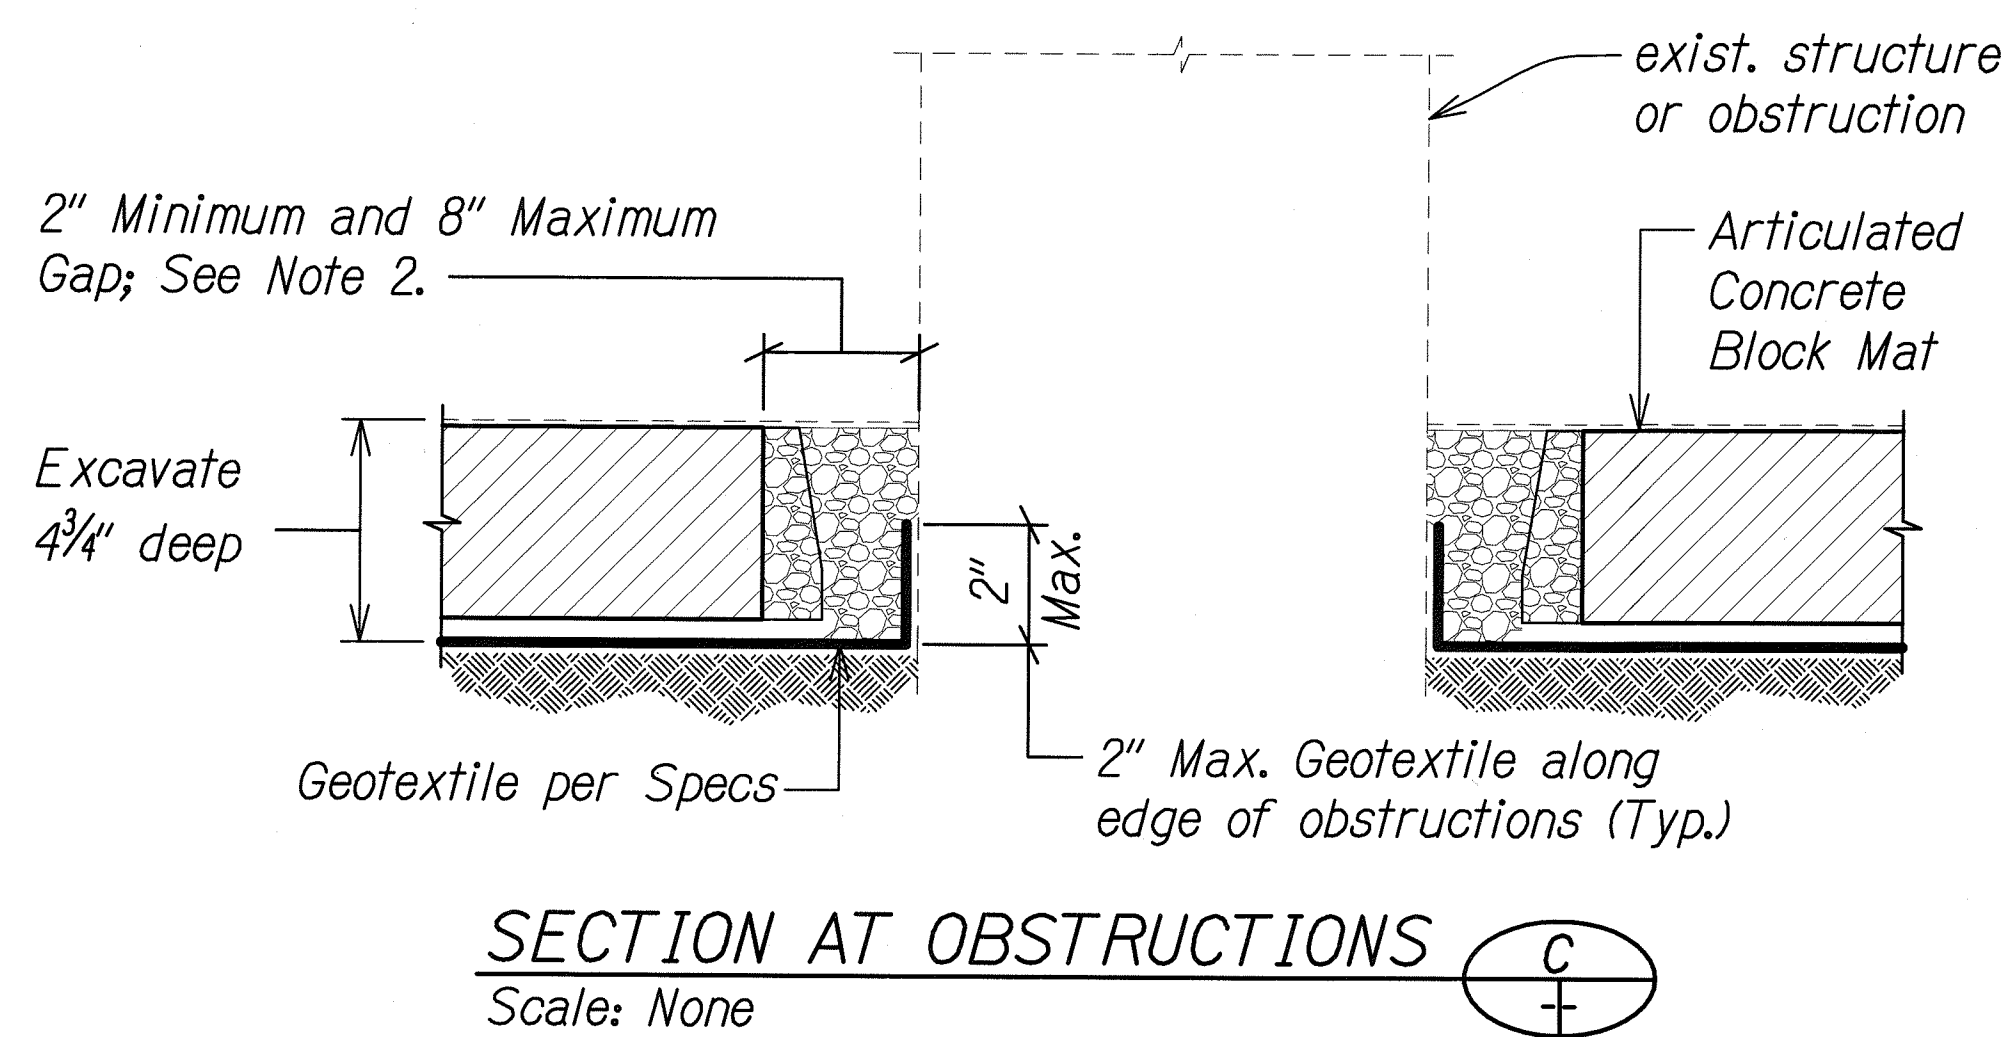
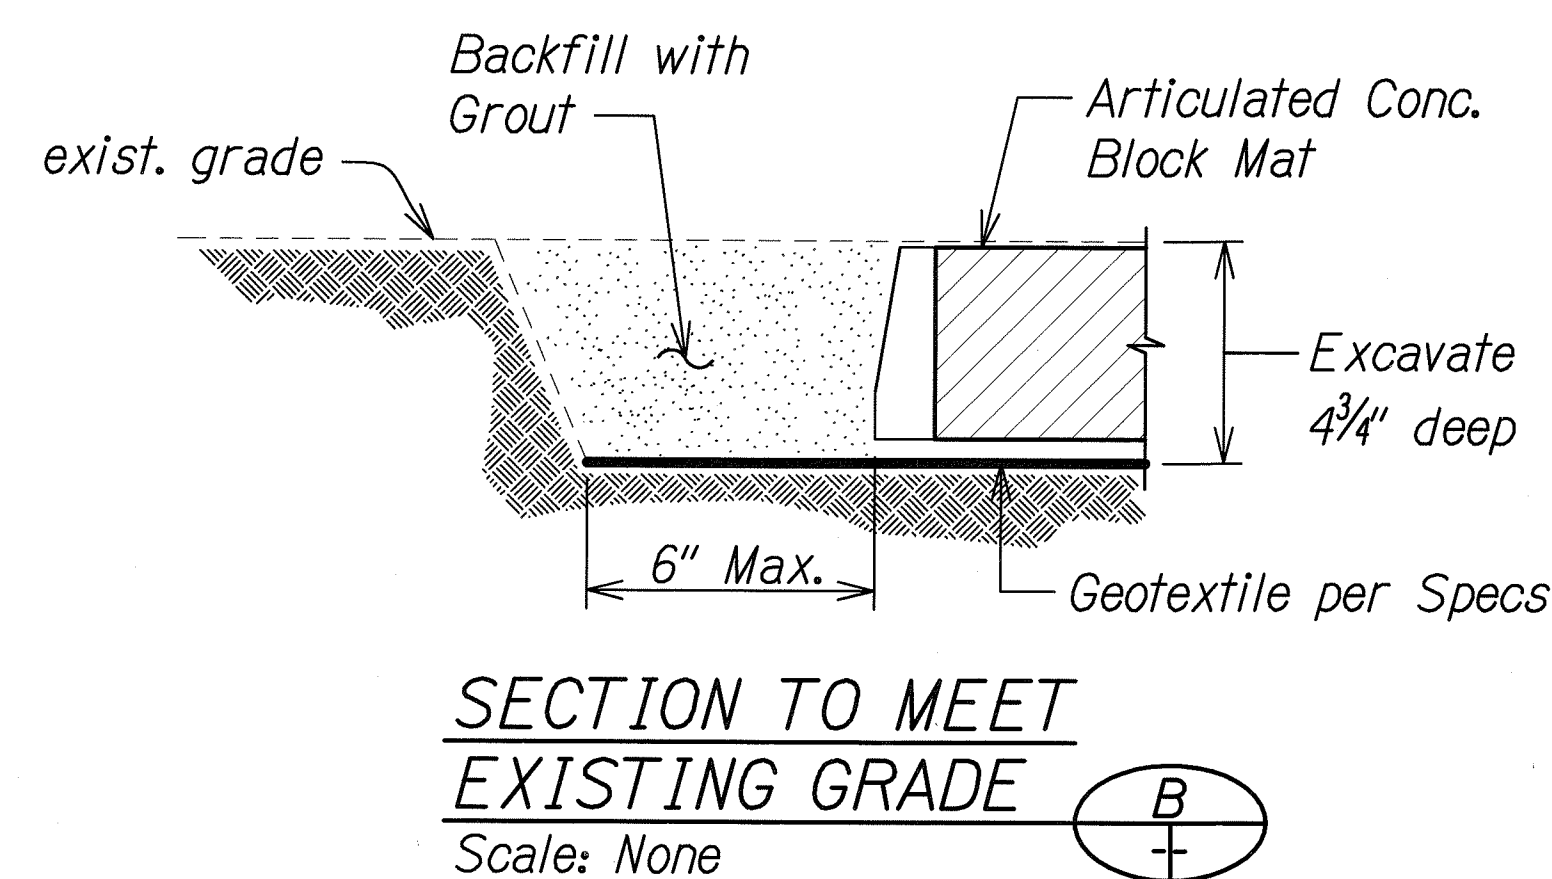



FED. ROAD DIST. NO.	STATE	PROJ. NO.	FISCAL YEAR	SHEET NO.	TOTAL SHEETS
HAWAII	HAW.	HWY-O-04-10M	2010	ADD. 11	45

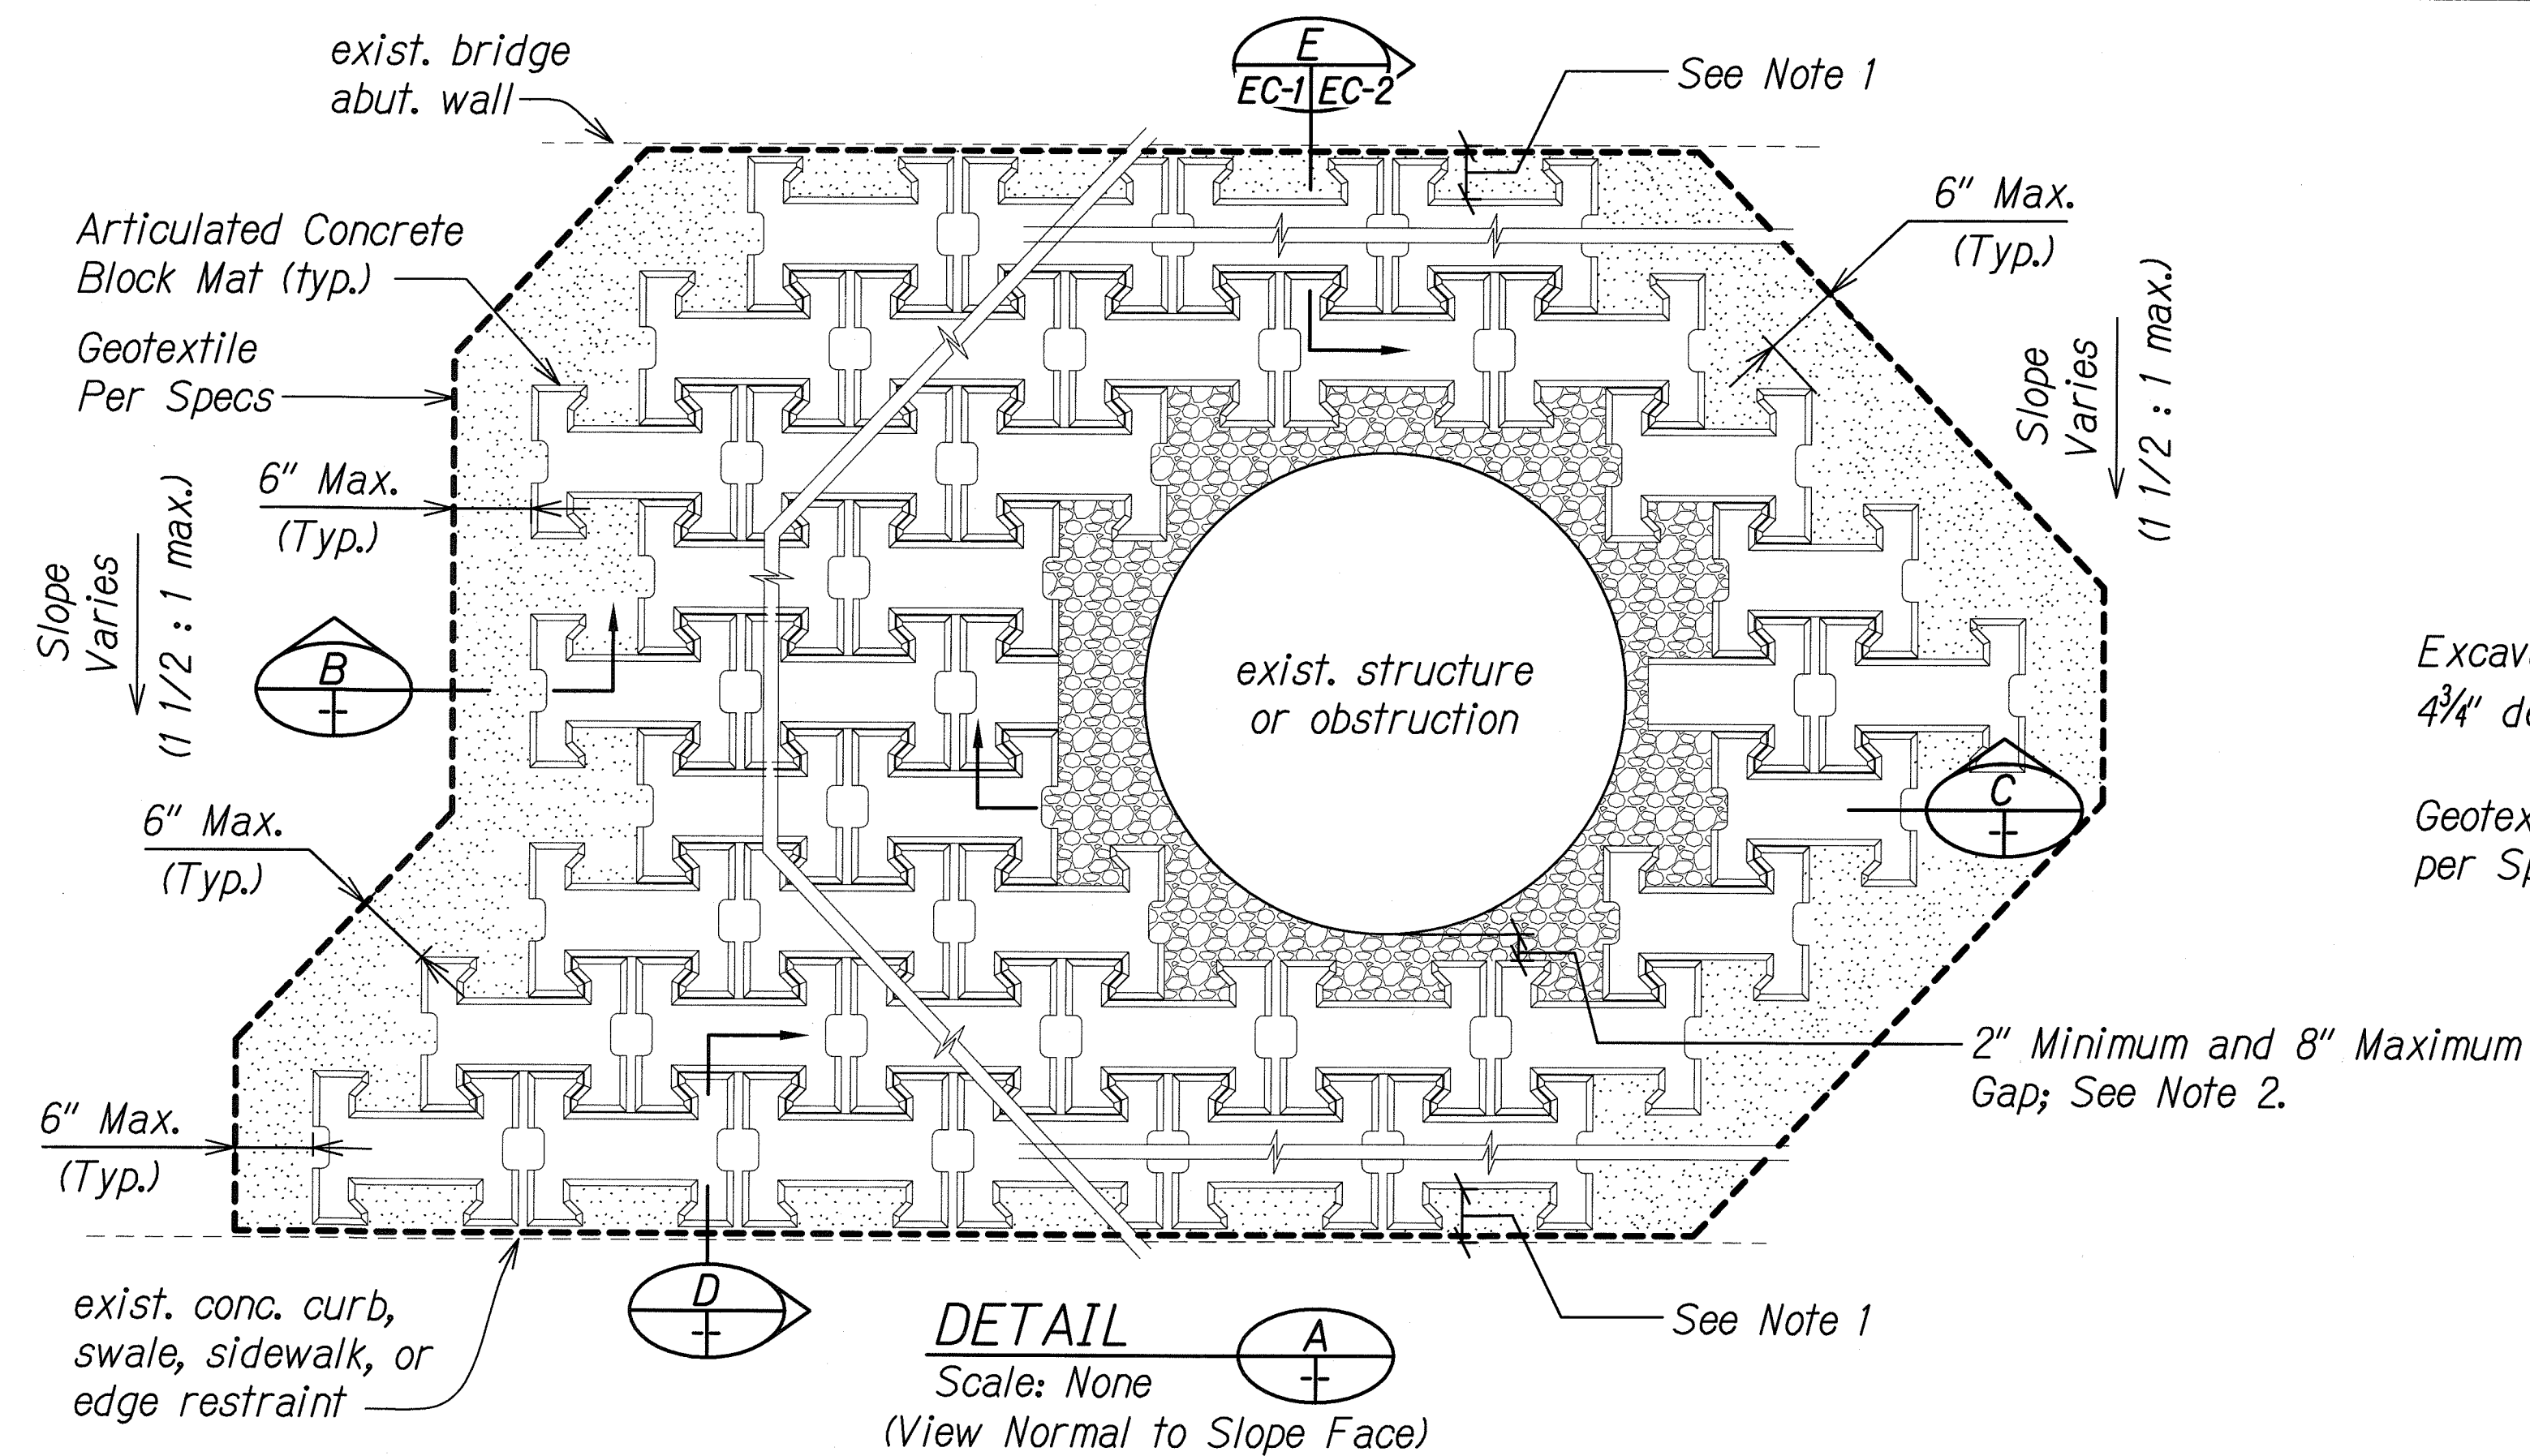

**TYPICAL SECTION**  
Scale: None

- NOTES:**
1. Grout all gaps at peak and toe of ACBM.
  2. ACBM blocks may be sawcut to meet the space requirements. The remaining open areas shall be filled with uncompacted 3B Fine aggregate material and made flush with the top of the ACBMs as indicated in the Specifications.

6/9/10	Changed design of ACBM system around exist. structure or obstruction
DATE	REVISION

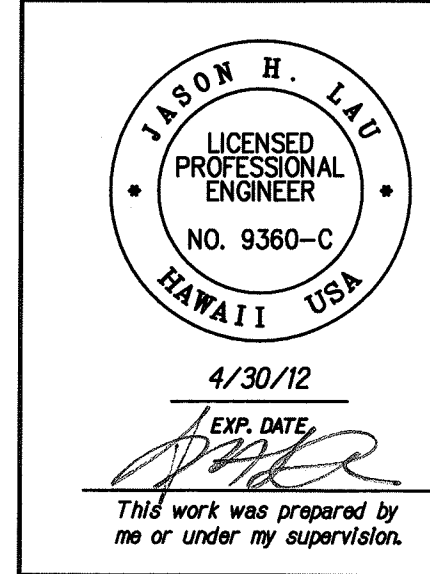

STATE OF HAWAII  
DEPARTMENT OF TRANSPORTATION  
HIGHWAYS DIVISION

**ARTICULATED CONCRETE BLOCK MAT DETAILS**

SLOPE MAINTENANCE FOR EROSION CONTROL AT VARIOUS SITES ON OAHU, PHASE 4

Project No. HWY-O-04-10M

Scale: As Shown Date: May 2010

SHEET No. EC-1 OF 17 SHEETS