


FED. ROAD DIST. NO.	STATE	PROJ. NO.	FISCAL YEAR	SHEET NO.	TOTAL SHEETS
HAWAII	HAW.	HWY-O-01-12	2012	22	123

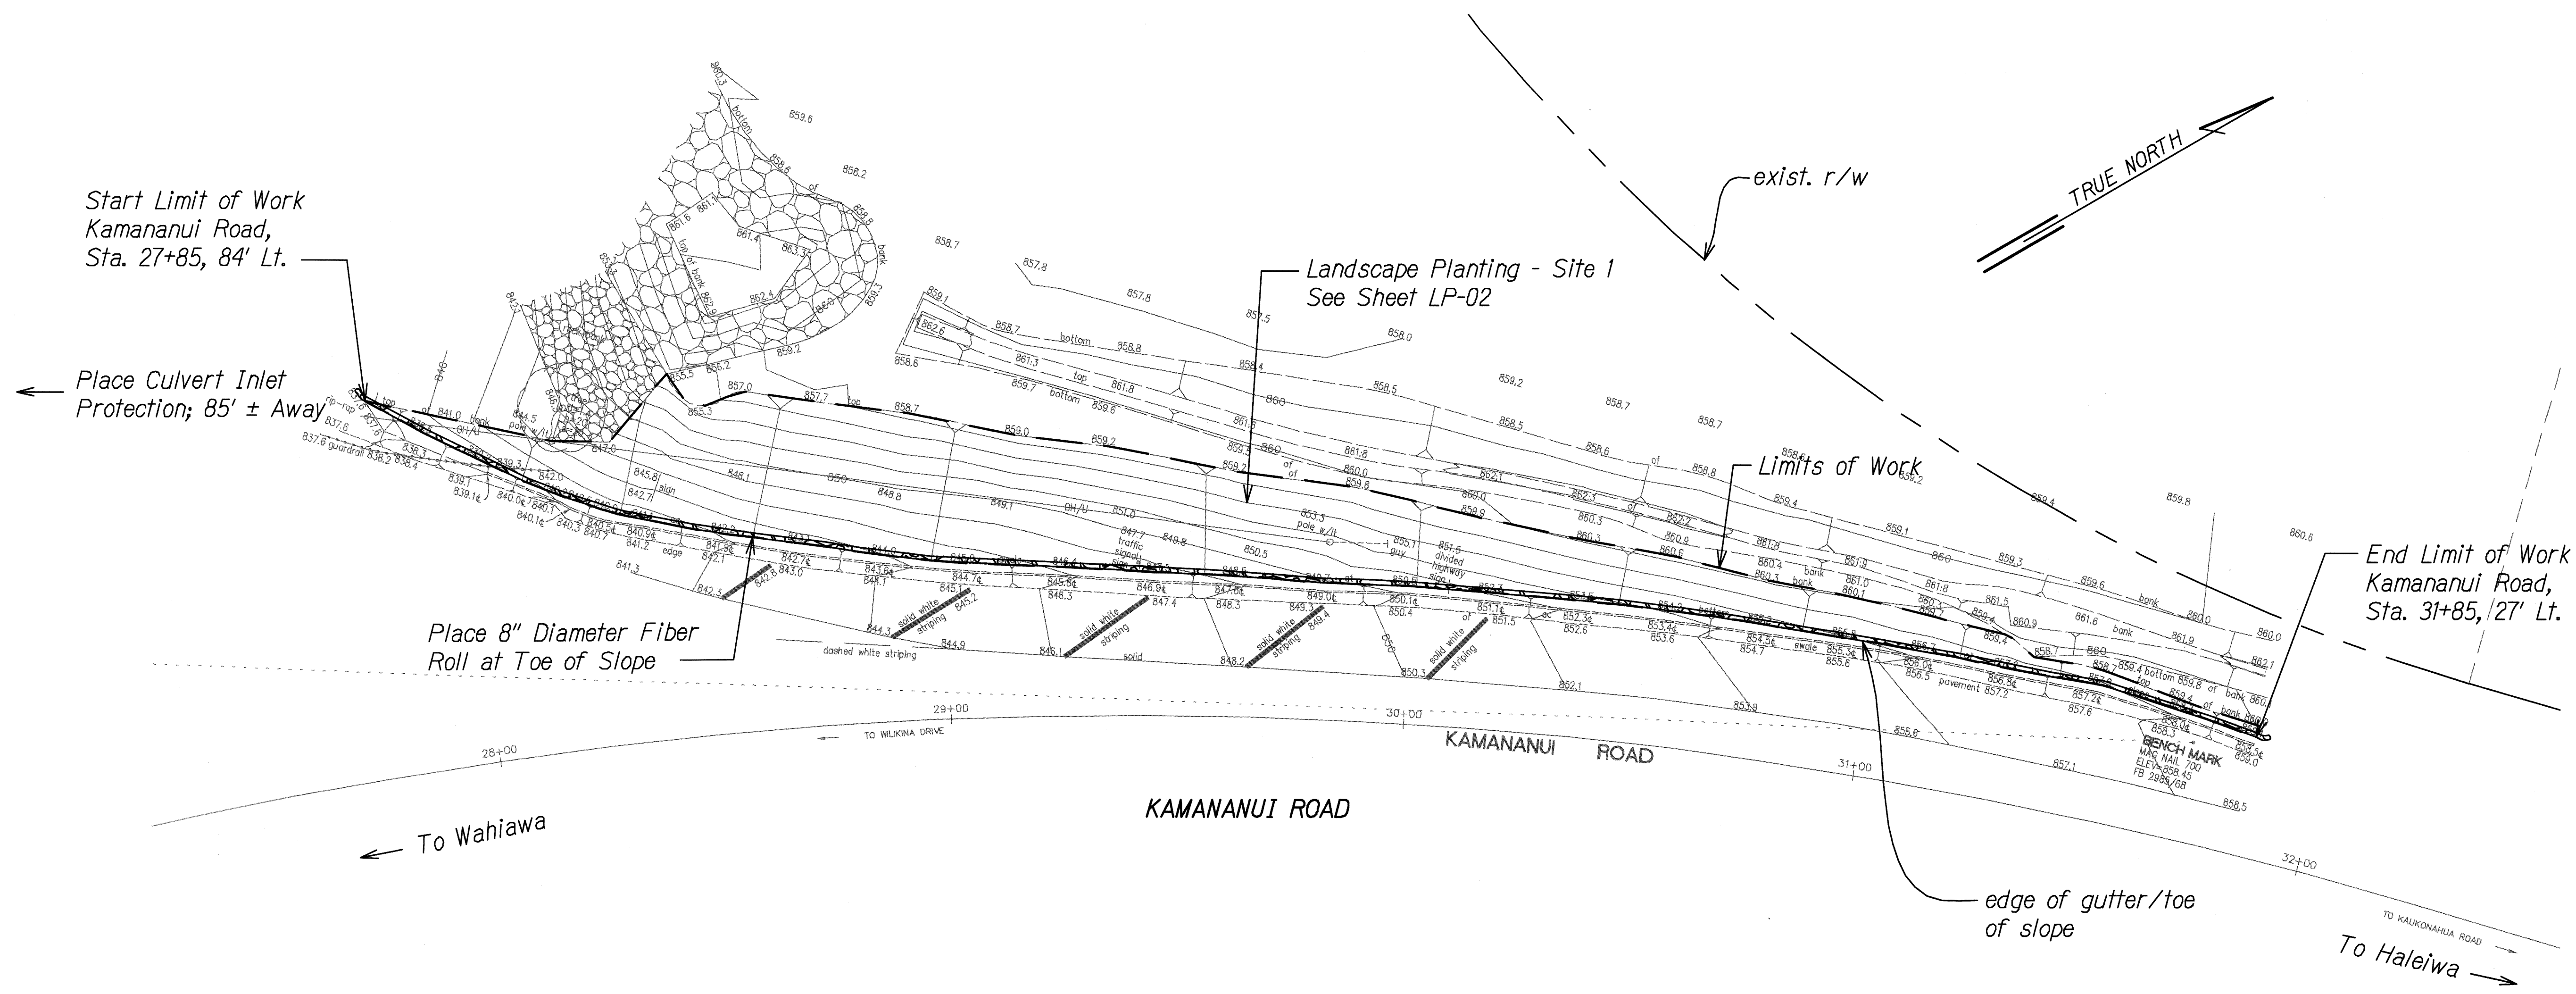

EROSION CONTROL PLAN SITE 1
Scale: 1" = 20'-0"

Estimated Area of Grassing Measured Along Slope Face: 7,000 SF

- Notes:**
1. Install erosion control matting on slopes greater than 3:1. See Sheet LP-02.
 2. For erosion mat details, see Sheets EC-42 & 43.

SURVEY PLOTTED BY	DATE
DESIGNED BY	
TRACED BY	
NOTE BOOK	
QUANTITIES BY	
CHECKED BY	

4/30/12
EXP. DATE
This work was prepared by me or under my supervision.

STATE OF HAWAII
DEPARTMENT OF TRANSPORTATION
HIGHWAYS DIVISION


EROSION CONTROL PLAN
SITE 1

SLOPE IMPROVEMENTS FOR EROSION CONTROL
AT VARIOUS SITES ON OAHU, PHASE 5

Project No. HWY-O-01-12
Scale: 1" = 20' Date: April 2012

SHEET No. EC-1 OF 50 SHEETS

FED. ROAD DIST. NO.	STATE	PROJ. NO.	FISCAL YEAR	SHEET NO.	TOTAL SHEETS
HAWAII	HAW.	HWY-O-01-12	2012	23	123

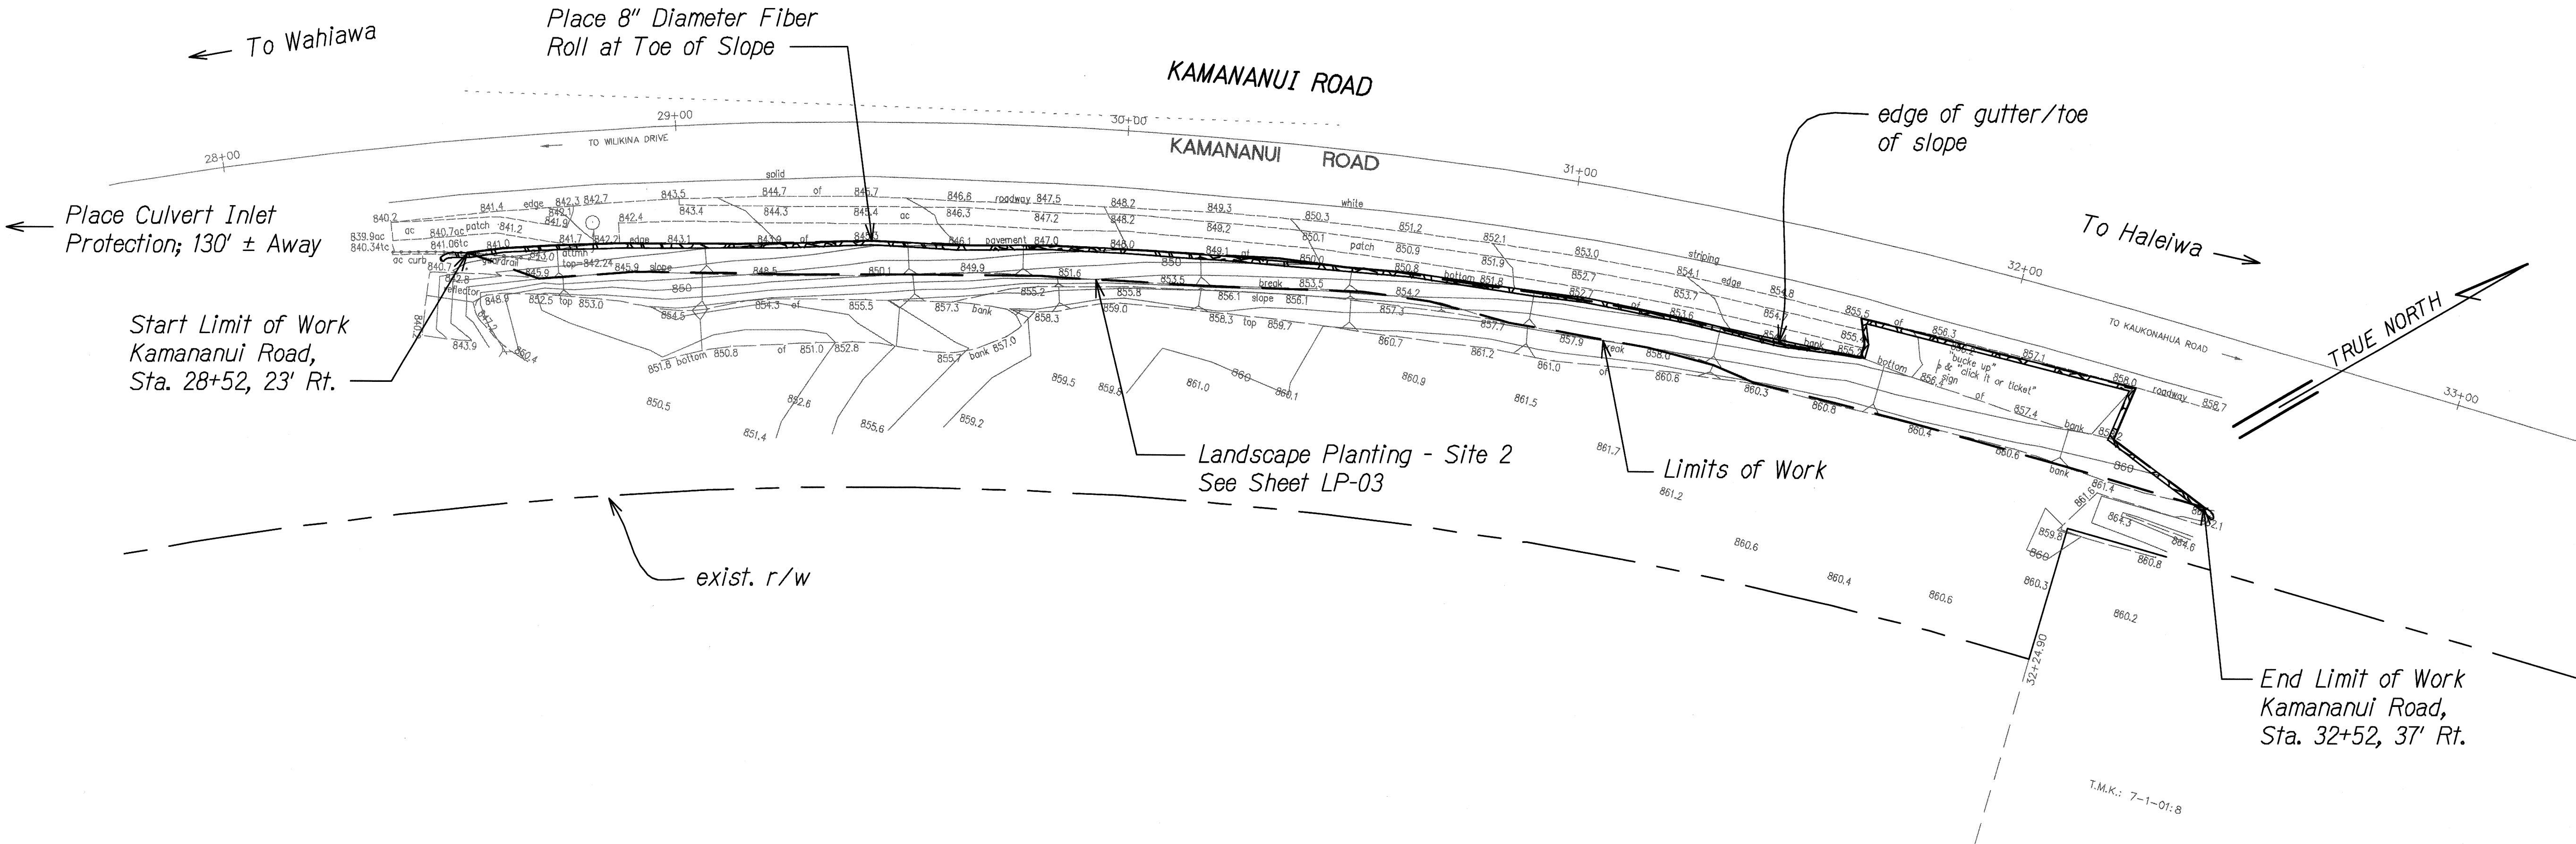

EROSION CONTROL PLAN SITE 2
 Scale: 1" = 20'-0"

Estimated Area of Grassing Measured Along Slope Face: 3,500 SF

- Notes:**
1. Install erosion control matting on slopes greater than 3:1. See Sheet LP-03.
 2. For erosion mat details, see Sheets EC-42 & 43.

SURVEY PLOTTED BY	DATE
DESIGNED BY	
TRACED BY	
NOTE BOOK	
QUANTITIES BY	
CHECKED BY	

EC-2.DWG 1/30/2012 10:40:03 PM

4/30/12
 EXP. DATE
[Signature]
 This work was prepared by
 me or under my supervision.


STATE OF HAWAII
 DEPARTMENT OF TRANSPORTATION
 HIGHWAYS DIVISION

EROSION CONTROL PLAN
SITE 2

SLOPE IMPROVEMENTS FOR EROSION CONTROL
AT VARIOUS SITES ON OAHU, PHASE 5

Project No. HWY-O-01-12
 Scale: 1" = 20' Date: April 2012


DIST. NO.	DIST.	PROJECT NO.	YEAR	NO.
HAWAII	HAW.	HWY-O-01-12	2012	24

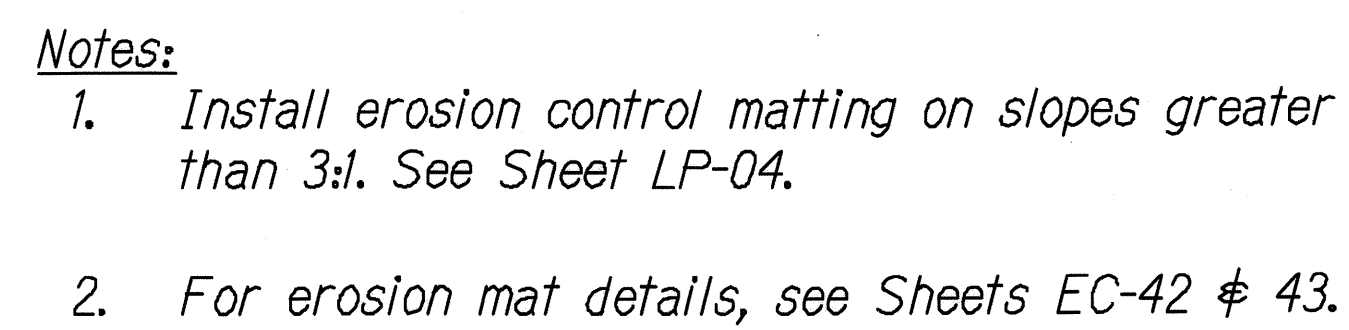

Scale: 1" = 20'-0"

24

FED. ROAD DIST. NO.	STATE	PROJ. NO.	FISCAL YEAR	SHEET NO.	TOTAL SHEETS
HAWAII	HAW.	HWY-O-01-12	2012	25	123

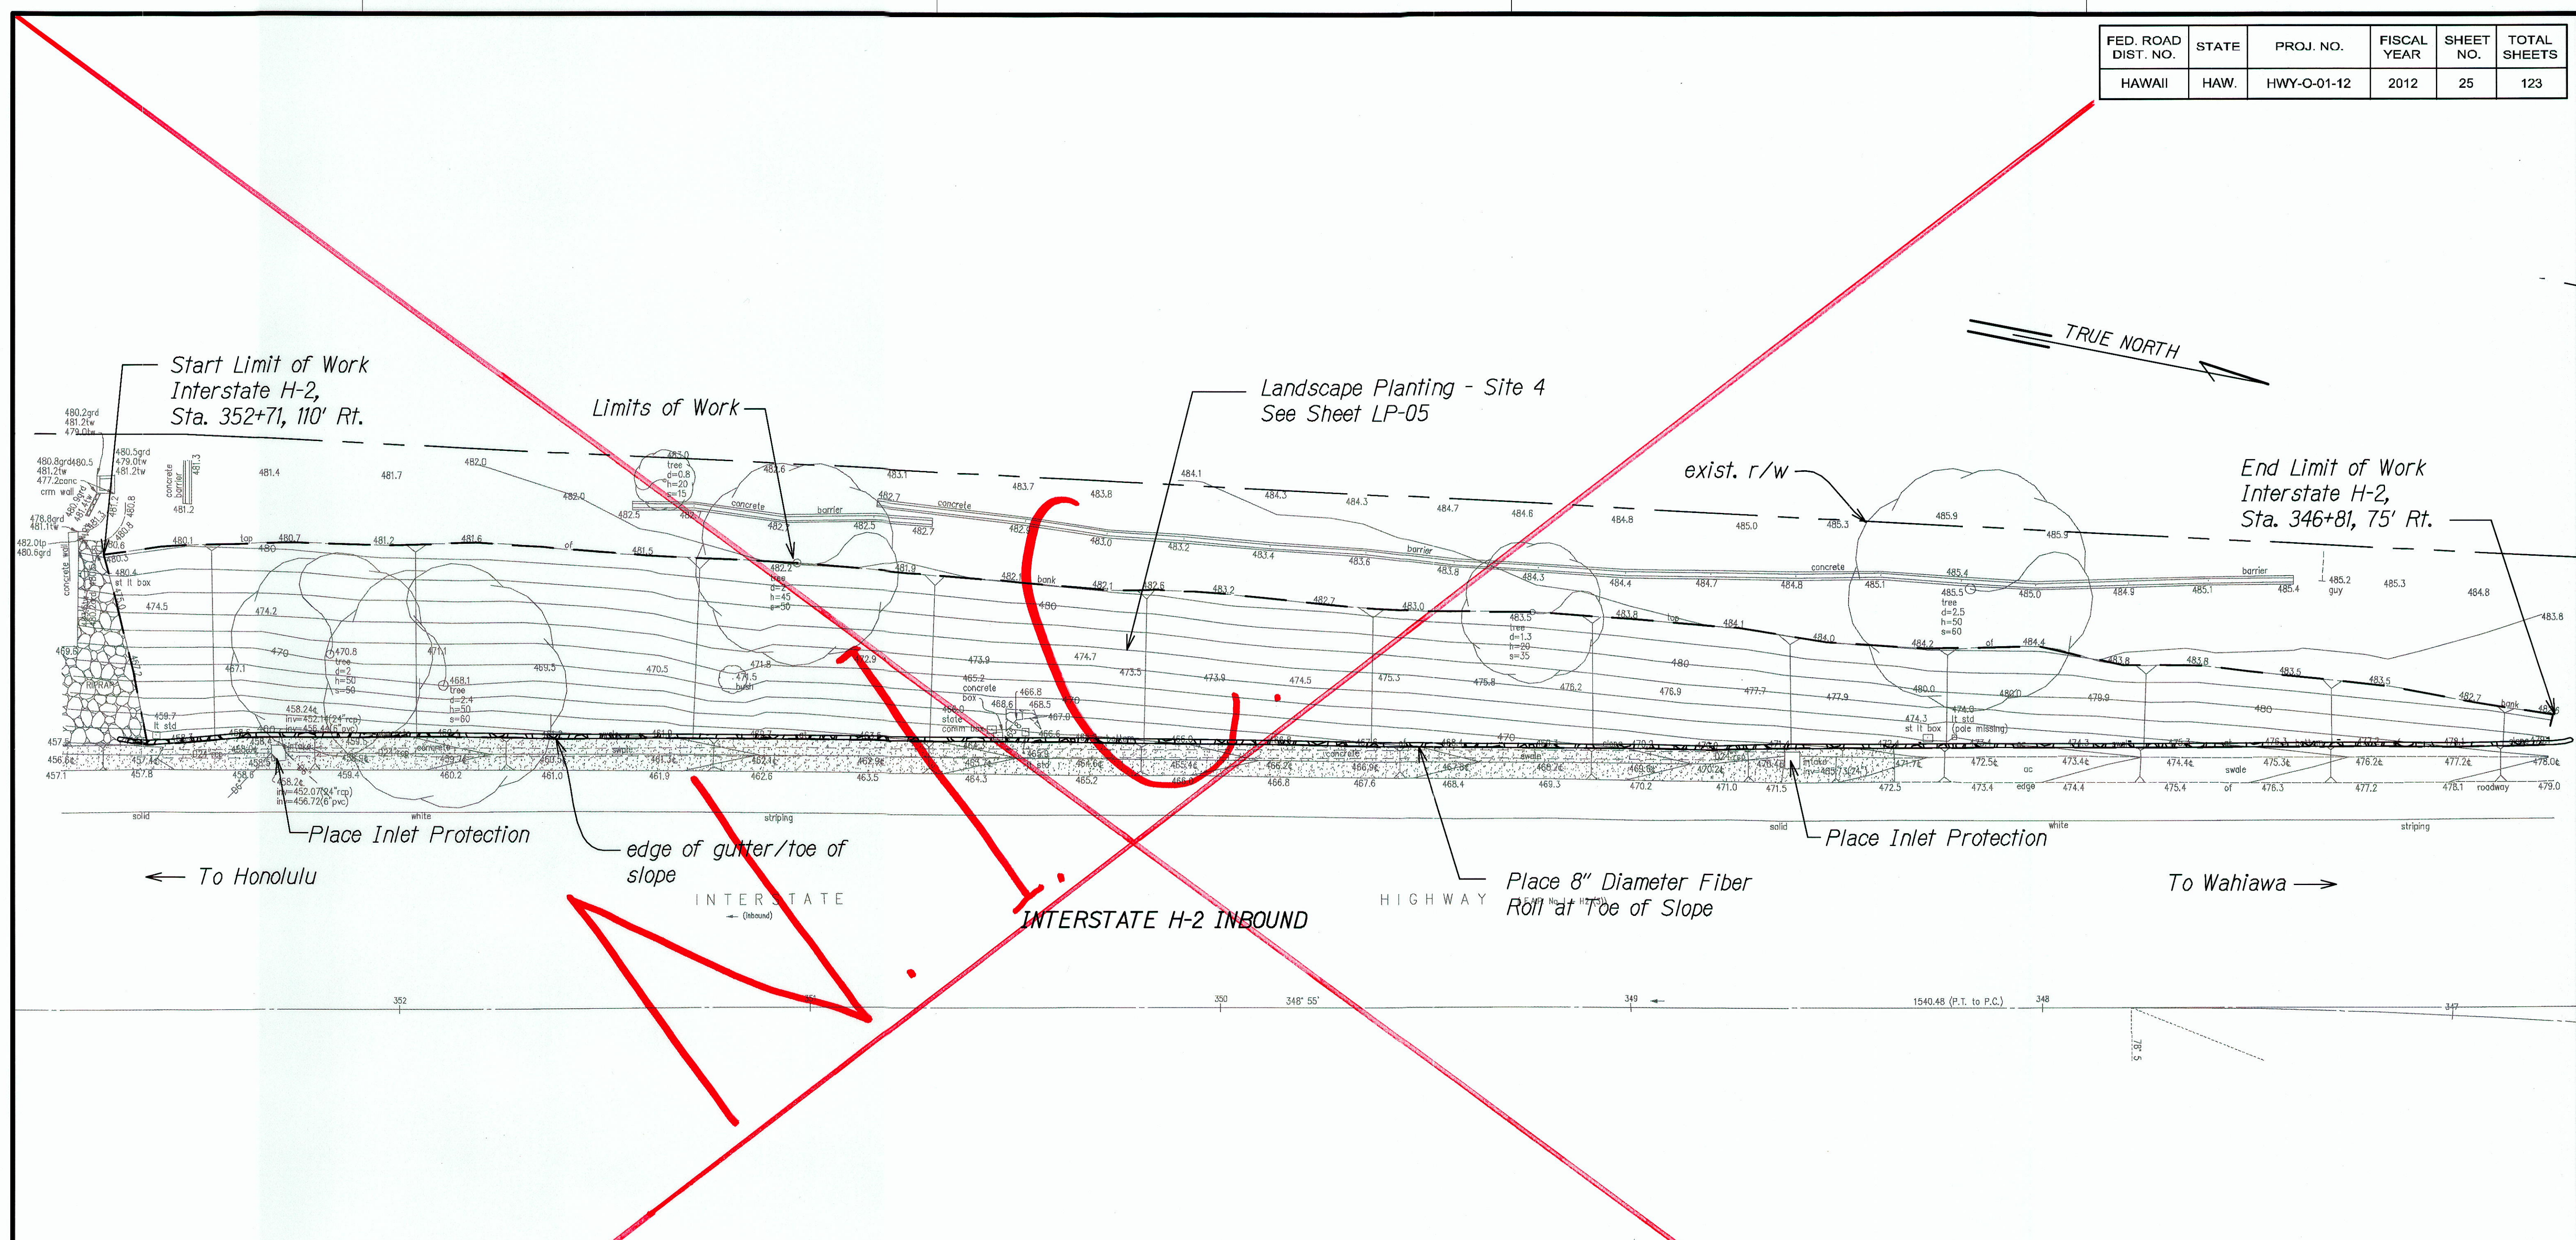

EROSION CONTROL PLAN SITE 4
Scale: 1" = 20'-0"

Estimated Area of Grassing Measured Along Slope Face: 19,750 SF

- Notes:
1. Install erosion control matting on slopes greater than 3:1. See Sheet LP-05.
 2. For erosion mat details, see Sheets EC-42 & 43.

SURVEY PLOTTED BY	DATE
DRAWN BY	
CHECKED BY	
NOTE BOOK	
QUANTITIES BY	
CHECKED BY	

4/30/12
EXP. DATE
This work was prepared by me or under my supervision.

STATE OF HAWAII
DEPARTMENT OF TRANSPORTATION
HIGHWAYS DIVISION


EROSION CONTROL PLAN
SITE 4

SLOPE IMPROVEMENTS FOR EROSION CONTROL
AT VARIOUS SITES ON OAHU, PHASE 5
Project No. HWY-O-01-12
Scale: 1" = 20' Date: April 2012

SHEET No. EC-4 OF 50 SHEETS

"AS-BUILT"

FED. ROAD DIST. NO.	STATE	PROJ. NO.	FISCAL YEAR	SHEET NO.	TOTAL SHEETS
HAWAII	HAW.	HWY-O-01-12	2012	26	123

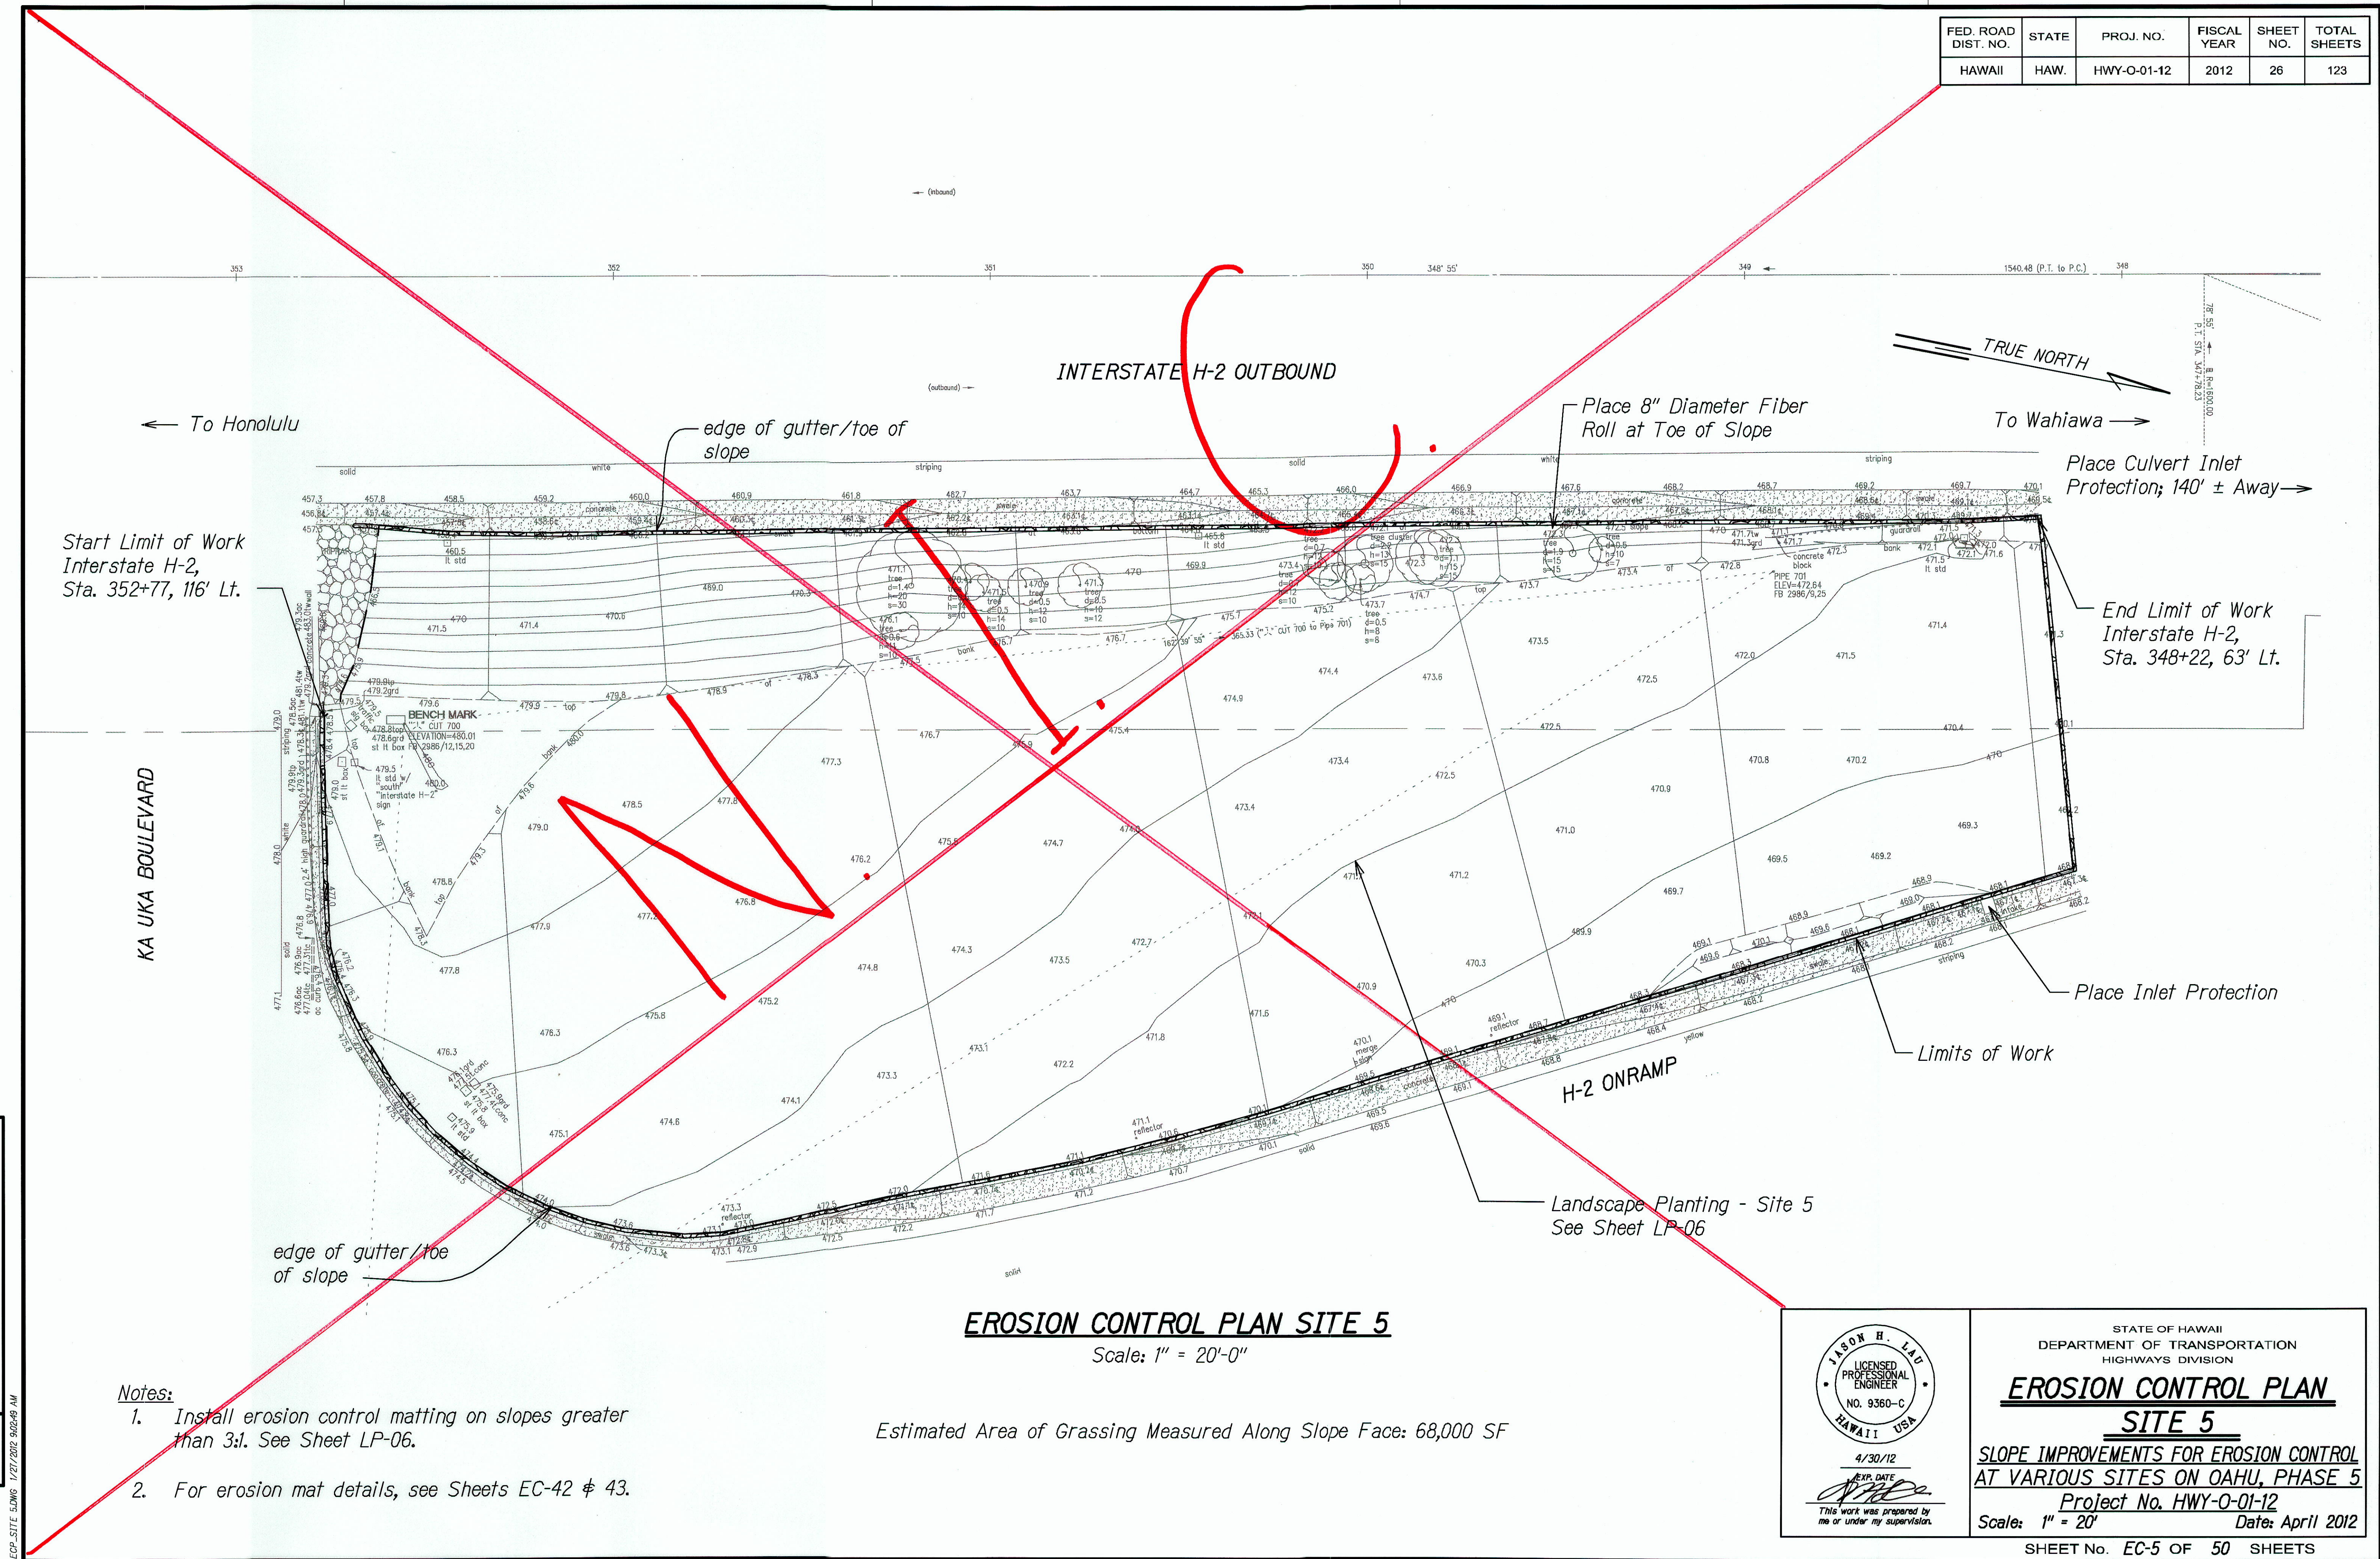

Start Limit of Work
Interstate H-2,
Sta. 352+77, 116' Lt.

KA UKA BOULEVARD

INTERSTATE H-2 OUTBOUND

Place 8" Diameter Fiber
Roll at Toe of Slope

To Wahiawa →

Place Culvert Inlet
Protection; 140' ± Away →

End Limit of Work
Interstate H-2,
Sta. 348+22, 63' Lt.

Place Inlet Protection

Limits of Work

H-2 ONRAMP

Landscape Planting - Site 5
See Sheet LP-06

EROSION CONTROL PLAN SITE 5
Scale: 1" = 20'-0"

Estimated Area of Grassing Measured Along Slope Face: 68,000 SF

- Notes:**
1. Install erosion control matting on slopes greater than 3:1. See Sheet LP-06.
 2. For erosion mat details, see Sheets EC-42 & 43.

4/30/12
EXP. DATE
This work was prepared by me or under my supervision.

STATE OF HAWAII
DEPARTMENT OF TRANSPORTATION
HIGHWAYS DIVISION

EROSION CONTROL PLAN
SITE 5


SLOPE IMPROVEMENTS FOR EROSION CONTROL
AT VARIOUS SITES ON OAHU, PHASE 5

Project No. HWY-O-01-12
Scale: 1" = 20' Date: April 2012

SHEET No. EC-5 OF 50 SHEETS

"AS-BUILT"

FED. ROAD DIST. NO.	STATE	PROJ. NO.	FISCAL YEAR	SHEET NO.	TOTAL SHEETS
HAWAII	HAW.	HWY-Q-01-12	2012	27	123

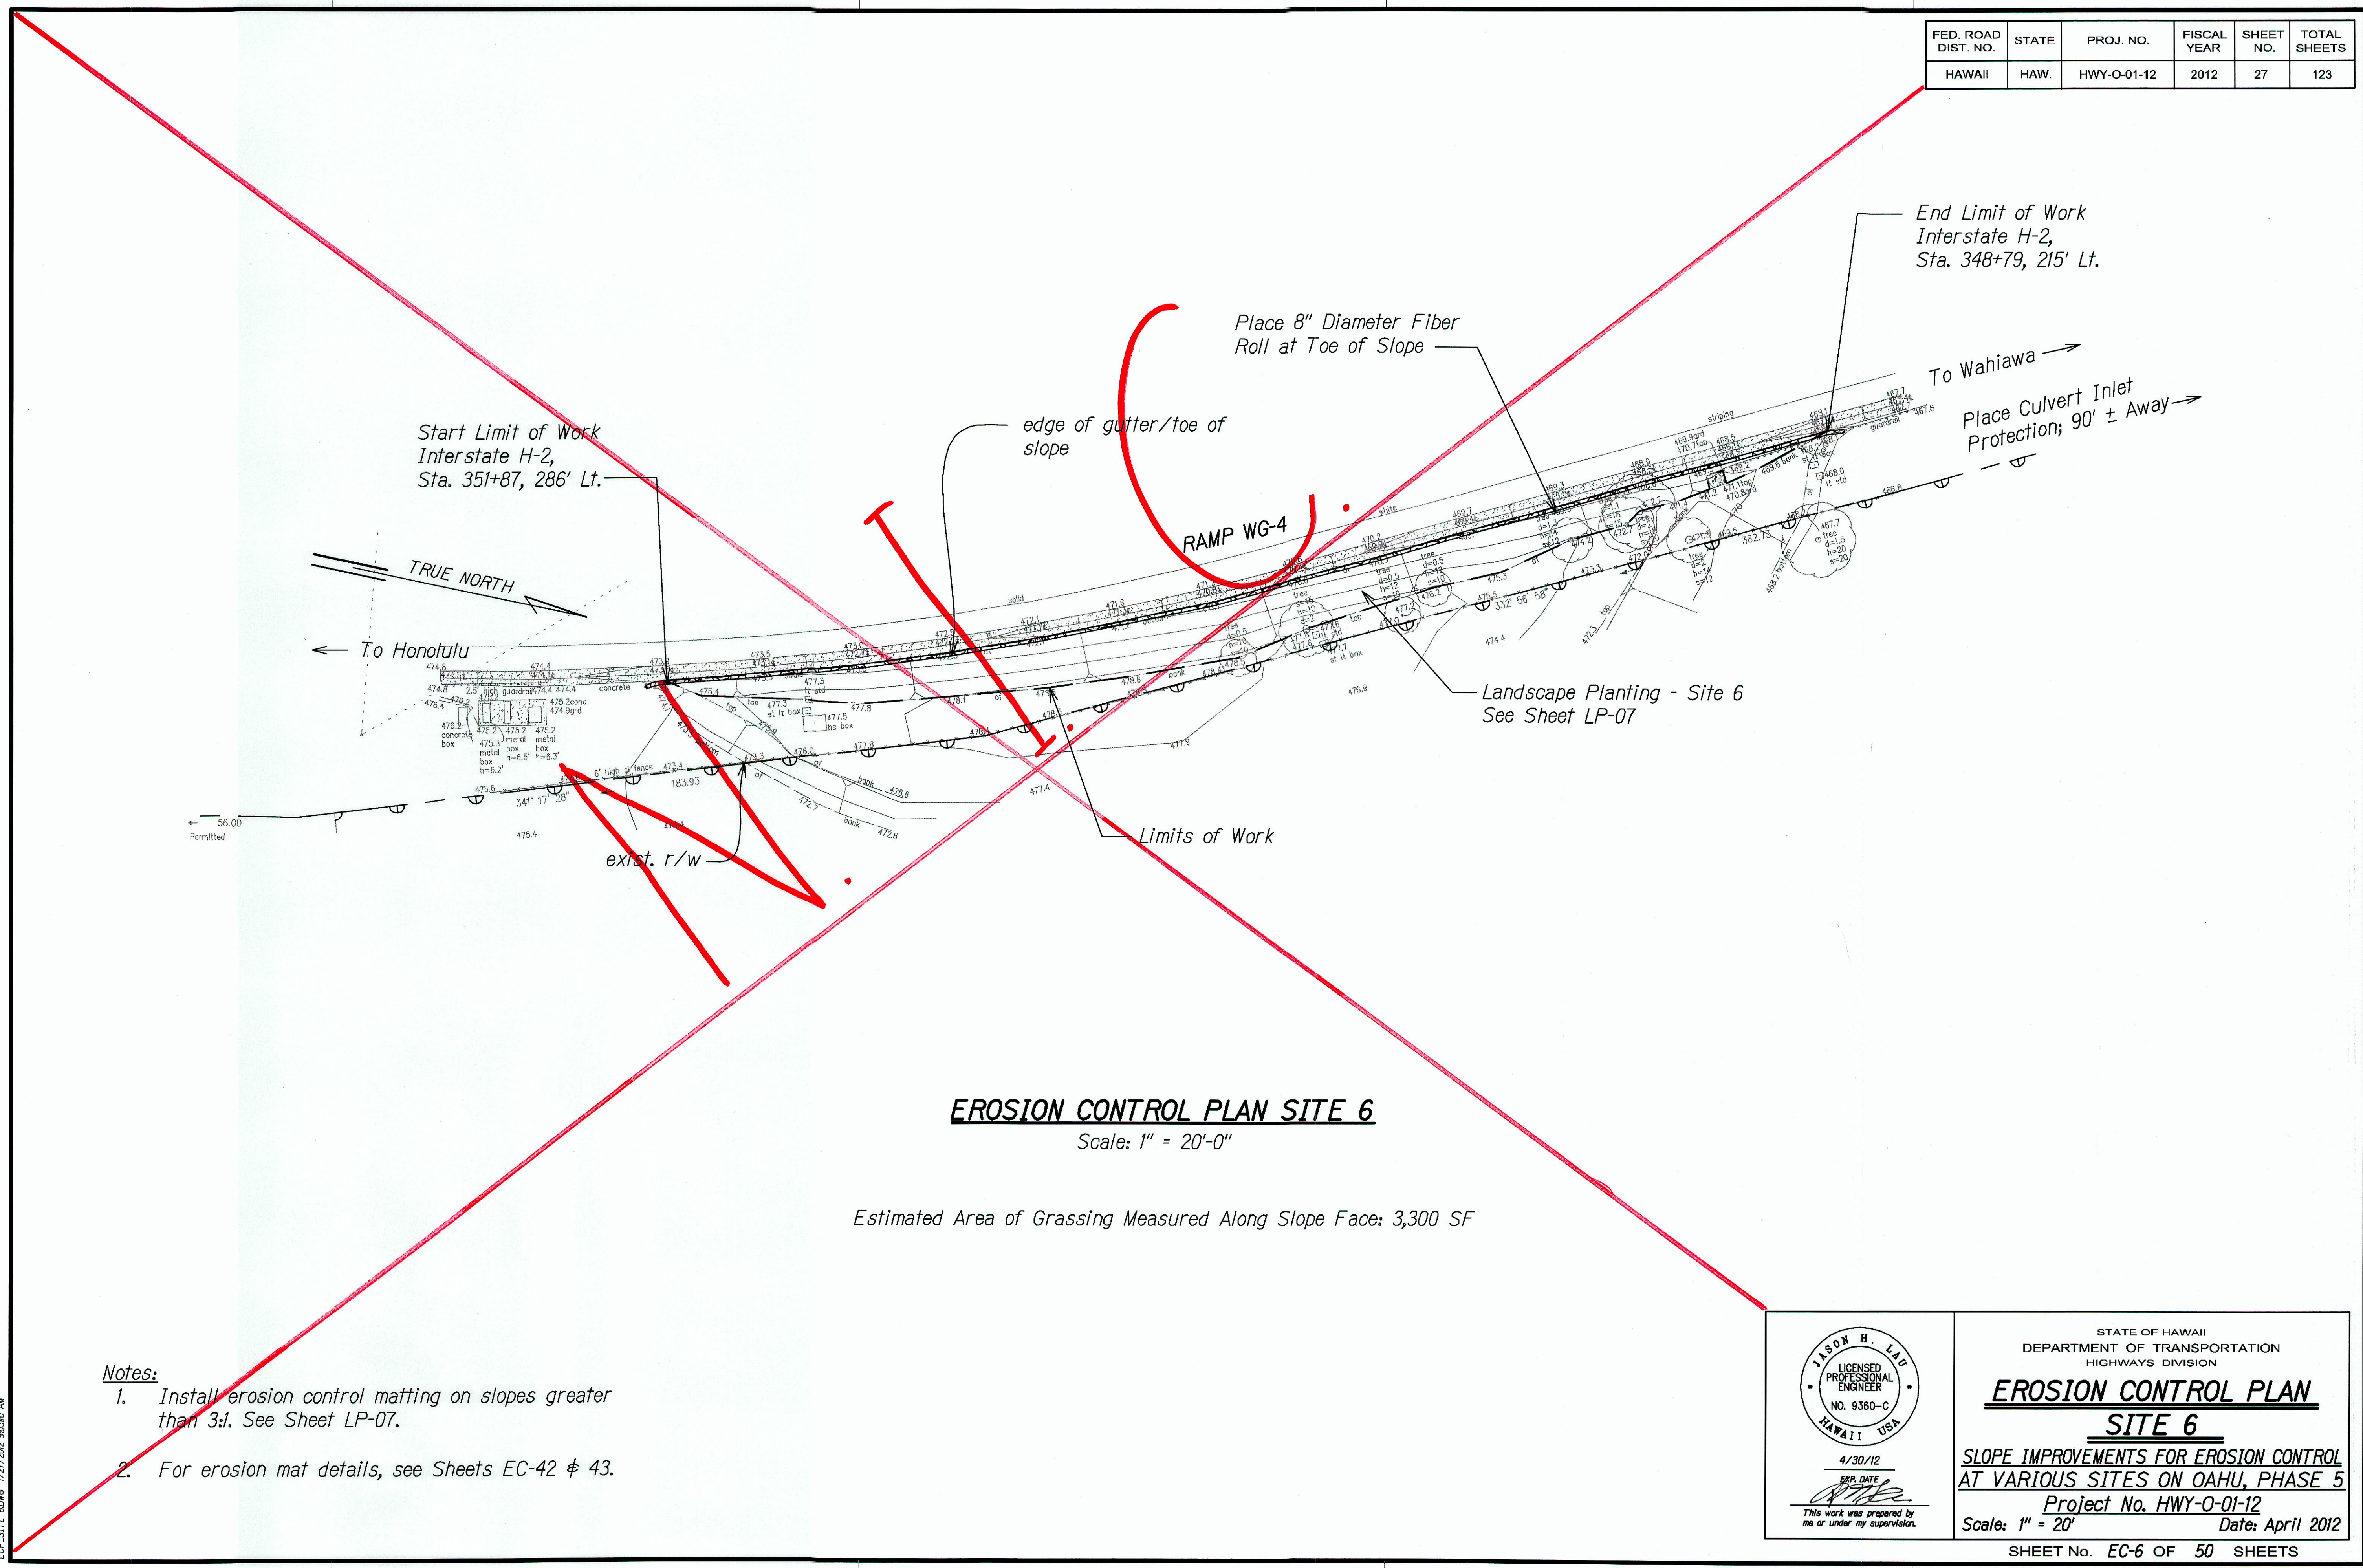

EROSION CONTROL PLAN SITE 6
Scale: 1" = 20'-0"

Estimated Area of Grassing Measured Along Slope Face: 3,300 SF

- Notes:
1. Install erosion control matting on slopes greater than 3:1. See Sheet LP-07.
 2. For erosion mat details, see Sheets EC-42 & 43.

SURVEY PLOTTED BY	DATE
DRAWN BY	
DESIGNED BY	
QUANTITIES BY	
CHECKED BY	
ORIGINAL PLAN	
NOTE BOOK	
DATE	

4/30/12
This work was prepared by me or under my supervision.

STATE OF HAWAII
DEPARTMENT OF TRANSPORTATION
HIGHWAYS DIVISION

EROSION CONTROL PLAN
SITE 6


SLOPE IMPROVEMENTS FOR EROSION CONTROL
AT VARIOUS SITES ON OAHU, PHASE 5

Project No. HWY-Q-01-12
Scale: 1" = 20' Date: April 2012

SHEET No. EC-6 OF 50 SHEETS

"AS-BUILT"

FED. ROAD DIST. NO.	STATE	PROJ. NO.	FISCAL YEAR	SHEET NO.	TOTAL SHEETS
HAWAII	HAW.	HWY-O-01-12	2012	28	123

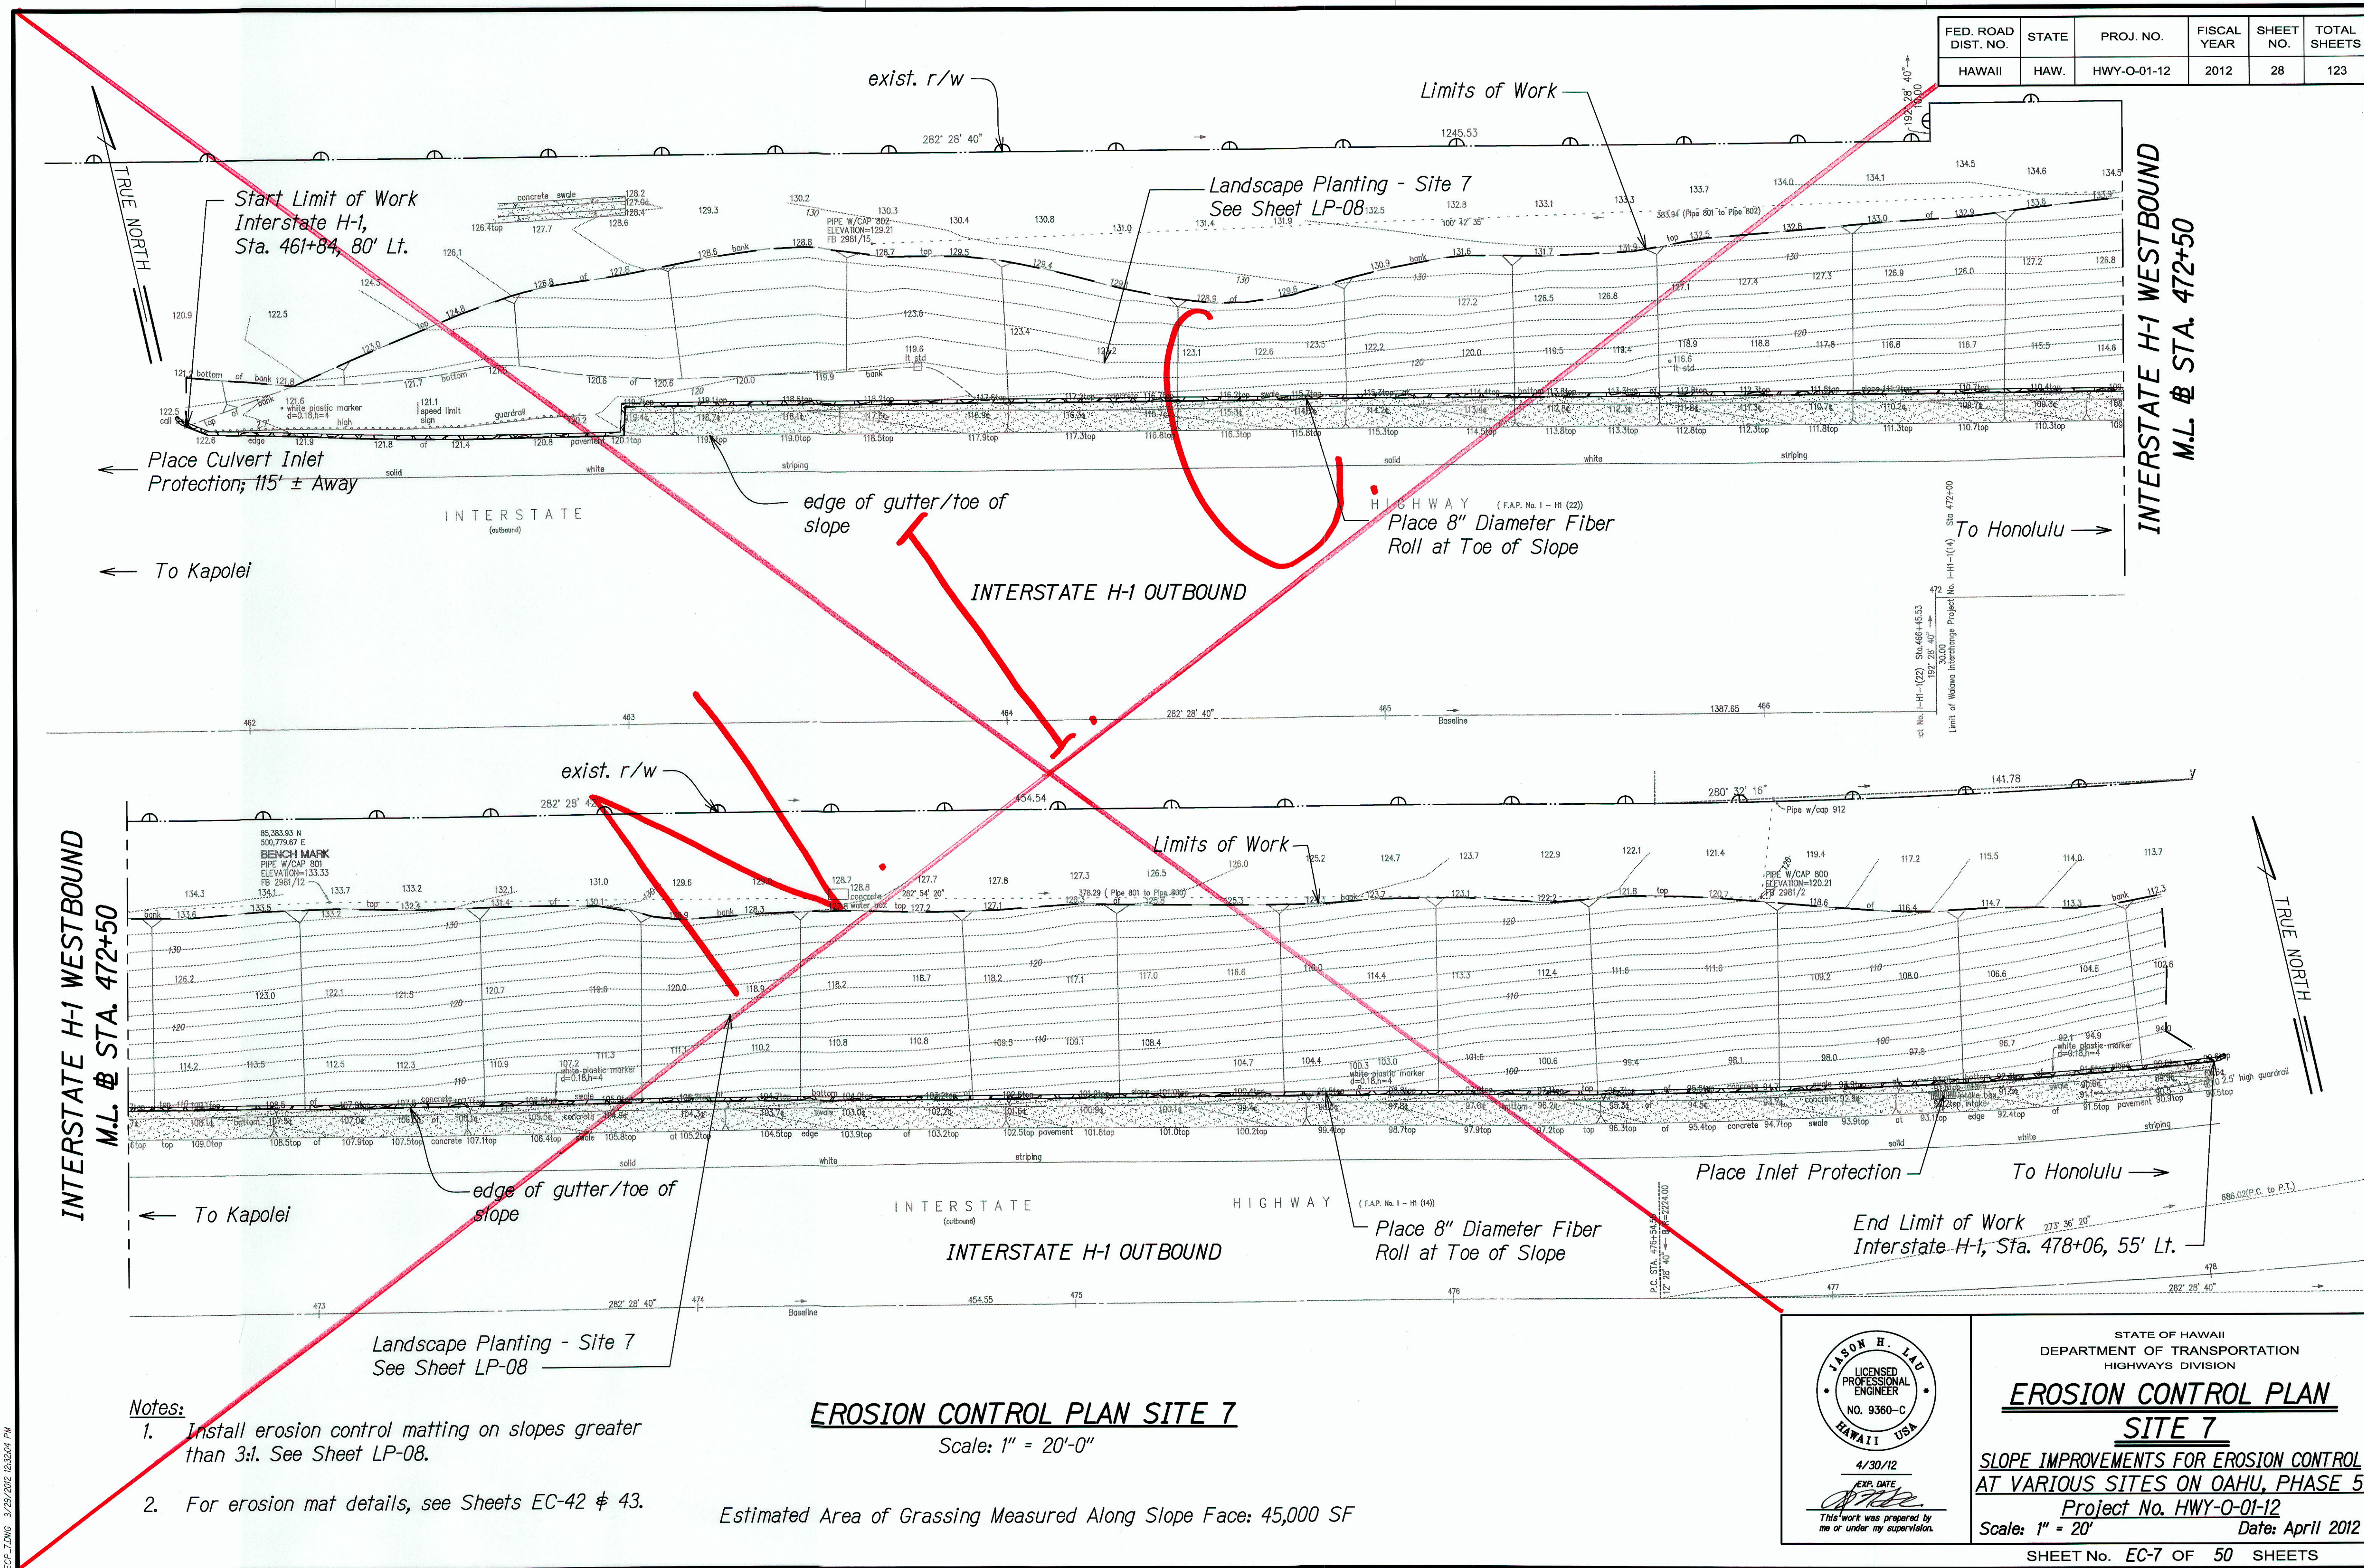

STATE OF HAWAII
DEPARTMENT OF TRANSPORTATION
HIGHWAYS DIVISION

**EROSION CONTROL PLAN
SITE 7**

SLOPE IMPROVEMENTS FOR EROSION CONTROL
AT VARIOUS SITES ON OAHU, PHASE 5

Project No. HWY-O-01-12
Scale: 1" = 20' Date: April 2012


4/30/12
EXP. DATE

[Signature]
This work was prepared by me or under my supervision.

SHEET No. EC-7 OF 50 SHEETS

28

FED. ROAD DIST. NO.	STATE	PROJ. NO.	FISCAL YEAR	SHEET NO.	TOTAL SHEETS
HAWAII	HAW.	HWY-O-01-12	2012	29	123

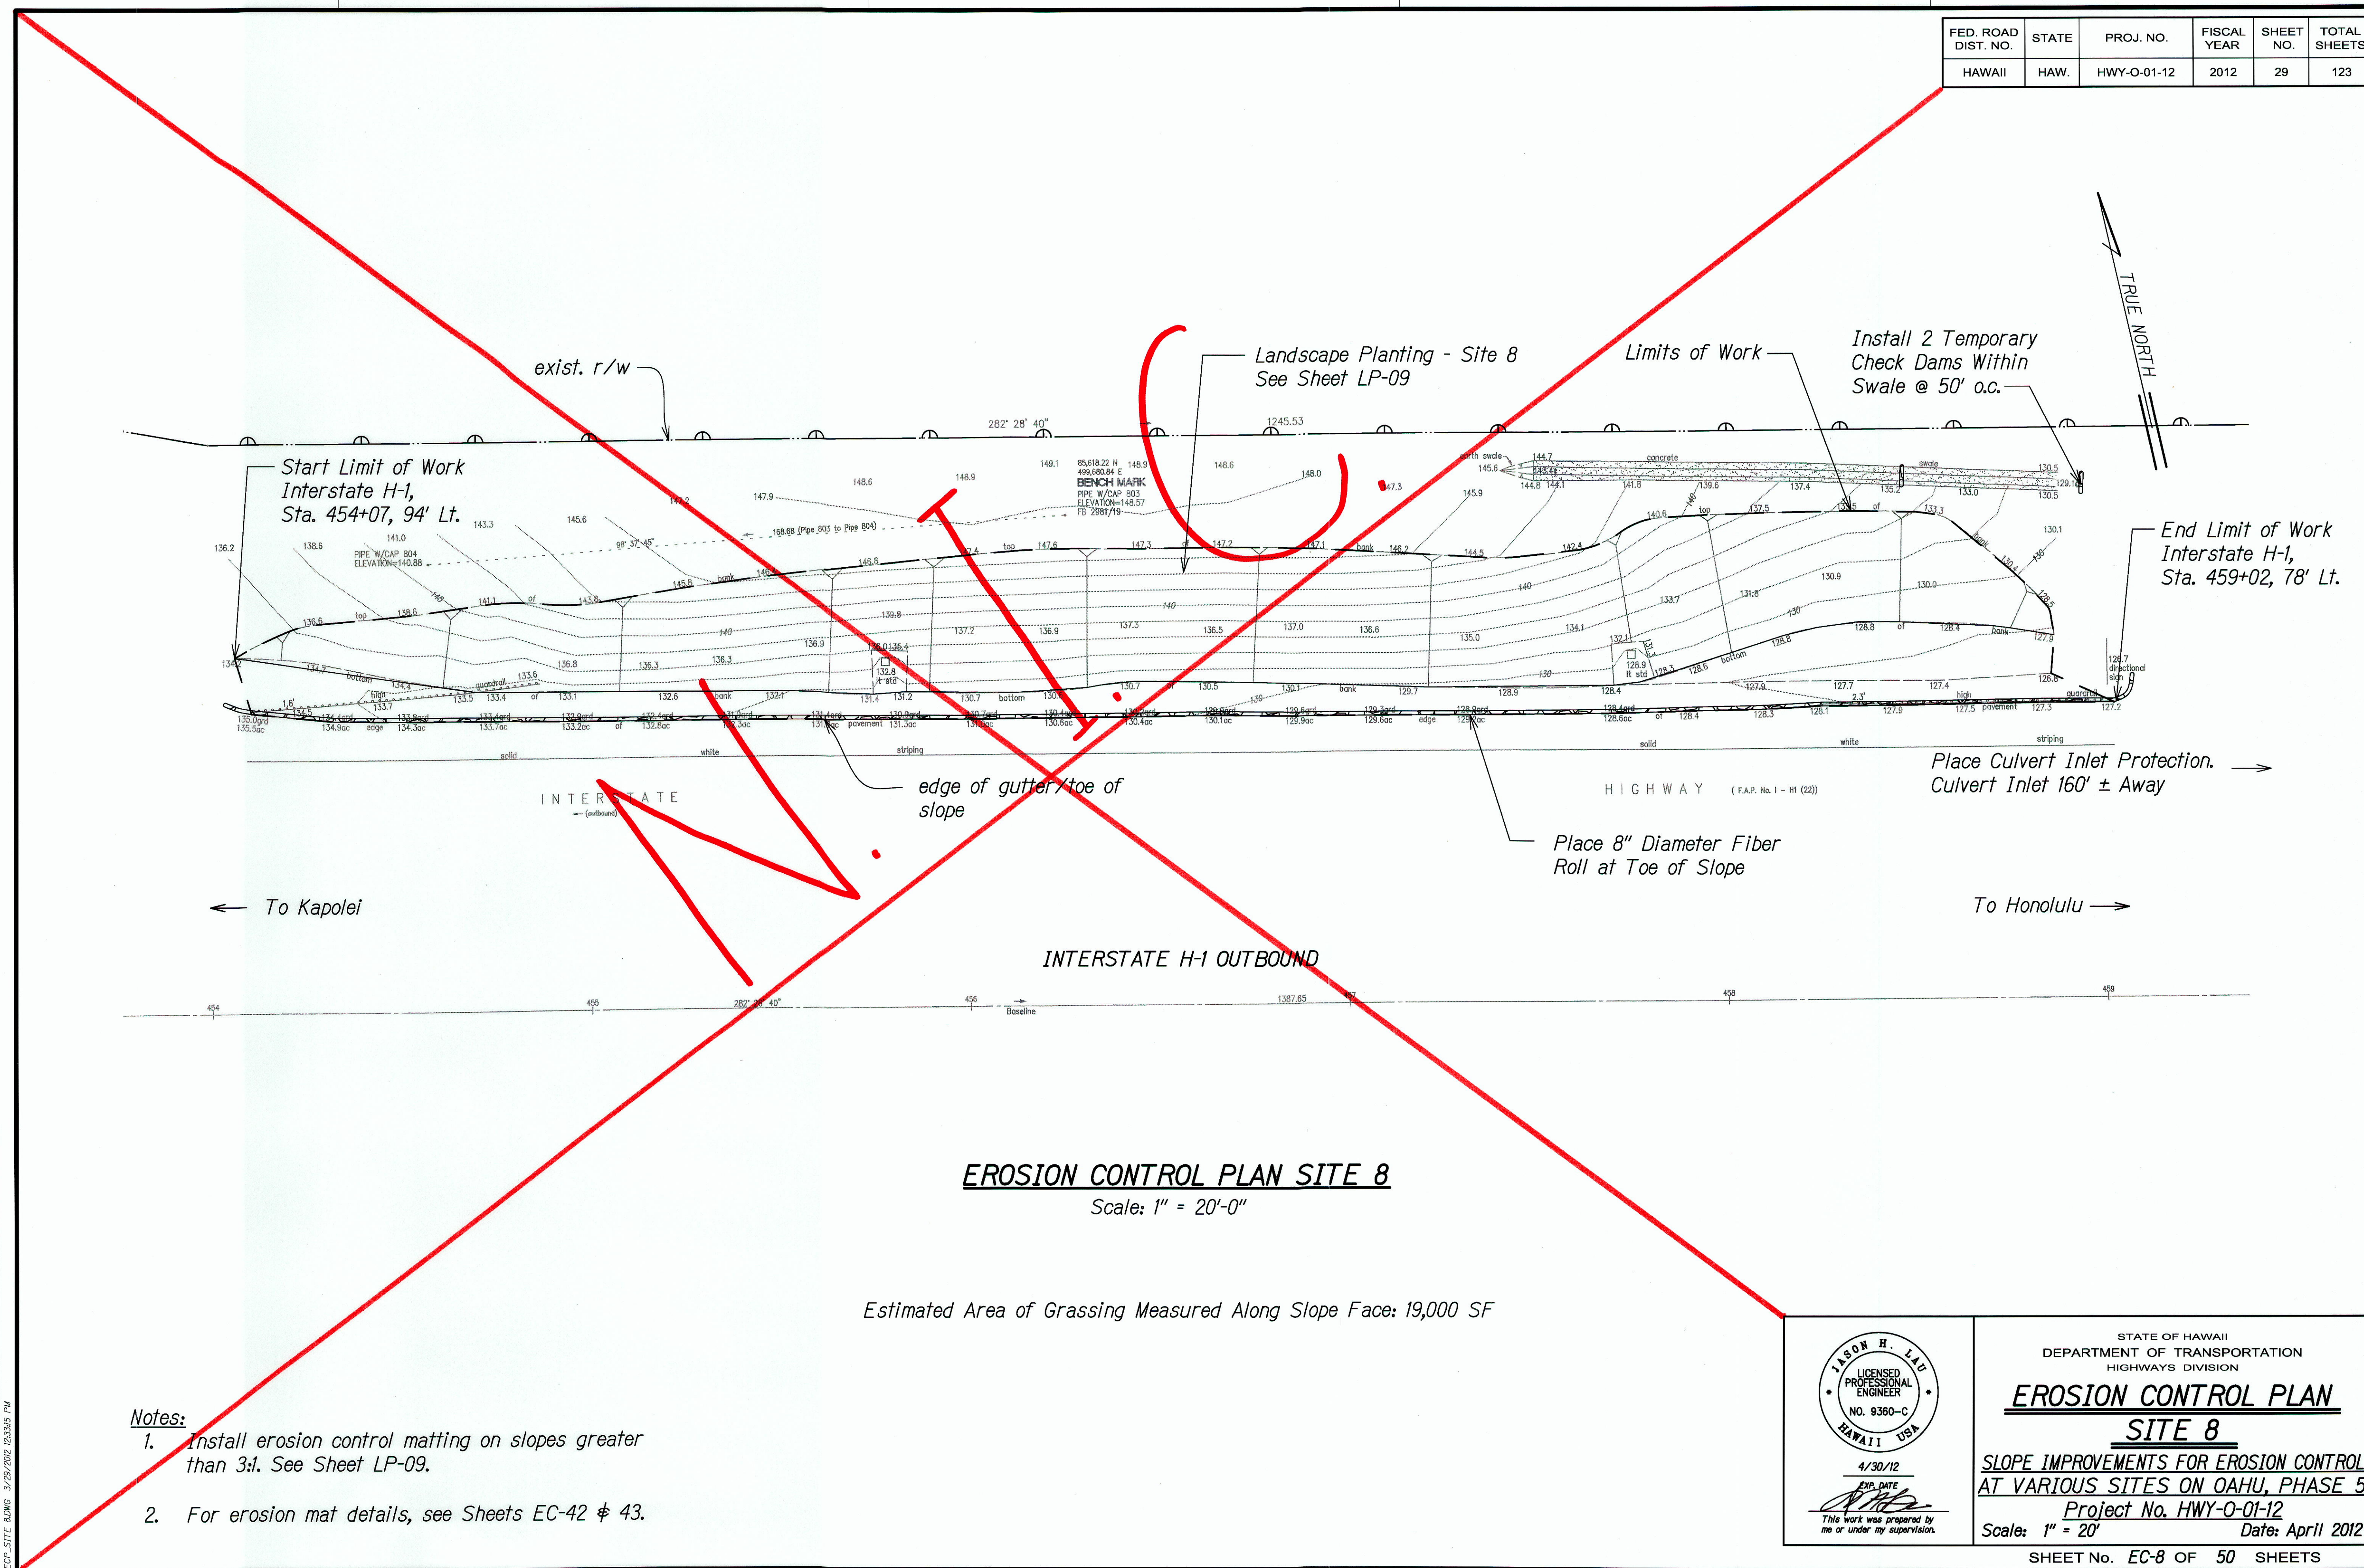

EROSION CONTROL PLAN SITE 8

Scale: 1" = 20'-0"

Estimated Area of Grassing Measured Along Slope Face: 19,000 SF

Notes:

1. Install erosion control matting on slopes greater than 3:1. See Sheet LP-09.
2. For erosion mat details, see Sheets EC-42 & 43.



4/30/12
 EXP. DATE
 This work was prepared by
 me or under my supervision.

STATE OF HAWAII
 DEPARTMENT OF TRANSPORTATION
 HIGHWAYS DIVISION

EROSION CONTROL PLAN SITE 8


SLOPE IMPROVEMENTS FOR EROSION CONTROL
 AT VARIOUS SITES ON OAHU, PHASE 5

Project No. HWY-O-01-12
 Scale: 1" = 20' Date: April 2012

SHEET No. EC-8 OF 50 SHEETS

"AS-BUILT"

FED. ROAD DIST. NO.	STATE	PROJ. NO.	FISCAL YEAR	SHEET NO.	TOTAL SHEETS
HAWAII	HAW.	HWY-O-01-12	2012	30	123

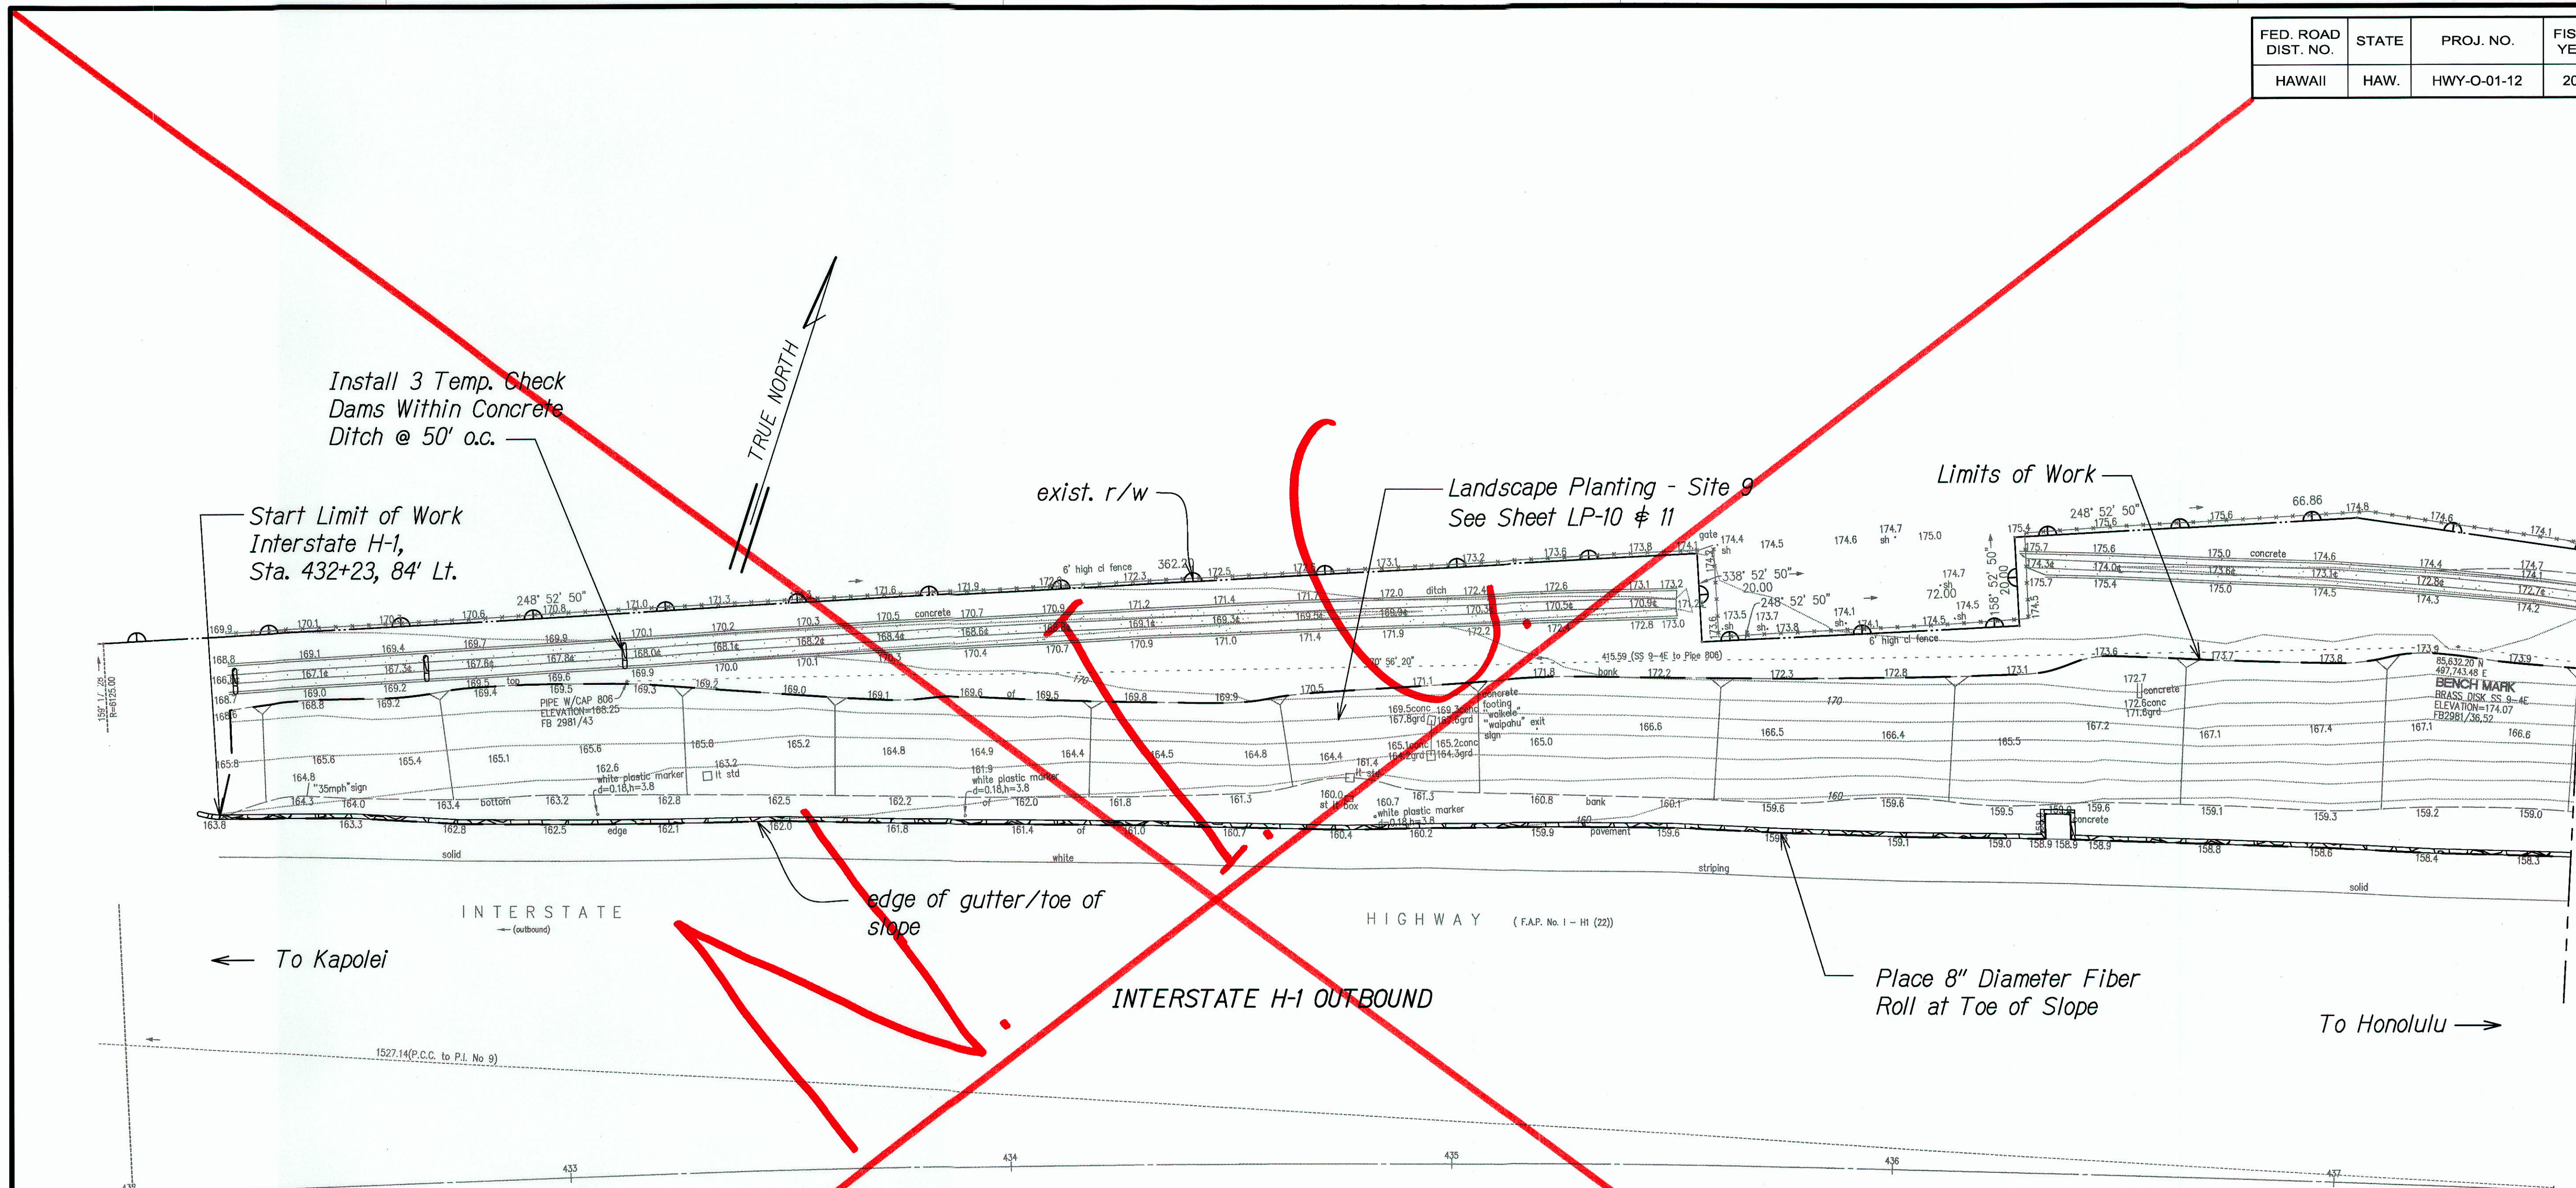

INTERSTATE H-1 WESTBOUND
M.L. @ STA. 437+50
SEE SHEET EC-10

EROSION CONTROL PLAN SITE 9

Scale: 1" = 20'-0"

Estimated Area of Grassing Measured Along Slope Face: 46,000 SF

Notes:

1. Install erosion control matting on slopes greater than 3:1. See Sheet LP-10 & 11.
2. For erosion mat details, see Sheets EC-42 & 43.

ORIGINAL PLAN	SURVEY PLOTTED BY	DATE
NOTE BOOK	DRAWN BY	
QUANTITIES BY	DESIGNED BY	
CHECKED BY		

EC-9 SITE 9.DWG 3/27/2012 10:33:38 AM

4/30/12
EXP. DATE
This work was prepared by me or under my supervision.


STATE OF HAWAII
DEPARTMENT OF TRANSPORTATION
HIGHWAYS DIVISION

EROSION CONTROL PLAN
SITE 9
SLOPE IMPROVEMENTS FOR EROSION CONTROL AT VARIOUS SITES ON OAHU, PHASE 5
Project No. HWY-O-01-12
Scale: 1" = 20' Date: April 2012

SHEET No. EC-9 OF 50 SHEETS

"AS-BUILT"

FED. ROAD DIST. NO.	STATE	PROJ. NO.	FISCAL YEAR	SHEET NO.	TOTAL SHEETS
HAWAII	HAW.	HWY-O-01-12	2012	31	123

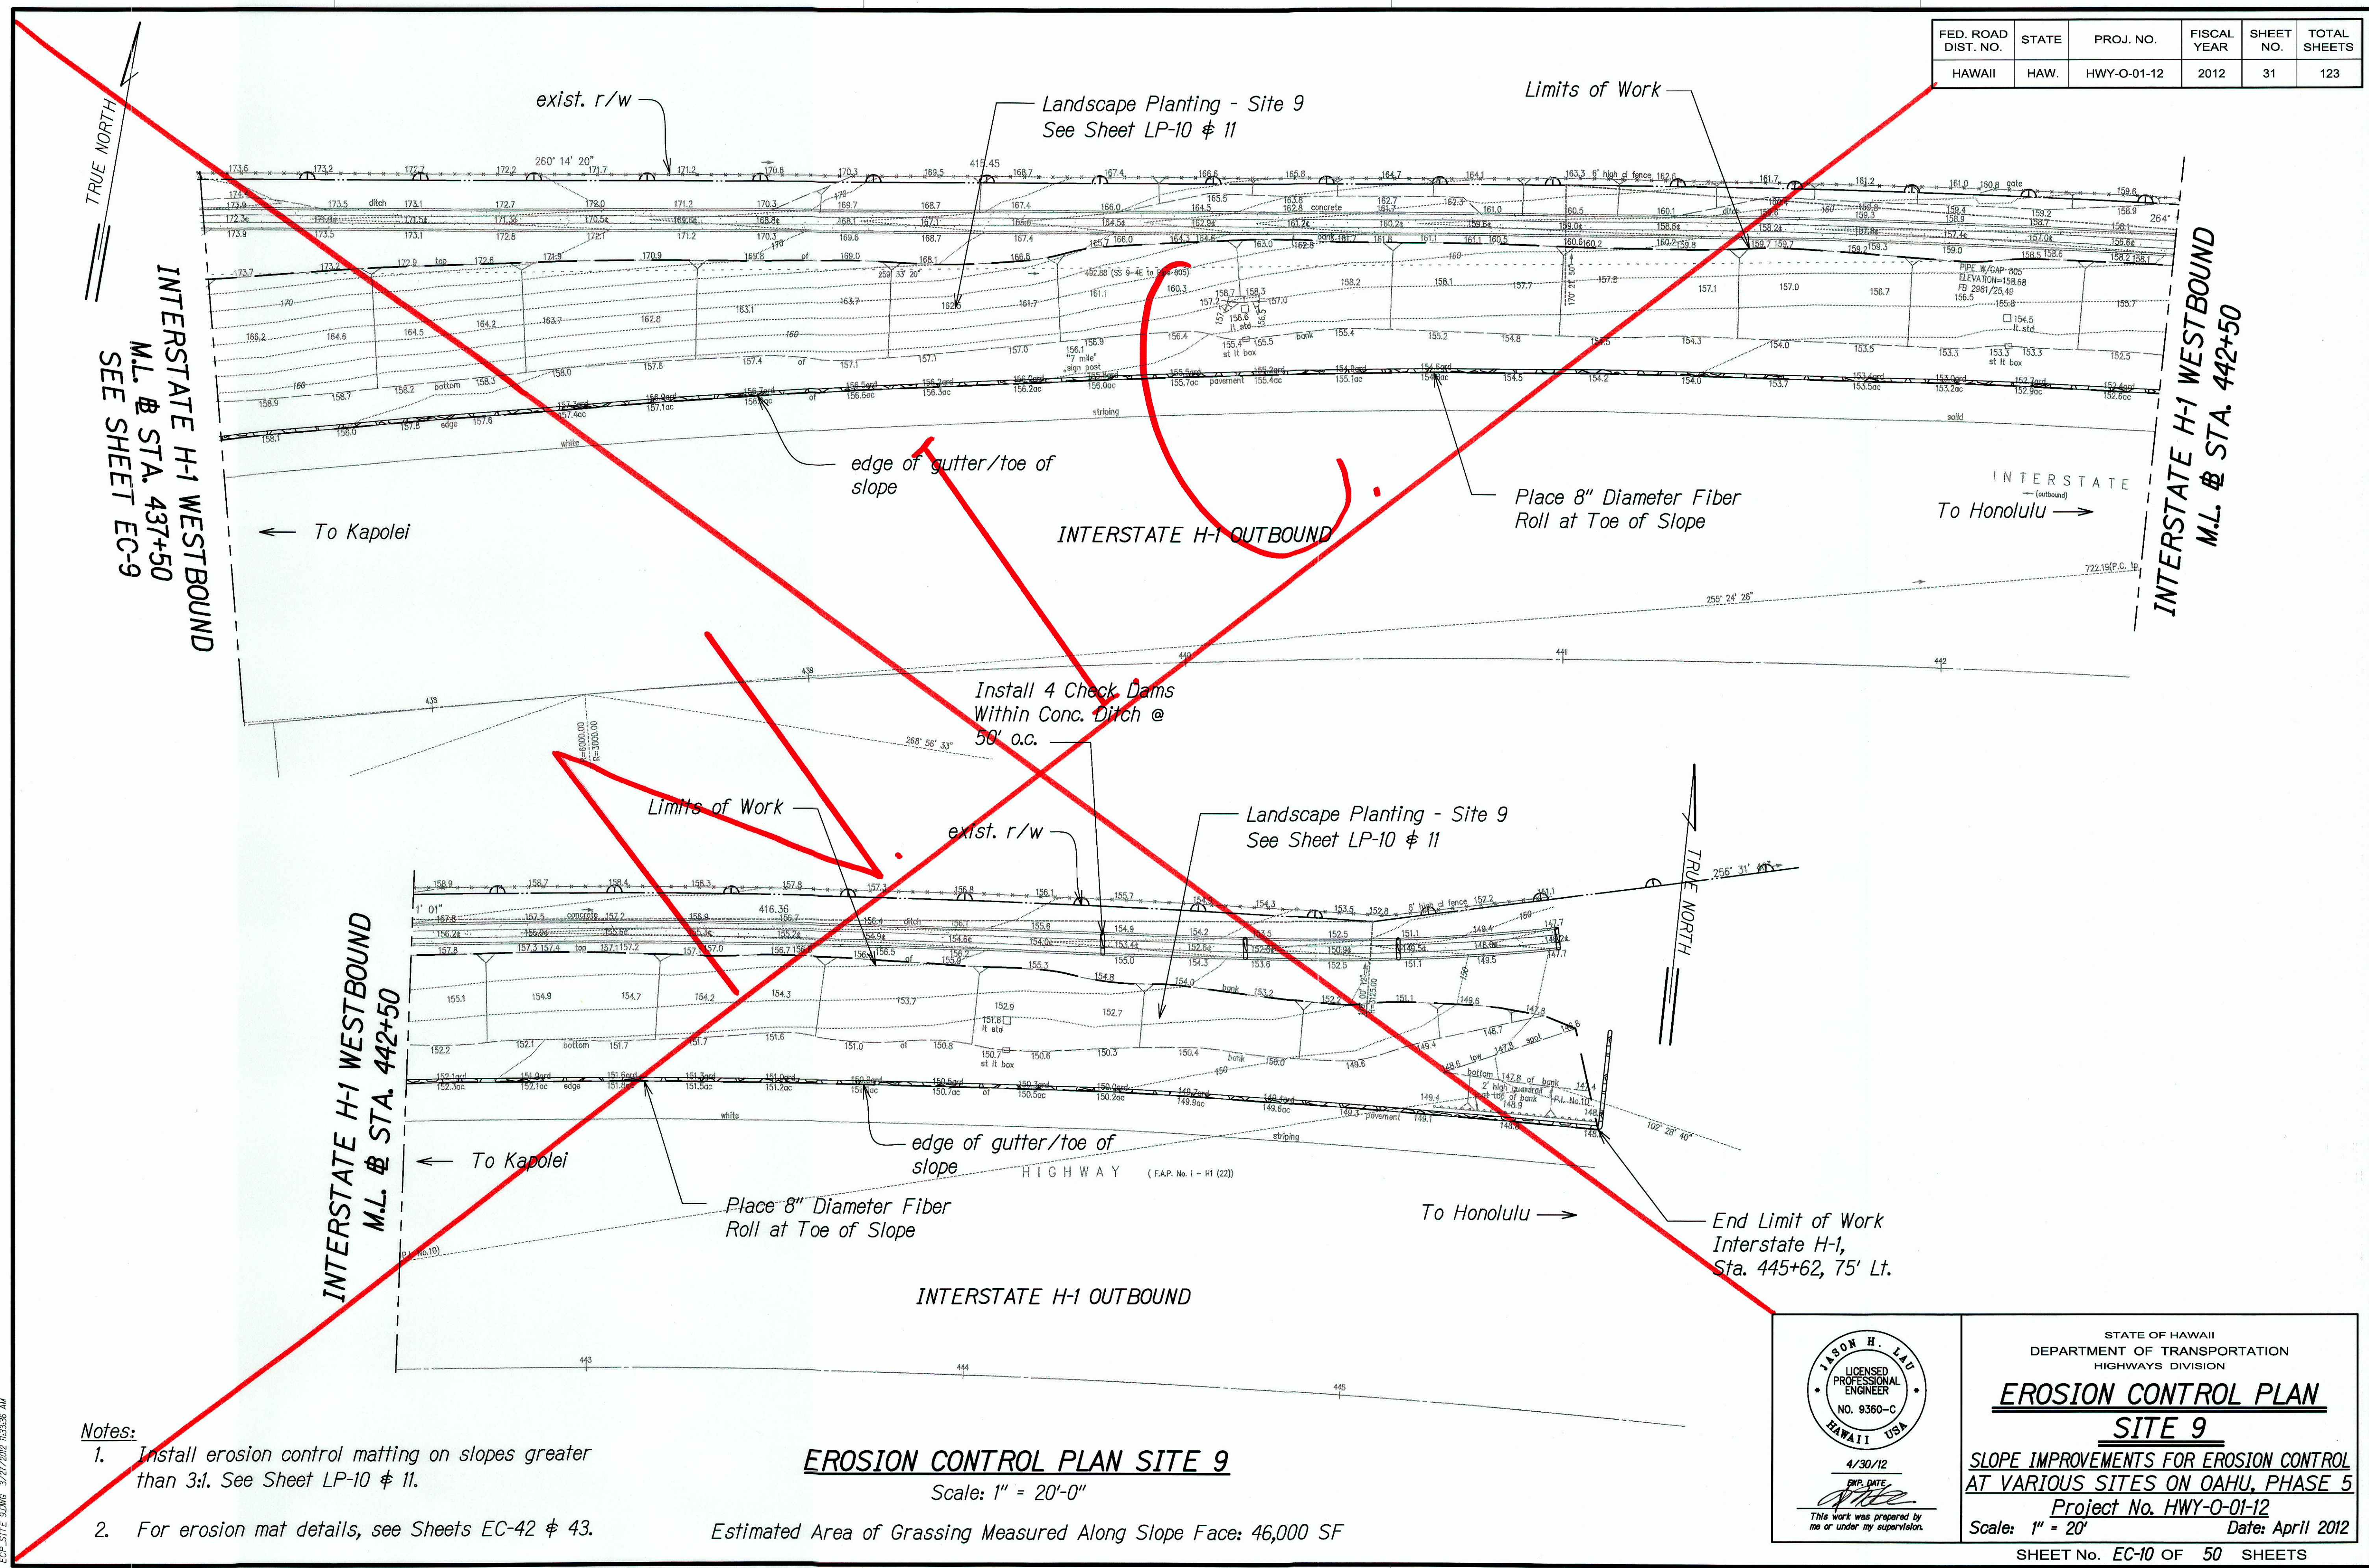

- Notes:
1. Install erosion control matting on slopes greater than 3:1. See Sheet LP-10 & 11.
 2. For erosion mat details, see Sheets EC-42 & 43.

EROSION CONTROL PLAN SITE 9

Scale: 1" = 20'-0"

Estimated Area of Grassing Measured Along Slope Face: 46,000 SF

ORIGINAL PLAN	DATE
DRAWN BY	
TRACED BY	
NOTED BY	
CHECKED BY	

4/30/12
Date

This work was prepared by me or under my supervision.

STATE OF HAWAII
DEPARTMENT OF TRANSPORTATION
HIGHWAYS DIVISION

EROSION CONTROL PLAN

SITE 9

SLOPE IMPROVEMENTS FOR EROSION CONTROL AT VARIOUS SITES ON OAHU, PHASE 5


Project No. HWY-O-01-12

Scale: 1" = 20' Date: April 2012

SHEET No. EC-10 OF 50 SHEETS

"AS-BUILT"

FED. ROAD DIST. NO.	STATE	PROJ. NO.	FISCAL YEAR	SHEET NO.	TOTAL SHEETS
HAWAII	HAW.	HWY-0-01-12	2012	32	123

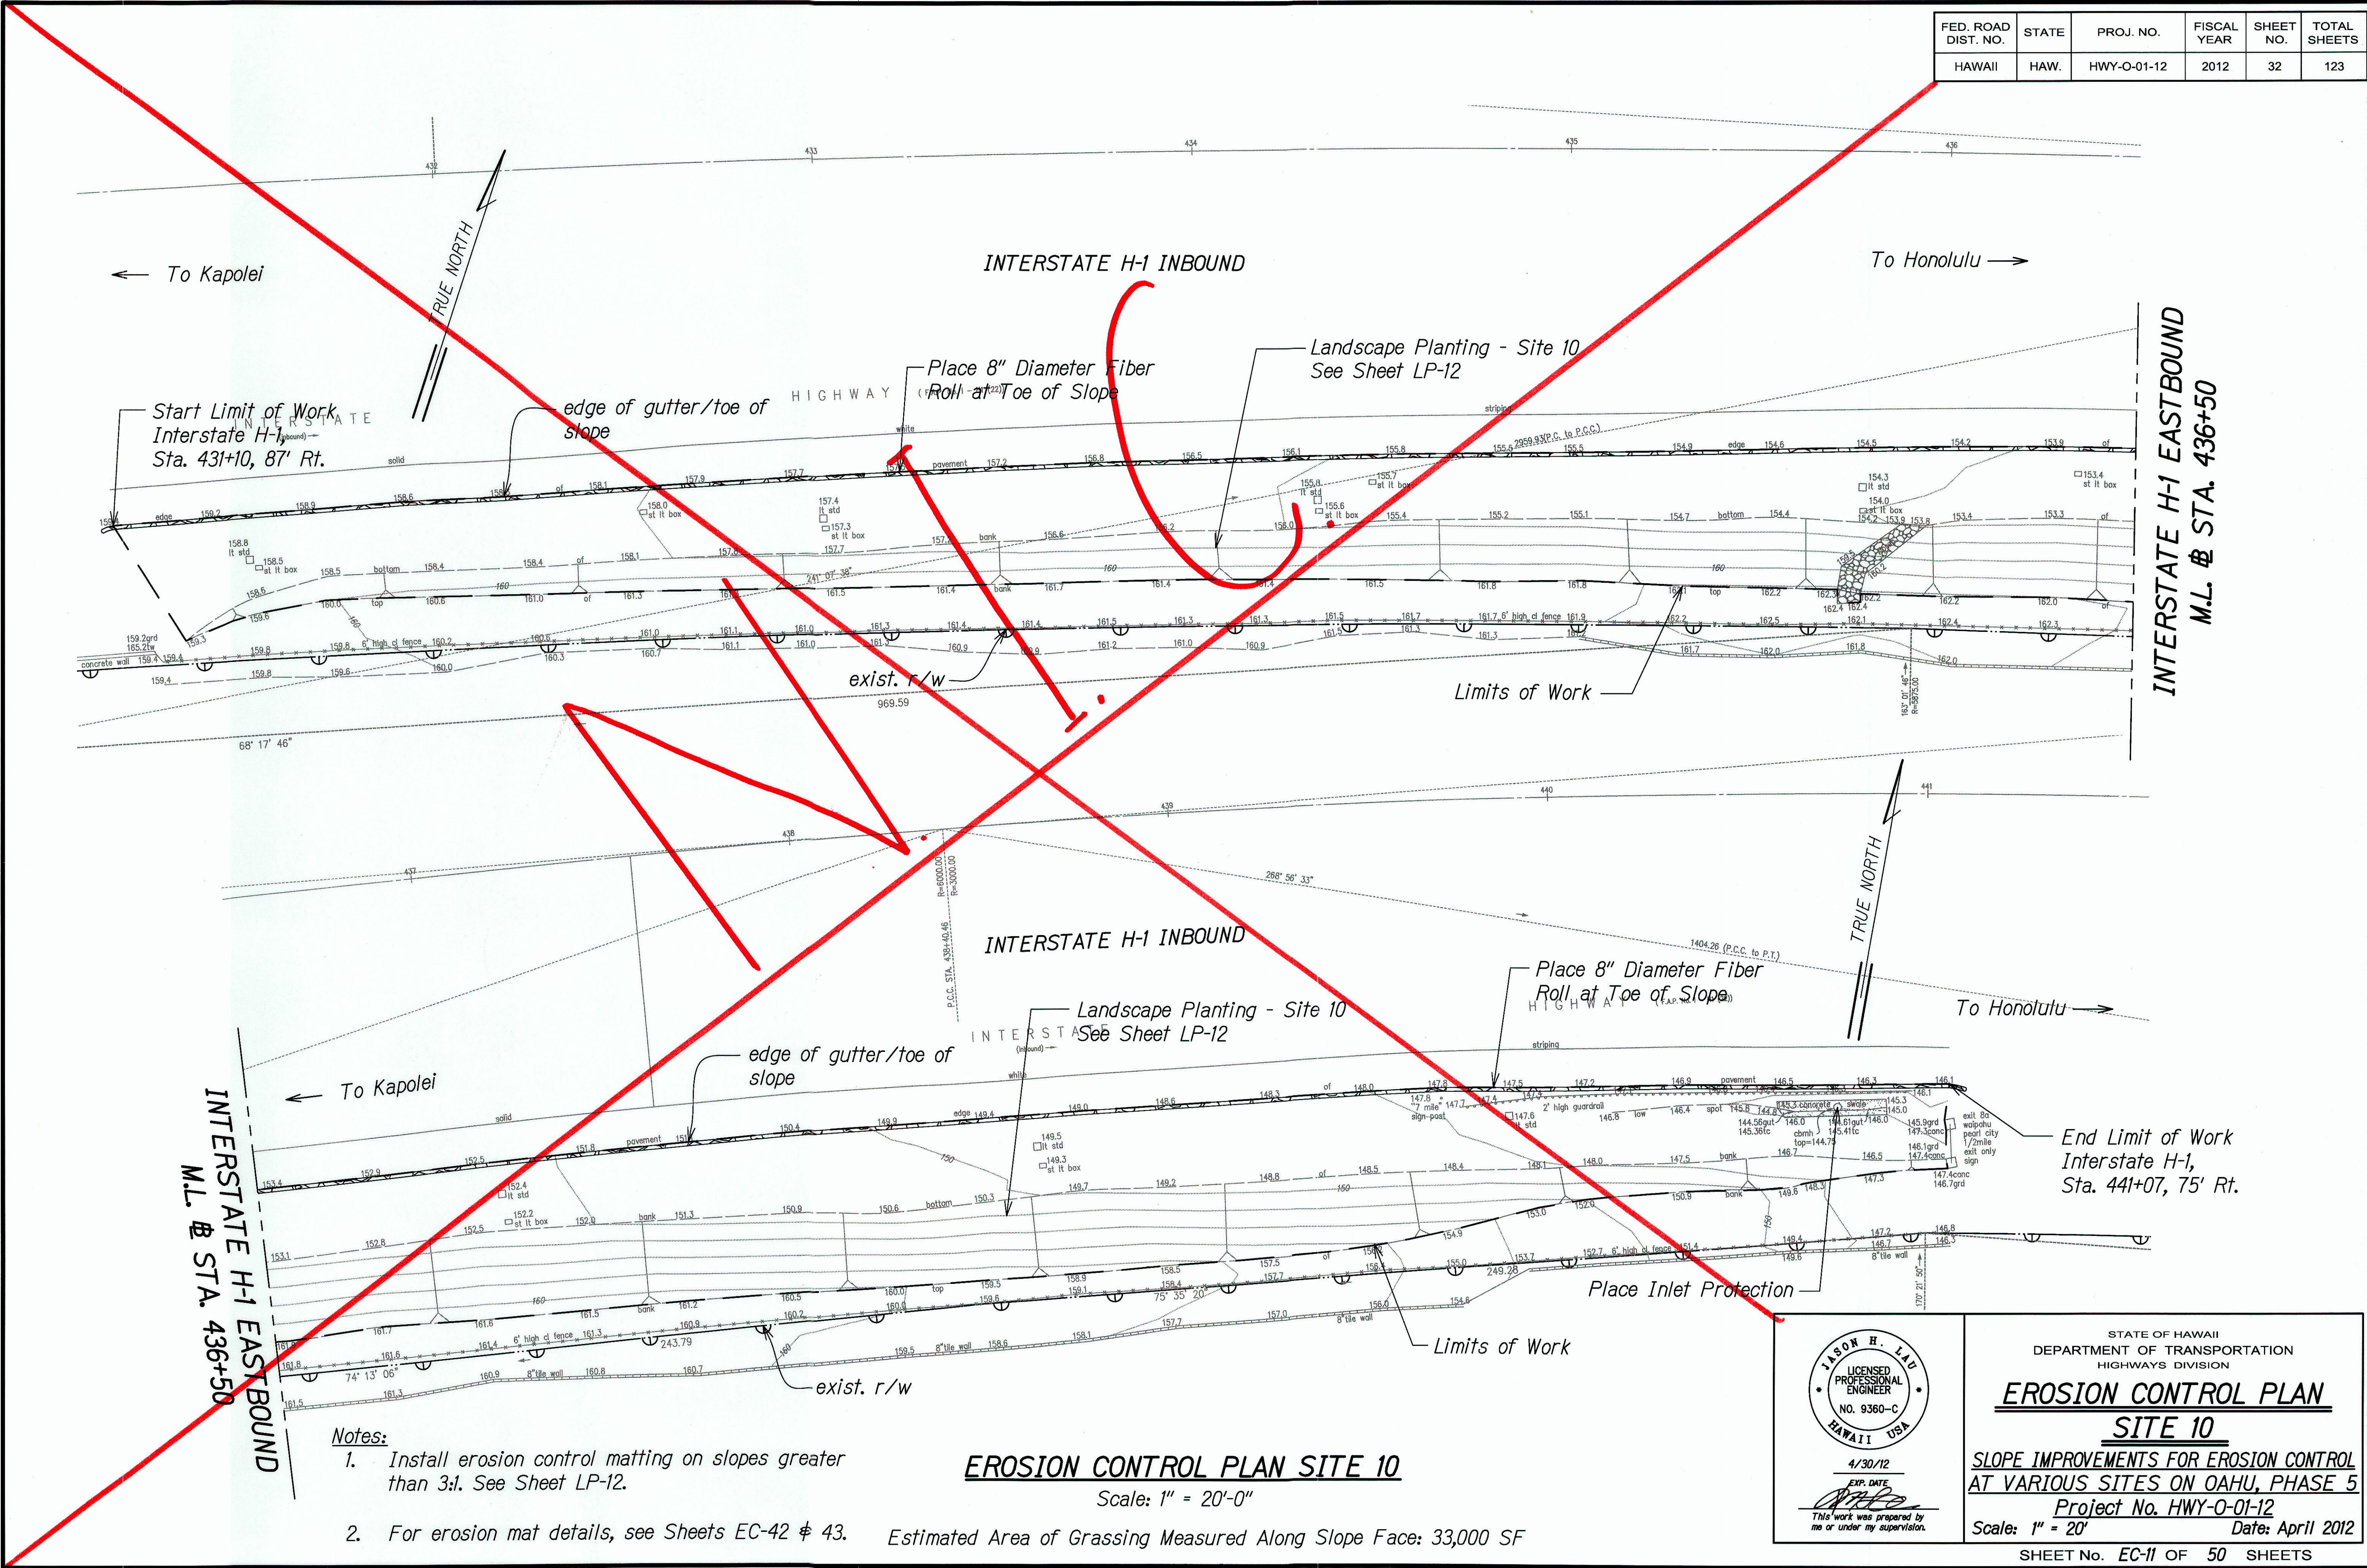

ORIGINAL PLAN	SURVEY PLOTTED BY	DATE
TRACED BY		
NOTE BOOK		
QUANTITIES BY		
CHECKED BY		

EC-11 SITE 10, 3/29/2012 10:43:33 PM

EROSION CONTROL PLAN SITE 10

Scale: 1" = 20'-0"

Estimated Area of Grassing Measured Along Slope Face: 33,000 SF




STATE OF HAWAII
DEPARTMENT OF TRANSPORTATION
HIGHWAYS DIVISION
EROSION CONTROL PLAN
SITE 10
SLOPE IMPROVEMENTS FOR EROSION CONTROL
AT VARIOUS SITES ON OAHU, PHASE 5
Project No. HWY-0-01-12
Scale: 1" = 20' Date: April 2012

SHEET No. EC-11 OF 50 SHEETS

"AS-BUILT"

FED. ROAD DIST. NO.	STATE	PROJ. NO.	FISCAL YEAR	SHEET NO.	TOTAL SHEETS
HAWAII	HAW.	HWY-O-01-12	2012	33	123

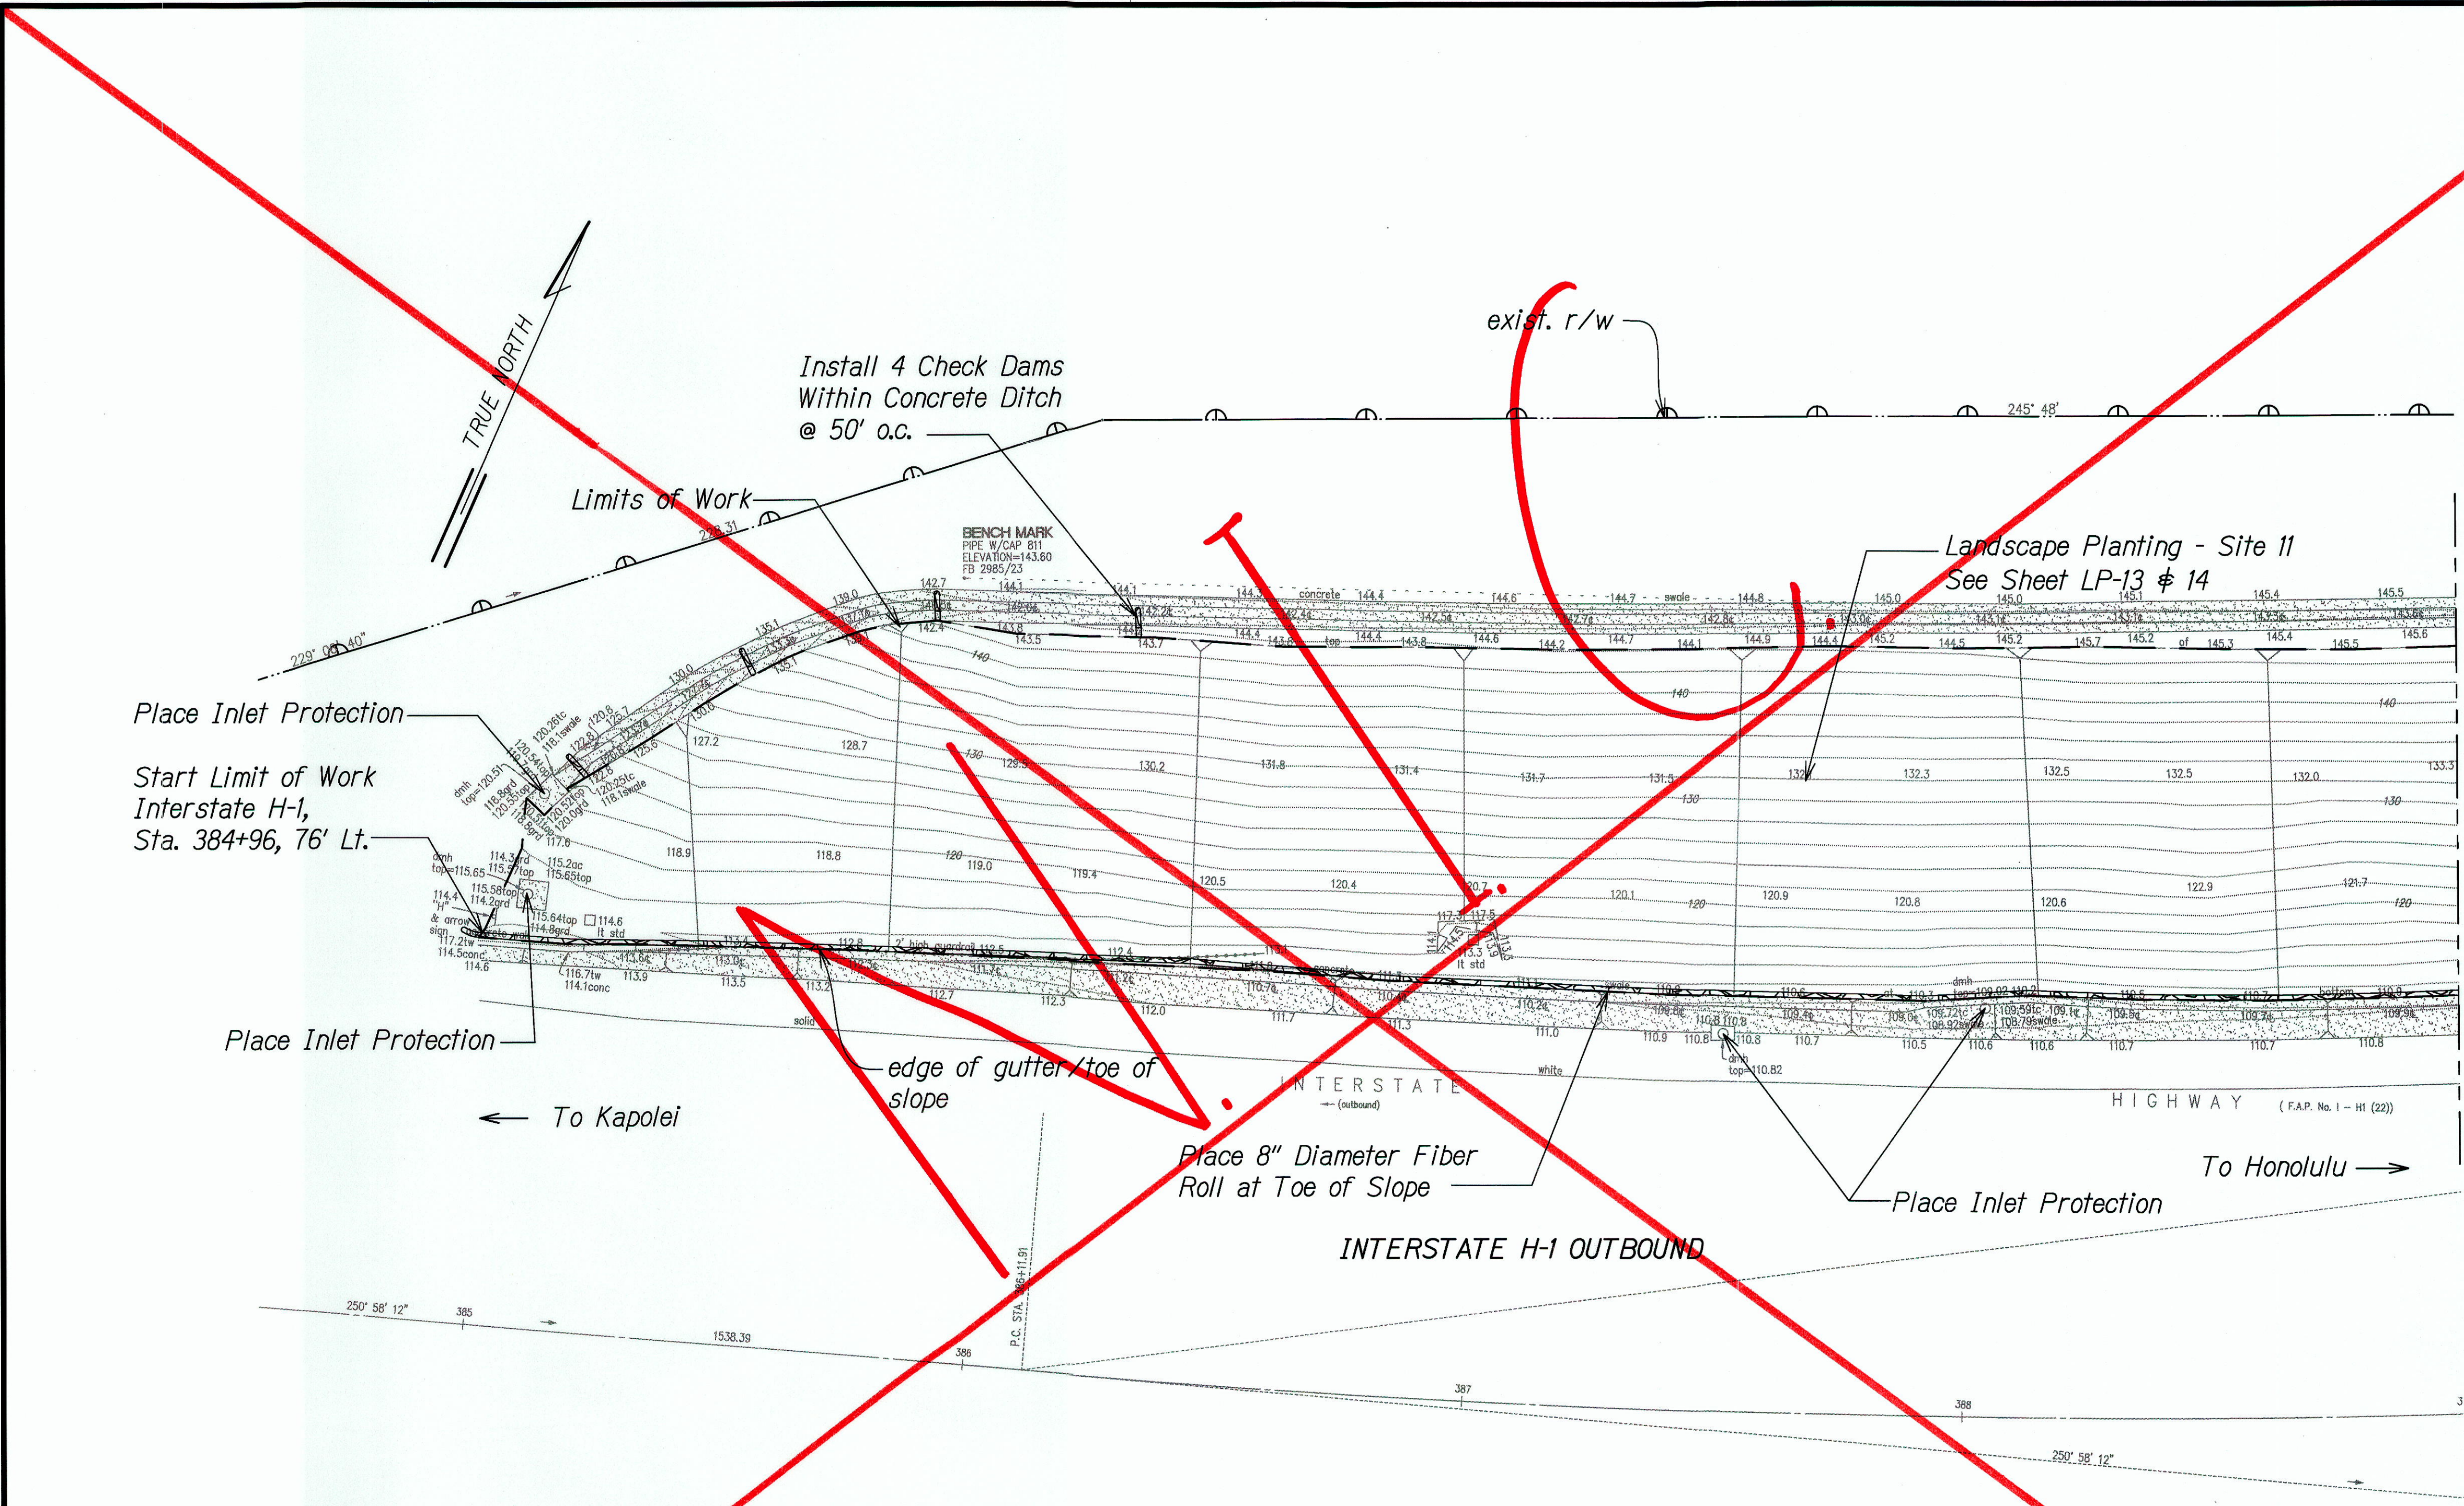

INTERSTATE H-1 WESTBOUND
M.L. @ STA. 389+00
SEE SHEET EC-13

EROSION CONTROL PLAN SITE 11 Scale: 1" = 20'-0"

- Notes:**
1. Install erosion control matting on slopes greater than 3:1. See Sheet LP-12 # 13.
 2. For erosion mat details, see Sheets EC-42 # 43.

Estimated Area of Grassing Measured Along Slope Face: 80,710 SF

ORIGINAL	SURVEY PLOTTED BY	DATE
PLAN	DRAWN BY	
NOTE BOOK	TRACED BY	
QUANTITIES BY	CHECKED BY	
N.		

4/30/12
EXP. DATE
Jason H. Lau
This work was prepared by me or under my supervision.


STATE OF HAWAII
DEPARTMENT OF TRANSPORTATION
HIGHWAYS DIVISION

EROSION CONTROL PLAN
SITE 11
SLOPE IMPROVEMENTS FOR EROSION CONTROL
AT VARIOUS SITES ON OAHU, PHASE 5
Project No. HWY-O-01-12
Scale: 1" = 20' Date: April 2012

SHEET No. EC-12 OF 50 SHEETS


"AS-BUILT"

FED. ROAD DIST. NO.	STATE	PROJ. NO.	FISCAL YEAR	SHEET NO.	TOTAL SHEETS
HAWAII	HAW.	HWY-O-01-12	2012	34	123

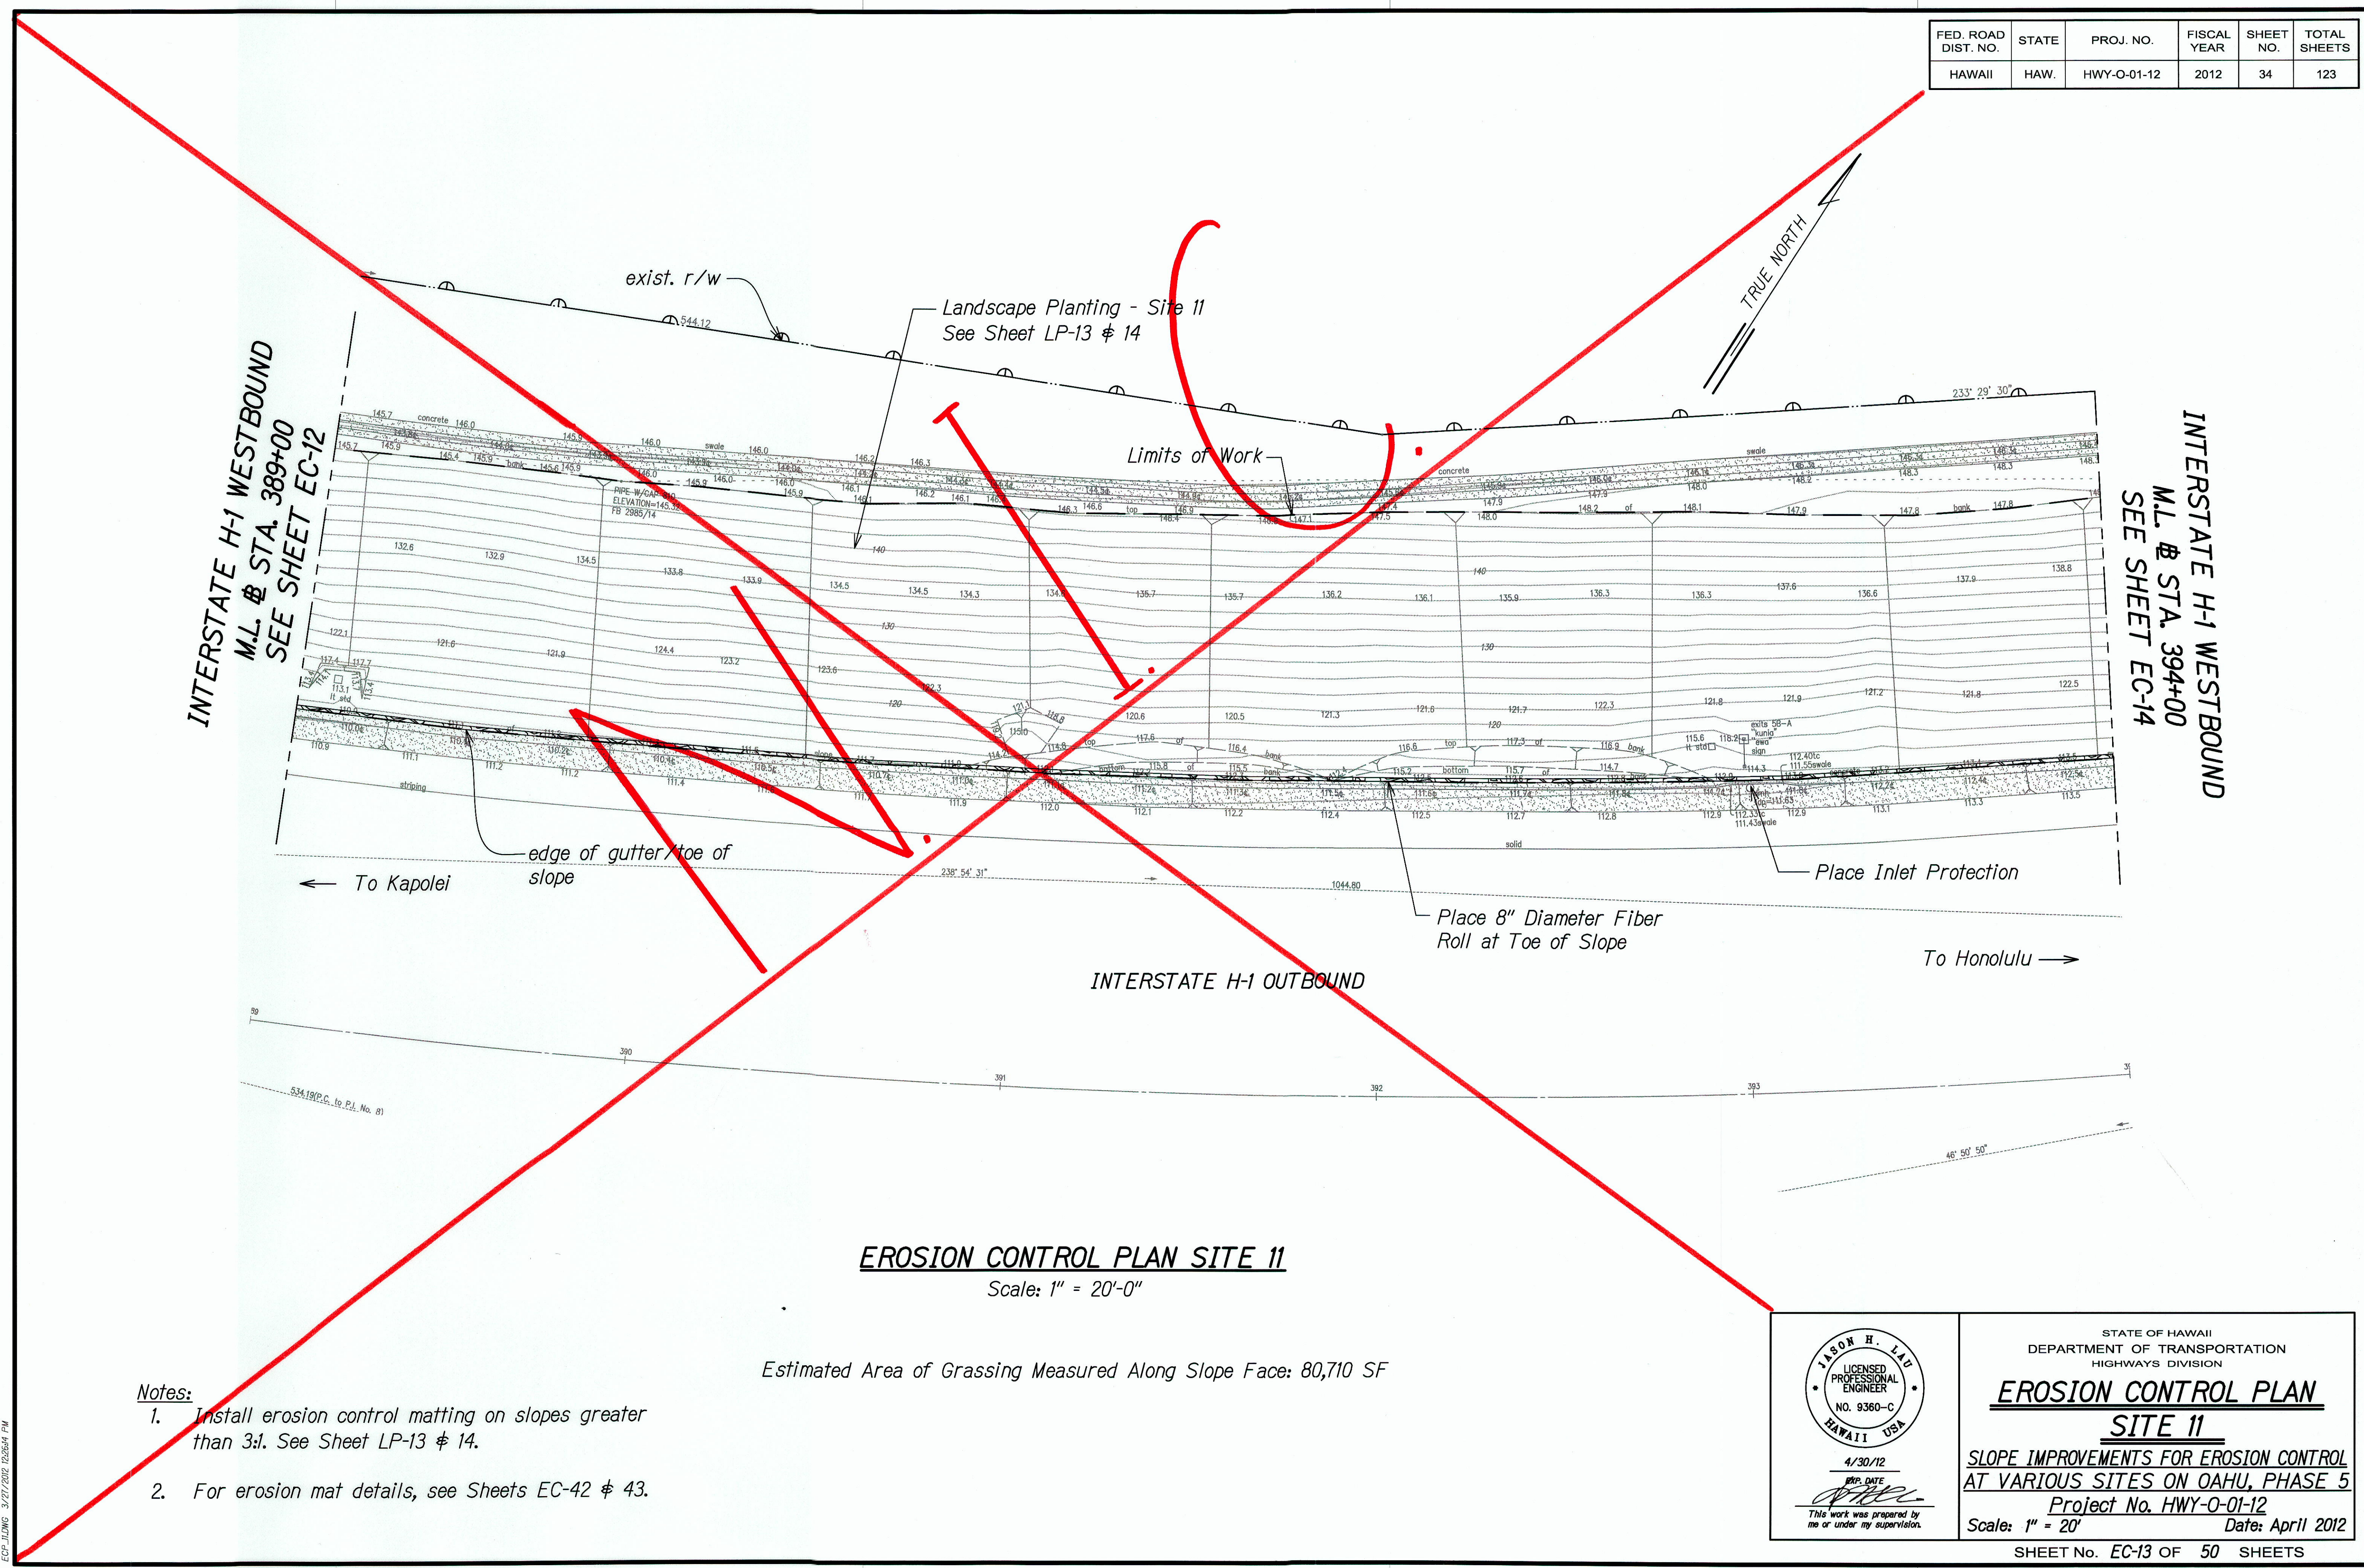

"AS-BUILT"

FED. ROAD DIST. NO.	STATE	PROJ. NO.	FISCAL YEAR	SHEET NO.	TOTAL SHEETS
HAWAII	HAW.	HWY-O-01-12	2012	35	123

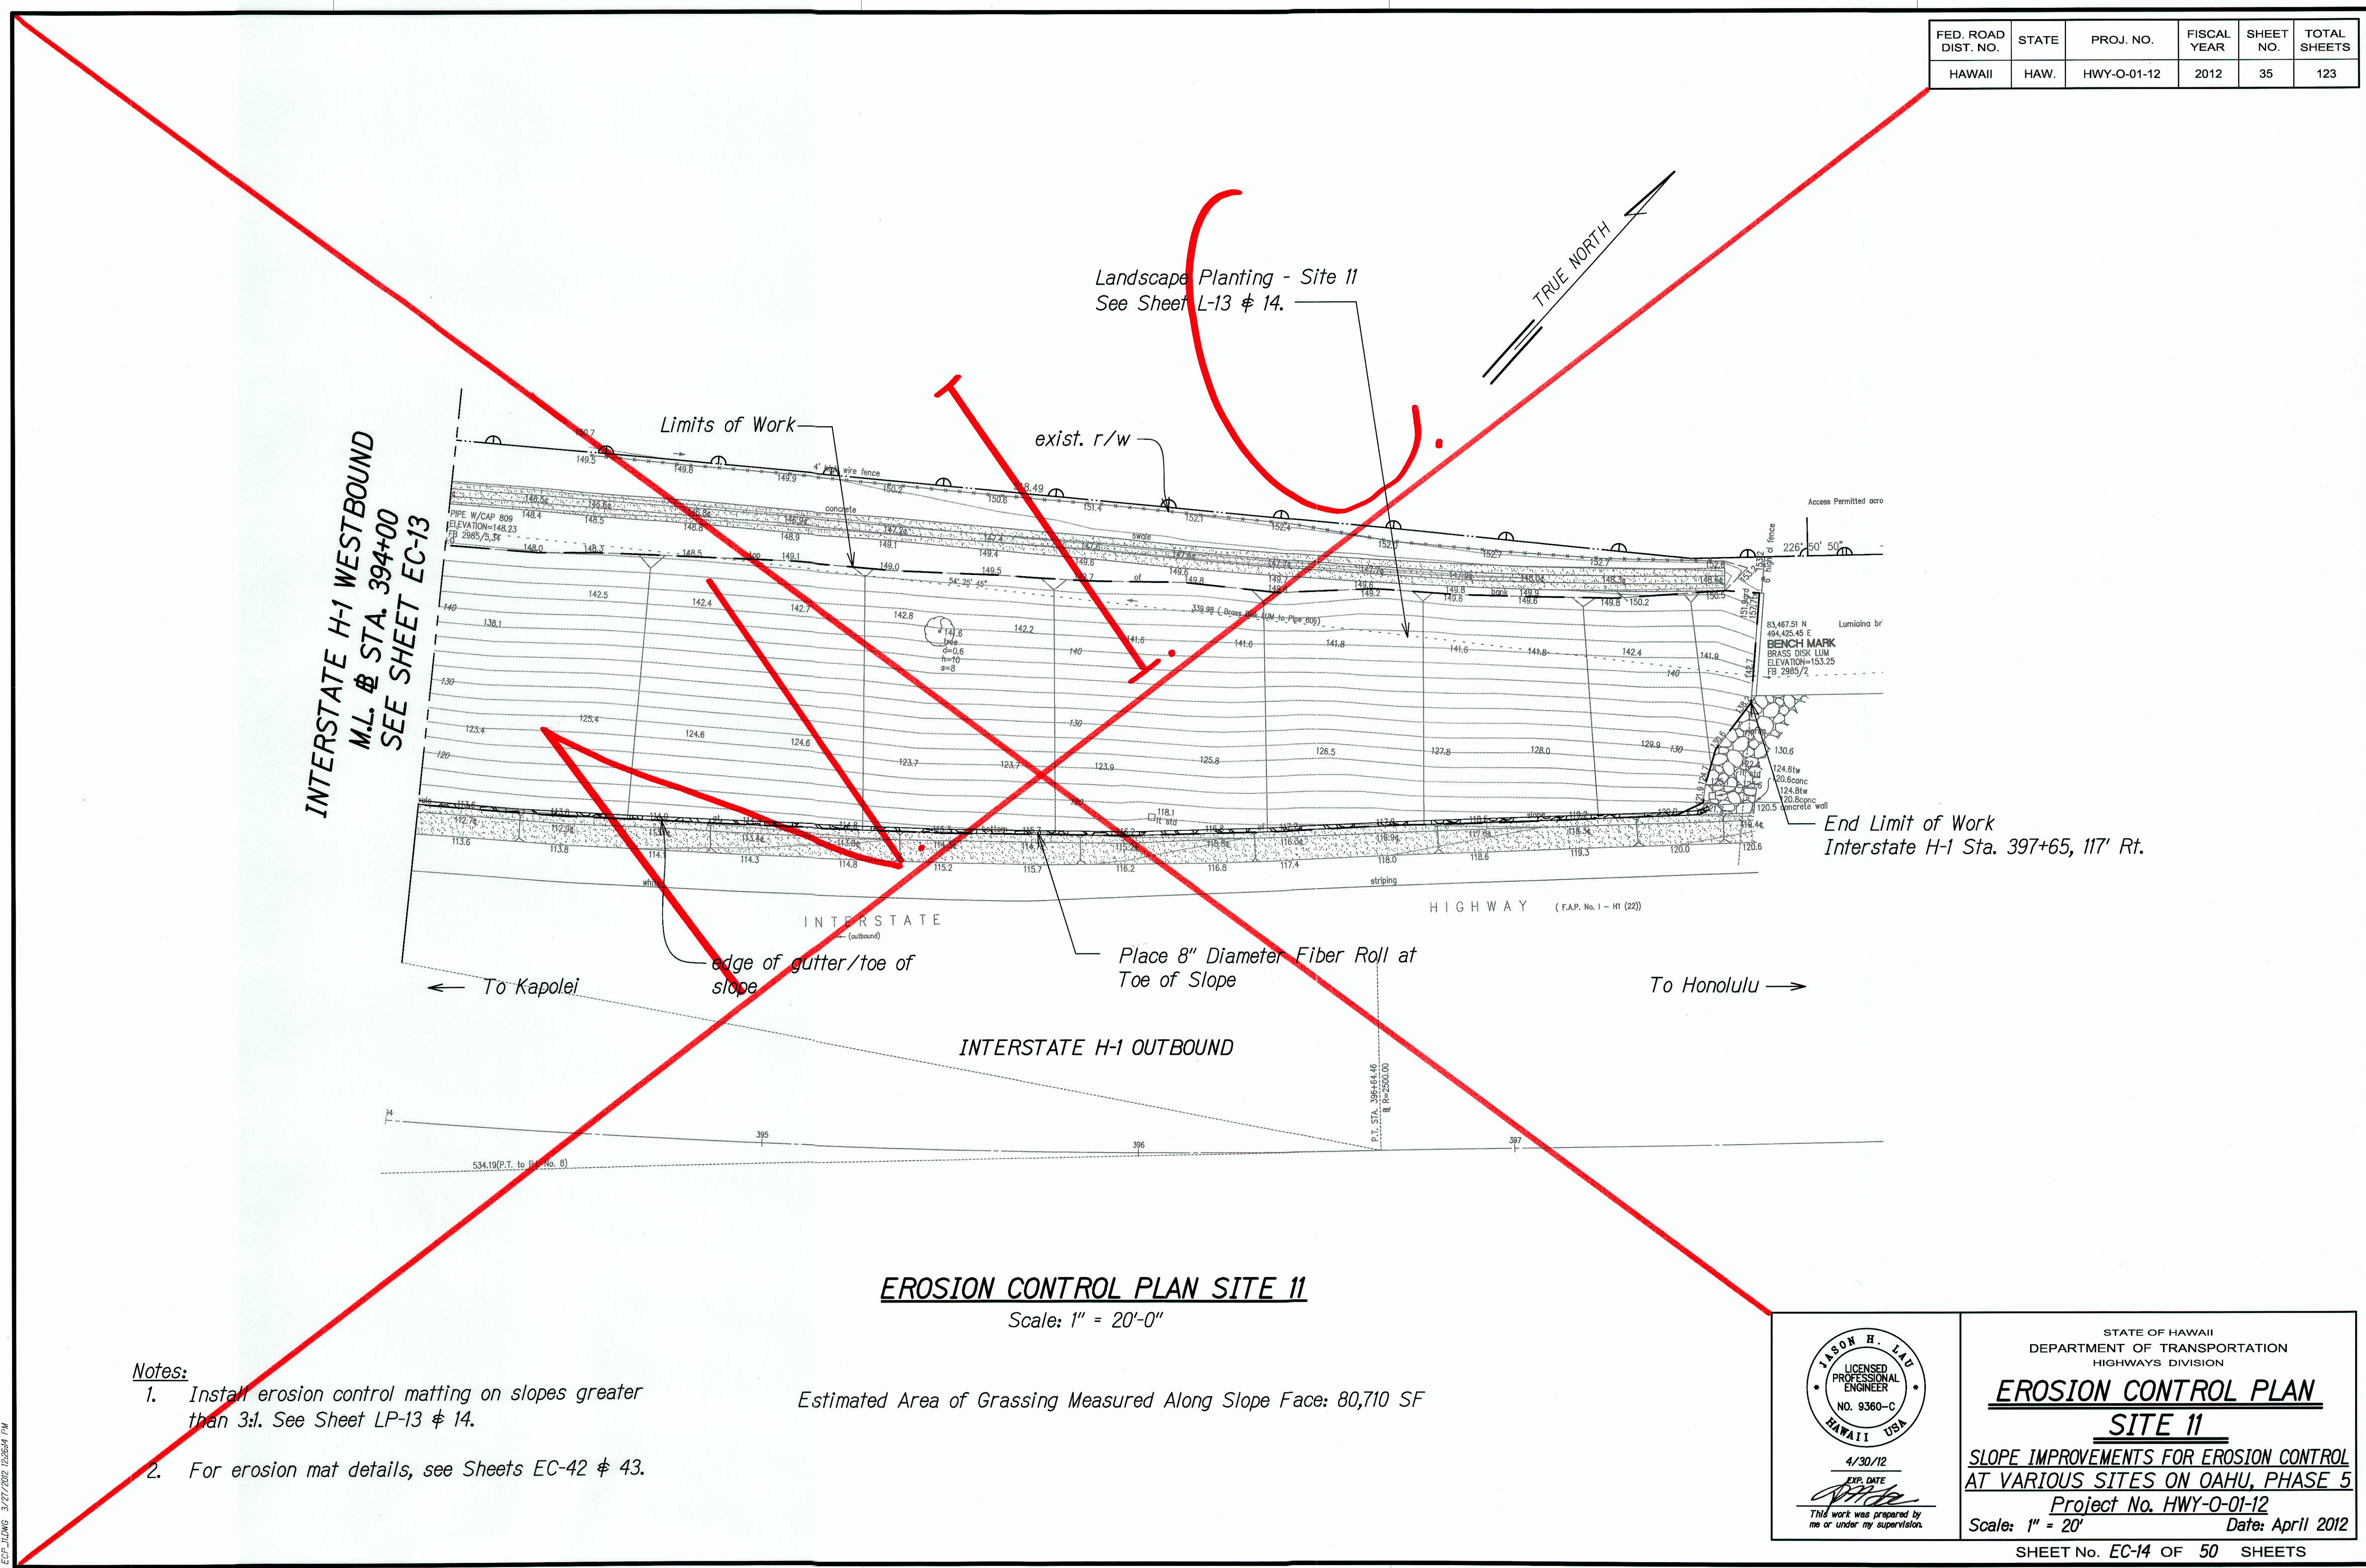

INTERSTATE H-1 WESTBOUND
M.L. STA. 394+00
SEE SHEET EC-13

EROSION CONTROL PLAN SITE 11
Scale: 1" = 20'-0"

Estimated Area of Grassing Measured Along Slope Face: 80,710 SF

- Notes:**
1. Install erosion control matting on slopes greater than 3:1. See Sheet LP-13 & 14.
 2. For erosion mat details, see Sheets EC-42 & 43.

ORIGINAL	SURVEY PLOTTED BY	DATE
PLAN	DRAWN BY	
NOTE BOOK	TRACED BY	
	QUANTITIES BY	
	CHECKED BY	

4/30/12
EXP. DATE
This work was prepared by me or under my supervision.

STATE OF HAWAII
DEPARTMENT OF TRANSPORTATION
HIGHWAYS DIVISION

EROSION CONTROL PLAN
SITE 11


SLOPE IMPROVEMENTS FOR EROSION CONTROL
AT VARIOUS SITES ON OAHU, PHASE 5

Project No. HWY-O-01-12
Scale: 1" = 20' Date: April 2012

SHEET No. EC-14 OF 50 SHEETS


"AS-BUILT"

FED. ROAD DIST. NO.	STATE	PROJ. NO.	FISCAL YEAR	SHEET NO.	TOTAL SHEETS
HAWAII	HAW.	HWY-O-01-12	2012	36	123

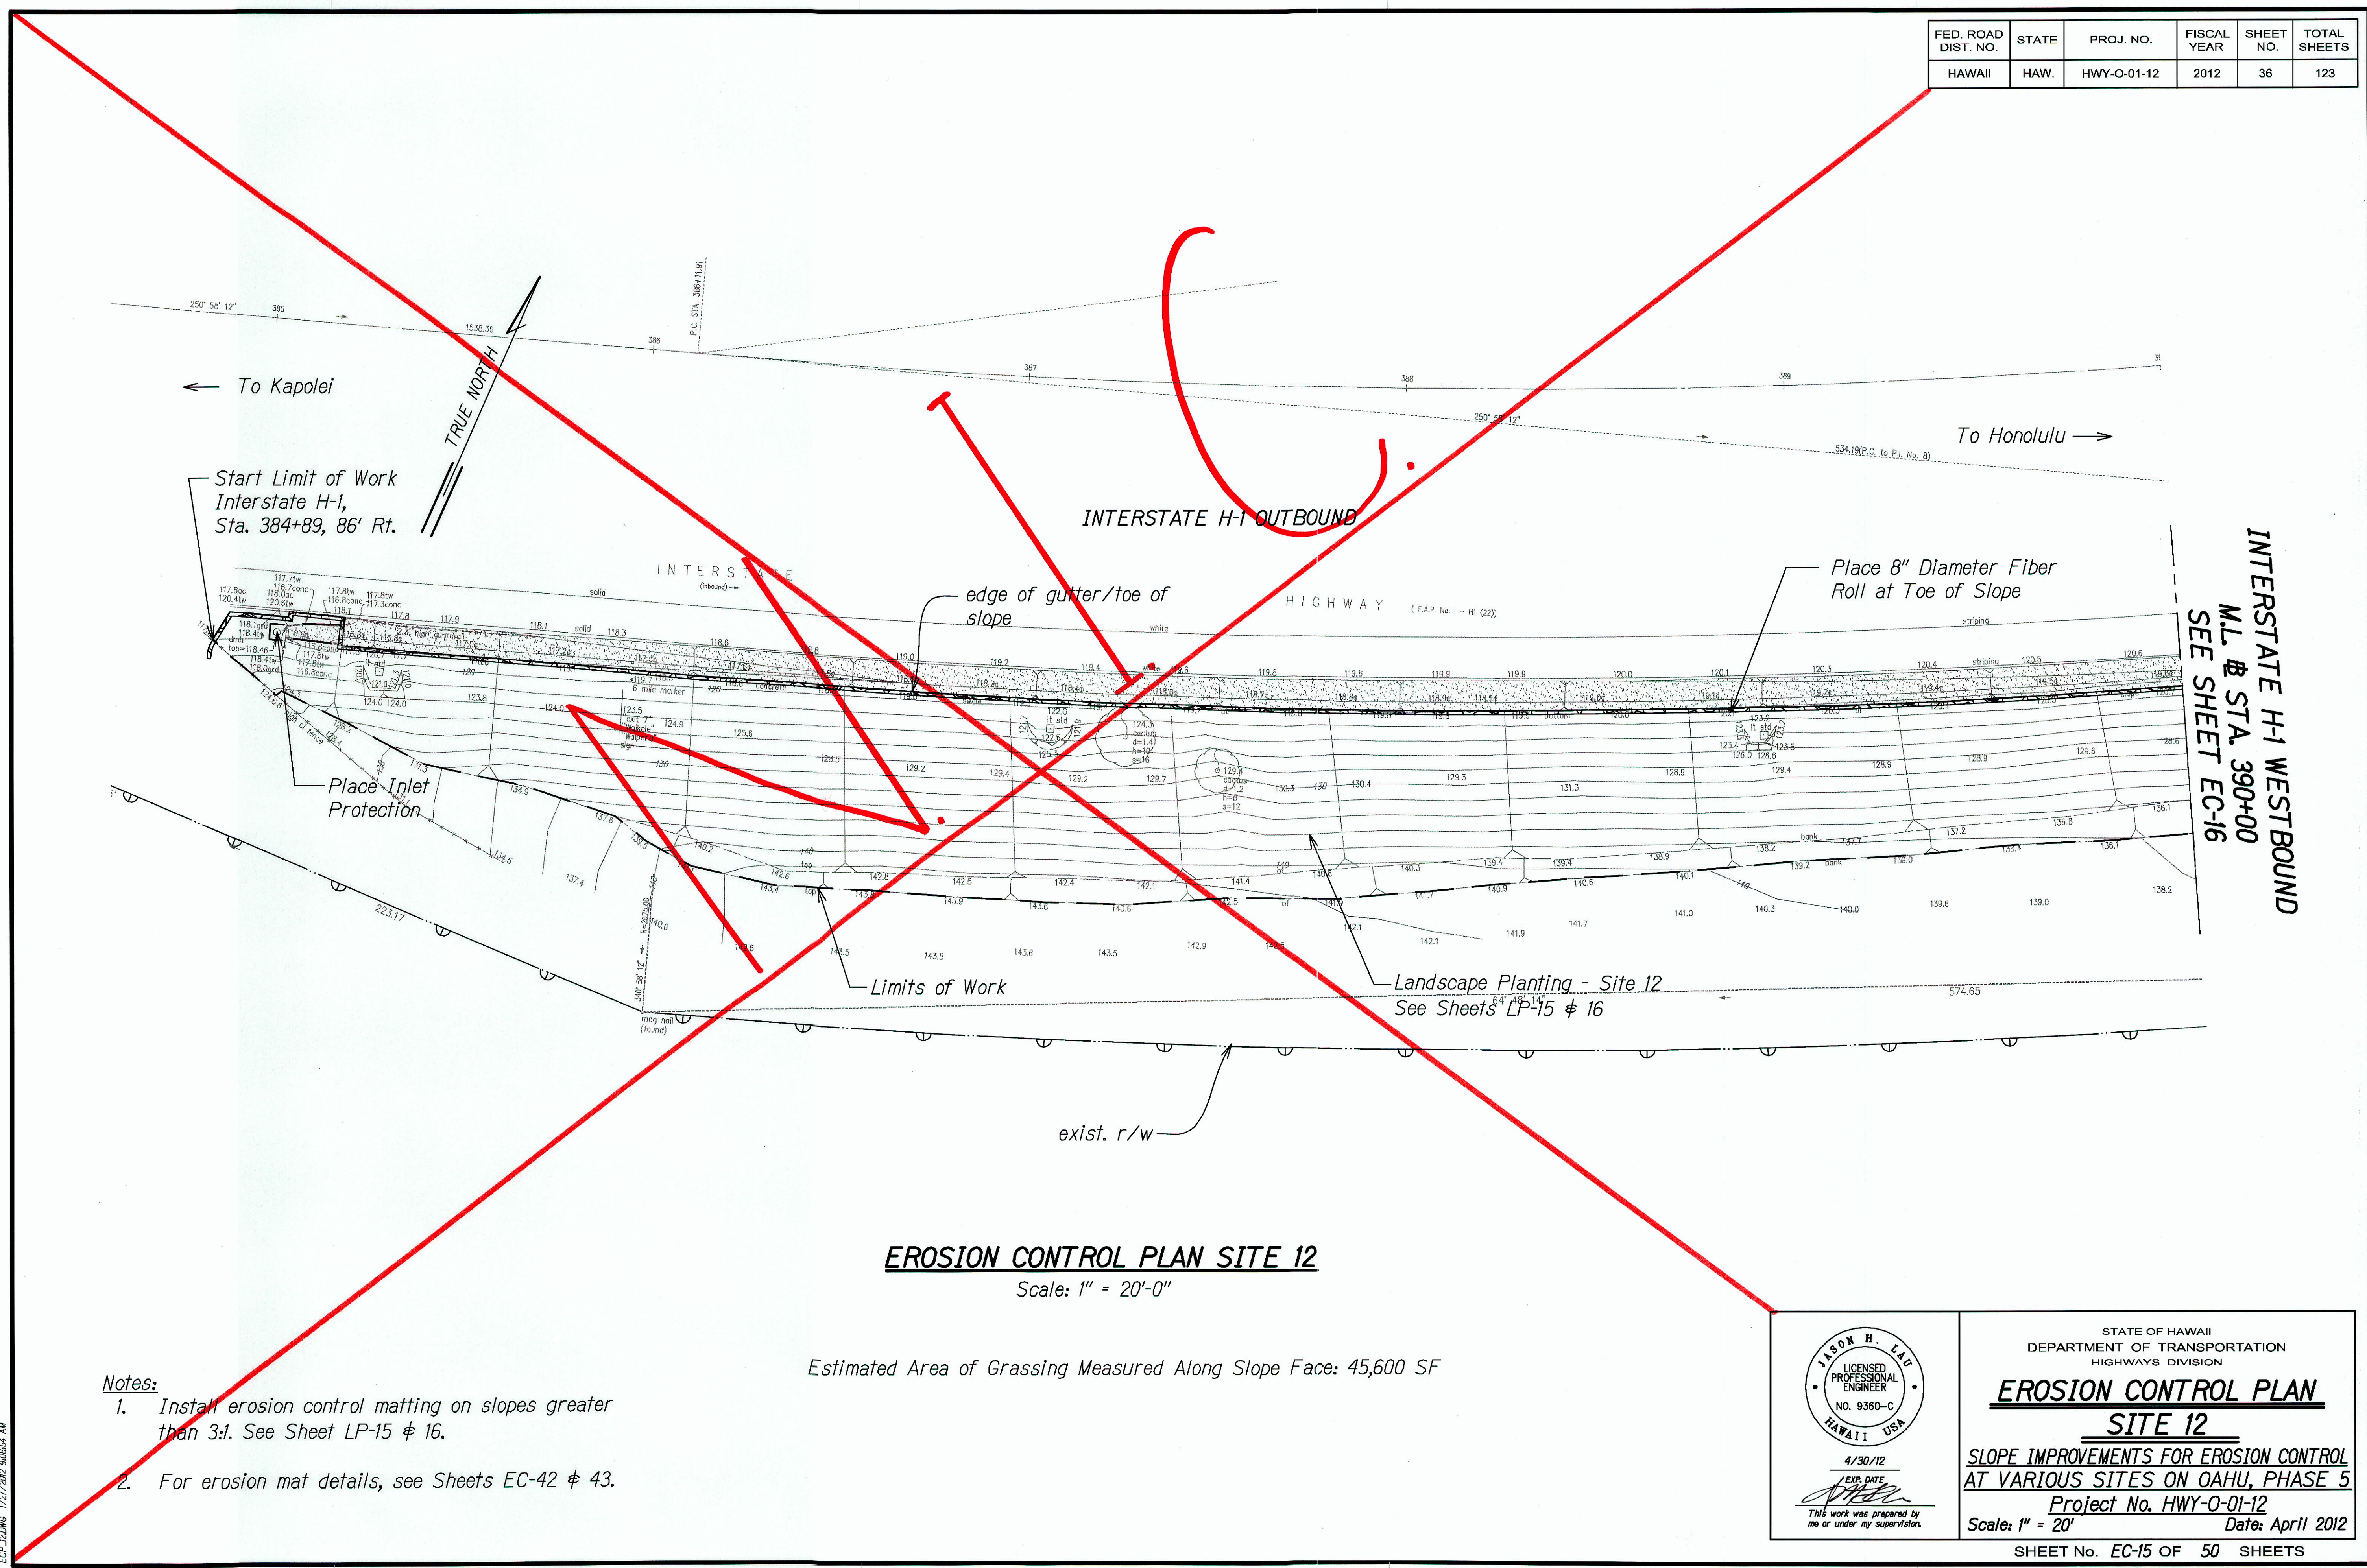

"AS-BUILT"

FED. ROAD DIST. NO.	STATE	PROJ. NO.	FISCAL YEAR	SHEET NO.	TOTAL SHEETS
HAWAII	HAW.	HWY-O-01-12	2012	37	123

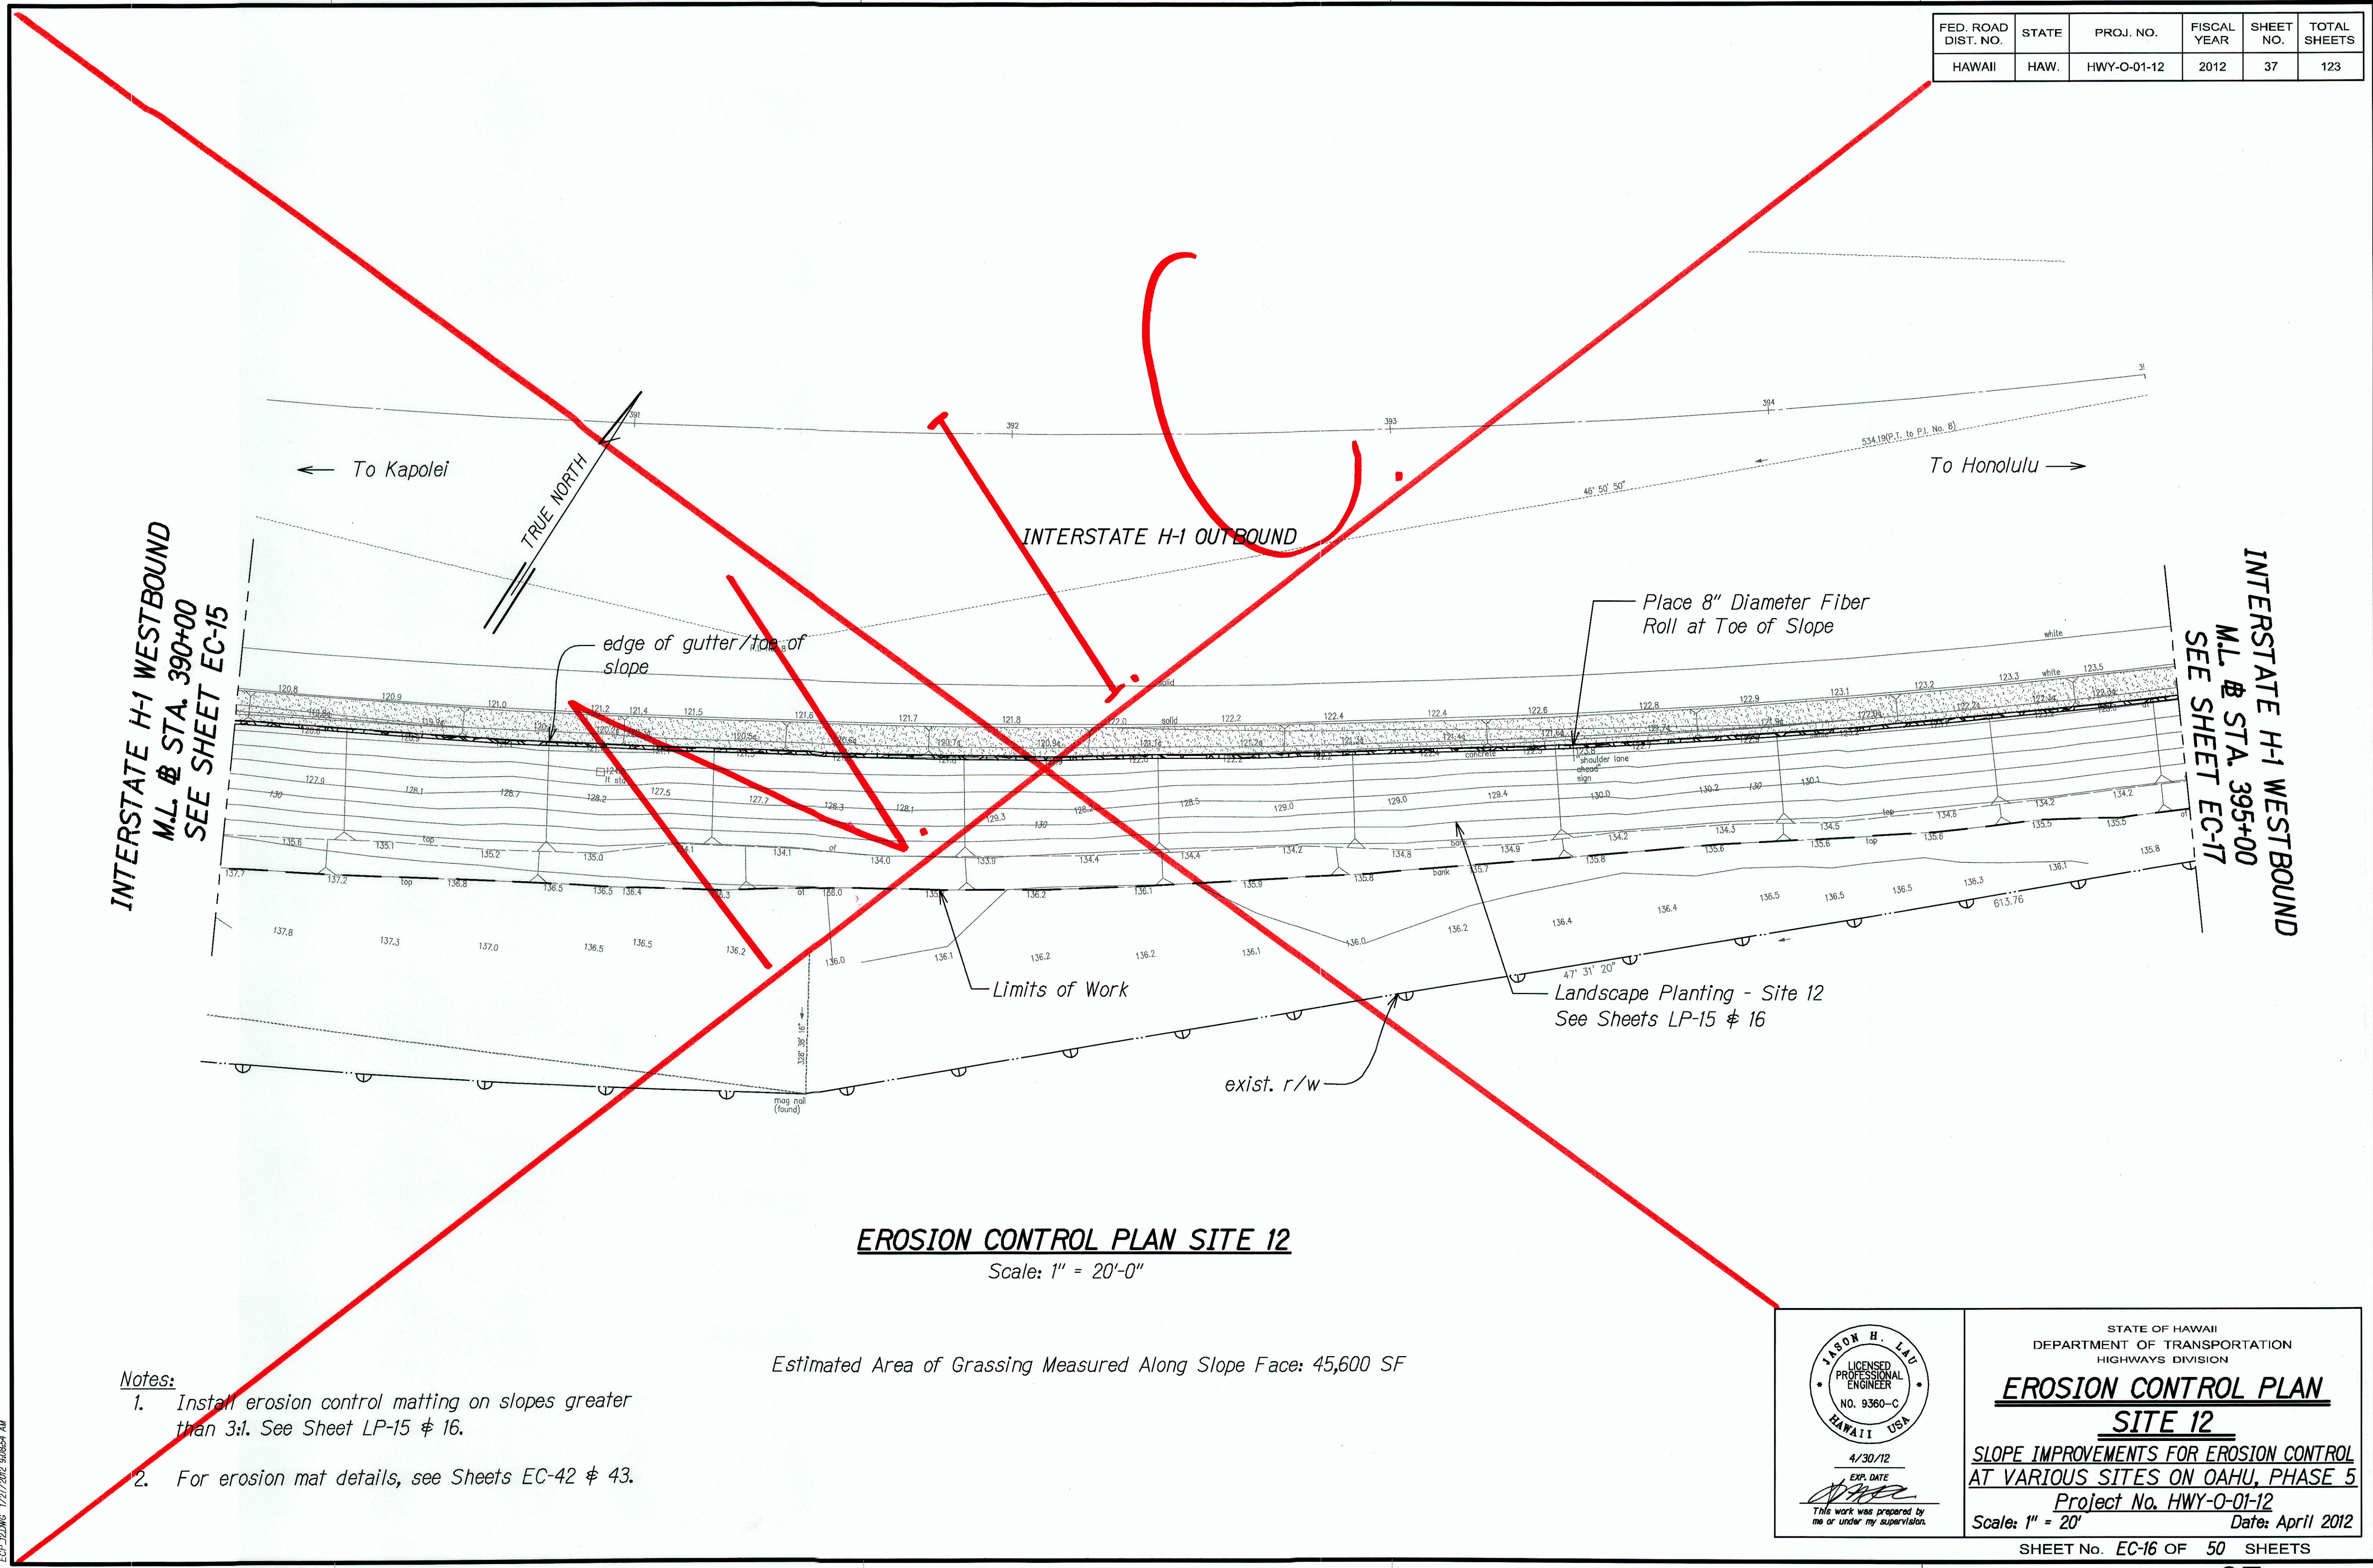

EROSION CONTROL PLAN SITE 12

Scale: 1" = 20'-0"

Estimated Area of Grassing Measured Along Slope Face: 45,600 SF

- Notes:
1. Install erosion control matting on slopes greater than 3:1. See Sheet LP-15 & 16.
 2. For erosion mat details, see Sheets EC-42 & 43.

ORIGINAL PLAN	SURVEY PLACED BY	DATE
DATE	DRAWN BY	
NOTE BOOK	TRACED BY	
QUANTITIES BY	CHECKED BY	
N.		


4/30/12
EXP. DATE
This work was prepared by me or under my supervision.

STATE OF HAWAII
DEPARTMENT OF TRANSPORTATION
HIGHWAYS DIVISION

EROSION CONTROL PLAN
SITE 12
SLOPE IMPROVEMENTS FOR EROSION CONTROL
AT VARIOUS SITES ON OAHU, PHASE 5
Project No. HWY-O-01-12
Scale: 1" = 20' Date: April 2012

FED. ROAD DIST. NO.	STATE	PROJ. NO.	FISCAL YEAR	SHEET NO.	TOTAL SHEETS
HAWAII	HAW.	HWY-O-01-12	2012	38	123

INTERSTATE H-1 WESTBOUND
M.L. # STA. 395+00
SEE SHEET EC-16

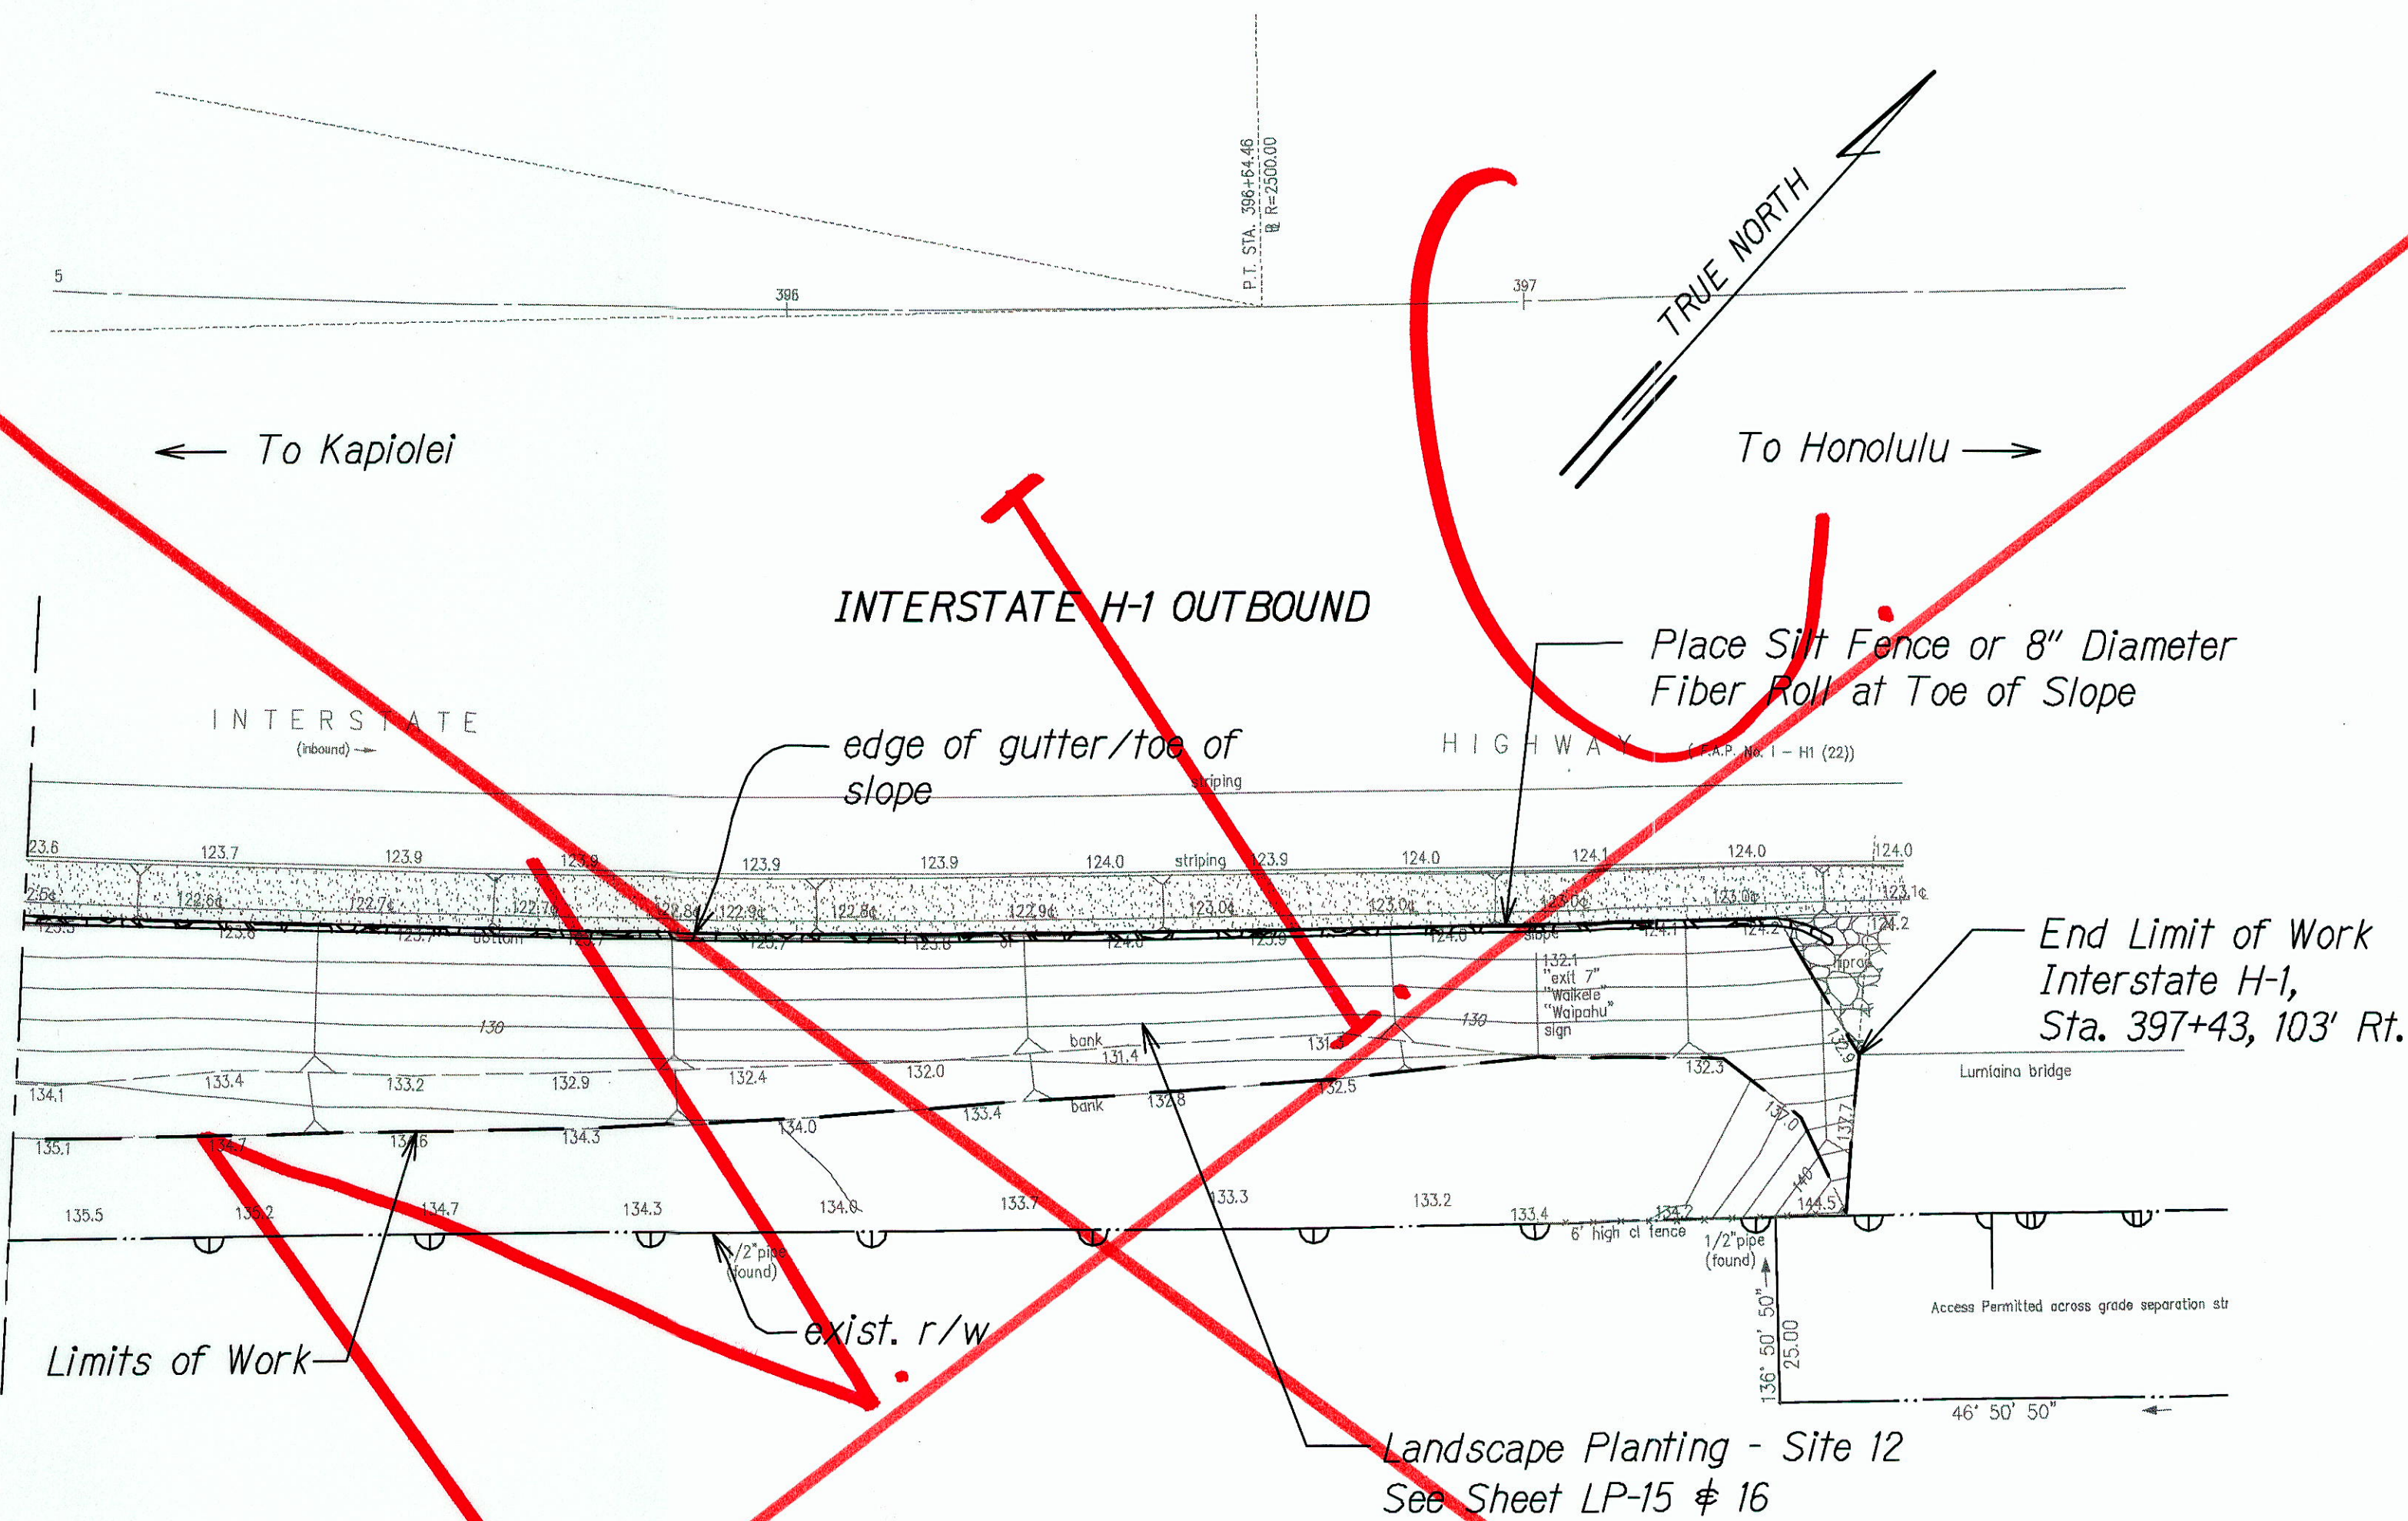

EROSION CONTROL PLAN SITE 12

Scale: 1" = 20'-0"

Estimated Area of Grassing Measured Along Slope Face: 45,600 SF

- Notes:
1. Install erosion control matting on slopes greater than 3:1. See Sheet LP-15 # 16.
 2. For erosion mat details, see Sheets EC-42 # 43.

ORIGINAL PLAN	SURVEY PLOTTED BY	DATE
NOTE BOOK	DRAWN BY	
	QUANTITIES BY	
	CHECKED BY	

EC-12/16/12 1/27/2012 9:05:54 AM

4/30/12
EXP. DATE
Jason H. Lau
This work was prepared by me or under my supervision.

STATE OF HAWAII
DEPARTMENT OF TRANSPORTATION
HIGHWAYS DIVISION

**EROSION CONTROL PLAN
SITE 12**


SLOPE IMPROVEMENTS FOR EROSION CONTROL
AT VARIOUS SITES ON OAHU, PHASE 5

Project No. HWY-O-01-12
Scale: 1" = 20' Date: April 2012

SHEET No. EC-17 OF 50 SHEETS

"AS-BUILT"

FED. ROAD DIST. NO.	STATE	PROJ. NO.	FISCAL YEAR	SHEET NO.	TOTAL SHEETS
HAWAII	HAW.	HWY-O-01-12	2012	39	123

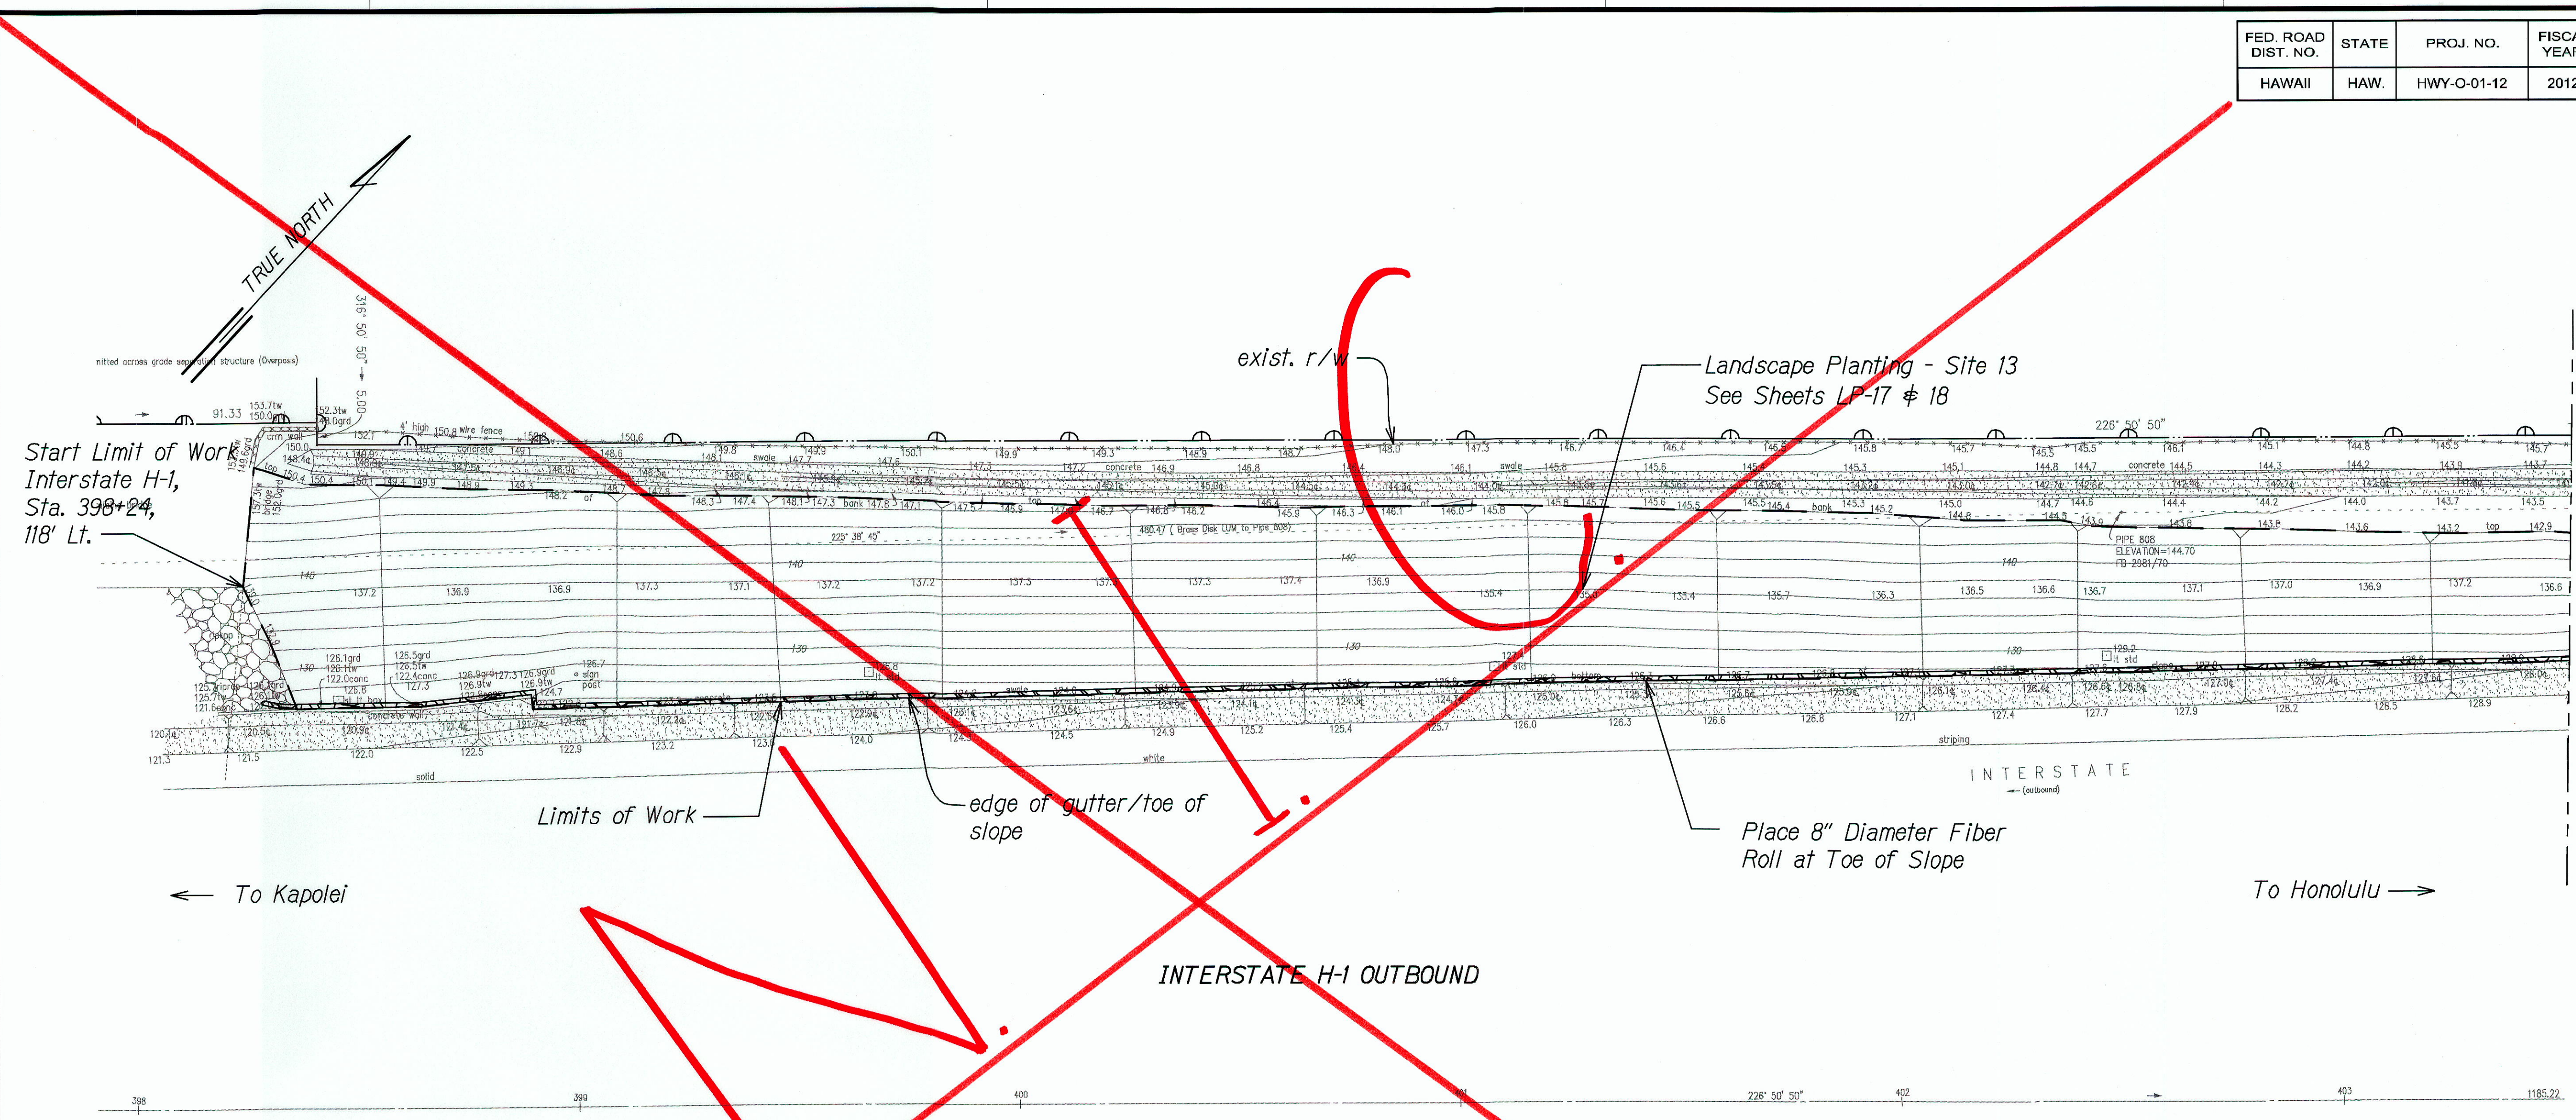

INTERSTATE H-1 WESTBOUND
M.L. @ STA. 403+50
SEE SHEET EC-19

EROSION CONTROL PLAN SITE 13
Scale: 1" = 20'-0"

Estimated Area of Grassing Measured Along Slope Face: 31,500 SF

- Notes:
1. Install erosion control matting on slopes greater than 3:1. See Sheet LP-17 & 18.
 2. For erosion mat details, see Sheets EC-42 & 43.

ORIGINAL PLAN	SURVEY PLOTTED BY	DATE
NOTE BOOK	DRAWN BY	
	TRACED BY	
	QUANTITIES BY	
	CHECKED BY	

4/30/12
EXP. DATE


STATE OF HAWAII
DEPARTMENT OF TRANSPORTATION
HIGHWAYS DIVISION

EROSION CONTROL PLAN
SITE 13

SLOPE IMPROVEMENTS FOR EROSION CONTROL
AT VARIOUS SITES ON OAHU, PHASE 5

Project No. HWY-O-01-12
Scale: 1" = 20' Date: April 2012

FED. ROAD DIST. NO.	STATE	PROJ. NO.	FISCAL YEAR	SHEET NO.	TOTAL SHEETS
HAWAII	HAW.	HWY-O-01-12	2012	40	123

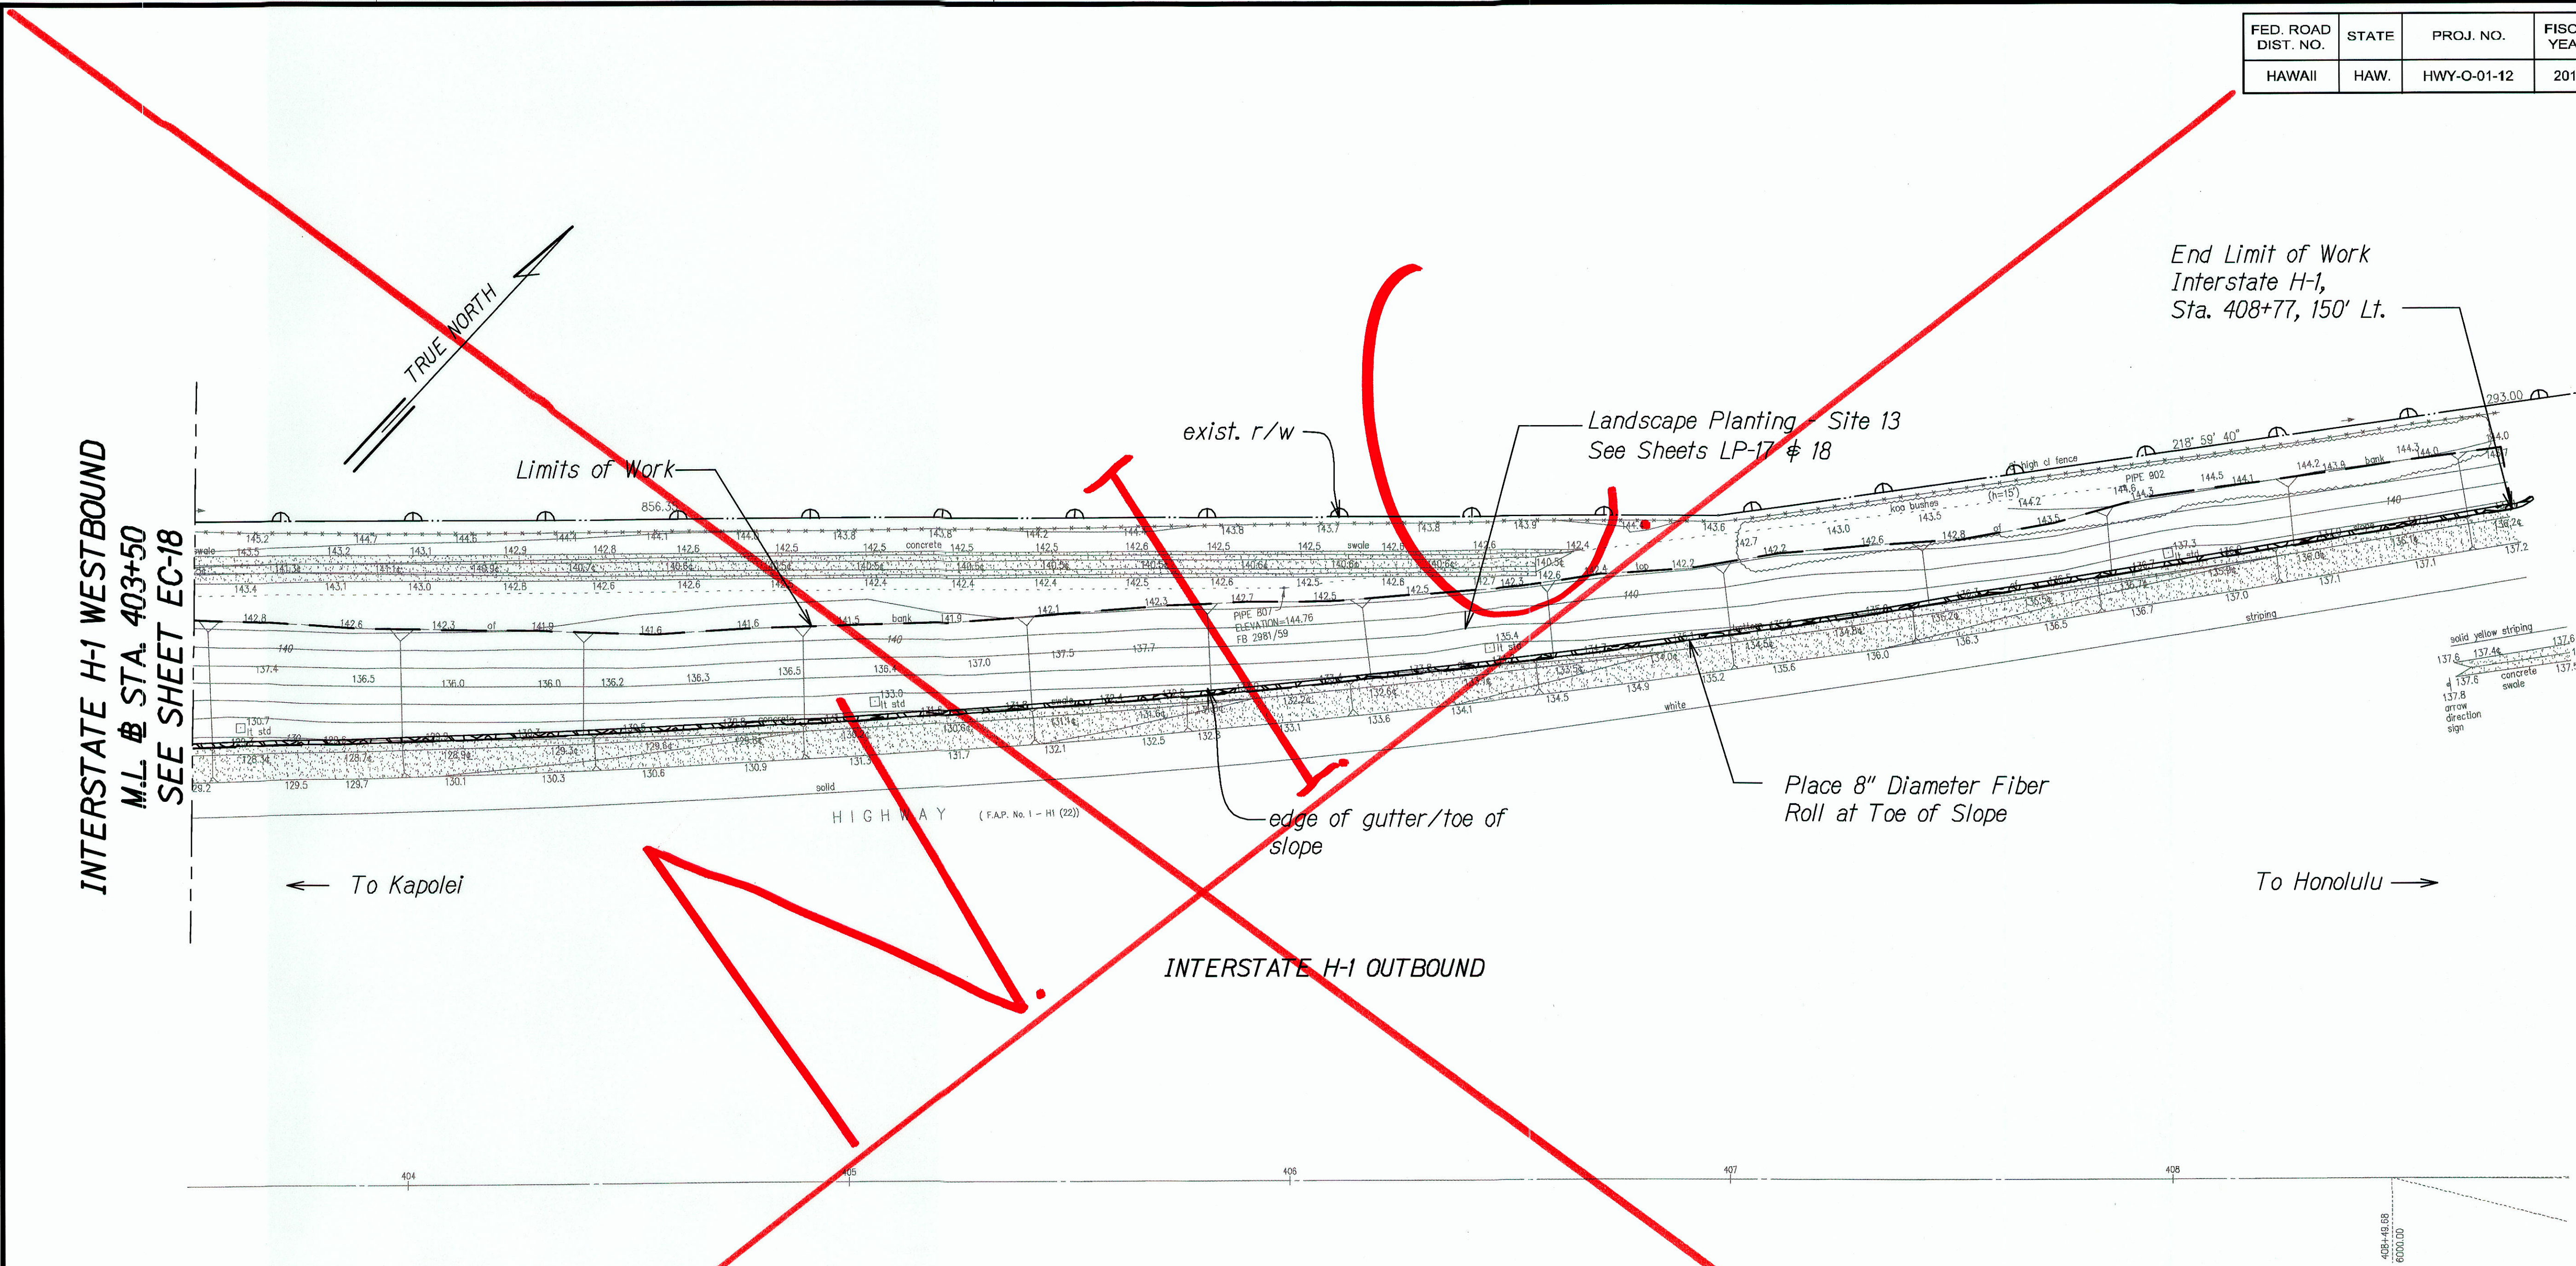

EROSION CONTROL PLAN SITE 13
Scale: 1" = 20'-0"

Estimated Area of Grassing Measured Along Slope Face: 31,500 SF

- Notes:
- 1. Install erosion control matting on slopes greater than 3:1. See Sheet LP-17 & 18.
 - 2. For erosion mat details, see Sheets EC-42 & 43.

SURVEY PLOTTED BY	DATE
DRAWN BY	
TRACED BY	
QUANTITIES BY	
CHECKED BY	
ORIGINAL PLAN	
NOTE BOOK	
N.	

EC-19.DWG 2/1/2012 145238 PH

STATE OF HAWAII
DEPARTMENT OF TRANSPORTATION
HIGHWAYS DIVISION

EROSION CONTROL PLAN
SITE 13


SLOPE IMPROVEMENTS FOR EROSION CONTROL
AT VARIOUS SITES ON OAHU, PHASE 5

Project No. HWY-O-01-12
Scale: 1" = 20' Date: April 2012

SHEET No. EC-19 OF 50 SHEETS

"AS-BUILT"

FED. ROAD DIST. NO.	STATE	PROJ. NO.	FISCAL YEAR	SHEET NO.	TOTAL SHEETS
HAWAII	HAW.	HWY-O-01-12	2012	41	123

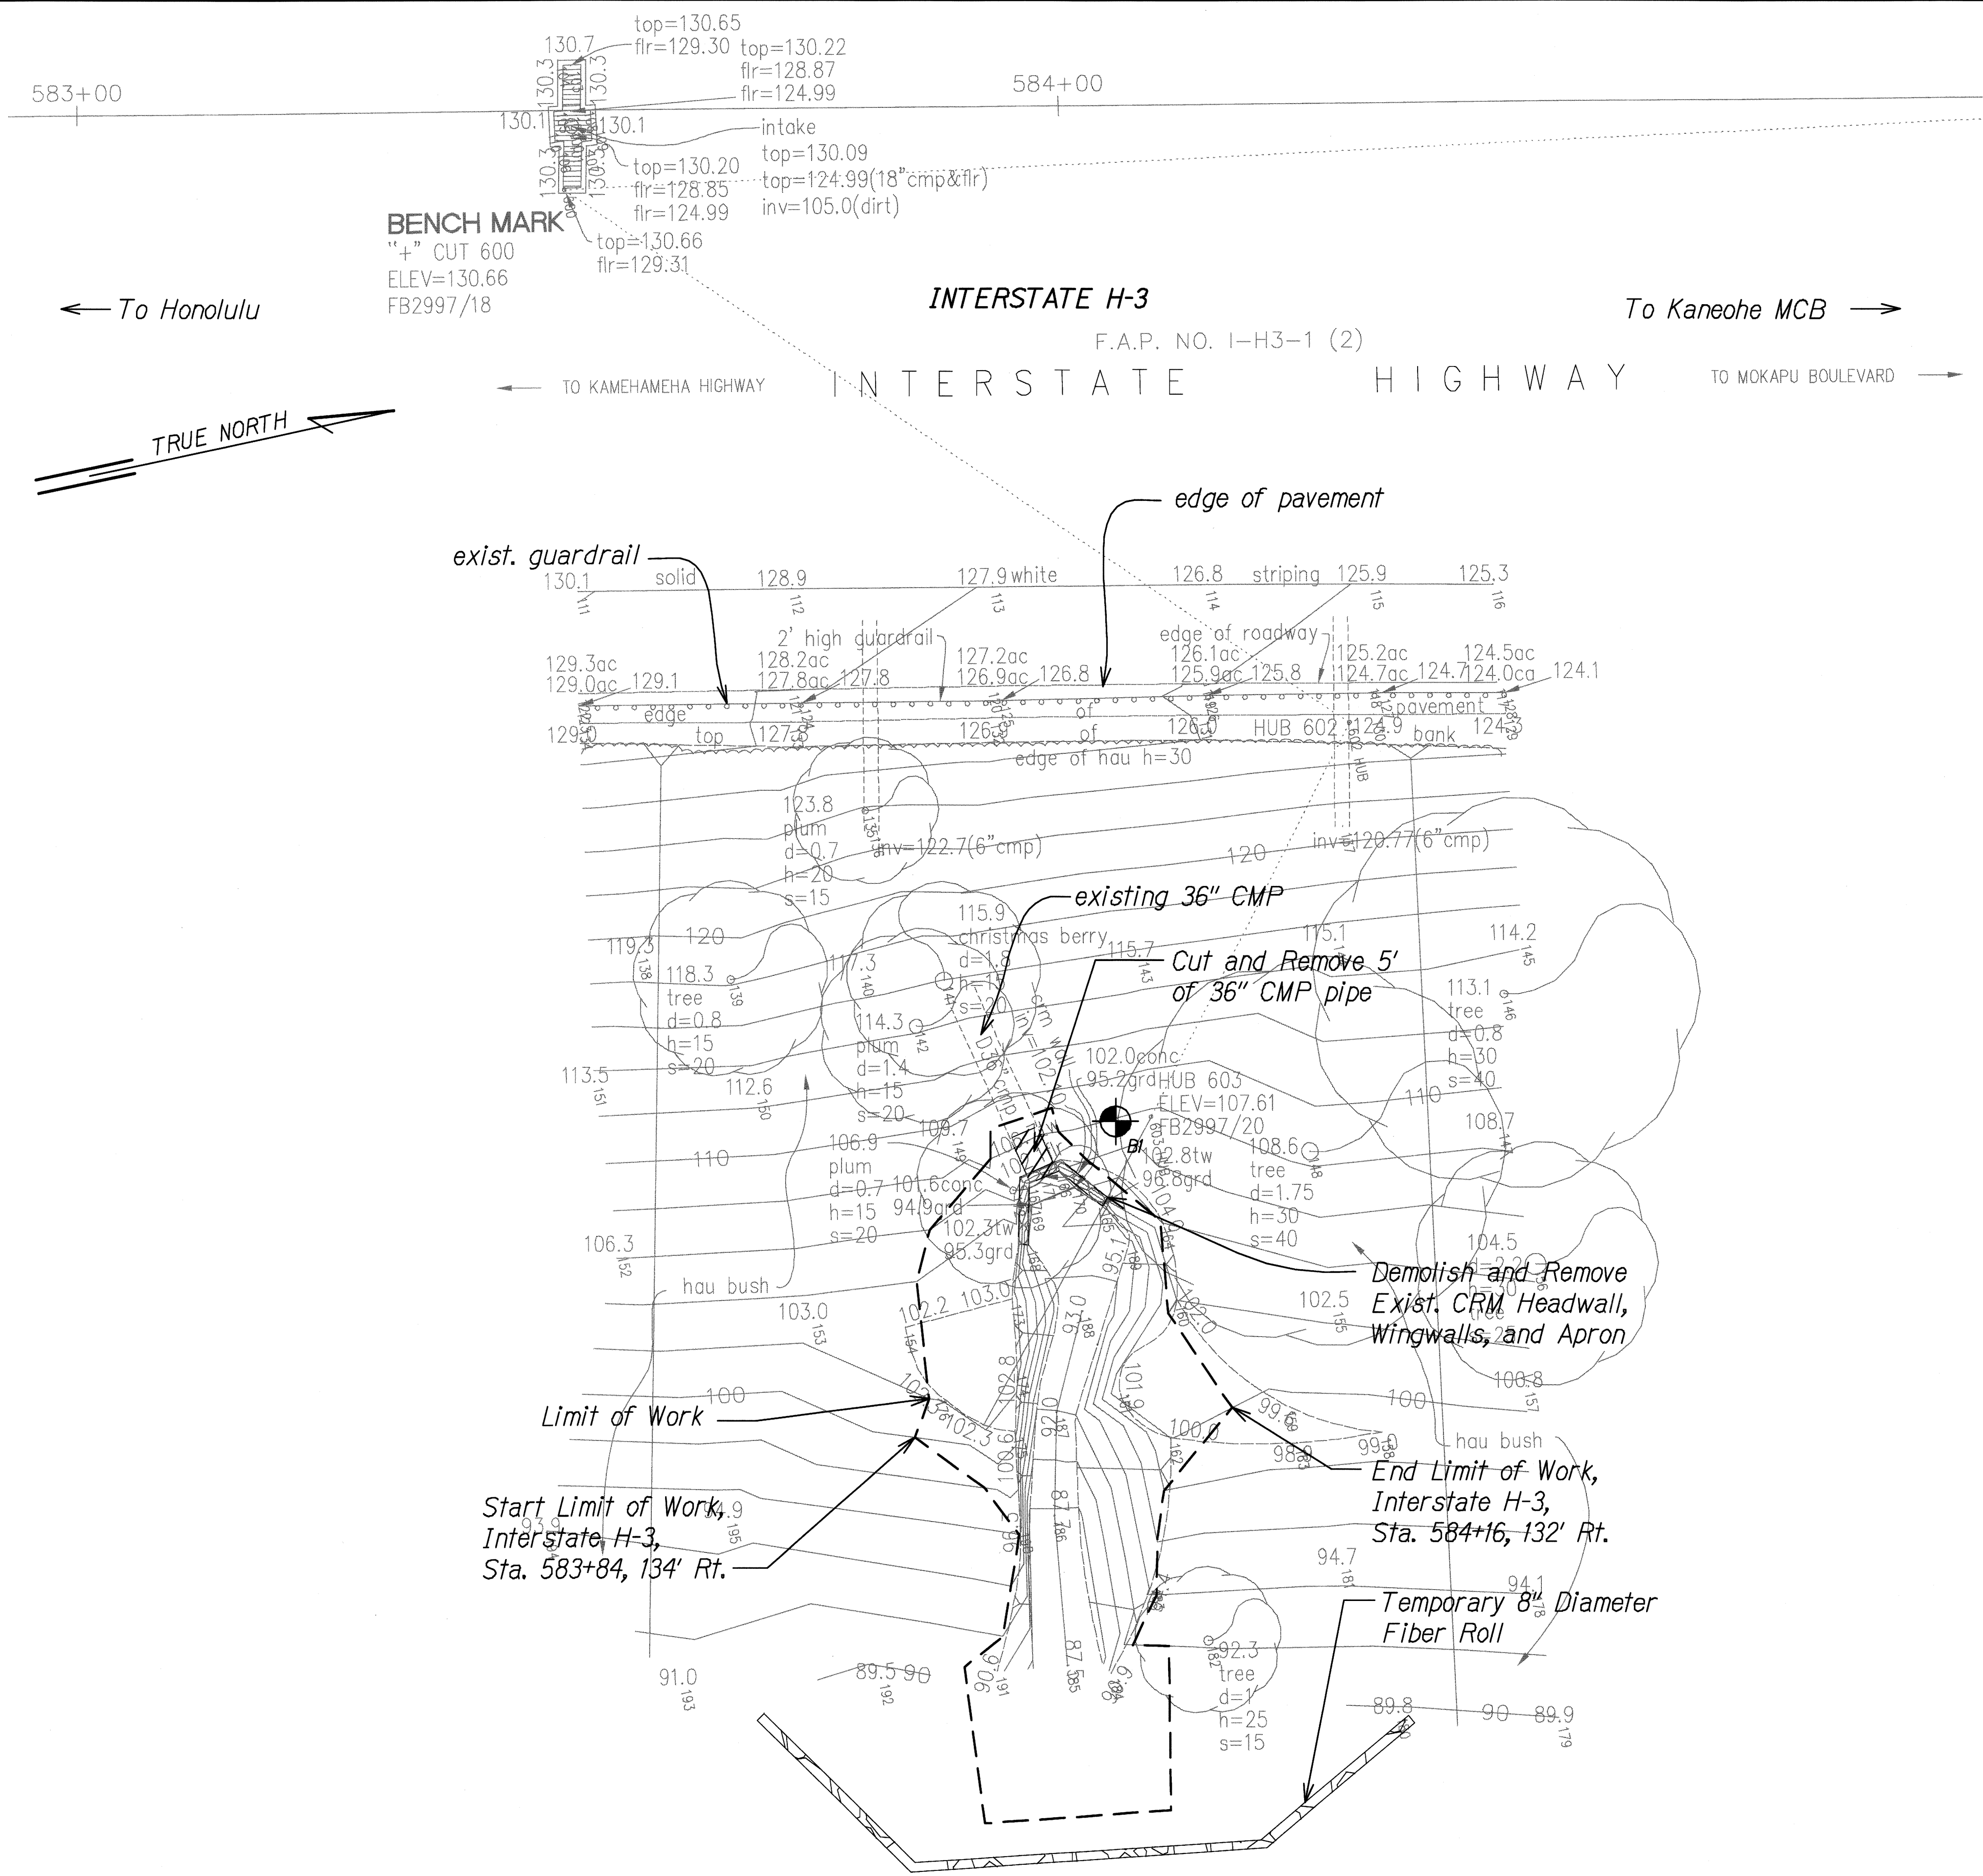

LEGEND

- ⊗ D36 ⊗ Existing Drain Pipe to be Removed
- Limits of Work
- BI Approx. Location of Boring

- Notes:**
- Remove all vegetation within limit of work unless otherwise indicated.
 - Contractor shall schedule construction of outfall improvements during dry weather periods and shall be prepared in case of rainfall events. The Contractor shall provide for temporary bypass or detention of stormwater flows or other measures to avoid flooding of properties upstream or adjacent to the site.
 - For boring log data, see Sheet No. EC-50.

SURVEY PLOTTED BY	DATE
DESIGNED BY	
TRACED BY	
NOTED BY	
QUANTITIES BY	
CHECKED BY	

SITE H-13 OUTFALL SECTION 2M/HBOX.C2D16 2/24/2012 7:53:39 AM

DEMOLITION AND EROSION CONTROL PLAN SITE 14

Scale: 1" = 10'-0"

JASON H. LIO
LICENSED PROFESSIONAL ENGINEER
NO. 9360-C
HAWAII USA

4/30/12
DATE
This work was prepared by me or under my supervision.

STATE OF HAWAII
DEPARTMENT OF TRANSPORTATION
HIGHWAYS DIVISION

DEMOLITION AND EROSION CONTROL PLAN SITE 14


SLOPE IMPROVEMENTS FOR EROSION CONTROL AT VARIOUS SITES ON OAHU, PHASE 5

Project No. HWY-O-01-12

Scale: 1" = 10' Date: April 2012

SHEET No. EC-20 OF 50 SHEETS

FED. ROAD DIST. NO.	STATE	PROJ. NO.	FISCAL YEAR	SHEET NO.	TOTAL SHEETS
HAWAII	HAW.	HWY-O-01-12	2012	42	123

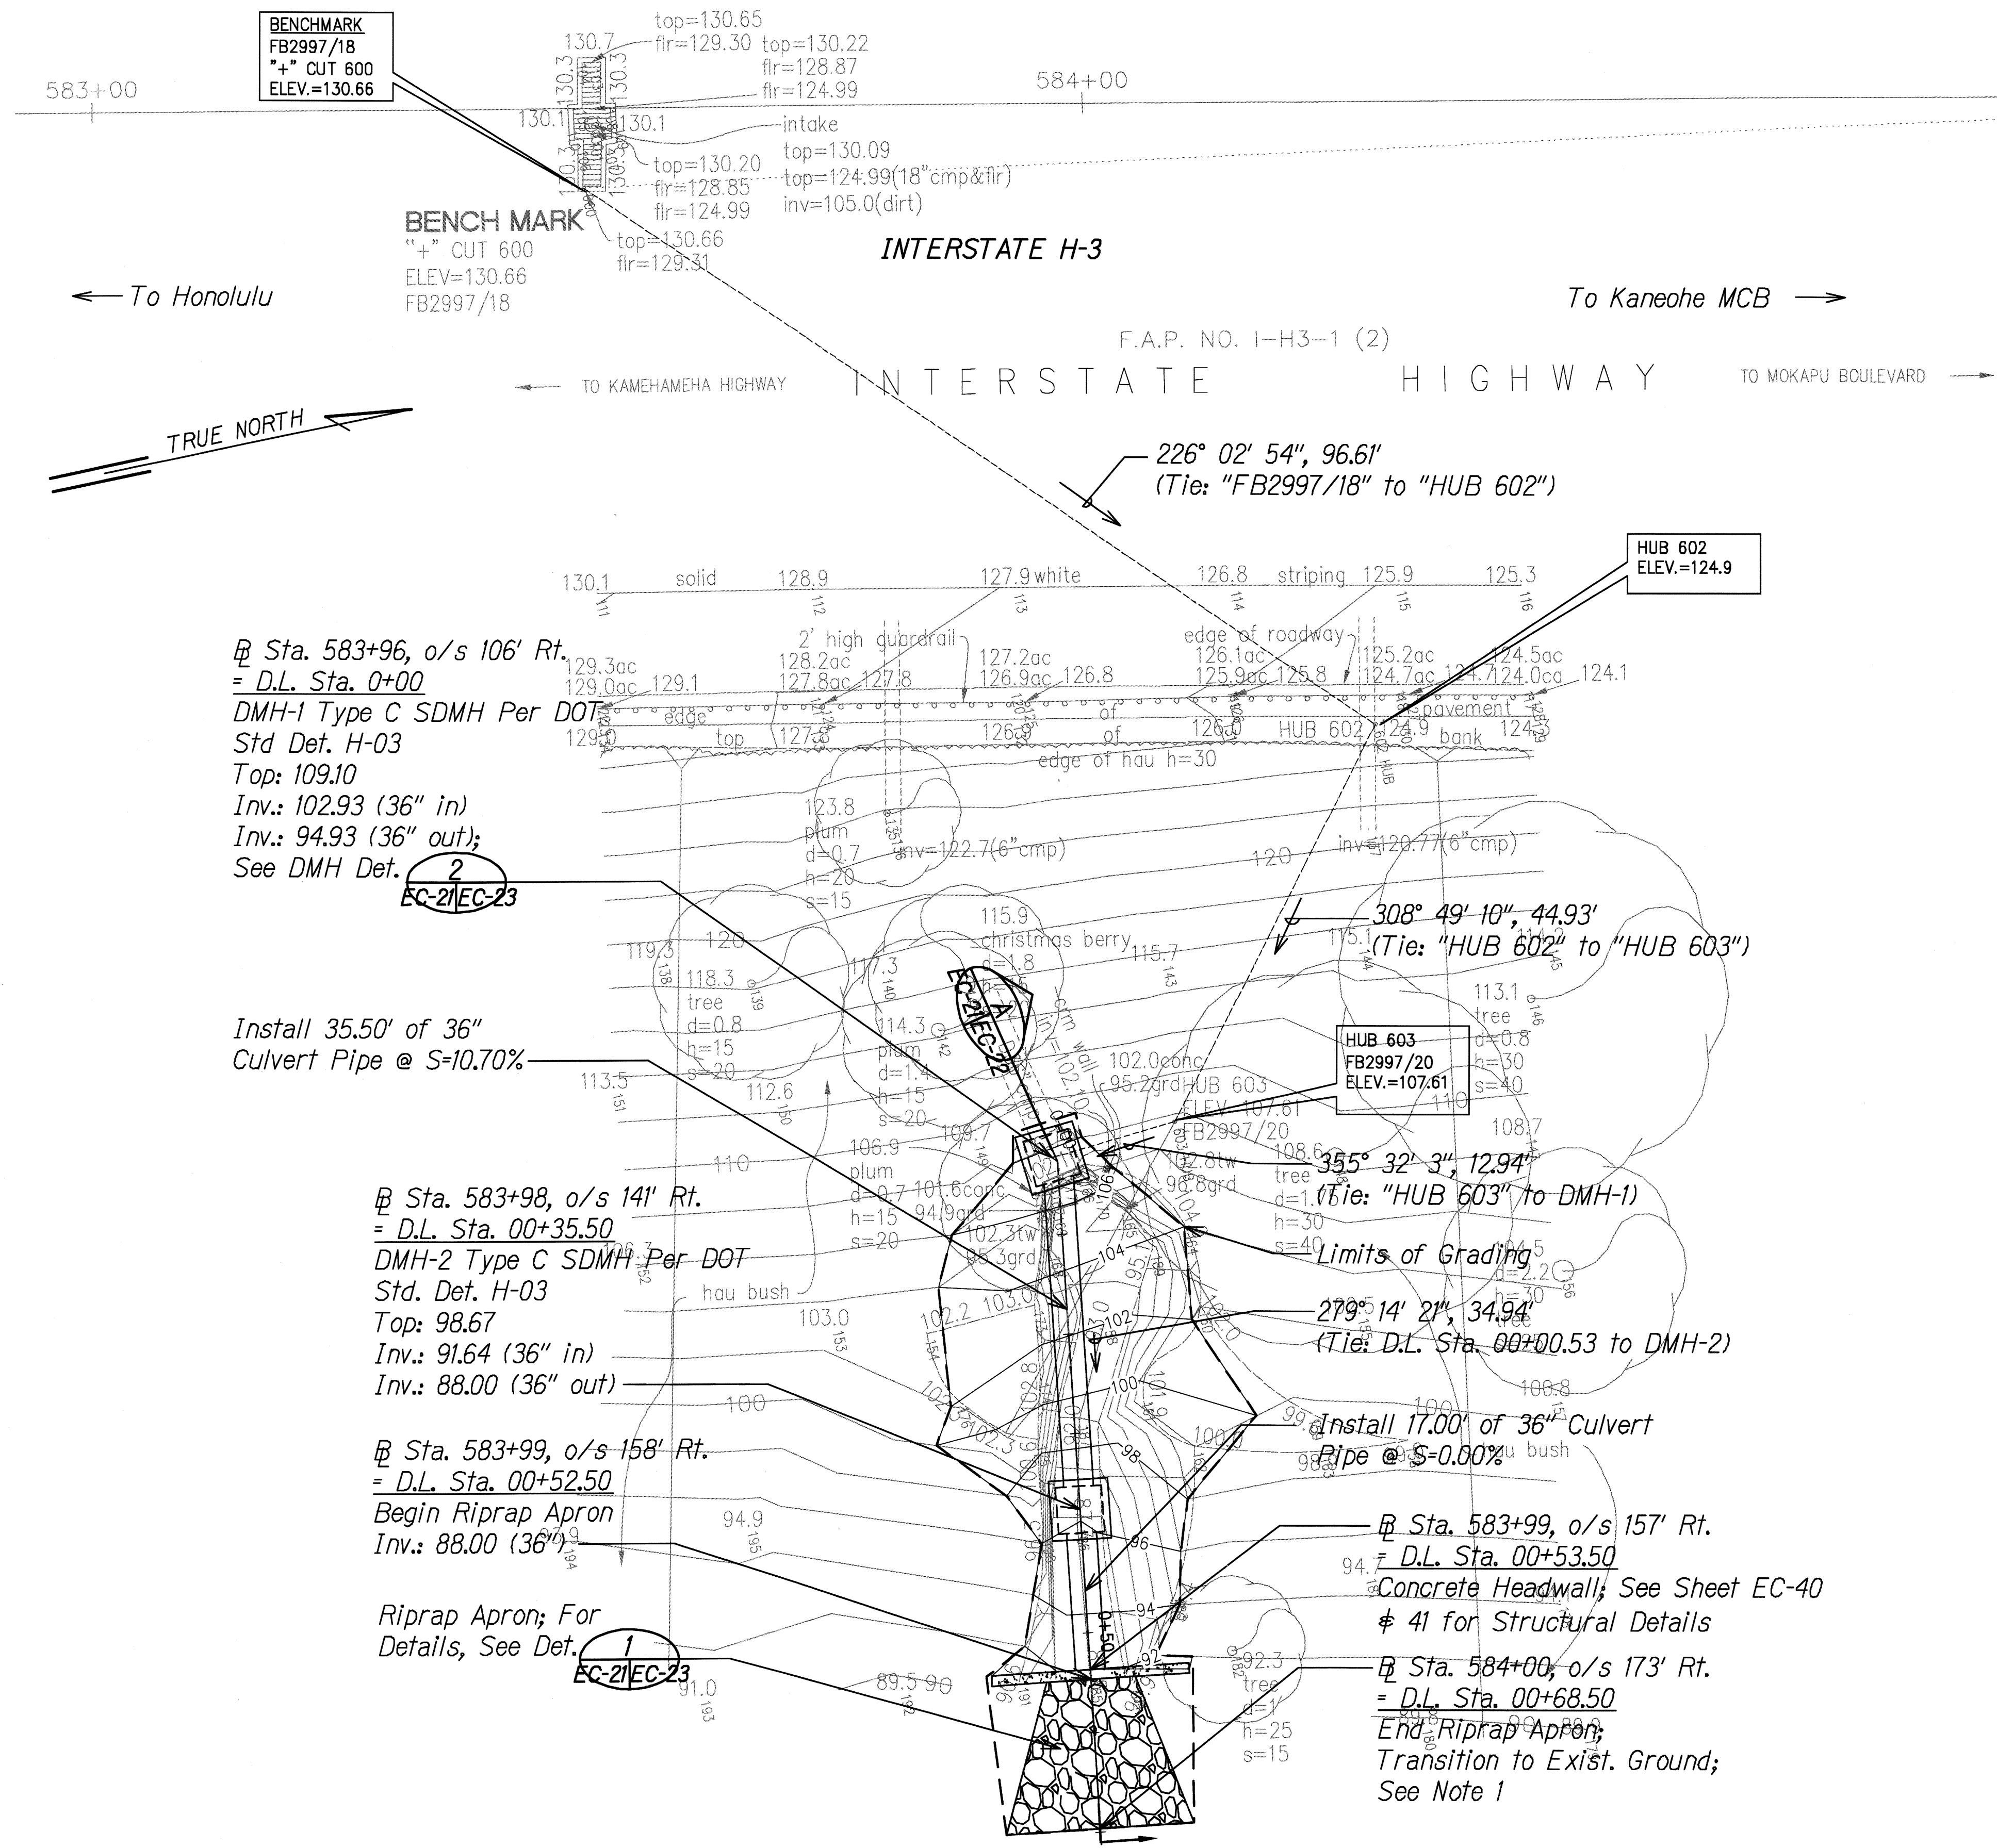

LEGEND

- 100--- Existing Contour
- 100— Finish Contour
- [Symbol] New Drain Manhole and Pipe
- [Symbol] Riprap Apron

Estimated Area of Grading: 1,430 SF

Notes:

1. The Contractor shall transition downstream edge of riprap apron to existing ground at a maximum 3H:1V slope.
2. For typical drain pipe trench detail, see Sheet No. EC-23.
3. The Contractor shall install erosion control matting over disturbed areas to control sediment runoff from the site in accordance with the plans and specifications.

DATE	BY
DESIGNED BY	DATE
TRACED BY	DATE
NOTED BY	DATE
CHECKED BY	DATE

SITE M-13 DUTAIL SECTION 2/10/2012 4:30:40 AM

EROSION CONTROL PLAN SITE 14 LAYOUT

Scale: 1" = 10'-0"

JASON H. LAU
LICENSED PROFESSIONAL ENGINEER
NO. 9360-C
HAWAII, USA

4/30/12

DATE

This work was prepared by me or under my supervision.

STATE OF HAWAII
DEPARTMENT OF TRANSPORTATION
HIGHWAYS DIVISION

EROSION CONTROL PLAN
SITE 14 LAYOUT


SLOPE IMPROVEMENTS FOR EROSION CONTROL
AT VARIOUS SITES ON OAHU, PHASE 5

Project No. HWY-O-01-12


Scale: 1" = 10' Date: April 2012

SHEET No. EC-21 OF 50 SHEETS


FED. ROAD DIST. NO.	STATE	PROJ. NO.	FISCAL YEAR	SHEET NO.	TOTAL SHEETS
HAWAII	HAW.	HWY-O-01-12	2012	43	123

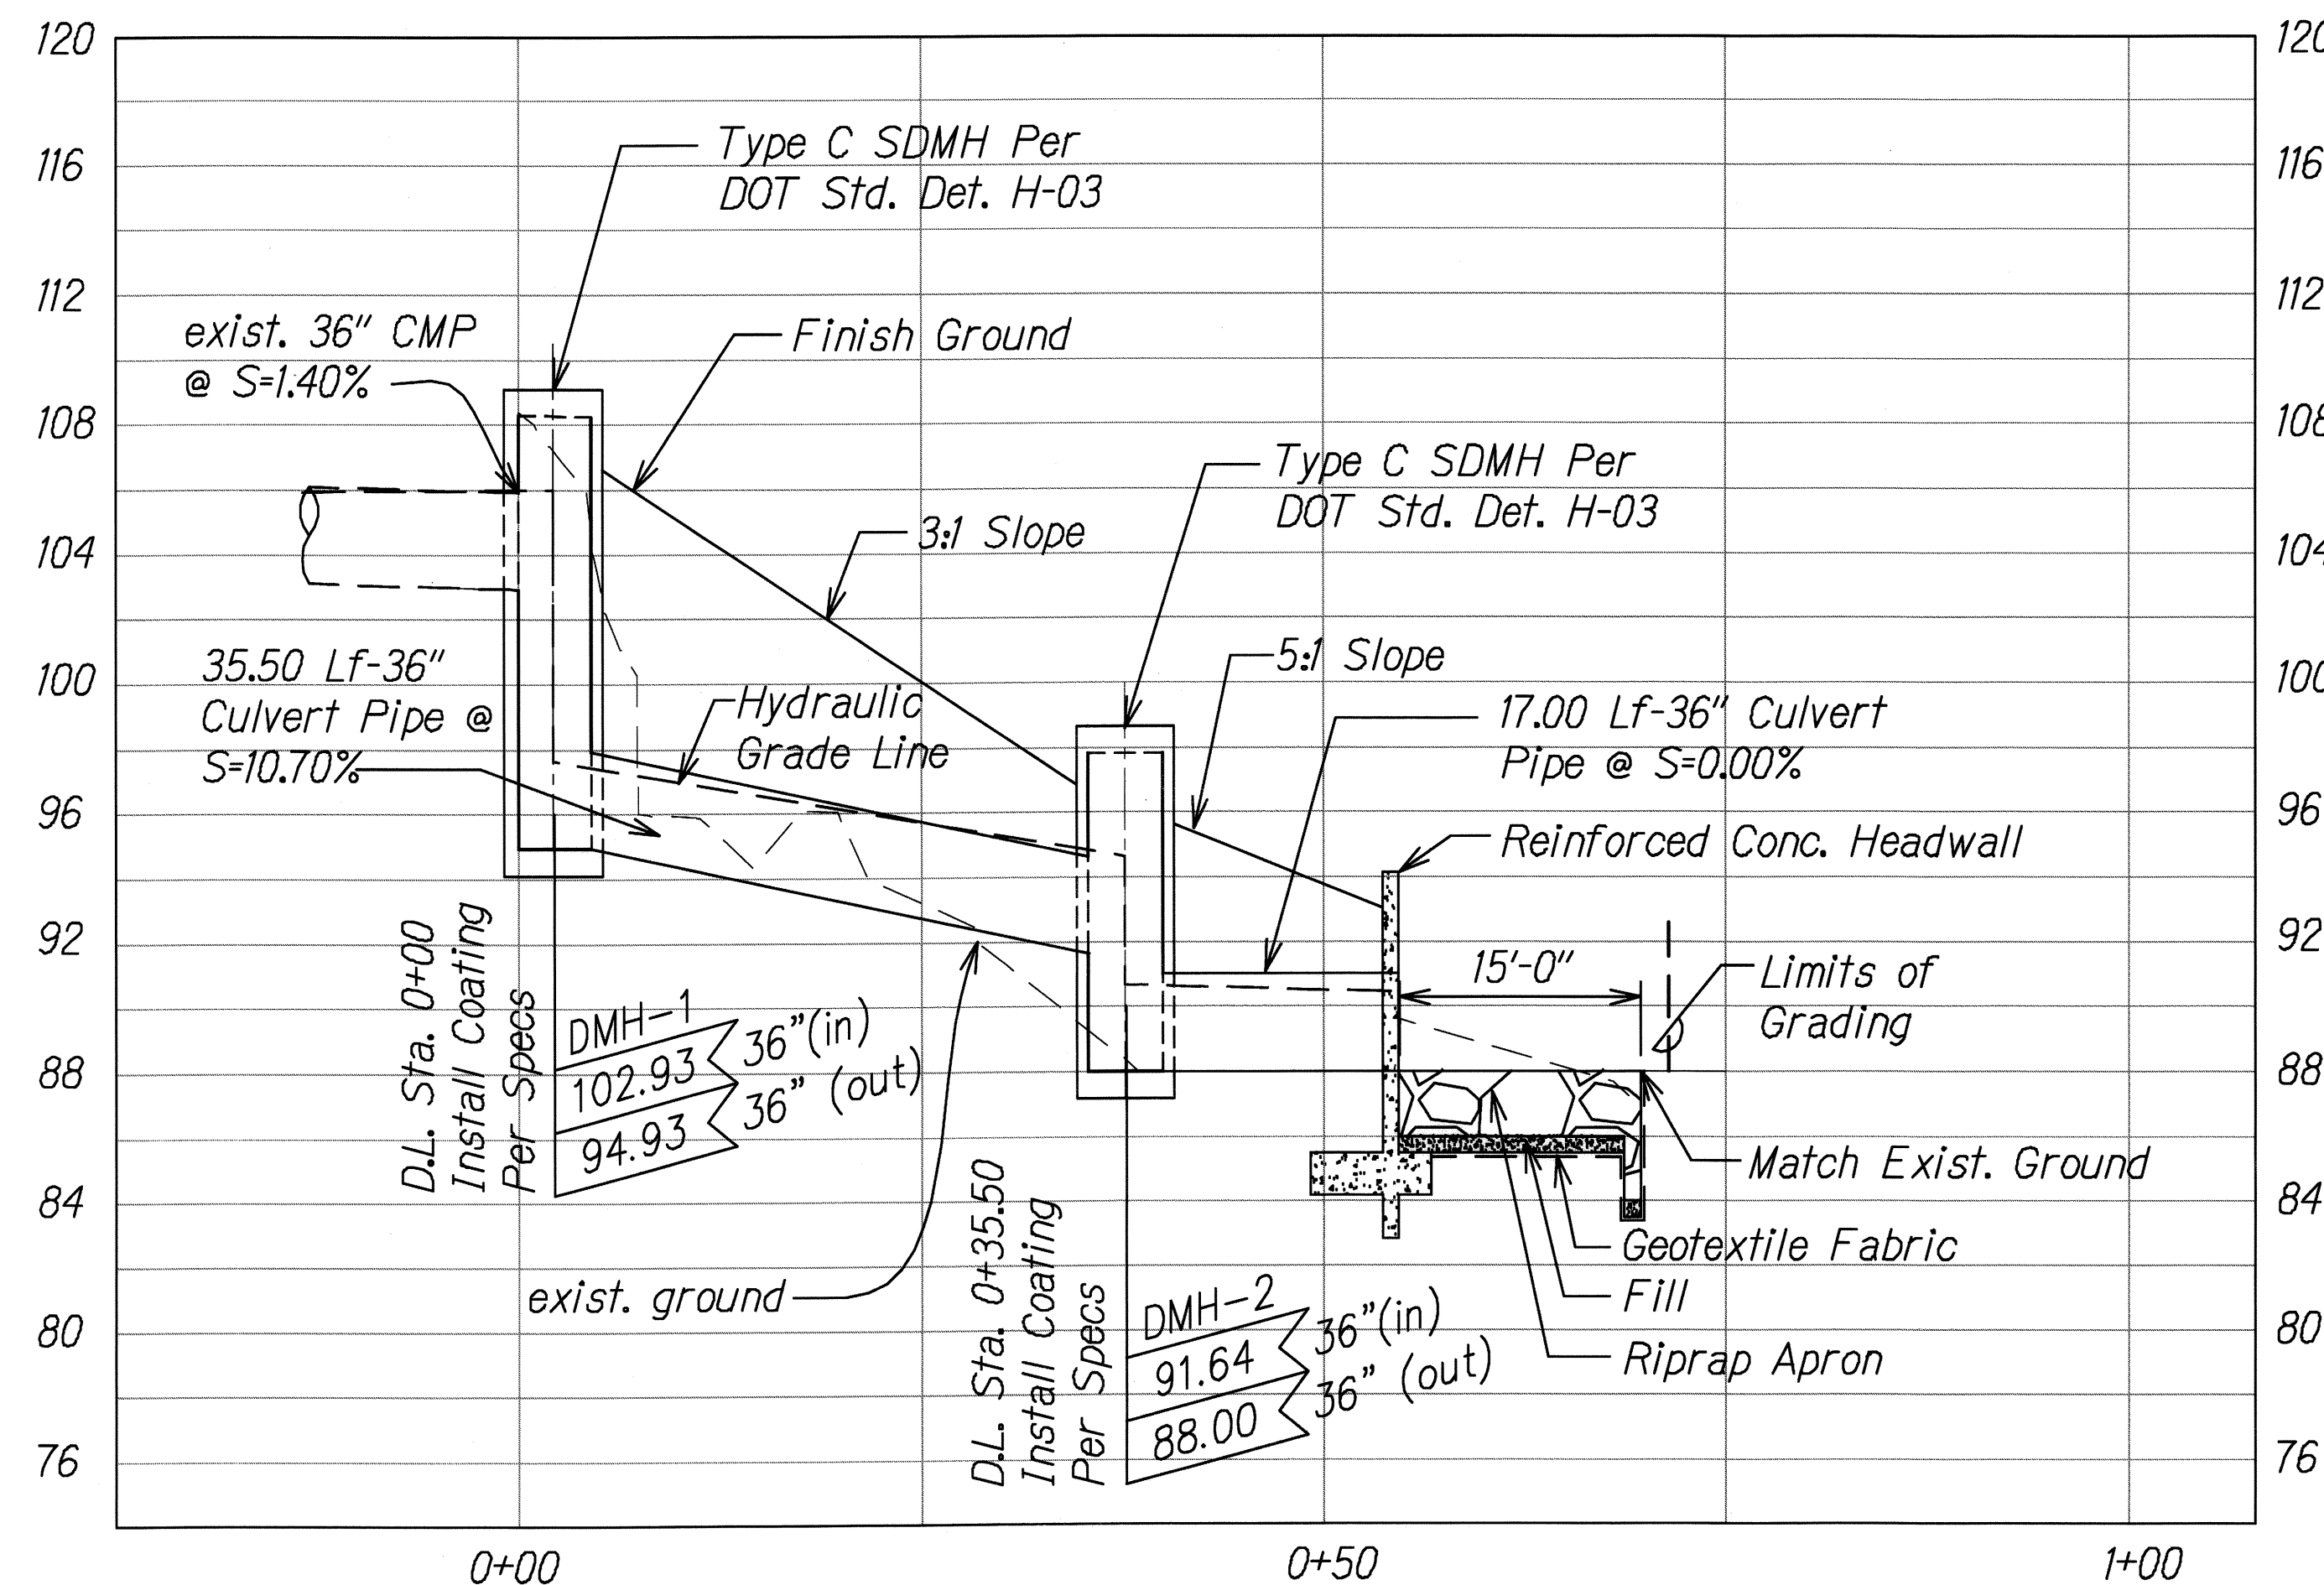


SECTION A
Scale: Horiz. 1" = 10'-0"
Vert. 1" = 5'-0"

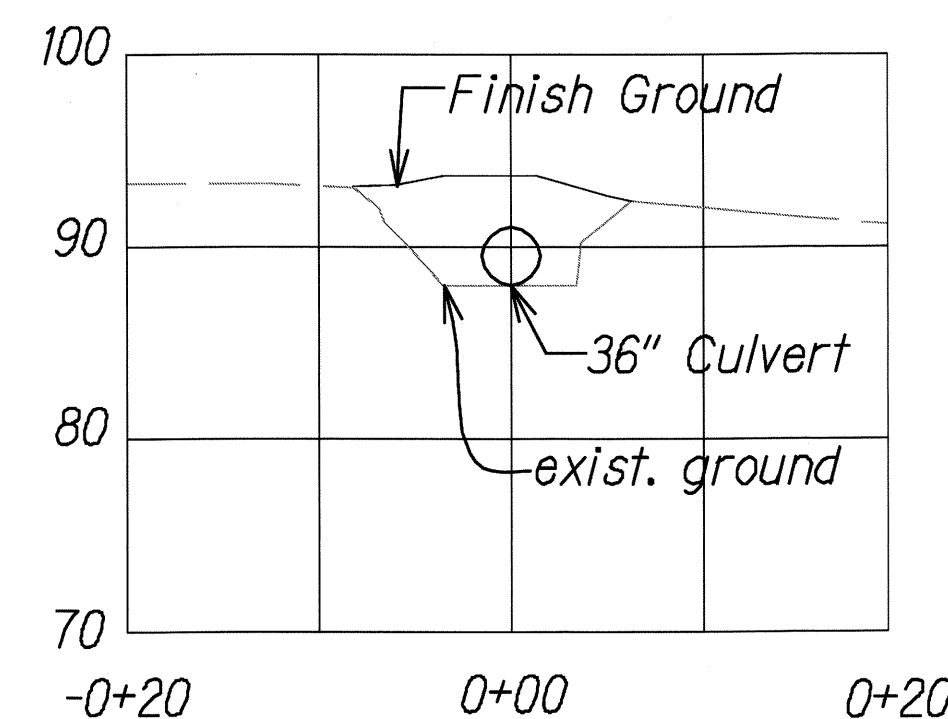


STA. 00+50
Scale: Horiz. 1" = 10'-0"
Vert. 1" = 10'-0"

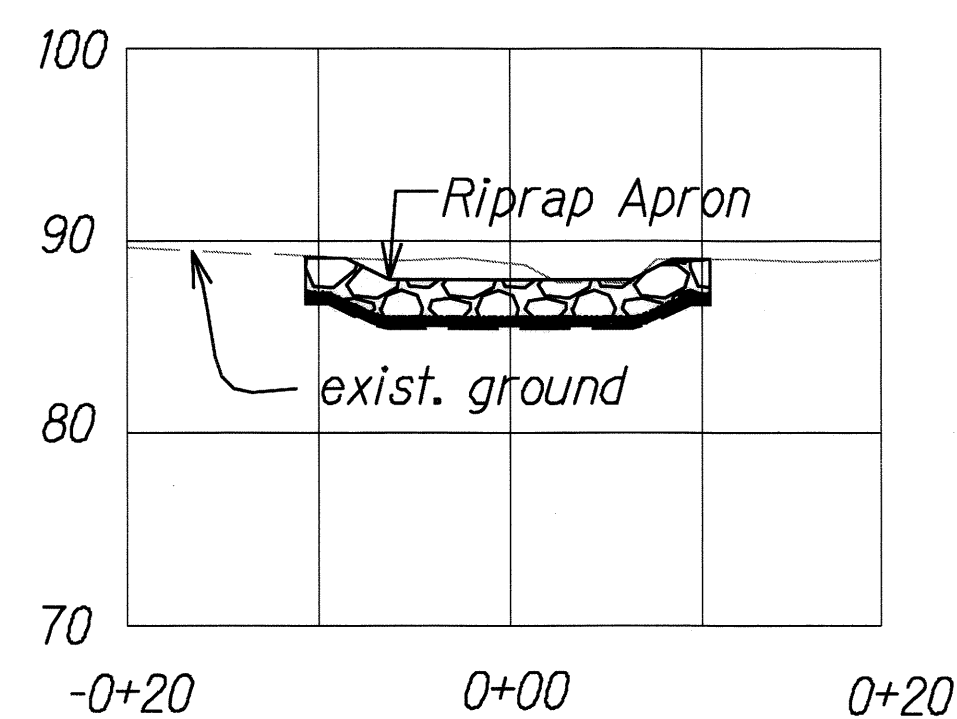


STA. 00+60
Scale: Horiz. 1" = 10'-0"
Vert. 1" = 10'-0"

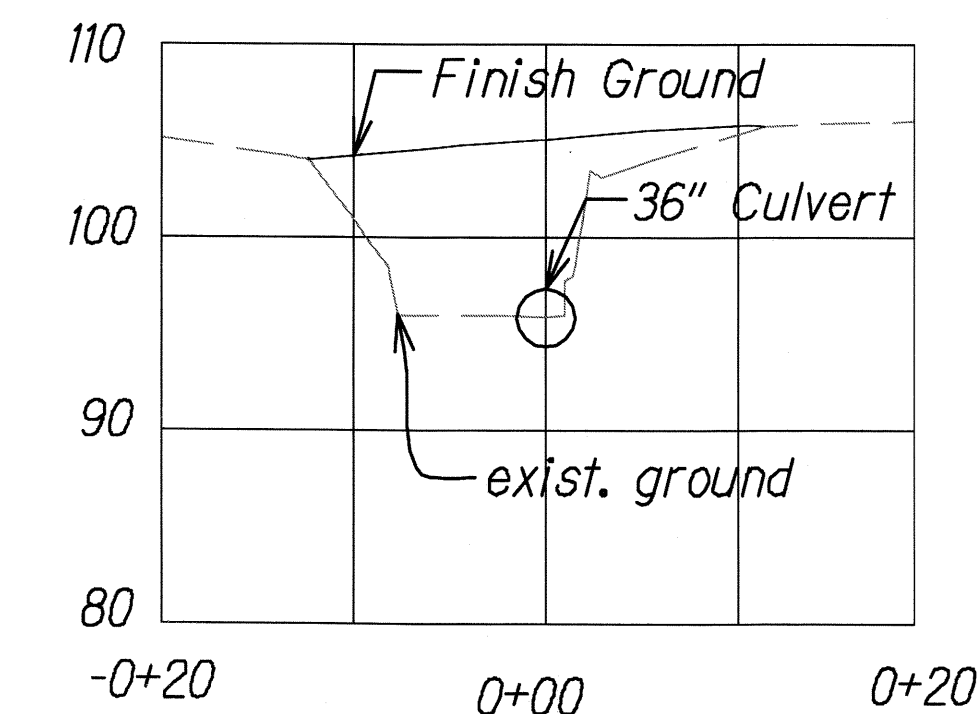


STA. 00+10
Scale: Horiz. 1" = 10'-0"
Vert. 1" = 10'-0"

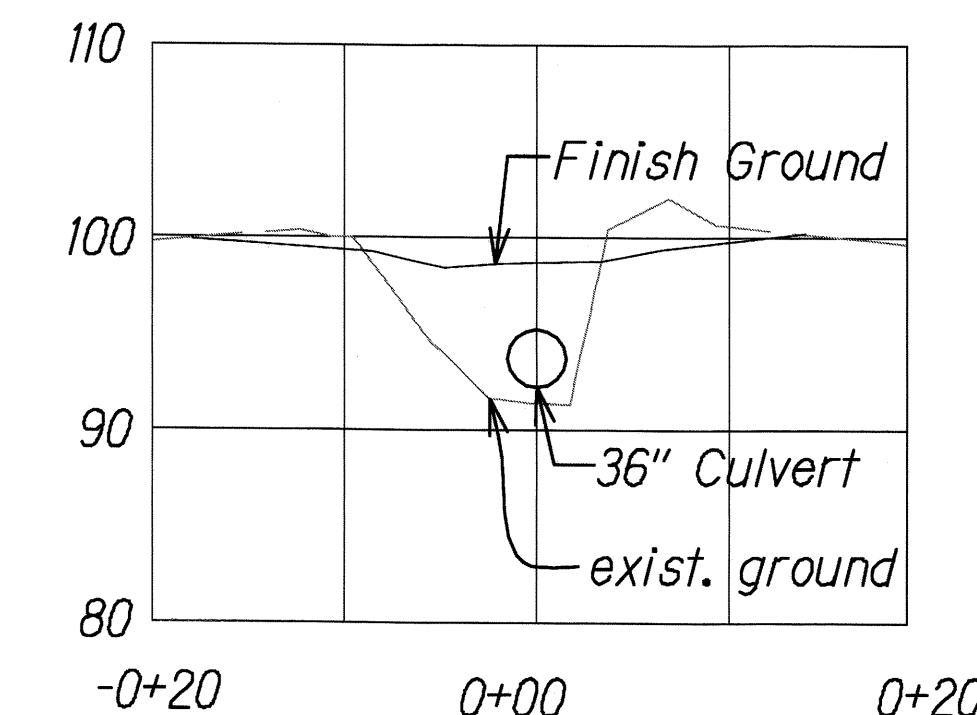

STA. 00+30
Scale: Horiz. 1" = 10'-0"
Vert. 1" = 10'-0"

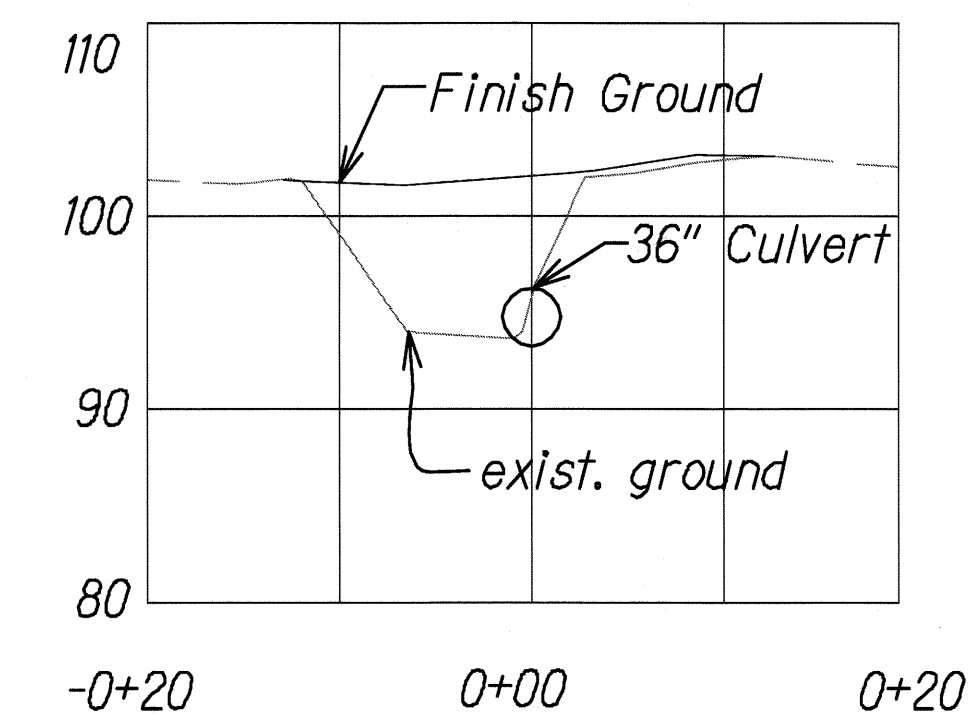

STA. 00+20
Scale: Horiz. 1" = 10'-0"
Vert. 1" = 10'-0"

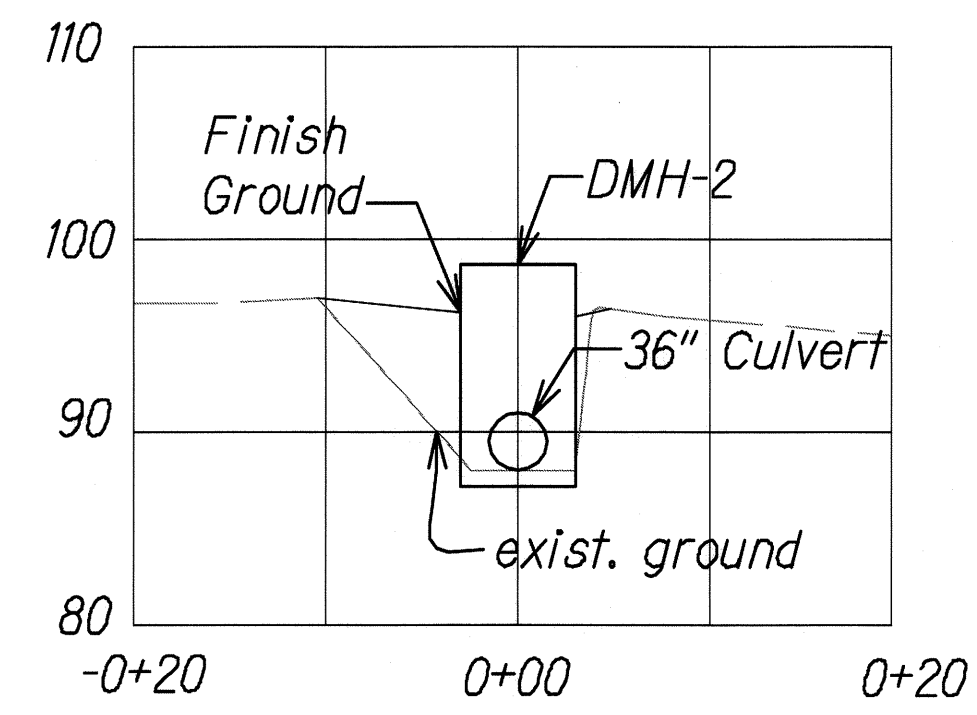

STA. 00+40
Scale: Horiz. 1" = 10'-0"
Vert. 1" = 10'-0"

SITE 14 ESTIMATED QUANTITIES


Cut	8 cubic yards
Fill	144 cubic yards

SURVEY PLOTTED BY	DATE
DESIGNED BY	
TRACED BY	
NOTE BOOK	
QUANTITIES BY	
CHECKED BY	

SITE M-103 OUT-FALL SECTION 2M-HBOX.C22JWG 2/29/2012 7:56:39 AM


NOTES:

- Quantity of excavation shown in the Site 14 Estimated Quantities table may not correspond with the actual quantity of work and is shown for the comparison of bids only. There will be no increase in contract price or contract time if the actual quantity exceeds the estimated quantity shown in the Site 14 Estimated Quantities table up to a maximum of 200 cubic yards.


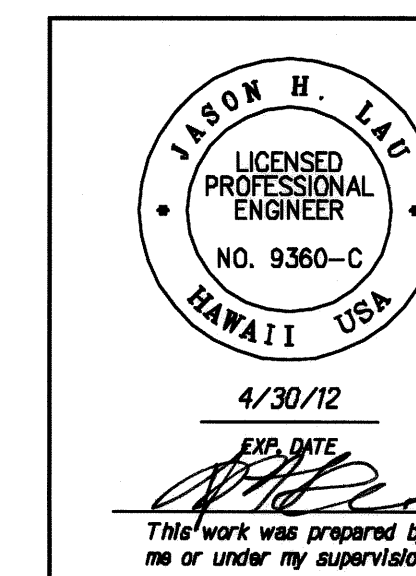


STATE OF HAWAII
DEPARTMENT OF TRANSPORTATION
HIGHWAYS DIVISION
EROSION CONTROL PLAN
SITE 14 SECTIONS
SLOPE IMPROVEMENTS FOR EROSION CONTROL
AT VARIOUS SITES ON OAHU, PHASE 5
Project No. HWY-O-01-12
Scale: As Shown Date: April 2012
SHEET No. EC-22 OF 50 SHEETS


FED. ROAD DIST. NO.	STATE	PROJ. NO.	FISCAL YEAR	SHEET NO.	TOTAL SHEETS
HAWAII	HAW.	HWY-O-01-12	2012	44	123

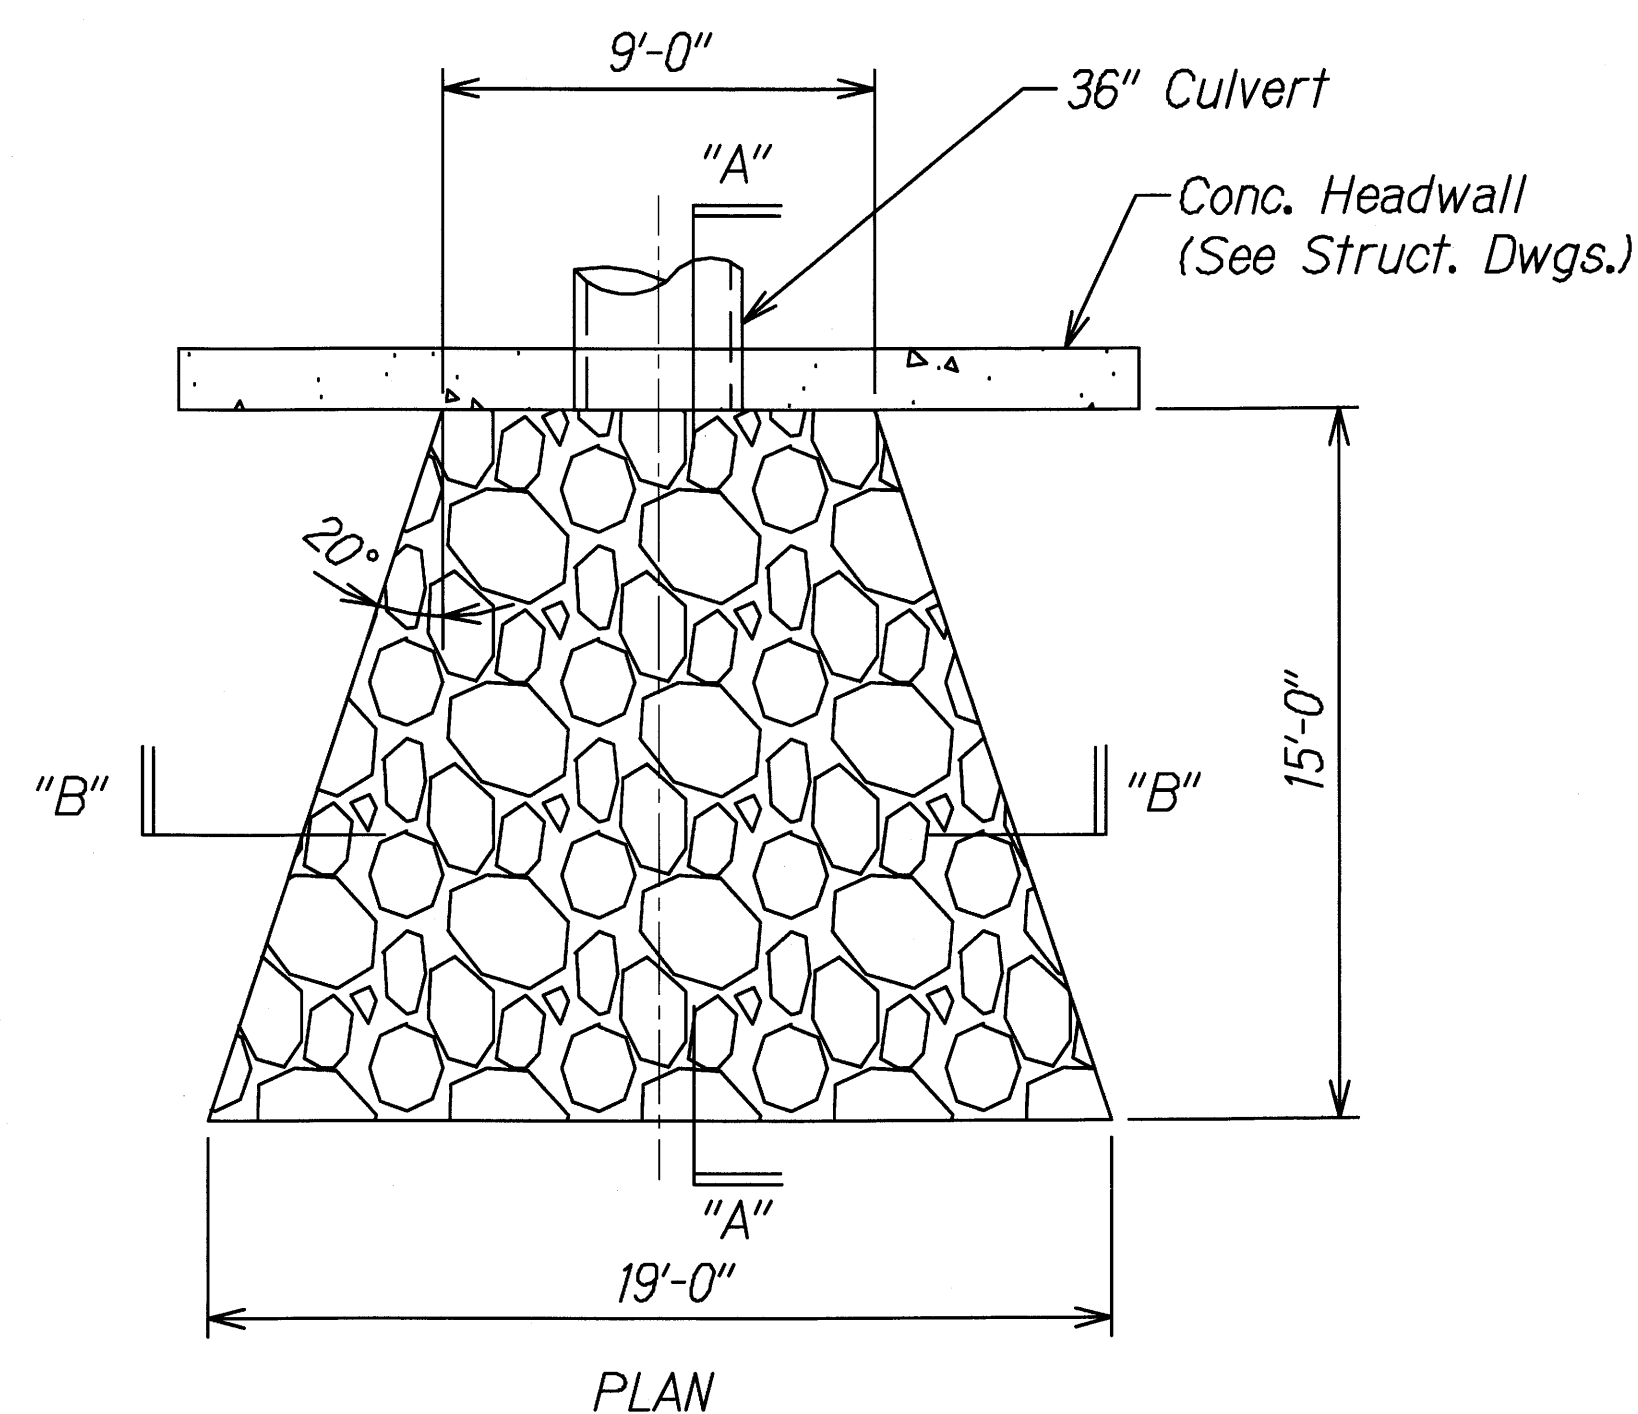

- Notes:**
1. See EC-40 & 41 for reinforced concrete headwall and footing details.
 2. Extend riprap on side slopes at 2:1 slope where applicable

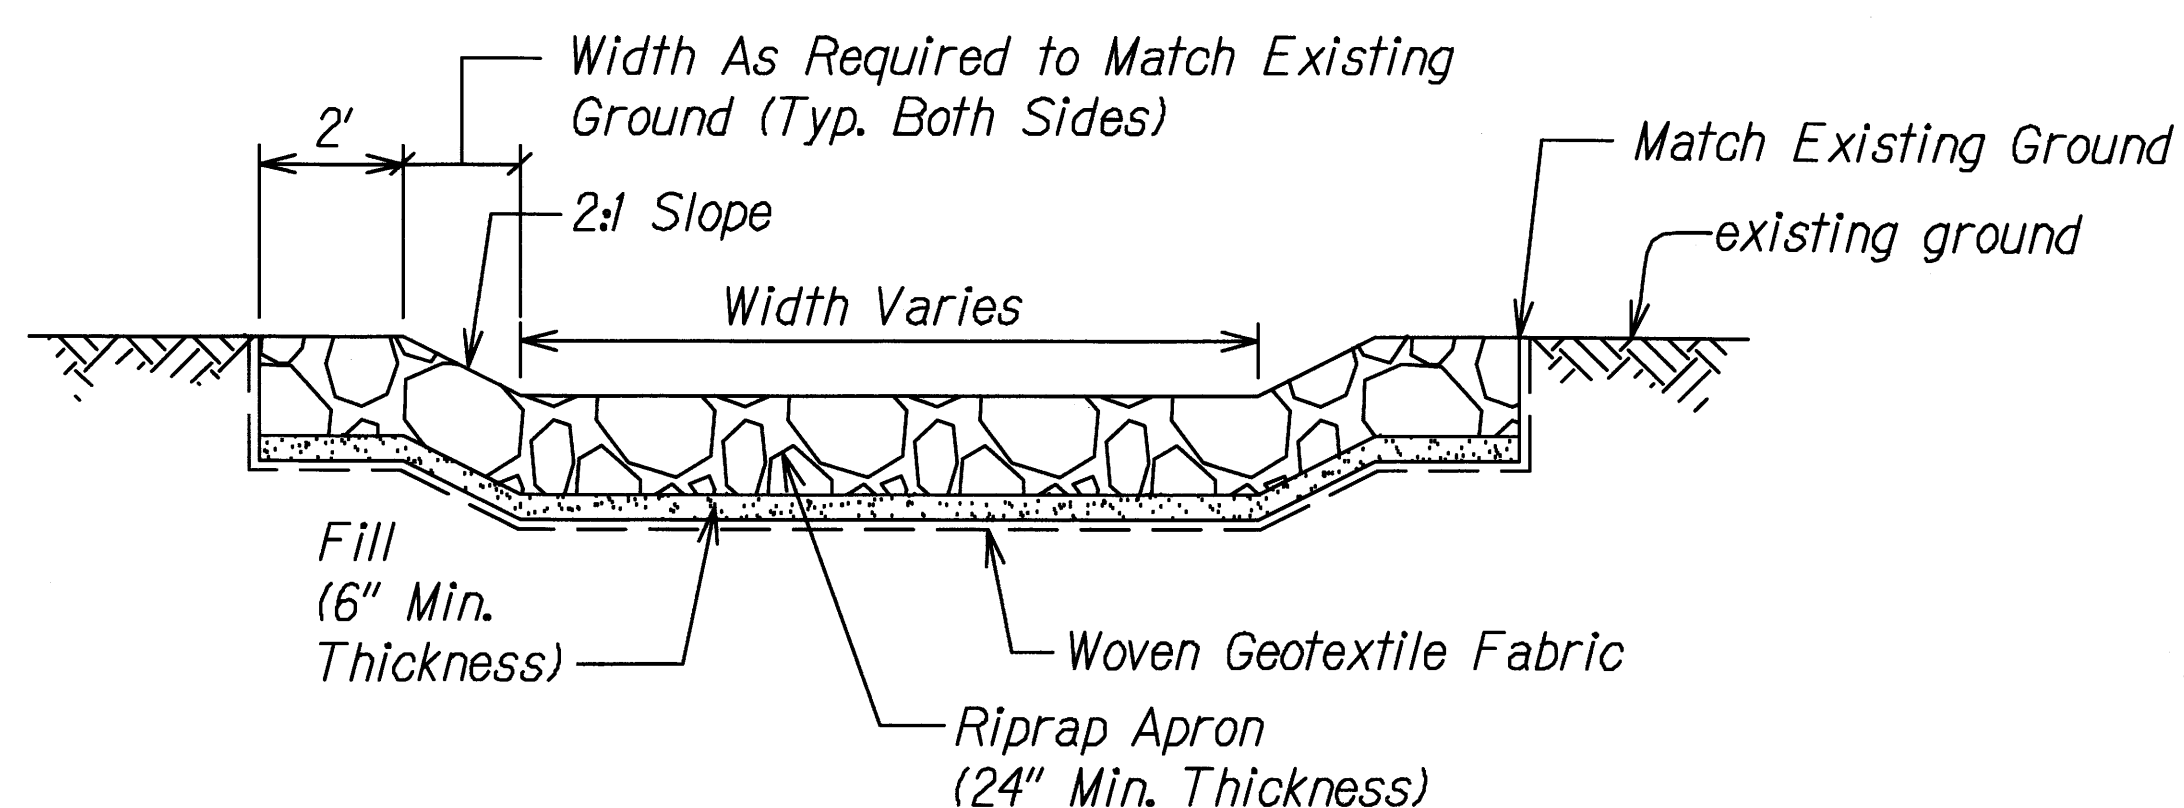
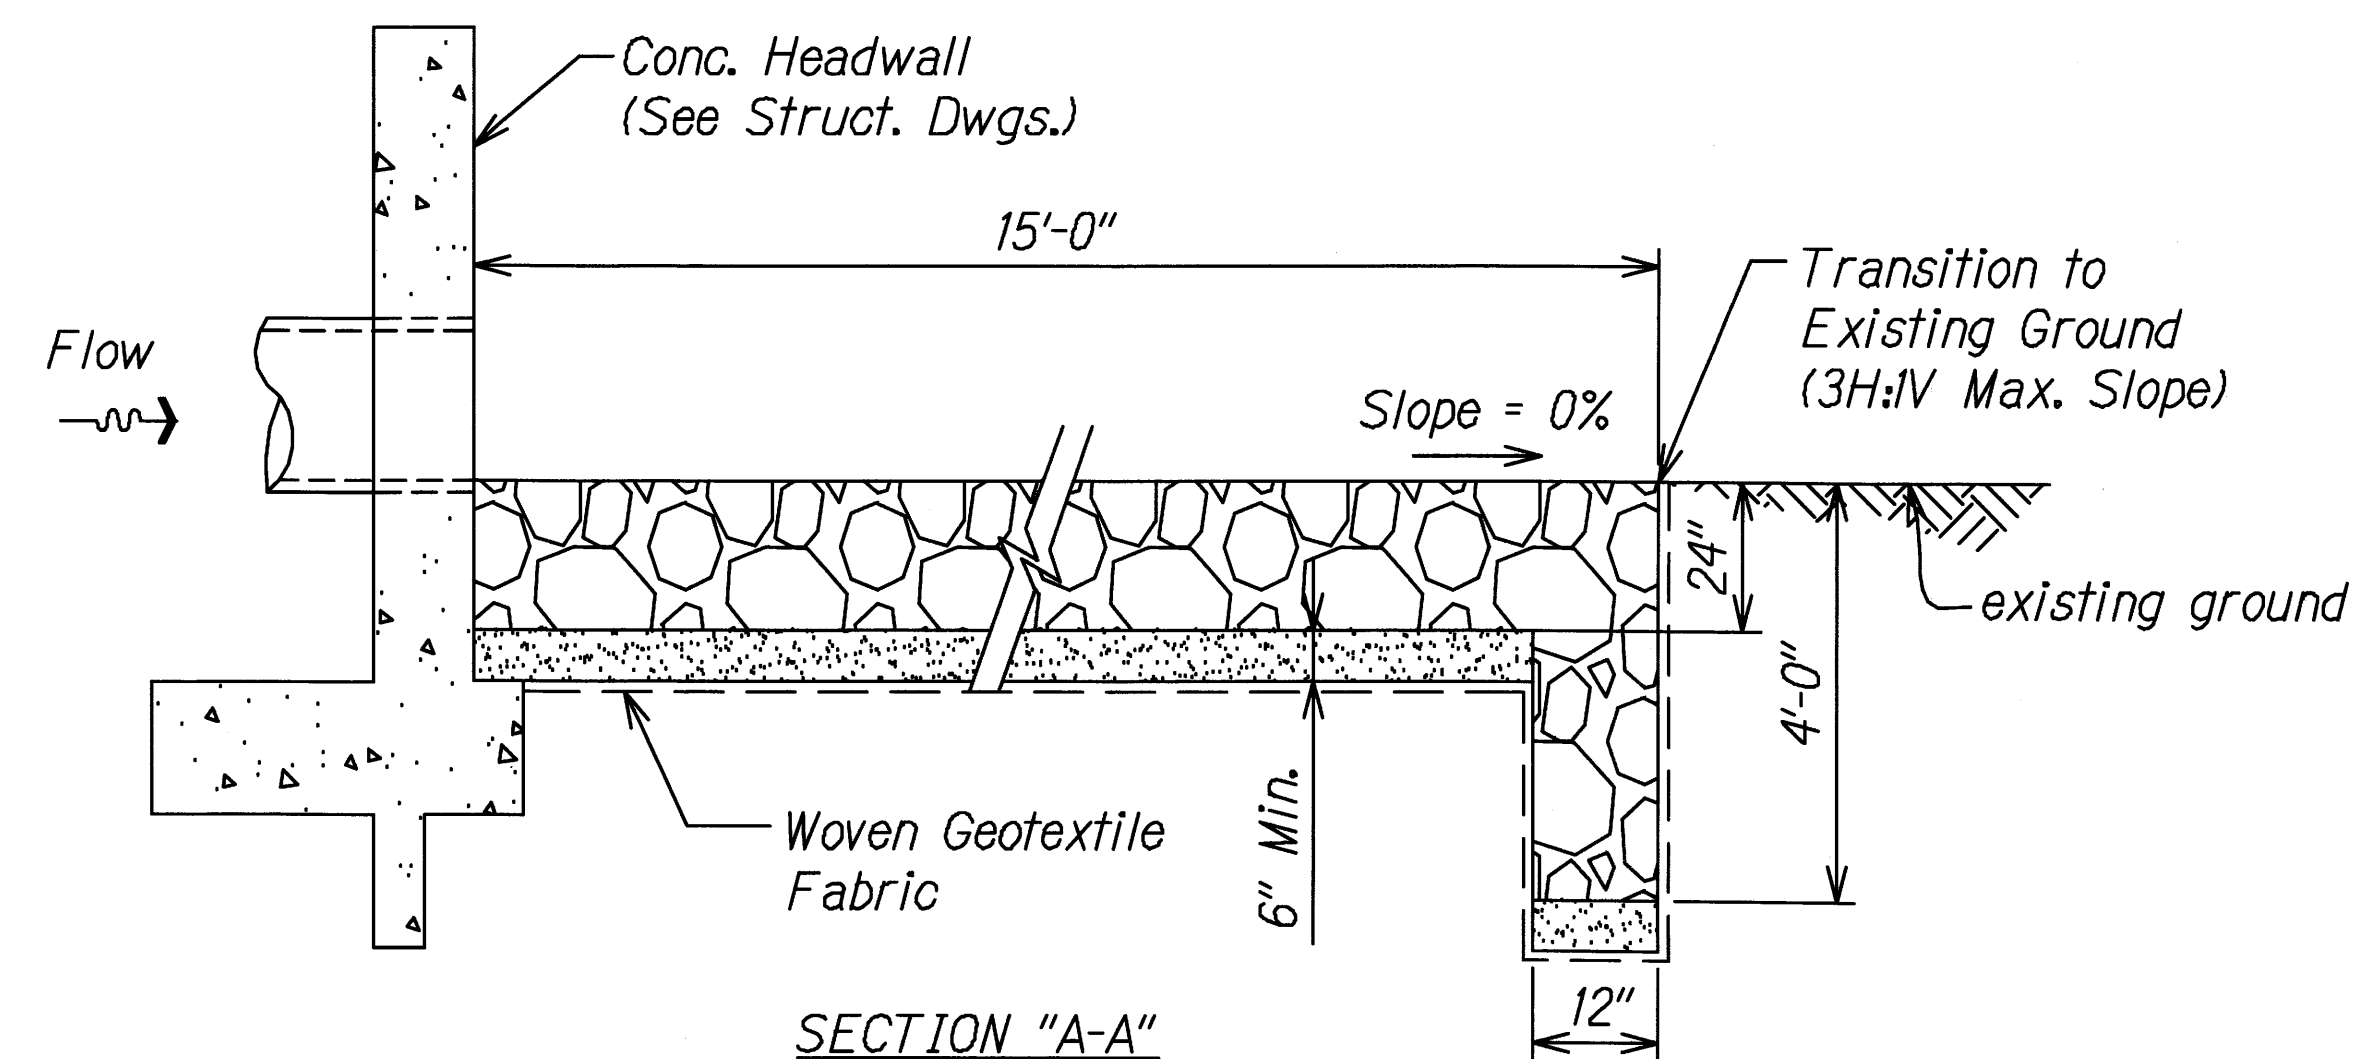


RIPRAP APRON DETAIL
Not to Scale

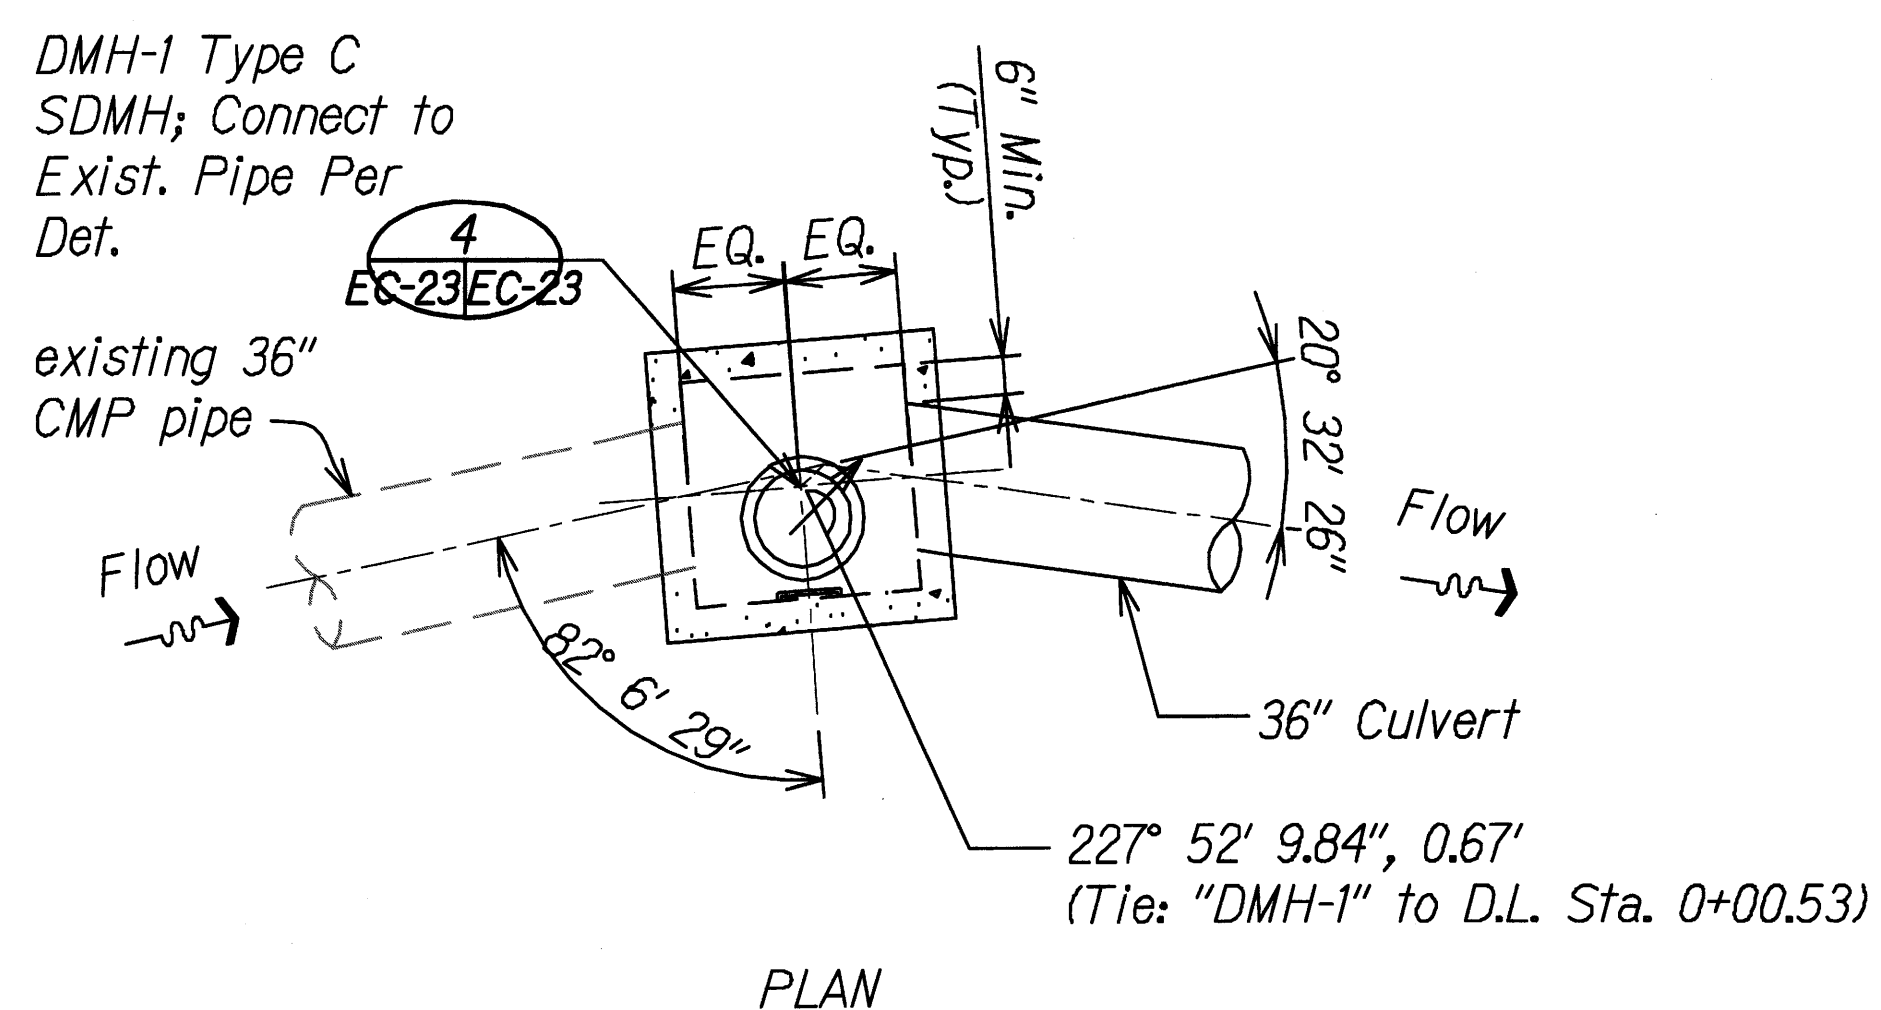


Note: See DOT Std. Plan H-03 for reinforcement and other details not shown.


DMH-1 MANHOLE DETAIL
Scale: 3" = 1'-0"

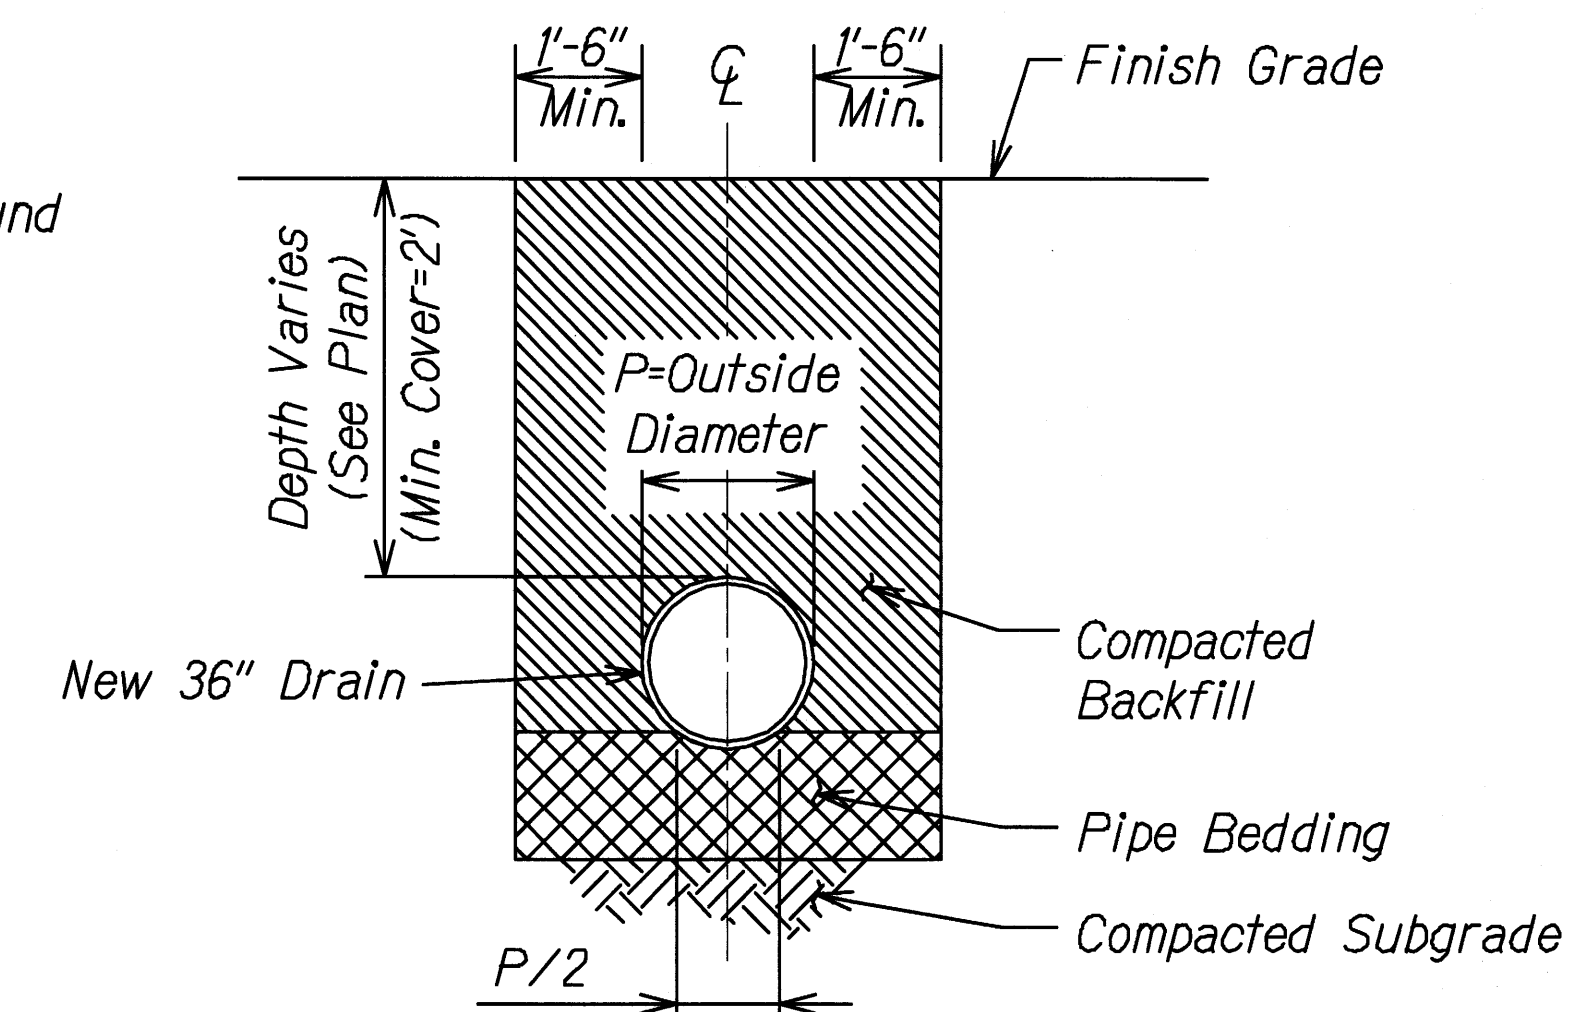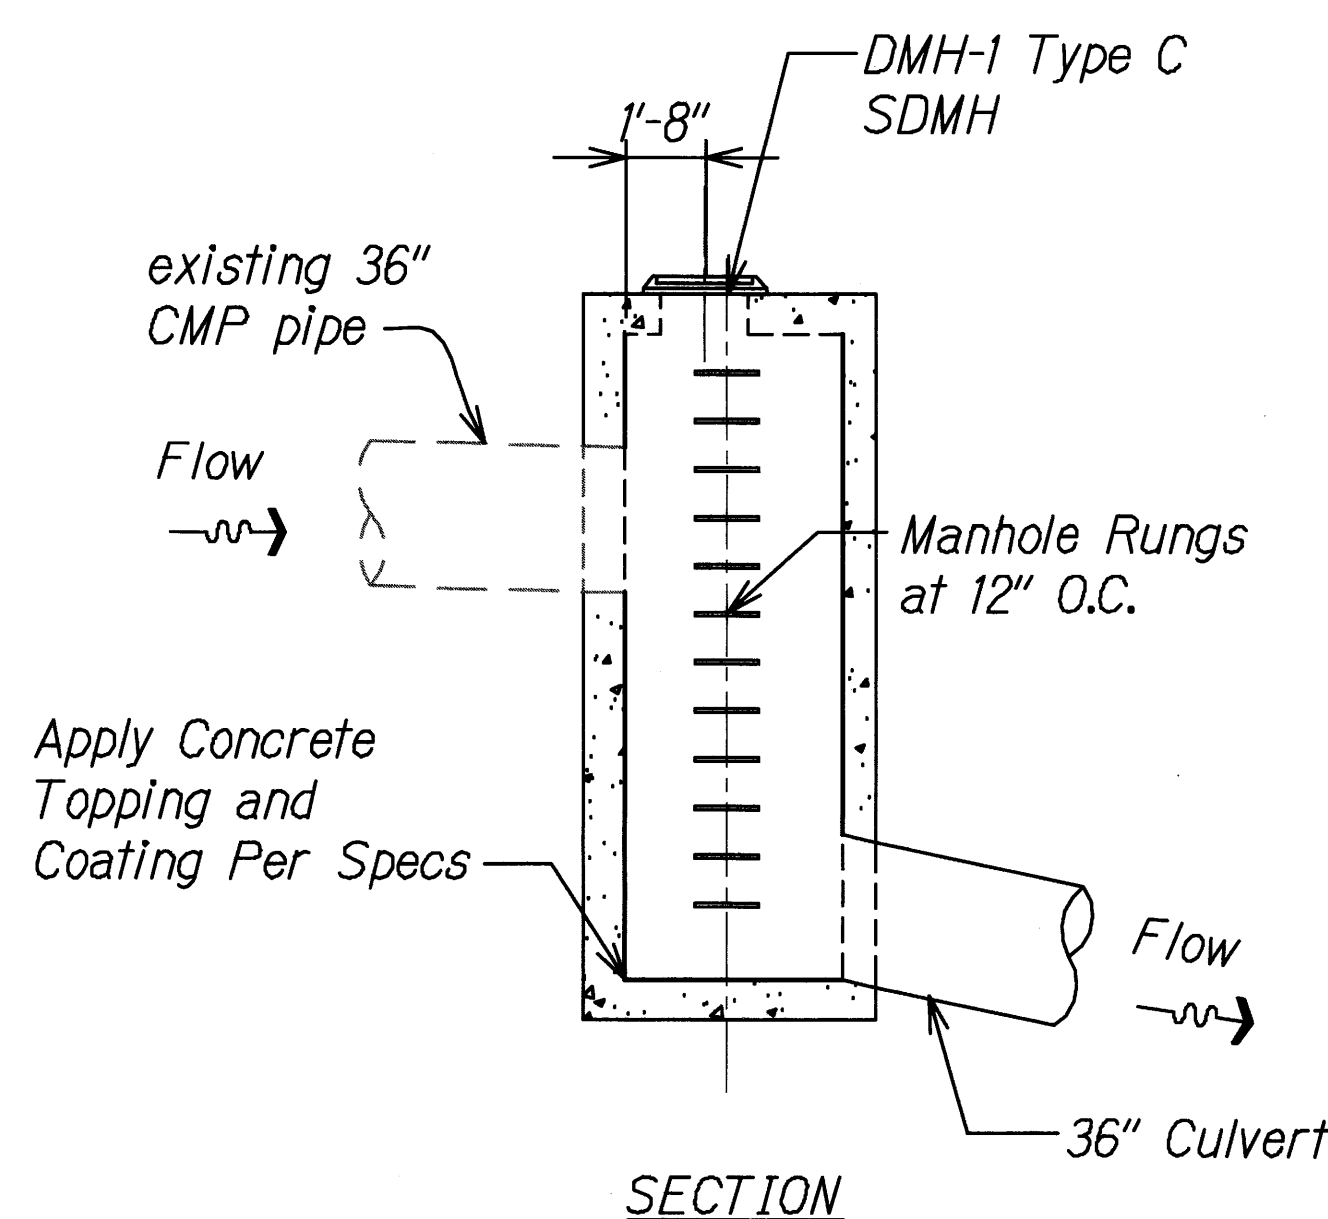

DRAIN TRENCH DETAIL
Not to Scale

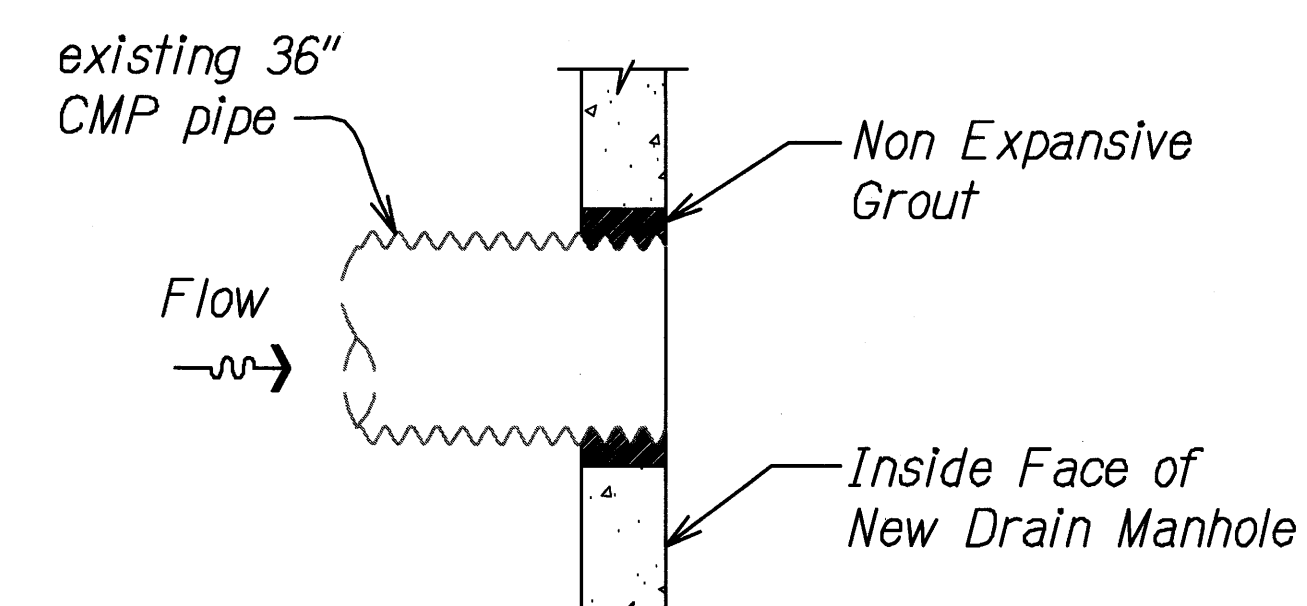

MANHOLE CONNECTION DETAIL
Not to Scale

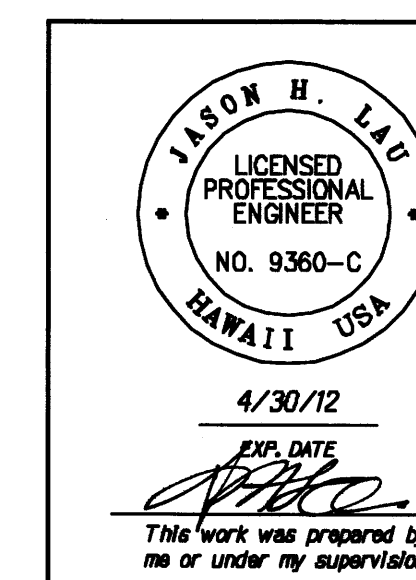

STATE OF HAWAII
DEPARTMENT OF TRANSPORTATION
HIGHWAYS DIVISION


EROSION CONTROL PLAN
SITE 14 DETAILS

SLOPE IMPROVEMENTS FOR EROSION CONTROL
AT VARIOUS SITES ON OAHU, PHASE 5

Project No. HWY-O-01-12
Scale: As Shown Date: April 2012

SHEET No. EC-23 OF 50 SHEETS

FED. ROAD DIST. NO.	STATE	PROJ. NO.	FISCAL YEAR	SHEET NO.	TOTAL SHEETS
HAWAII	HAW.	HWY-O-01-12	2012	45	123

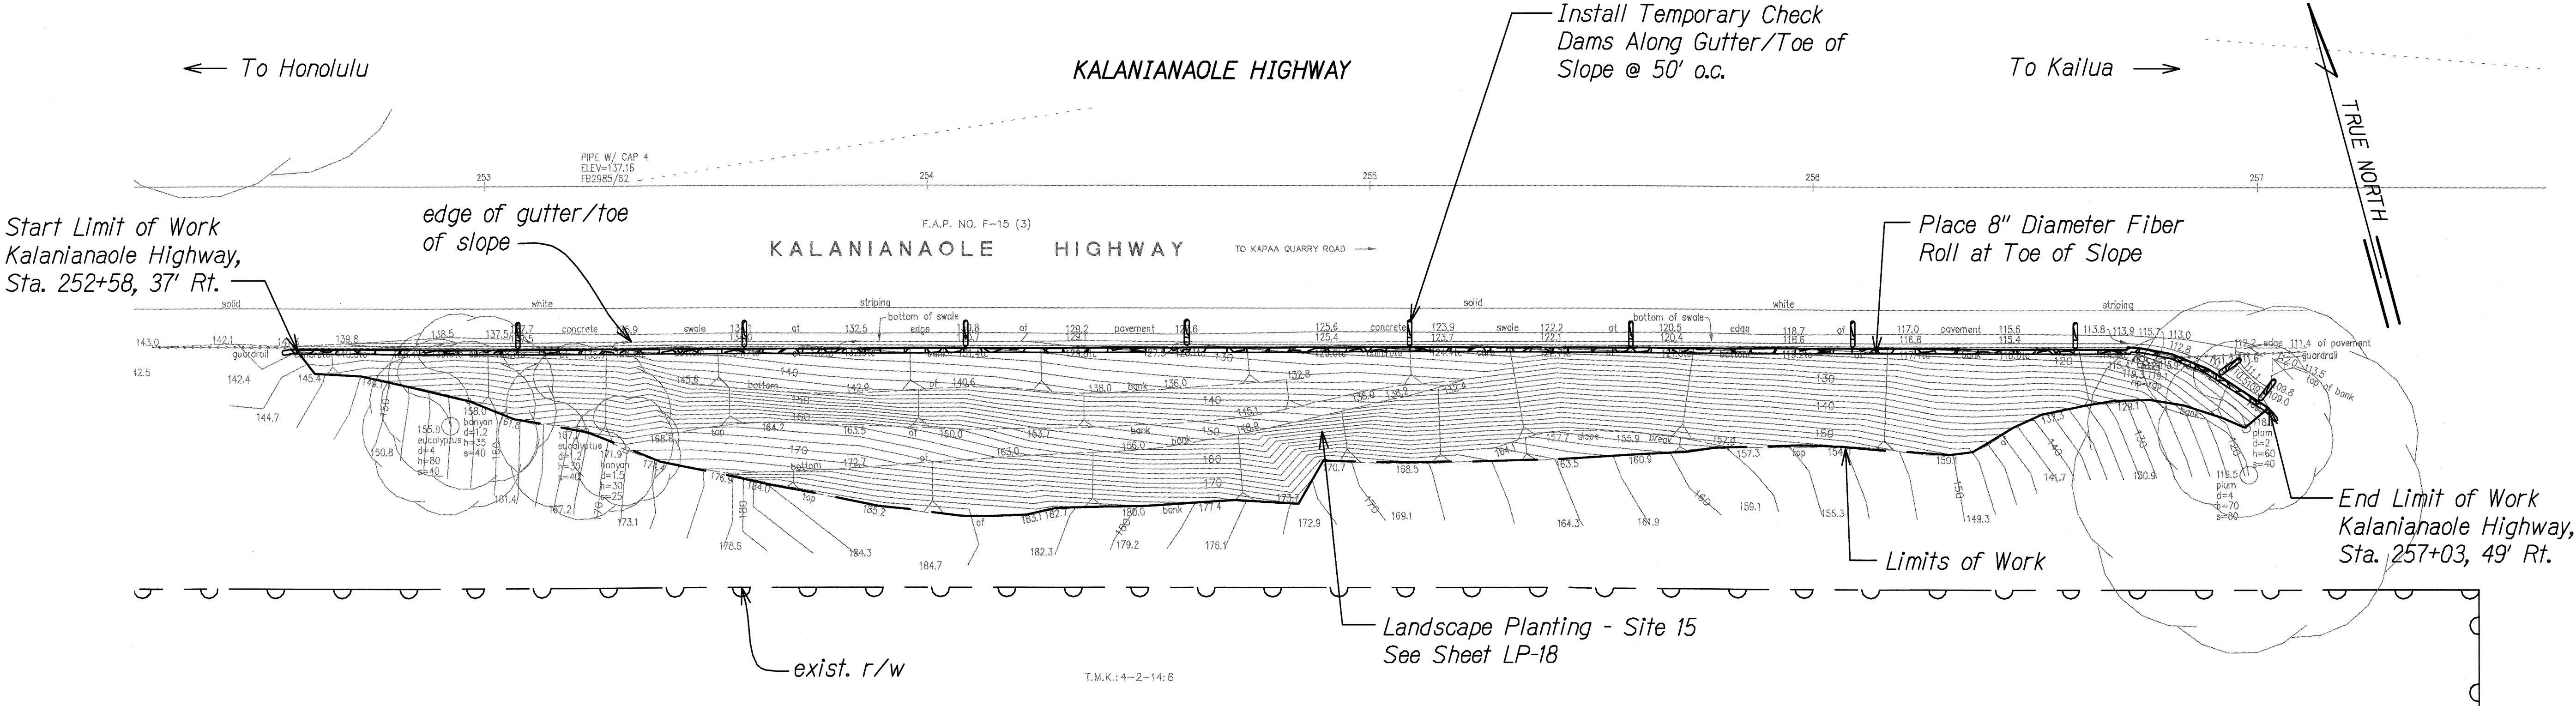

EROSION CONTROL PLAN SITE 15

Scale: 1" = 20'-0"

Estimated Area of Grassing Measured Along Slope Face: 10,600 SF

- Notes:**
1. For anchor layout, see Sheet EC-25.
 2. For erosion mat details, see Sheets EC-42 & 43.
 3. For anchored wire mesh system details, see Sheets EC-44 to EC-47.

SURVEY PLOTTED BY	DATE
DESIGNED BY	
TRACED BY	
NOTE BOOK	
QUANTITIES BY	
CHECKED BY	

ECF-JS/ONG 1/12/2012 12:55:43 PM


4/30/12
DATE
This work was prepared by me or under my supervision.

STATE OF HAWAII
DEPARTMENT OF TRANSPORTATION
HIGHWAYS DIVISION

EROSION CONTROL PLAN
SITE 15
SLOPE IMPROVEMENTS FOR EROSION CONTROL
AT VARIOUS SITES ON OAHU, PHASE 5
Project No. HWY-O-01-12
Scale: 1" = 20' Date: April 2012

SHEET No. EC-24 OF 50 SHEETS


FED. ROAD DIST. NO.	STATE	PROJ. NO.	FISCAL YEAR	SHEET NO.	TOTAL SHEETS
HAWAII	HAW.	HWY-O-01-12	2012	46	123

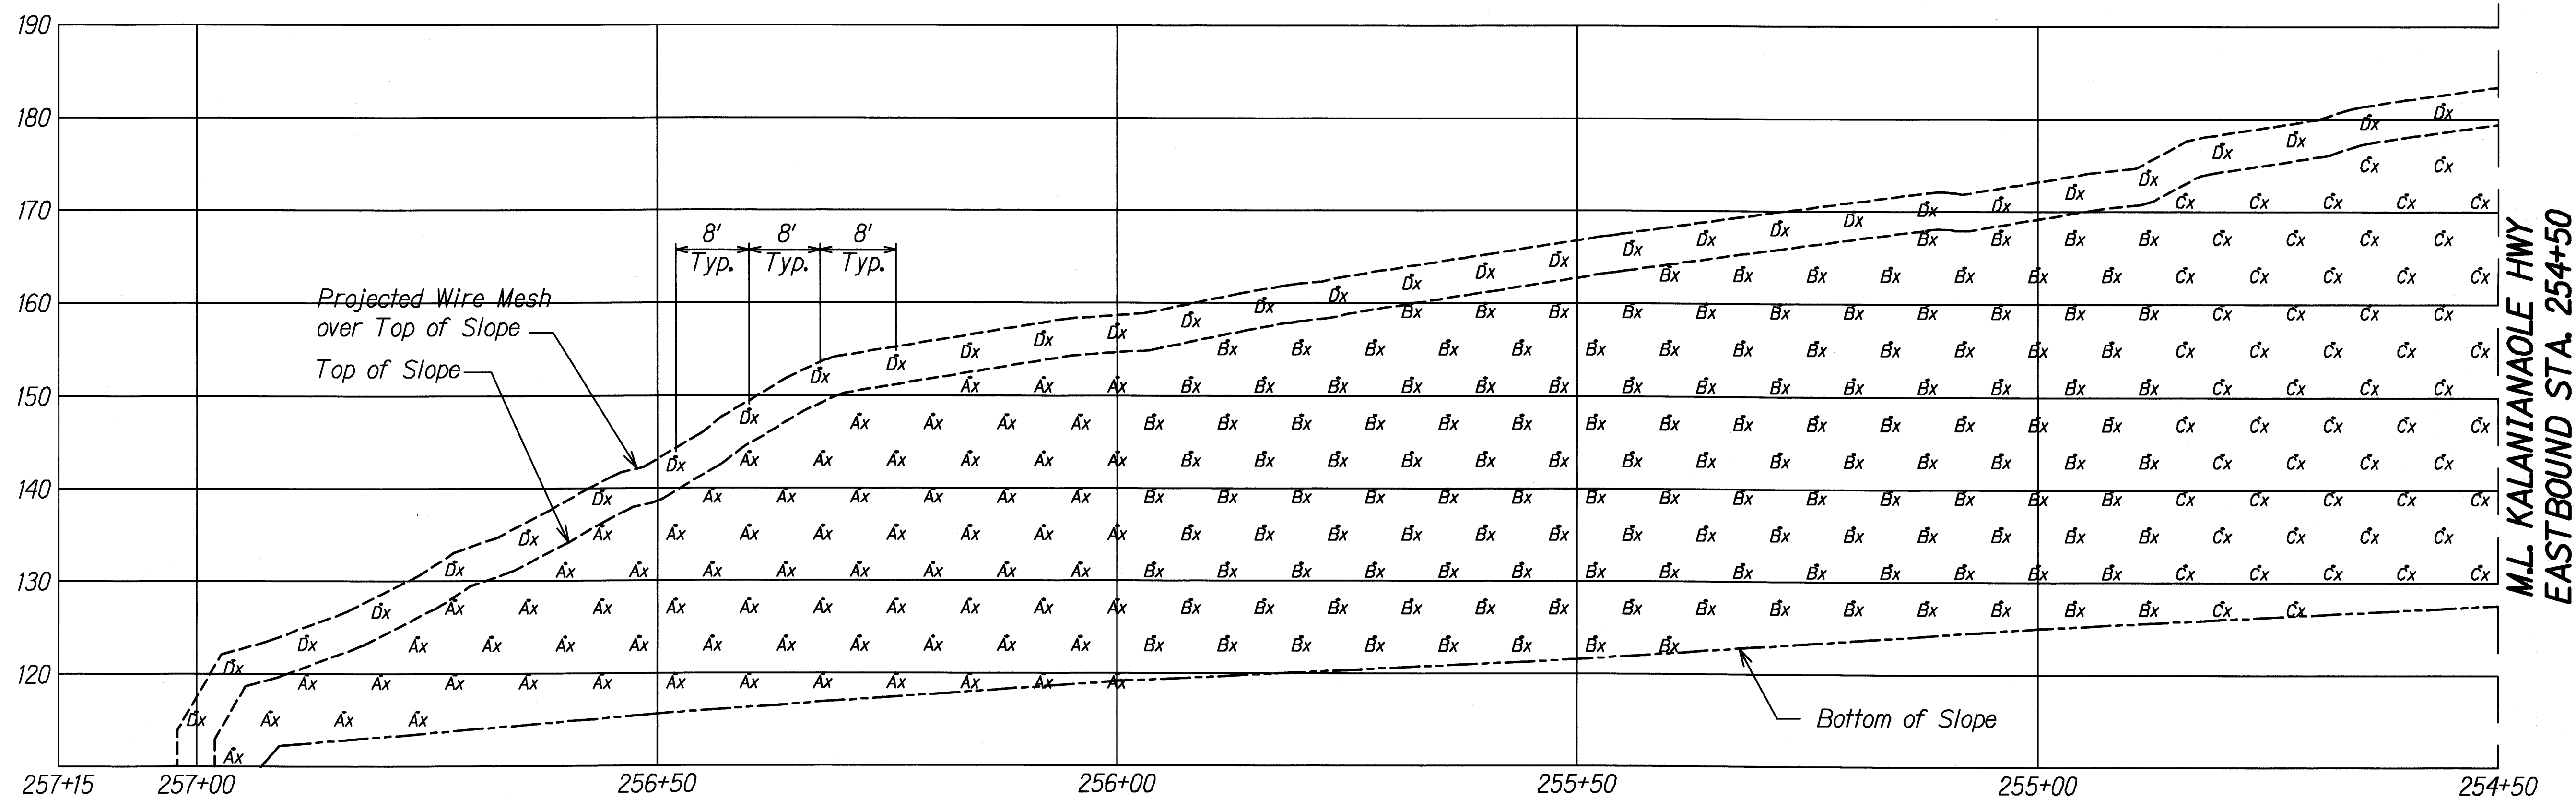

LEGEND

- Ax Type A Anchor*
- Bx Type B Anchor*
- Cx Type C Anchor*
- Dx Type D Anchor*

* See Soil and/or Rock Anchor Schedule on Sheet N-3

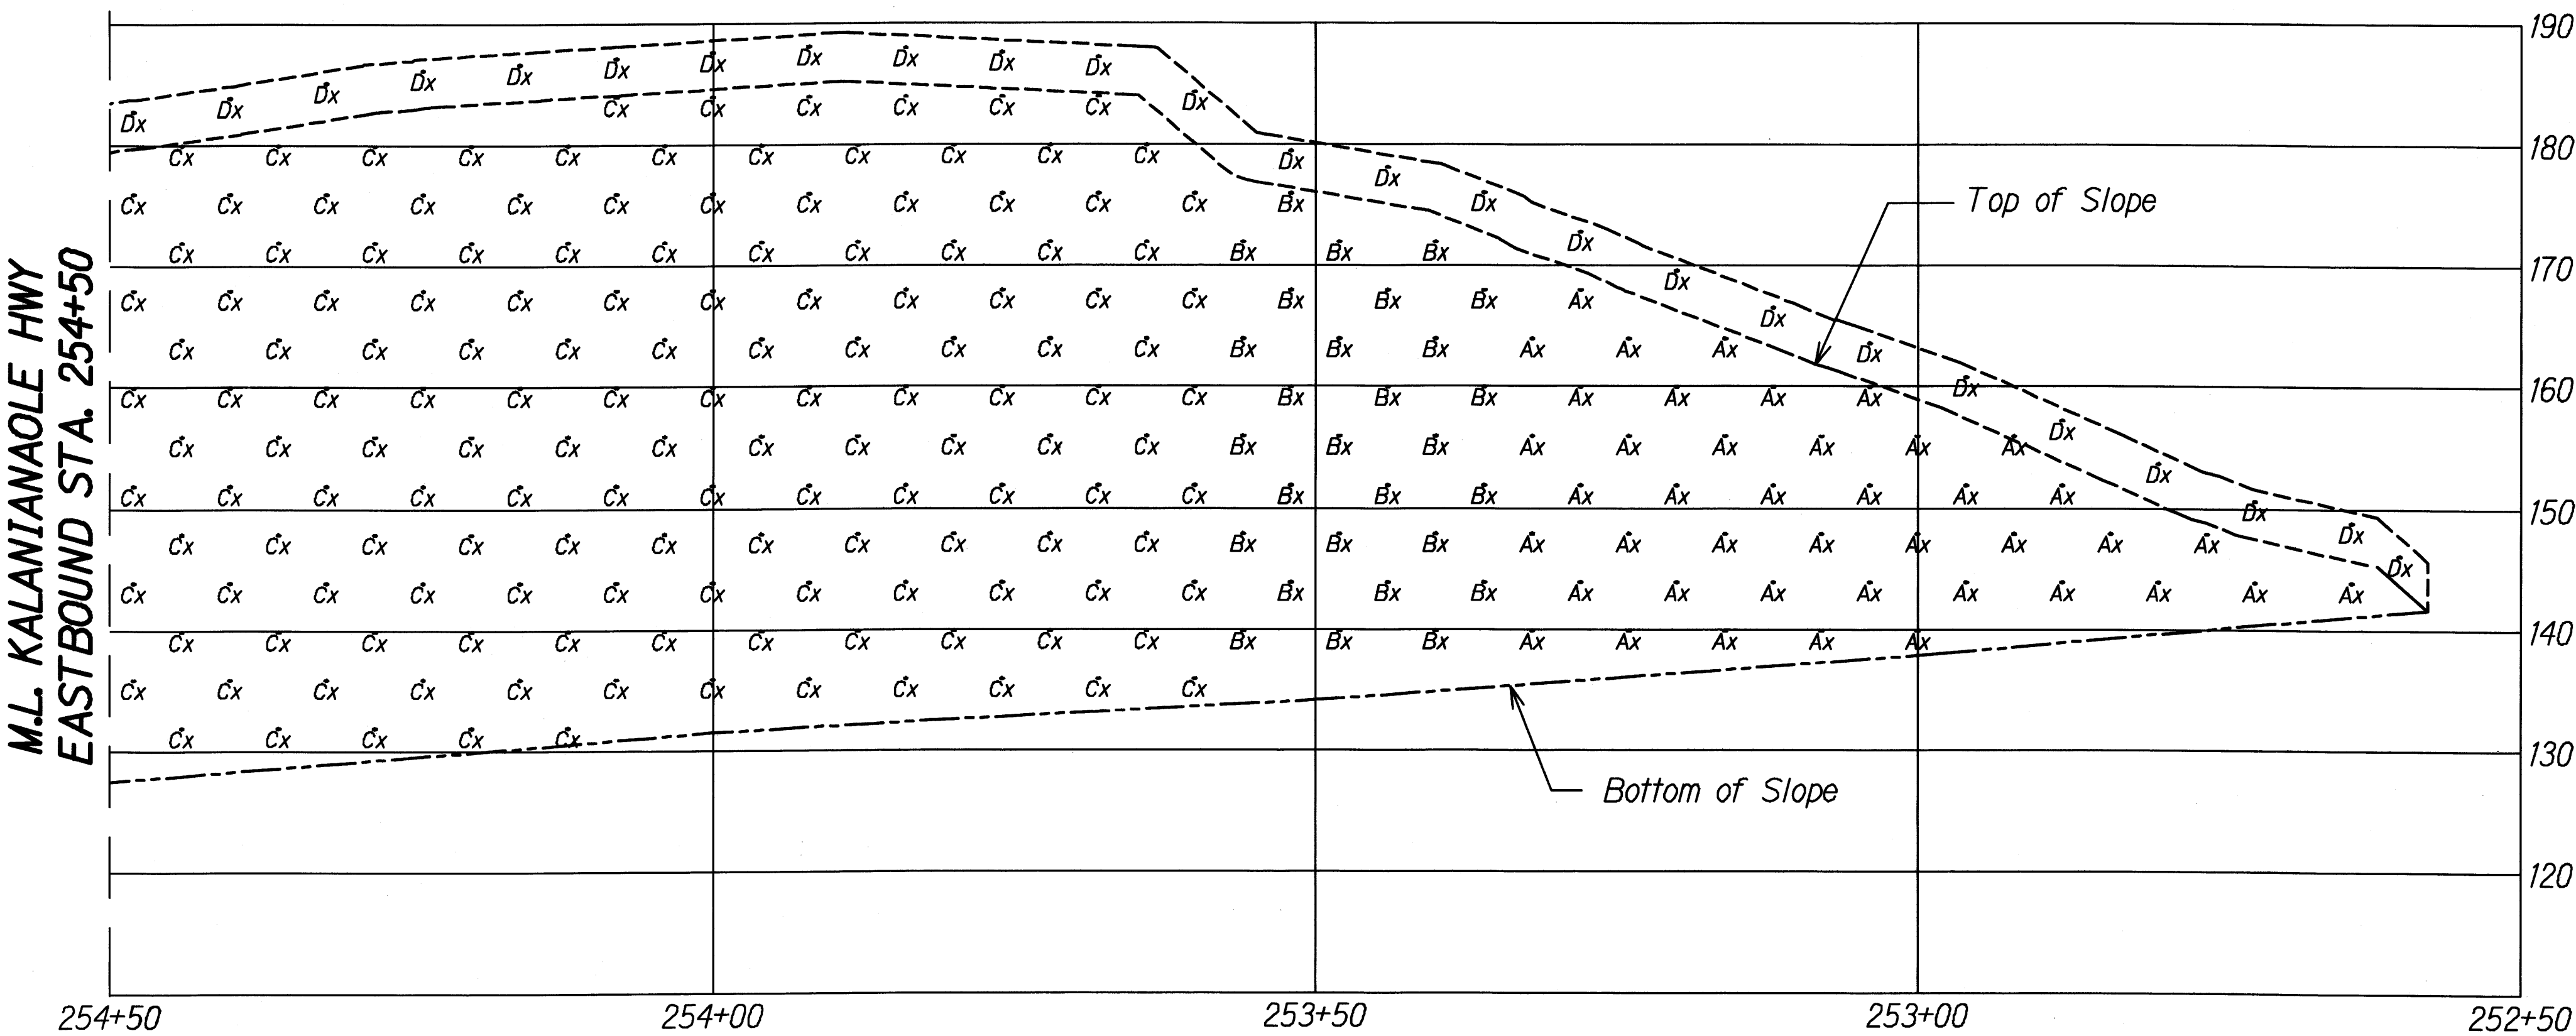

DATE	4/30/12
SURVEY PLOTTED BY	DATE
DESIGNED BY	DATE
NOTED BY	DATE
CHECKED BY	DATE

EC-25 SITE IS ANCHOR LAYOUT.BIT.DWG 2/24/2012 12:36:59 PM

4/30/12
DATE
This work was prepared by me or under my supervision.









STATE OF HAWAII
DEPARTMENT OF TRANSPORTATION
HIGHWAYS DIVISION

EROSION CONTROL PLAN
SITE 15 ANCHOR LAYOUT

SLOPE IMPROVEMENTS FOR EROSION CONTROL
AT VARIOUS SITES ON OAHU, PHASE 5

Project No. HWY-O-01-12
Scale: 1" = 10' Date: April 2012

FED. ROAD DIST. NO.	STATE	PROJ. NO.	FISCAL YEAR	SHEET NO.	TOTAL SHEETS
HAWAII	HAW.	HWY-O-01-12	2012	47	123

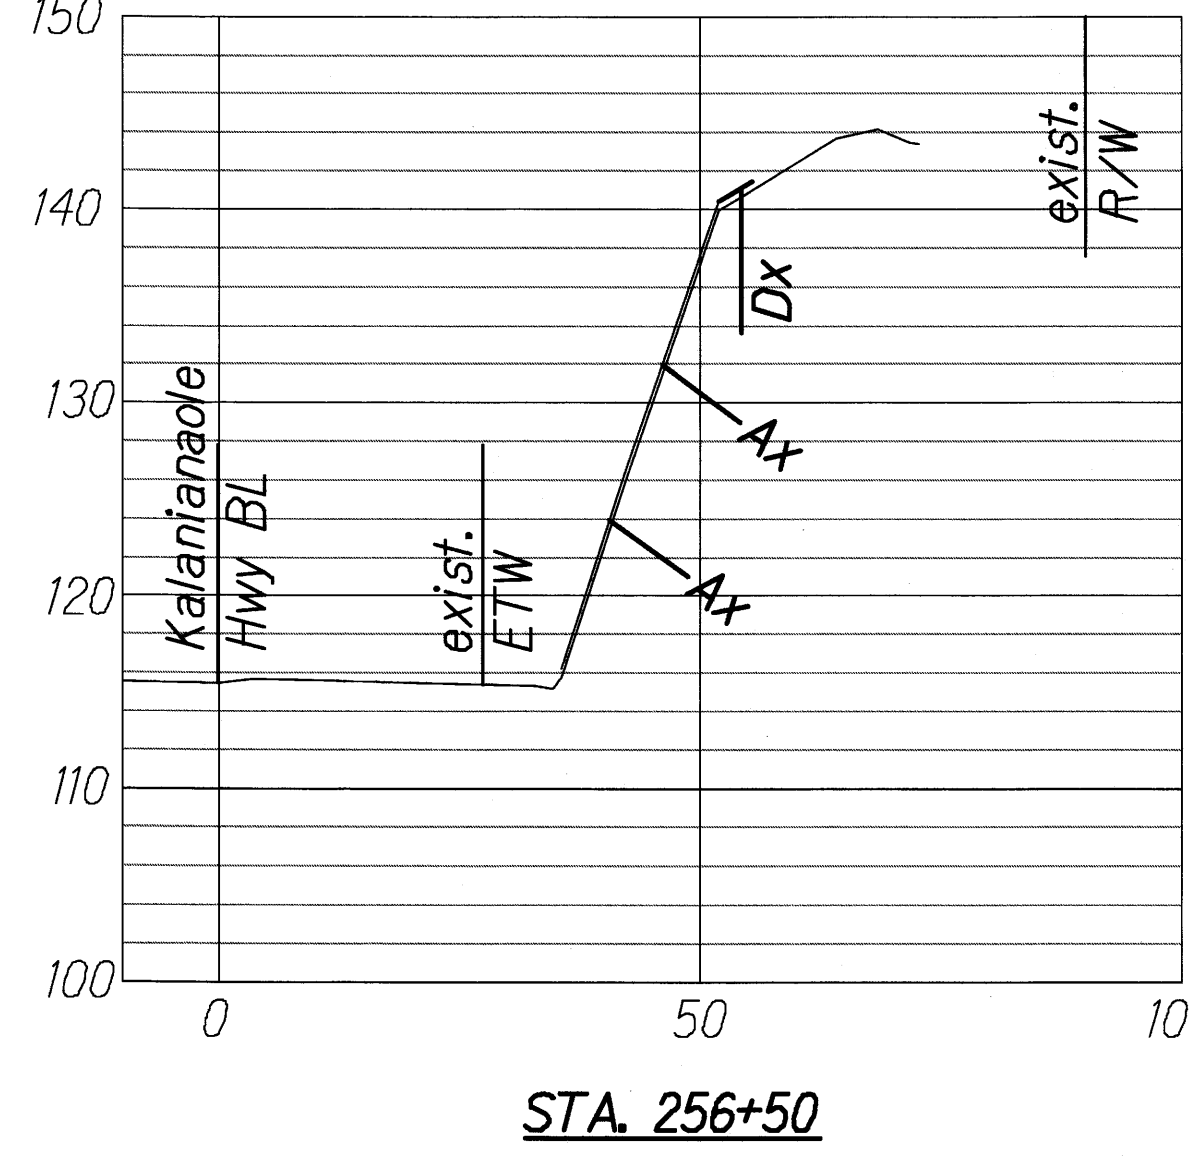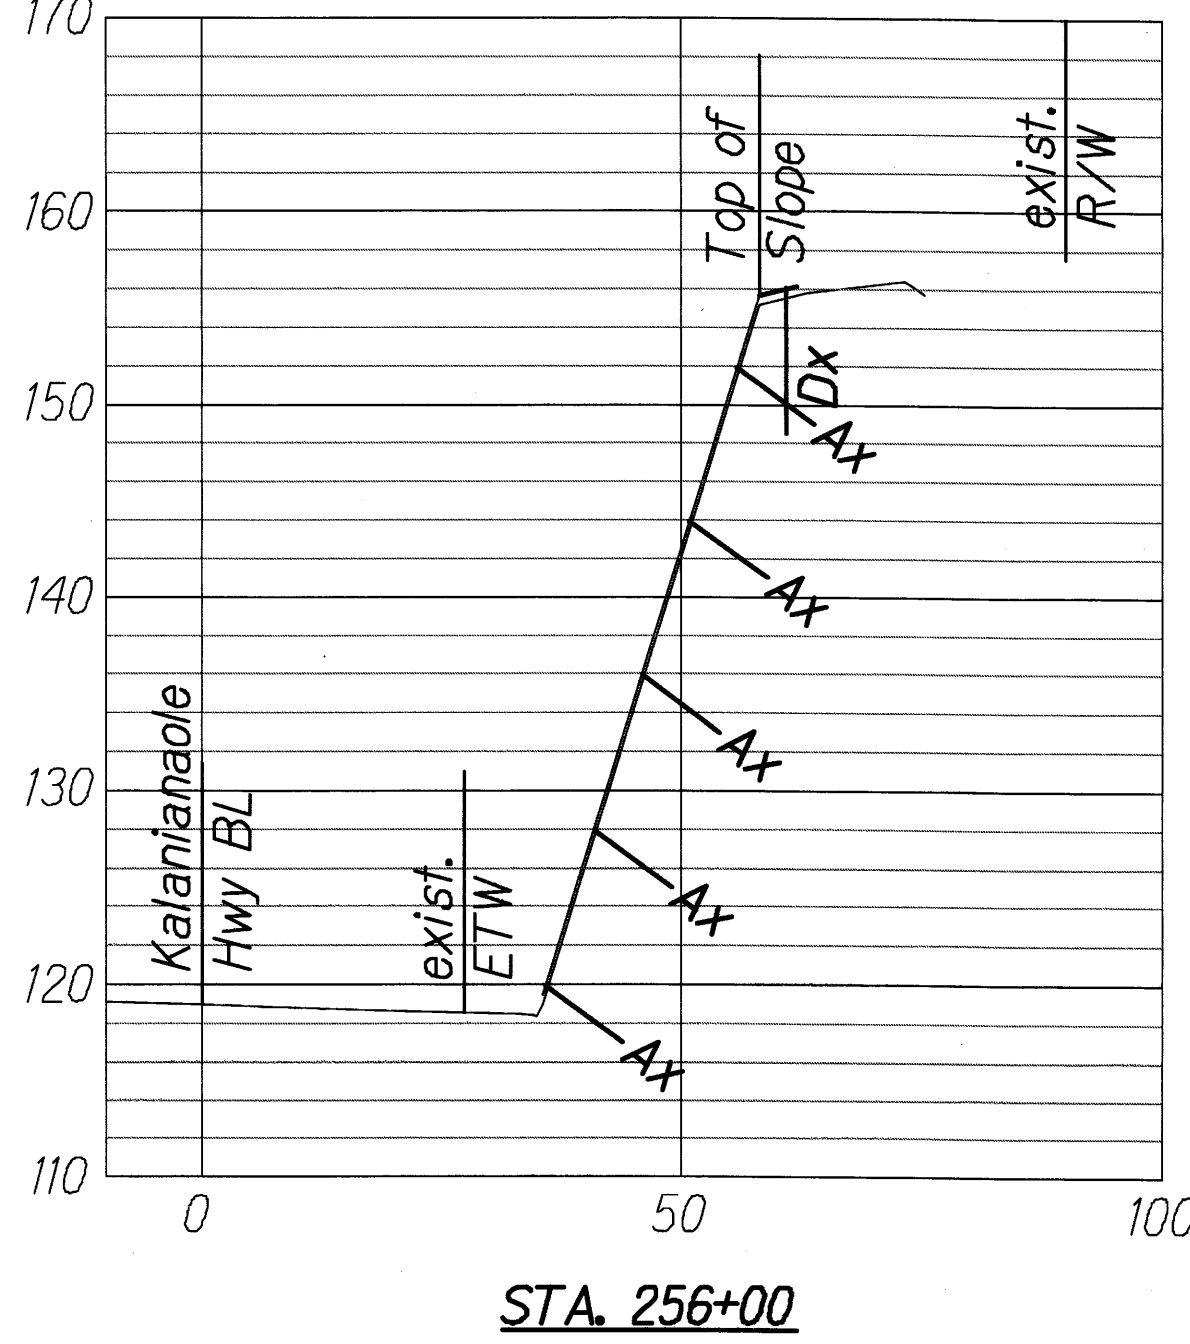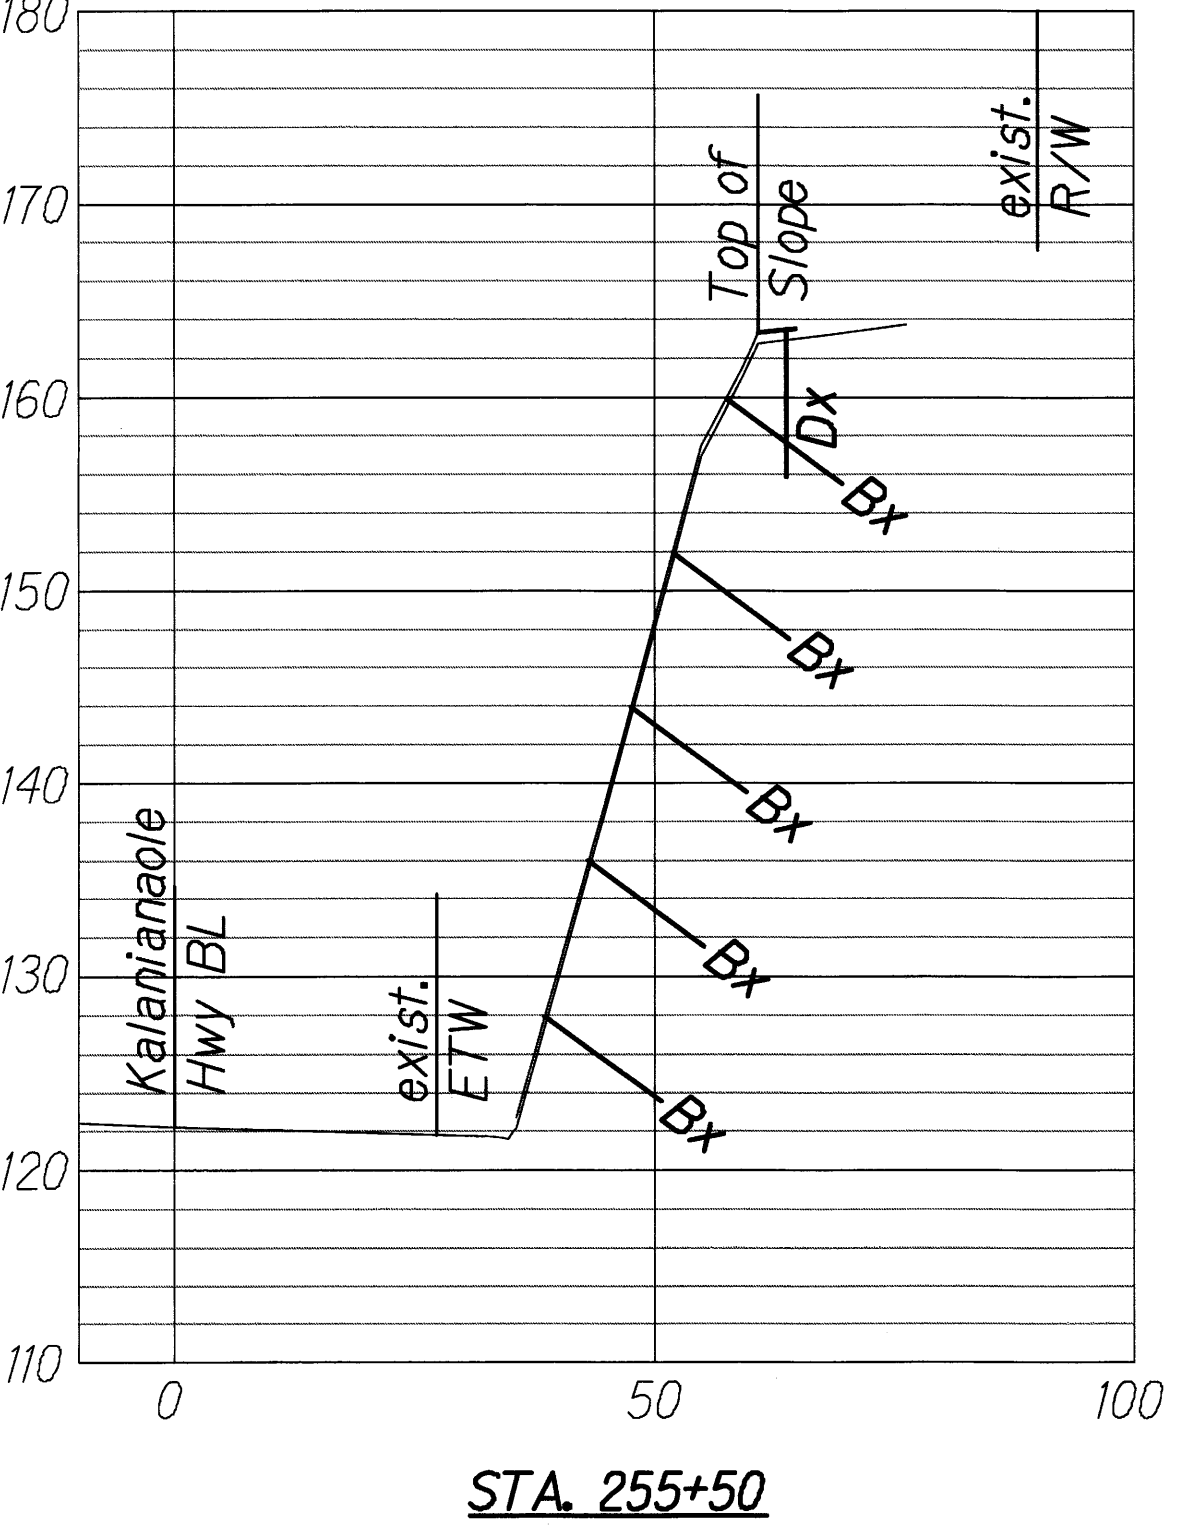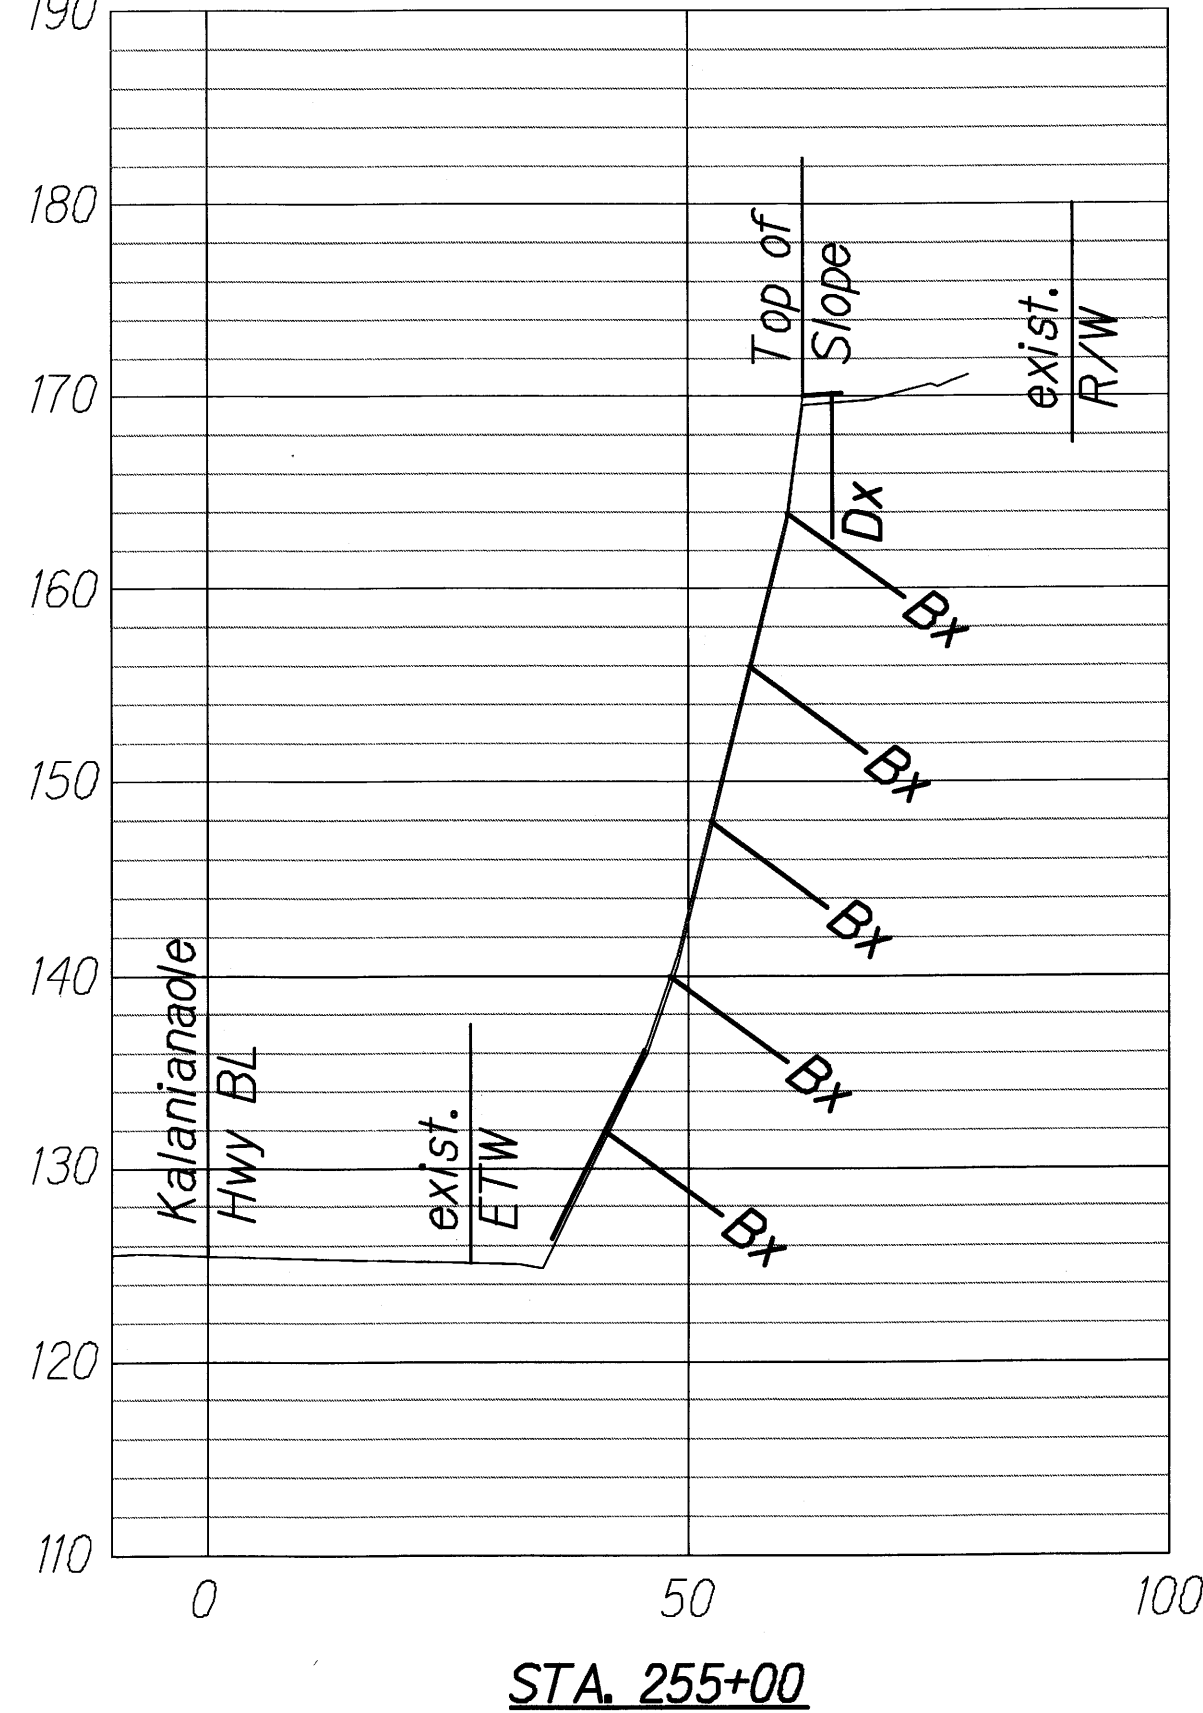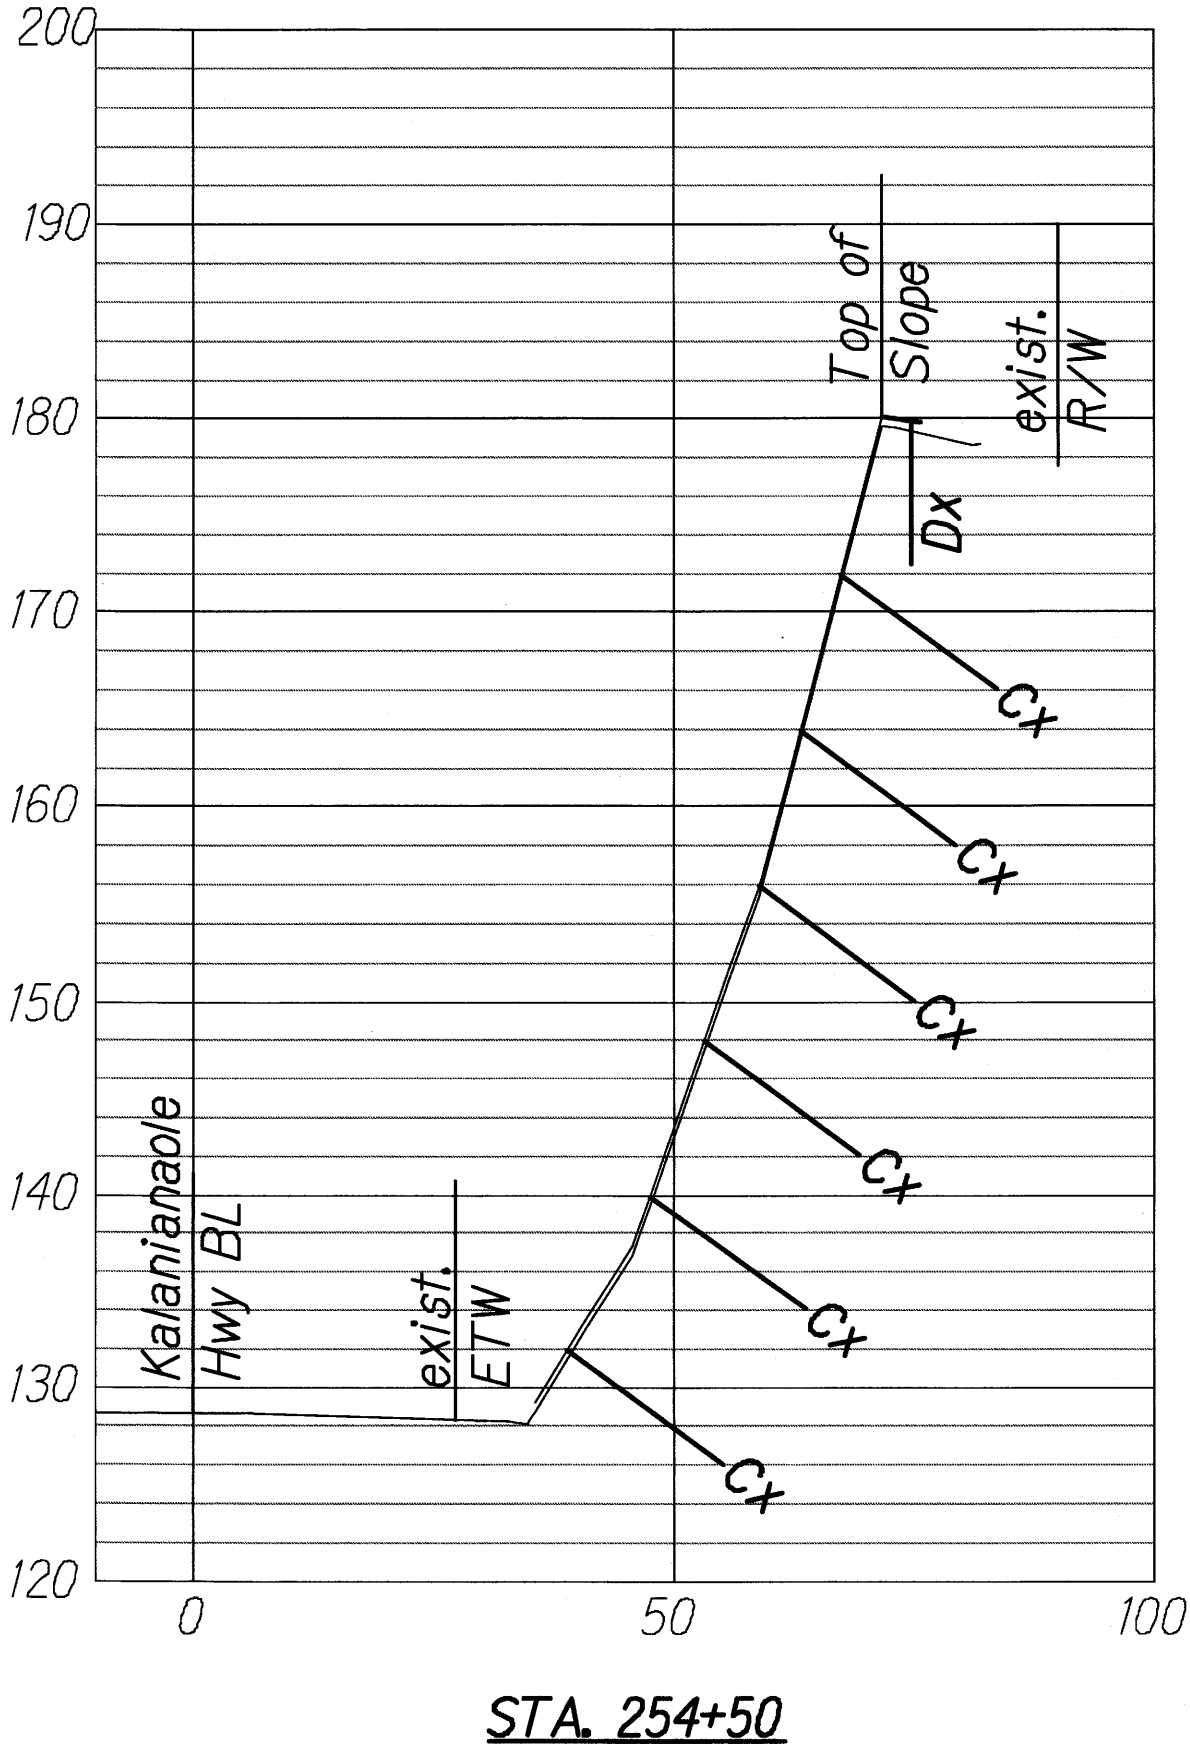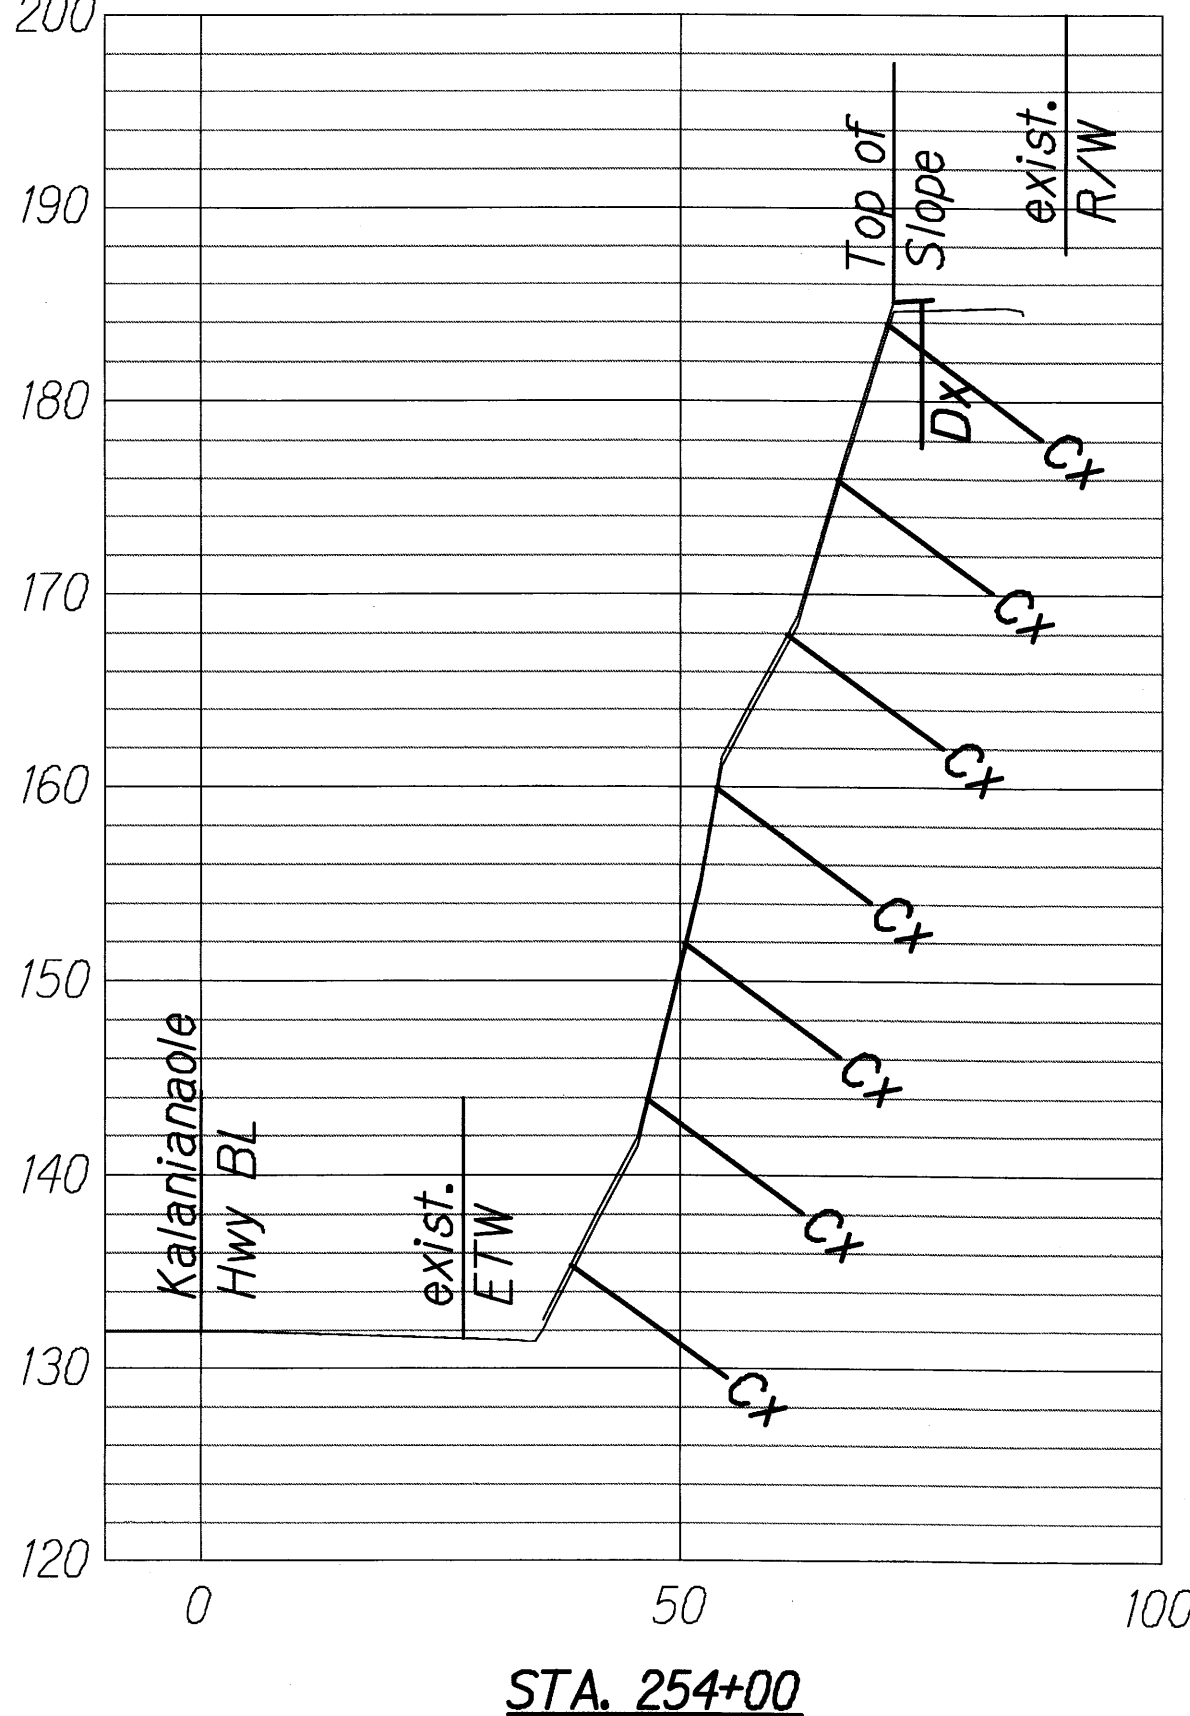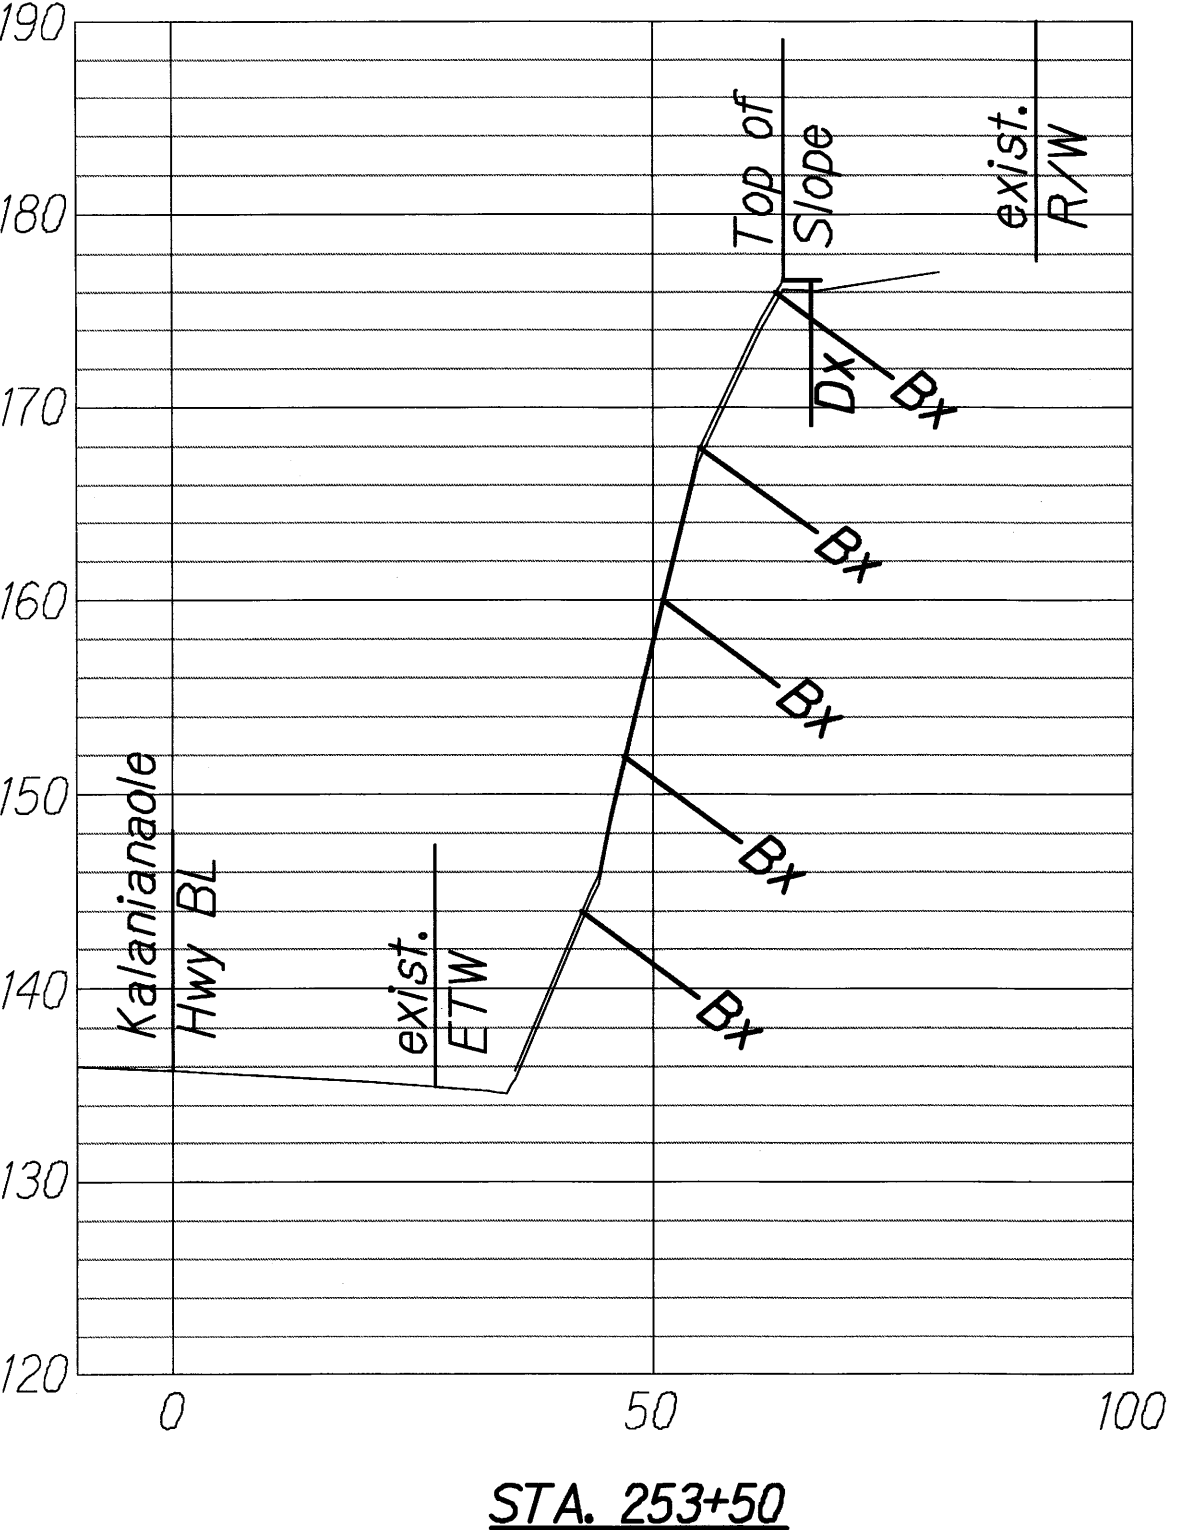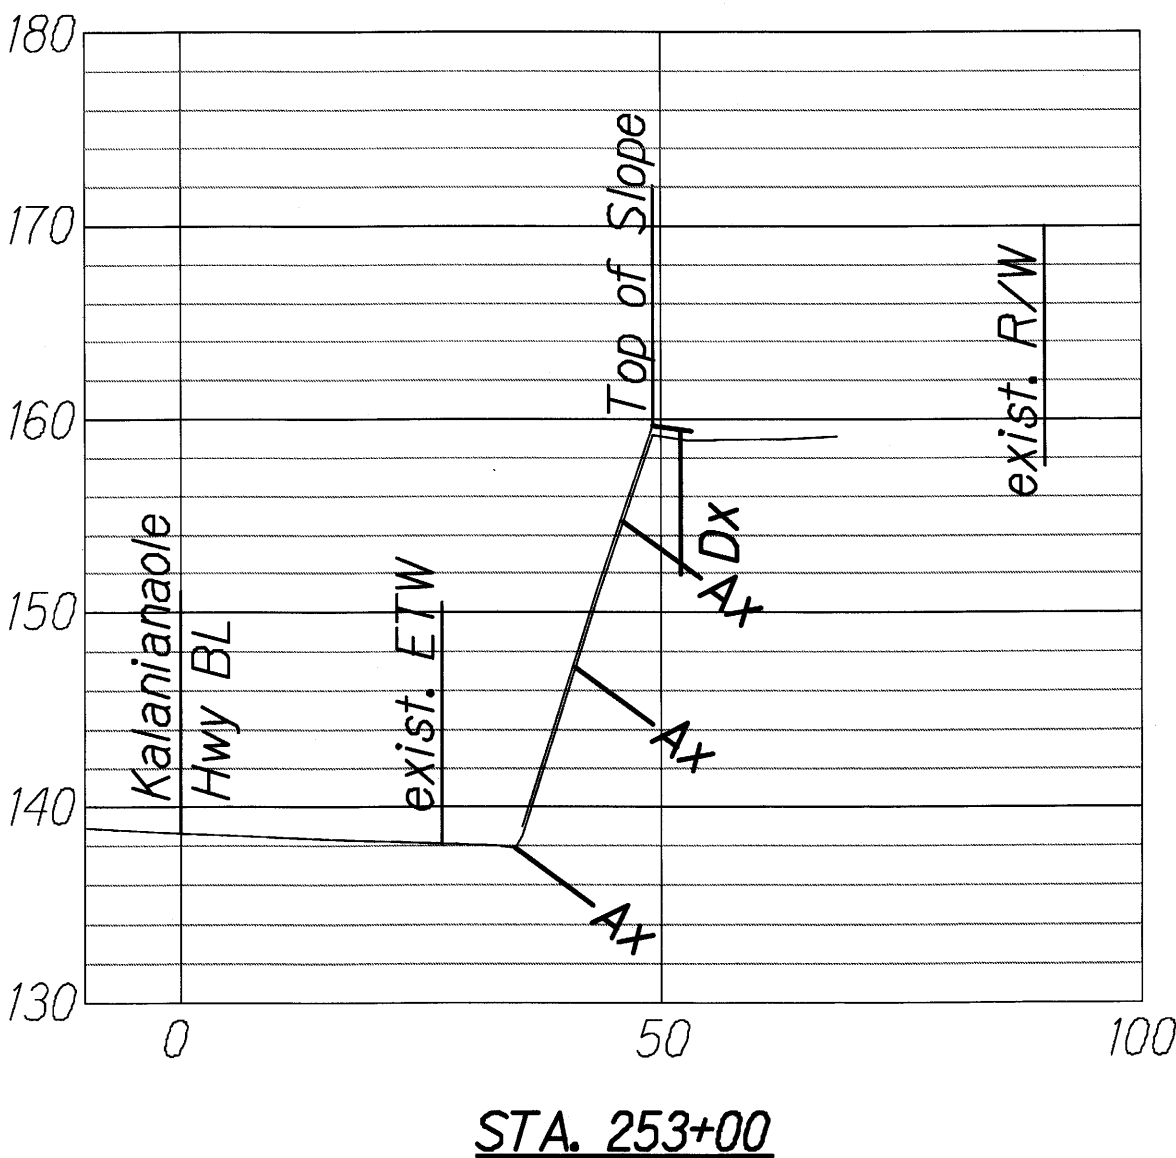

- LEGEND**

 - Ax Type A Anchor*
 - Bx Type B Anchor*
 - Cx Type C Anchor*
- Dx Type D Anchor*

*See Soil and/or Rock Anchor Schedule on Sheet N-3

EROSION CONTROL PLAN
SITE 15 SECTIONS
 Scale: 1" = 20'-0"

4/30/12
 EXP. DATE
 This work was prepared by me or under my supervision.

STATE OF HAWAII
 DEPARTMENT OF TRANSPORTATION
 HIGHWAYS DIVISION

EROSION CONTROL PLAN
SITE 15 SECTIONS


SLOPE IMPROVEMENTS FOR EROSION CONTROL AT VARIOUS SITES ON OAHU, PHASE 5
 Project No. HWY-O-01-12
 Scale: 1" = 20' Date: April 2012

SHEET No. EC-26 OF 50 SHEETS

SURVEY PLOTTED BY	DATE
DESIGNED BY	
TRACED BY	
NOTE BOOK	
QUANTITIES BY	
CHECKED BY	
IN CHARGE	

EC- SITE 15 - # 16 SECTIONS.DWG 2/1/2012 2:06:51 PM

FED. ROAD DIST. NO.	STATE	PROJ. NO.	FISCAL YEAR	SHEET NO.	TOTAL SHEETS
HAWAII	HAW.	HWY-O-01-12	2012	48	123

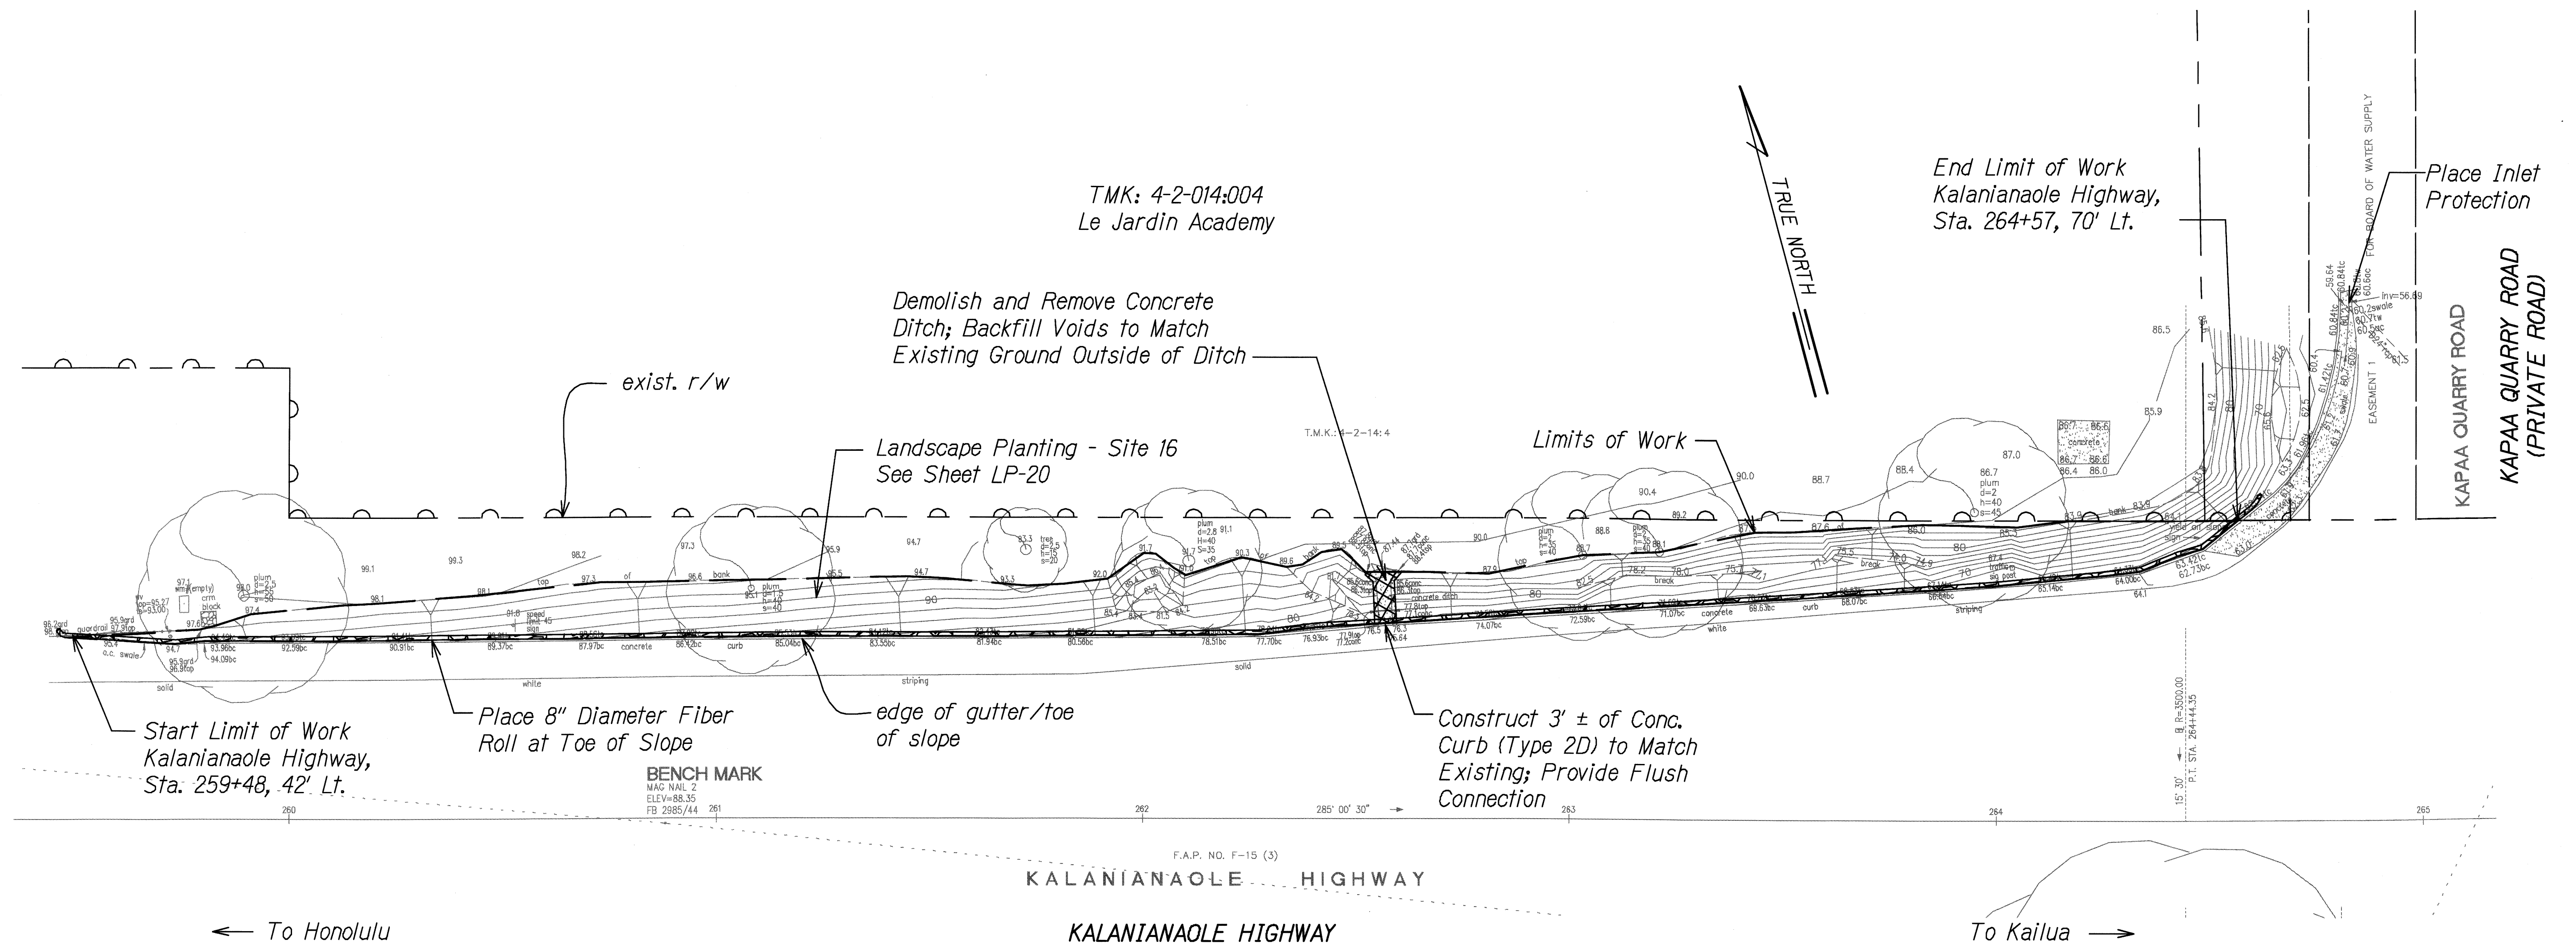

EROSION CONTROL PLAN SITE 16

Scale: 1" = 20'-0"

Estimated Area of Grassing Measured Along Slope Face: 6,075 SF
Estimated Area of Concrete Ditch to be Removed: 65 SF

- Notes:
1. Install erosion control matting on slopes greater than 3:1. See Sheet LP-20.
 2. For erosion mat details, see Sheets EC-42 & 43.

DATE	____
DESIGNED BY	____
TRACED BY	____
CHECKED BY	____
NOTED BY	____
DATE	____

JASON H. LIAO
LICENSED PROFESSIONAL ENGINEER
NO. 9360-C
HAWAII USA

4/30/12
EXP. DATE

This work was prepared by me or under my supervision.


STATE OF HAWAII
DEPARTMENT OF TRANSPORTATION
HIGHWAYS DIVISION

EROSION CONTROL PLAN
SITE 16

SLOPE IMPROVEMENTS FOR EROSION CONTROL AT VARIOUS SITES ON OAHU, PHASE 5

Project No. HWY-O-01-12
Scale: 1" = 20' Date: April 2012

FED. ROAD DIST. NO.	STATE	PROJ. NO.	FISCAL YEAR	SHEET NO.	TOTAL SHEETS
HAWAII	HAW.	HWY-O-01-12	2012	49	123

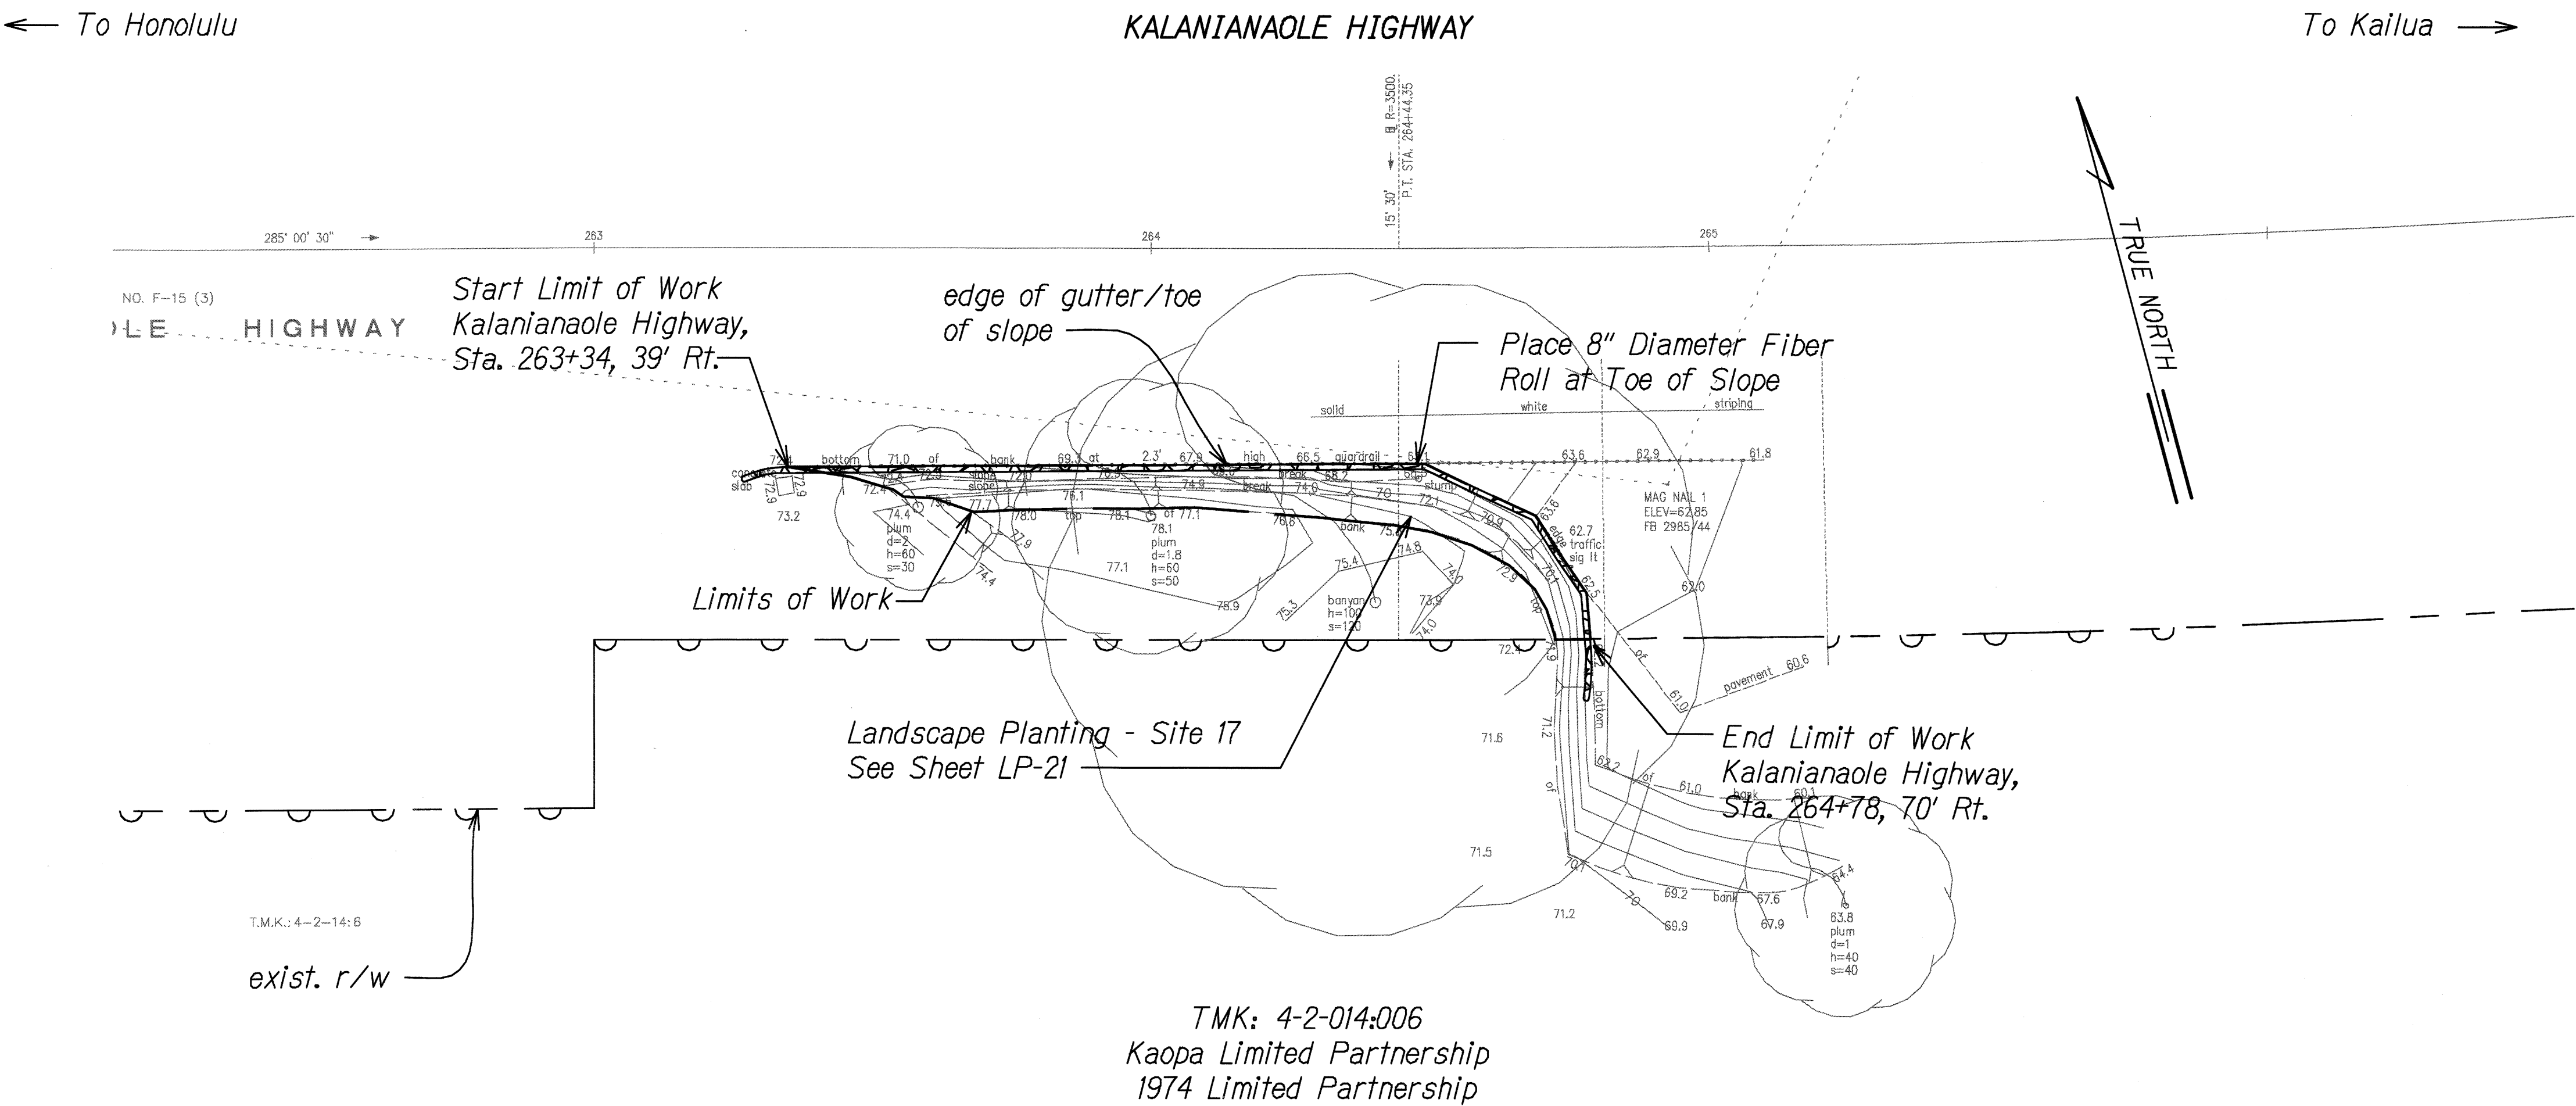

EROSION CONTROL PLAN SITE 17
 Scale: 1" = 20'-0"

Estimated Area of Grassing Measured Along Slope Face: 1,200 SF

- Notes:**
1. Install erosion control matting on slopes greater than 3:1. See Sheet LP-21.
 2. For erosion mat details, see Sheets EC-42 & 43.

SURVEY PLOTTED BY	DATE
DESIGNED BY	
TRACED BY	
NOTE BOOK	
QUANTITIES BY	
CHECKED BY	
NO.	

EC-112-123 1/12/2012 12:58:41 PM


4/30/12
 DATE
 This work was prepared by me or under my supervision.

STATE OF HAWAII
 DEPARTMENT OF TRANSPORTATION
 HIGHWAYS DIVISION

EROSION CONTROL PLAN
SITE 17

SLOPE IMPROVEMENTS FOR EROSION CONTROL AT VARIOUS SITES ON OAHU, PHASE 5
 Project No. HWY-O-01-12
 Scale: 1" = 20' Date: April 2012

FED. ROAD DIST. NO.	STATE	PROJ. NO.	FISCAL YEAR	SHEET NO.	TOTAL SHEETS
HAWAII	HAW.	HWY-O-01-12	2012	50	123

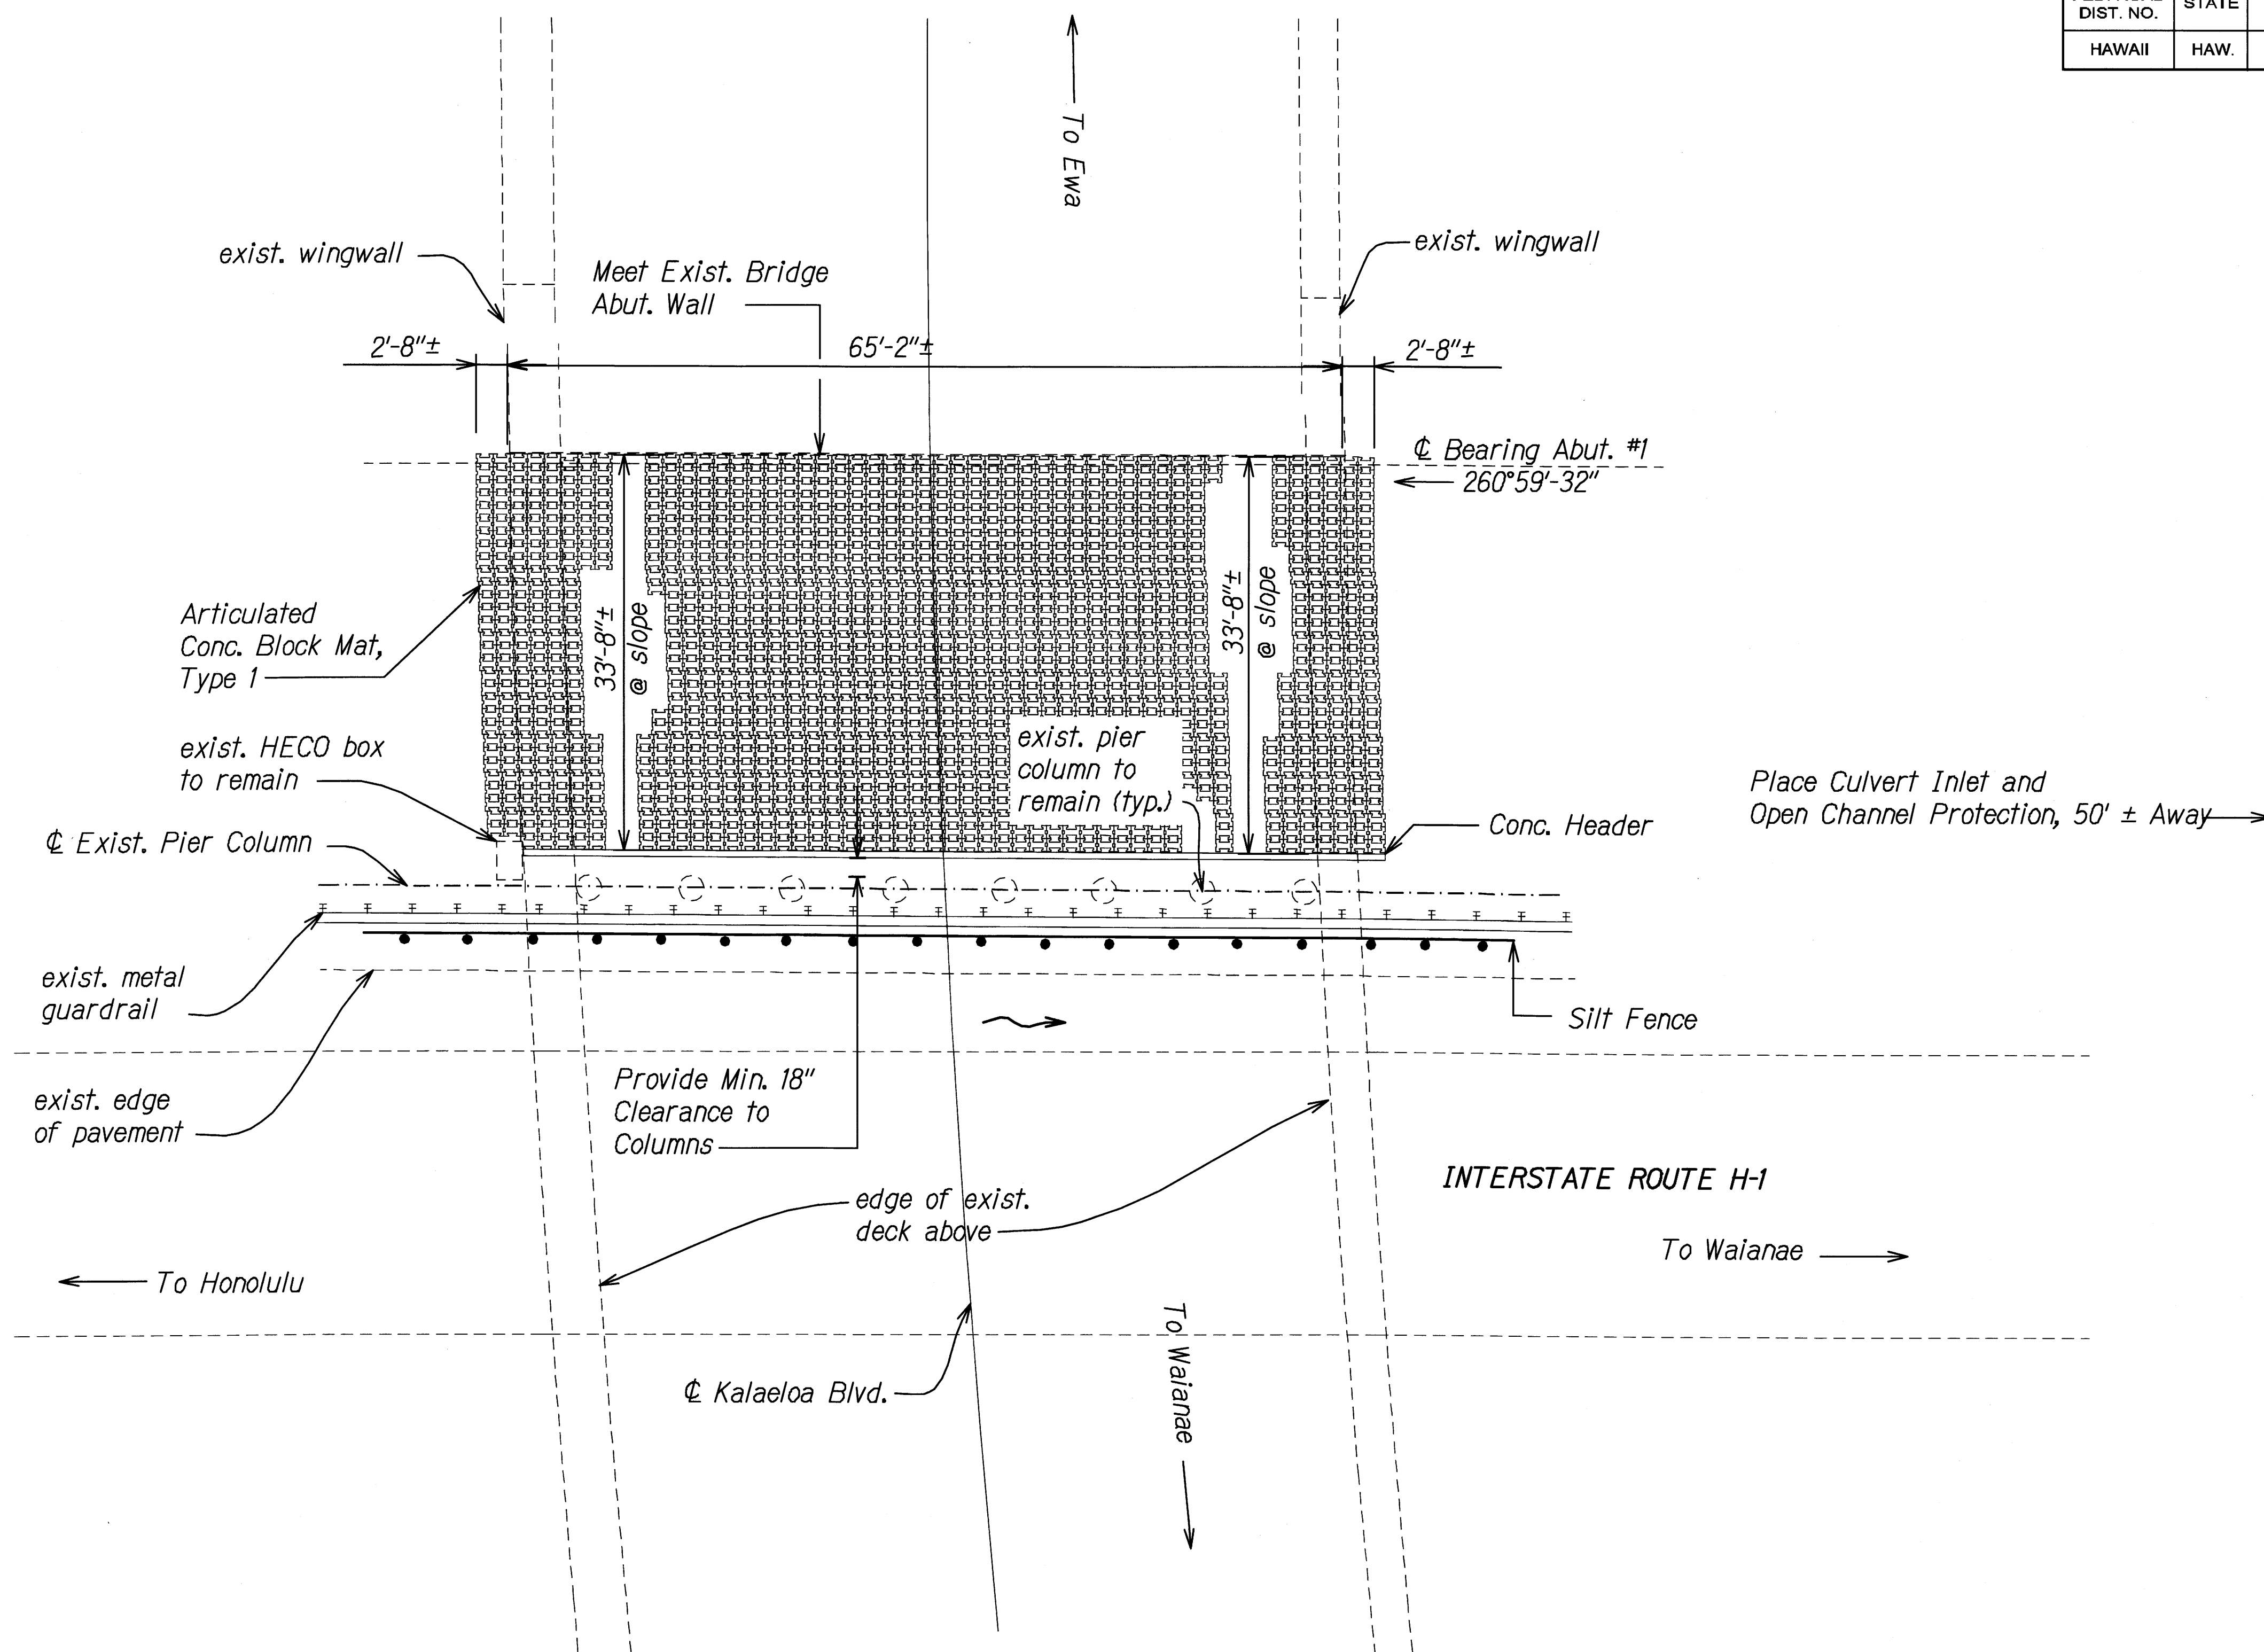

**EROSION CONTROL PLAN SITE 18 -
KALAELOA BLVD. OVERPASS AT H-1, SOUTH ABUTMENT**

Scale: 1/8" = 1'-0"

Estimated Area of Articulated Concrete Mat measured along slope face: 2,374 SQ. FT.

ORIGINAL PLAN	SURVEY PLATTED BY	DATE
NOTE BOOK	DRAWN BY	
	CHECKED BY	
	DESIGNED BY	
	QUANTITIES BY	
	CHECKED BY	

EC-29 SITE BLDG 1/6/2012 1:58 PM

4/30/12

This work was prepared by me or under my supervision.

STATE OF HAWAII
DEPARTMENT OF TRANSPORTATION
HIGHWAYS DIVISION

EROSION CONTROL PLAN

SITE 18



SLOPE IMPROVEMENTS FOR EROSION CONTROL
AT VARIOUS SITES ON OAHU, PHASE 5

Project No. HWY-O-01-12

Scale: 1/8" = 1' Date: April 2012

SHEET No. EC-29 OF 50 SHEETS

FED. ROAD DIST. NO.	STATE	PROJ. NO.	FISCAL YEAR	SHEET NO.	TOTAL SHEETS
HAWAII	HAW.	HWY-O-01-12	2012	51	123

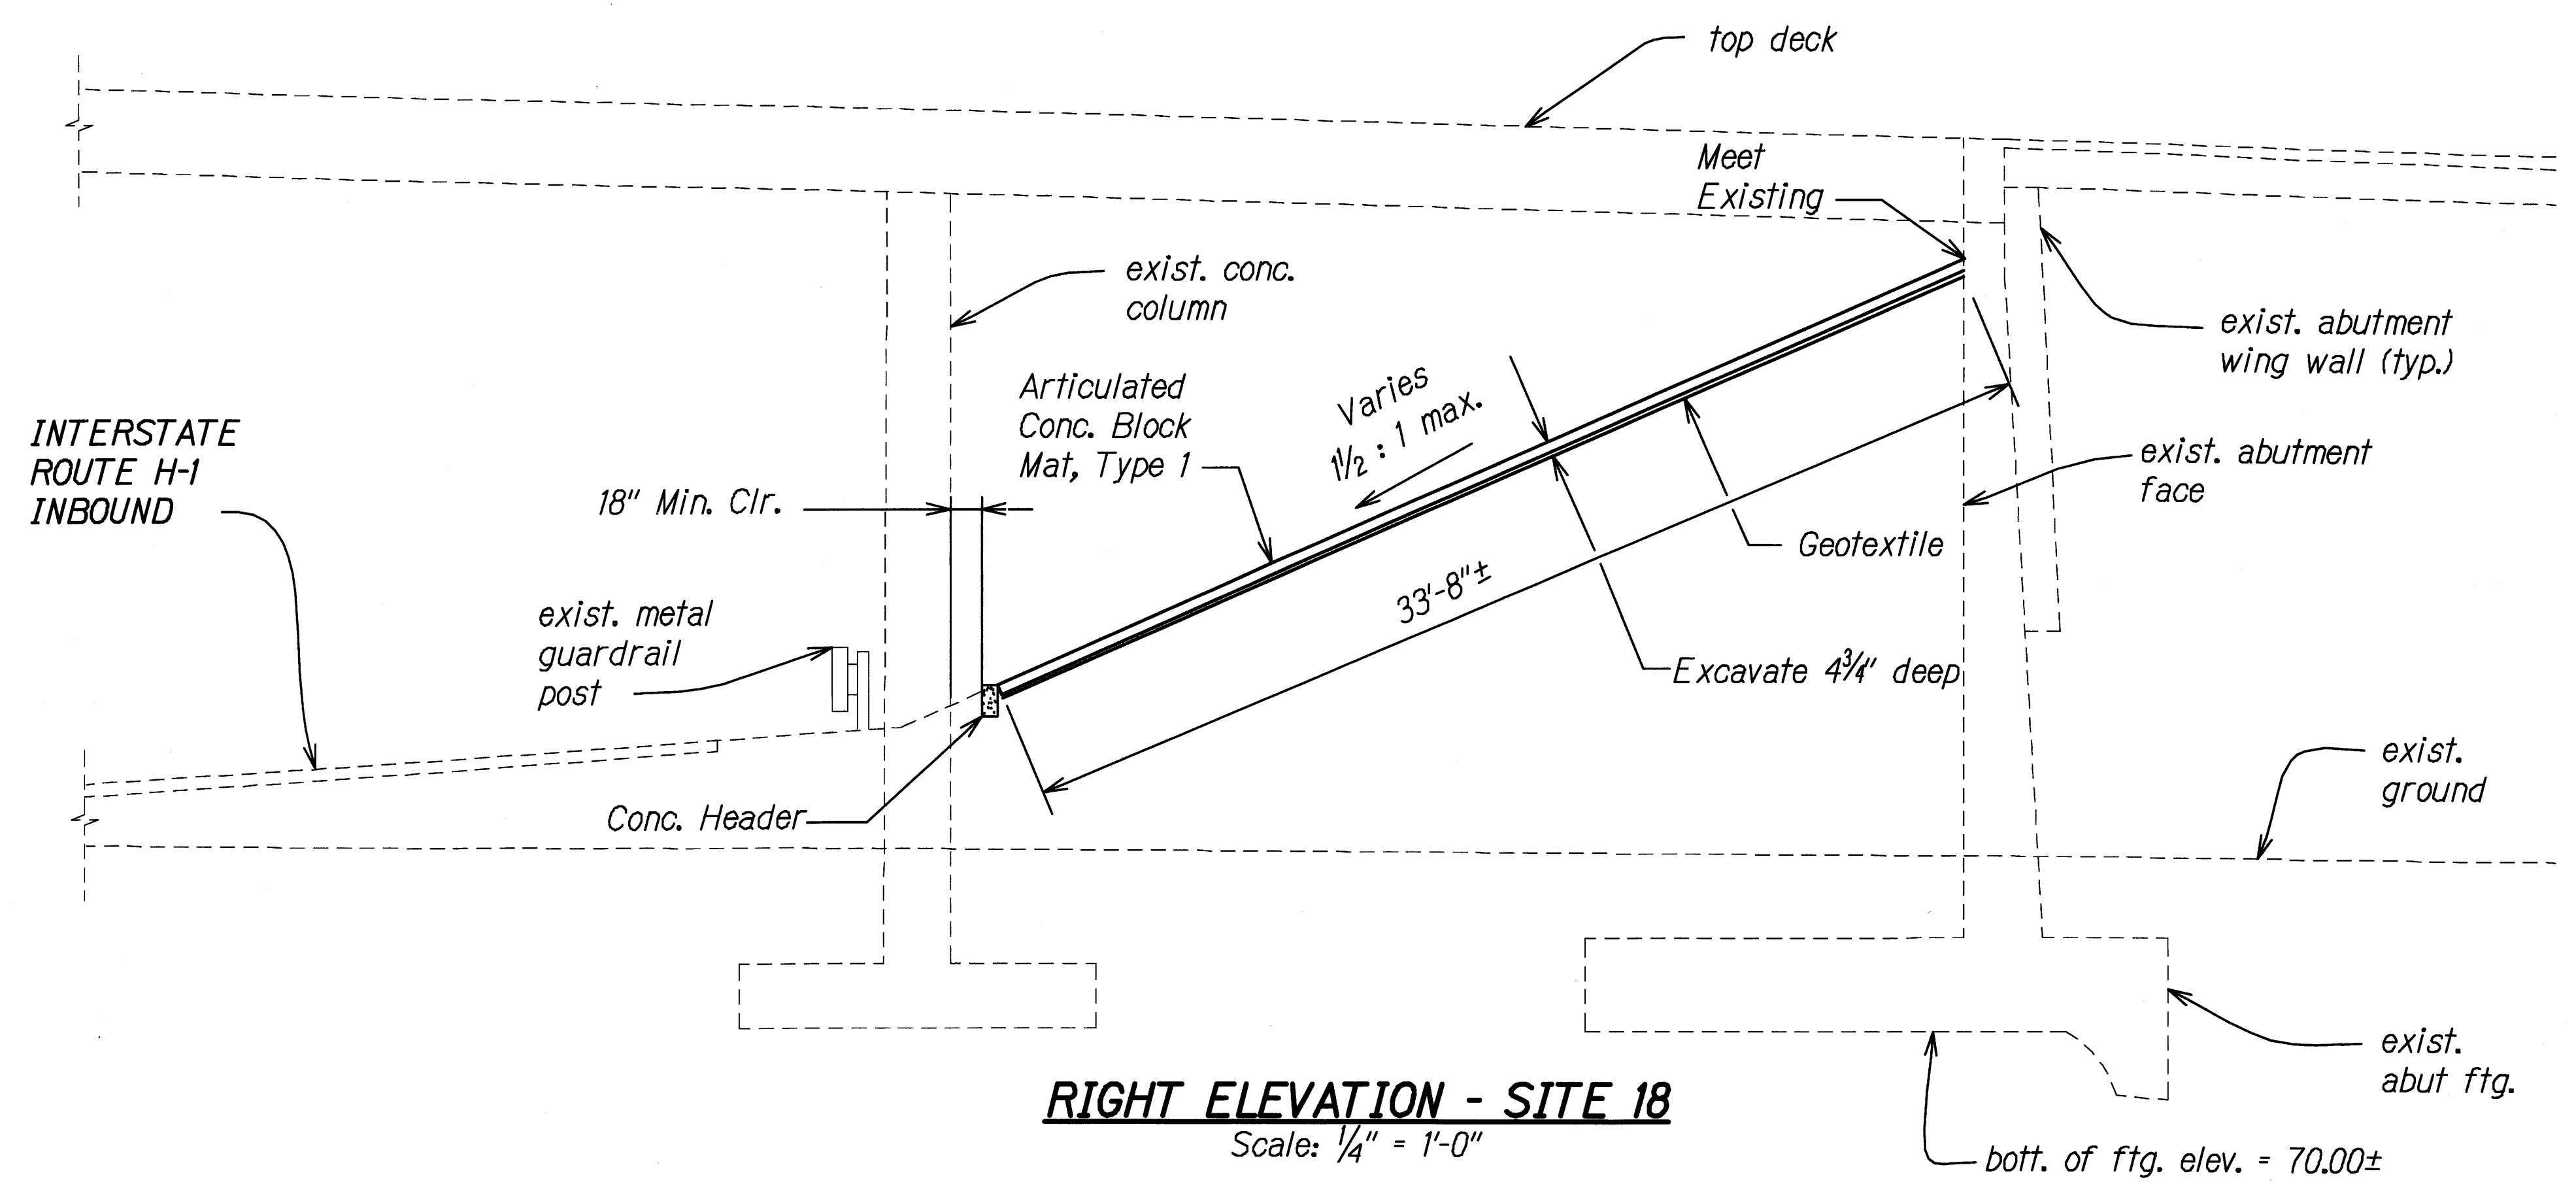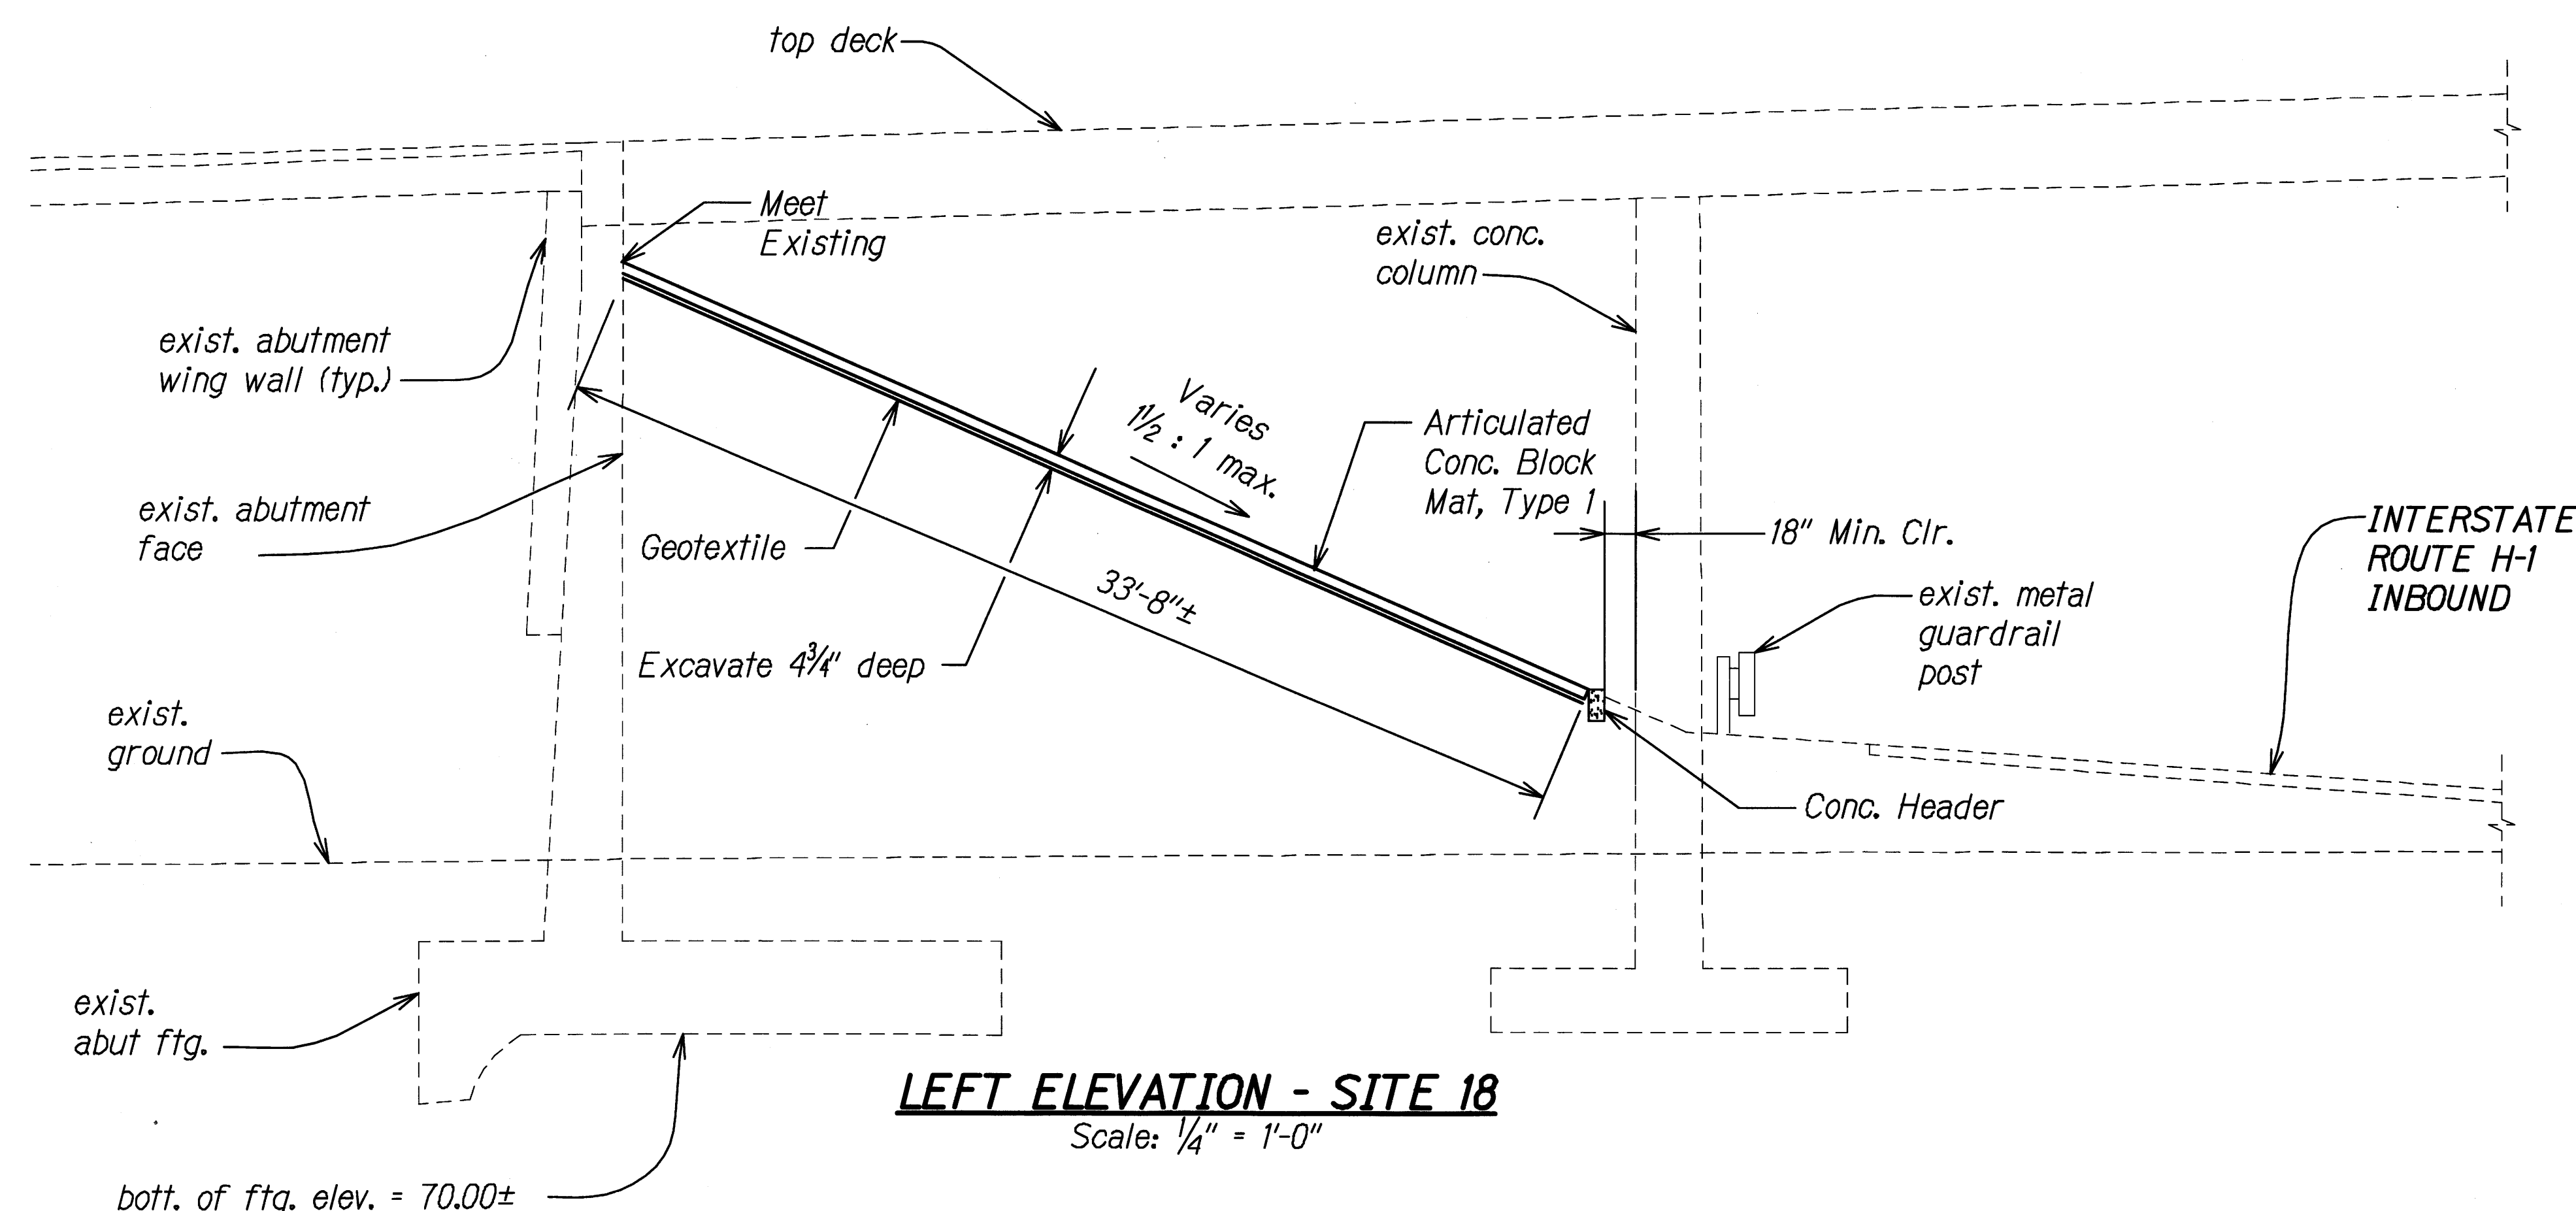

STATE OF HAWAII
DEPARTMENT OF TRANSPORTATION
HIGHWAYS DIVISION

EROSION CONTROL
ELEVATION SITE 18


SLOPE IMPROVEMENTS FOR EROSION CONTROL
AT VARIOUS SITES ON OAHU, PHASE 5

Project No. HWY-O-01-12
Scale: 1/4" = 1' Date: April 2012

ORIGINAL PLAN	SURVEY PLOTTED BY	DATE
NOTE BOOK	DRAWN BY	
	PLACED BY	
	QUANTITIES BY	
	CHECKED BY	

ECR-SITE 80WS 4/3/2012 8:02 AM

FED. ROAD DIST. NO.	STATE	PROJ. NO.	FISCAL YEAR	SHEET NO.	TOTAL SHEETS
HAWAII	HAW.	HWY-O-01-12	2012	52	123

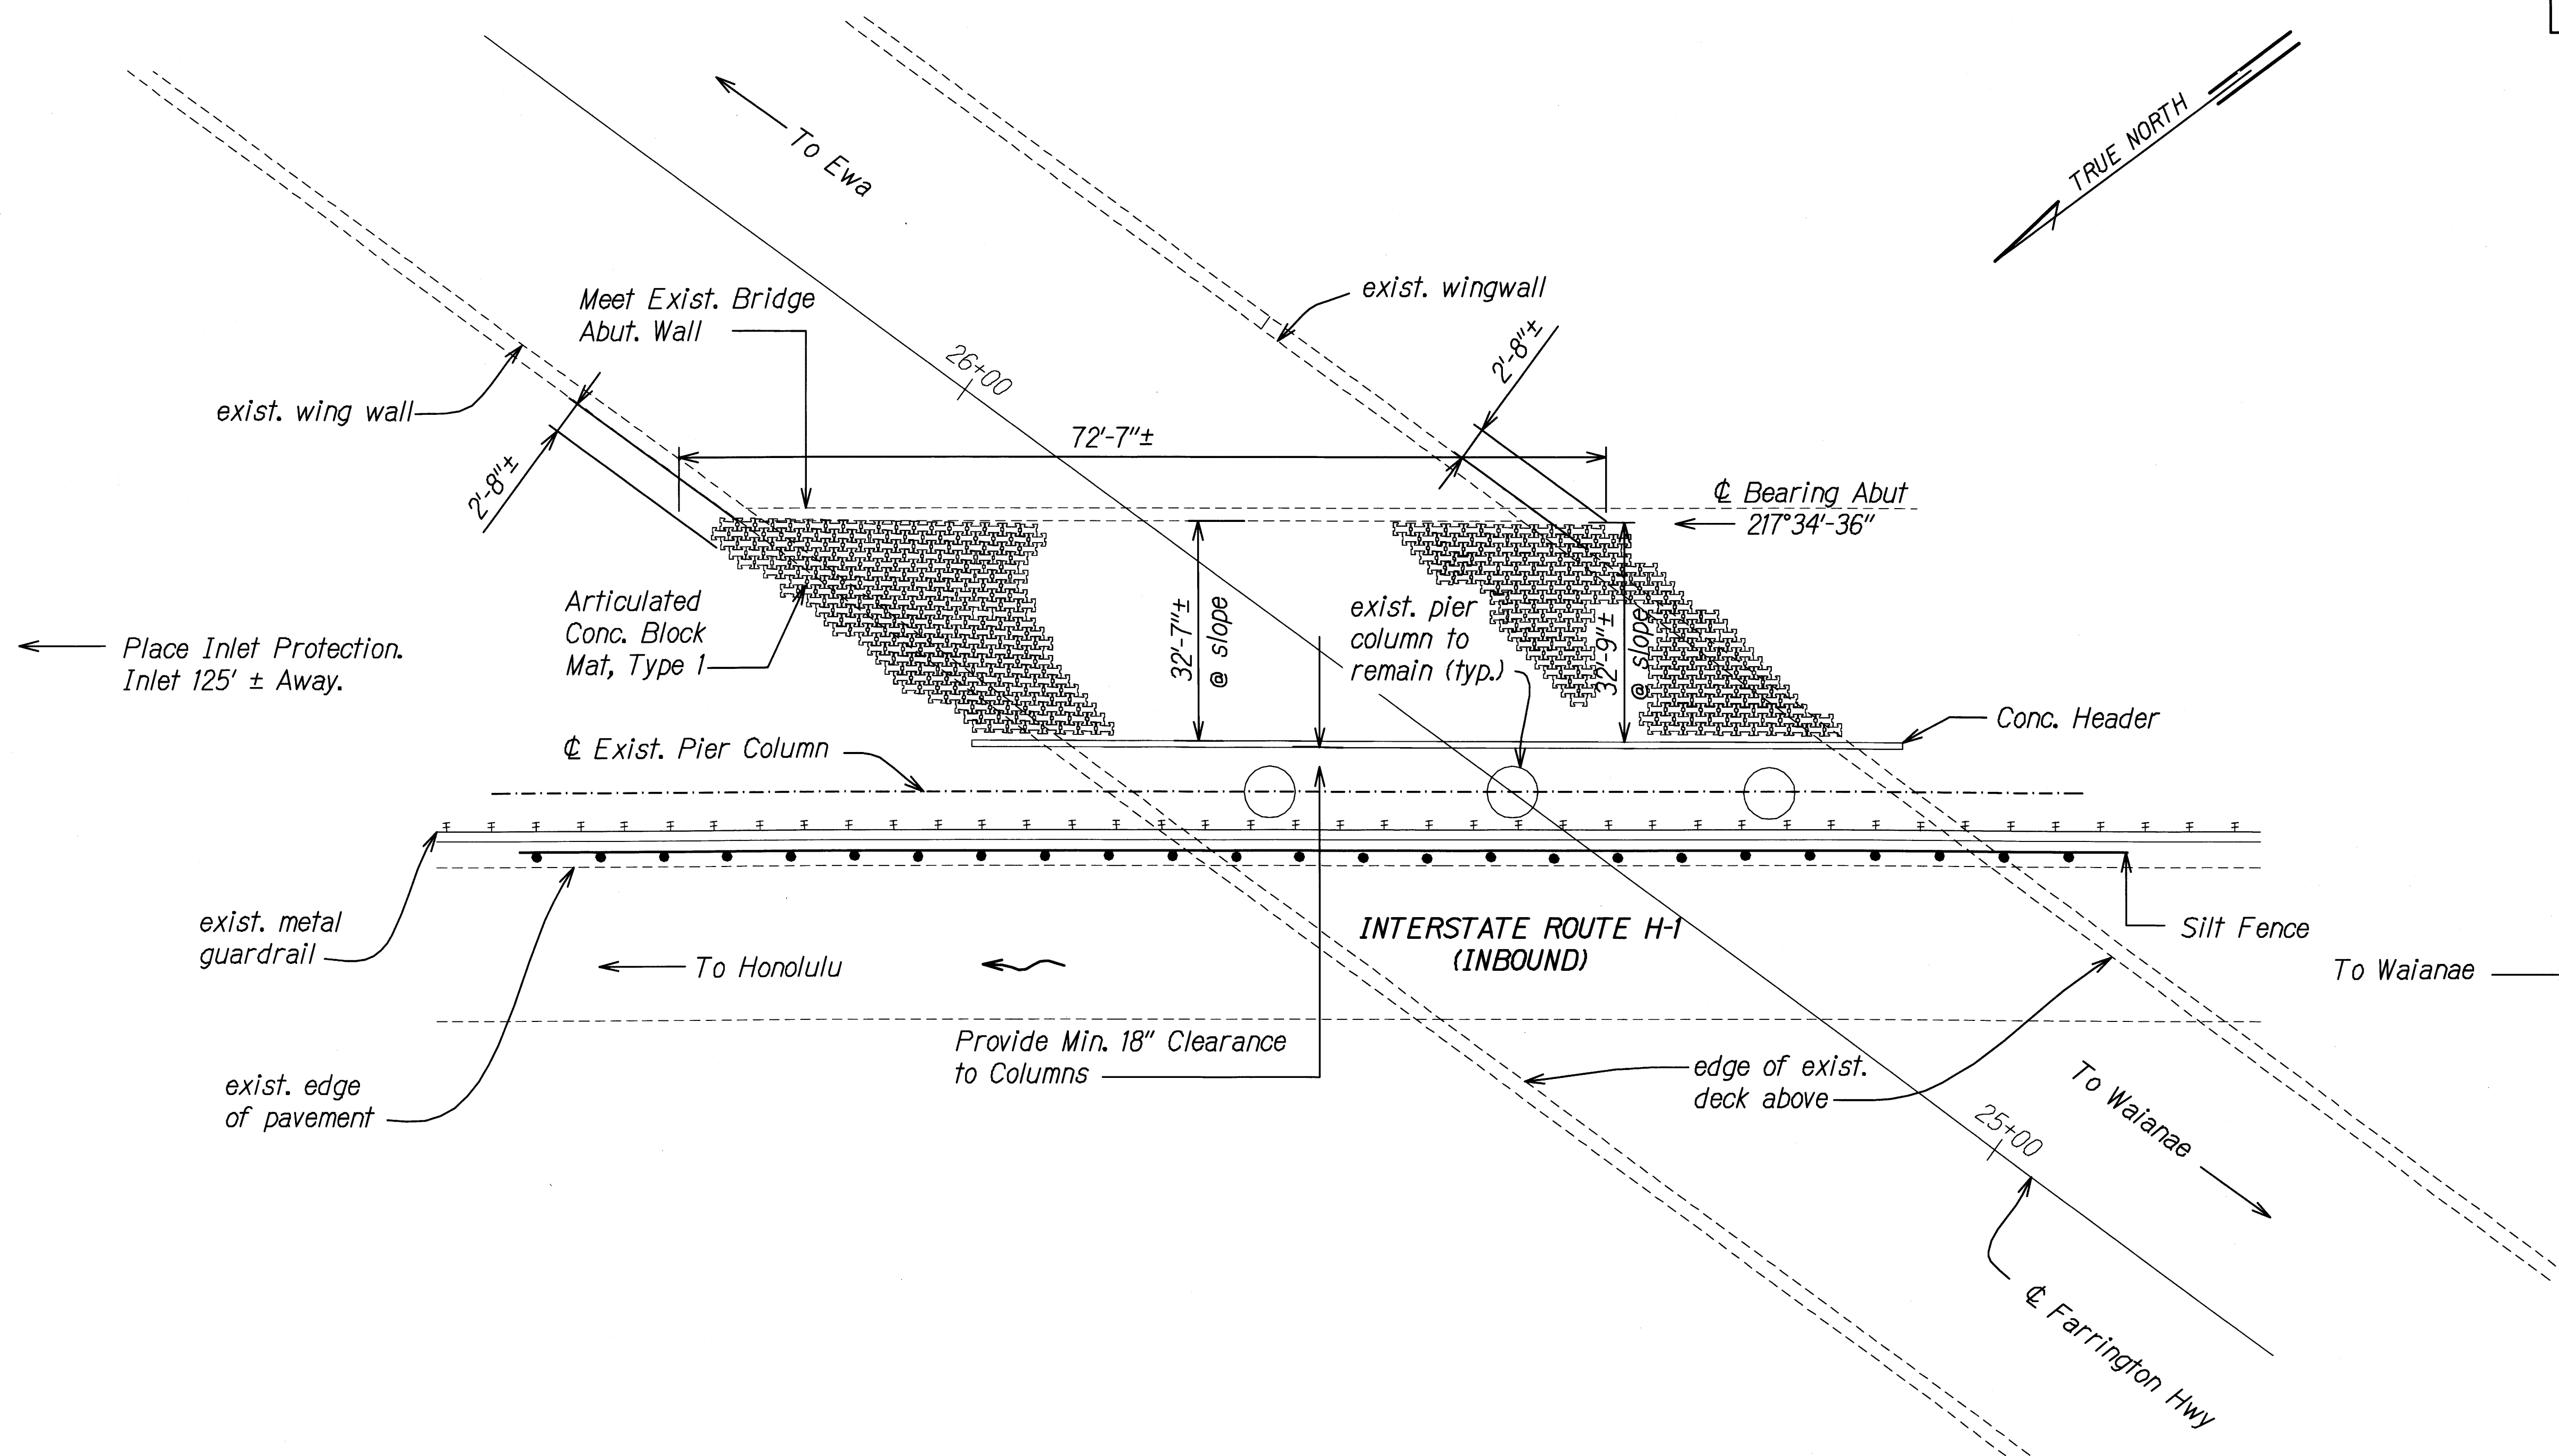

**EROSION CONTROL PLAN SITE 19 -
FARRINGTON HIGHWAY OVERPASS AT H-1, SOUTH ABUTMENT**
Scale: 1/8" = 1'-0"

Estimated Area of Articulated Concrete Mat measured along slope face: 2,546 SQ. FT.

SURVEY PLOTTED BY	DATE
DESIGNED BY	
TRACED BY	
NOTE BOOK	
QUANTITIES BY	
CHECKED BY	

ECP SITE 19.DWG 1/8/2012 10:22 PM

STATE OF HAWAII
DEPARTMENT OF TRANSPORTATION
HIGHWAYS DIVISION

EROSION CONTROL PLAN
SITE 19


SLOPE IMPROVEMENTS FOR EROSION CONTROL
AT VARIOUS SITES ON OAHU, PHASE 5

Project No. HWY-O-01-12
Date: April 2012


Scale: 1/8" = 1'

SHEET No. EC-31 OF 50 SHEETS

FED. ROAD DIST. NO.	STATE	PROJ. NO.	FISCAL YEAR	SHEET NO.	TOTAL SHEETS
HAWAII	HAW.	HWY-O-01-12	2012	53	123

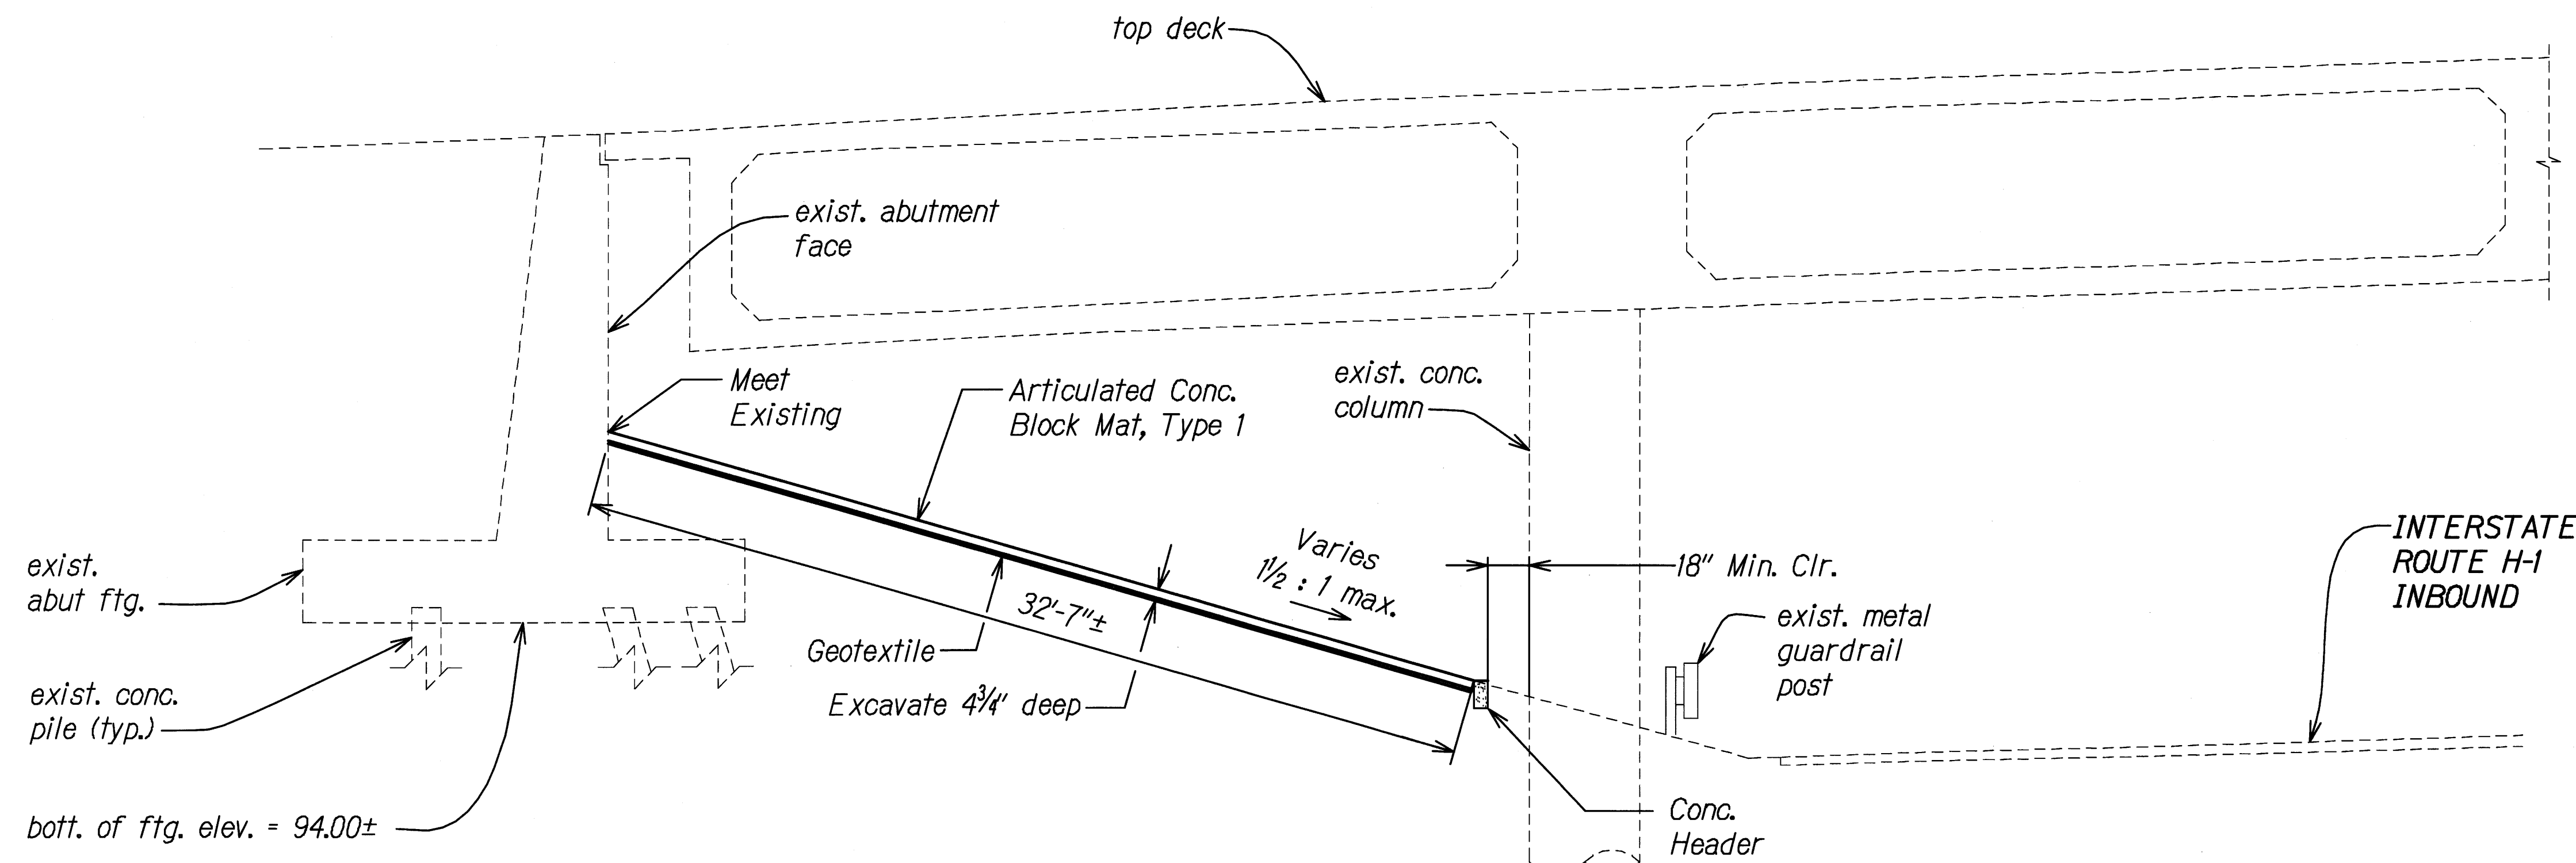


LEFT ELEVATION - SITE 19
Scale: 1/4" = 1'-0"

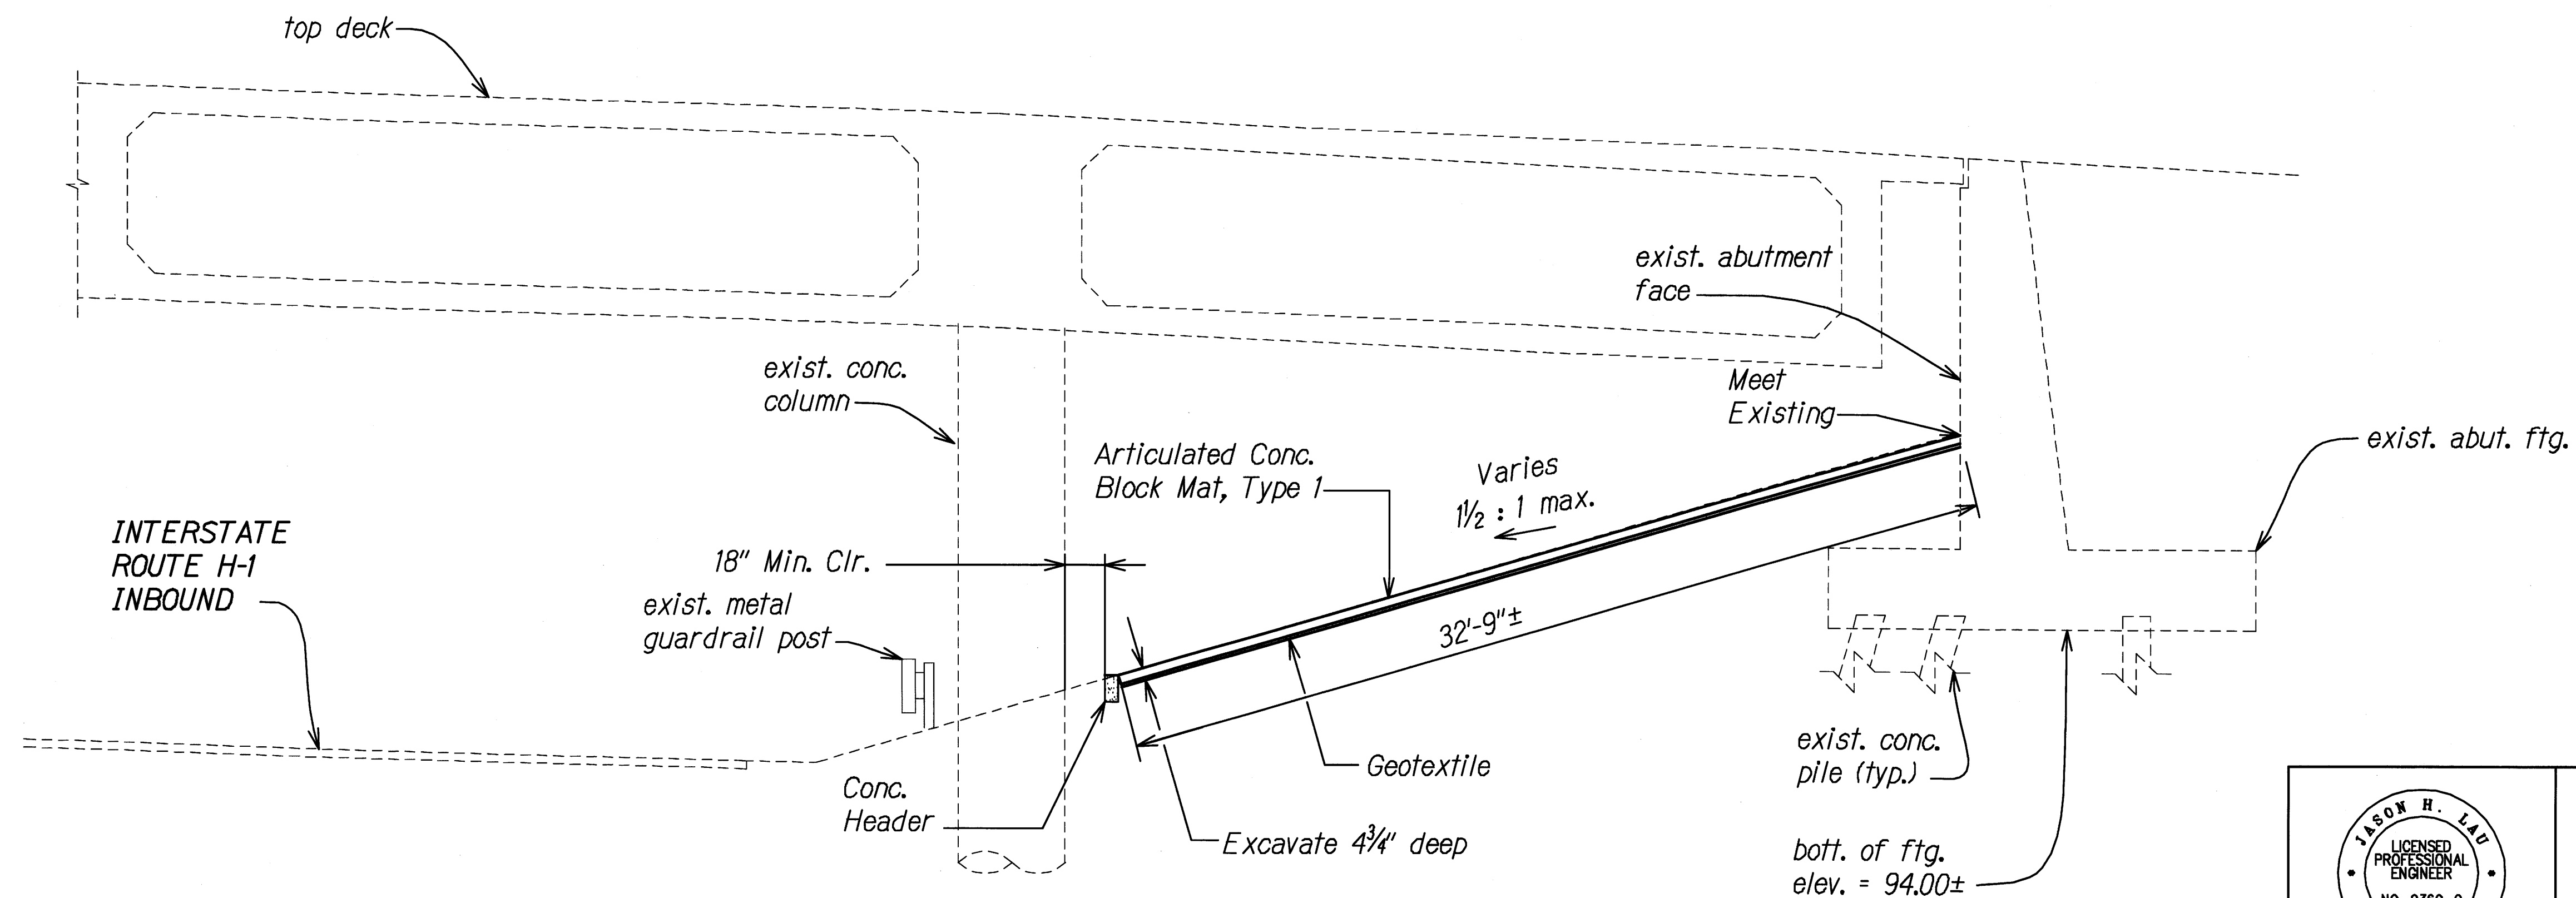

RIGHT ELEVATION - SITE 19
Scale: 1/4" = 1'-0"

SURVEY PLOTTED BY	DATE
DESIGNED BY	
TRACED BY	
NOTED BY	
QUANTITIES BY	
CHECKED BY	

EC-32 SITE 19 ELEVATION/2012 1/4/2012 4:56:28 PM

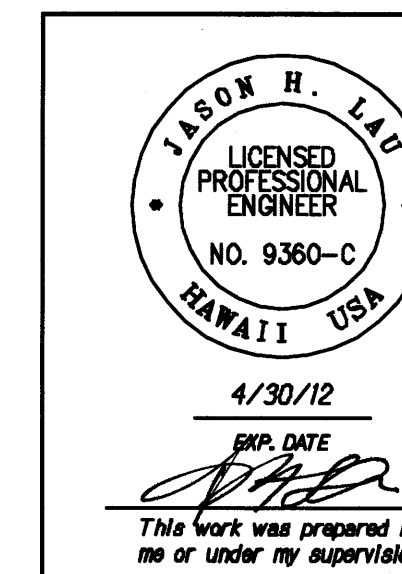

STATE OF HAWAII
DEPARTMENT OF TRANSPORTATION
HIGHWAYS DIVISION



**EROSION CONTROL
ELEVATION SITE 19**

SLOPE IMPROVEMENTS FOR EROSION CONTROL
AT VARIOUS SITES ON OAHU, PHASE 5

Project No. HWY-O-01-12
Scale: 1/4" = 1' Date: April 2012

SHEET No. EC-32 OF 50 SHEETS

FED. ROAD DIST. NO.	STATE	PROJ. NO.	FISCAL YEAR	SHEET NO.	TOTAL SHEETS
HAWAII	HAW.	HWY-O-01-12	2012	54	123

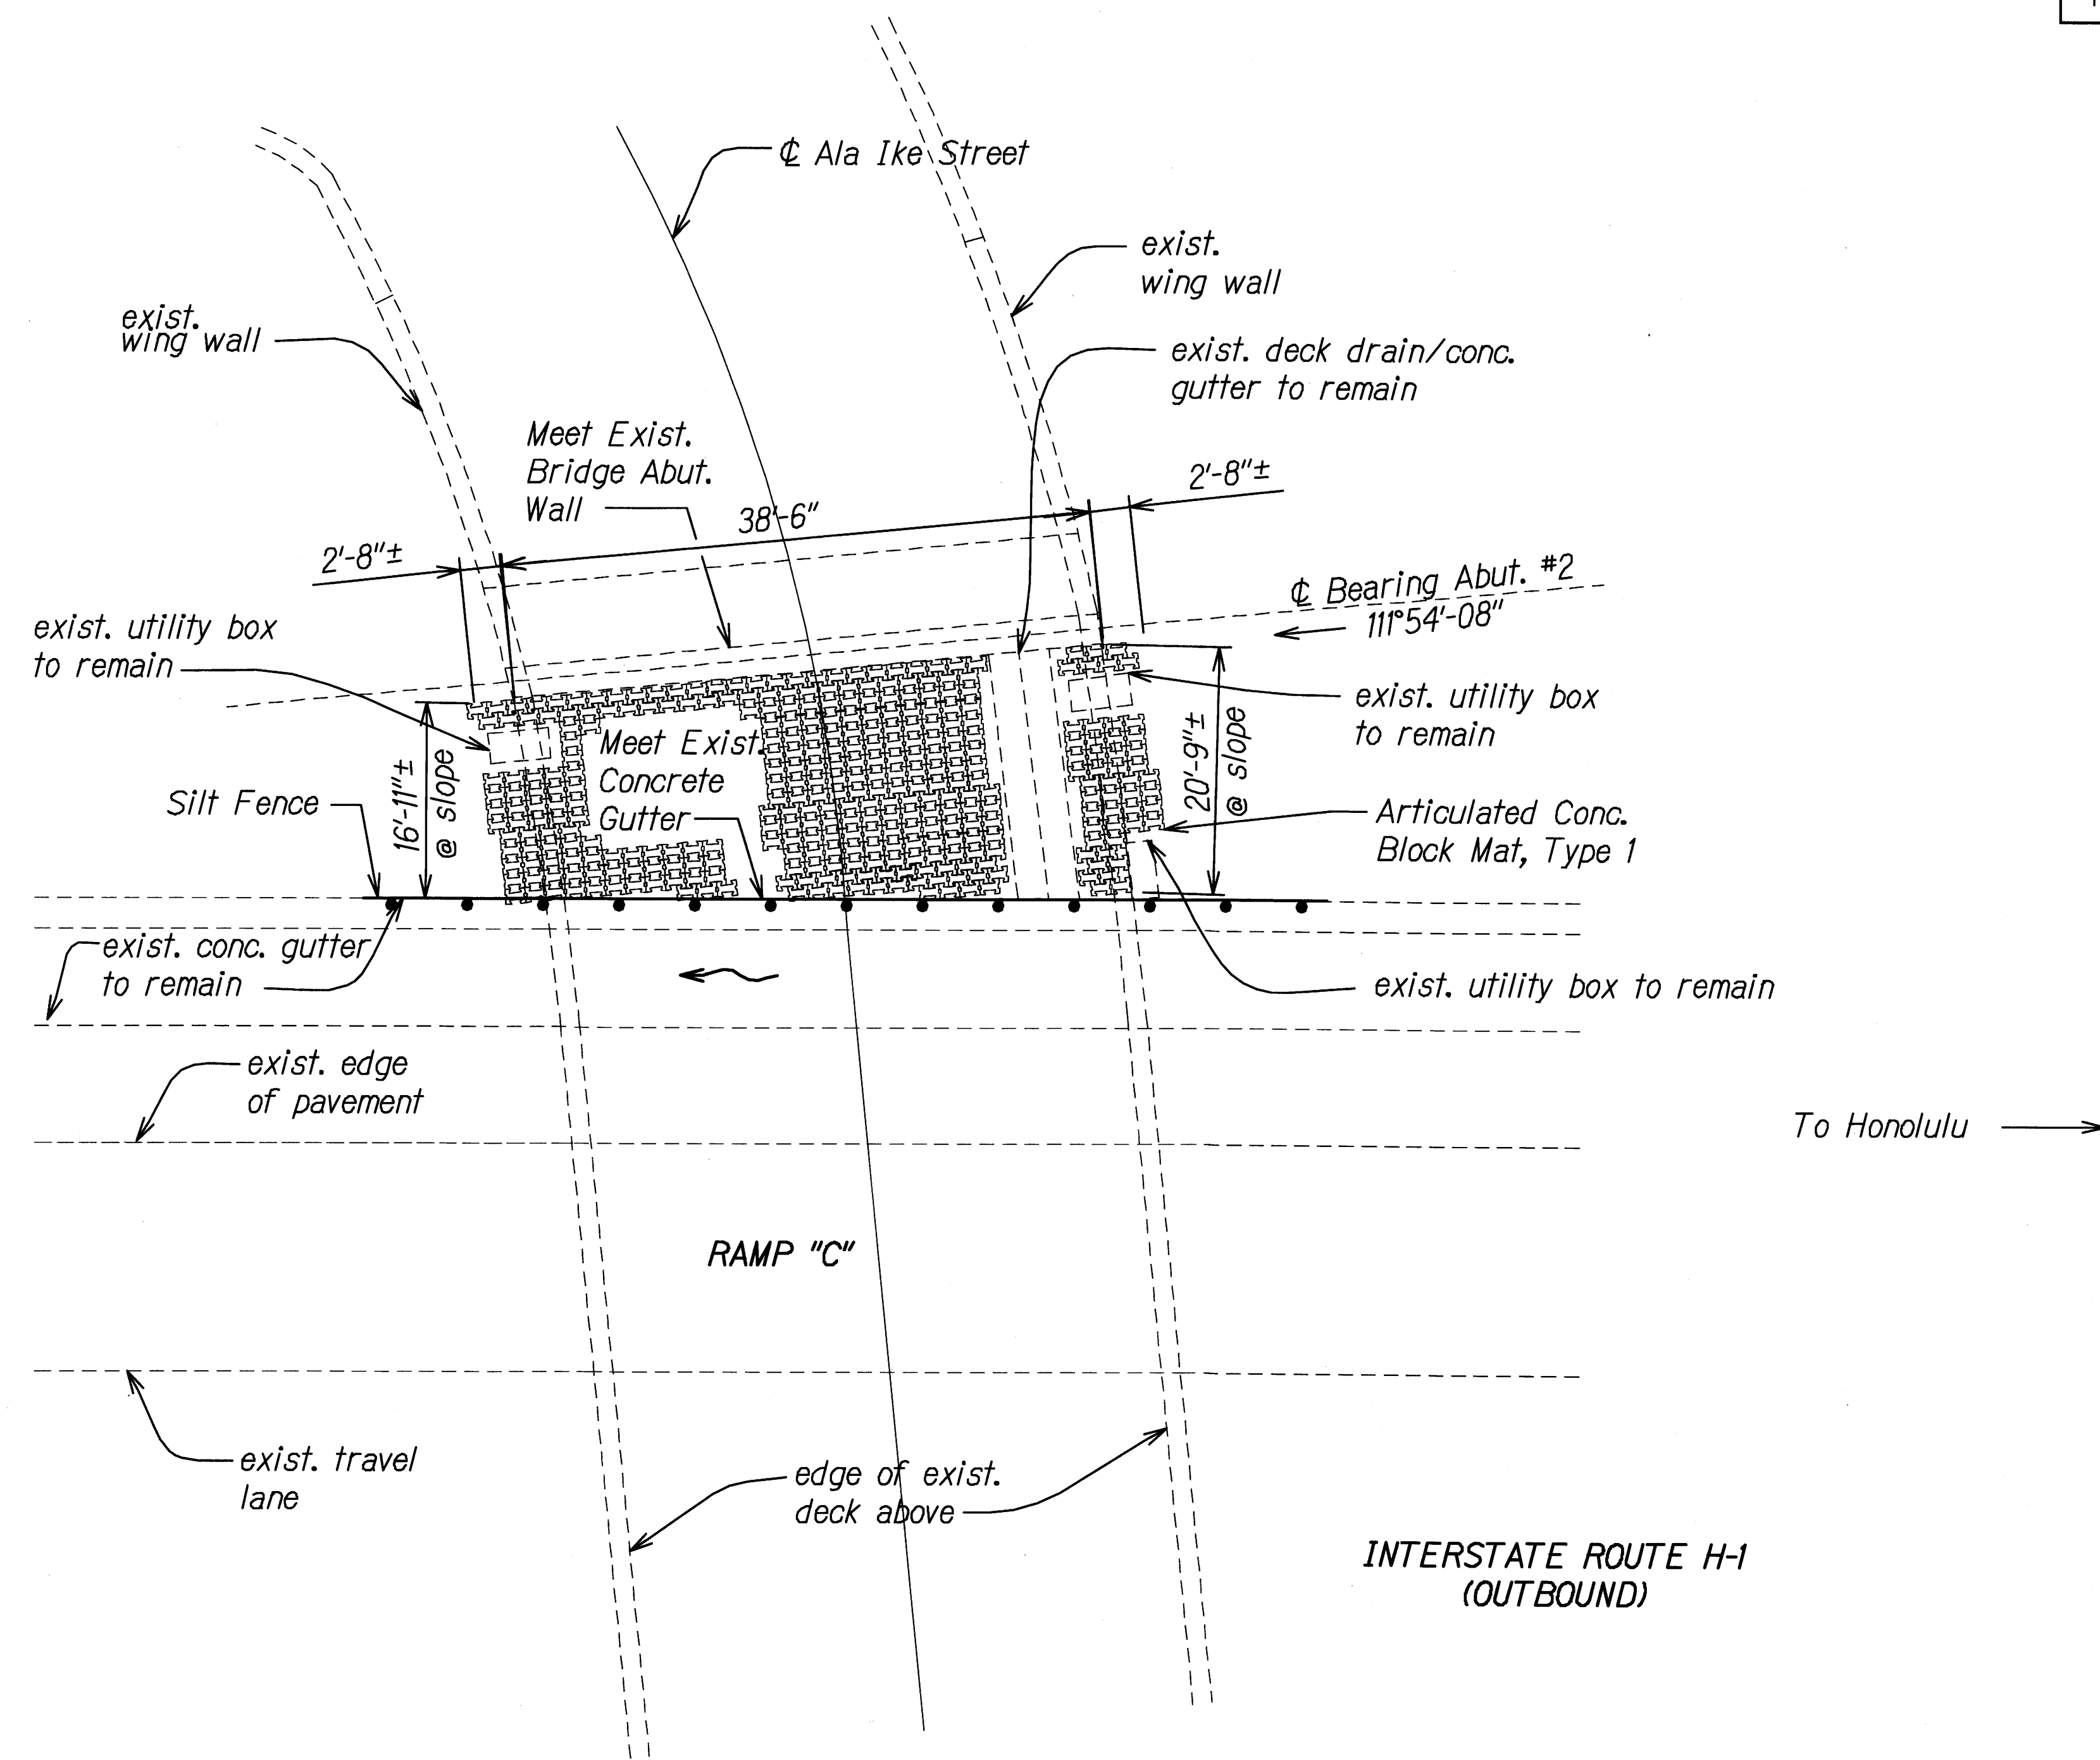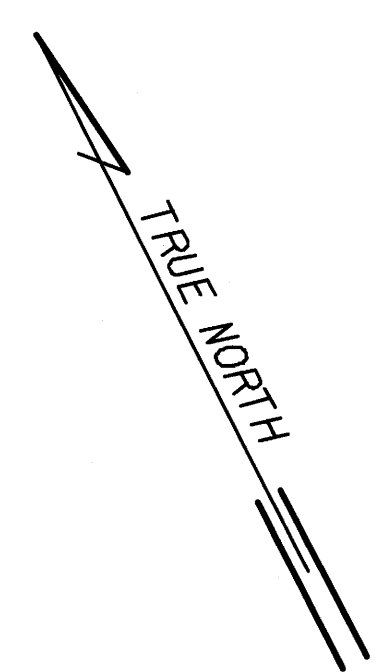

**EROSION CONTROL PLAN SITE 20 -
WAIAWA ROAD OVERPASS, NORTH ABUTMENT**

Scale: 1/8" = 1'-0"

Estimated Area of Articulated Concrete Mat Type 1 measured along slope face: 826 SQ. FT.


SURVEY PLOTTED BY	DATE
DRAWN BY	
TRACED BY	
NOTED BY	
CHECKED BY	

ECP SITE 20106 4/3/2012 03:35 AM

	STATE OF HAWAII DEPARTMENT OF TRANSPORTATION HIGHWAYS DIVISION
	<u>EROSION CONTROL PLAN</u>
	<u>SITE 20</u>
	<u>SLOPE IMPROVEMENTS FOR EROSION CONTROL</u> <u>AT VARIOUS SITES ON OAHU, PHASE 5</u>
	<u>Project No. HWY-O-01-12</u> Scale: 1/8" = 1' Date: April 2012


SHEET No. EC-33 OF 50 SHEETS

FED. ROAD DIST. NO.	STATE	PROJ. NO.	FISCAL YEAR	SHEET NO.	TOTAL SHEETS
HAWAII	HAW.	HWY-O-01-12	2012	55	123

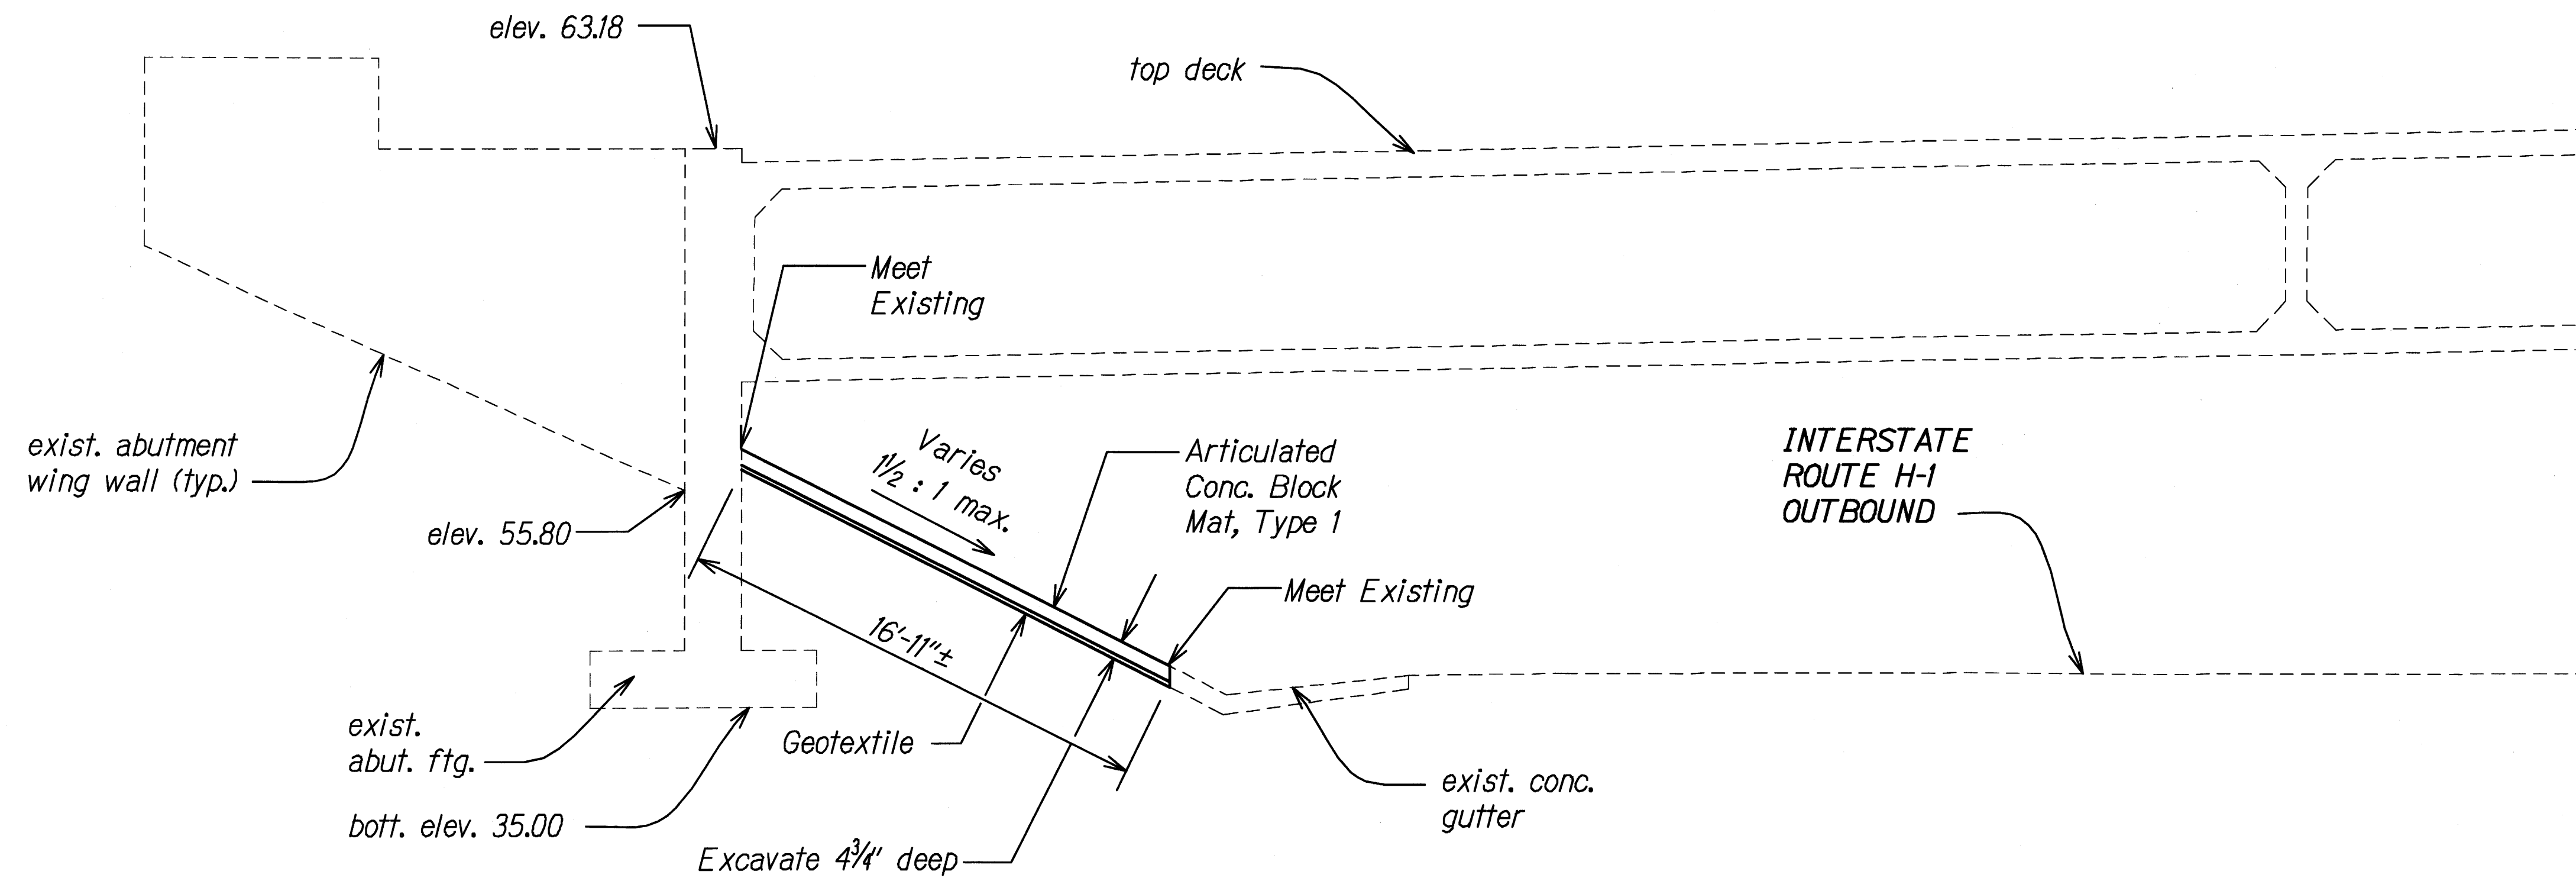

LEFT ELEVATION - SITE 20

Scale: 1/4" = 1'-0"

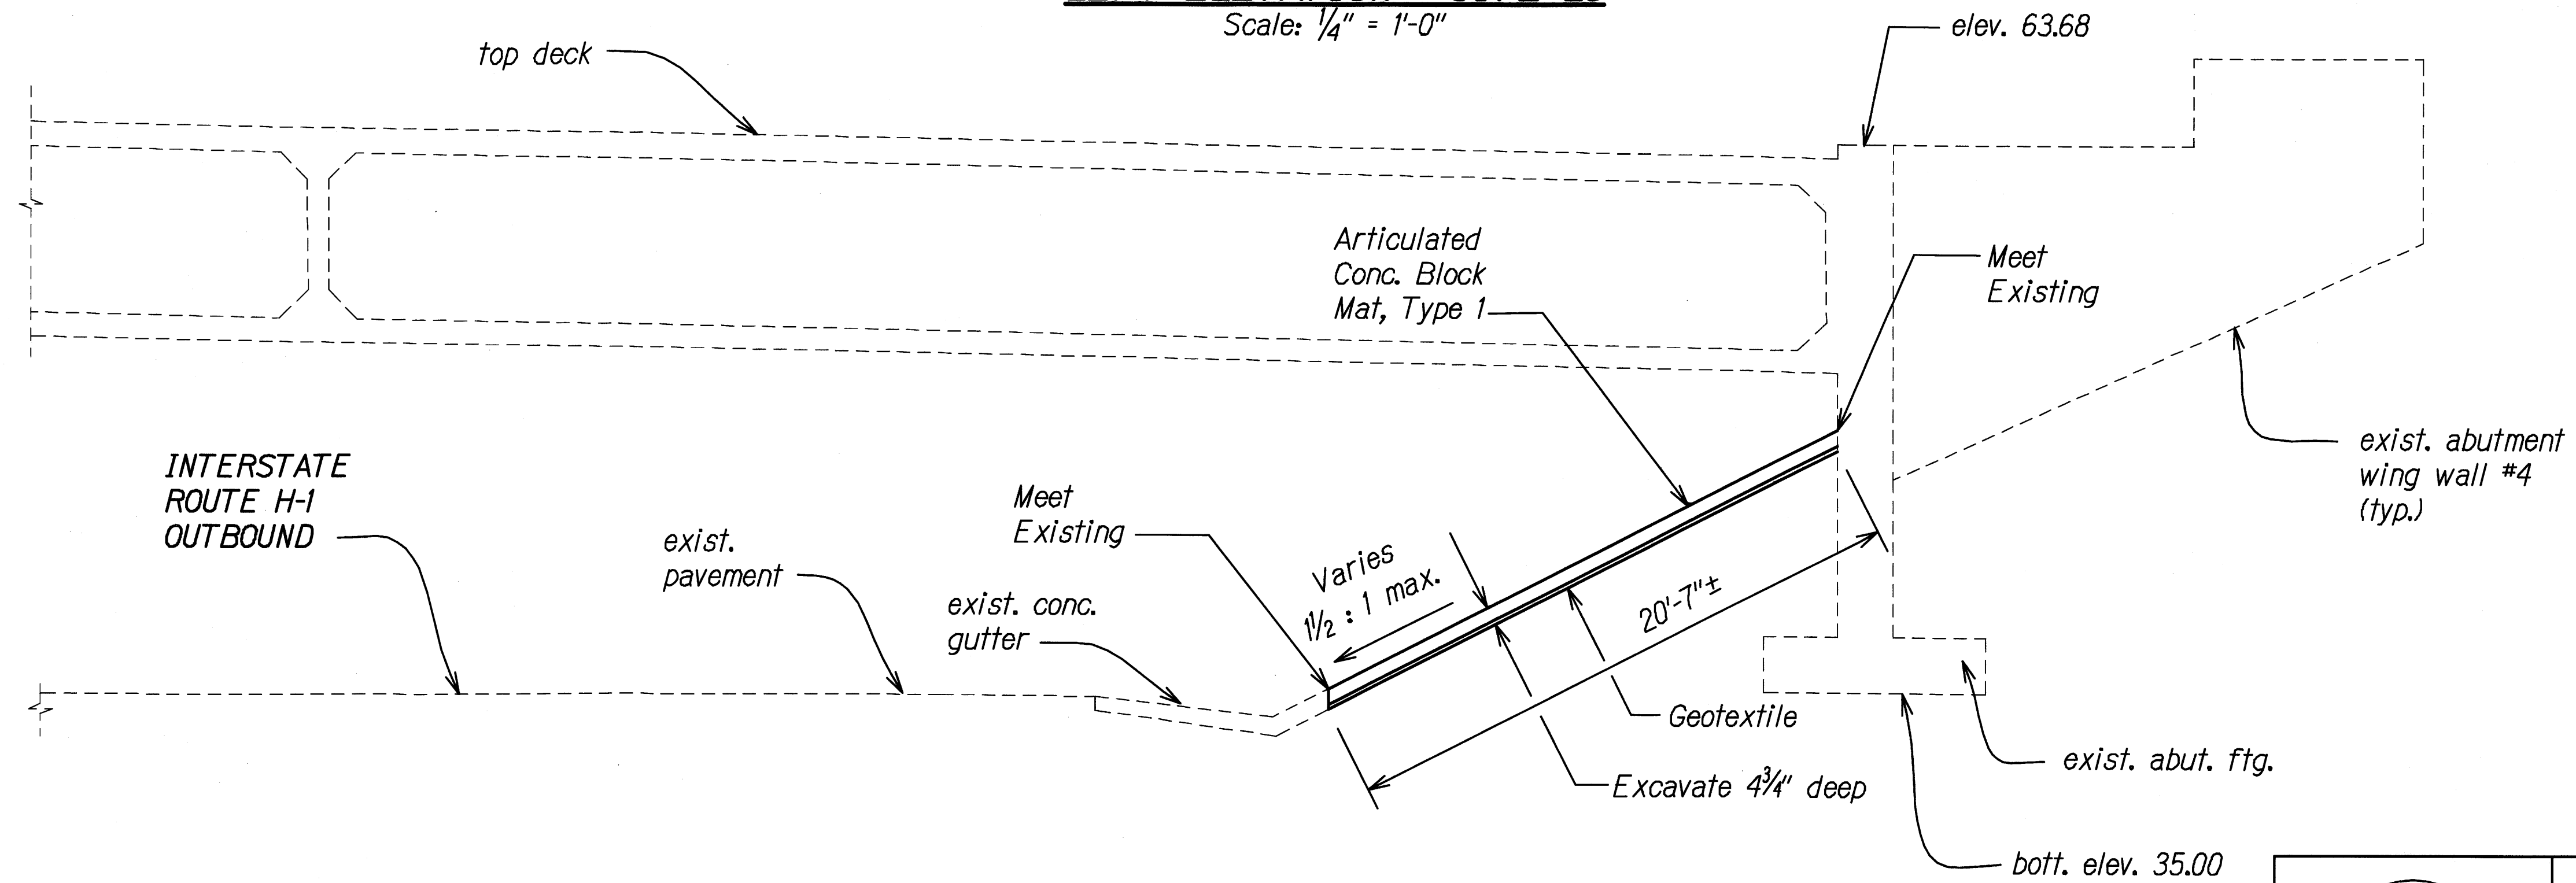

RIGHT ELEVATION - SITE 20

Scale: 1/4" = 1'-0"

ORIGINAL PLAN	SURVEY PLOTTED BY	DATE
NOTE BOOK	DRAWN BY	
	CHECKED BY	

EC-34 SITE 20.DWG 4/2/2012 8:35 AM

4/30/12
This work was prepared by me or under my supervision.


STATE OF HAWAII
DEPARTMENT OF TRANSPORTATION
HIGHWAYS DIVISION

**EROSION CONTROL
ELEVATION SITE 20**

SLOPE IMPROVEMENTS FOR EROSION CONTROL
AT VARIOUS SITES ON OAHU, PHASE 5

Project No. HWY-O-01-12
Scale: 1/4" = 1' Date: April 2012

FED. ROAD DIST. NO.	STATE	PROJ. NO.	FISCAL YEAR	SHEET NO.	TOTAL SHEETS
HAWAII	HAW.	HWY-O-01-12	2012	56	123

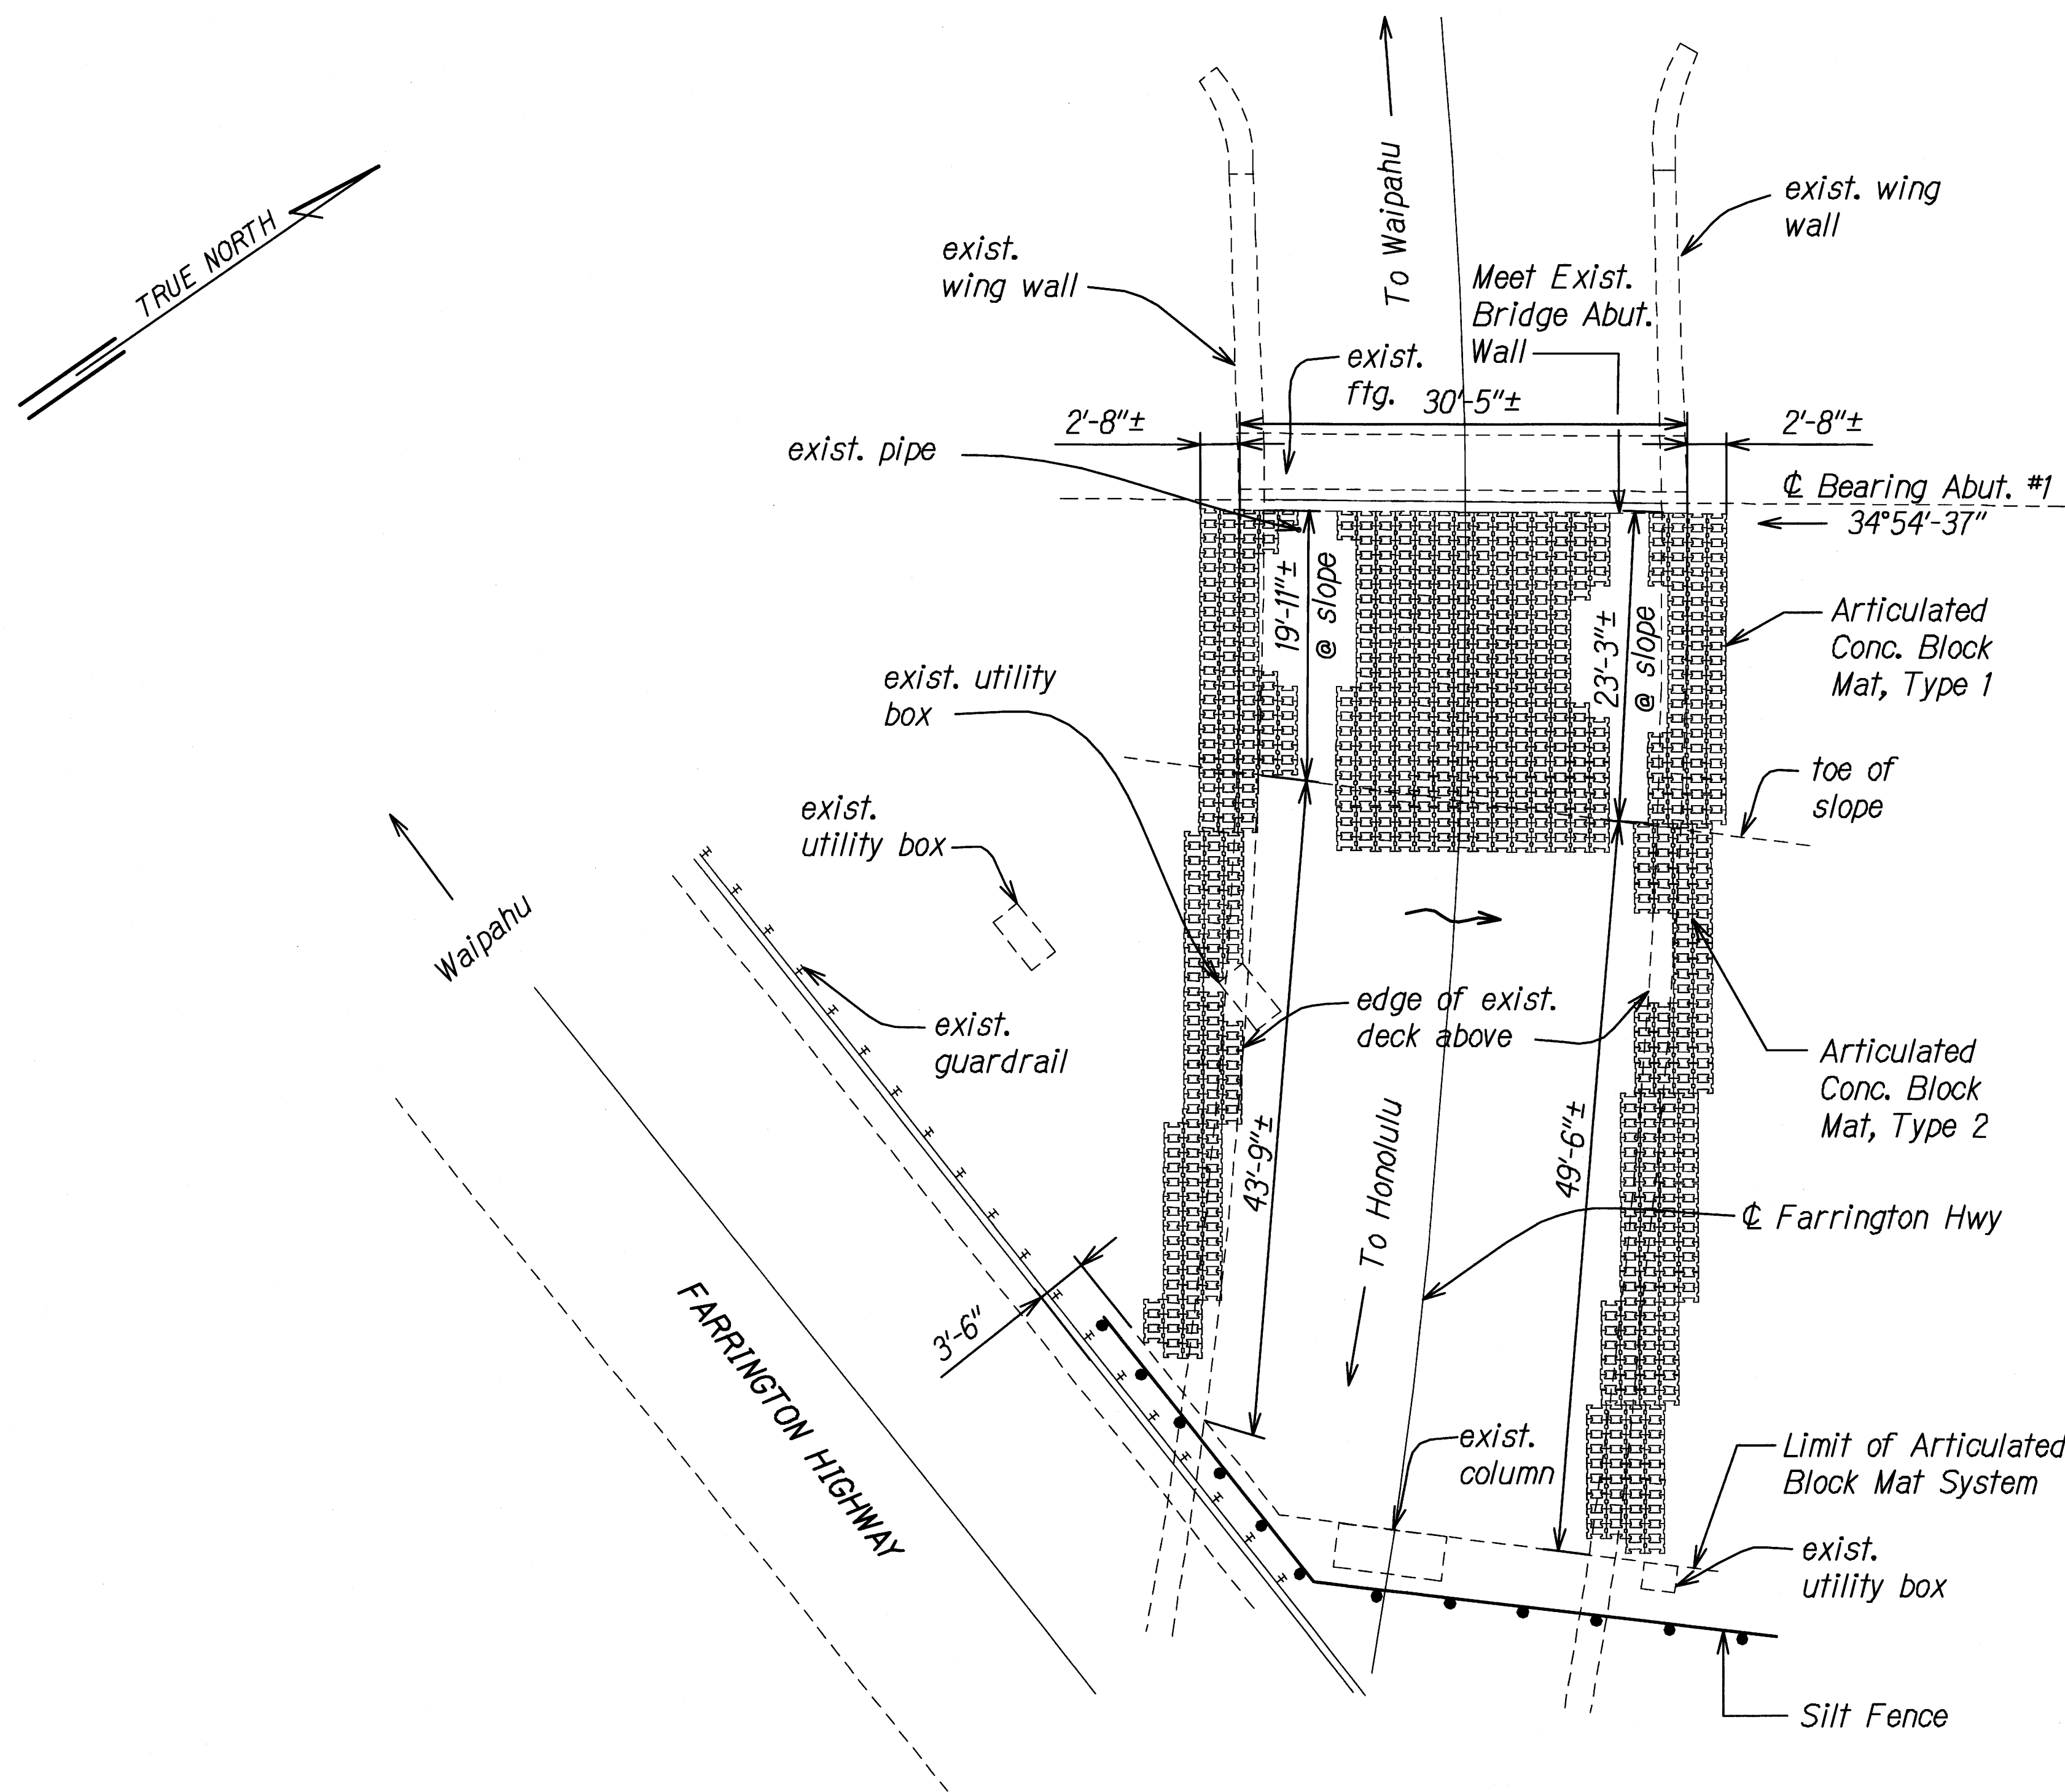


**EROSION CONTROL PLAN SITE 21 -
FARRINGTON HIGHWAY OVERPASS, NORTH ABUTMENT**
Scale: 1/8" = 1'-0"


Estimated Area of Articulated Concrete Mat Type 1 measured along slope face: 772 SQ. FT.
Estimated Area of Articulated Concrete Mat Type 2 measured along slope face: 1,667 SQ. FT

ORIGINAL PLAN	SURVEY PLOTTED BY	DATE
NOTE BOOK	DRAWN BY	
	CHECKED BY	
	DESIGNED BY	
	REVIEWED BY	


EC-35 SITE 21.DWG 1/12/2012 10:52 PM

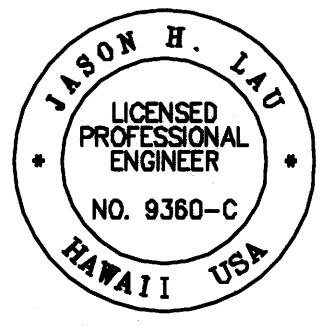 4/30/12 EXP. DATE This work was prepared by me or under my supervision.	STATE OF HAWAII DEPARTMENT OF TRANSPORTATION HIGHWAYS DIVISION <u>EROSION CONTROL PLAN</u> <u>SITE 21</u> SLOPE IMPROVEMENTS FOR EROSION CONTROL AT VARIOUS SITES ON OAHU, PHASE 5 Project No. HWY-O-01-12 Scale: 1/8" = 1' Date: April 2012
	SHEET No. EC-35 OF 50 SHEETS
	56

FED. ROAD DIST. NO.	STATE	PROJ. NO.	FISCAL YEAR	SHEET NO.	TOTAL SHEETS
HAWAII	HAW.	HWY-O-01-12	2012	57	123

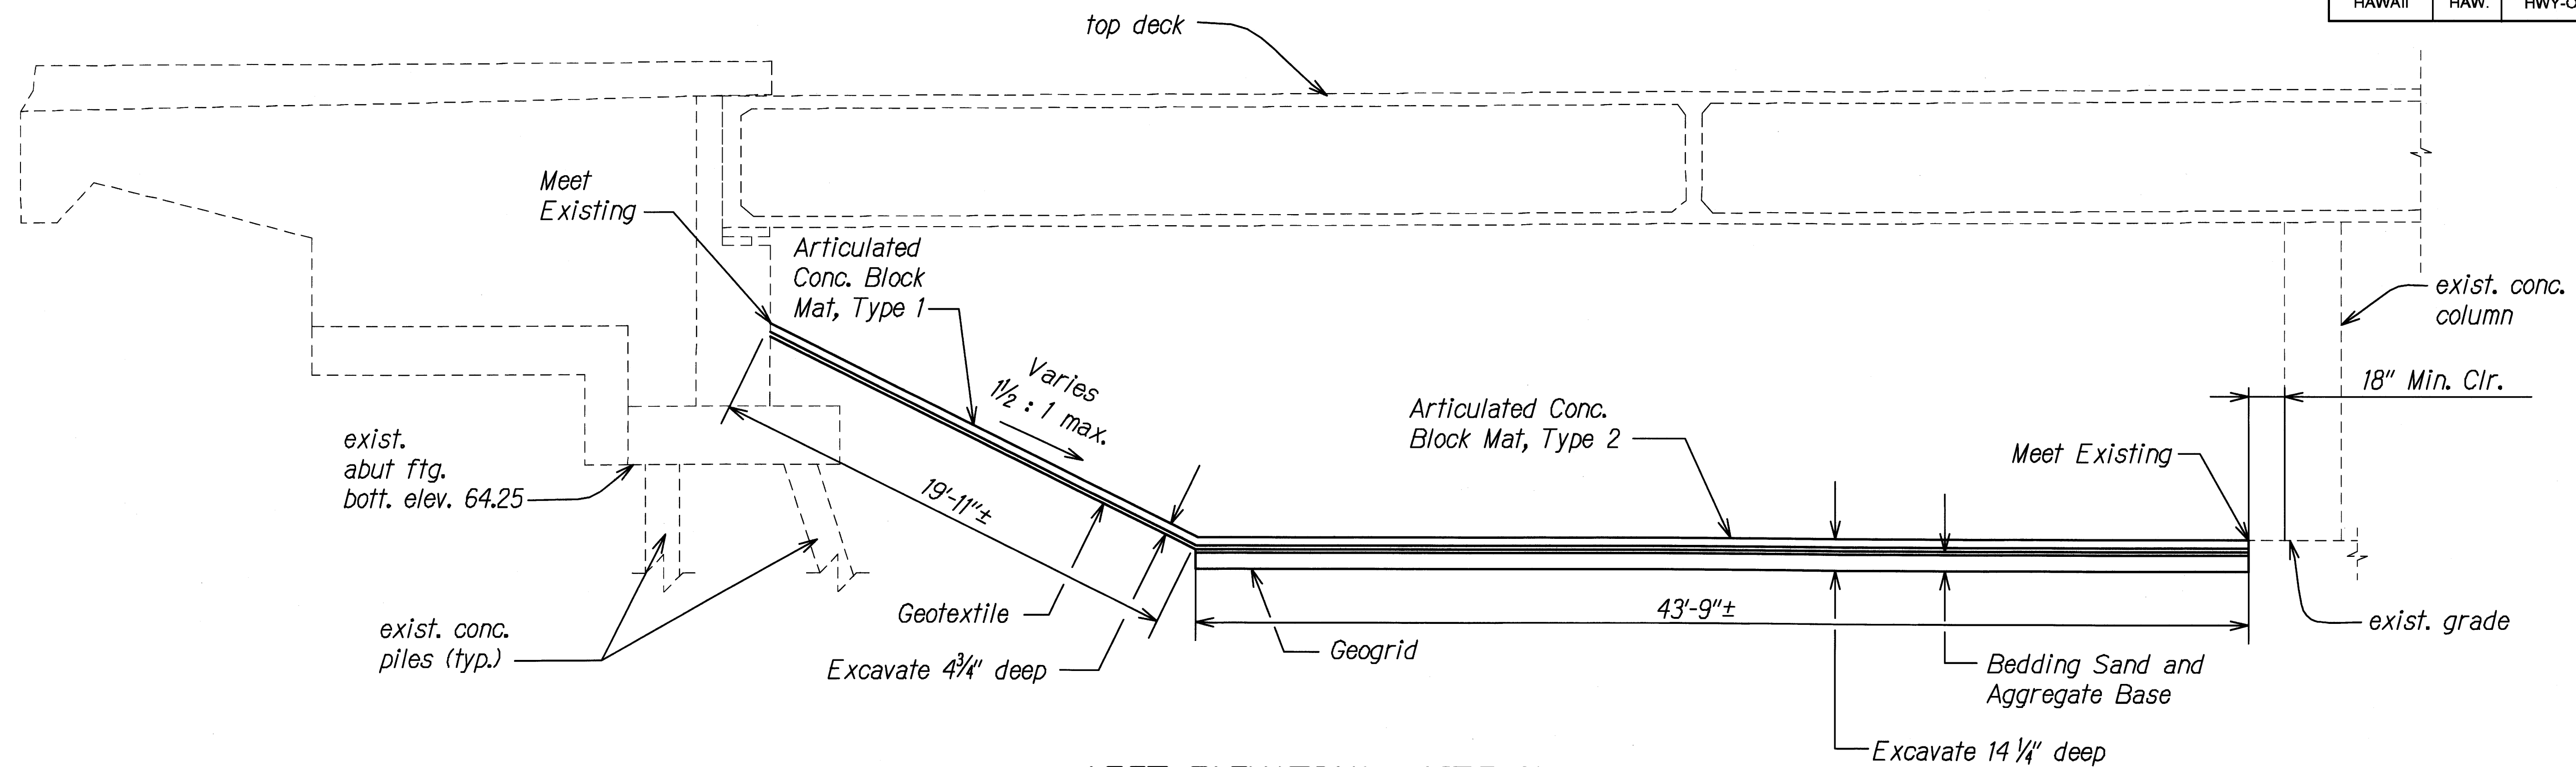


LEFT ELEVATION - SITE 21
Scale: 1/4" = 1'-0"

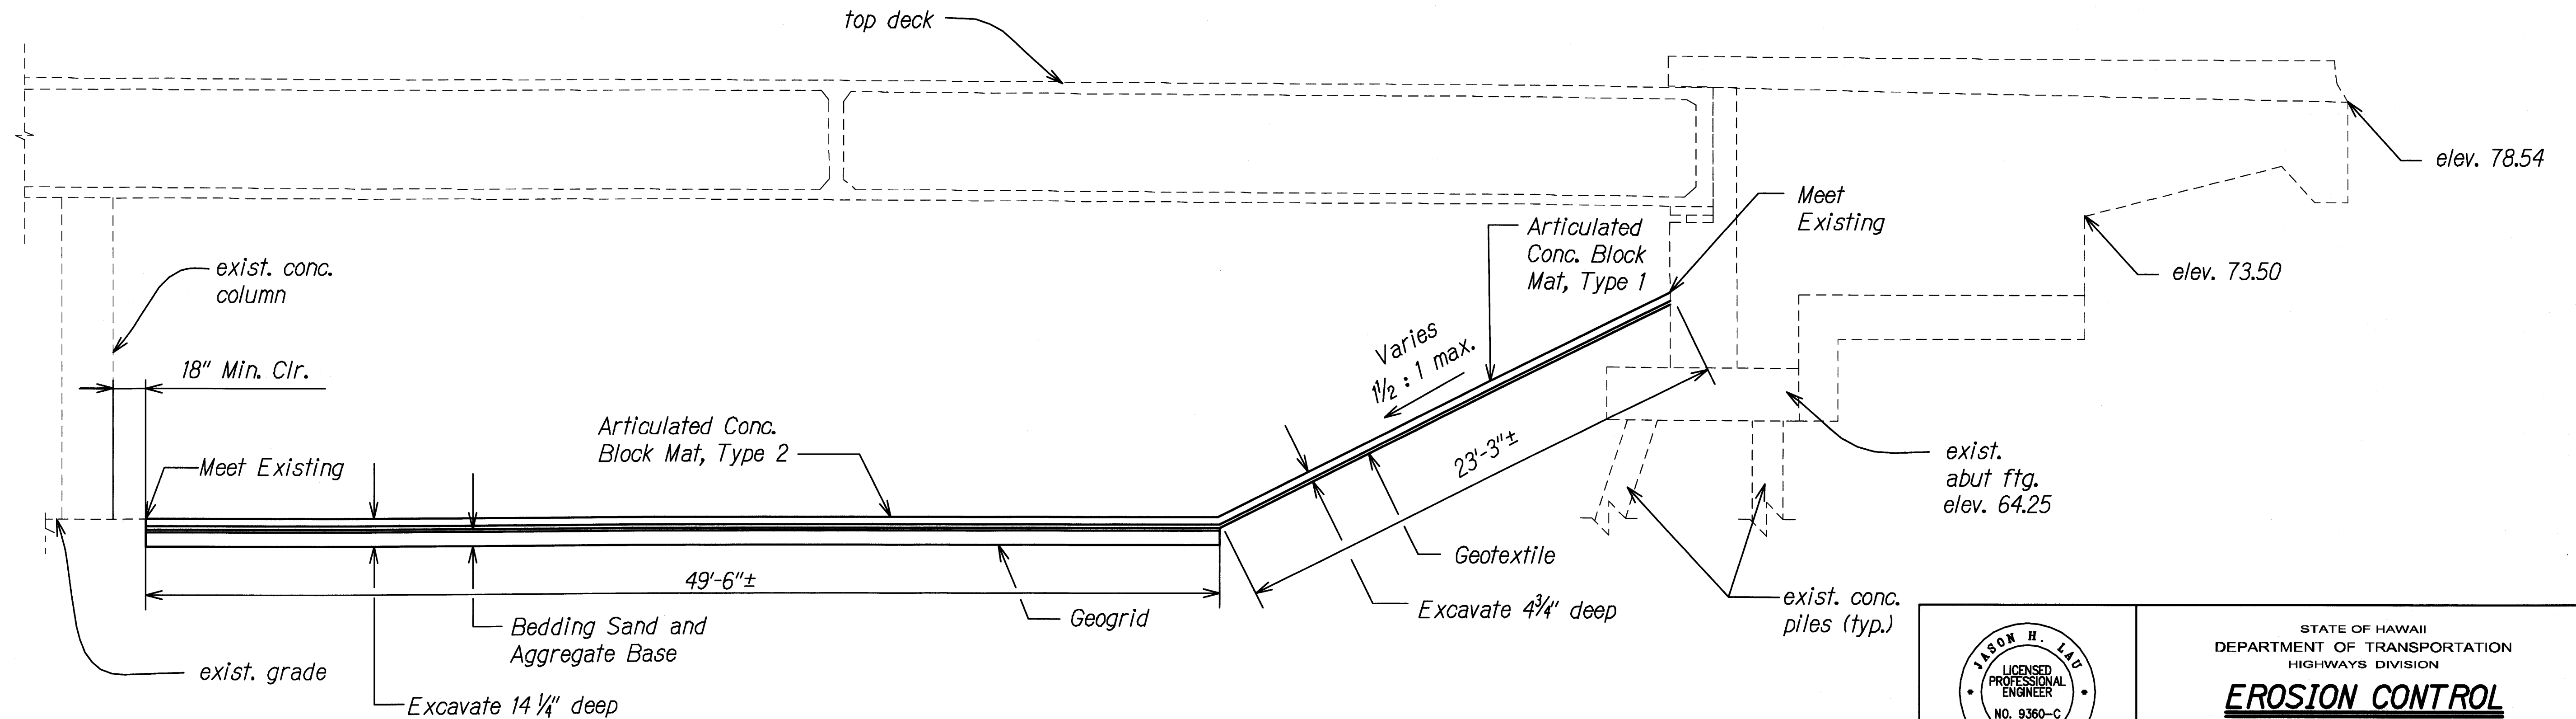

RIGHT ELEVATION - SITE 21
Scale: 1/4" = 1'-0"

ORIGINAL PLAN	SURVEY PLOTTED BY	DATE
TRACED BY	DRAWN BY	
NOTED BY	DESIGNED BY	
CHECKED BY	REVIEWED BY	

EEP-SITE 21.DWG 4/3/2012 8:50 AM

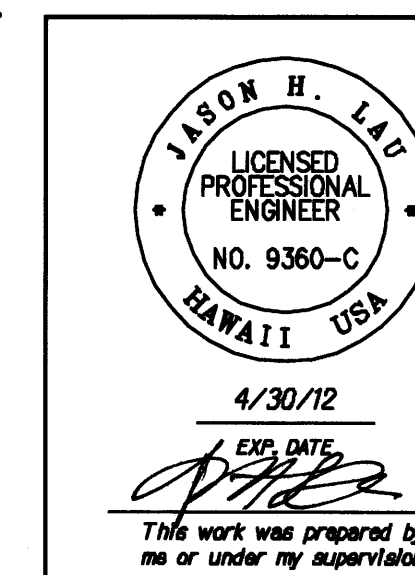

STATE OF HAWAII
DEPARTMENT OF TRANSPORTATION
HIGHWAYS DIVISION


**EROSION CONTROL
ELEVATION SITE 21**

SLOPE IMPROVEMENTS FOR EROSION CONTROL
AT VARIOUS SITES ON OAHU, PHASE 5

Project No. HWY-O-01-12
Scale: 1/4" = 1' Date: April 2012

SHEET No. EC-36 OF 50 SHEETS

FED. ROAD DIST. NO.	STATE	PROJ. NO.	FISCAL YEAR	SHEET NO.	TOTAL SHEETS
HAWAII	HAW.	HWY-O-01-12	2012	58	123

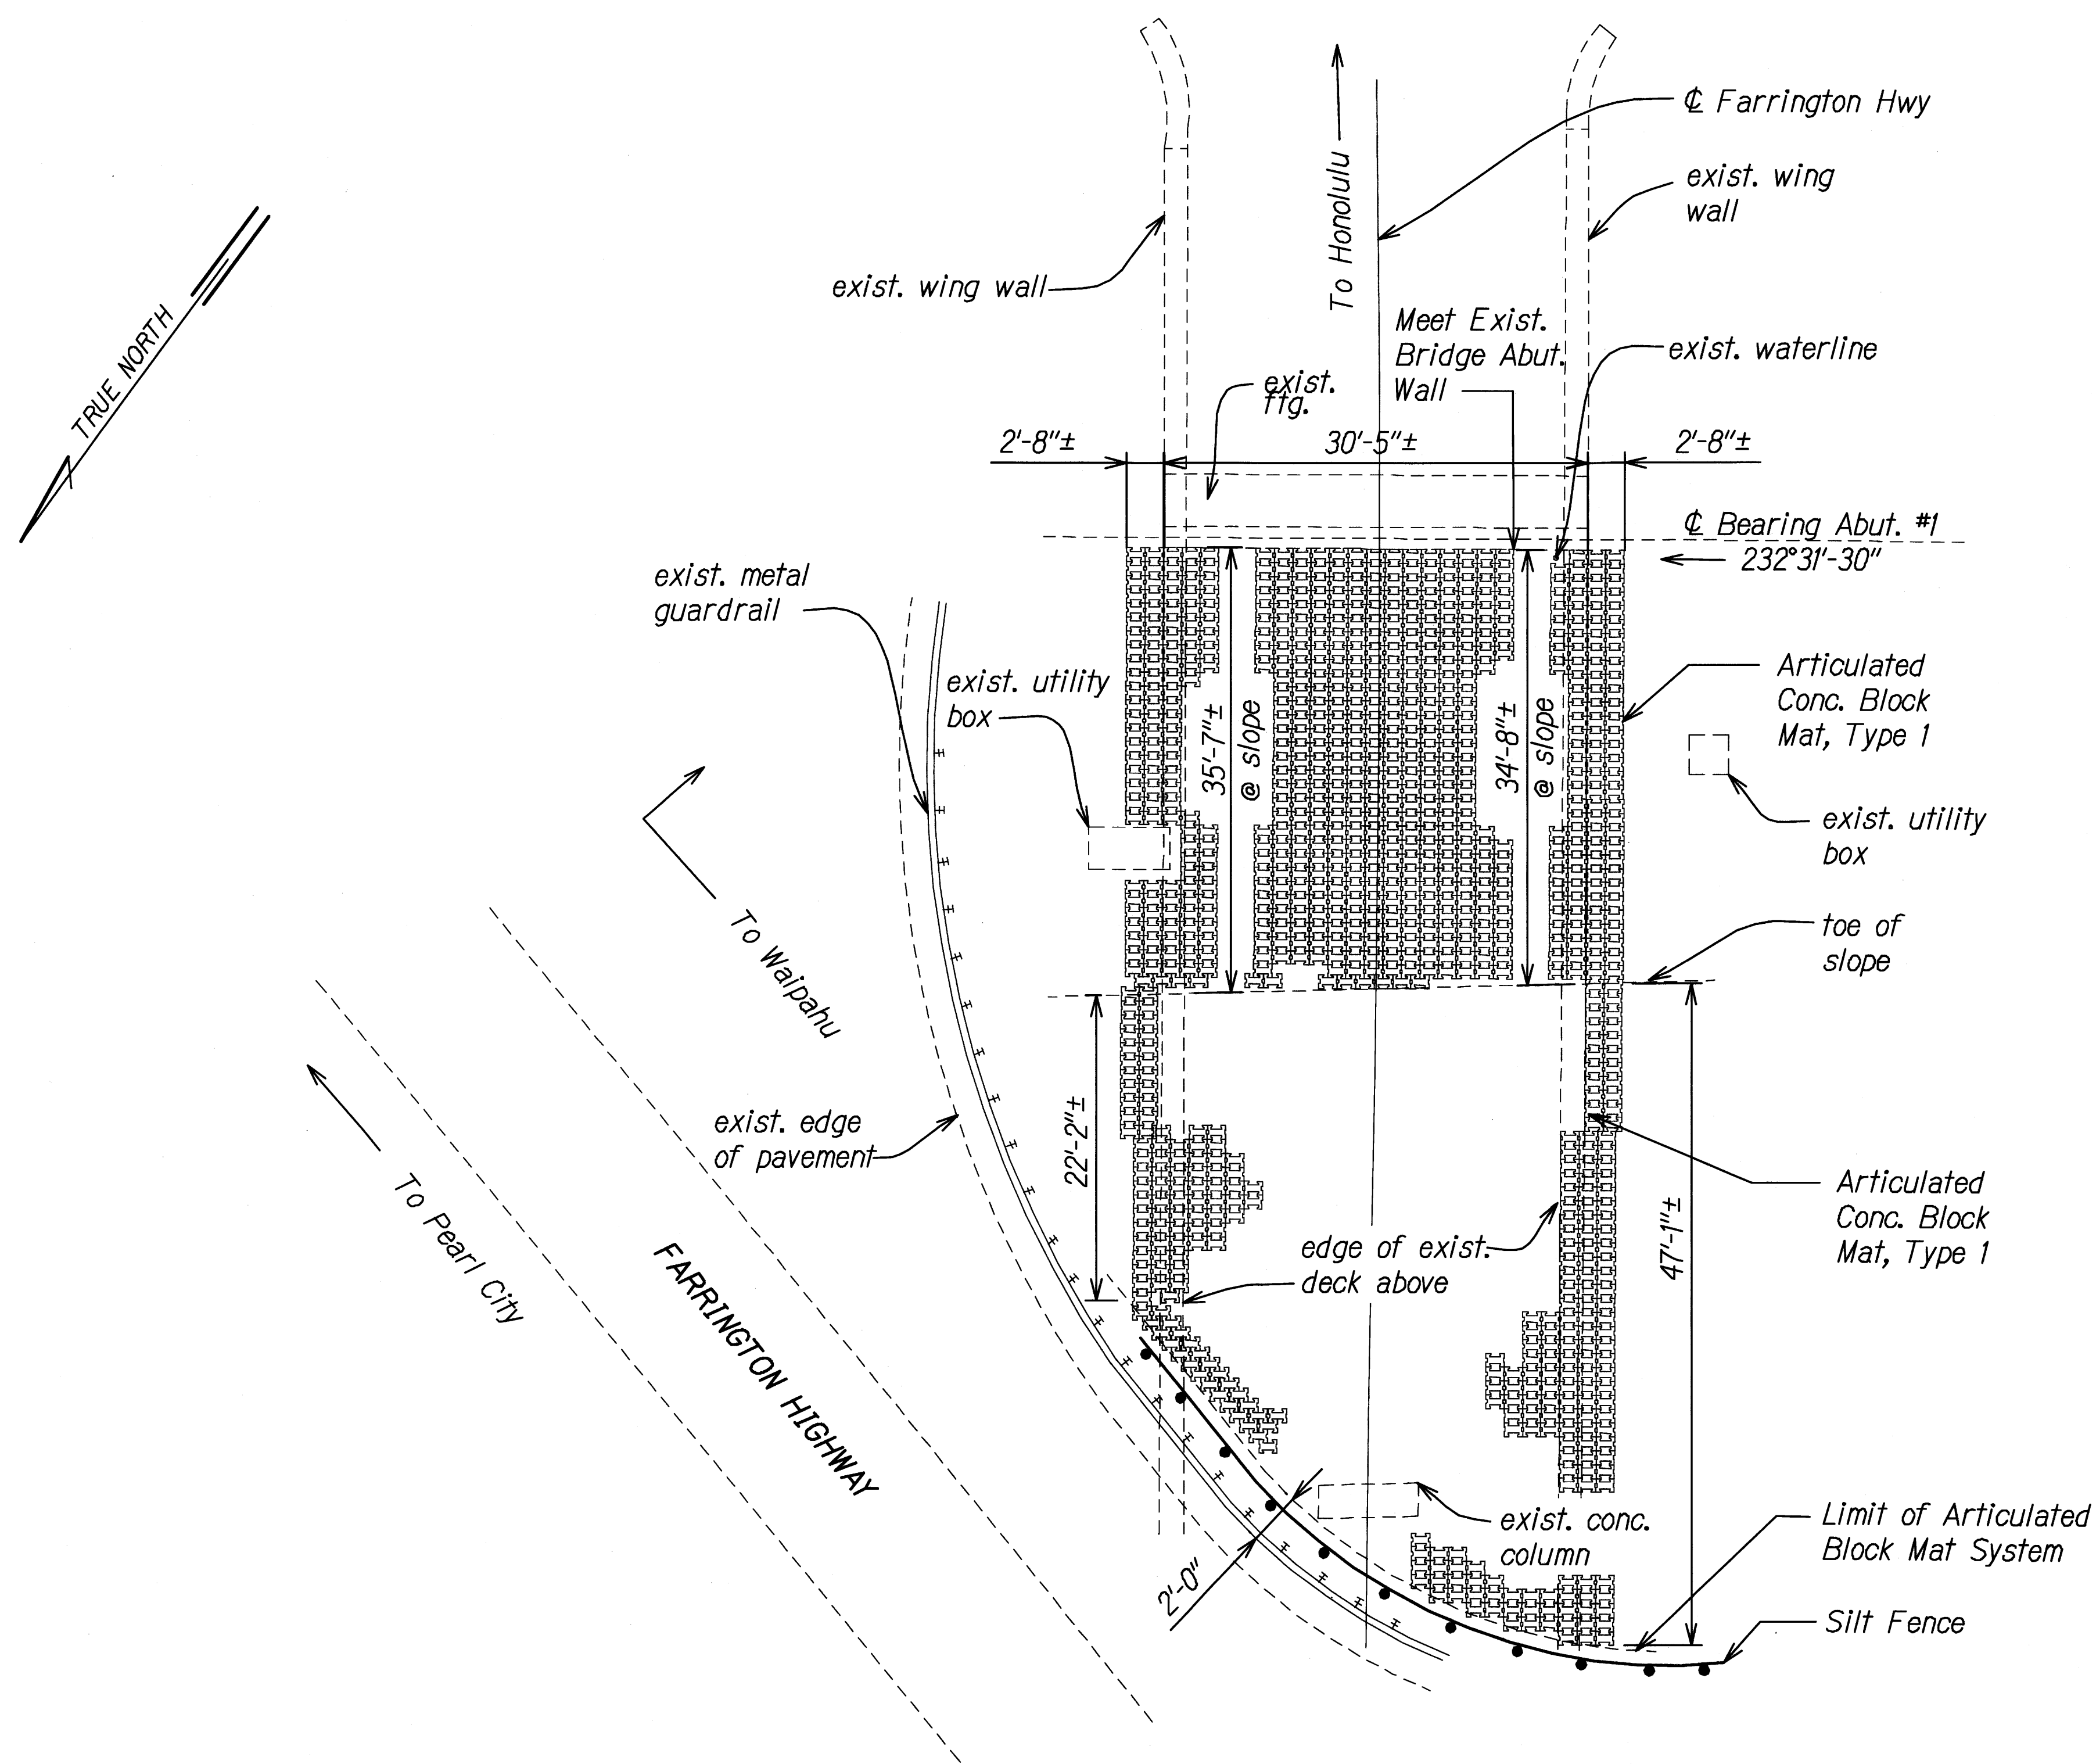

**EROSION CONTROL PLAN SITE 22 -
FARRINGTON HIGHWAY OVERPASS, EAST ABUTMENT**

Scale: 1/8" = 1'-0"


Estimated Area of Articulated Concrete Mat Type 1 measured along slope face: 2,494 SQ. FT.

4/30/12 EXP. DATE This work was prepared by me or under my supervision.	STATE OF HAWAII DEPARTMENT OF TRANSPORTATION HIGHWAYS DIVISION <u>EROSION CONTROL PLAN</u> <u>SITE 22</u> <u>SLOPE IMPROVEMENTS FOR EROSION CONTROL AT VARIOUS SITES ON OAHU, PHASE 5</u> <u>Project No. HWY-O-01-12</u> Scale: 1/8" = 1' Date: April 2012
	SHEET No. EC-37 OF 50 SHEETS
	58


SURVEY PLOTTED BY	DATE
DRAWN BY	
TRACED BY	
NOTE BOOK	
QUANTITIES BY	
CHECKED BY	
No.	

EC-37 SITE 22.DWG 1/9/2012 9:25:50 AM

FED. ROAD DIST. NO.	STATE	PROJ. NO.	FISCAL YEAR	SHEET NO.	TOTAL SHEETS
HAWAII	HAW.	HWY-O-01-12	2012	59	123

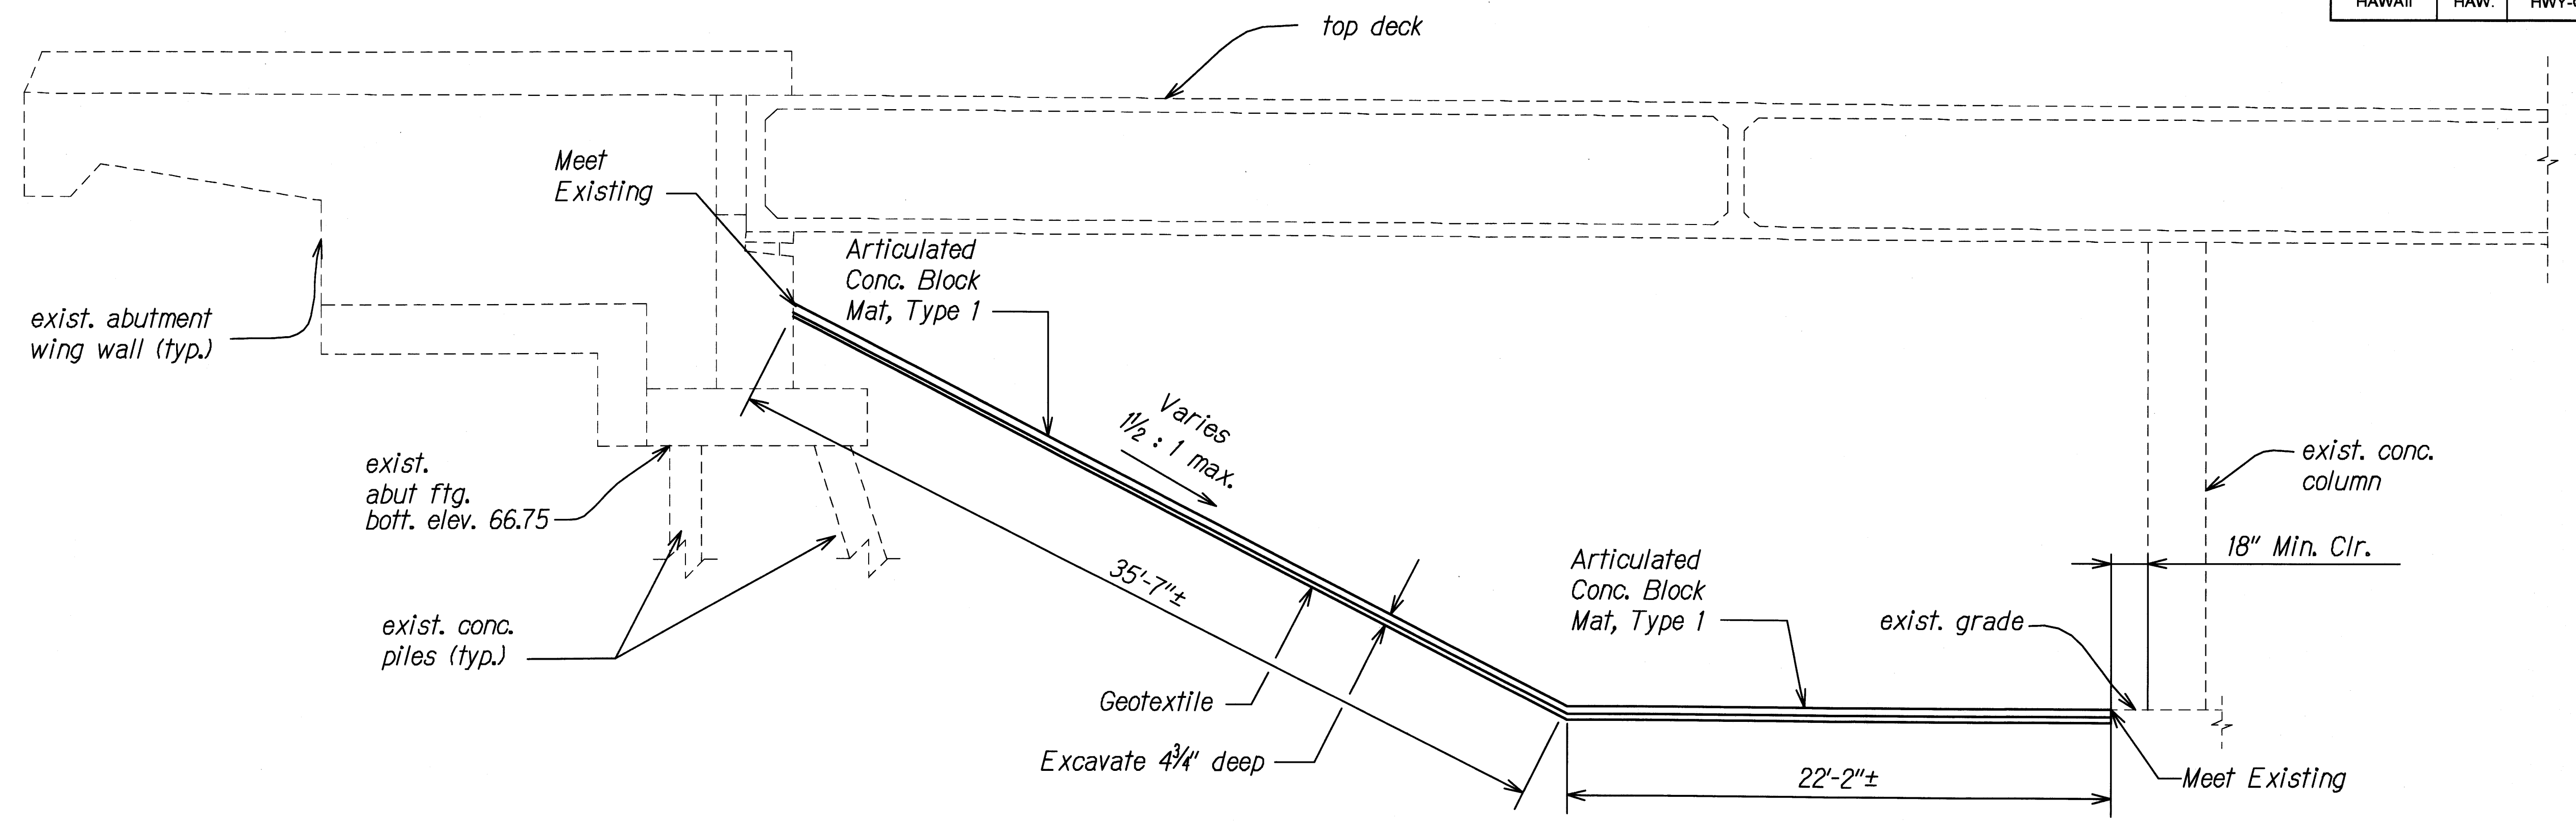

LEFT ELEVATION - SITE 22
Scale: 1/4" = 1'-0"

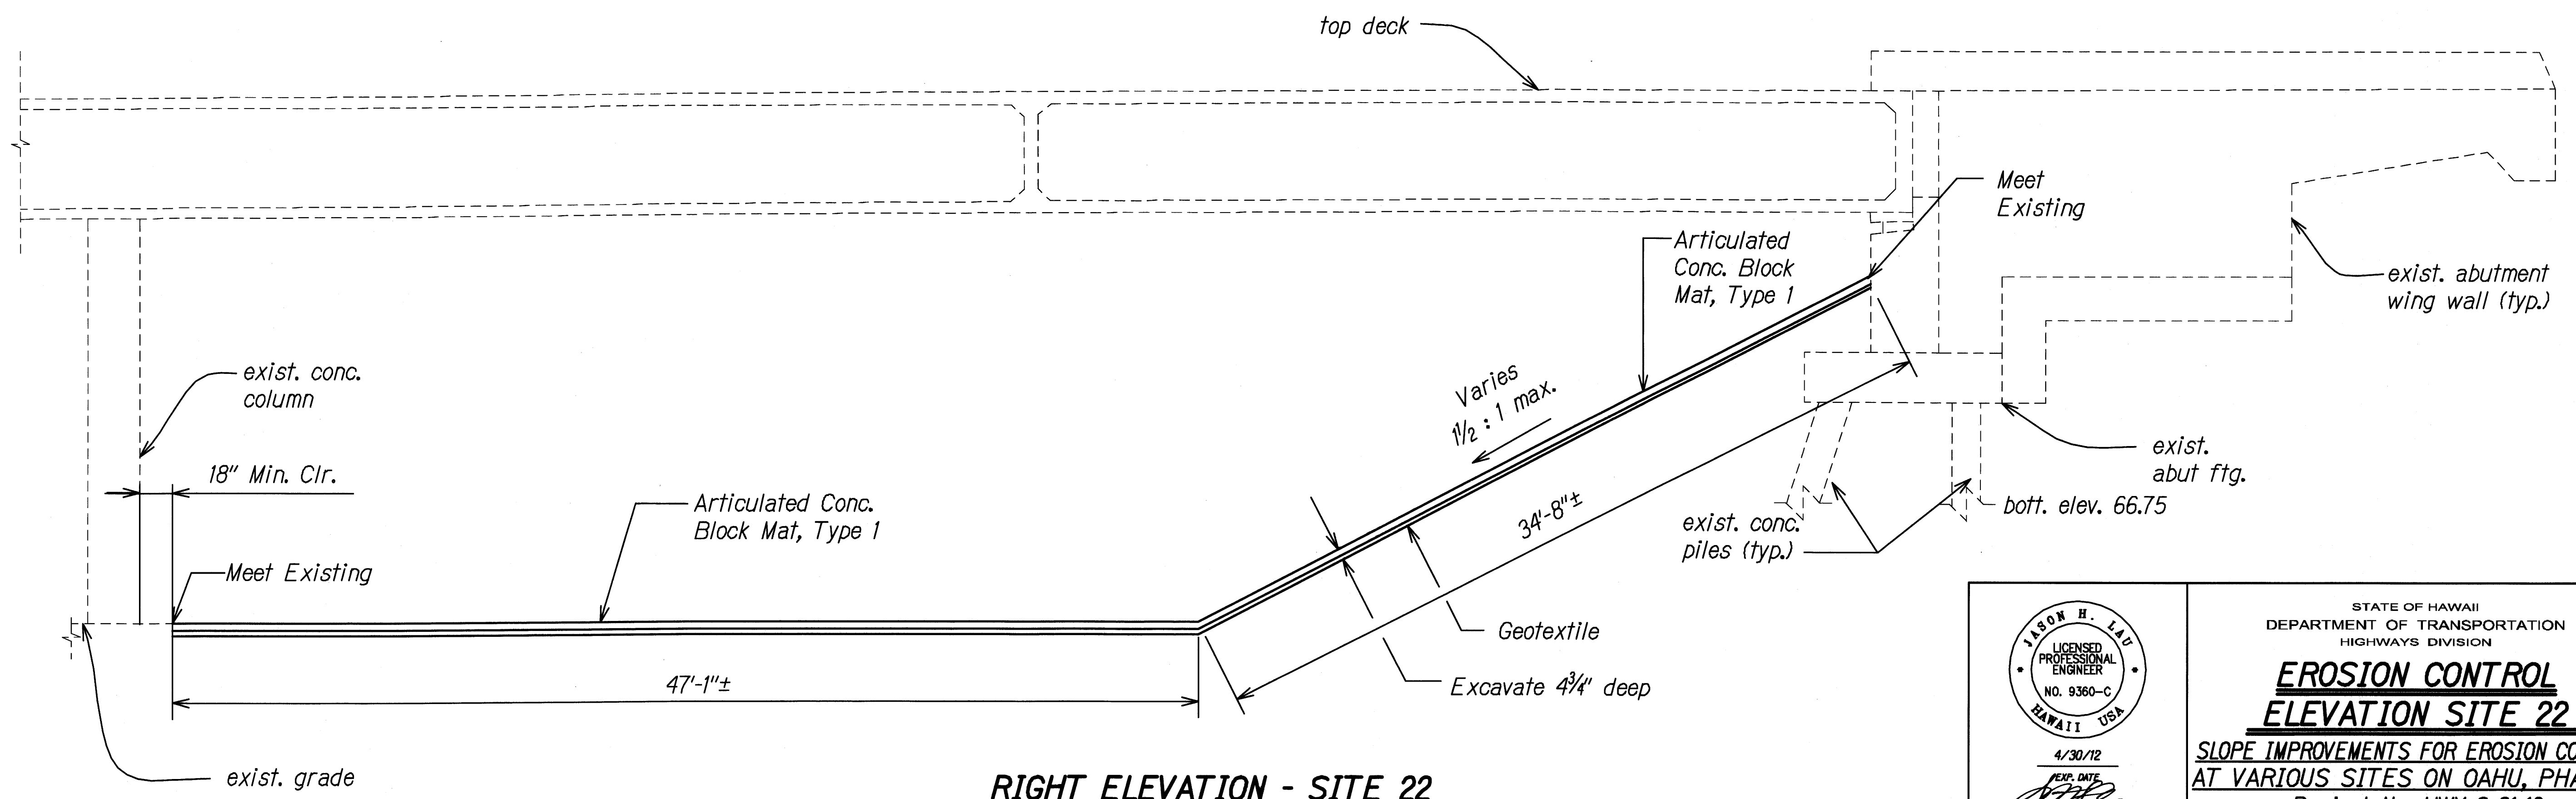

RIGHT ELEVATION - SITE 22
Scale: 1/4" = 1'-0"

SURVEY PLOTTED BY	DATE
DRAWN BY	
PLACED BY	
NOTED BY	
CHECKED BY	
NO.	

EC-38 SITE 22.DWG 4/2/2012 8:58 AM

STATE OF HAWAII
DEPARTMENT OF TRANSPORTATION
HIGHWAYS DIVISION

**EROSION CONTROL
ELEVATION SITE 22**

SLOPE IMPROVEMENTS FOR EROSION CONTROL
AT VARIOUS SITES ON OAHU, PHASE 5

Project No. HWY-O-01-12

Scale: 1/4" = 1' Date: April 2012

GENERAL

1. Workmanship and materials shall conform to the Hawaii Standard Specifications for Road & Bridge Construction (2005 Edition) & Special Provisions. However, where reference is made to performance conforming to other standards the more stringent shall apply.
2. The Contractor shall compare all the contract documents with each other and report in writing to the Engineer all inconsistencies and omissions.
3. The Contractor shall take field measurements and verify field conditions and shall compare such field measurements and conditions with the drawings before commencing work. Report in writing to the Engineer all inconsistencies and omissions.
4. The Contractor shall be responsible for methods of construction, workmanship and job safety. The Contractor shall provide temporary shoring and bracing as required for stability of structural members and systems.
5. The Contractor shall be responsible for protection of the adjacent properties, structures, streets and utilities during the construction period.
6. Details noted as typical on the Structural drawings shall apply in all conditions unless specifically shown or noted.
7. The General Contractor and his subcontractors must submit in writing any requests for modifications to the plans and specifications.

DESIGN CRITERIA

1. Retaining wall design criteria
 - a. Allowable foundation bearing,
Dead load + Live load _____ 3000 psf
 - b. Coefficient of friction _____ 0.4
 - c. Active earth pressure _____ 40 pcf level backfill,
50 pcf sloping
 - d. Passive earth pressure: _____ 300 pcf

FOUNDATION

- A. Foundation design is based on Geotechnical Investigation by Hirata & Associates, Inc. and report dated November 7, 2011.
- B. Contractor shall provide for de-watering of excavation from surface water, ground water or seepage.
- C. Contractor shall provide for design and installation of all cribbing, sheeting, and shoring necessary to preserve excavations and earth banks.
- D. The project site shall be cleared of all vegetation, pipe and CRM headwall debris, and other deleterious materials. In areas requiring fill placement, the exposed subgrade shall be scarified to a minimum depth of 6 inches, moisture conditioned to about 2 percent above optimum moisture content, and compacted to between 90 and 95 percent compaction as determined by ASTM D 1557.
- E. Contractor shall conform to all OSHA safety standards for excavations.

FOUNDATION (CONT)

- F. The onsite clayey silt will be acceptable for reuse in backfills and structural fills, except in the imported granular fill section below foundations. All rock fragments larger than 3 inches in maximum dimension should be removed from the onsite clayey silt prior to reuse.
- G. Imported structural fill shall be well-graded, non expansive granular material. Specifications for imported granular fill shall indicate a maximum particle size of 3 inches, and state that between 8 and 20 percent of soil by weight shall pass the #200 sieve. In addition, the plasticity index (P.I.) of that portion of the soil passing the #40 sieve shall not be greater than 10. Imported structural fill shall have a CBR expansion value no greater than 1.0 percent and a minimum CBR value of 15 percent, when tested in accordance with ASTM D 1883.
- H. Cohesive soils, such as the onsite clayey silt, shall be placed in horizontal lifts restricted to 8 inches in loose thickness and compacted to between 90 and 95 percent compaction as determined by ASTM D 1557. Granular fill, such as imported granular structural fill, shall also be placed in horizontal lifts restricted to eight inches in loose thickness, but compacted to at least 95 percent compaction as determined by ASTM D 1557.
- I. Fill areas which slope steeper than 5h:1v shall be continually benched as the fill is brought up in lifts. Fill placed on slopes shall be keyed and benched into the existing slope to provide stability for the new fill against sliding. Filling the slope with sliver fills shall be avoided.

CONCRETE

1. Concrete construction workmanship & materials shall conform to the Hawaii Standard Specifications for Road & Bridge Construction (2005 Edition) & Special Provisions & the American Concrete Institute ACI 318R, whichever is more stringent.
2. Concrete shall be regular weight hard rock concrete and shall have the following minimum 28 day compressive strengths:
 - a. Footings _____ 3,000 psi
 - b. Walls _____ 4,000 psi
 - c. All other concrete _____ 3,000 psi
3. Concrete delivery tickets shall record all free water in the mix: at batching by plant, for consistency by driver, and any additional request by contractor if permitted by the mix design.
4. All inserts, anchor bolts, plates, and other items to be cast in the concrete shall be hot-dipped galvanized unless otherwise noted.
5. Reinforcing bars, anchor bolts, inserts, and other items to be cast in the concrete shall be secured in position prior to placement of concrete.
6. The Contractor shall locate construction joints so as not to impair the strength of the structure and to minimize shrinkage stresses. Submit location of construction joints to the Engineer for approval, unless otherwise noted.
7. The Engineer shall be notified at least 3 working days prior to any concrete pour. No concrete shall be poured prior to observation by the Engineer or his representative.


FED. ROAD DIST. NO.	STATE	PROJ. NO.	FISCAL YEAR	SHEET NO.	TOTAL SHEETS
HAWAII	HAW.	HWY-O-01-12	2012	60	123

REINFORCING STEEL

1. Reinforcing Steel shall be deformed bars conforming to ASTM A615, Grade 60.
2. Clear concrete cover for reinforcing bars shall be as follows, unless otherwise noted:
 - a. Footings, etc. cast against earth _____ 3"
 - b. Footings, etc. formed and exposed to earth or weather _____ 2"
 - c. Walls
 1. Faces exposed to earth or weather
#5 bars and smaller _____ 2"
#6 bars and larger _____ 2"
3. Reinforcing Steel shall be spliced where indicated on plans. Provide lap splice length per typical details and schedule, unless otherwise noted.
4. Bar laps shall be made away from points of maximum stress. Unless noted otherwise, splices, laps, dowel extensions and embedments shall be 48 bar diameters, but not less than 24 inches. Splices shall be staggered where possible.
5. Unless otherwise noted, all horizontal reinforcing steel at wall and wall footing corners and intersections shall extend to the far face of the corner and hooked a length of 48 bar diameters, but not less than 24 inches, around the corner.
6. Bar bends and hooks shall be "Standard Hooks" in accordance with AASHTO LRFD Bridge Design Specifications, Second Edition, Article 5.10.2- Hooks and Bends.


SPECIAL INSPECTION

1. The Contractor shall be responsible for ensuring that special inspection of portions of the work as made at the appropriate time. The Contractor shall give timely notice of when and where inspections are to be made and provide access for the Inspector. The Contractor shall correct defective work at no additional cost to the owner.
2. The following Structural work requires Special Inspection:
 - a. Concrete
 - b. Reinforcing steel

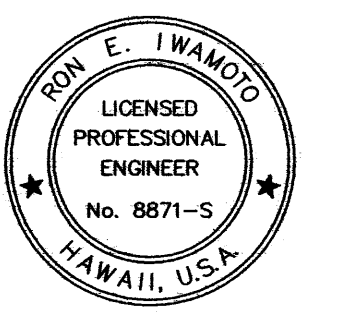
 4/30/14 EXP. DATE This work was prepared by me or under my supervision.	STATE OF HAWAII DEPARTMENT OF TRANSPORTATION HIGHWAYS DIVISION SITE 14 - STRUCTURAL NOTES SLOPE IMPROVEMENTS FOR EROSION CONTROL AT VARIOUS SITES ON OAHU, PHASE 5 Project No. HWY-O-01-12 Scale: None Date: April 2012
--	---

SHEET No. EC-39 OF 50 SHEETS

FED. ROAD DIST. NO.	STATE	PROJ. NO.	FISCAL YEAR	SHEET NO.	TOTAL SHEETS
HAWAII	HAW.	HWY-O-01-12	2012	61	123

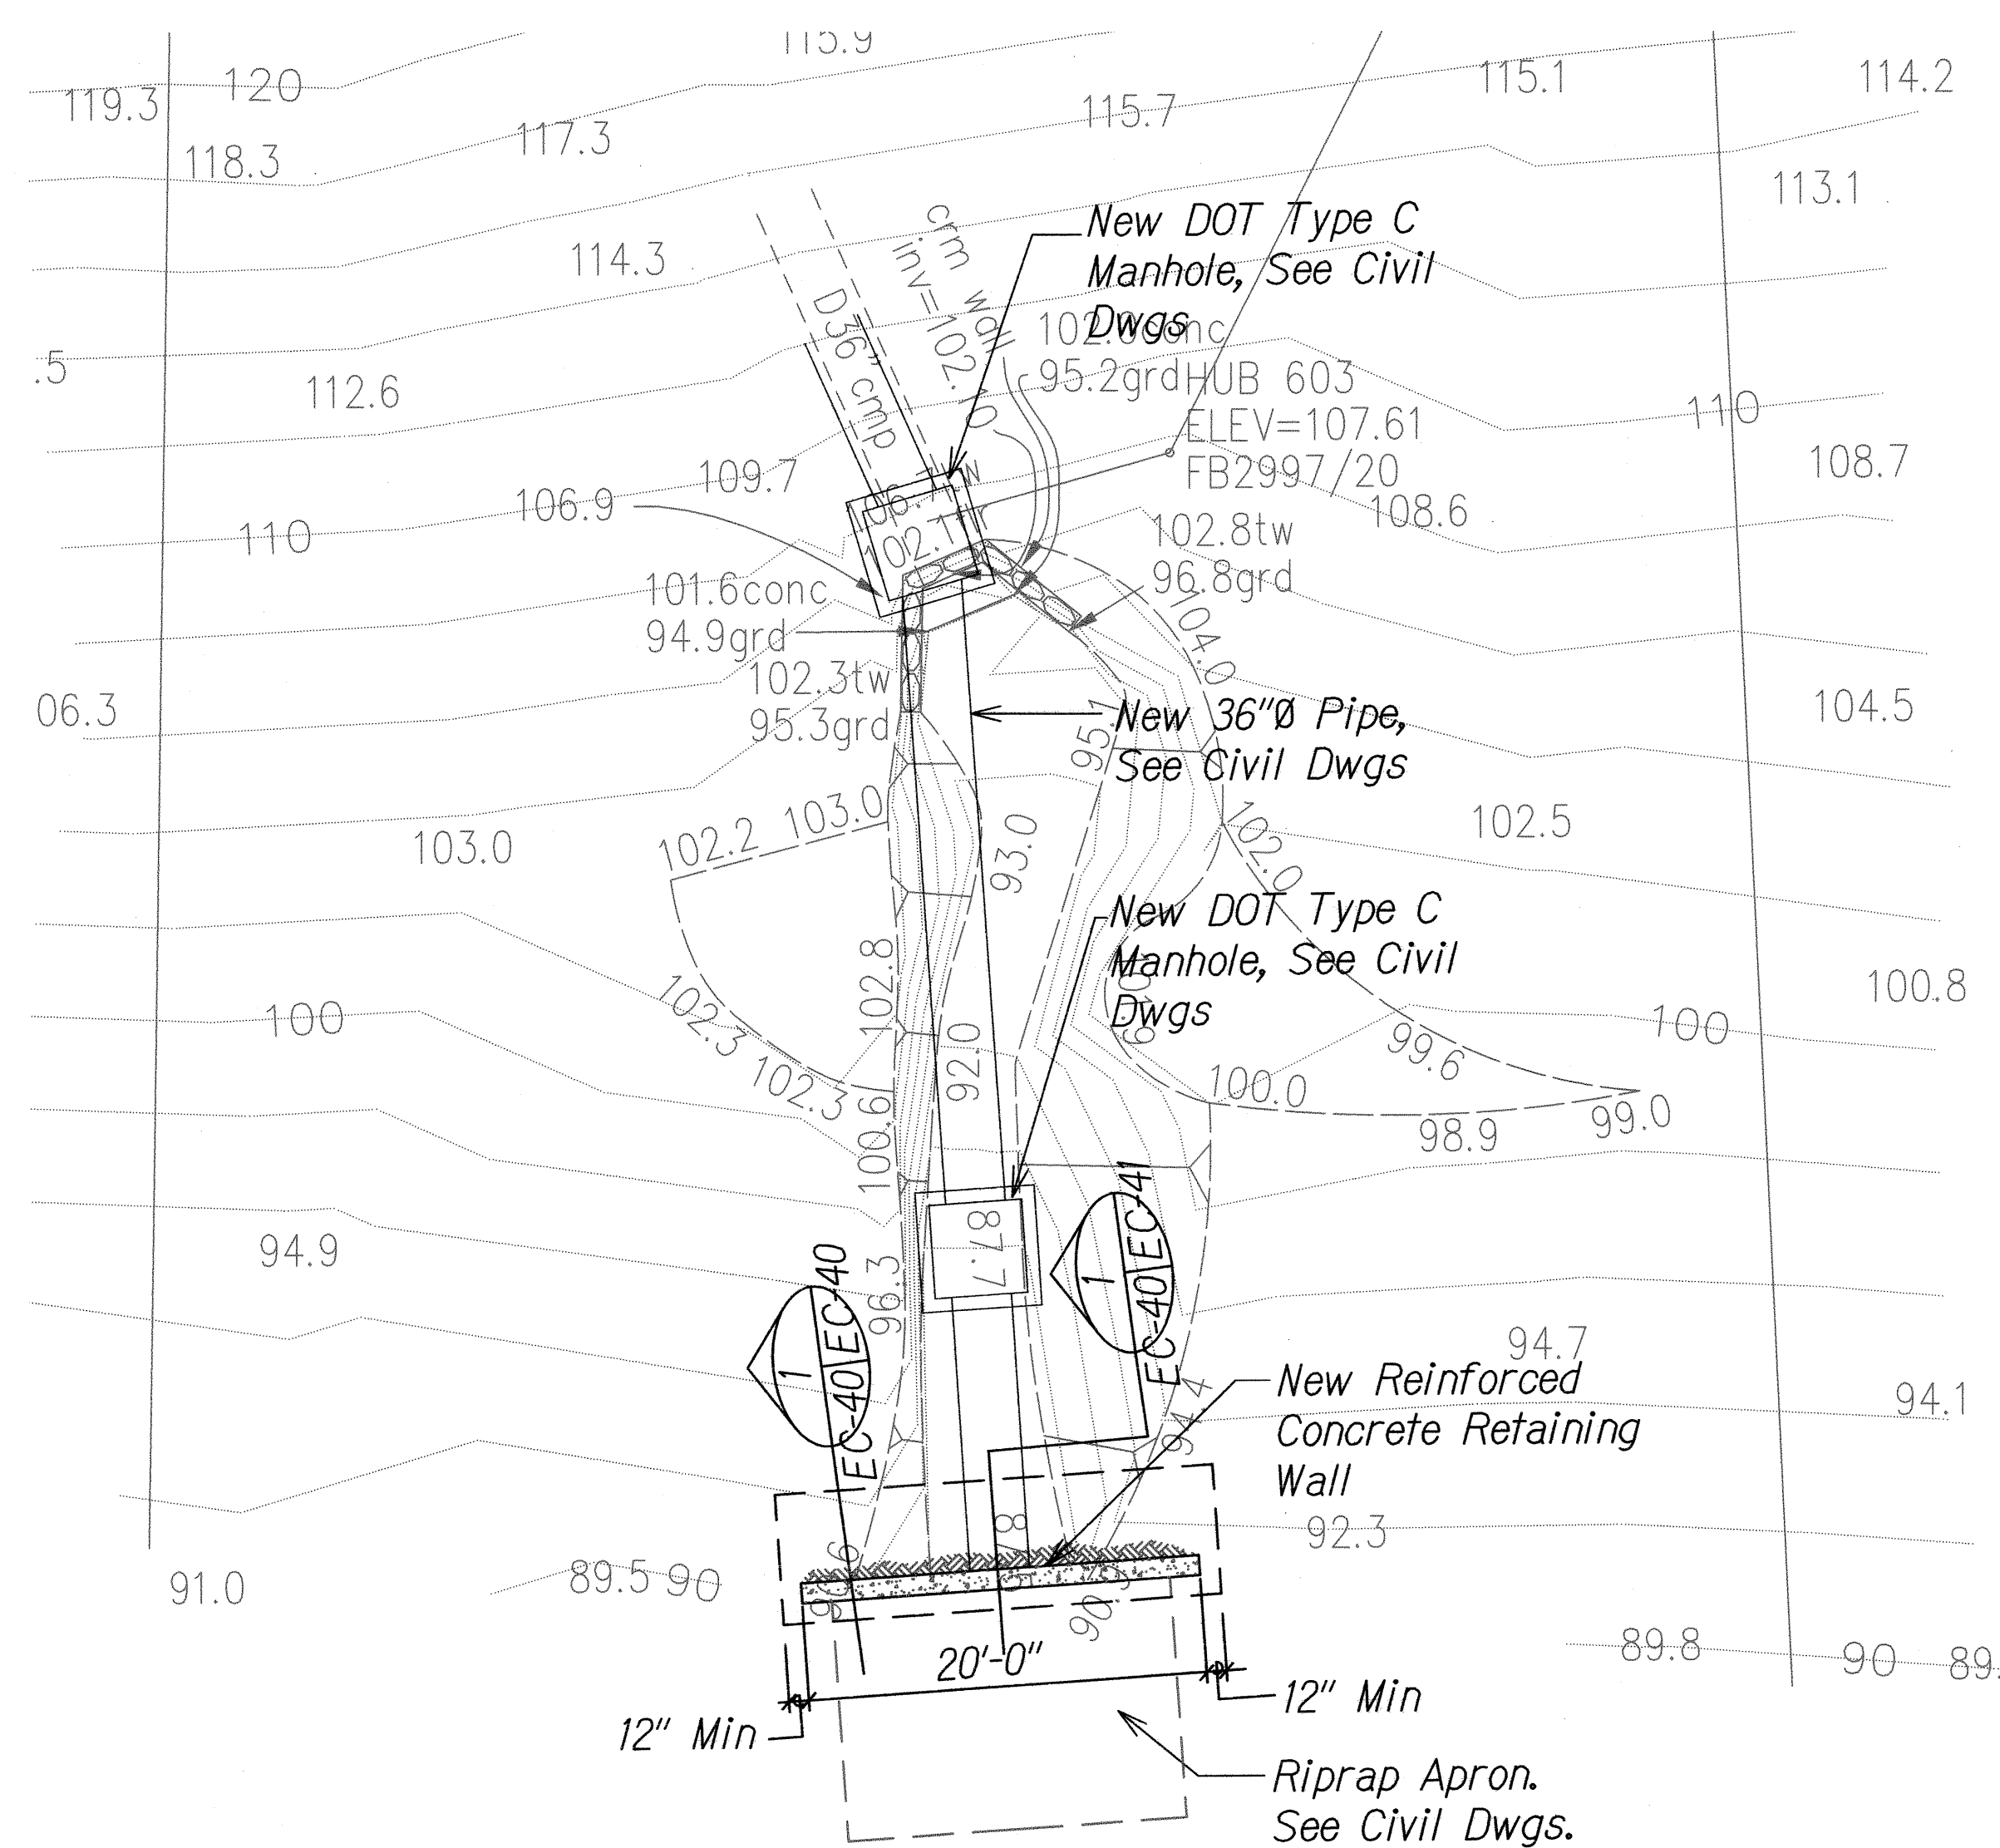

FOUNDATION PLAN
Scale: 1/8"=1'-0"

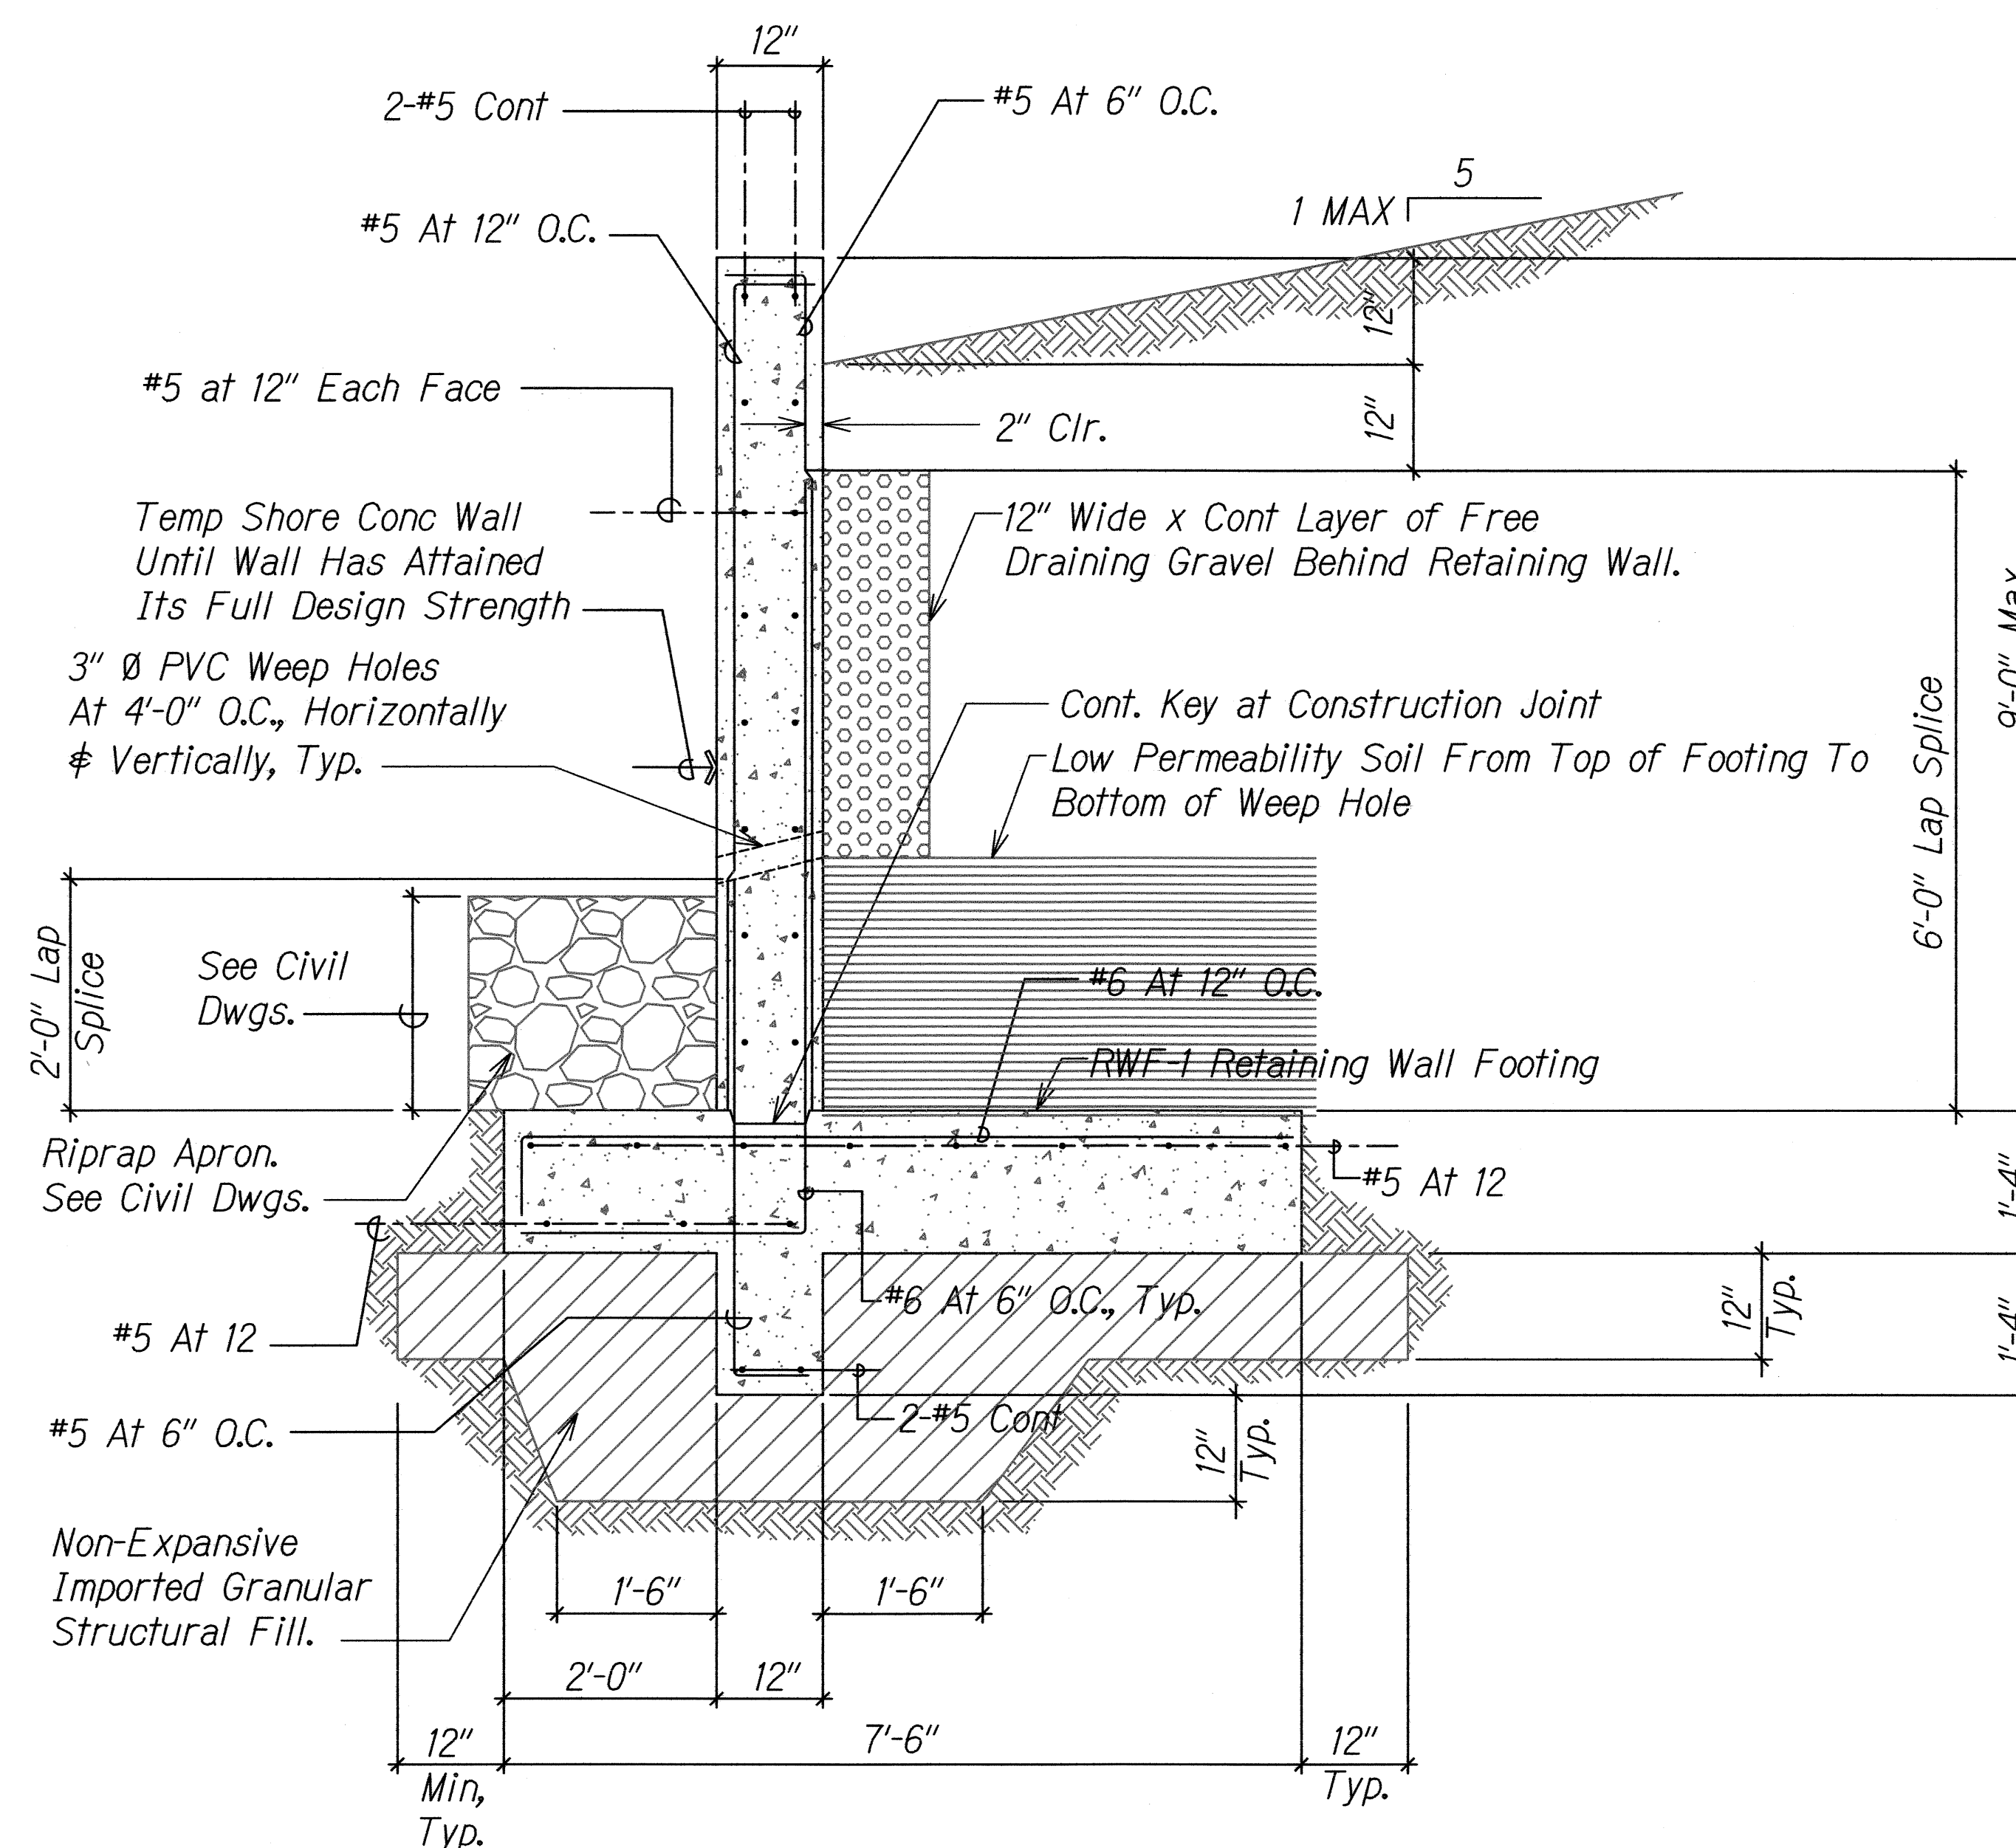

SECTION
Scale: 3/4" = 1'

ORIGINAL PLAN	SURVEY PLOTTED BY	DATE
NOTE BOOK	DRAWN BY	
	DESIGNED BY	
	CHECKED BY	

4-ECR-072WG 1/4/2012 6:46:07 PM

4/30/14
EXP. DATE
This work was prepared by me or under my supervision.

STATE OF HAWAII
DEPARTMENT OF TRANSPORTATION
HIGHWAYS DIVISION


**SITE 14 - STRUCTURAL
PLAN & SECTION**

SLOPE IMPROVEMENTS FOR EROSION CONTROL
AT VARIOUS SITES ON OAHU, PHASE 5



Project No. HWY-O-01-12
Date: April 2012

Scale: As Shown



FED. ROAD DIST. NO.	STATE	PROJ. NO.	FISCAL YEAR	SHEET NO.	TOTAL SHEETS
HAWAII	HAW.	HWY-O-01-12	2012	63	123

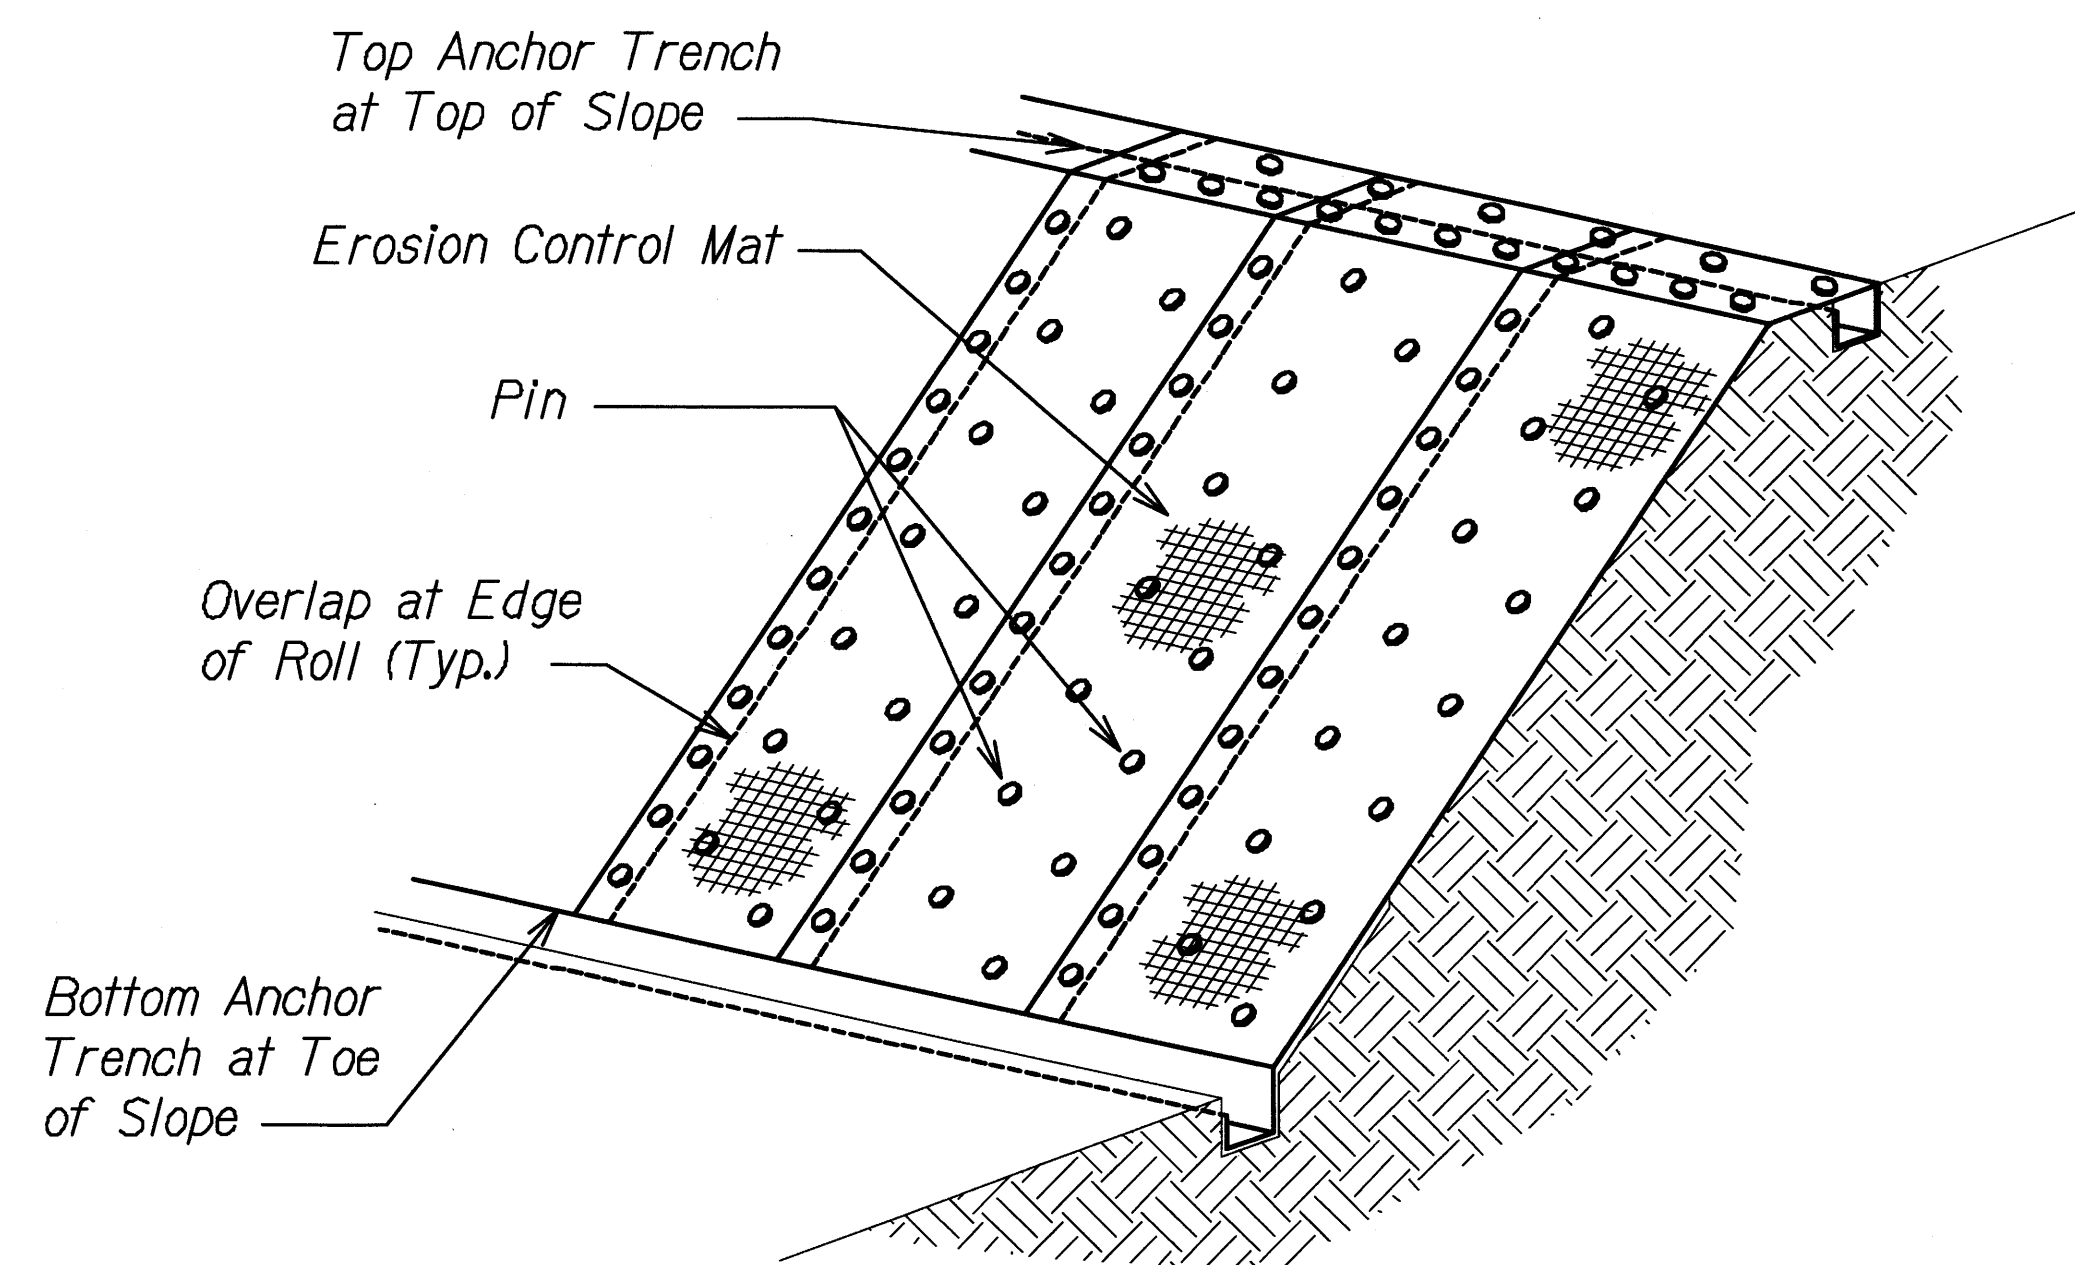



OVERVIEW OF EROSION CONTROL MATTING SYSTEM
Scale: None

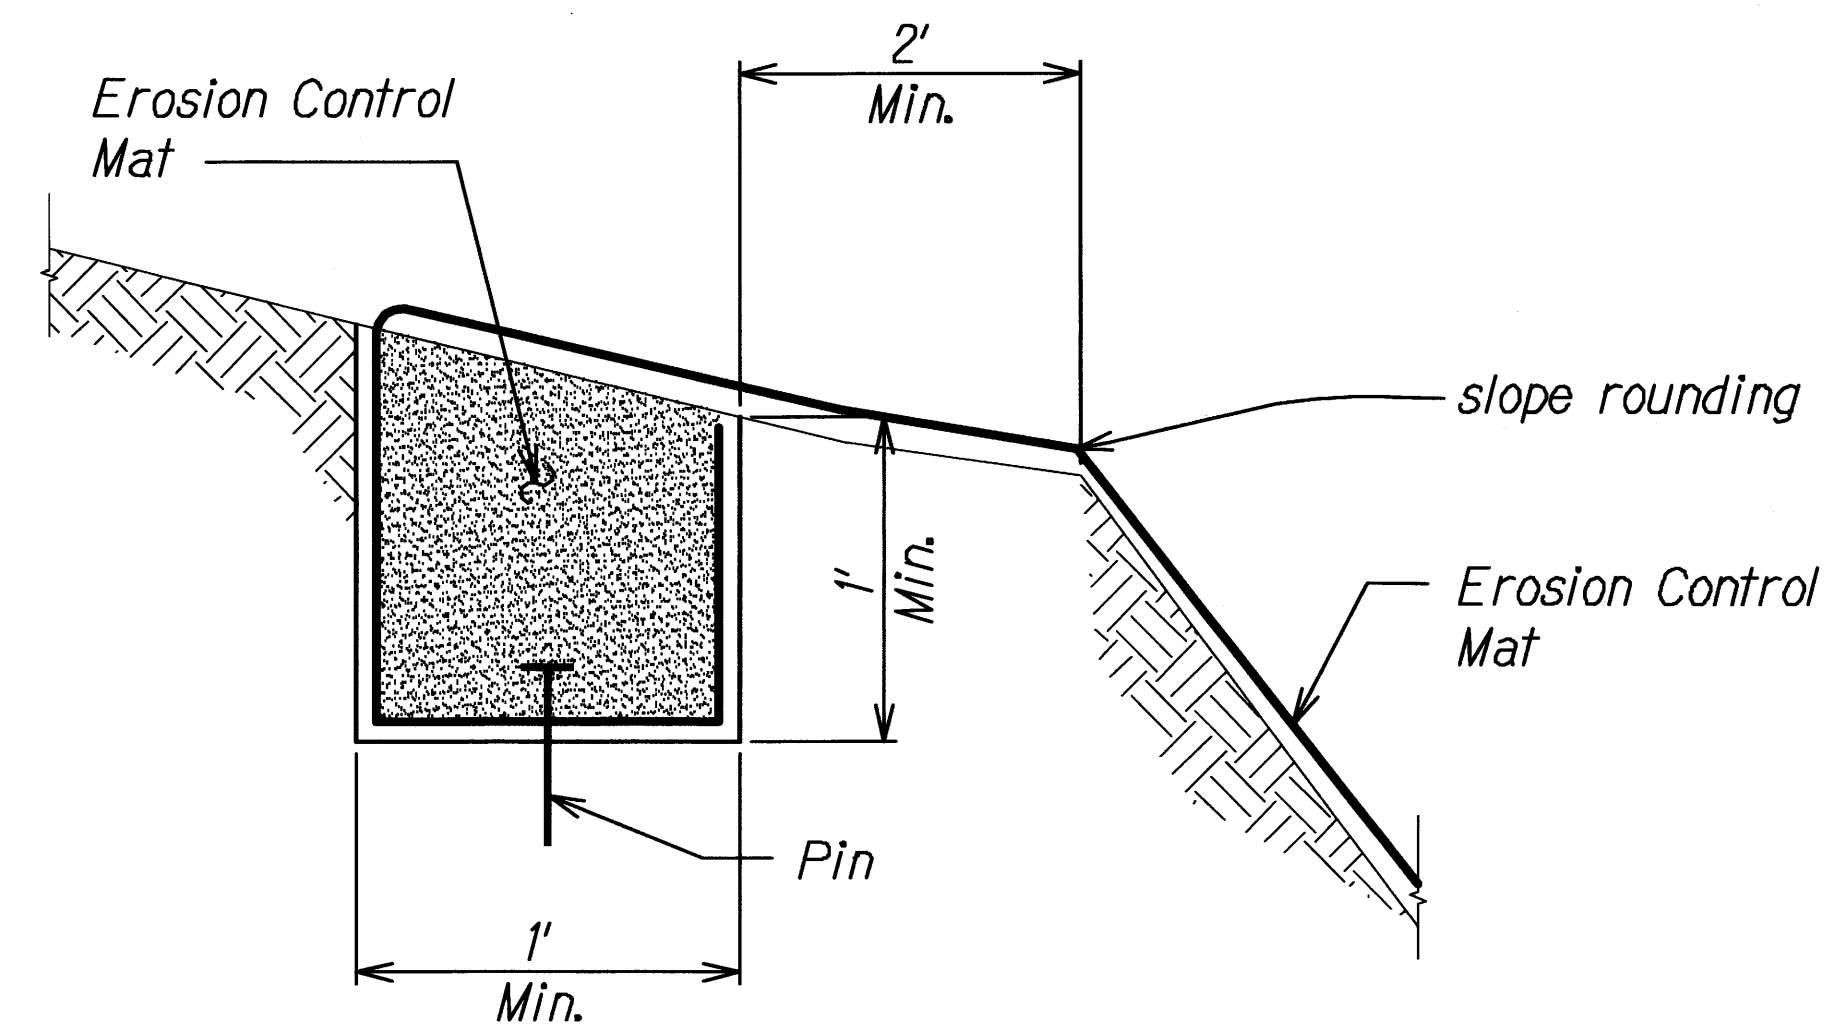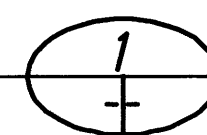



TOP ANCHOR TRENCH AT TOP OF SLOPE TRENCH DETAIL
Scale: None

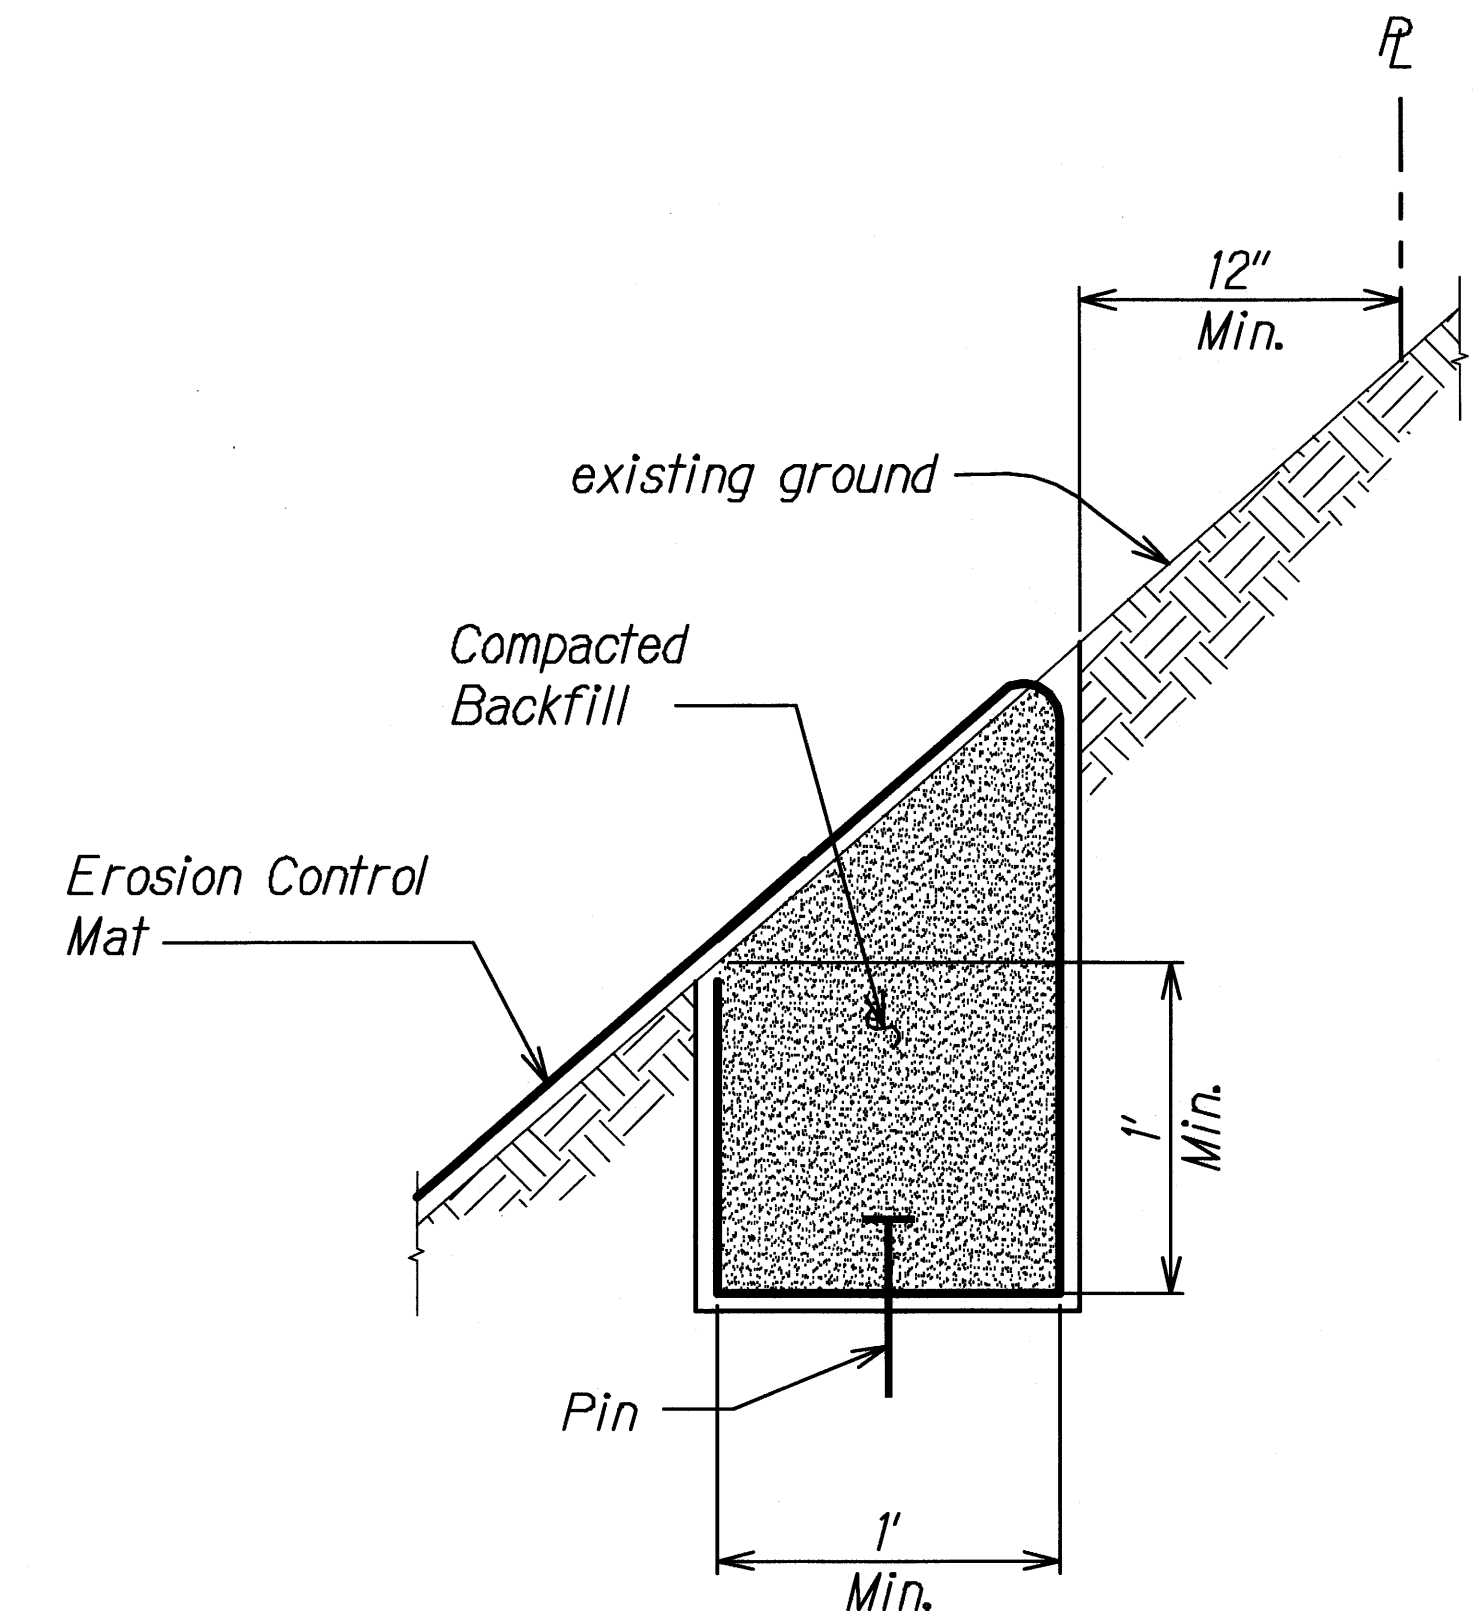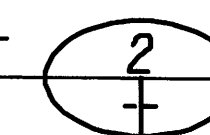


TOP ANCHOR TRENCH AT MID-SLOPE TRENCH DETAIL
Scale: None

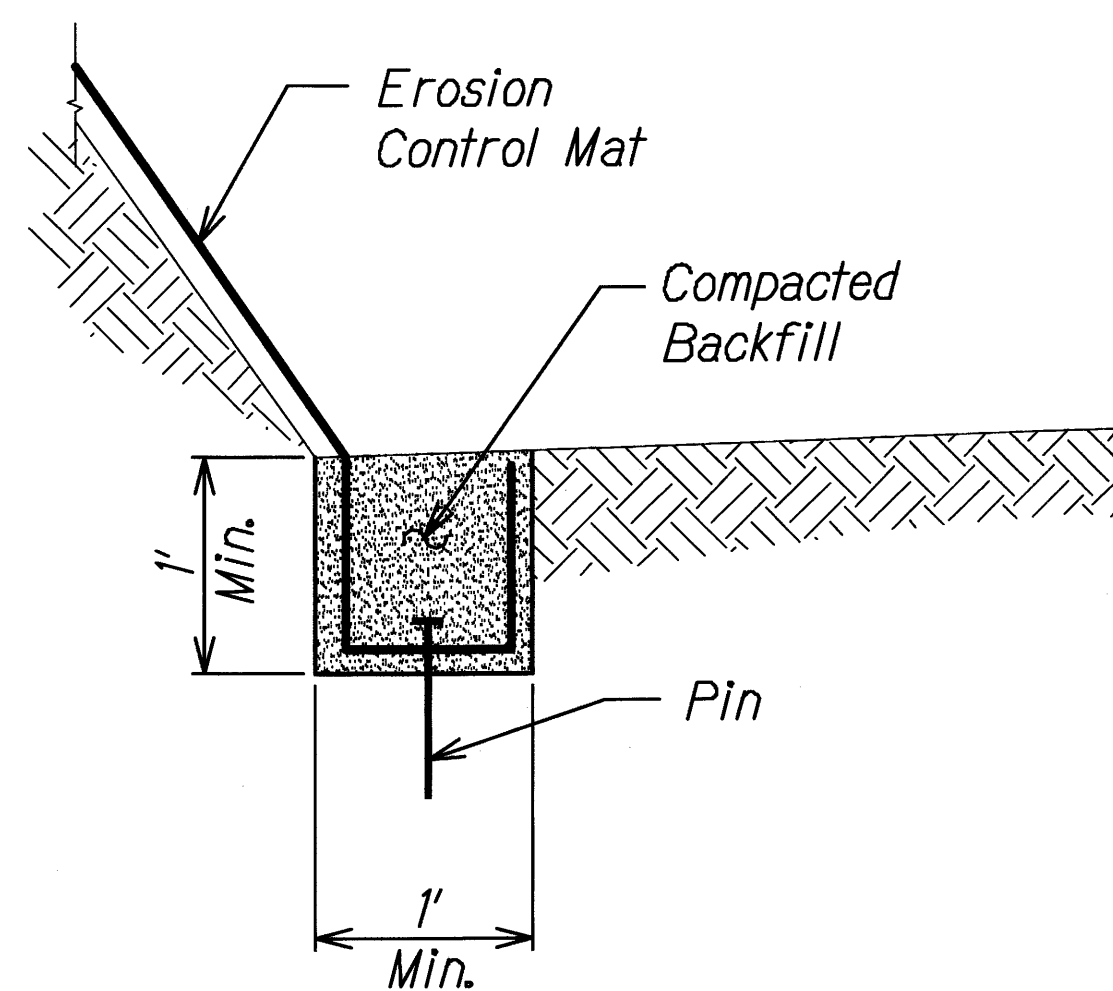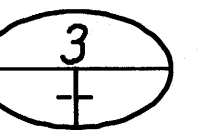

BOTTOM ANCHOR TRENCH DETAIL
Scale: None

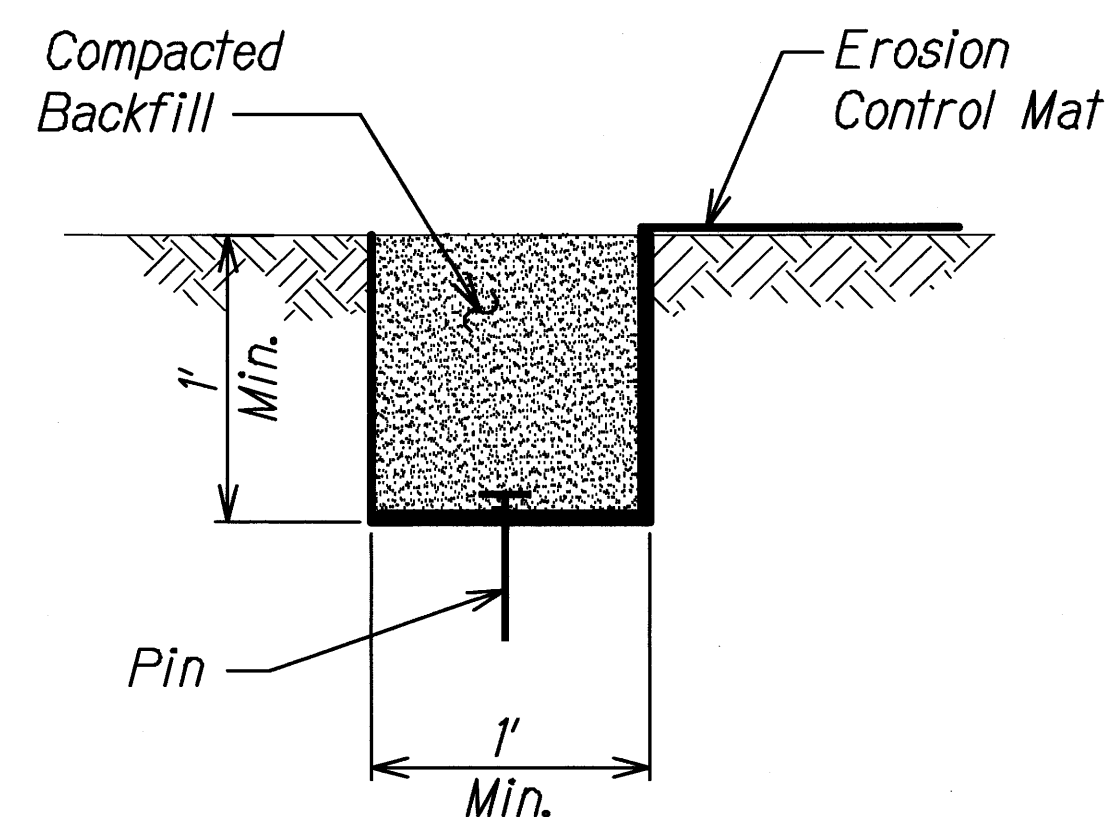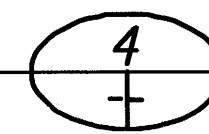

LONGITUDINAL EDGE TRENCH DETAIL
Scale: None

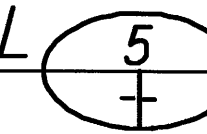

SURVEY PLOTTED BY	DATE
DESIGNED BY	
TRACED BY	
QUANTITIES BY	
CHECKED BY	
ORIGINAL PLAN	
NOTE BOOK	
NO.	

EC-42 EROSION CONTROL MATTING DETAILS (LONG) 2/21/2012 3:50:41 PM

4/30/12

THIS WORK WAS PREPARED BY ME OR UNDER MY SUPERVISION.

STATE OF HAWAII
DEPARTMENT OF TRANSPORTATION
HIGHWAYS DIVISION

**EROSION CONTROL
MATTING DETAILS**


SLOPE IMPROVEMENTS FOR EROSION CONTROL
AT VARIOUS SITES ON OAHU, PHASE 5

Project No. HWY-O-01-12

Scale: None Date: April 2012


SHEET No. EC-42 OF 50 SHEETS

FED. ROAD DIST. NO.	STATE	PROJ. NO.	FISCAL YEAR	SHEET NO.	TOTAL SHEETS
HAWAII	HAW.	HWY-O-01-12	2012	64	123

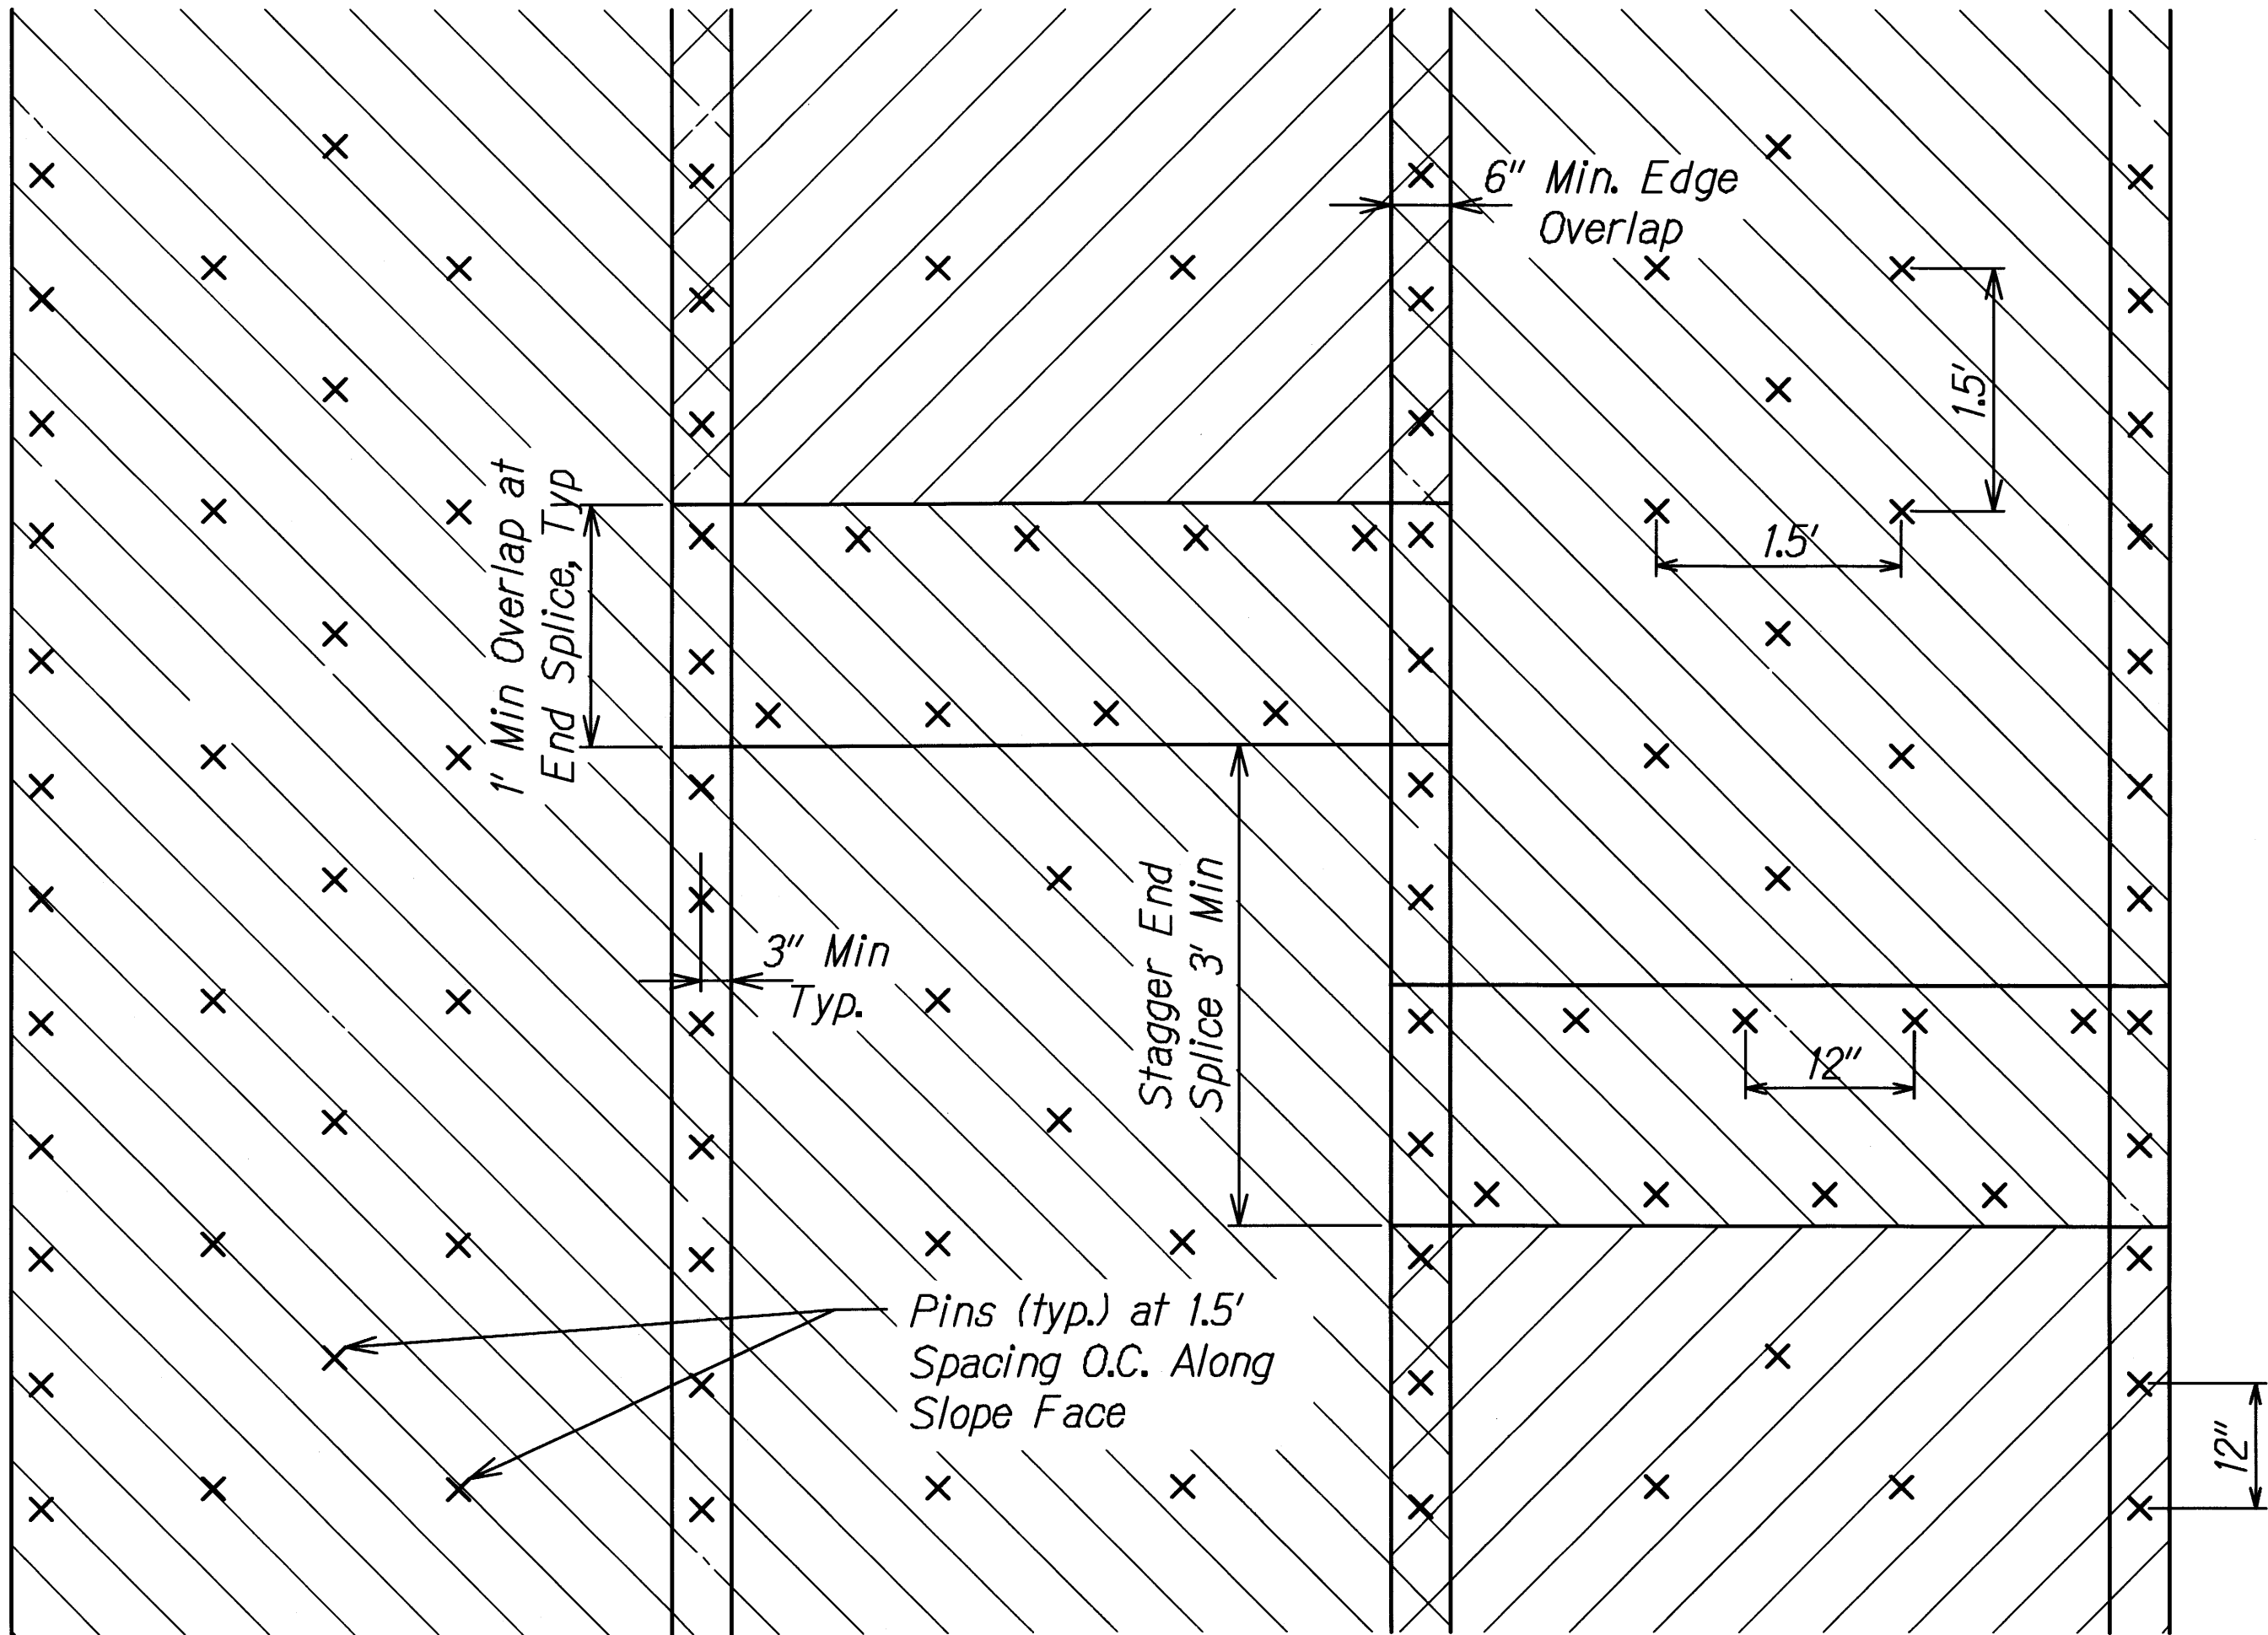

Pin Spacing		
Fastener Type	Along Slope Face	Top, Bottom & Edge Trenches
Pin	1.5'	1'

- Notes:
- Secure all erosion control mat edges with pins at the spacing indicated.
 - For slopes 3H:1V or flatter, no ECM required.

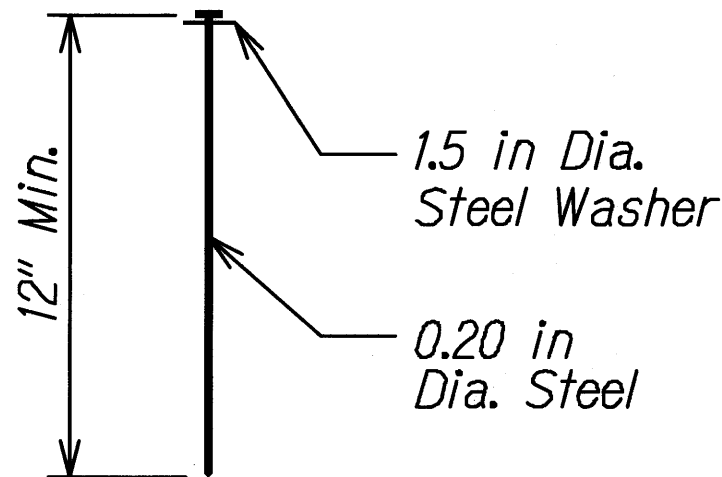

PIN DETAIL 2
Scale: None

TYPICAL EROSION CONTROL MAT AND PIN LAYOUT 1
Scale: None

ORIGINAL PLAN	SURVEY PLOTTED BY	DATE
NOTE BOOK	DESIGNED BY	
	QUANTITIES BY	
	CHECKED BY	

EC-43 EROSION CONTROL MATTING DETAILS ZUNIG 12/29/2012 09:45 AM


STATE OF HAWAII
DEPARTMENT OF TRANSPORTATION
HIGHWAYS DIVISION

**EROSION CONTROL
MATTING DETAILS**


SLOPE IMPROVEMENTS FOR EROSION CONTROL
AT VARIOUS SITES ON OAHU, PHASE 5

Project No. HWY-O-01-12
Date: April 2012


FED. ROAD DIST. NO.	STATE	PROJ. NO.	FISCAL YEAR	SHEET NO.	TOTAL SHEETS
HAWAII	HAW.	HWY-O-01-12	2012	65	123

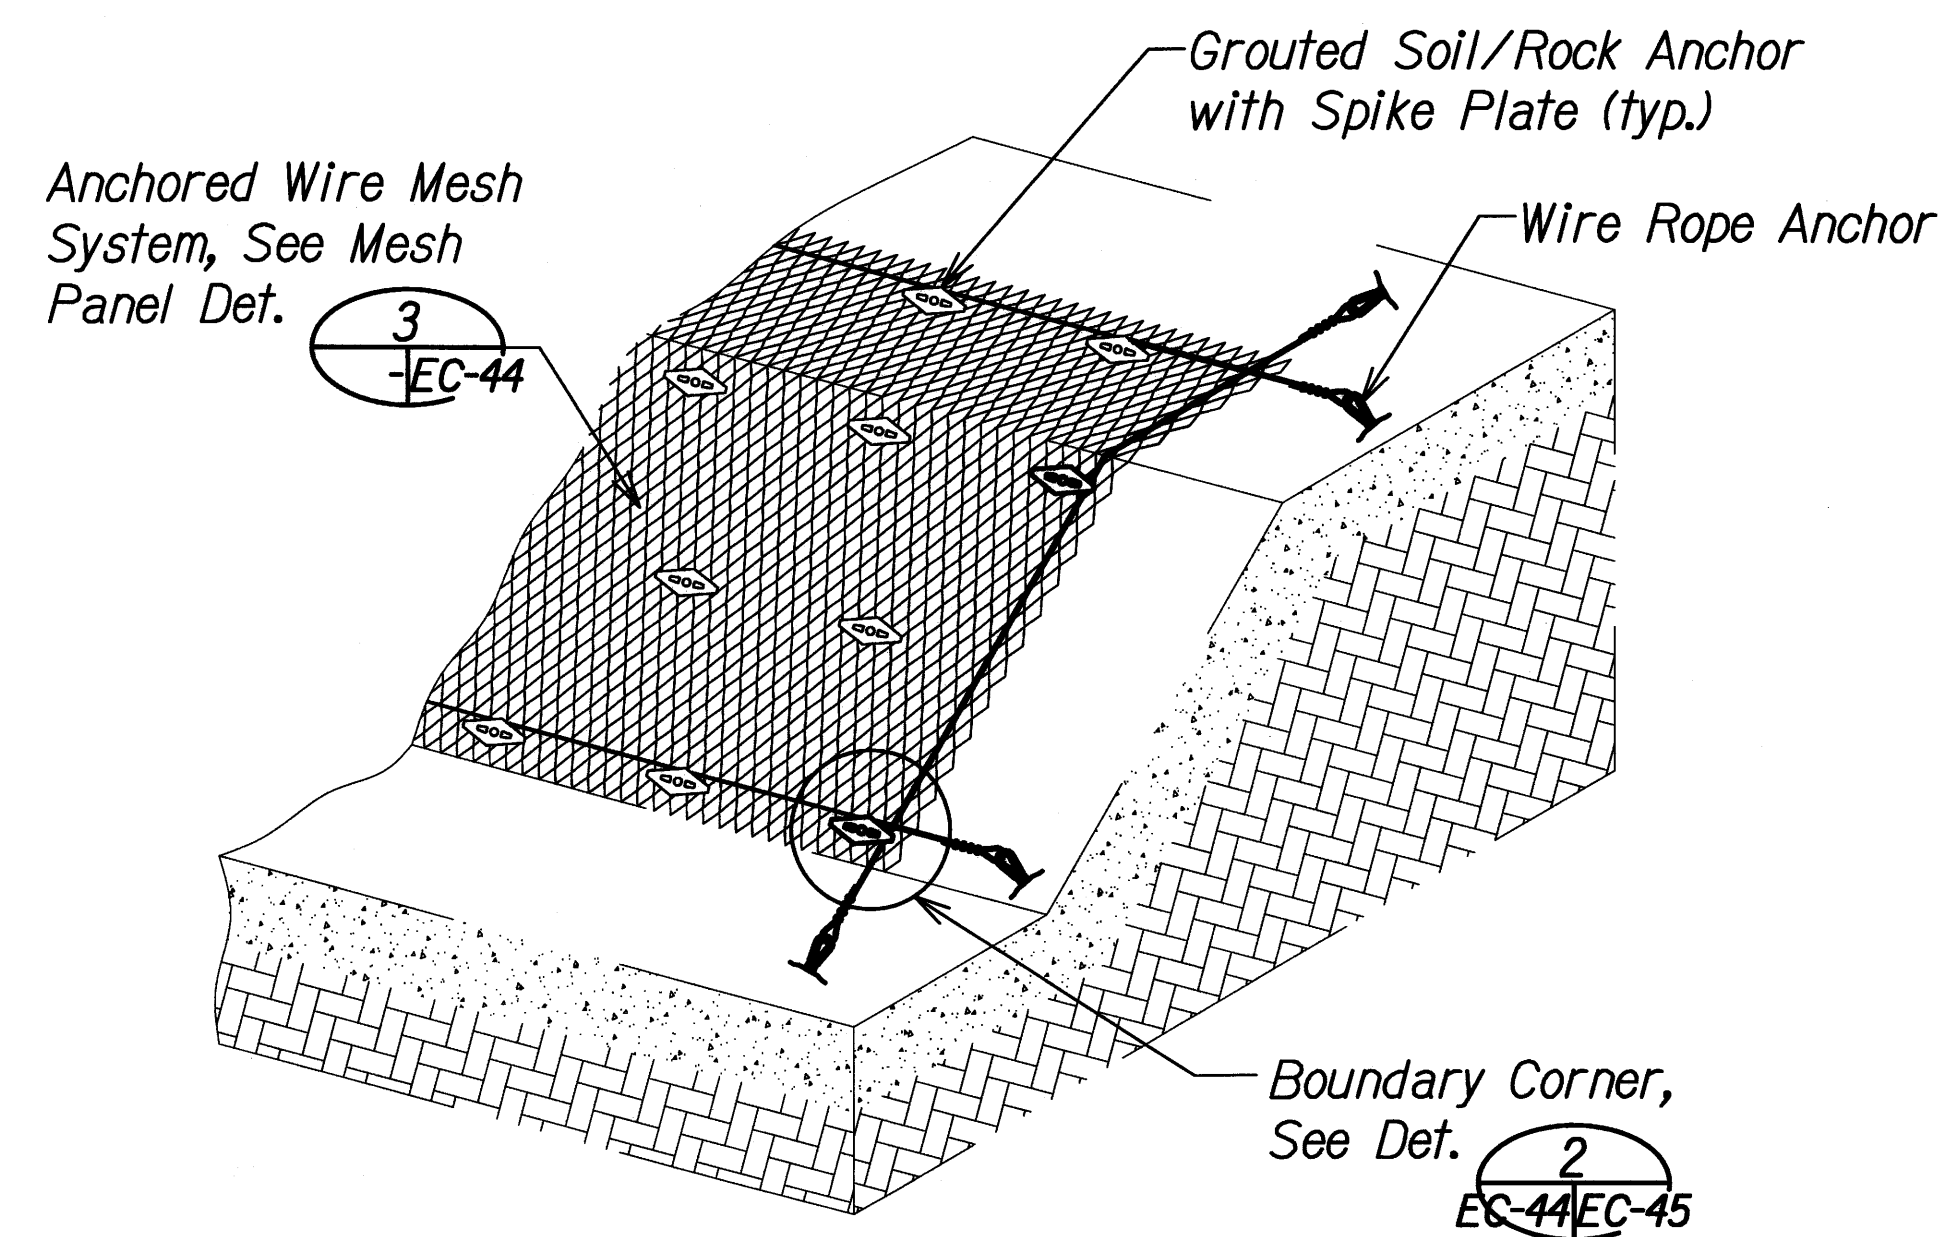

OVERALL MESH SYSTEM LAYOUT 1
Scale: None

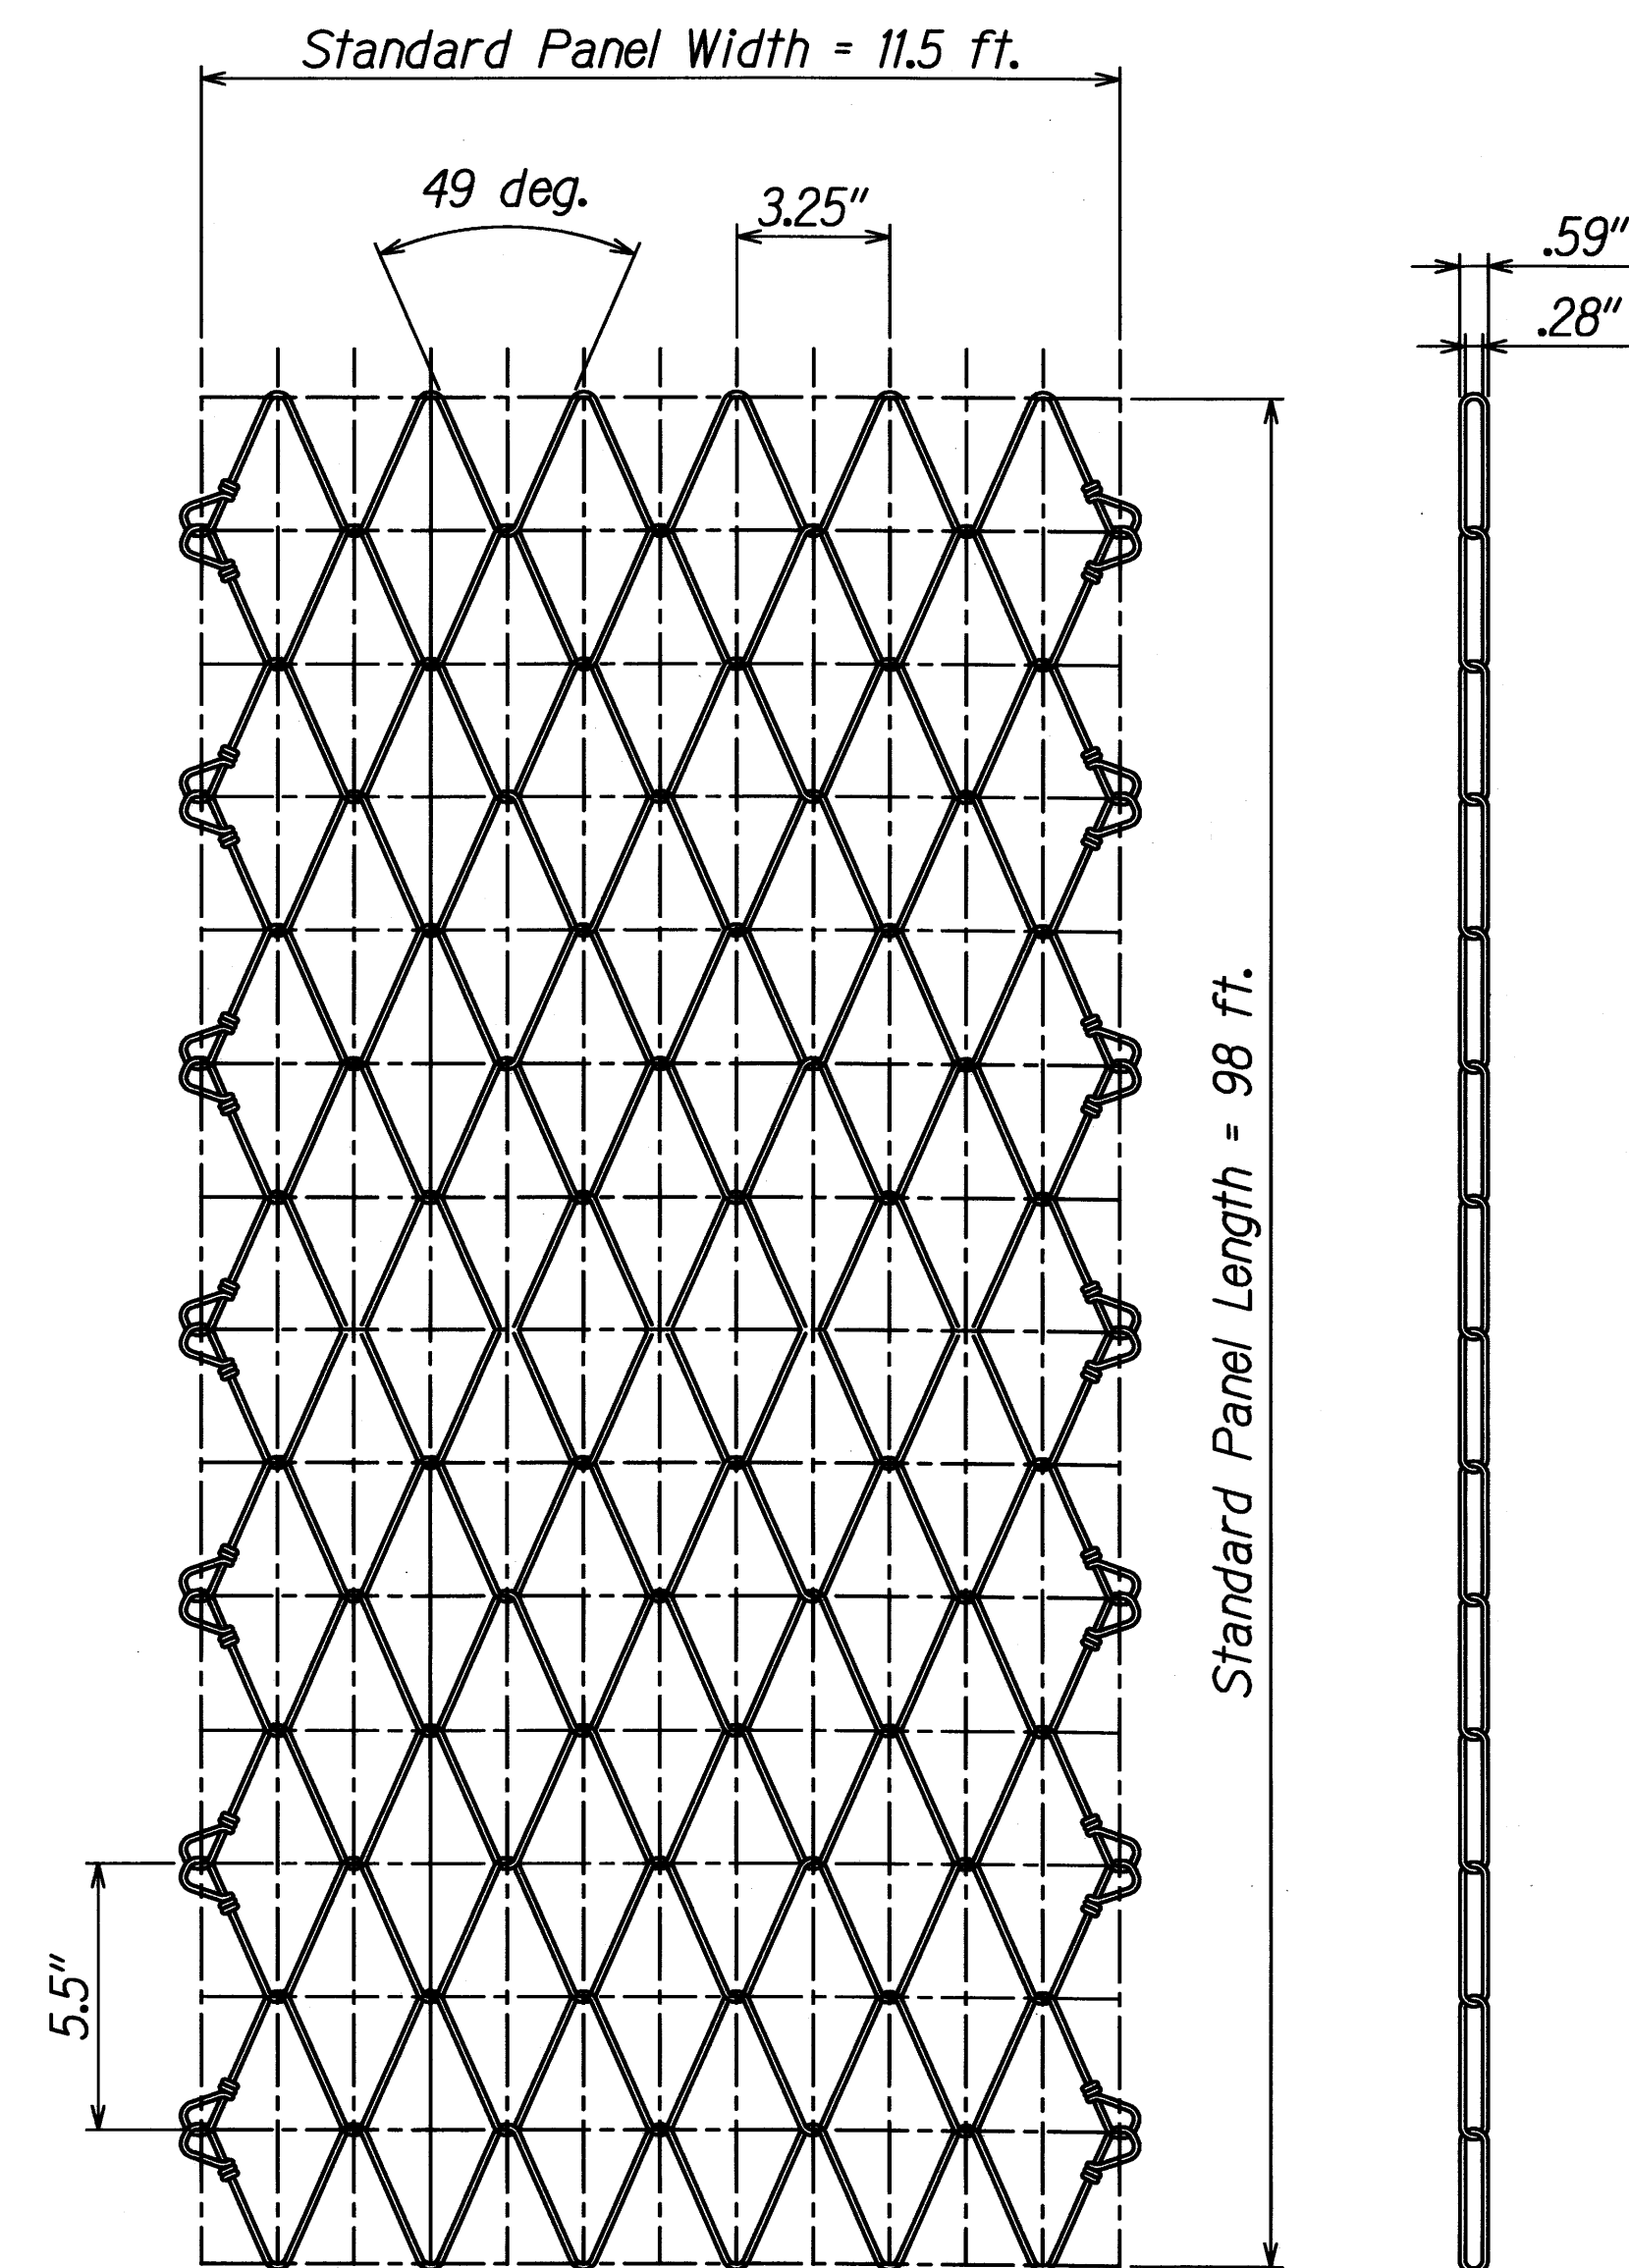

TYPICAL WIRE MESH PANEL 3
Scale: None

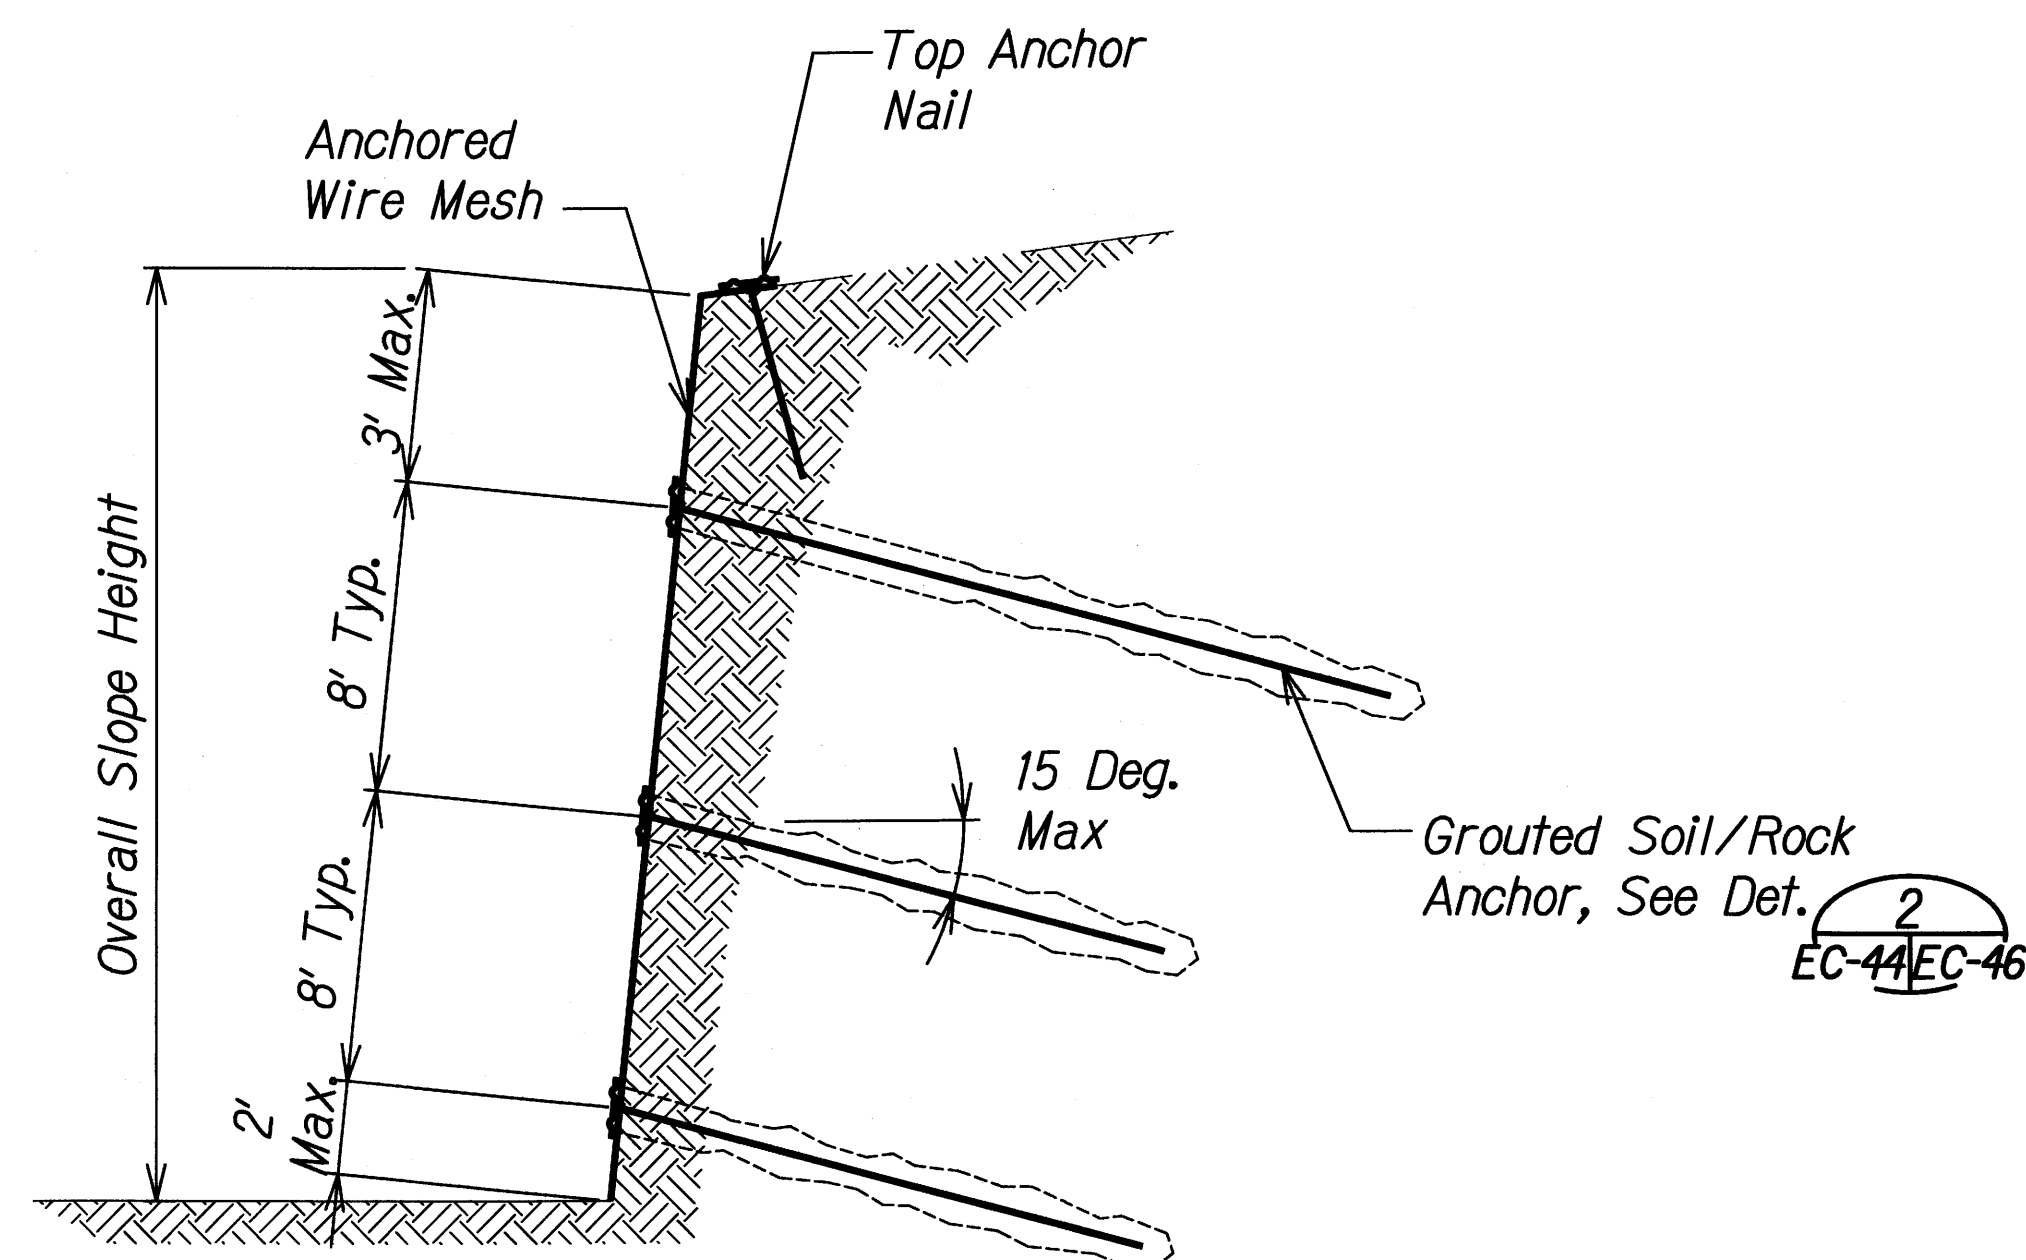

TYPICAL ANCHOR SECTION 2
Scale: None

SURVEY PLOTTED BY	DATE
DESIGNED BY	
TRACED BY	
NOTE BOOK	
QUANTITIES BY	
CHECKED BY	

EC-44 ANCHOR WIRE MESH DETAILS LONG 4/25/2012 11:29:07 AM

STATE OF HAWAII
DEPARTMENT OF TRANSPORTATION
HIGHWAYS DIVISION


**ANCHORED WIRE MESH
DETAILS**

SLOPE IMPROVEMENTS FOR EROSION CONTROL
AT VARIOUS SITES ON OAHU, PHASE 5


Project No. HWY-O-01-12

Scale: None Date: April 2012


FED. ROAD DIST. NO.	STATE	PROJ. NO.	FISCAL YEAR	SHEET NO.	TOTAL SHEETS
HAWAII	HAW.	HWY-O-01-12	2012	66	123

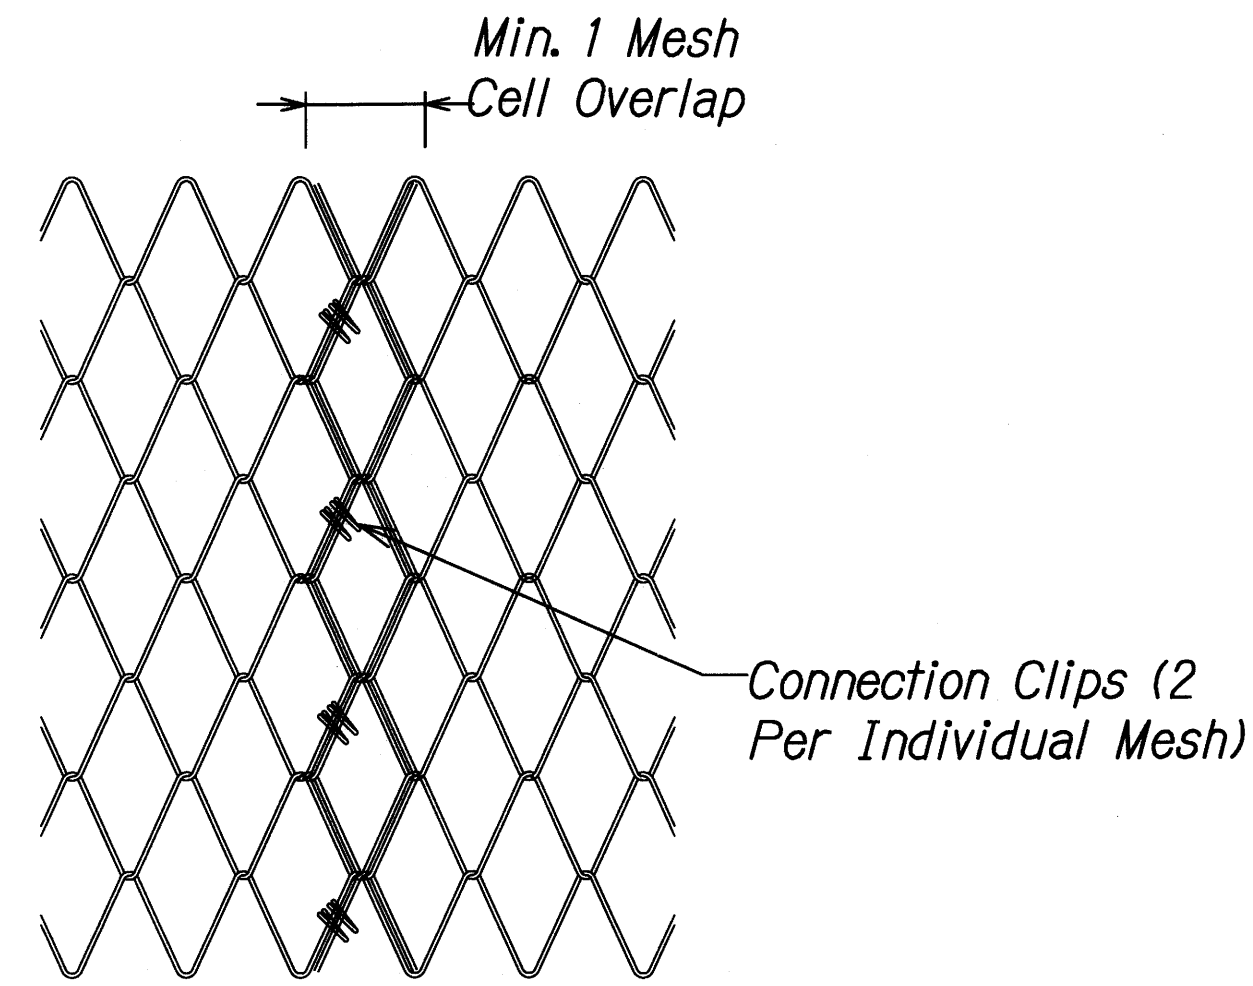

VERTICAL SPLICING WITH OVERLAP

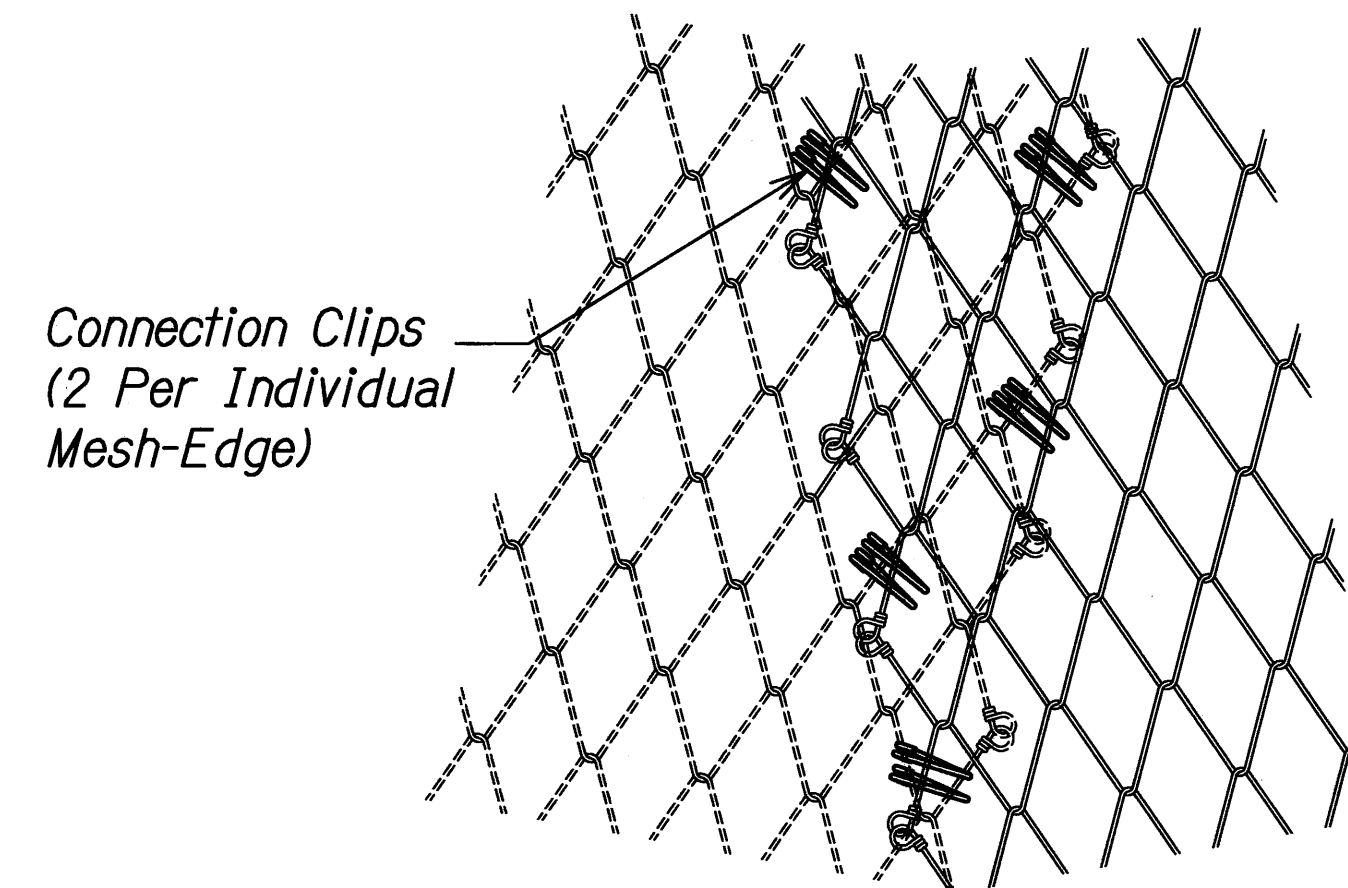


SKEWED SPLICING

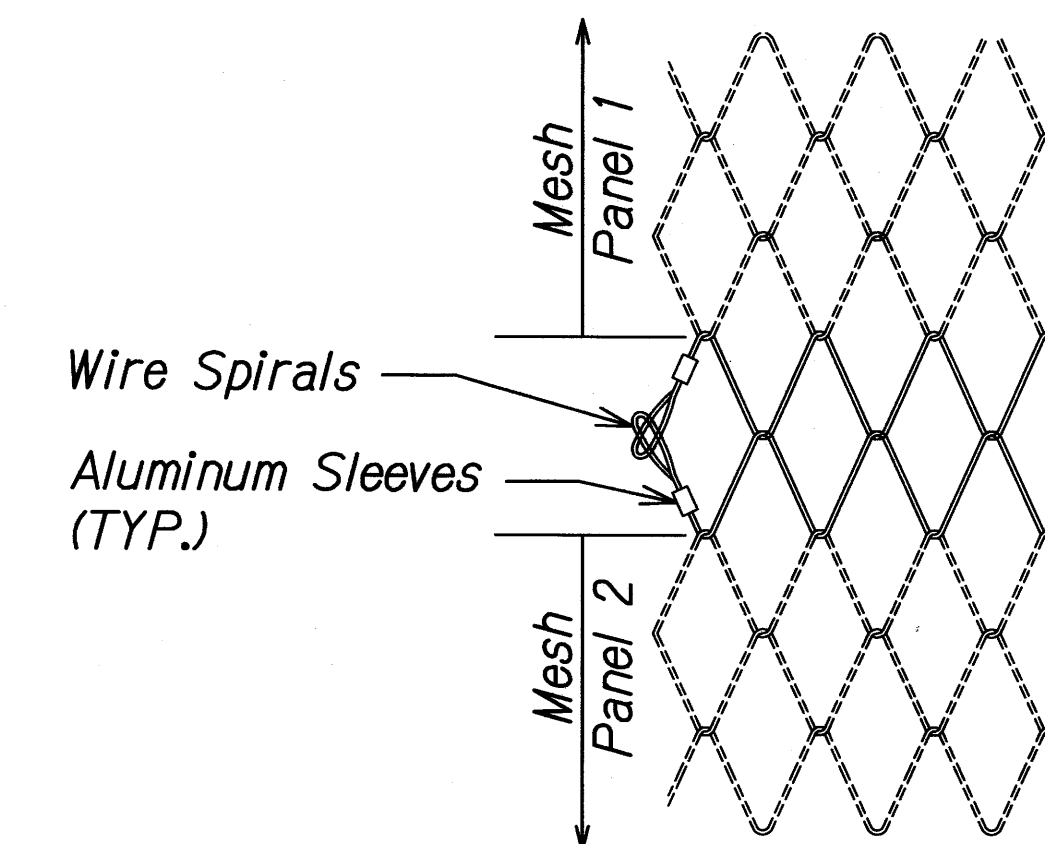


HORIZONTAL SPLICING

WIRE MESH CONNECTION DETAILS ①
Scale: None

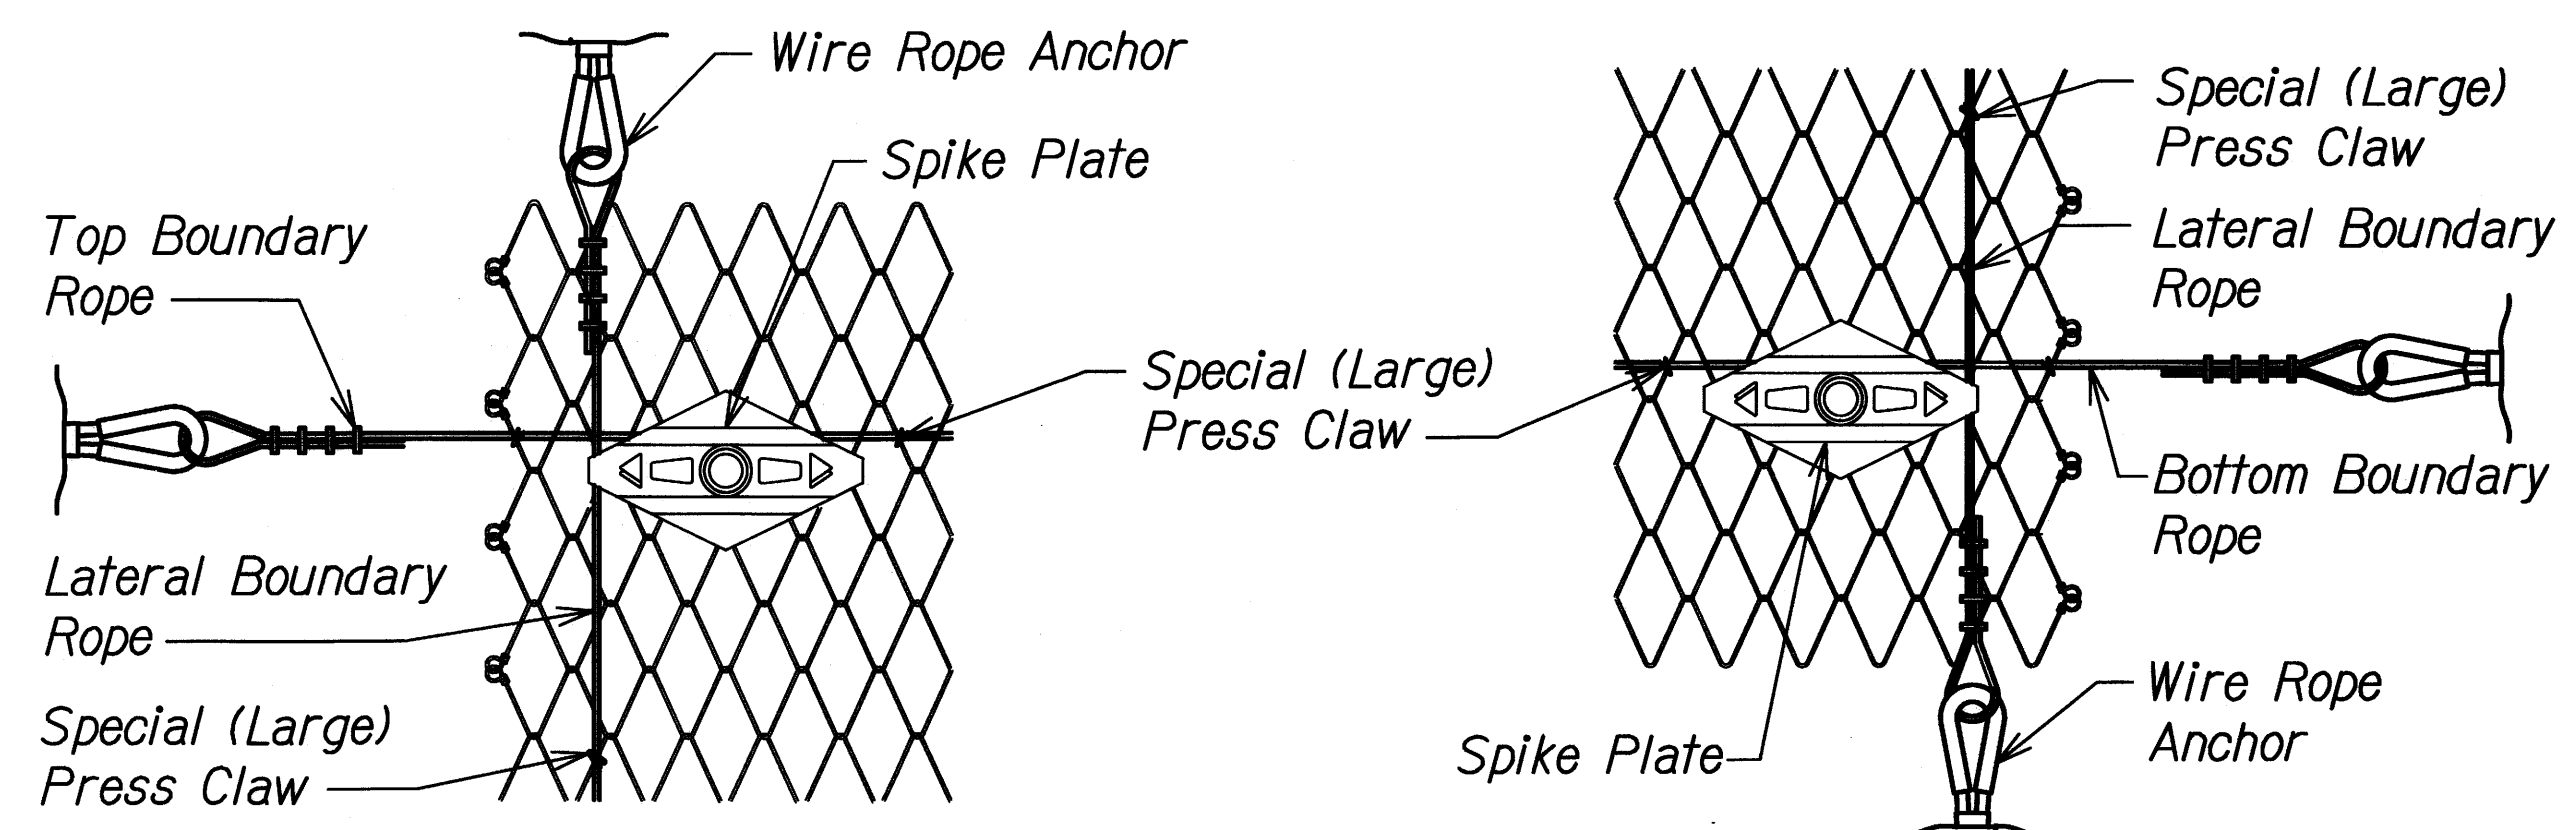

BOUNDARY ROPE AT CORNER DETAILS ②
Scale: None

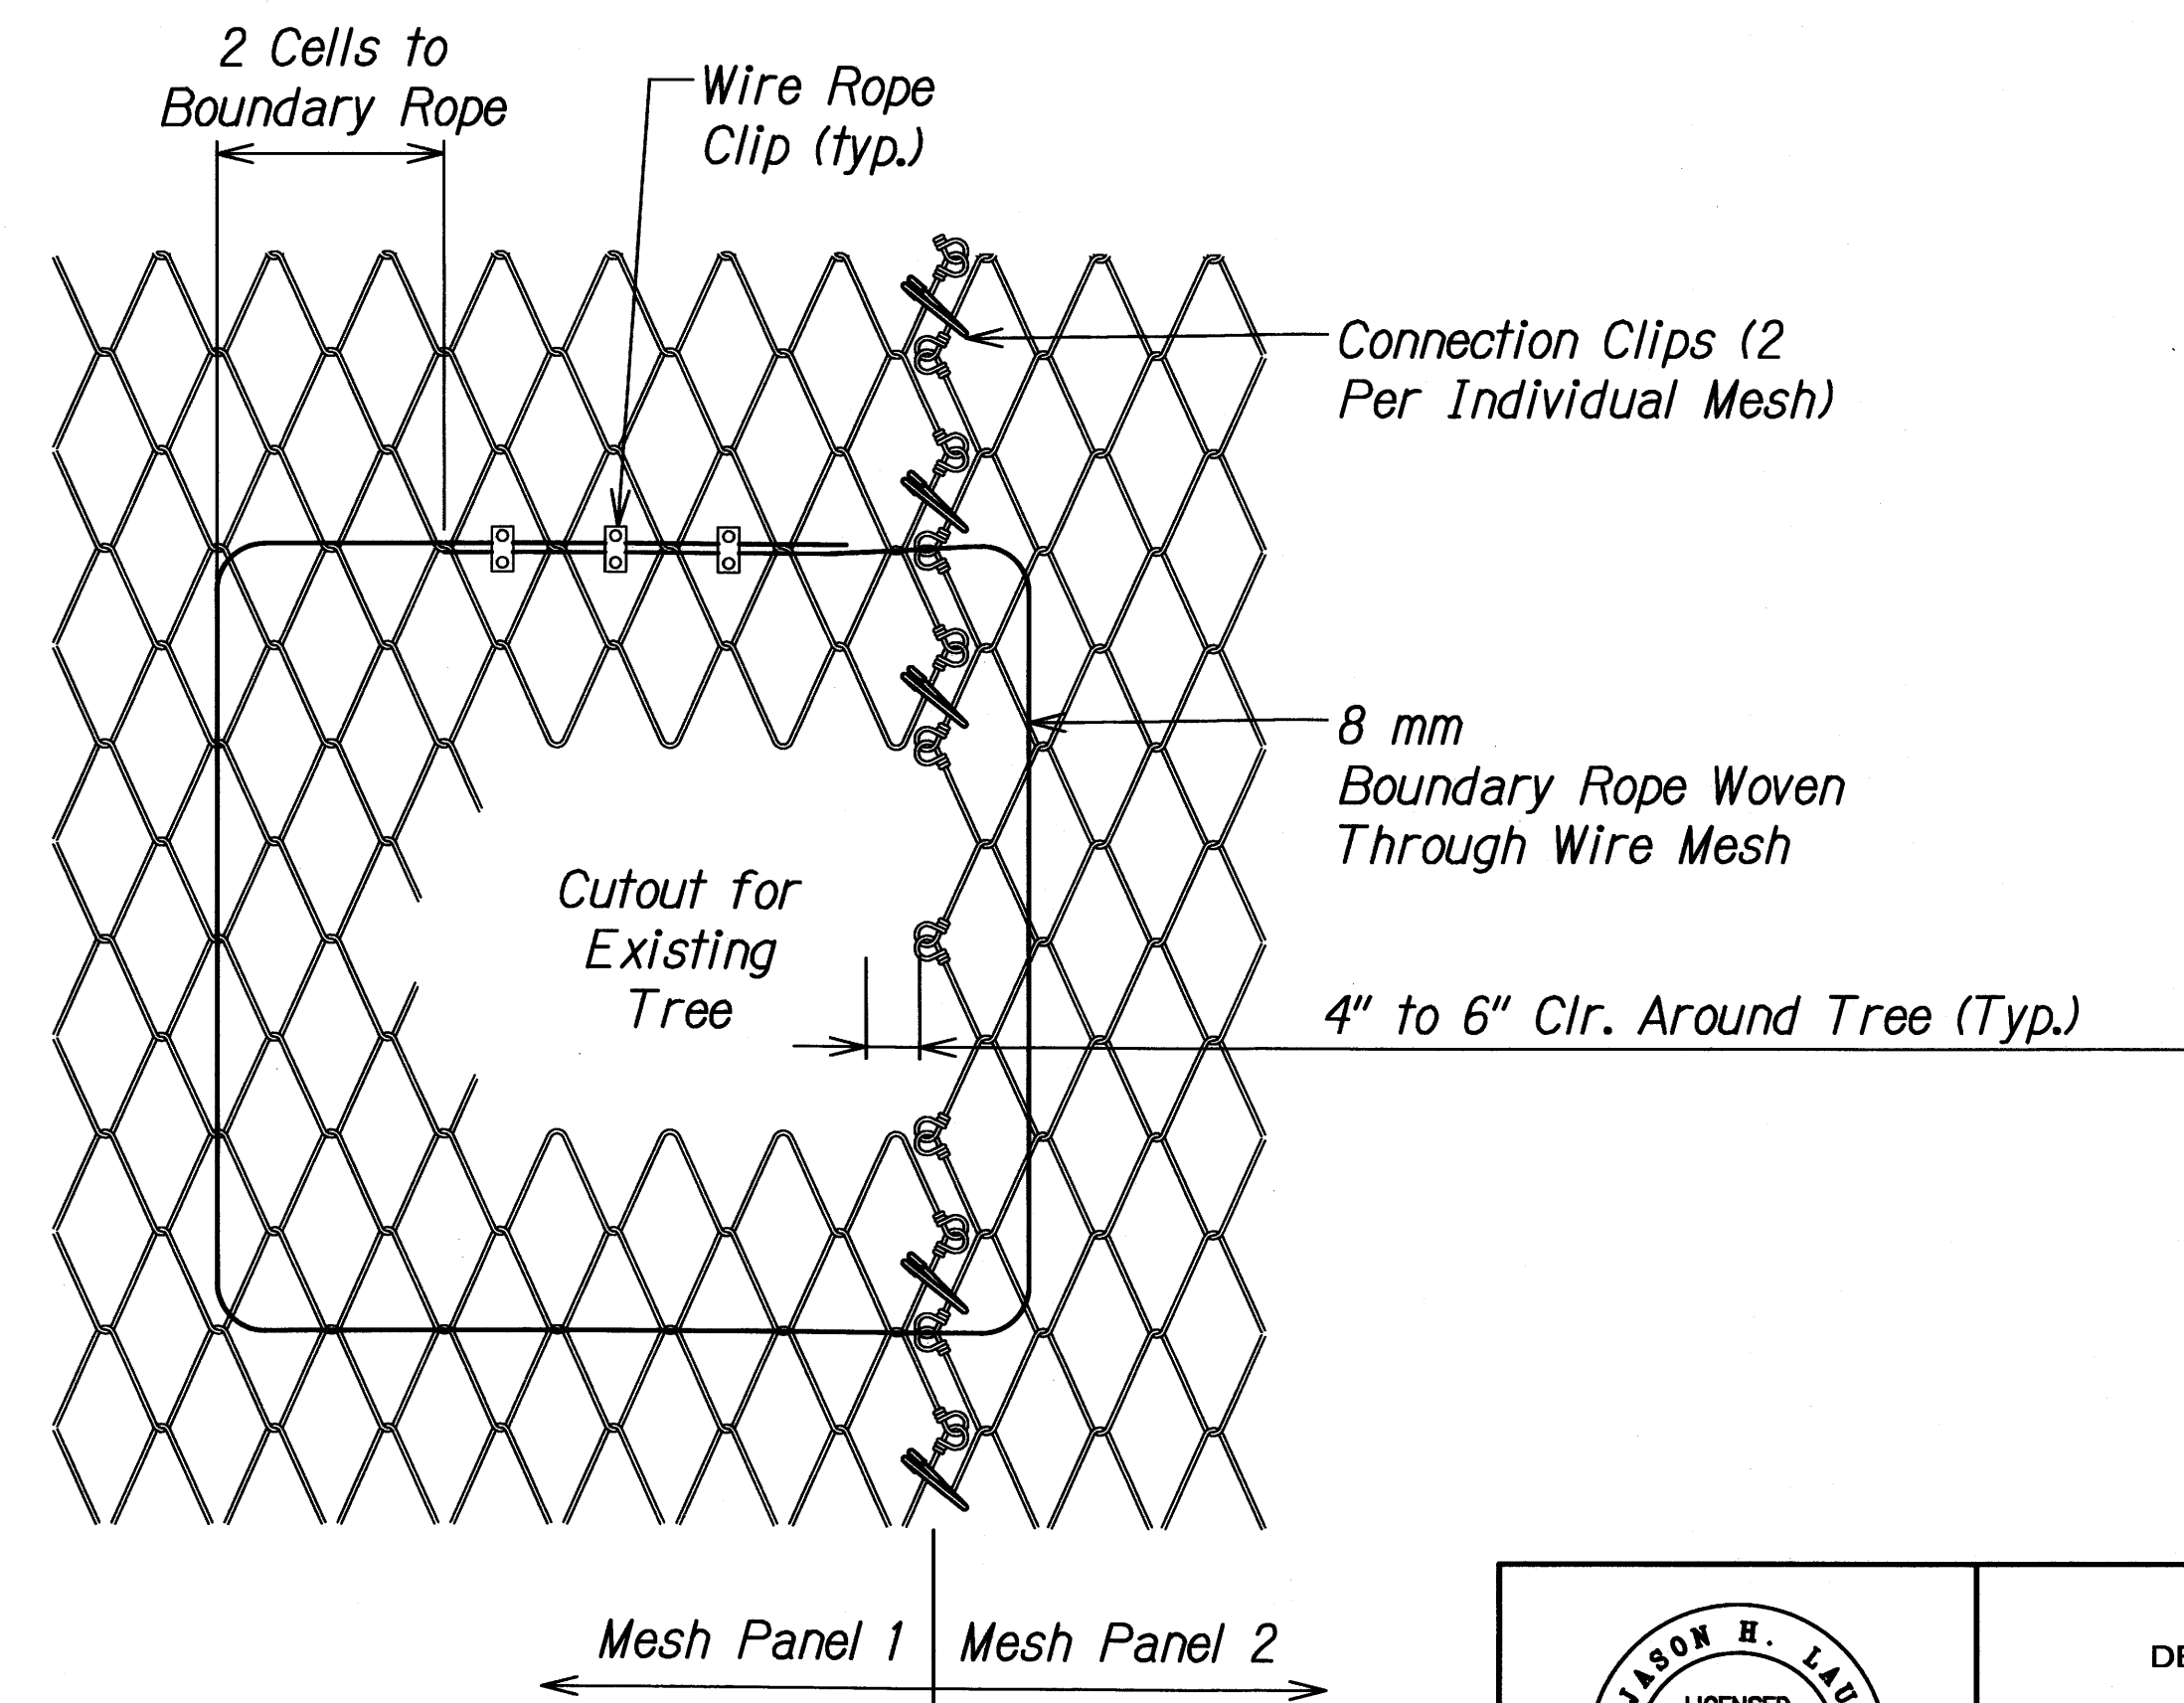

TREE CUTOUT DETAIL ③
Scale: None

STATE OF HAWAII
DEPARTMENT OF TRANSPORTATION
HIGHWAYS DIVISION

ANCHORED WIRE MESH DETAILS


SLOPE IMPROVEMENTS FOR EROSION CONTROL
AT VARIOUS SITES ON OAHU, PHASE 5

Project No. HWY-O-01-12


Scale: None Date: April 2012

SURVEY PLOTTED BY: _____ CHECKED BY: _____ DATE: _____ ORIGINAL PLAN: _____ NOTE BOOK: _____ QUANTITIES BY: _____ CHECKED BY: _____ DATE: _____	EC-45 ANCHOR WIRE MESH DETAILS 2/06 4/3/2012 9:45:37 AM
--	---

FED. ROAD DIST. NO.	STATE	PROJ. NO.	FISCAL YEAR	SHEET NO.	TOTAL SHEETS
HAWAII	HAW.	HWY-O-01-12	2012	67	123




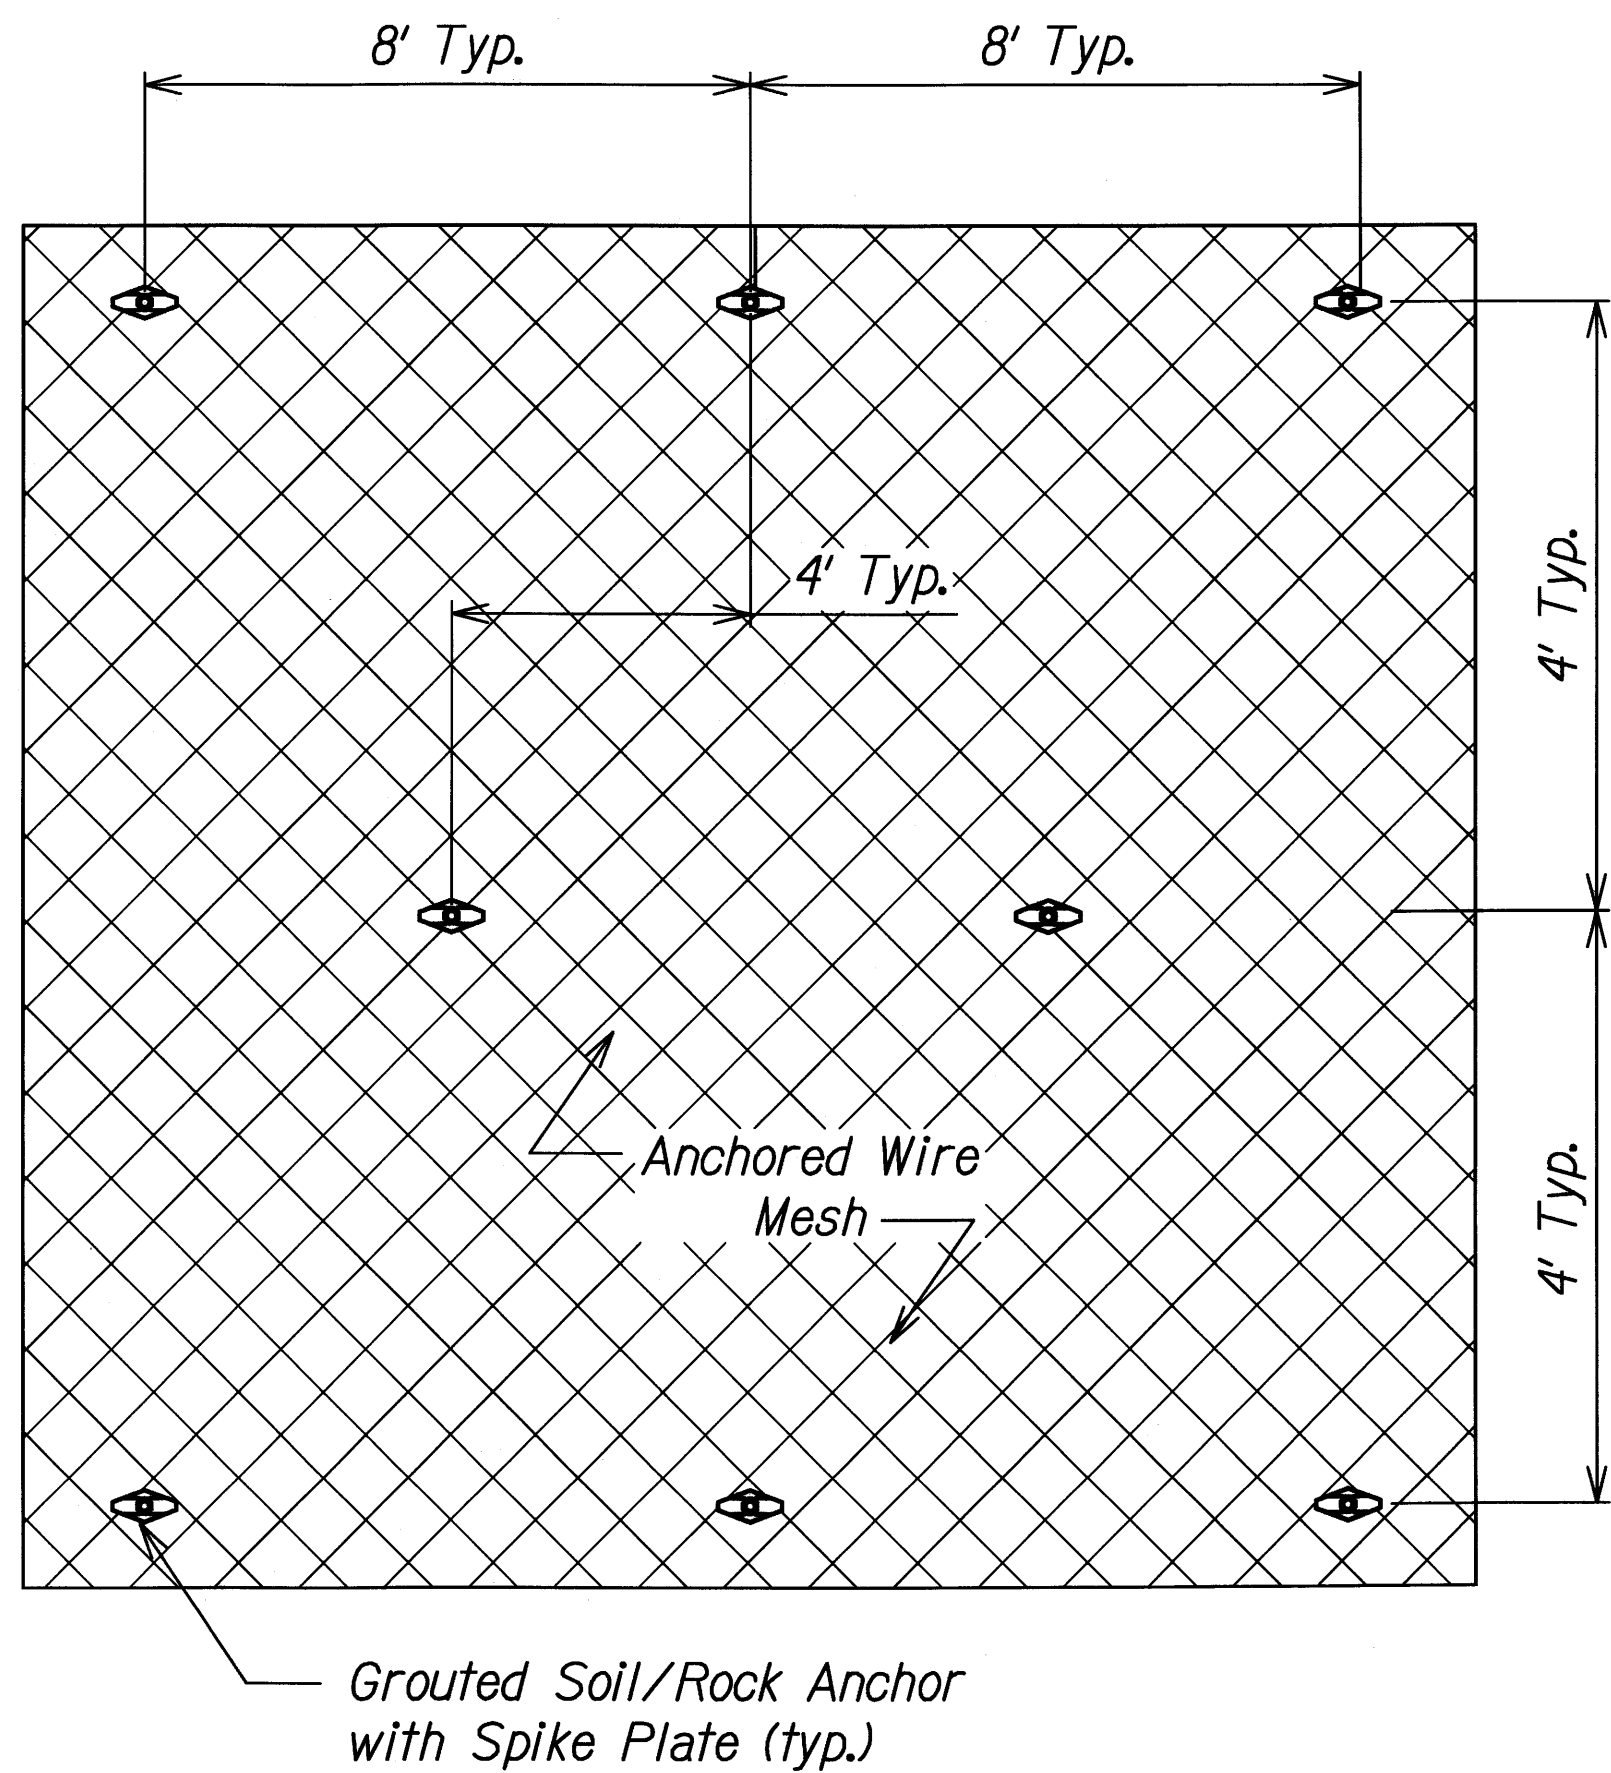


TYPICAL ANCHOR SPACING 1
Scale: None

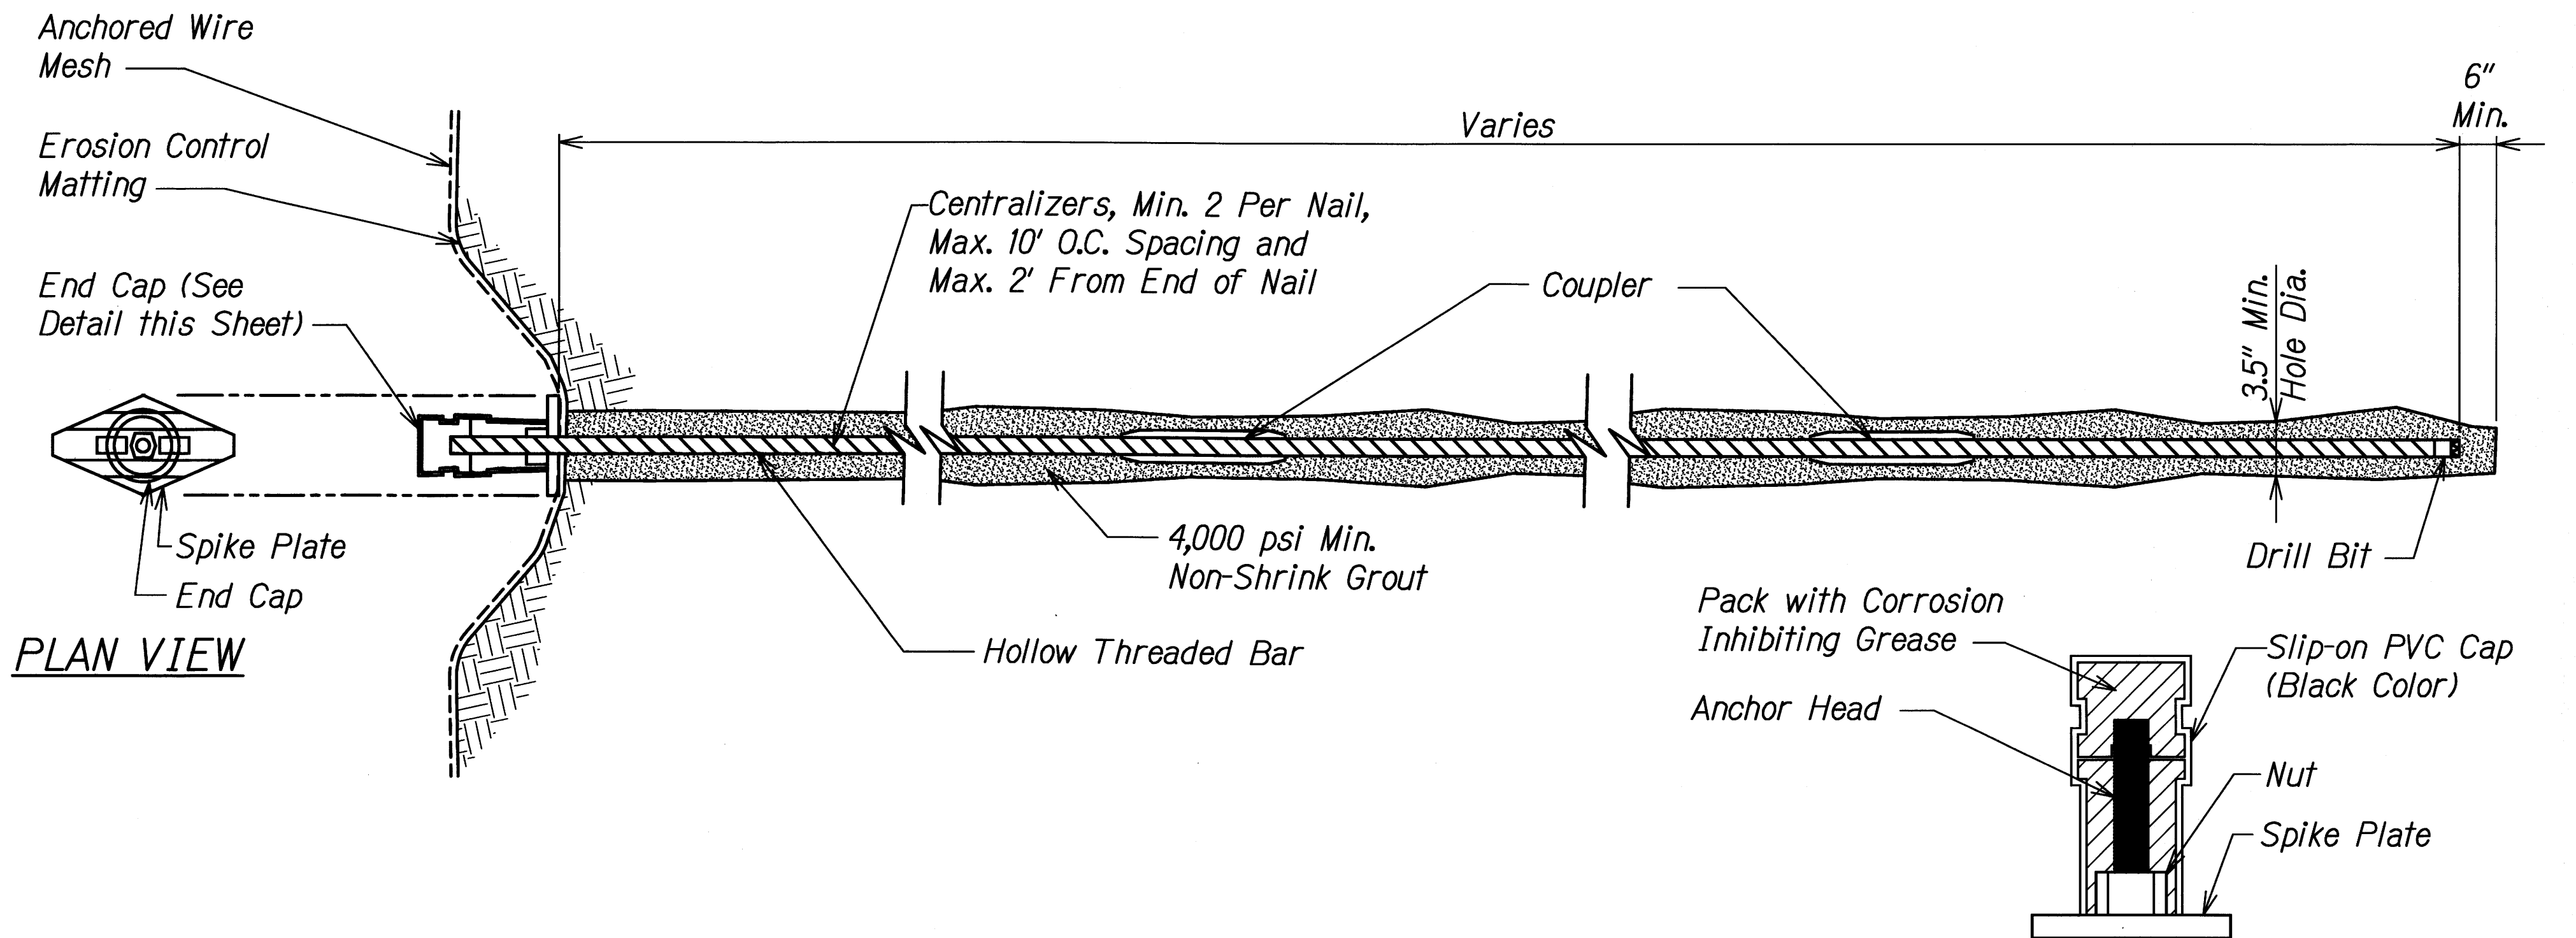


GROUTED SOIL/ROCK ANCHOR DETAIL 2
Scale: None

END CAP ELEVATION

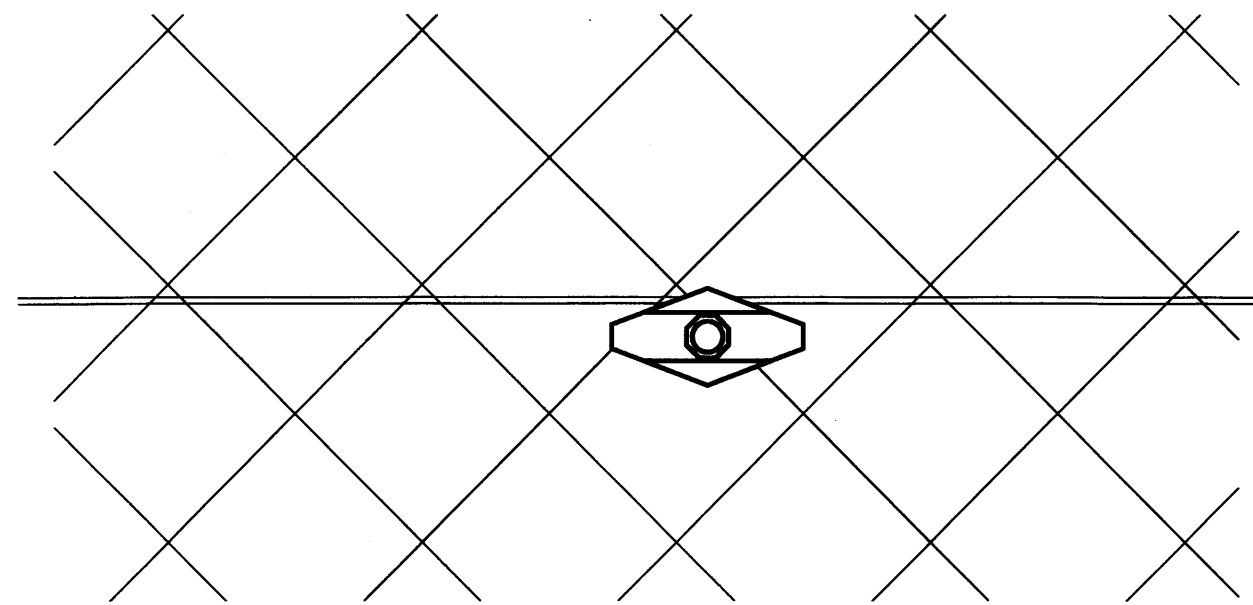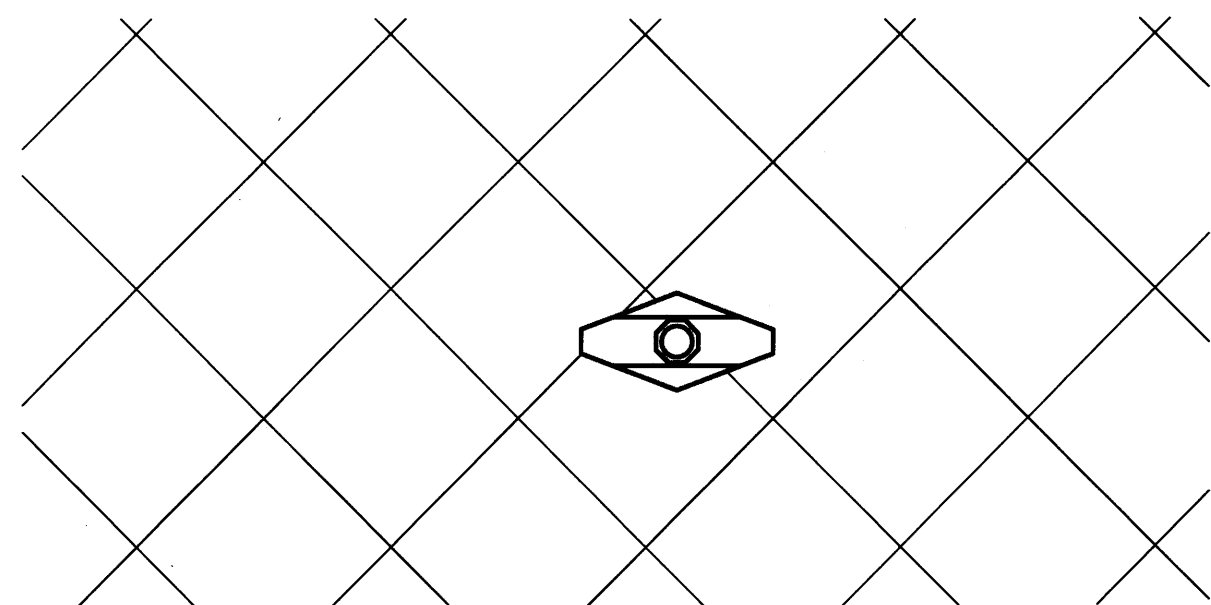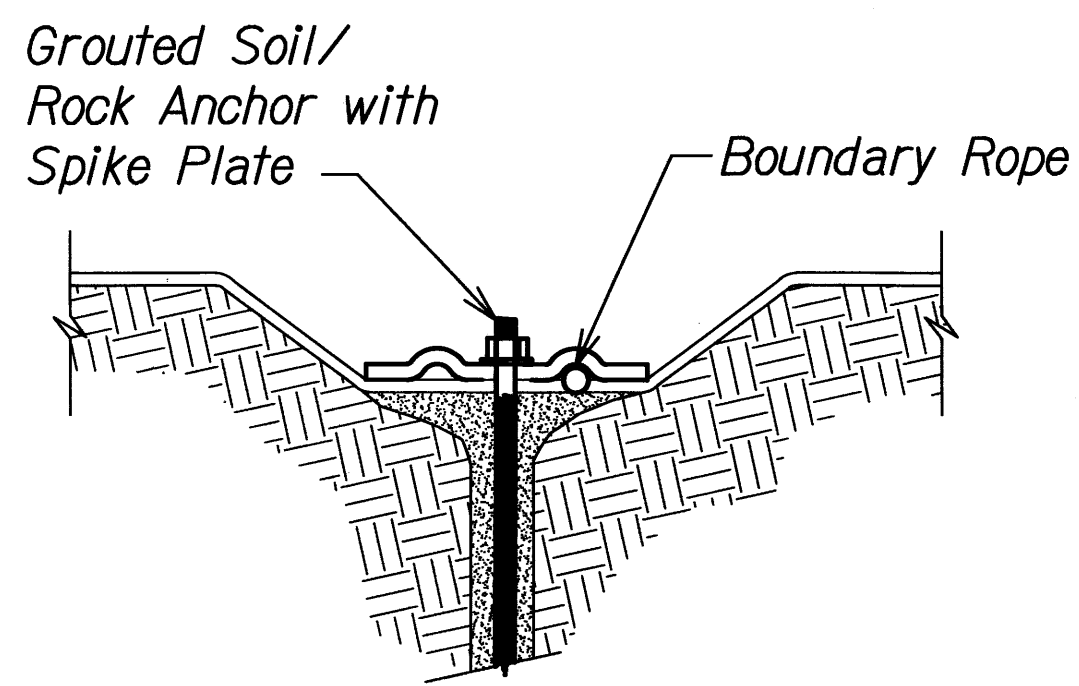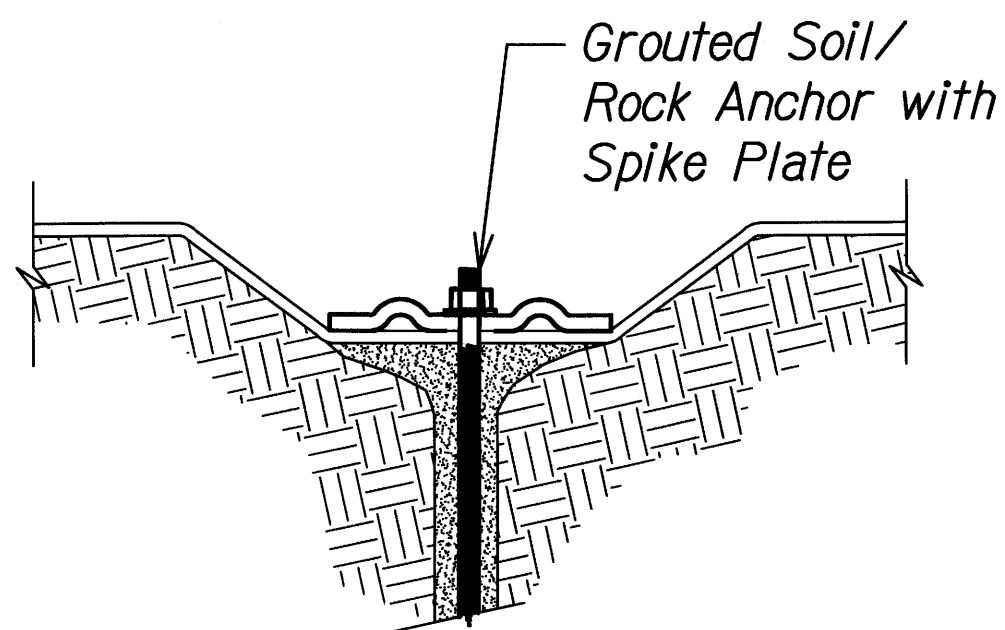

NAIL AND ANCHOR DETAILS 3
Scale: None

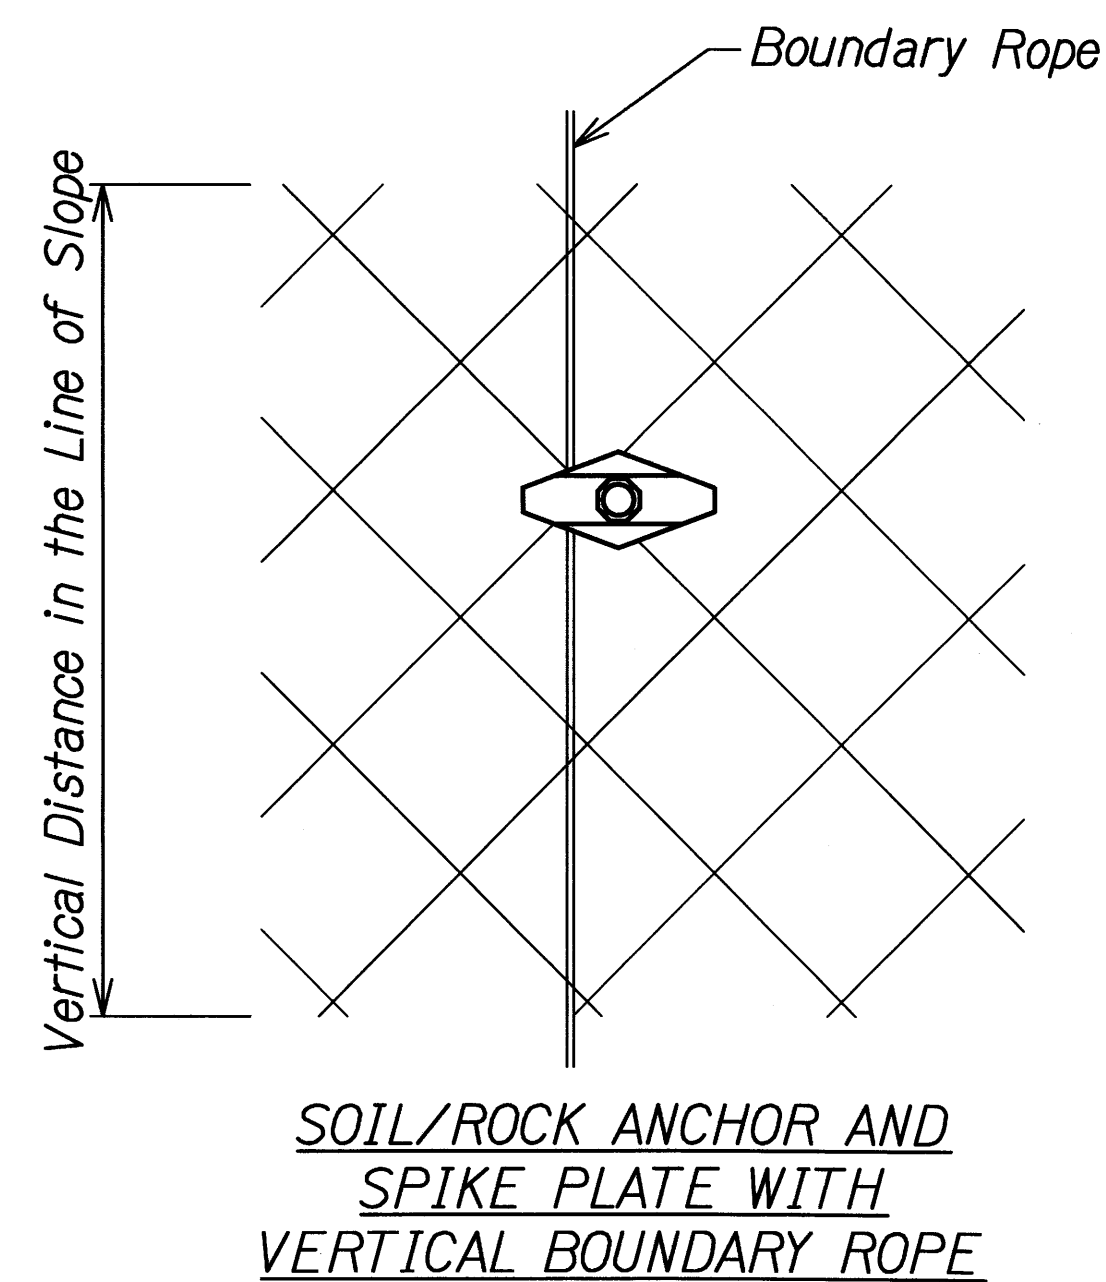

ORIGINAL PLAN	DATE
DESIGNED BY	
NOTED BY	
CHECKED BY	
DATE	

EC-46 ANCHOR WIRE MESH DETAILS 3.DWG 4/15/2012 10:07:38 AM

4/30/12
EXP. DATE
This work was prepared by me or under my supervision.

STATE OF HAWAII
DEPARTMENT OF TRANSPORTATION
HIGHWAYS DIVISION

ANCHORED WIRE MESH DETAILS


SLOPE IMPROVEMENTS FOR EROSION CONTROL AT VARIOUS SITES ON OAHU, PHASE 5

Project No. HWY-O-01-12


Scale: None Date: April 2012

SHEET No. EC-46 OF 50 SHEETS

FED. ROAD DIST. NO.	STATE	PROJ. NO.	FISCAL YEAR	SHEET NO.	TOTAL SHEETS
HAWAII	HAW.	HWY-O-01-12	2012	68	123

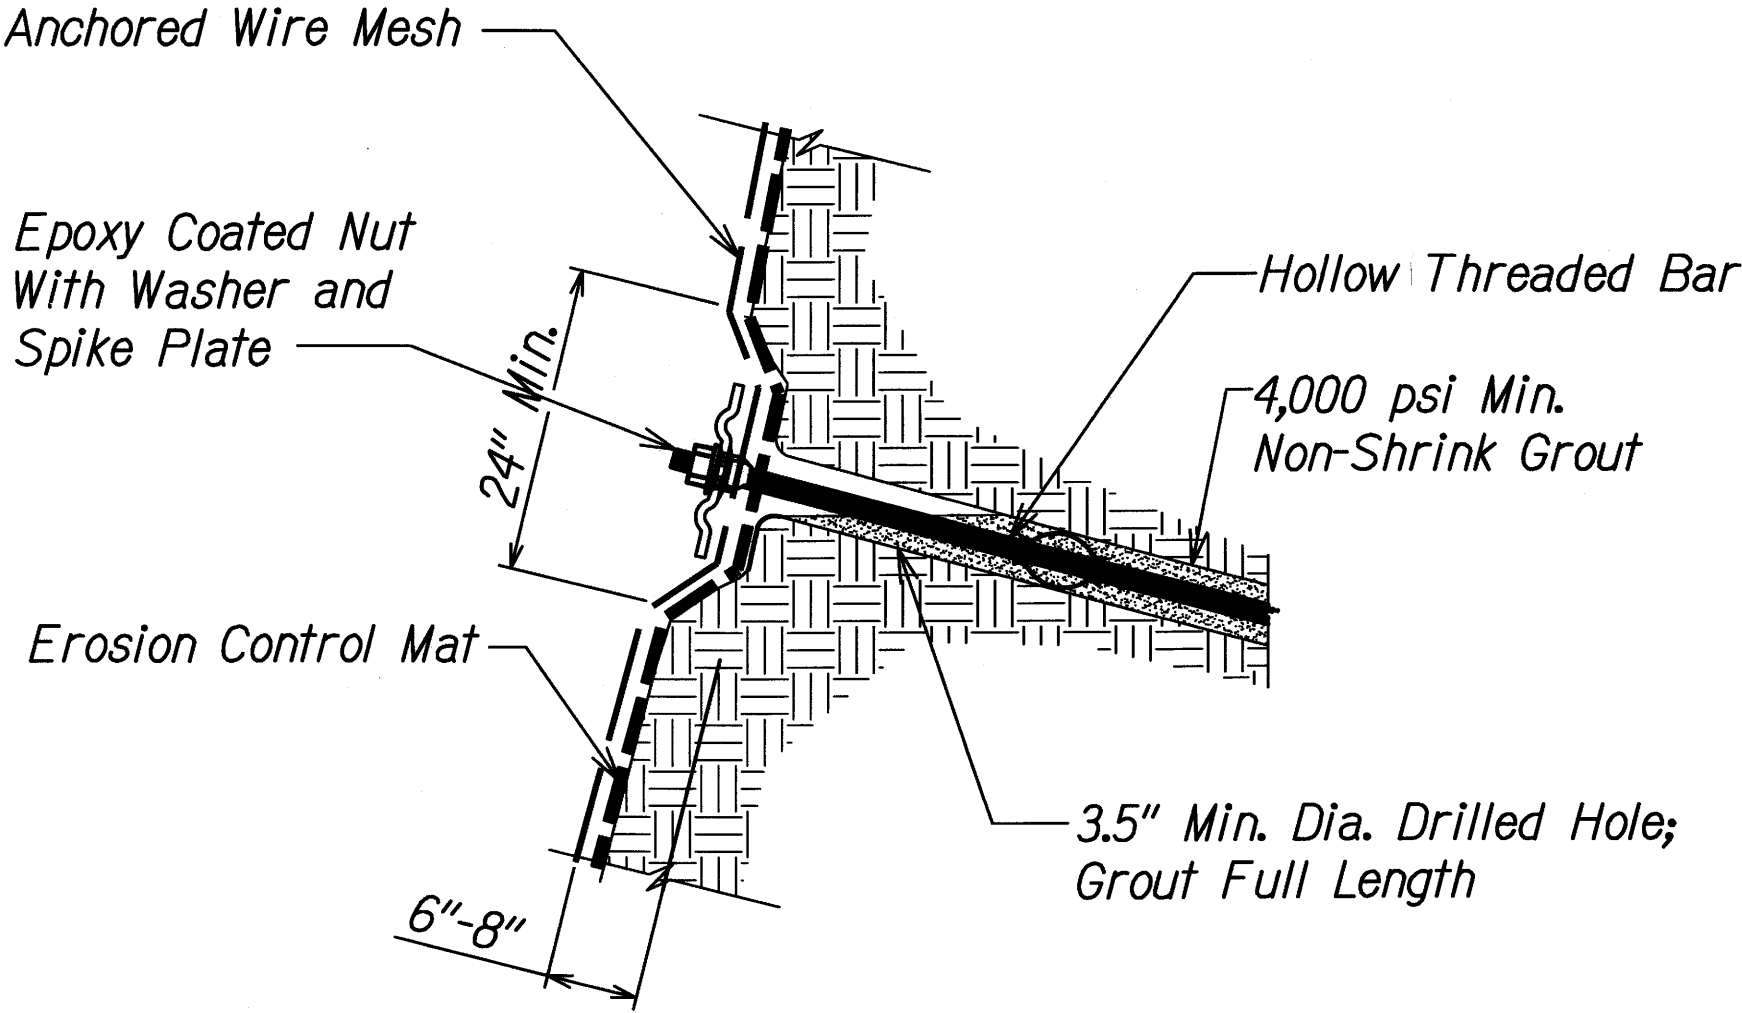

DELL ALONG SLOPE

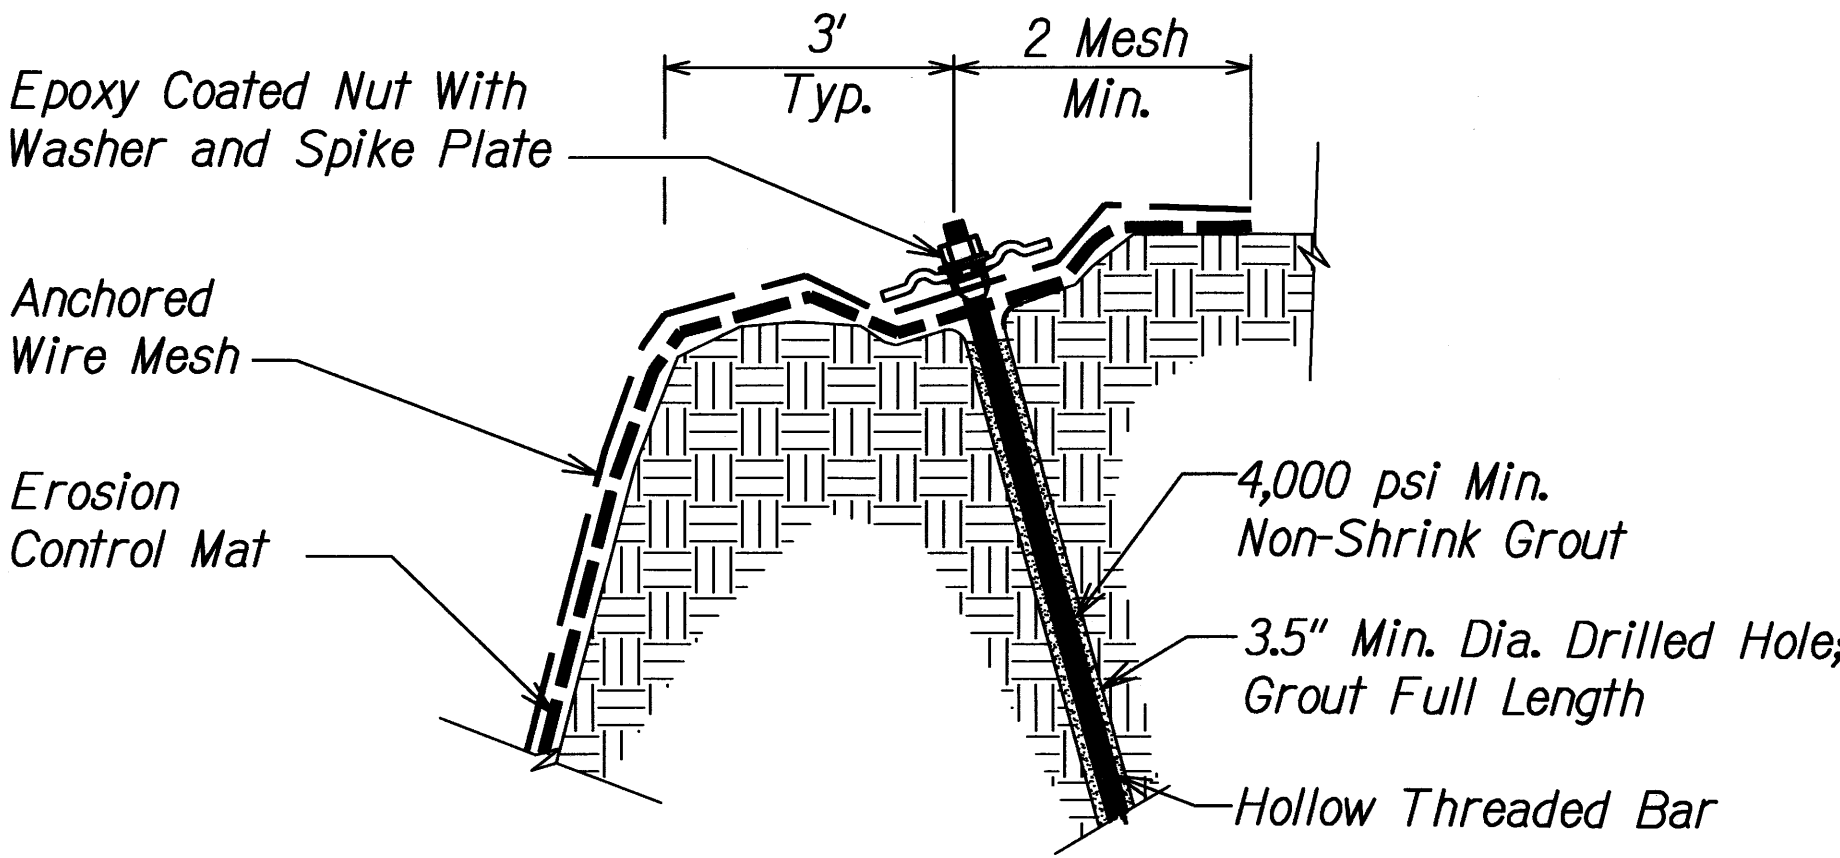

DELL AT TOP EDGE

TYPICAL DELL DETAILS
Scale: None

ORIGINAL PLAN	SURVEY PLOTTED BY	DATE
NOTE BOOK	DESIGNED BY	
	QUANTITIES BY	
	CHECKED BY	

EC-47 ANCHOR WIRE MESH DETAILS 4.DWG. 4/5/2012 10:36:01 AM

4/30/12

[Signature]


This work was prepared by me or under my supervision.

STATE OF HAWAII
DEPARTMENT OF TRANSPORTATION
HIGHWAYS DIVISION

**ANCHORED WIRE MESH
DETAILS**


SLOPE IMPROVEMENTS FOR EROSION CONTROL
AT VARIOUS SITES ON OAHU, PHASE 5
Project No. HWY-O-01-12
Scale: None Date: April 2012

FED. ROAD DIST. NO.	STATE	PROJ. NO.	FISCAL YEAR	SHEET NO.	TOTAL SHEETS
HAWAII	HAW.	HWY-O-01-12	2012	70	123

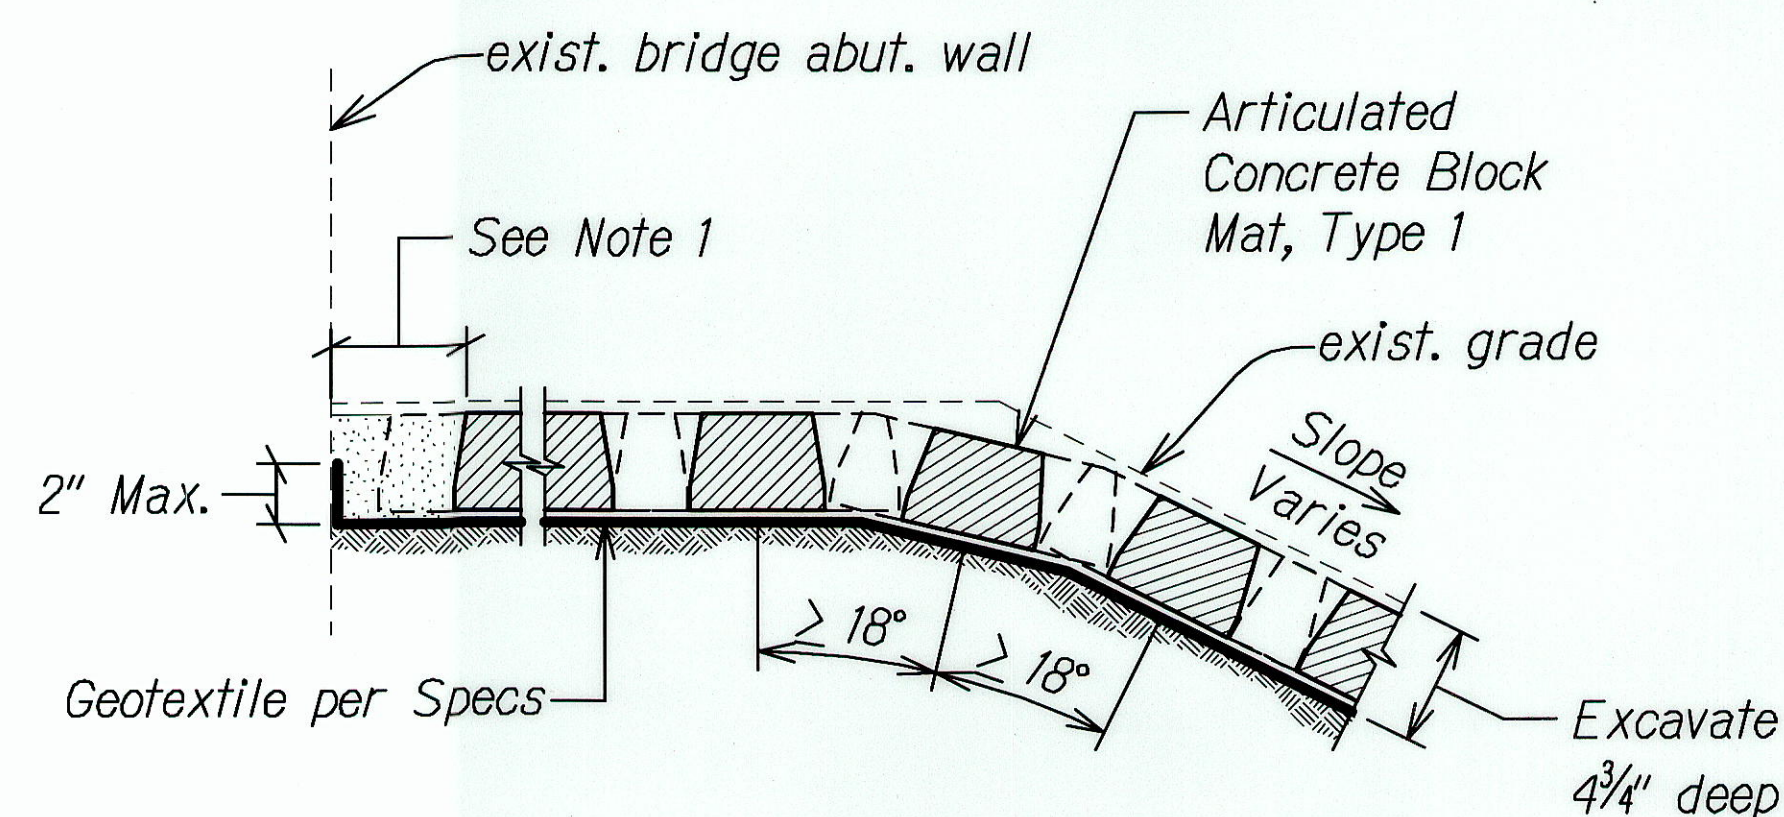

AT PEAK
ON LOCATIONS
WITH A GRADE BREAK


TYPICAL SECTION E
Scale: None

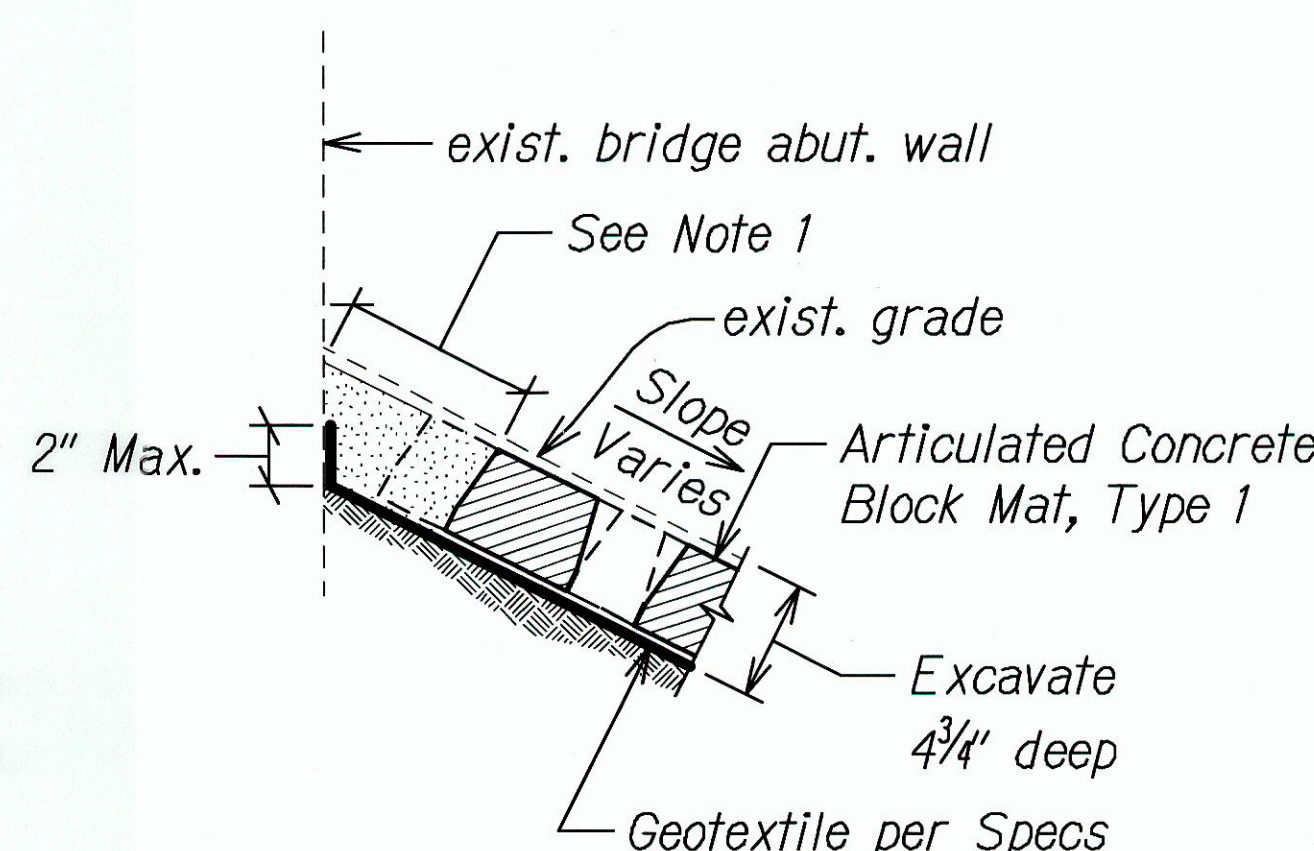


AT PEAK WITH A
CONSTANT SLOPE

NOTES:


1. Grout all gaps at peak and toe of ACBM.

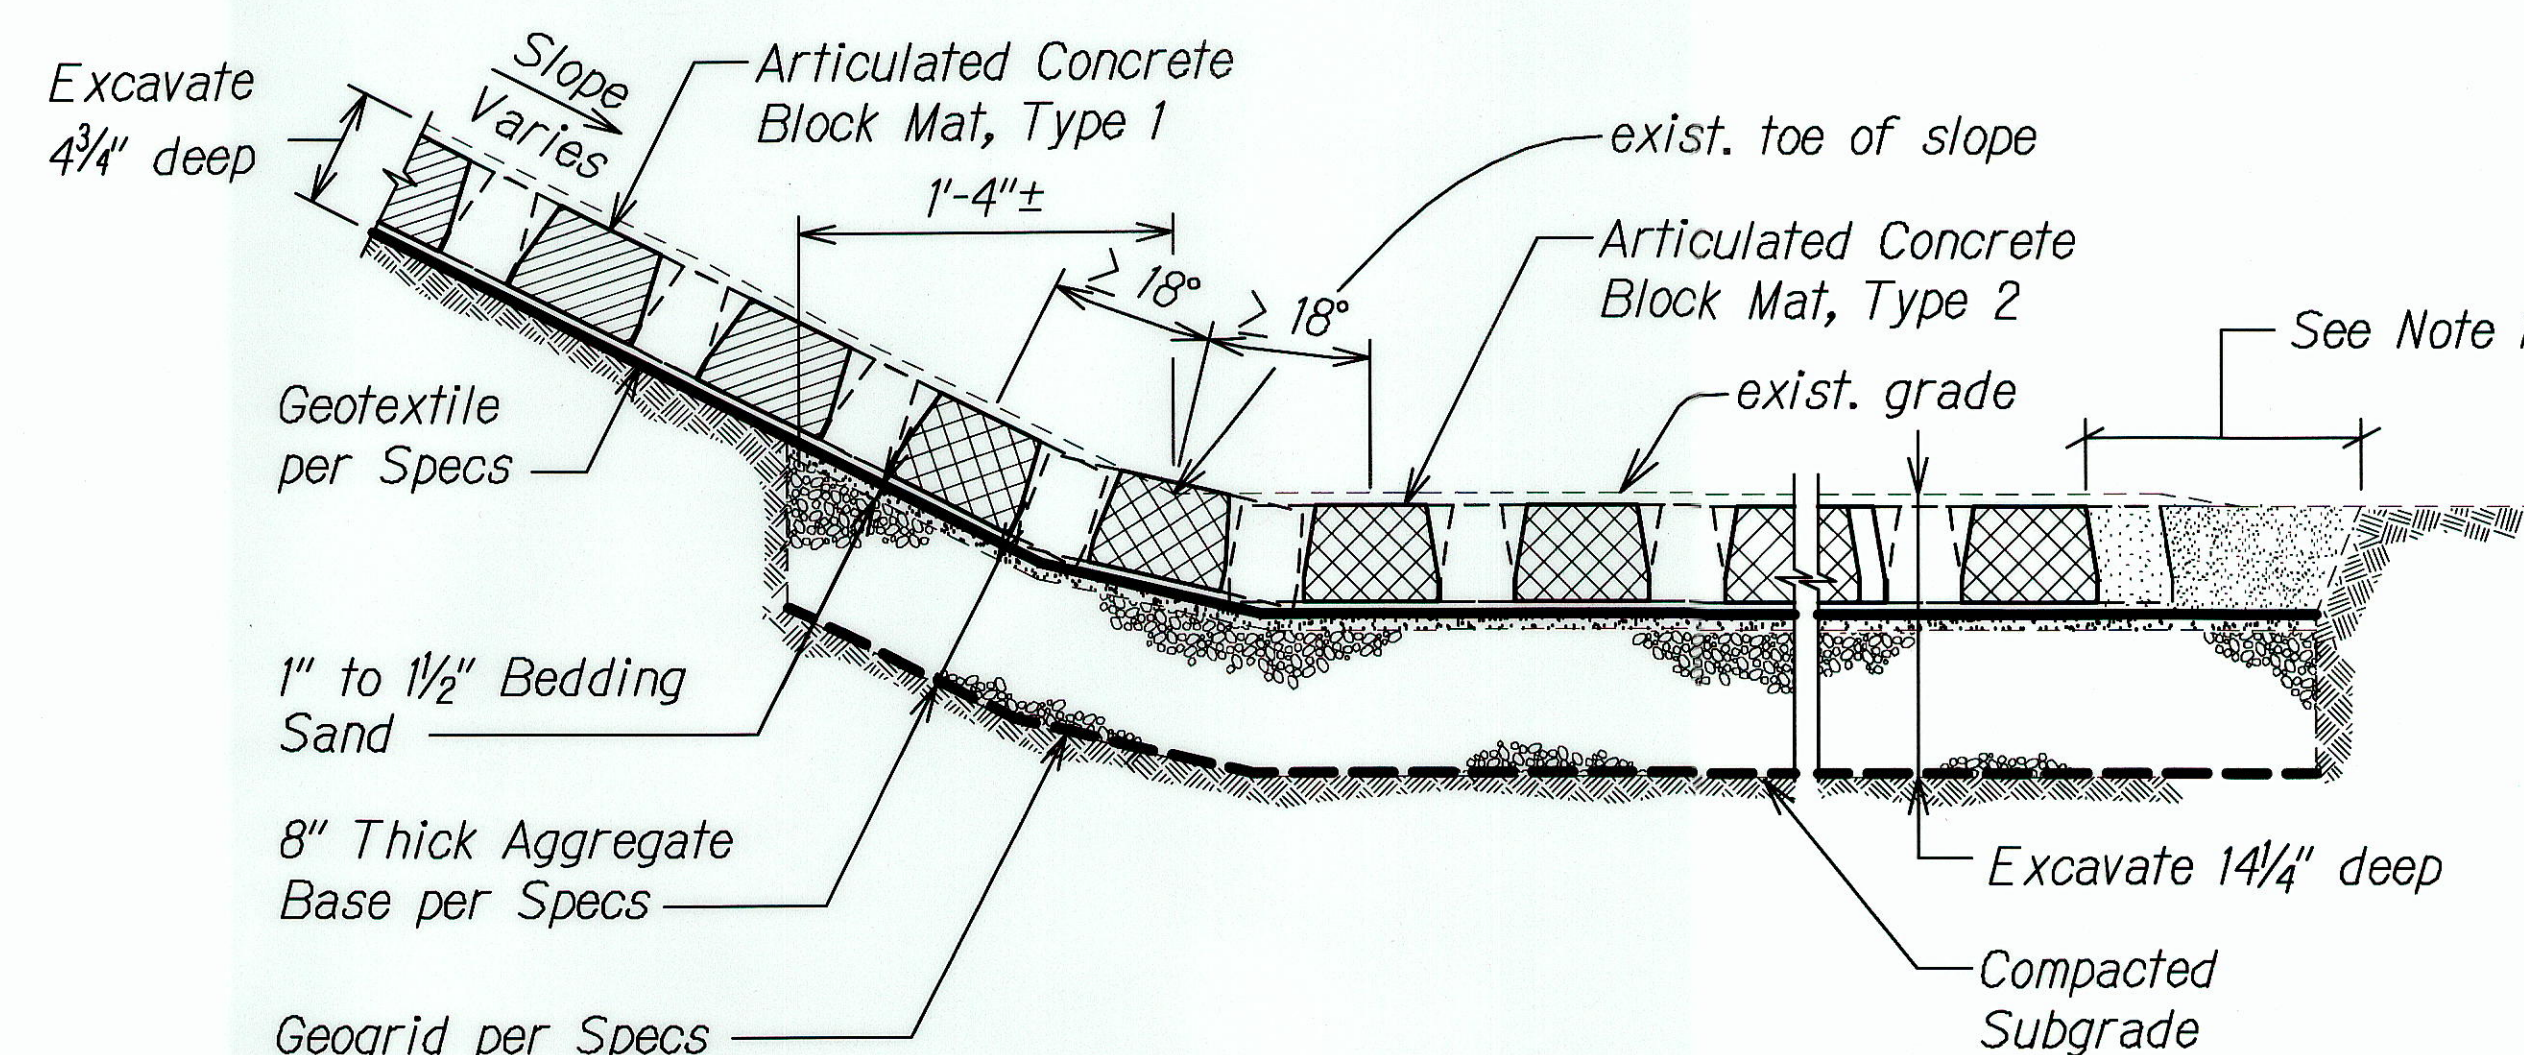

SECTION G
Scale: None

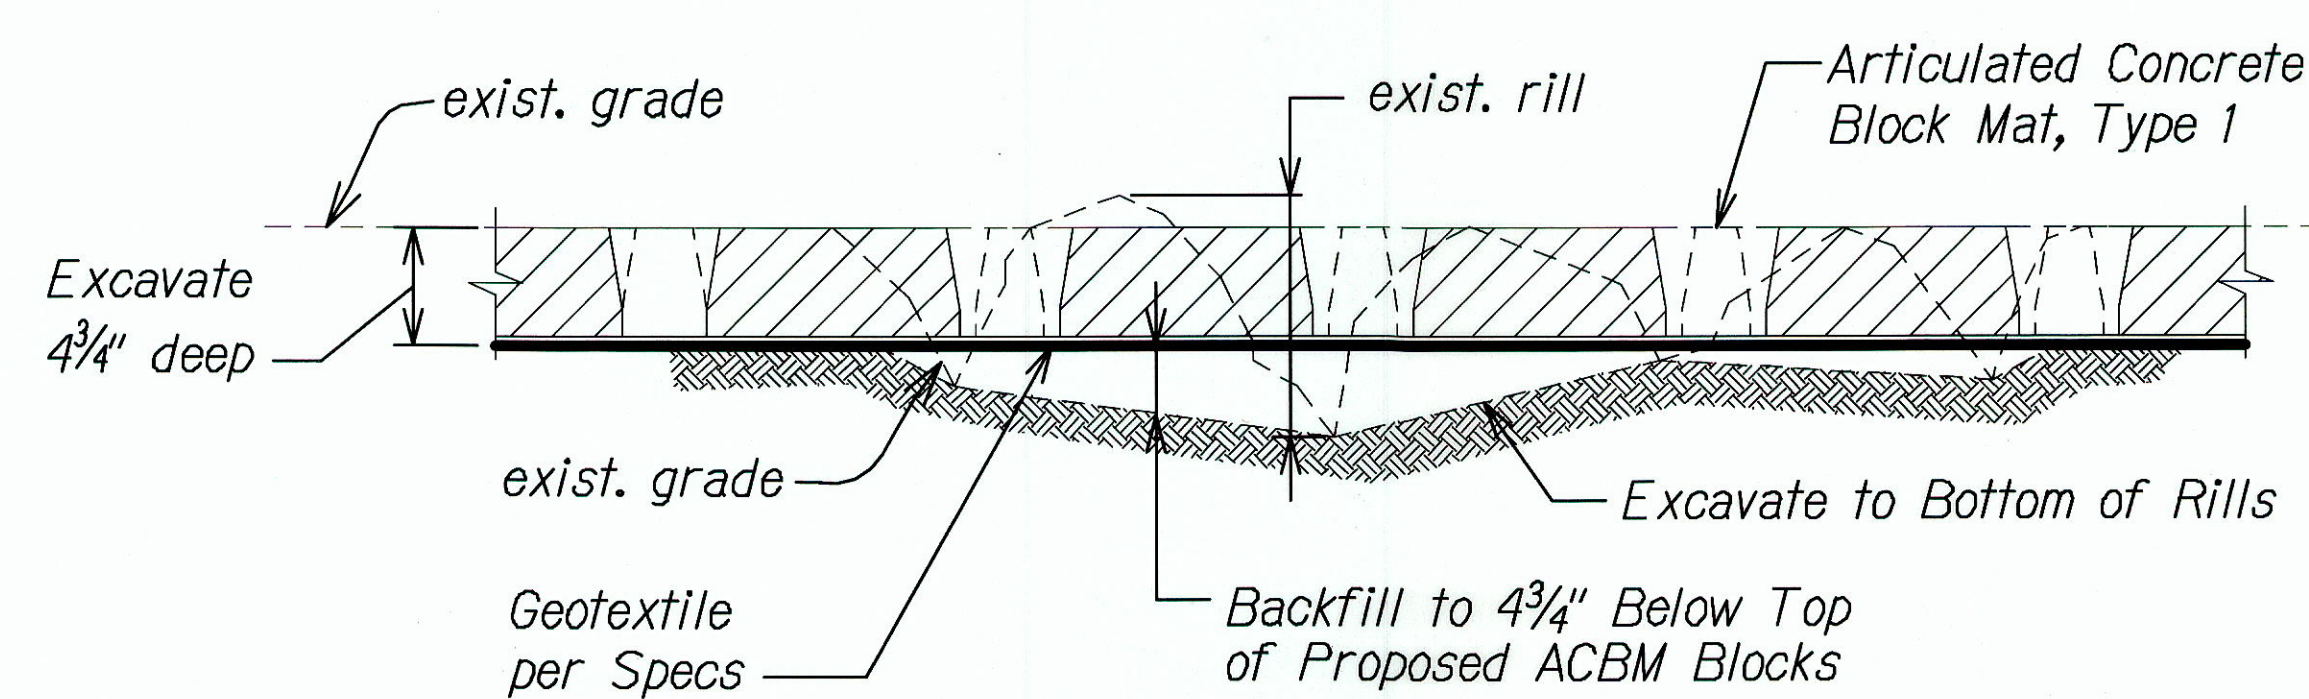

TYPICAL LONGITUDINAL VIEW OF RILLS F
Scale: None

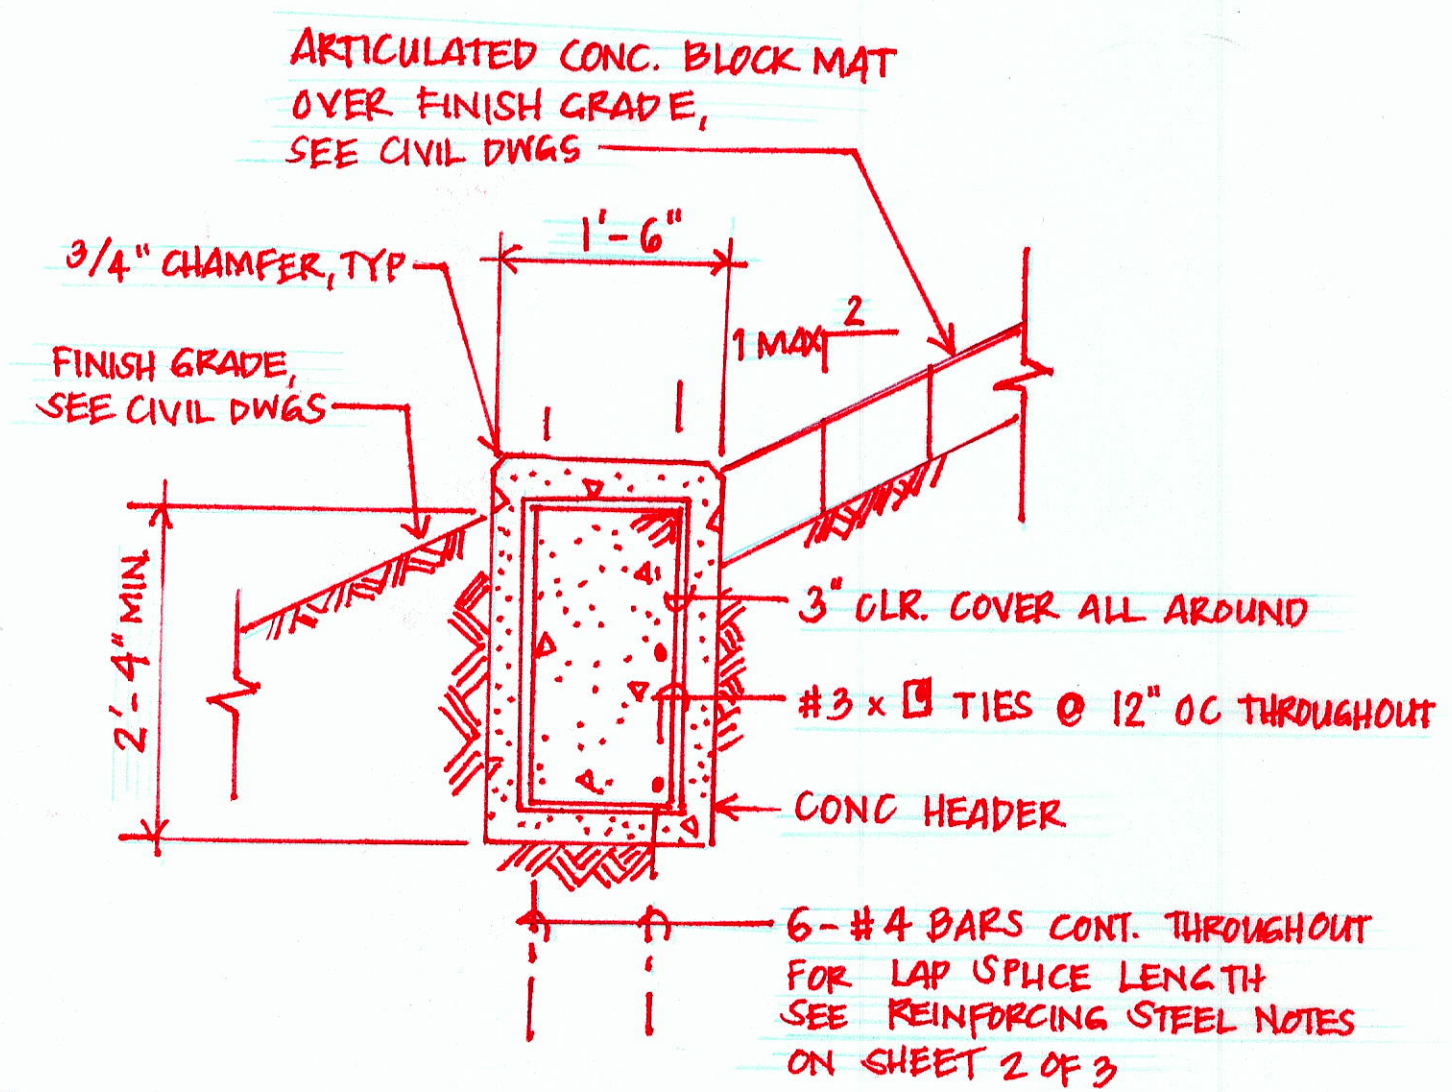

SECTION A
Scale: None

FIELD CHANGE NO. 1
REVISED CONCRETE HEADERS AT SITE 18 AND 19

SURVEY PLOTTED BY	DATE
DRAWN BY	
DESIGNED BY	
QUANTITIES BY	
CHECKED BY	
ORIGINAL PLAN	
NOTE BOOK	
No.	

ACBM DETAILING 1/4/2012 4:04:44 PM

4/30/12
This work was prepared by me or under my supervision.

STATE OF HAWAII
DEPARTMENT OF TRANSPORTATION
HIGHWAYS DIVISION

ARTICULATED CONCRETE BLOCK MAT DETAILS

SLOPE IMPROVEMENTS FOR EROSION CONTROL
AT VARIOUS SITES ON OAHU, PHASE 5
Project No. HWY-O-01-12
Scale: None Date: April 2012

"AS-BUILT"