




FED. ROAD DIST. NO.	STATE	PROJ. NO.	FISCAL YEAR	SHEET NO.	TOTAL SHEETS
HAWAII	HAW.	HWY-0-01-12	2012	3	123

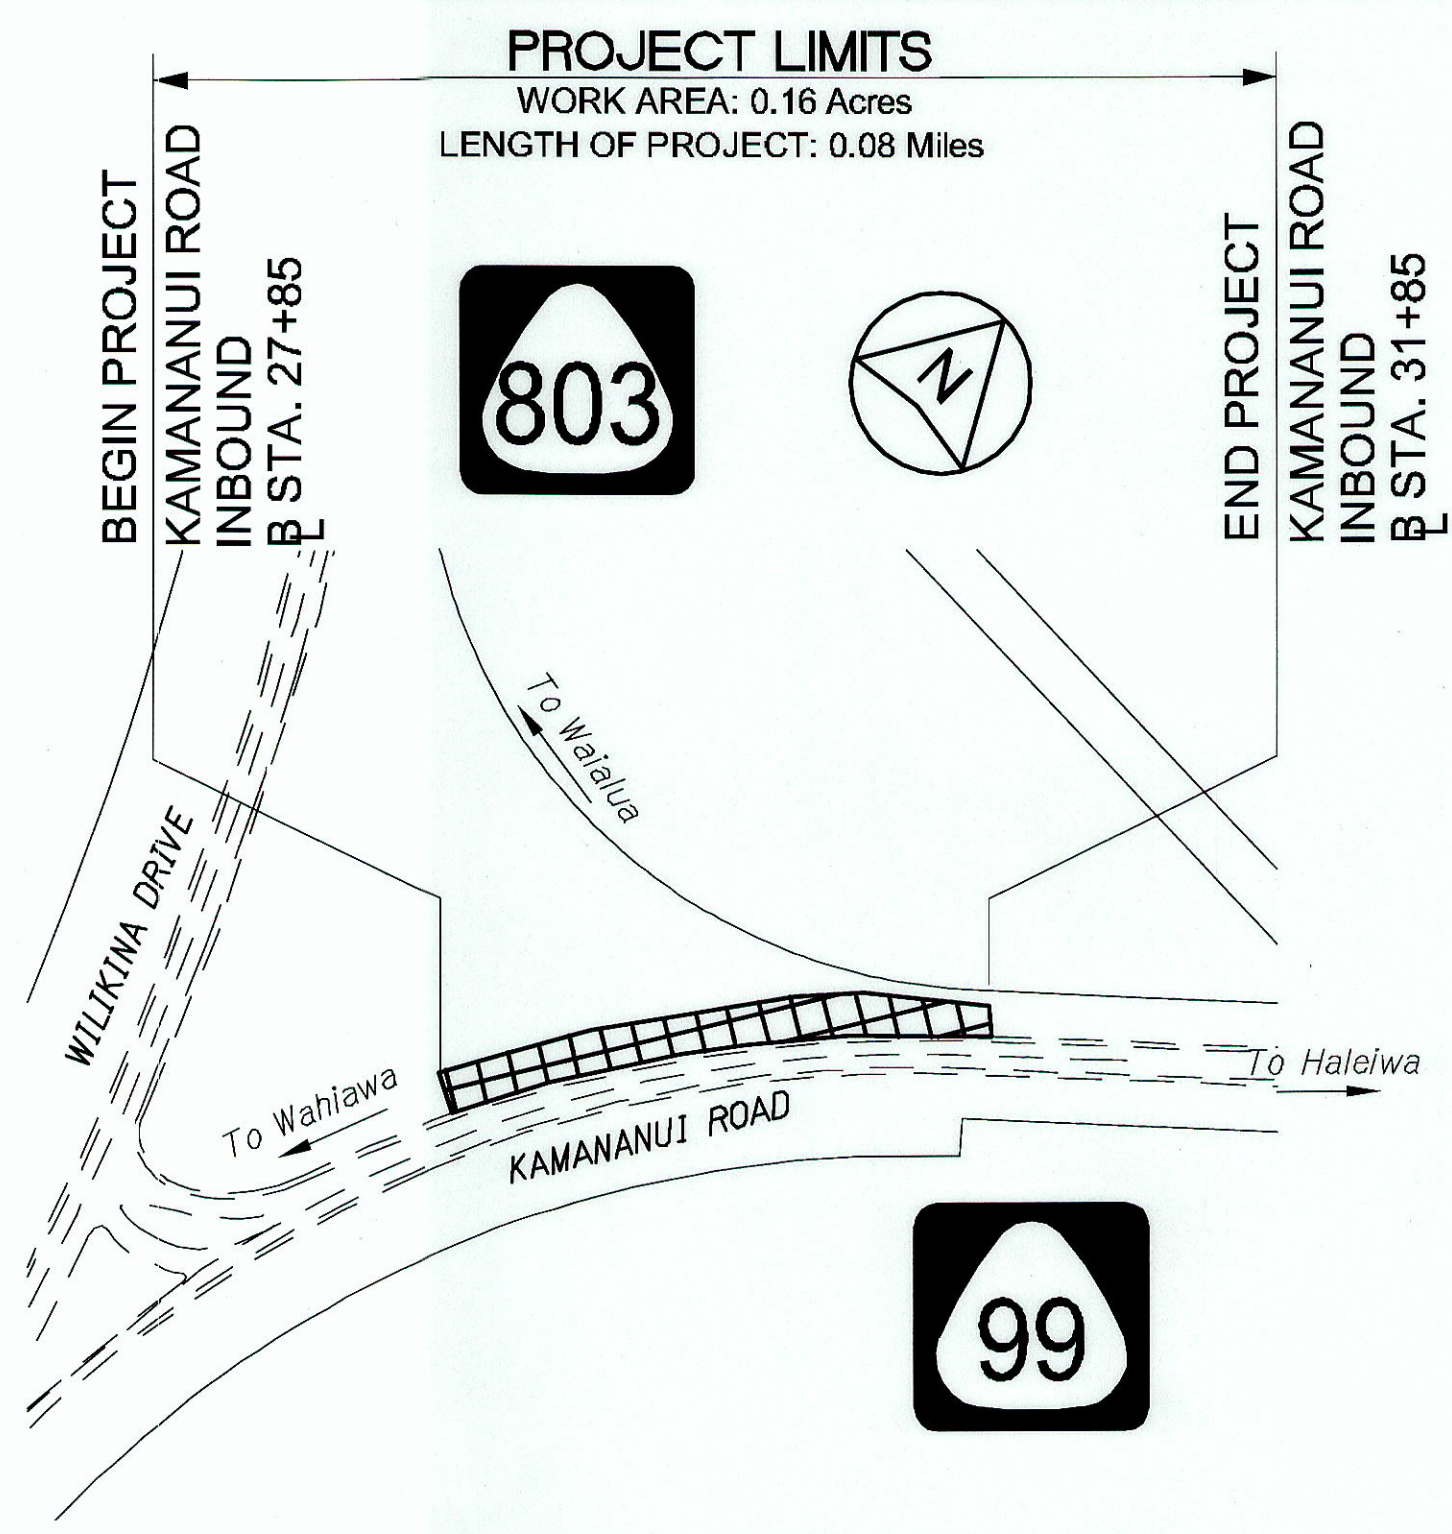


**KAMANANUI ROAD
LOCATION PLAN - SITE 1**
NOT TO SCALE

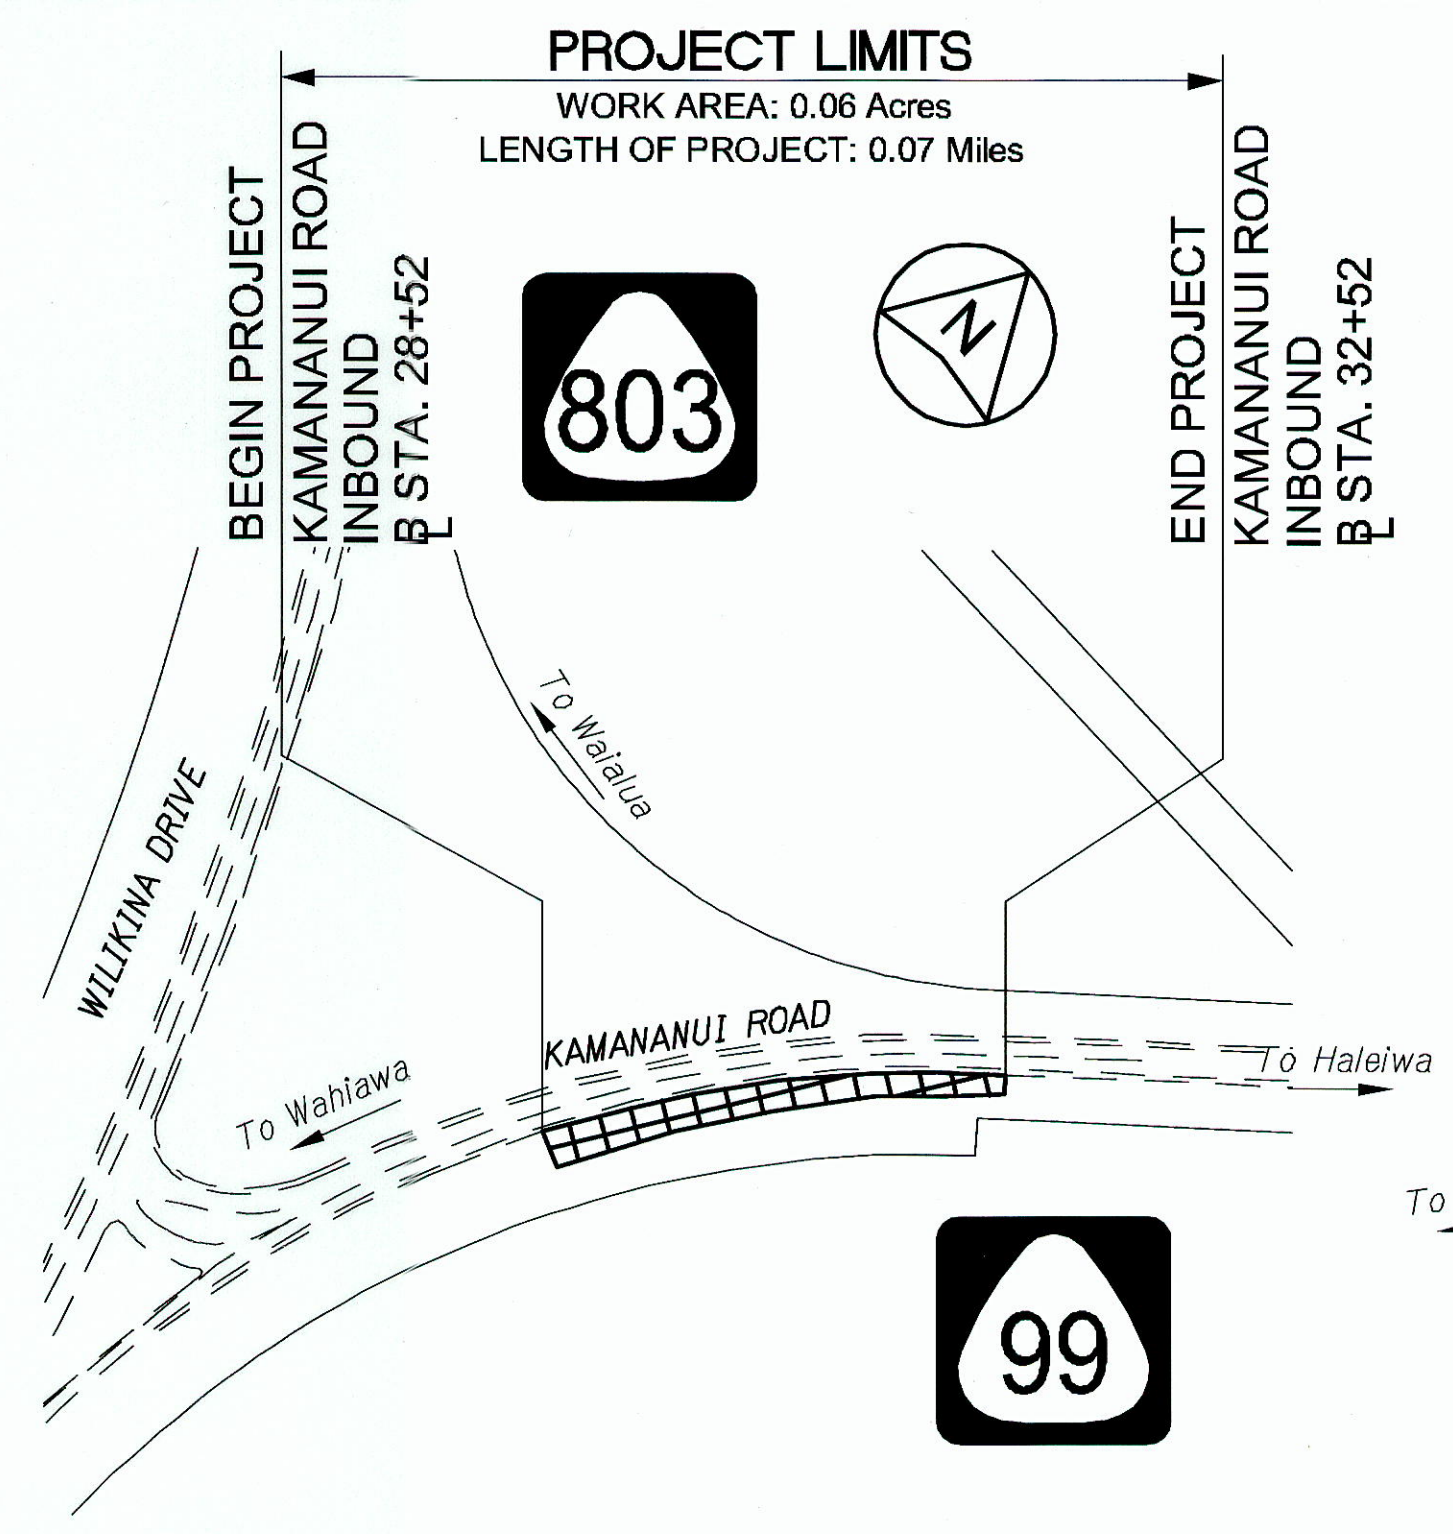


**KAMANANUI ROAD
LOCATION PLAN - SITE 2**
NOT TO SCALE

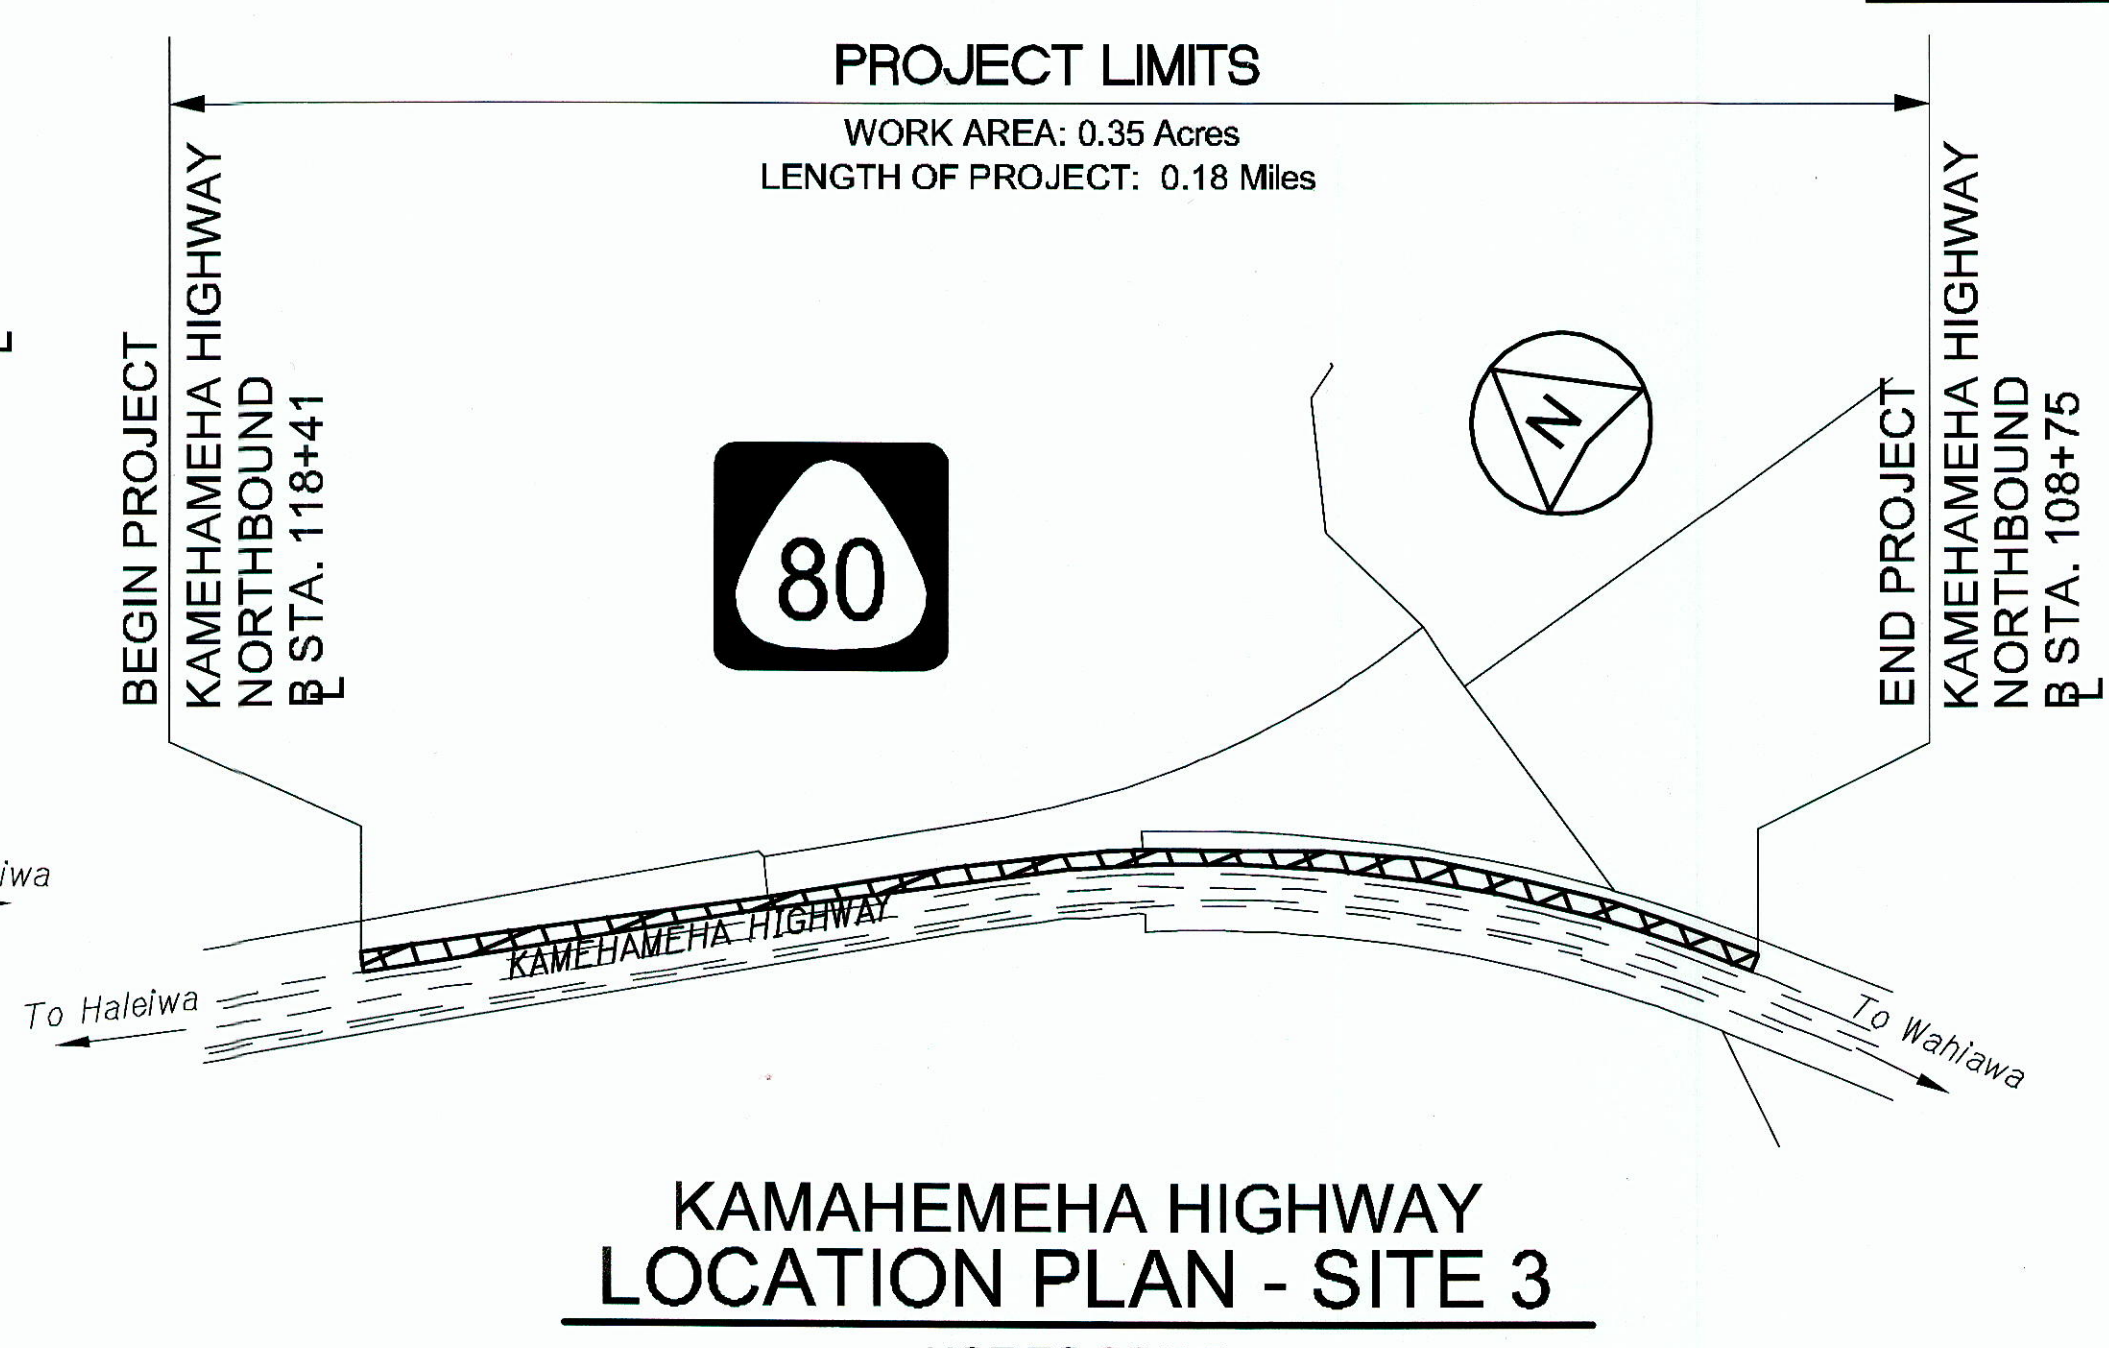


**KAMAHAMEHA HIGHWAY
LOCATION PLAN - SITE 3**
NOT TO SCALE

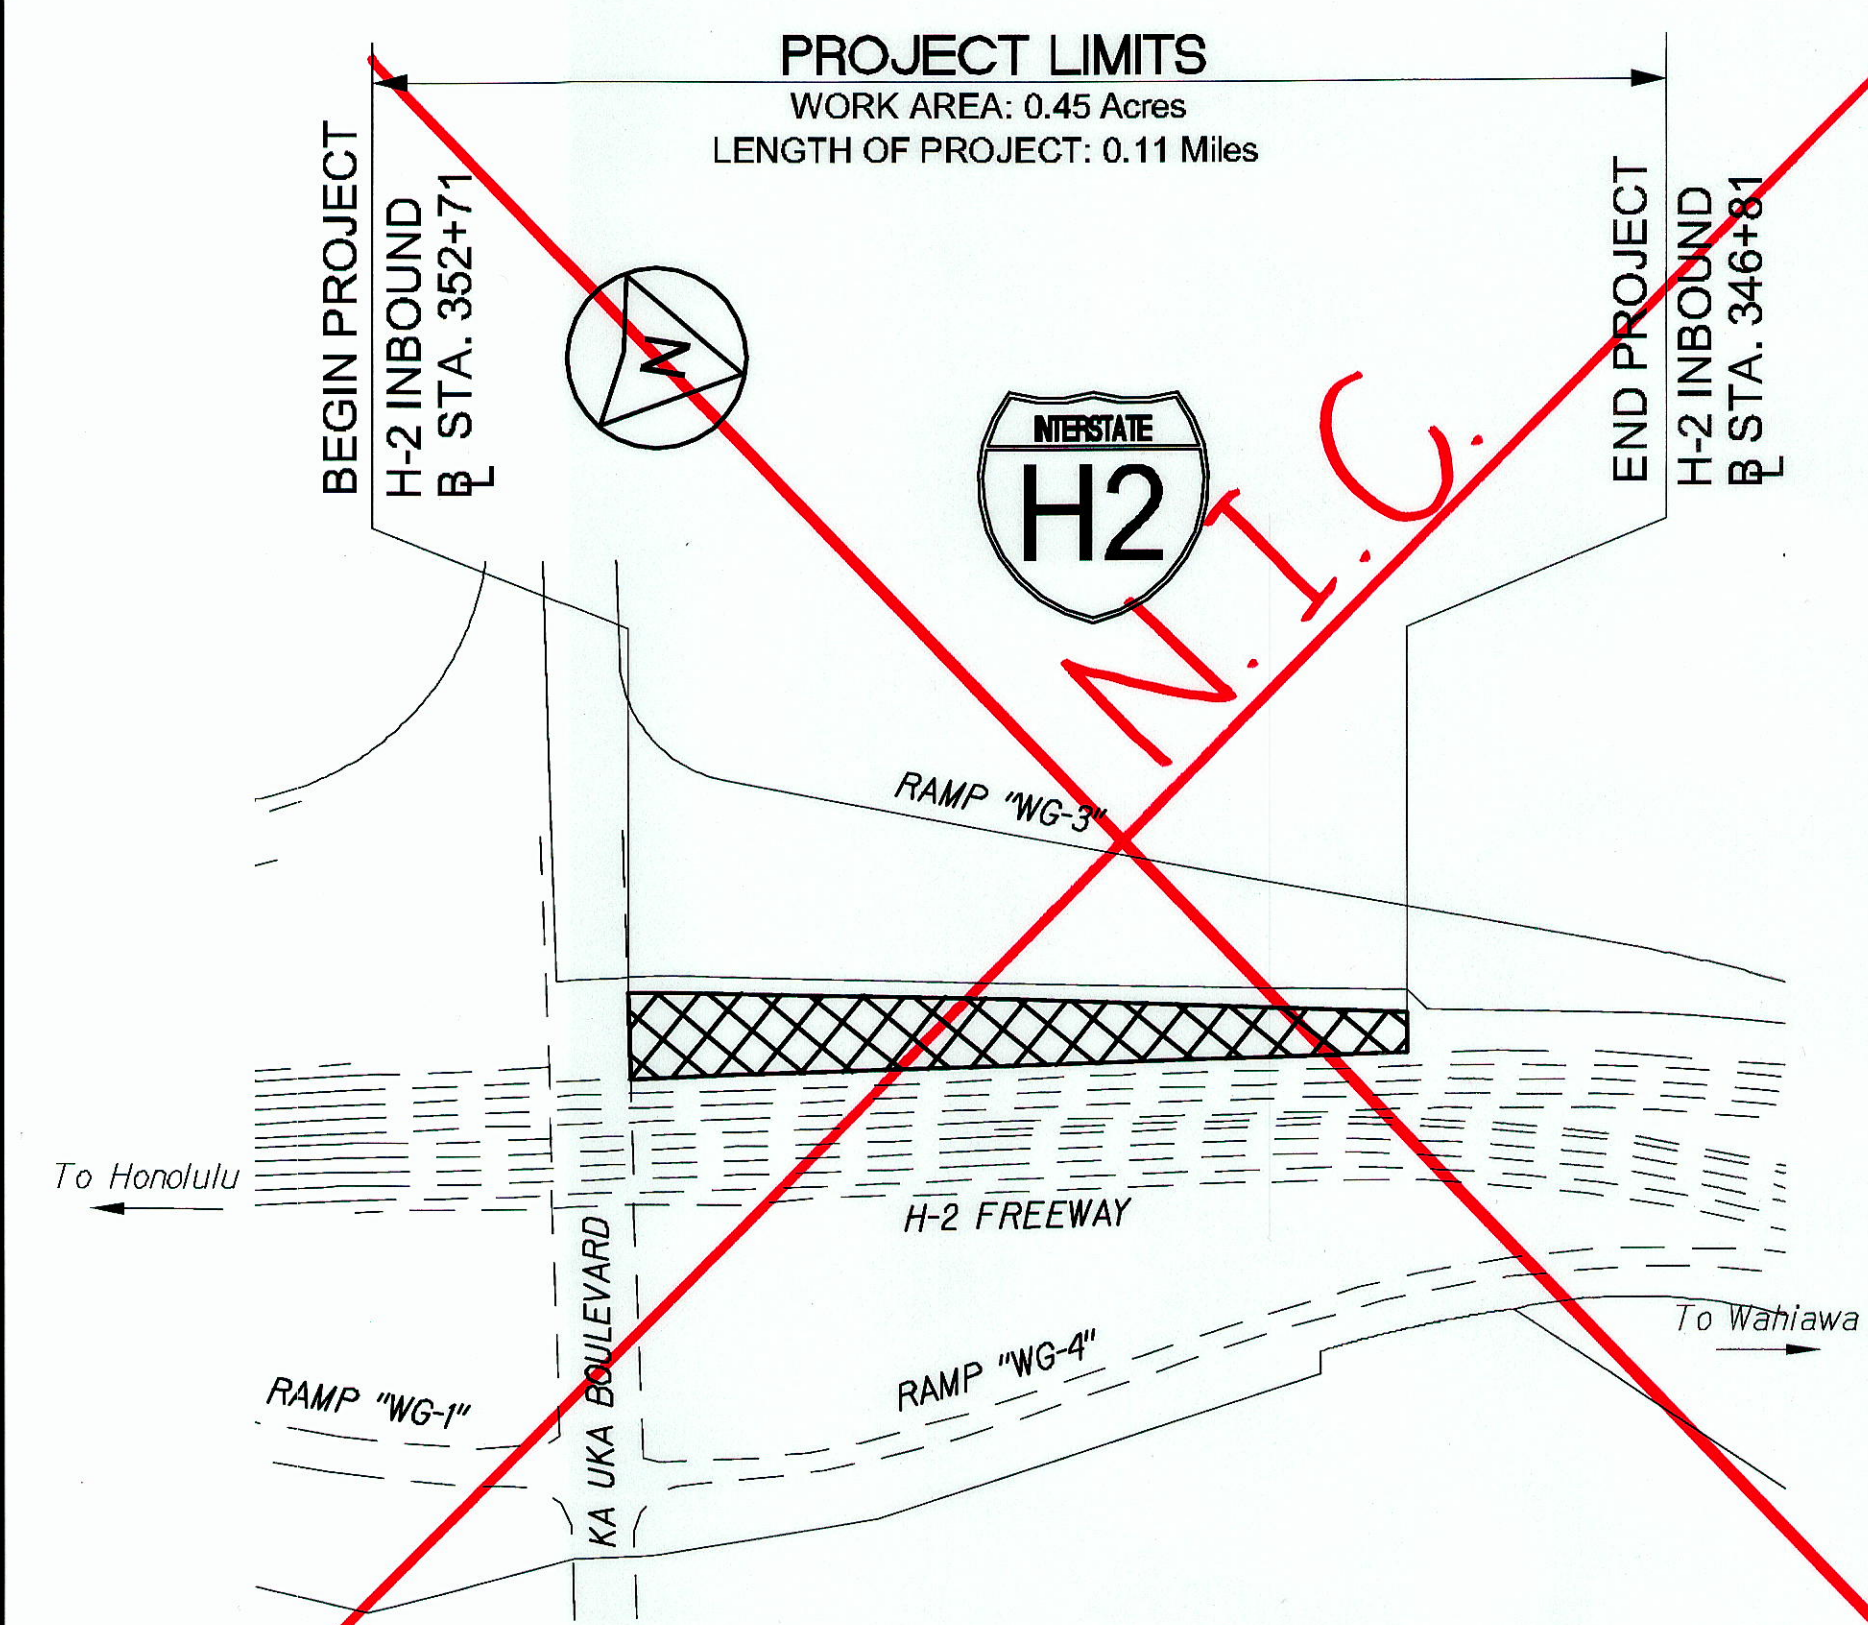

**INTERSTATE ROUTE H-2
LOCATION PLAN - SITE 4**
NOT TO SCALE

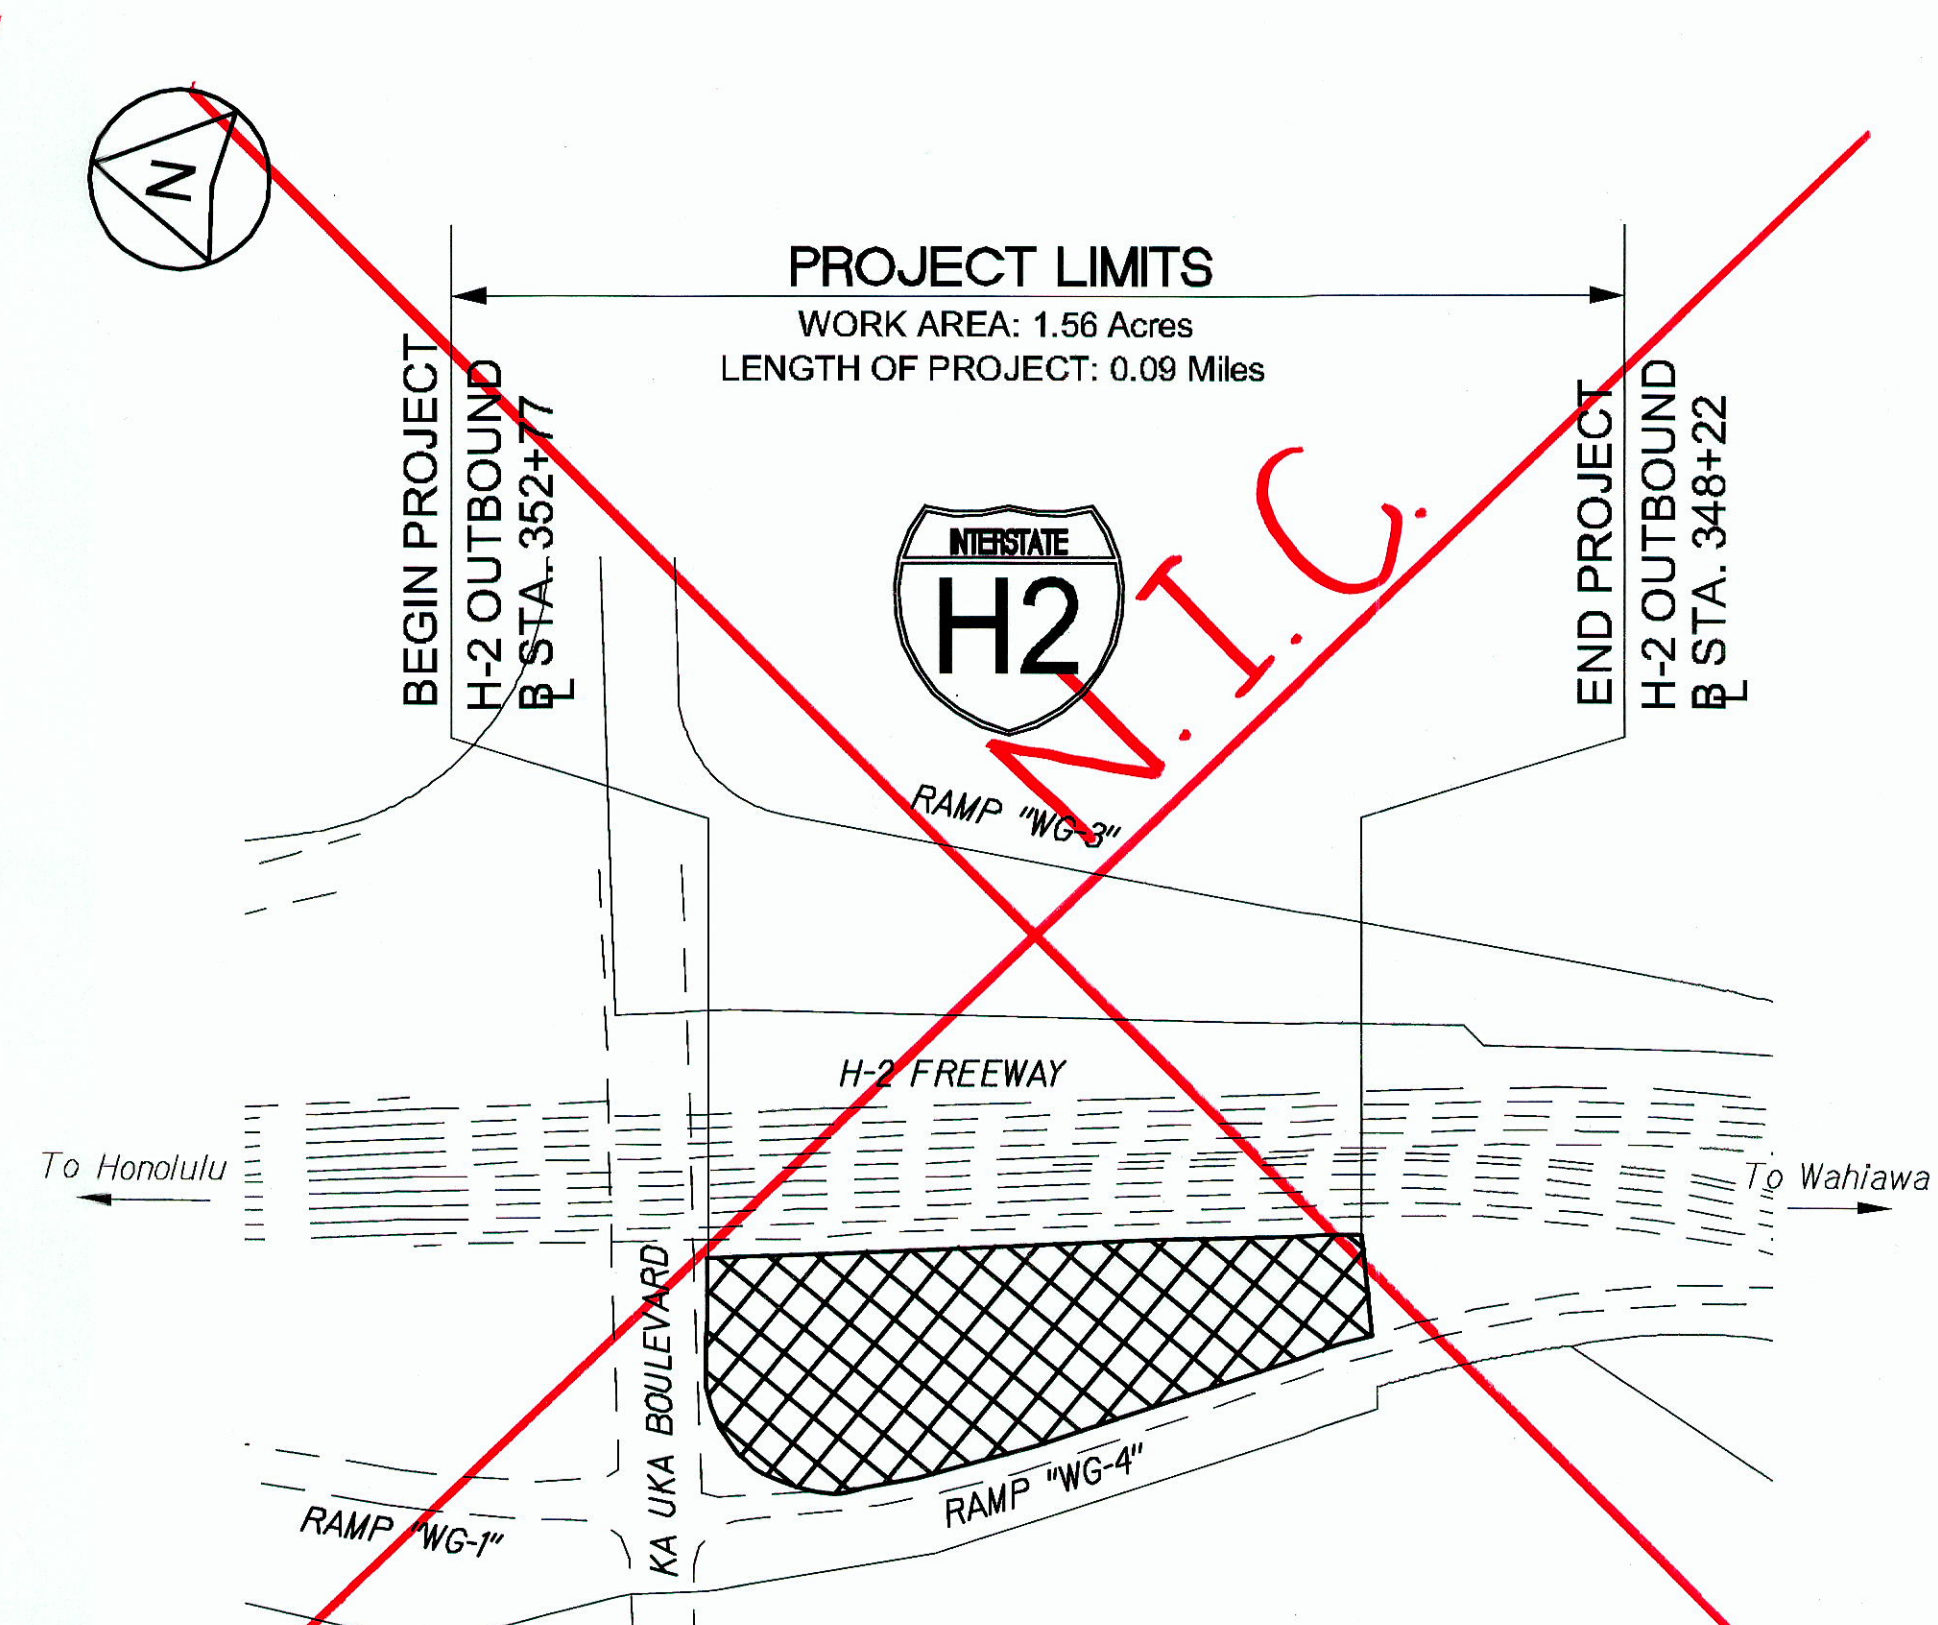

**INTERSTATE ROUTE H-2
LOCATION PLAN - SITE 5**
NOT TO SCALE

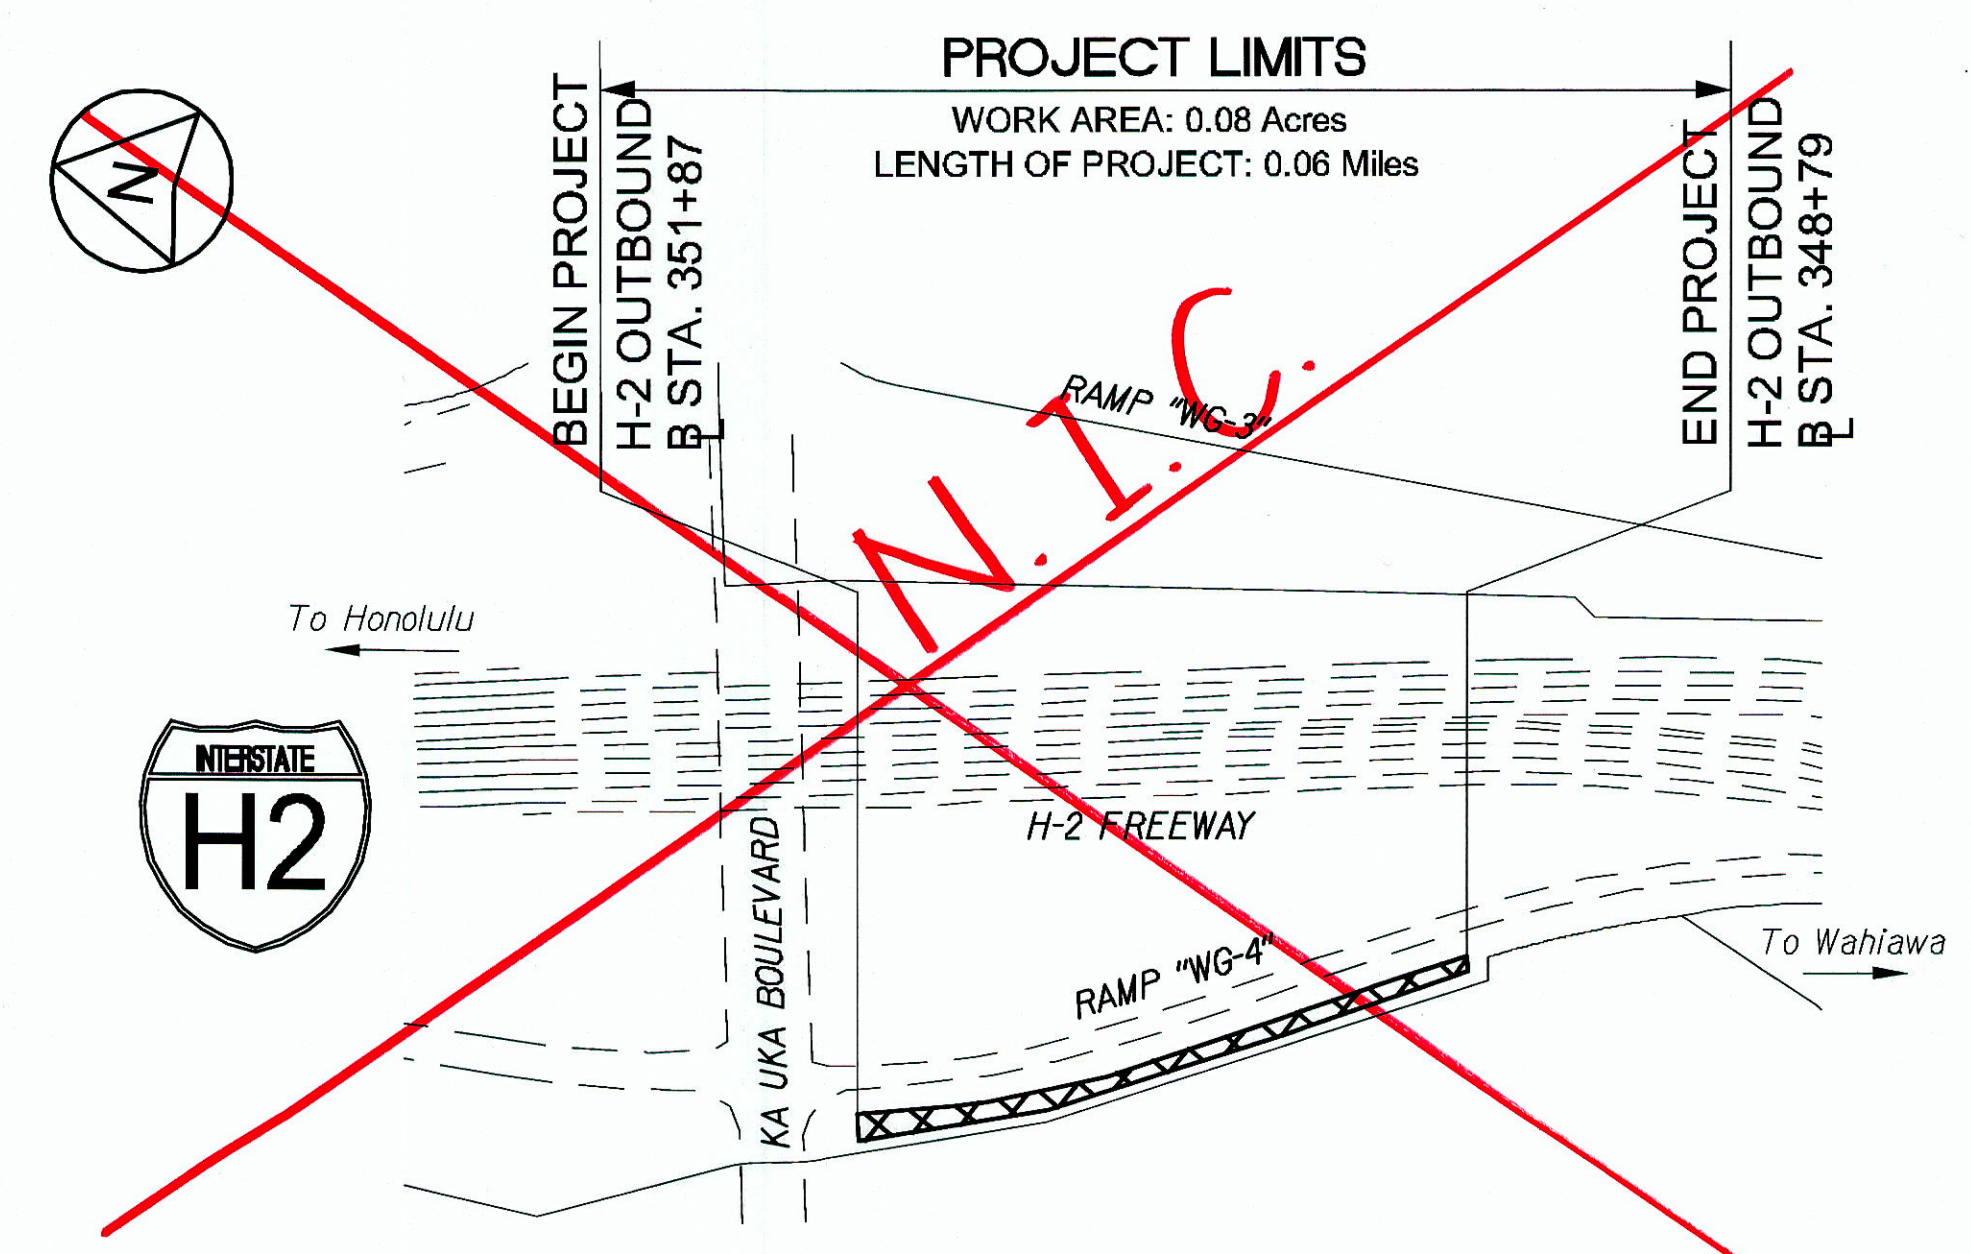

**INTERSTATE ROUTE H-2
LOCATION PLAN - SITE 6**
NOT TO SCALE

ORIGINAL PLAN	SURVEY PLOTTED BY	DATE
TRACED BY		
NOTE BOOK		
QUANTITIES BY		
CHECKED BY		
N.		

01 LOCATION PLANS 1/20/2012 2:45:51 PM

STATE OF HAWAII
DEPARTMENT OF TRANSPORTATION
HIGHWAYS DIVISION






**LOCATION PLAN
SITES 1-6**

SLOPE IMPROVEMENTS FOR EROSION CONTROL
AT VARIOUS SITES ON OAHU, PHASE 5

Project No. HWY-0-01-12
Scale: None Date: April 2012

"AS-BUILT"

FED. ROAD DIST. NO.	STATE	PROJ. NO.	FISCAL YEAR	SHEET NO.	TOTAL SHEETS
HAWAII	HAW.	HWY-0-01-12	2012	4	123

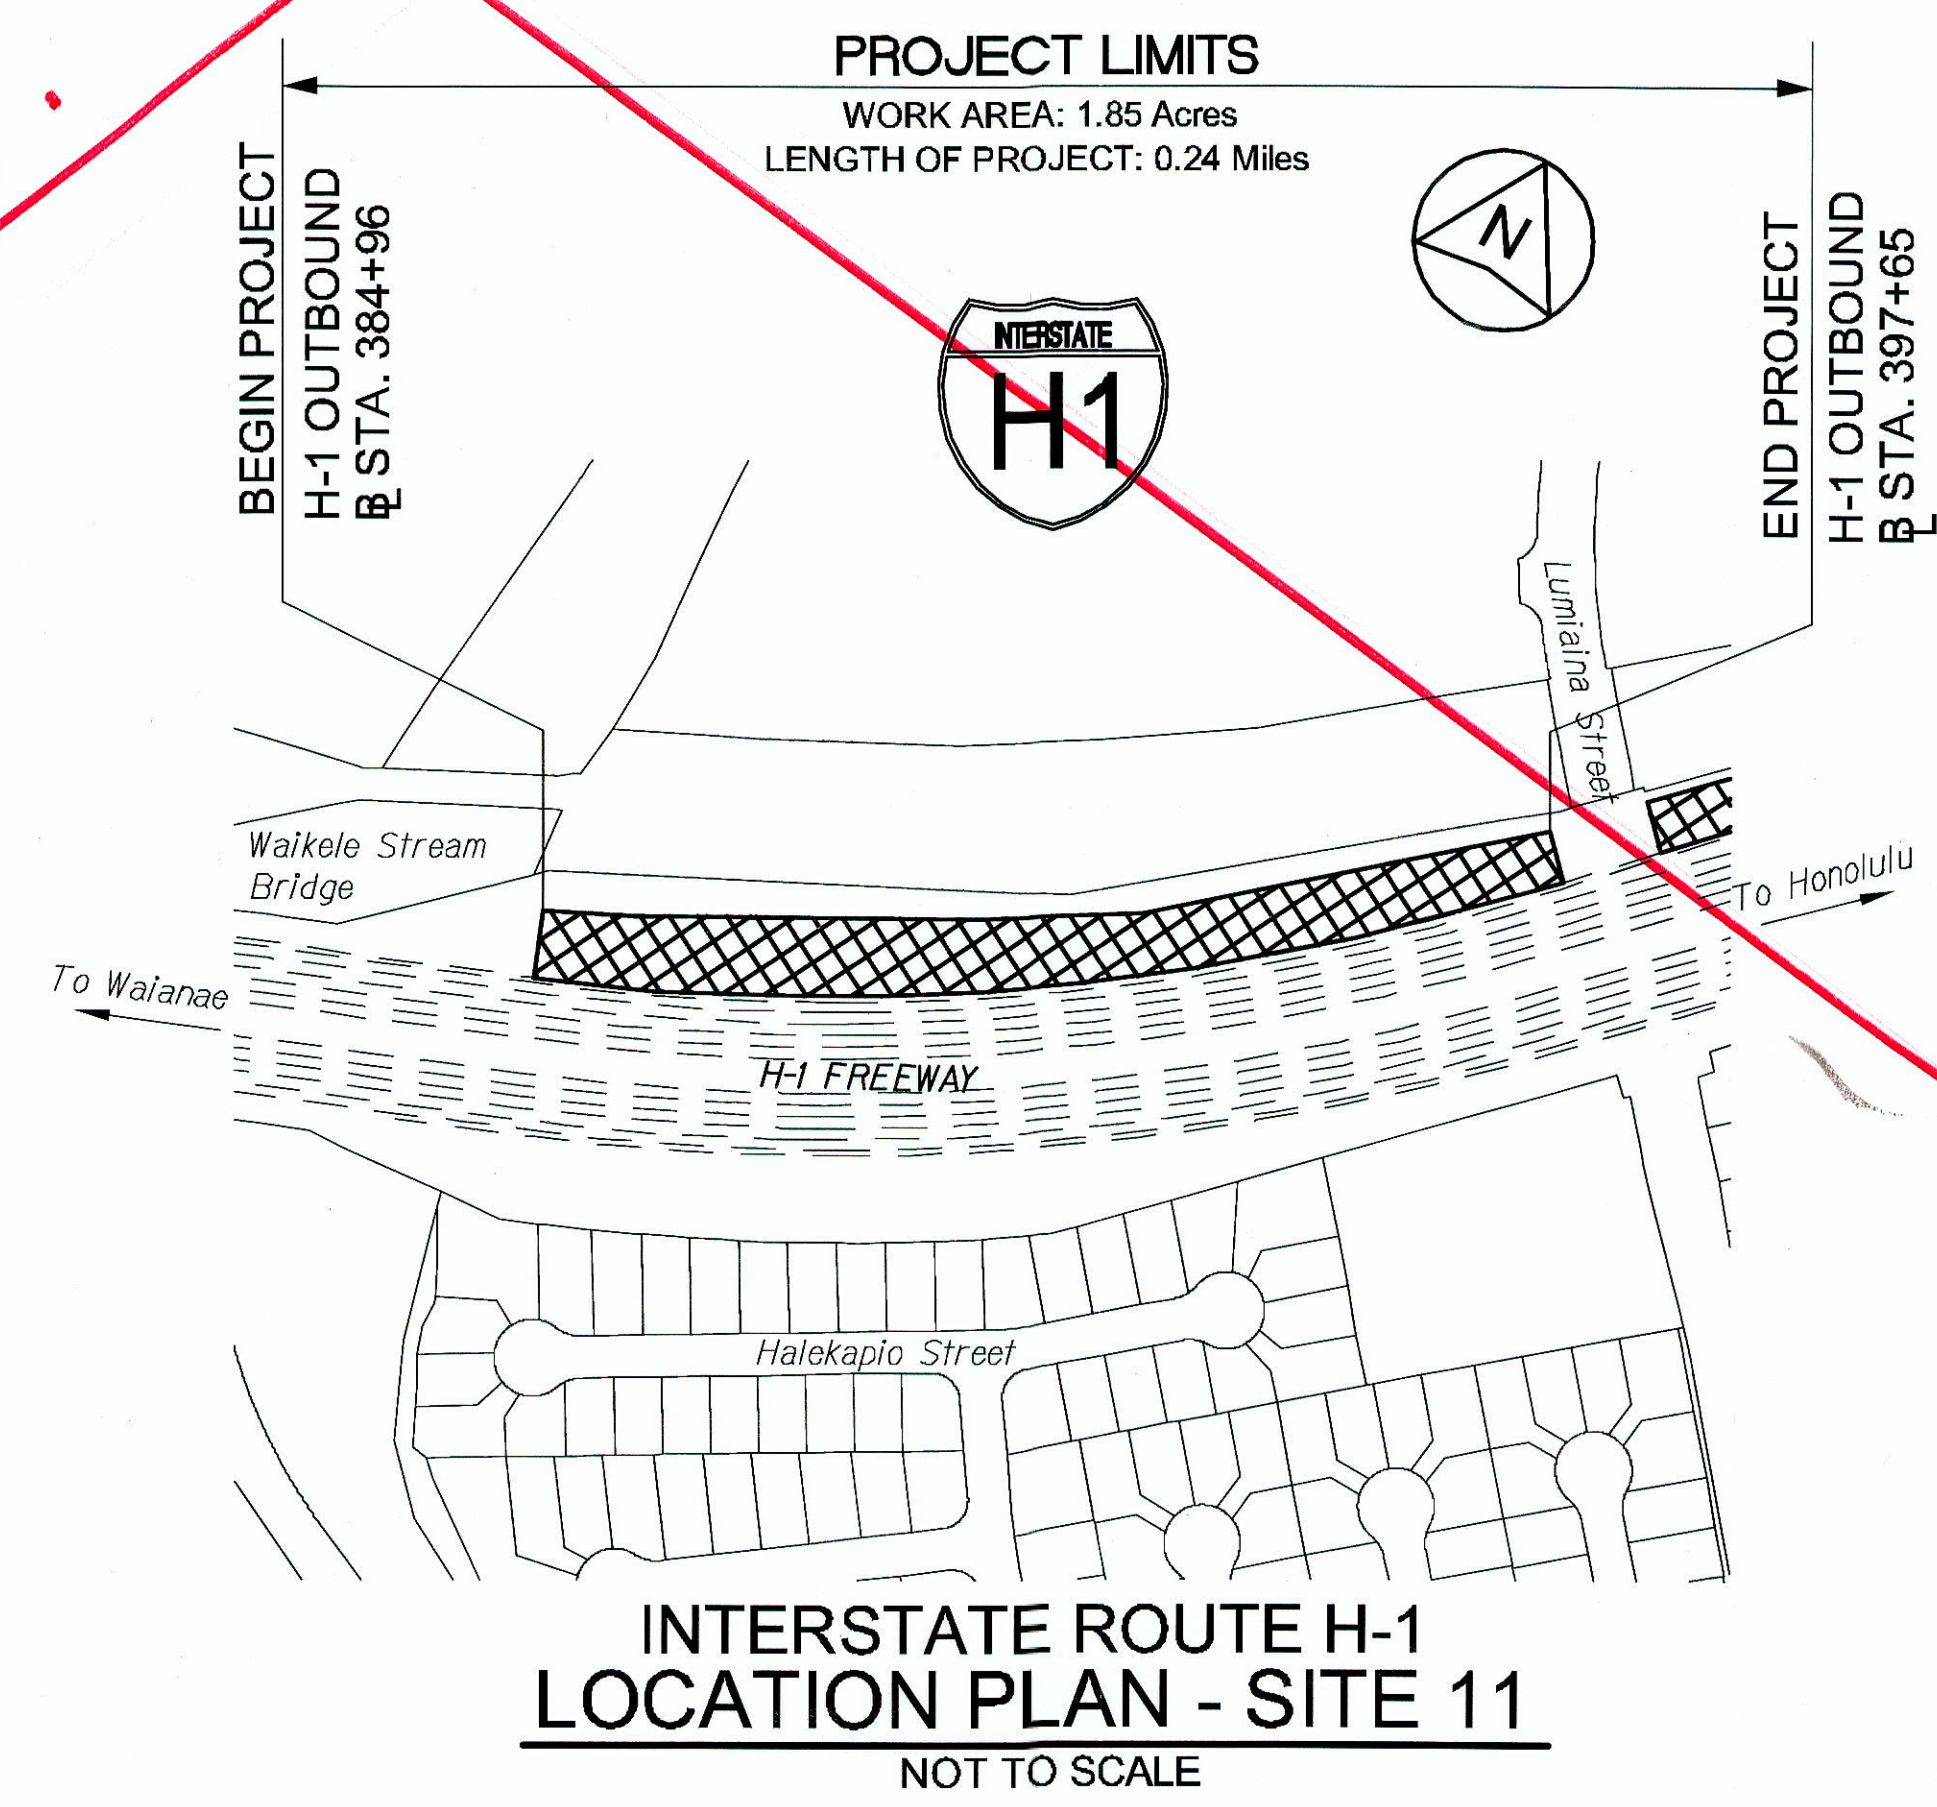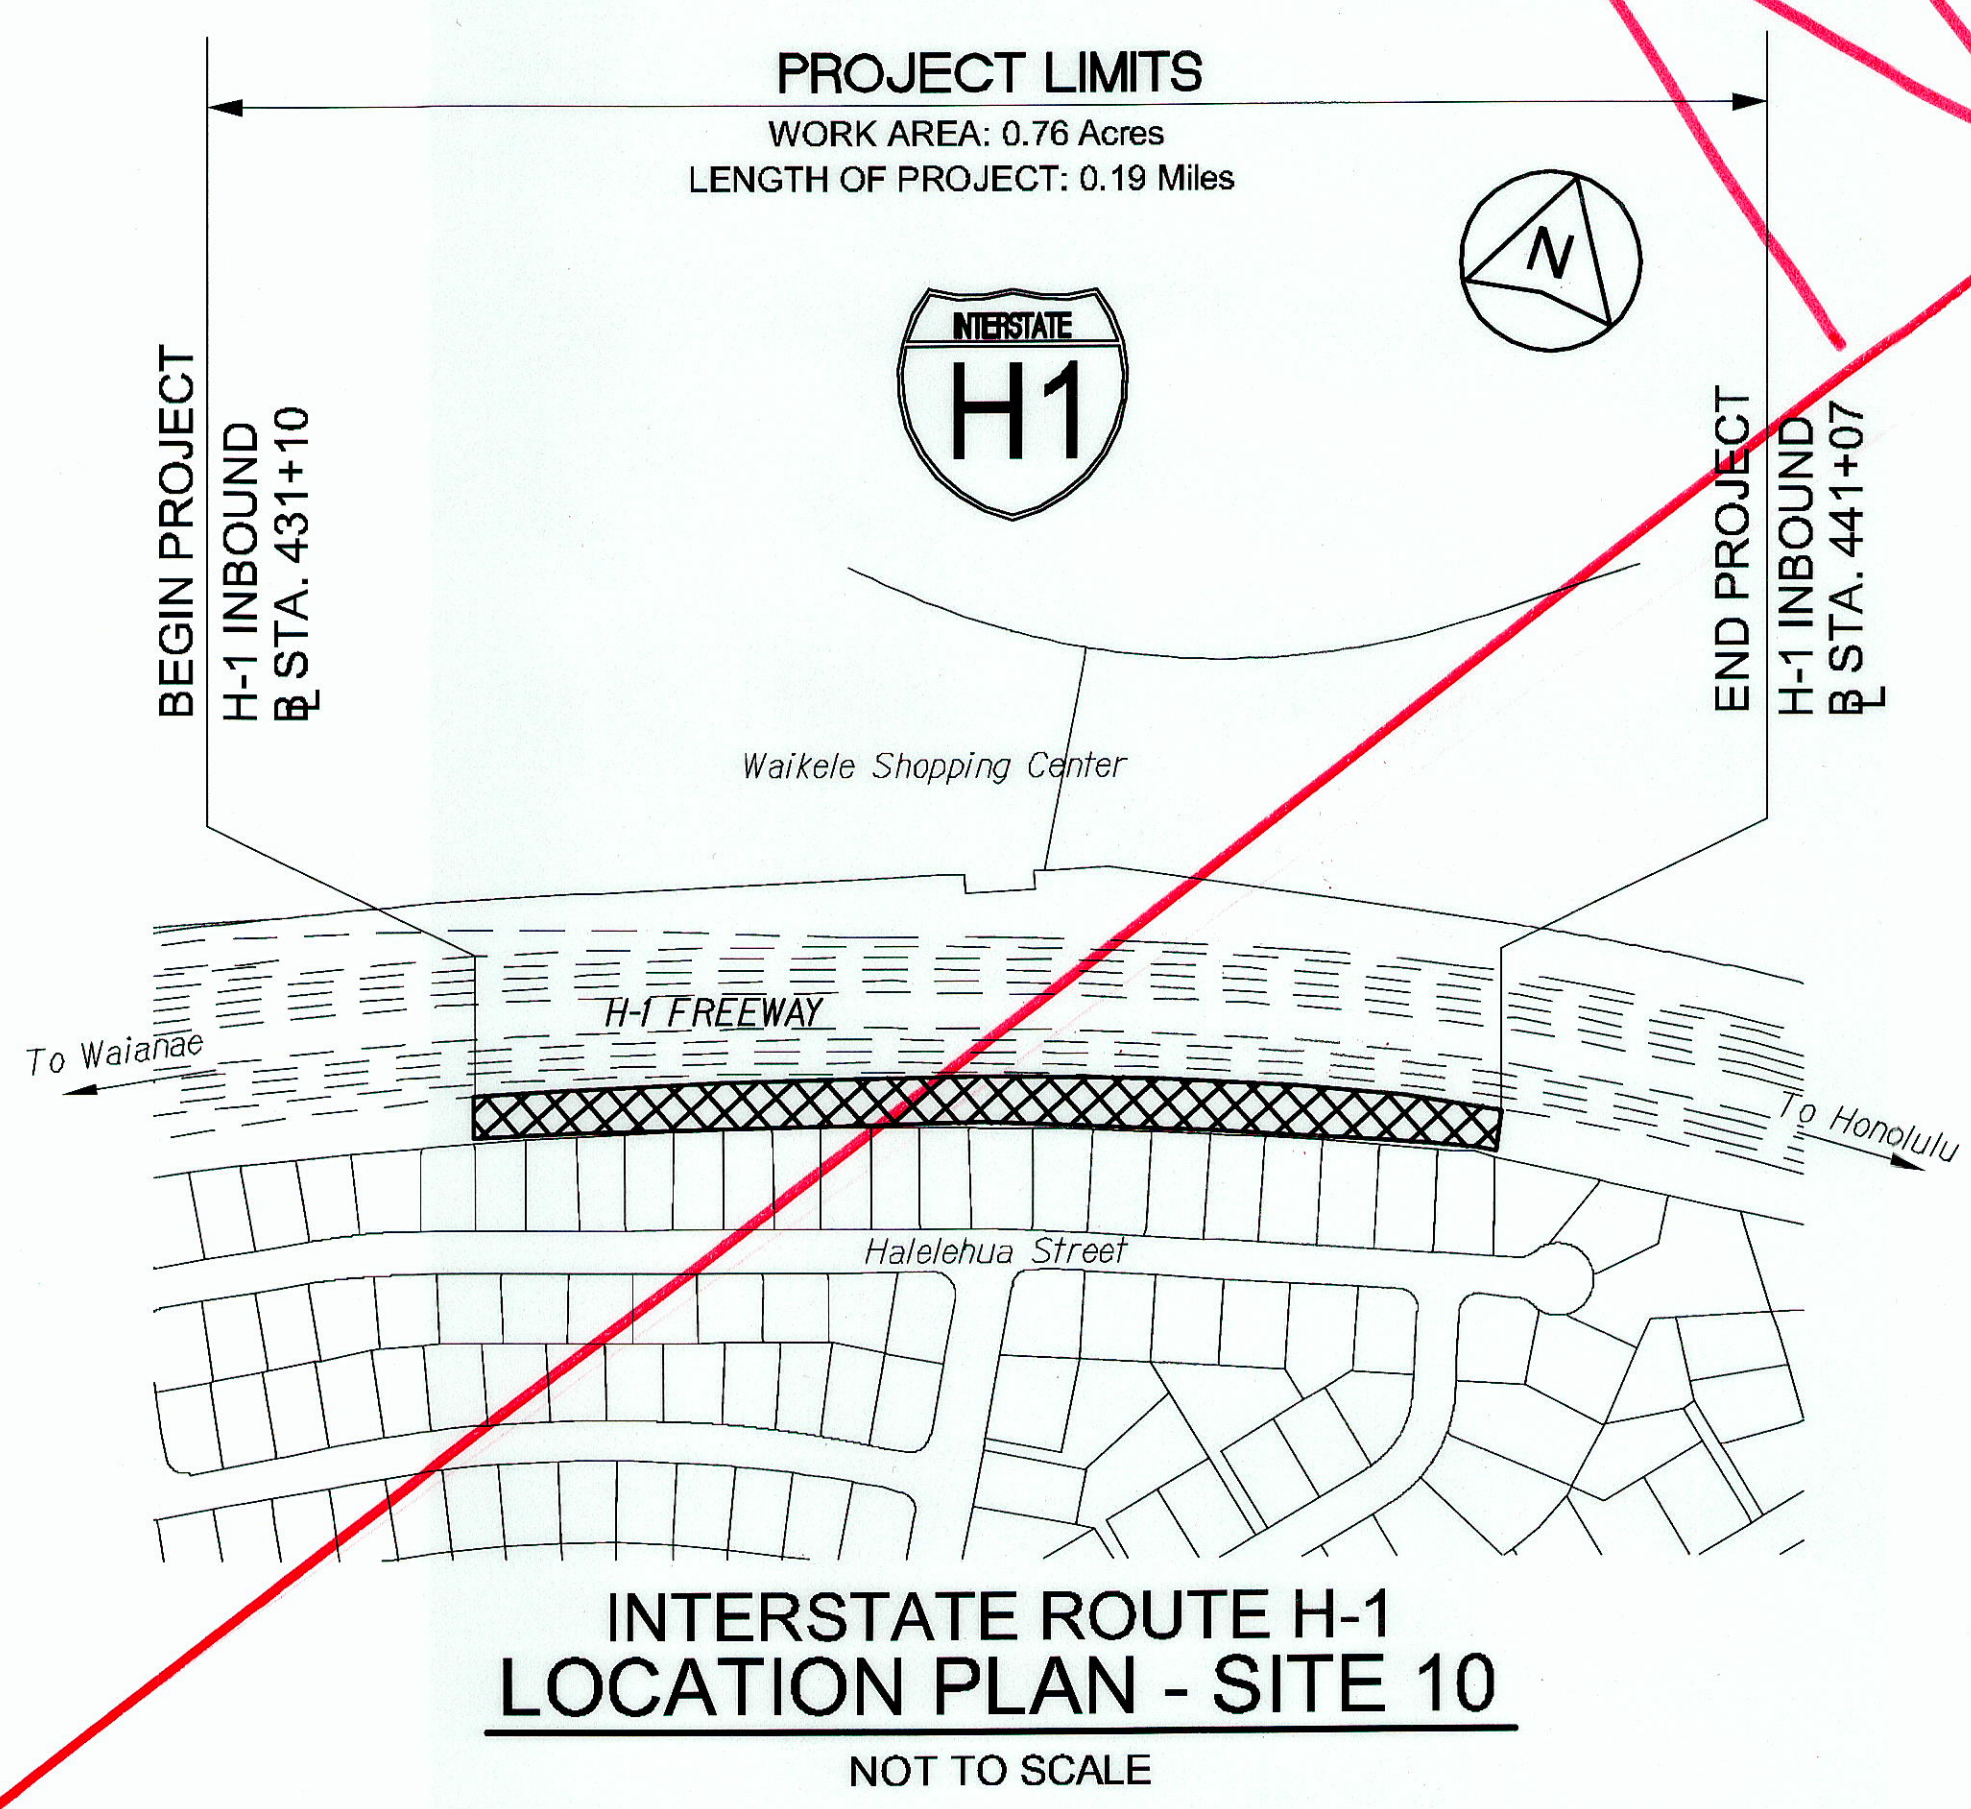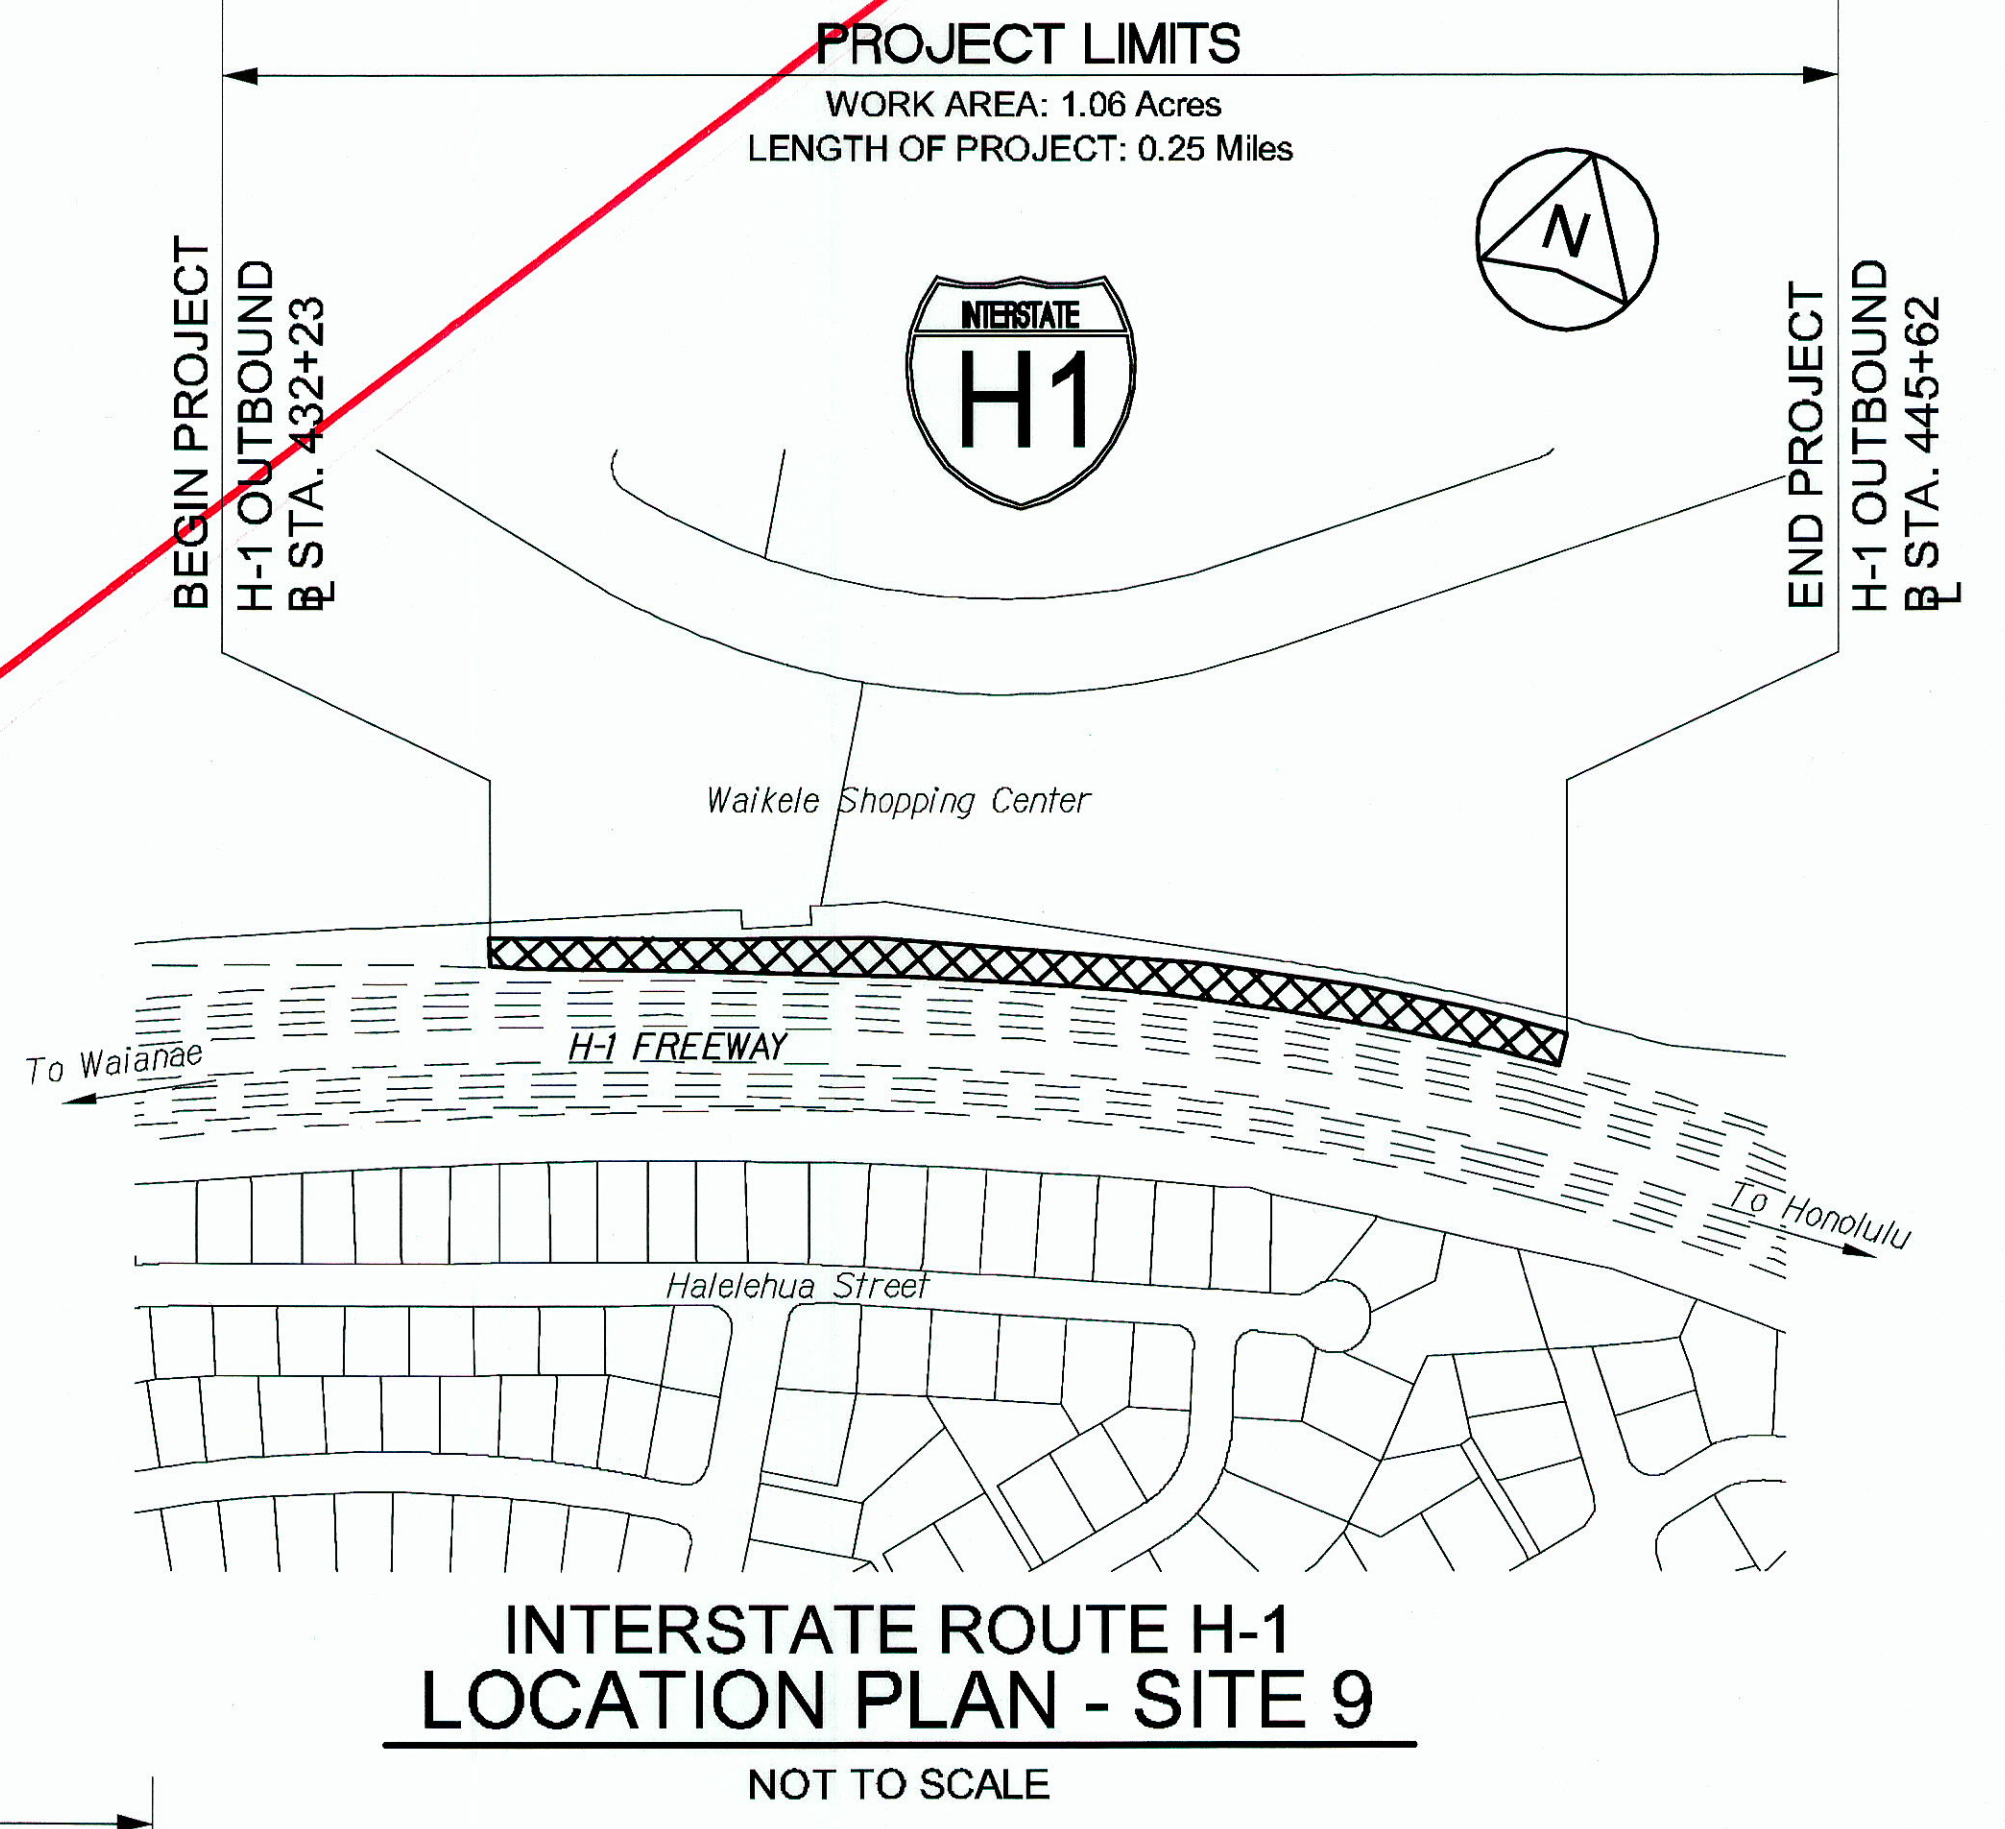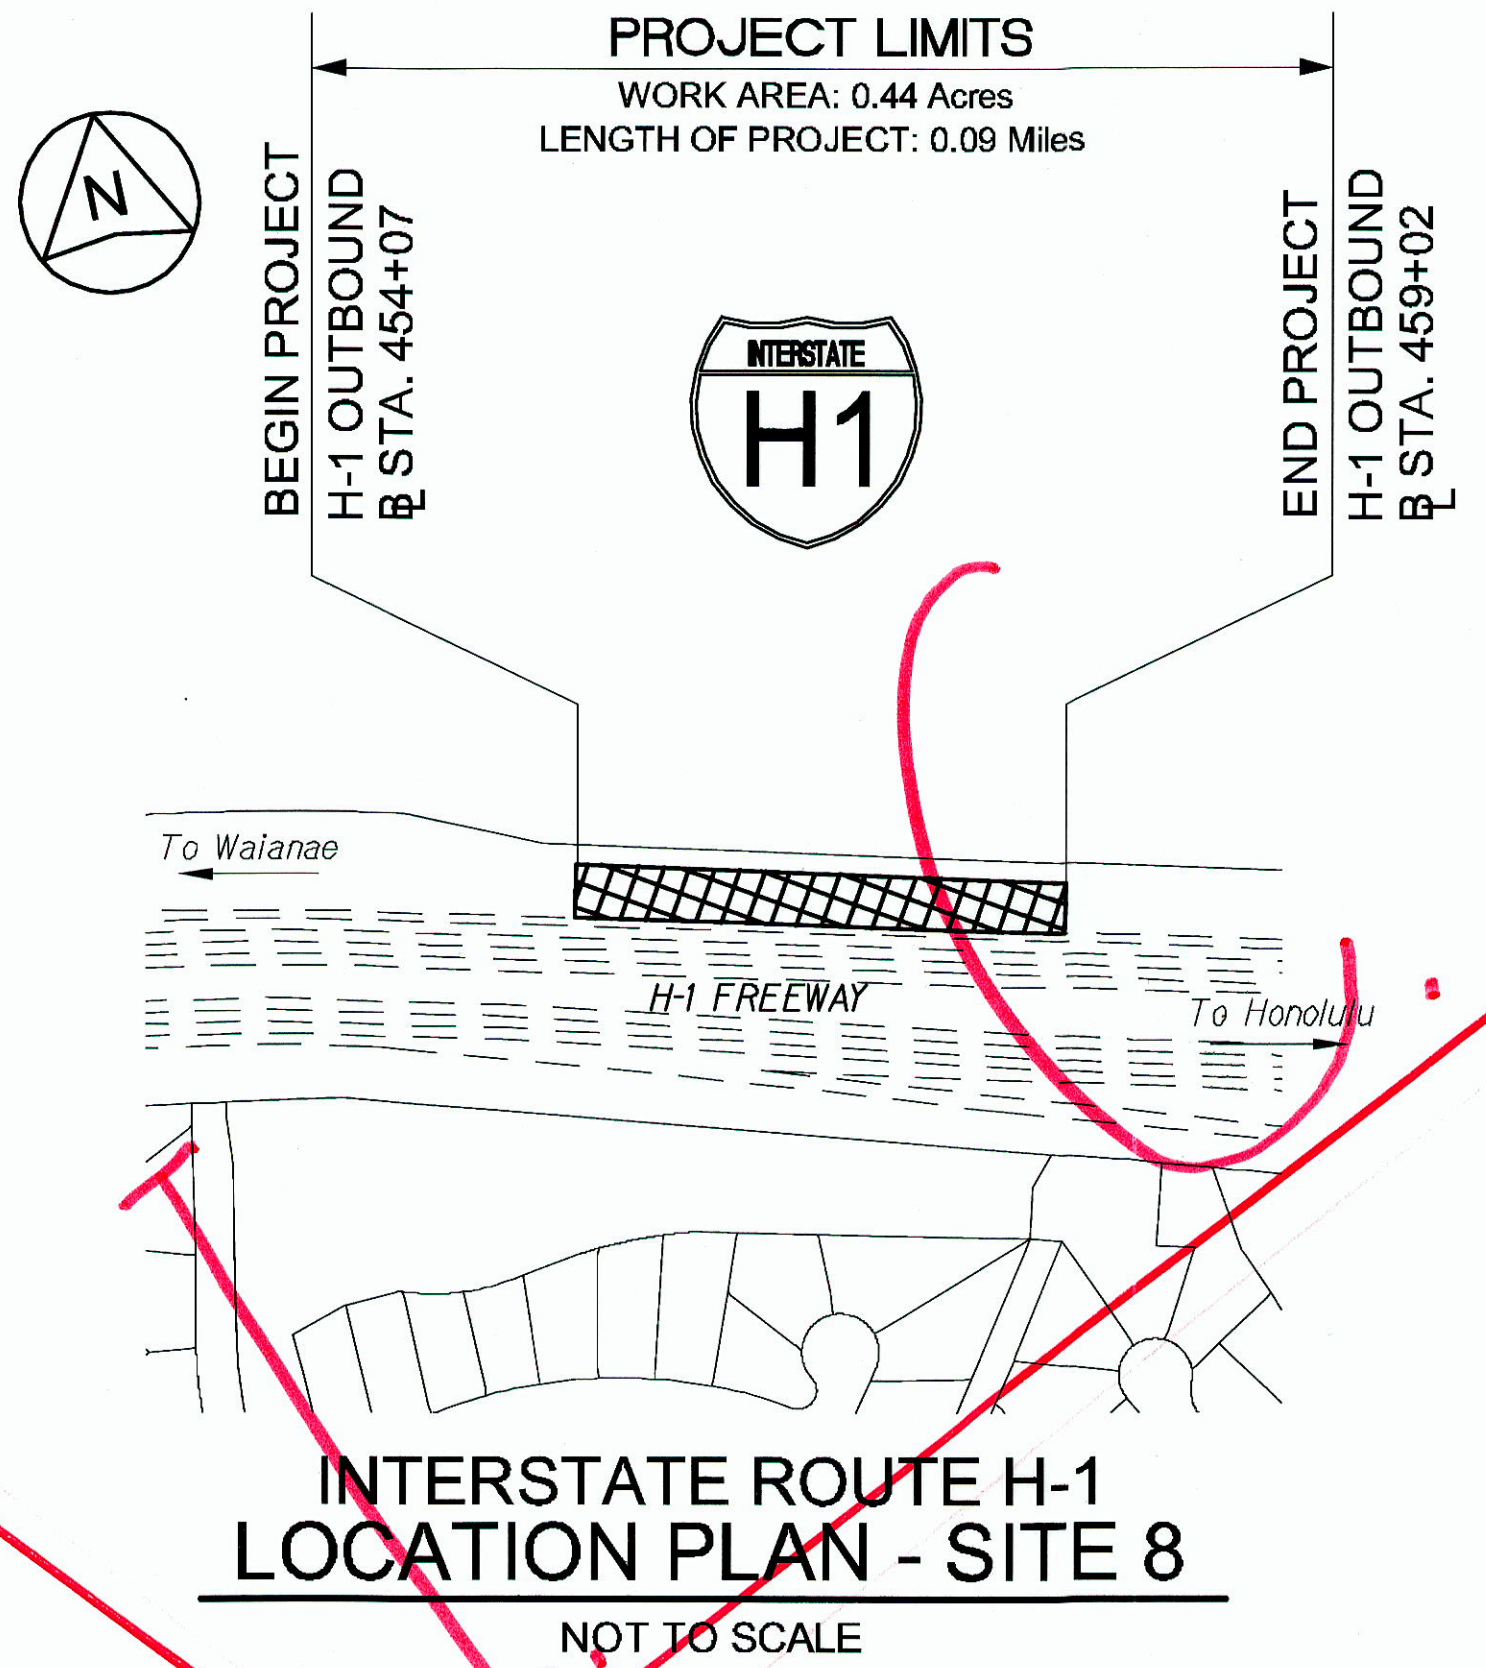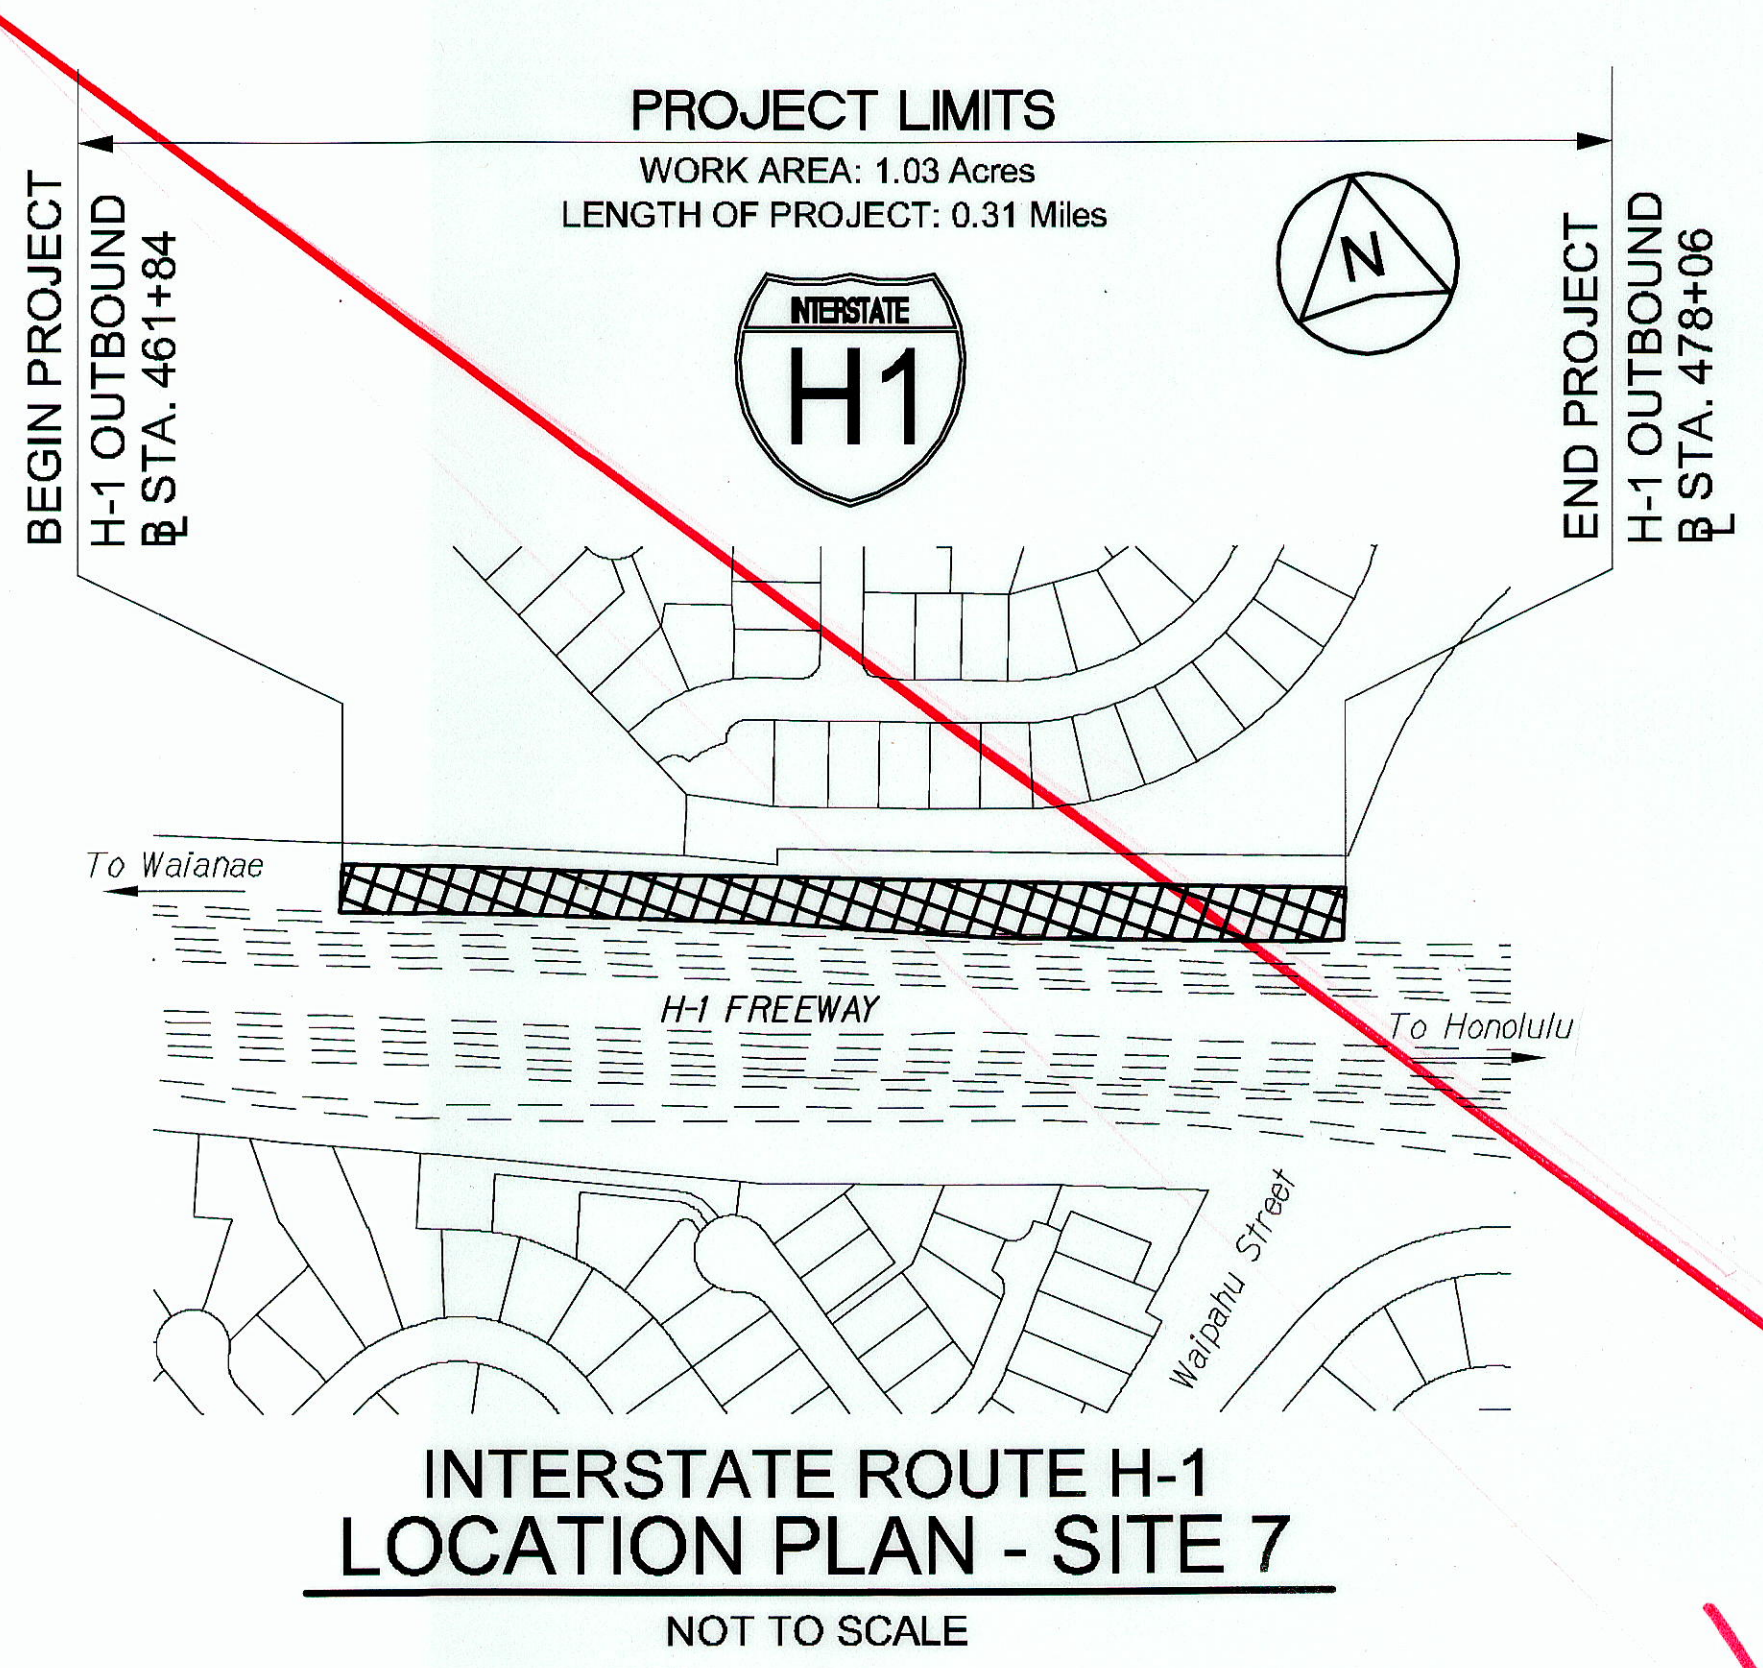

ORIGINAL PLAN	SURVEY PLOTTED BY	DATE
NOTE BOOK	DRAWN BY	
	DESIGNED BY	
	QUANTITIES BY	
	CHECKED BY	

01 LOCATION PLANS 1/30/2012 04:55 PM

4/30/12
 EXP. DATE
 This work was prepared by me or under my supervision.

STATE OF HAWAII
 DEPARTMENT OF TRANSPORTATION
 HIGHWAYS DIVISION







**LOCATION PLAN
 SITES 7-11**

SLOPE IMPROVEMENTS FOR EROSION CONTROL
 AT VARIOUS SITES ON OAHU, PHASE 5
 Project No. HWY-0-01-12
 Scale: None Date: April 2012

SHEET No. G-3 OF 5 SHEETS

"AS-BUILT"

FED. ROAD DIST. NO.	STATE	PROJ. NO.	FISCAL YEAR	SHEET NO.	TOTAL SHEETS
HAWAII	HAW.	HWY-O-01-12	2012	5	123

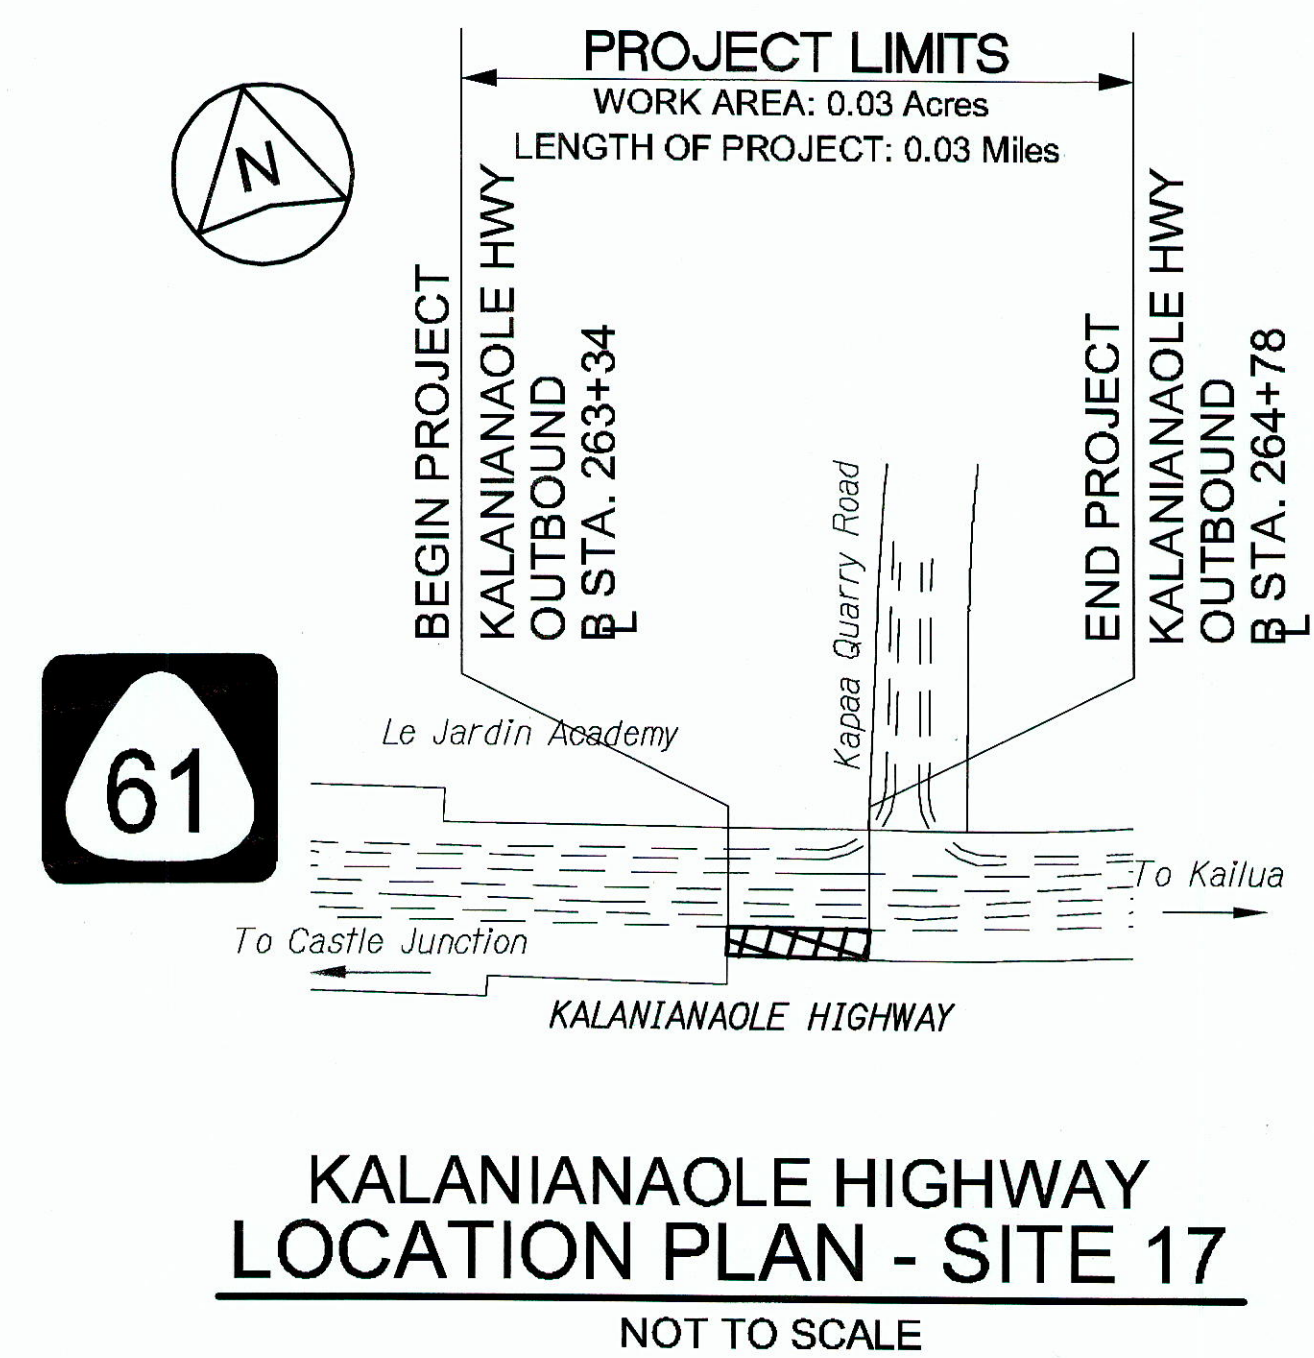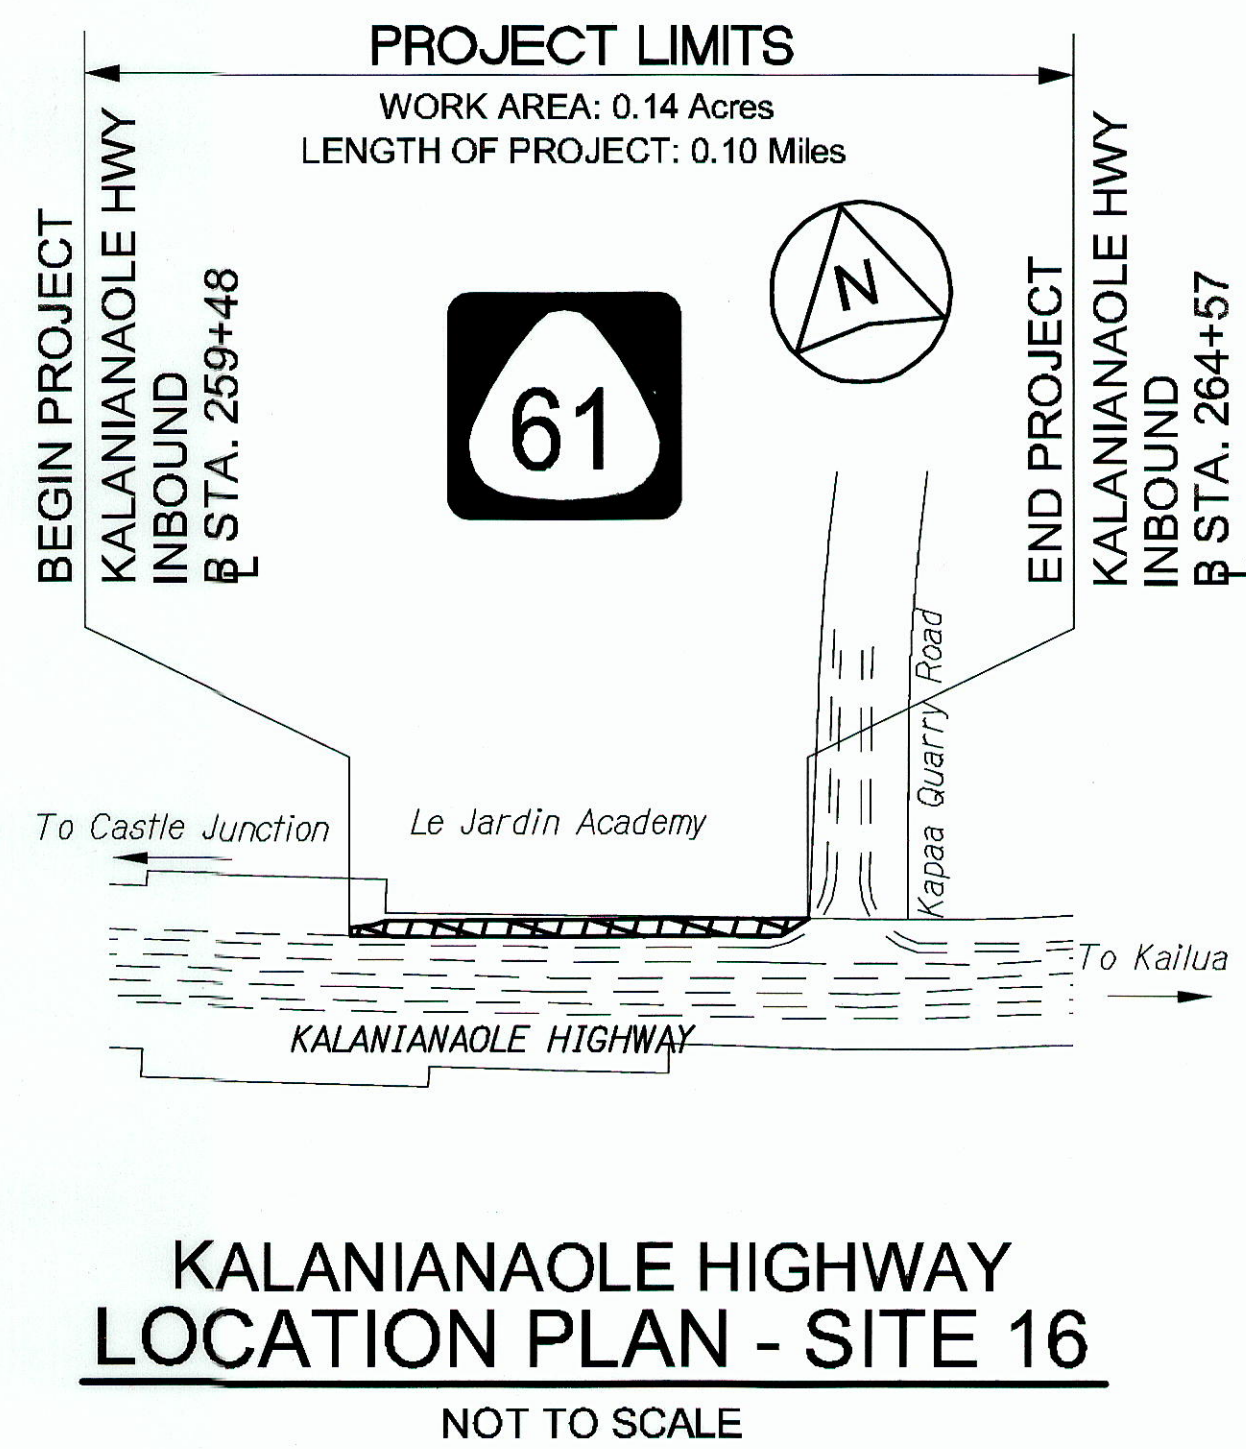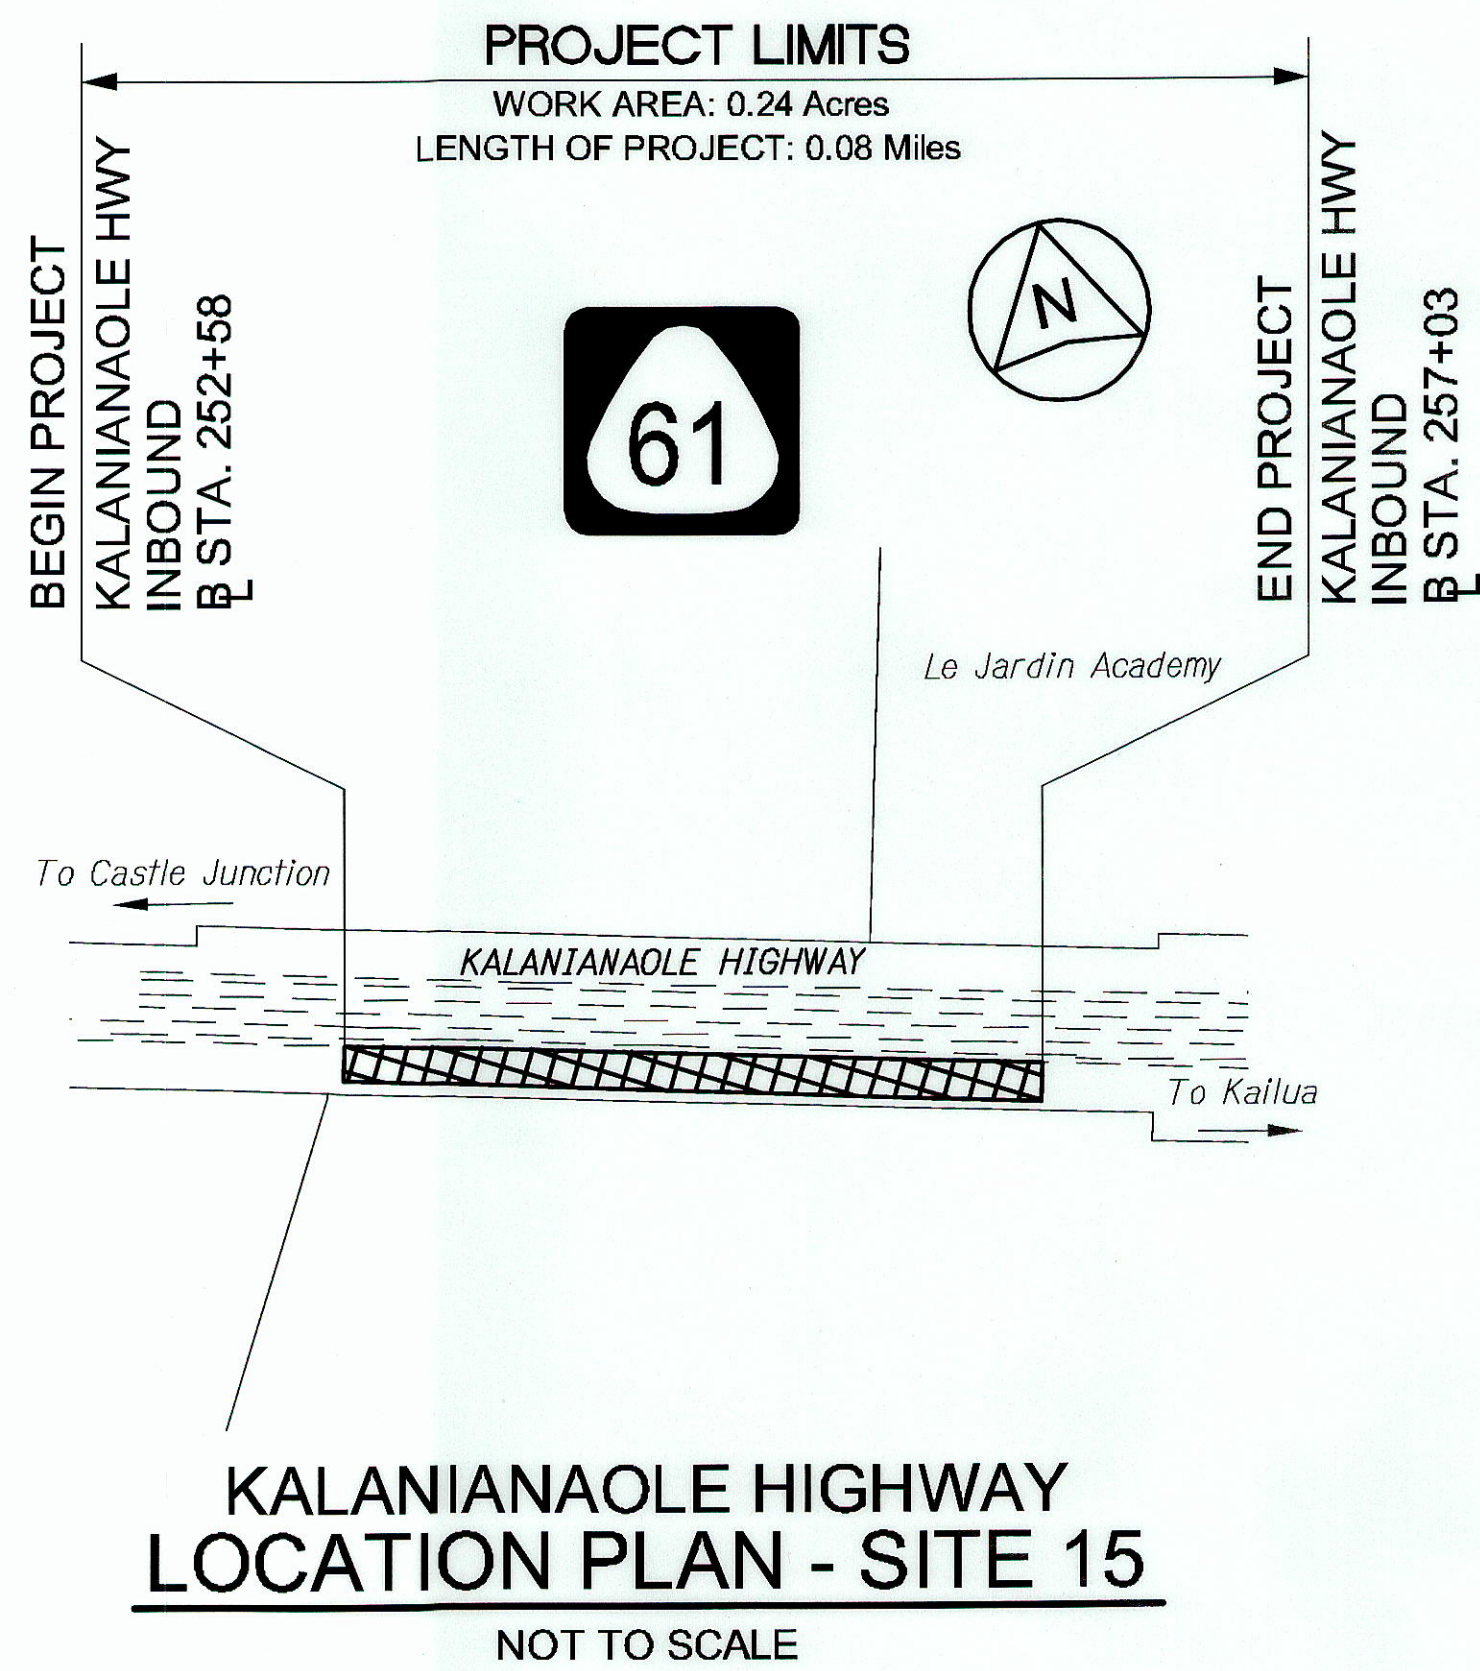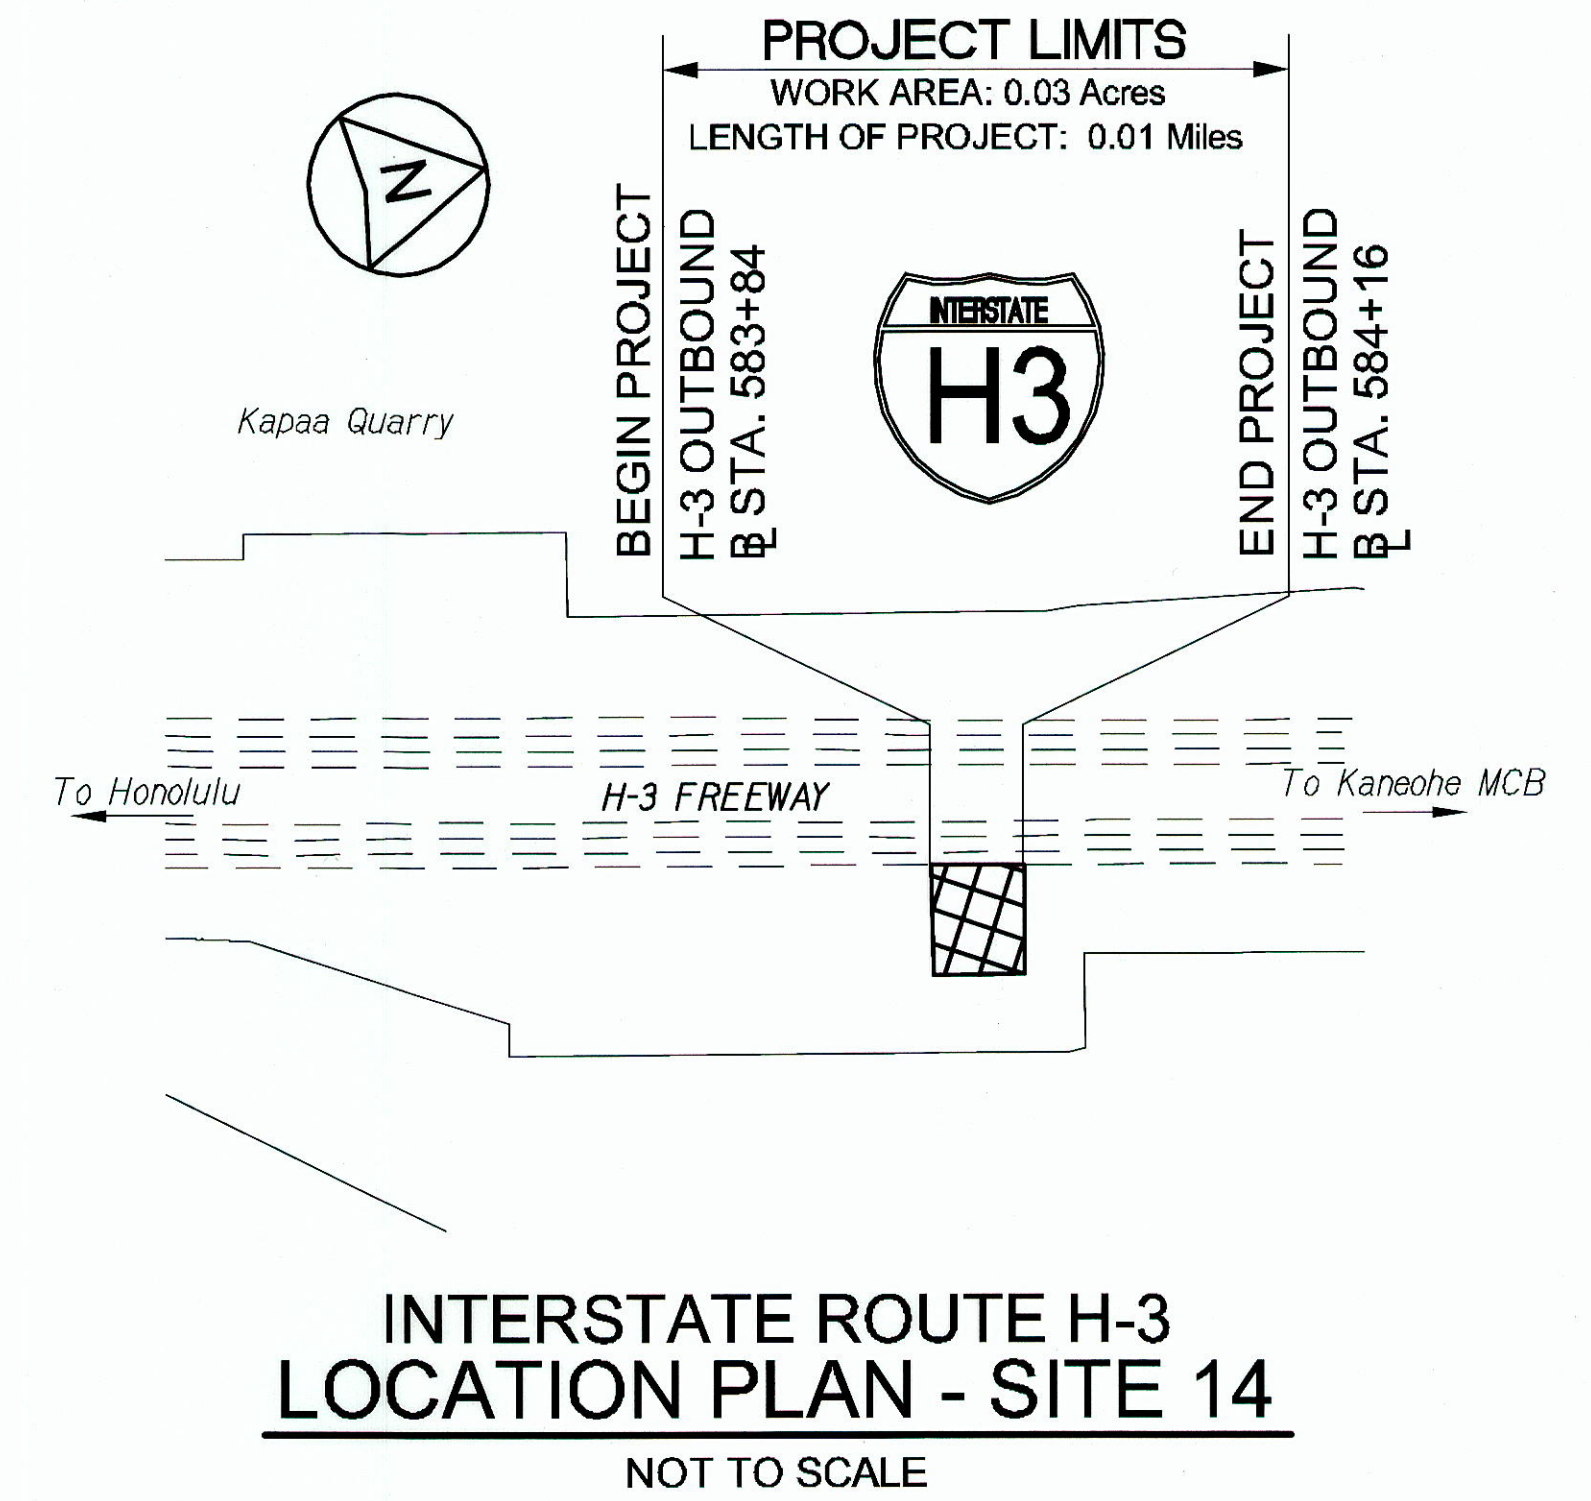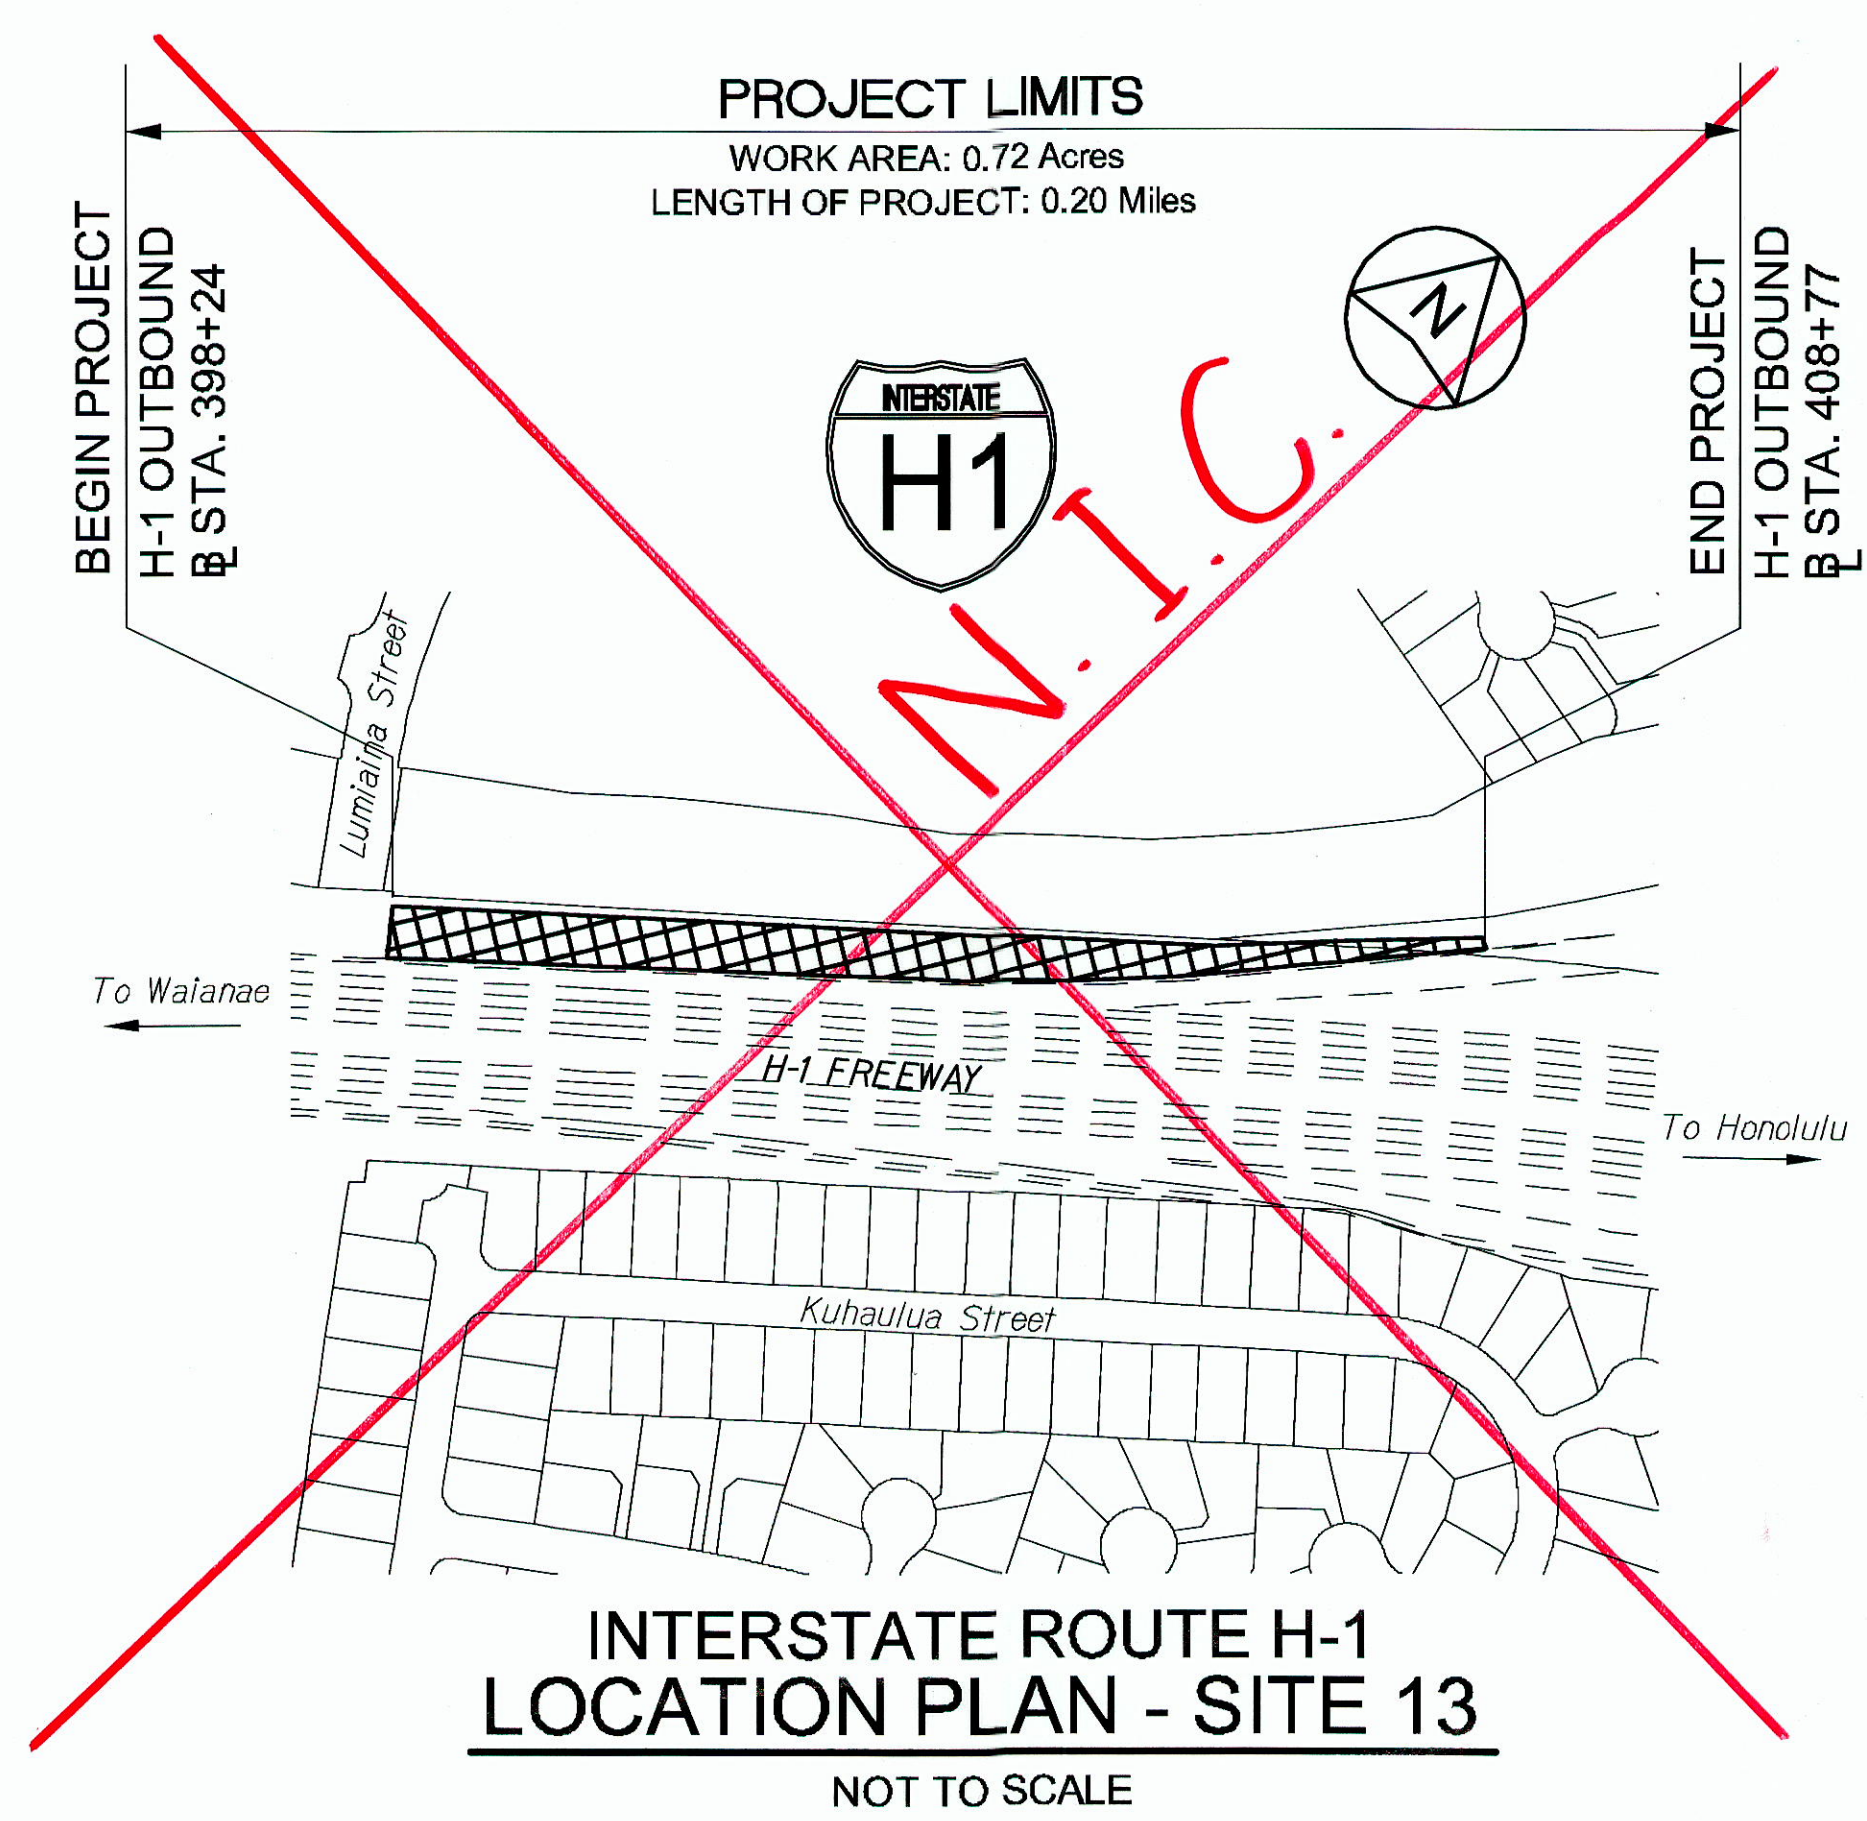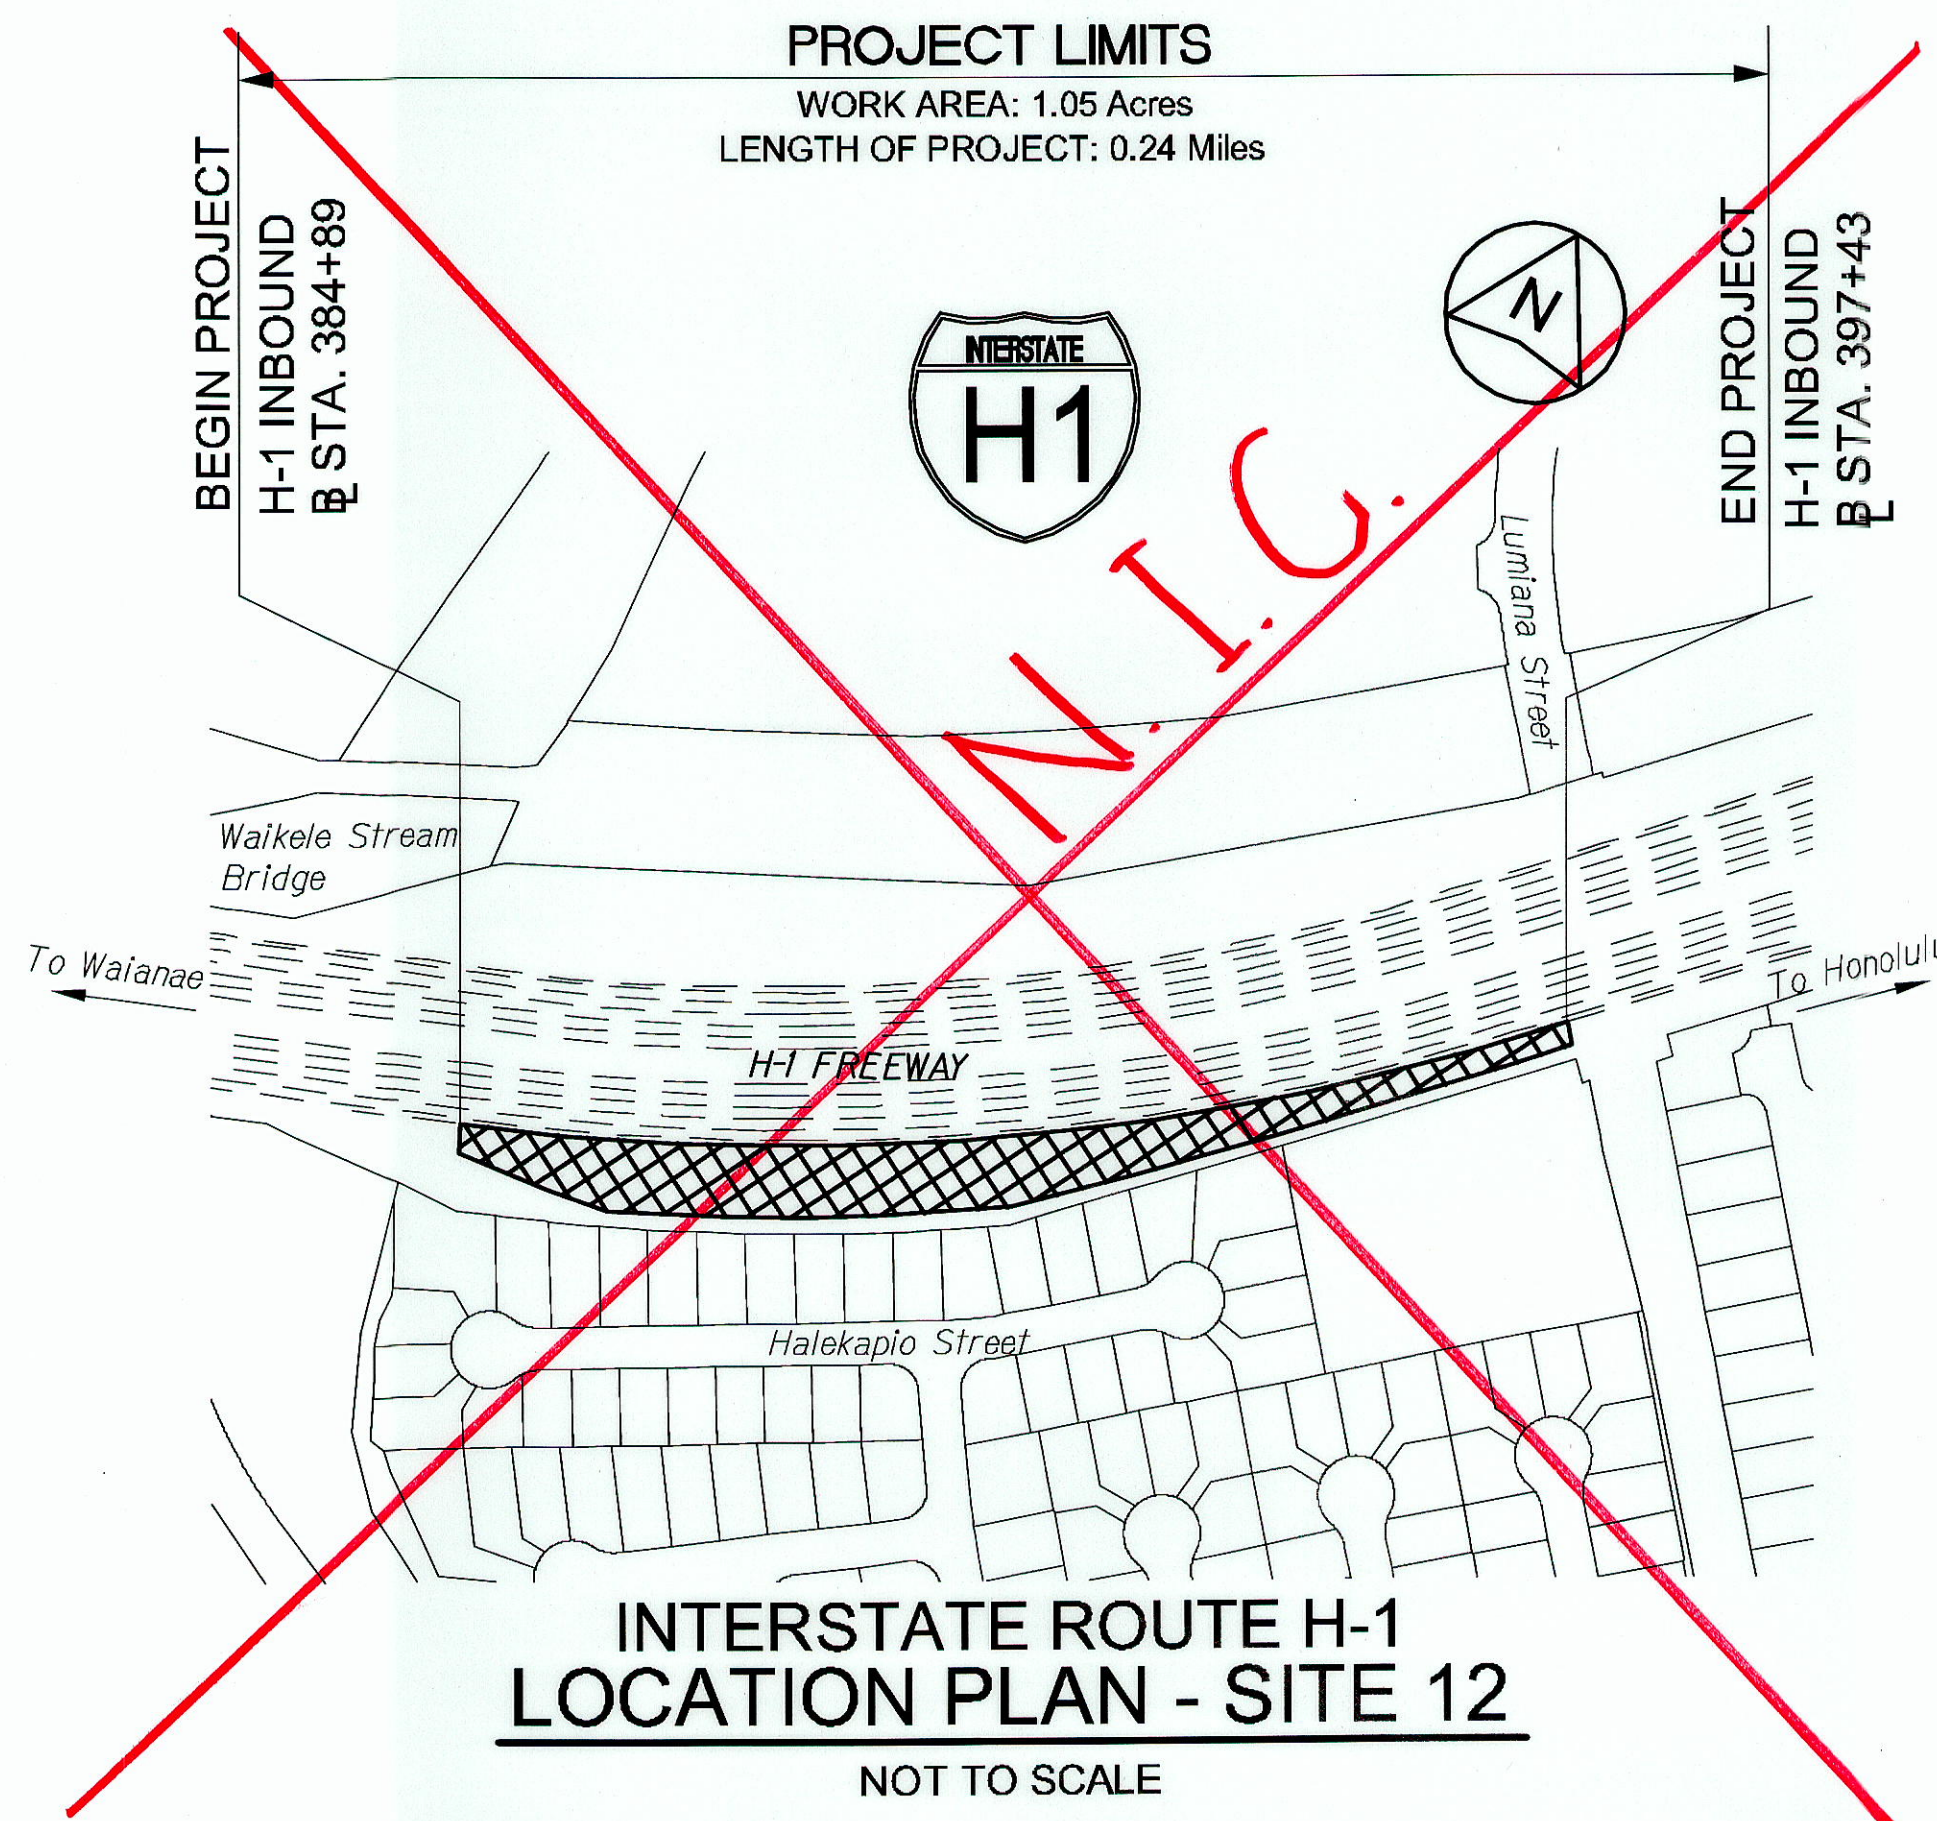

ORIGINAL PLAN	SURVEY PLOTTED BY	DATE
TRACED BY		
DESIGNED BY		
CHECKED BY		
NO.		

LOCATION PLANING 1/30/2012 10:45:17 PM


STATE OF HAWAII
DEPARTMENT OF TRANSPORTATION
HIGHWAYS DIVISION

**LOCATION PLAN
SITES 12-17**


SLOPE IMPROVEMENTS FOR EROSION CONTROL
AT VARIOUS SITES ON OAHU, PHASE 5
Project No. HWY-O-01-12
Scale: None Date: April 2012

SHEET No. G-4 OF 5 SHEETS


"AS-BUILT"

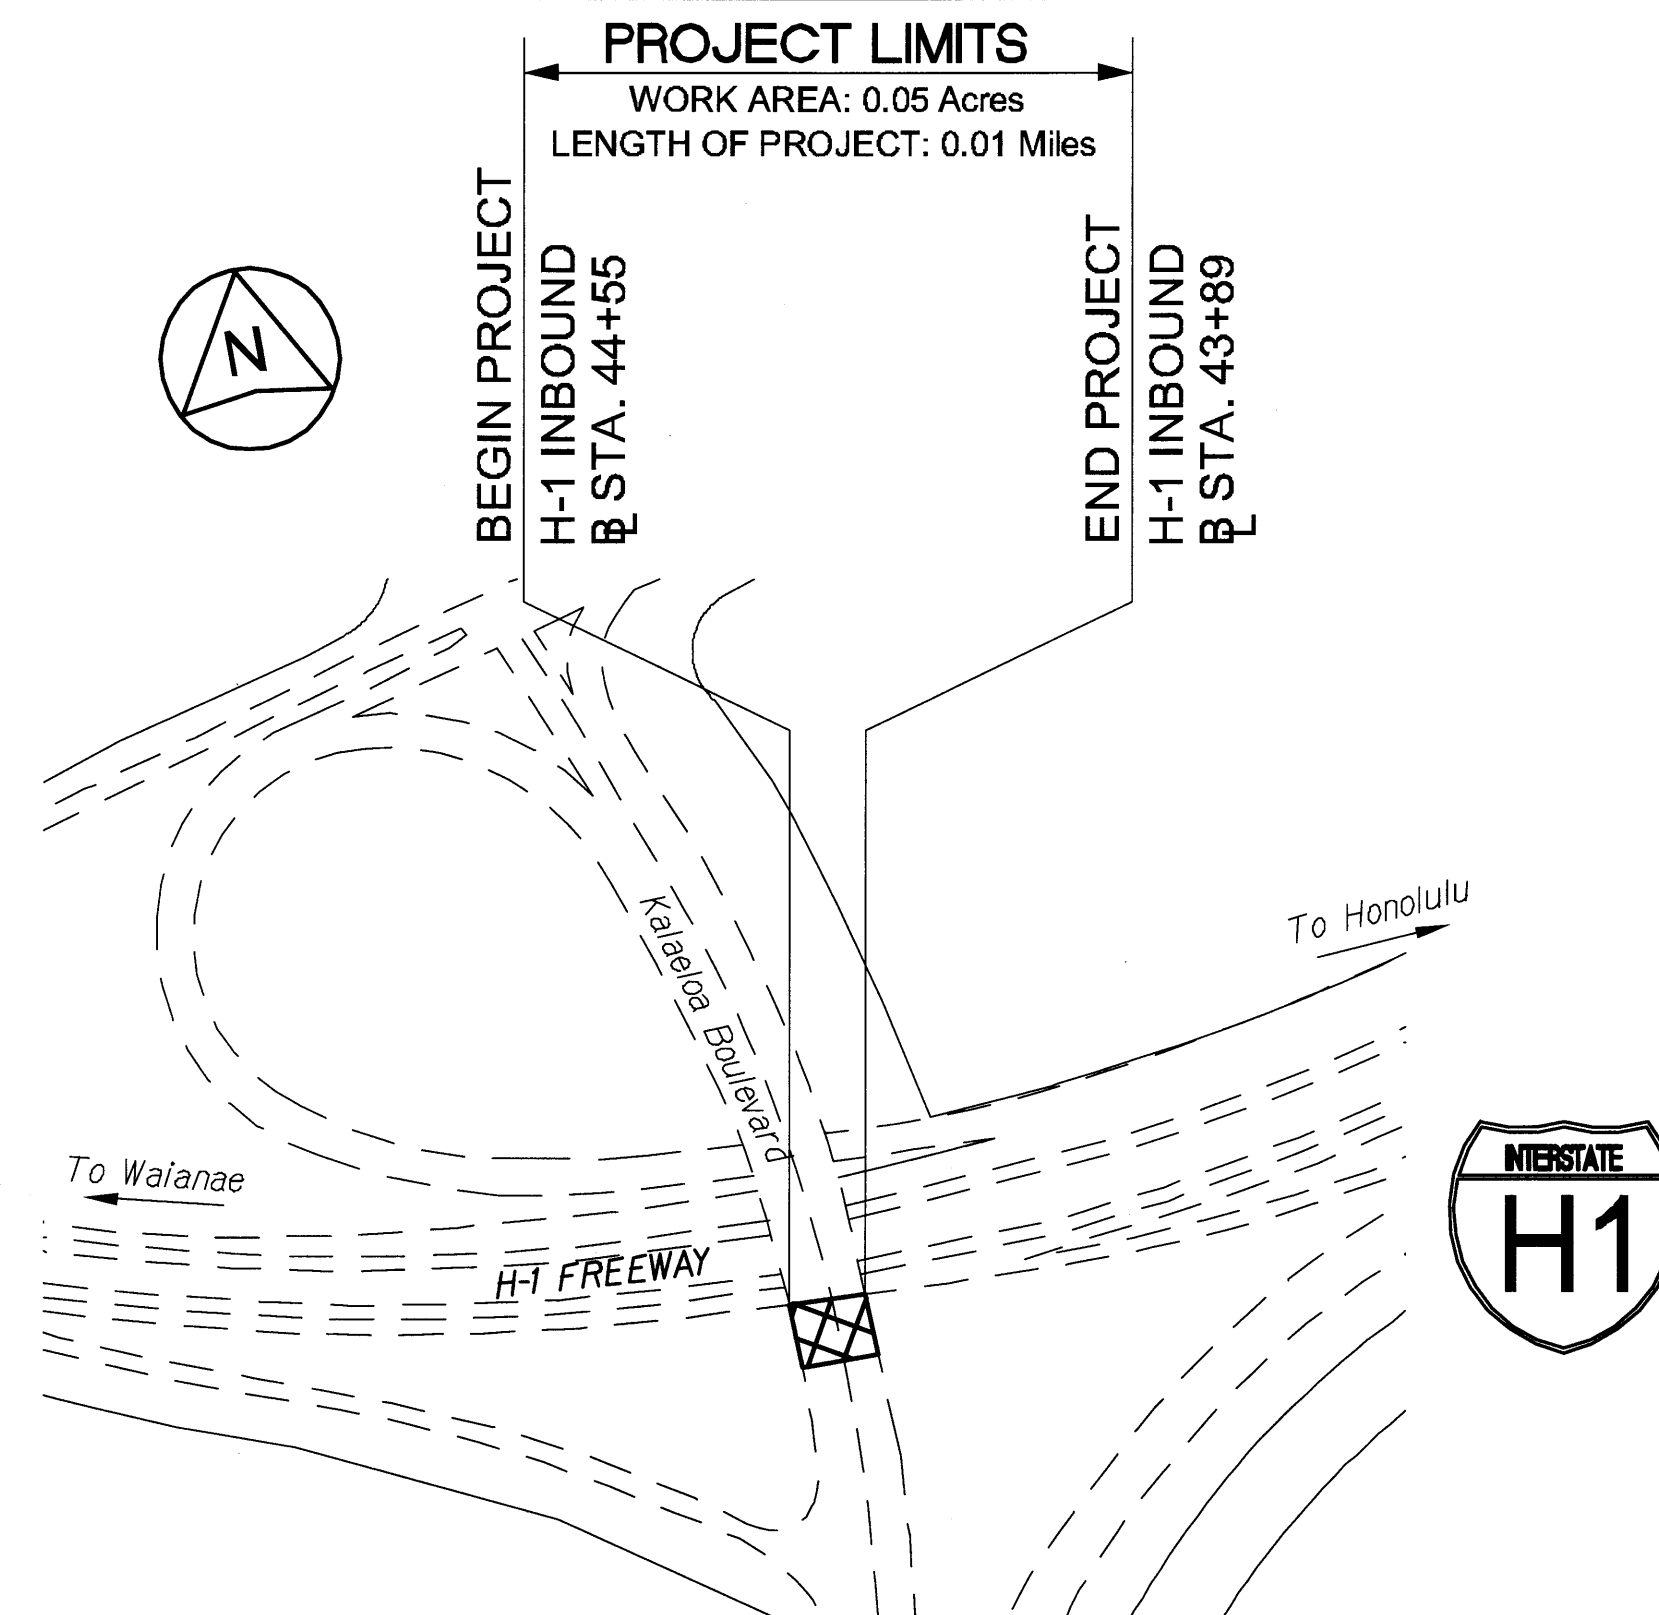


**INTERSTATE ROUTE H-1
LOCATION PLAN - SITE 18**
NOT TO SCALE

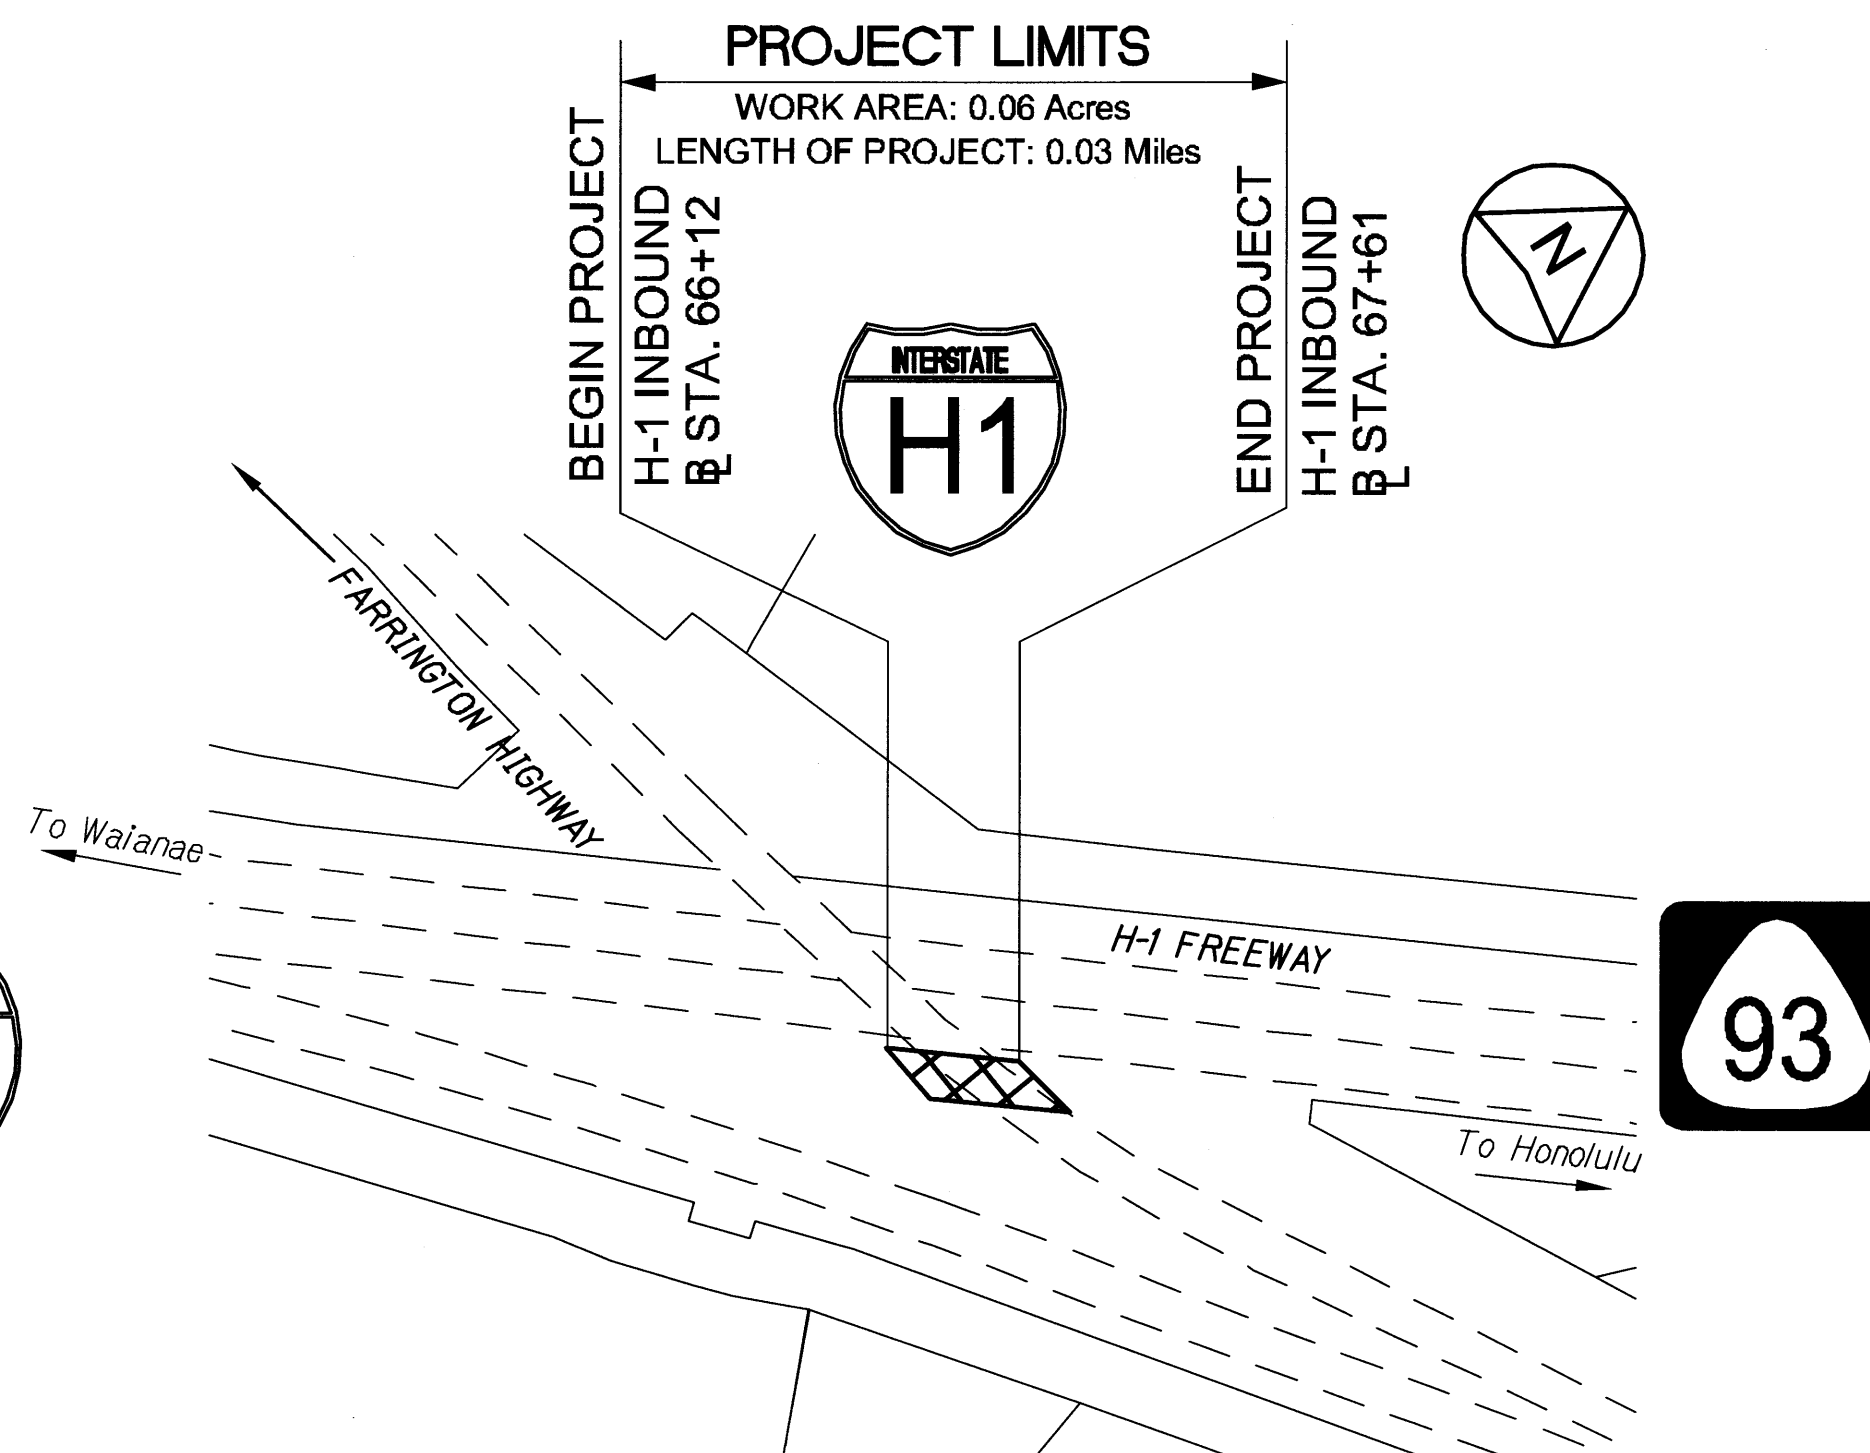


**INTERSTATE ROUTE H-1
LOCATION PLAN - SITE 19**
NOT TO SCALE

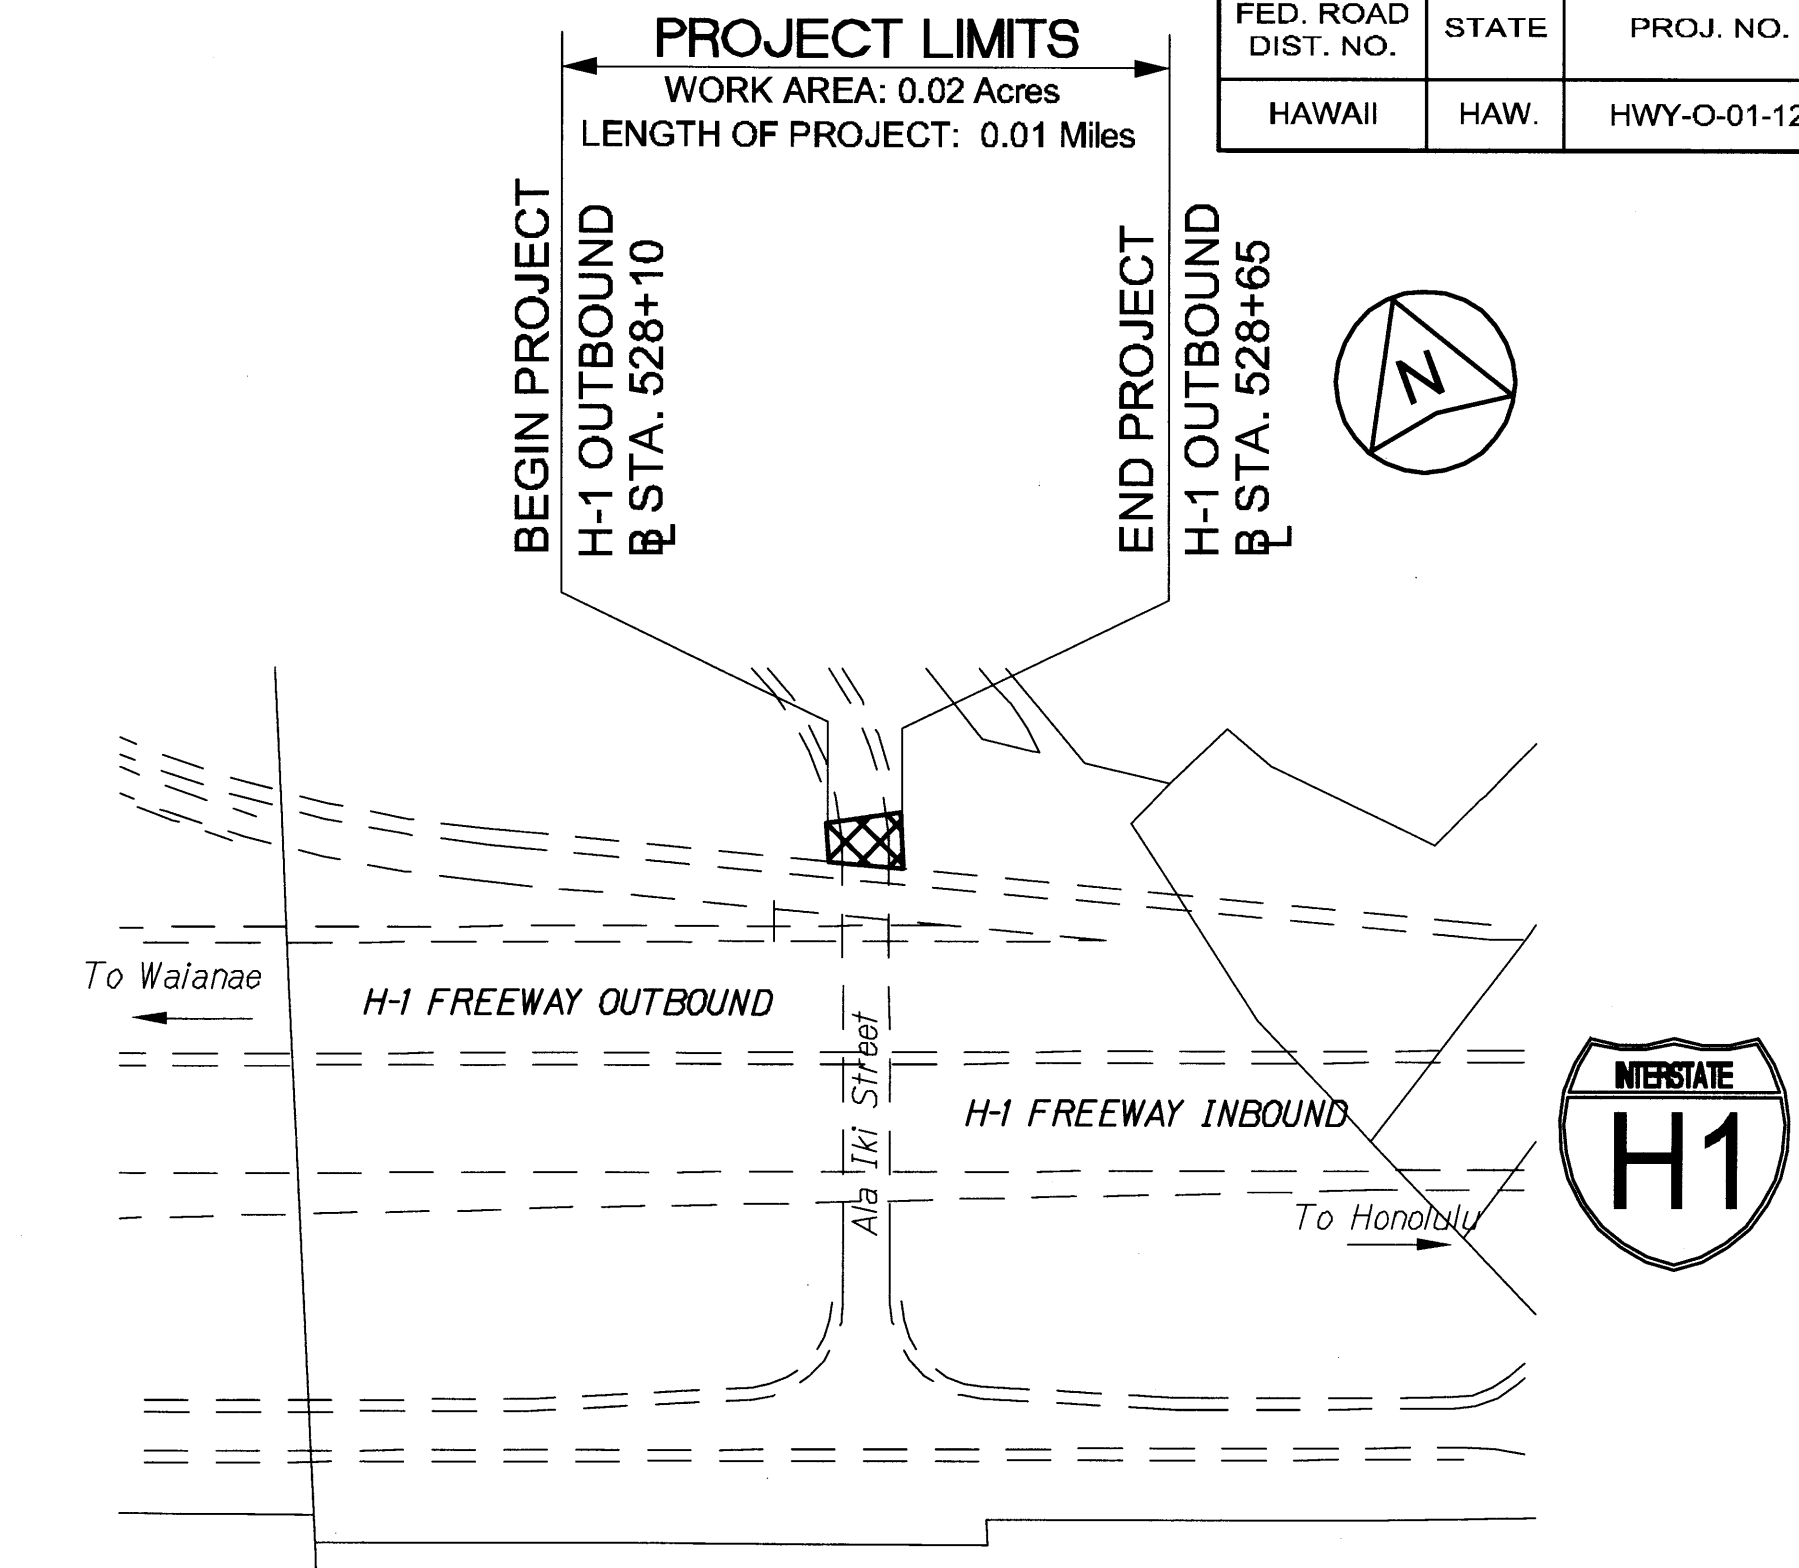

**INTERSTATE ROUTE H-1
LOCATION PLAN - SITE 20**
NOT TO SCALE

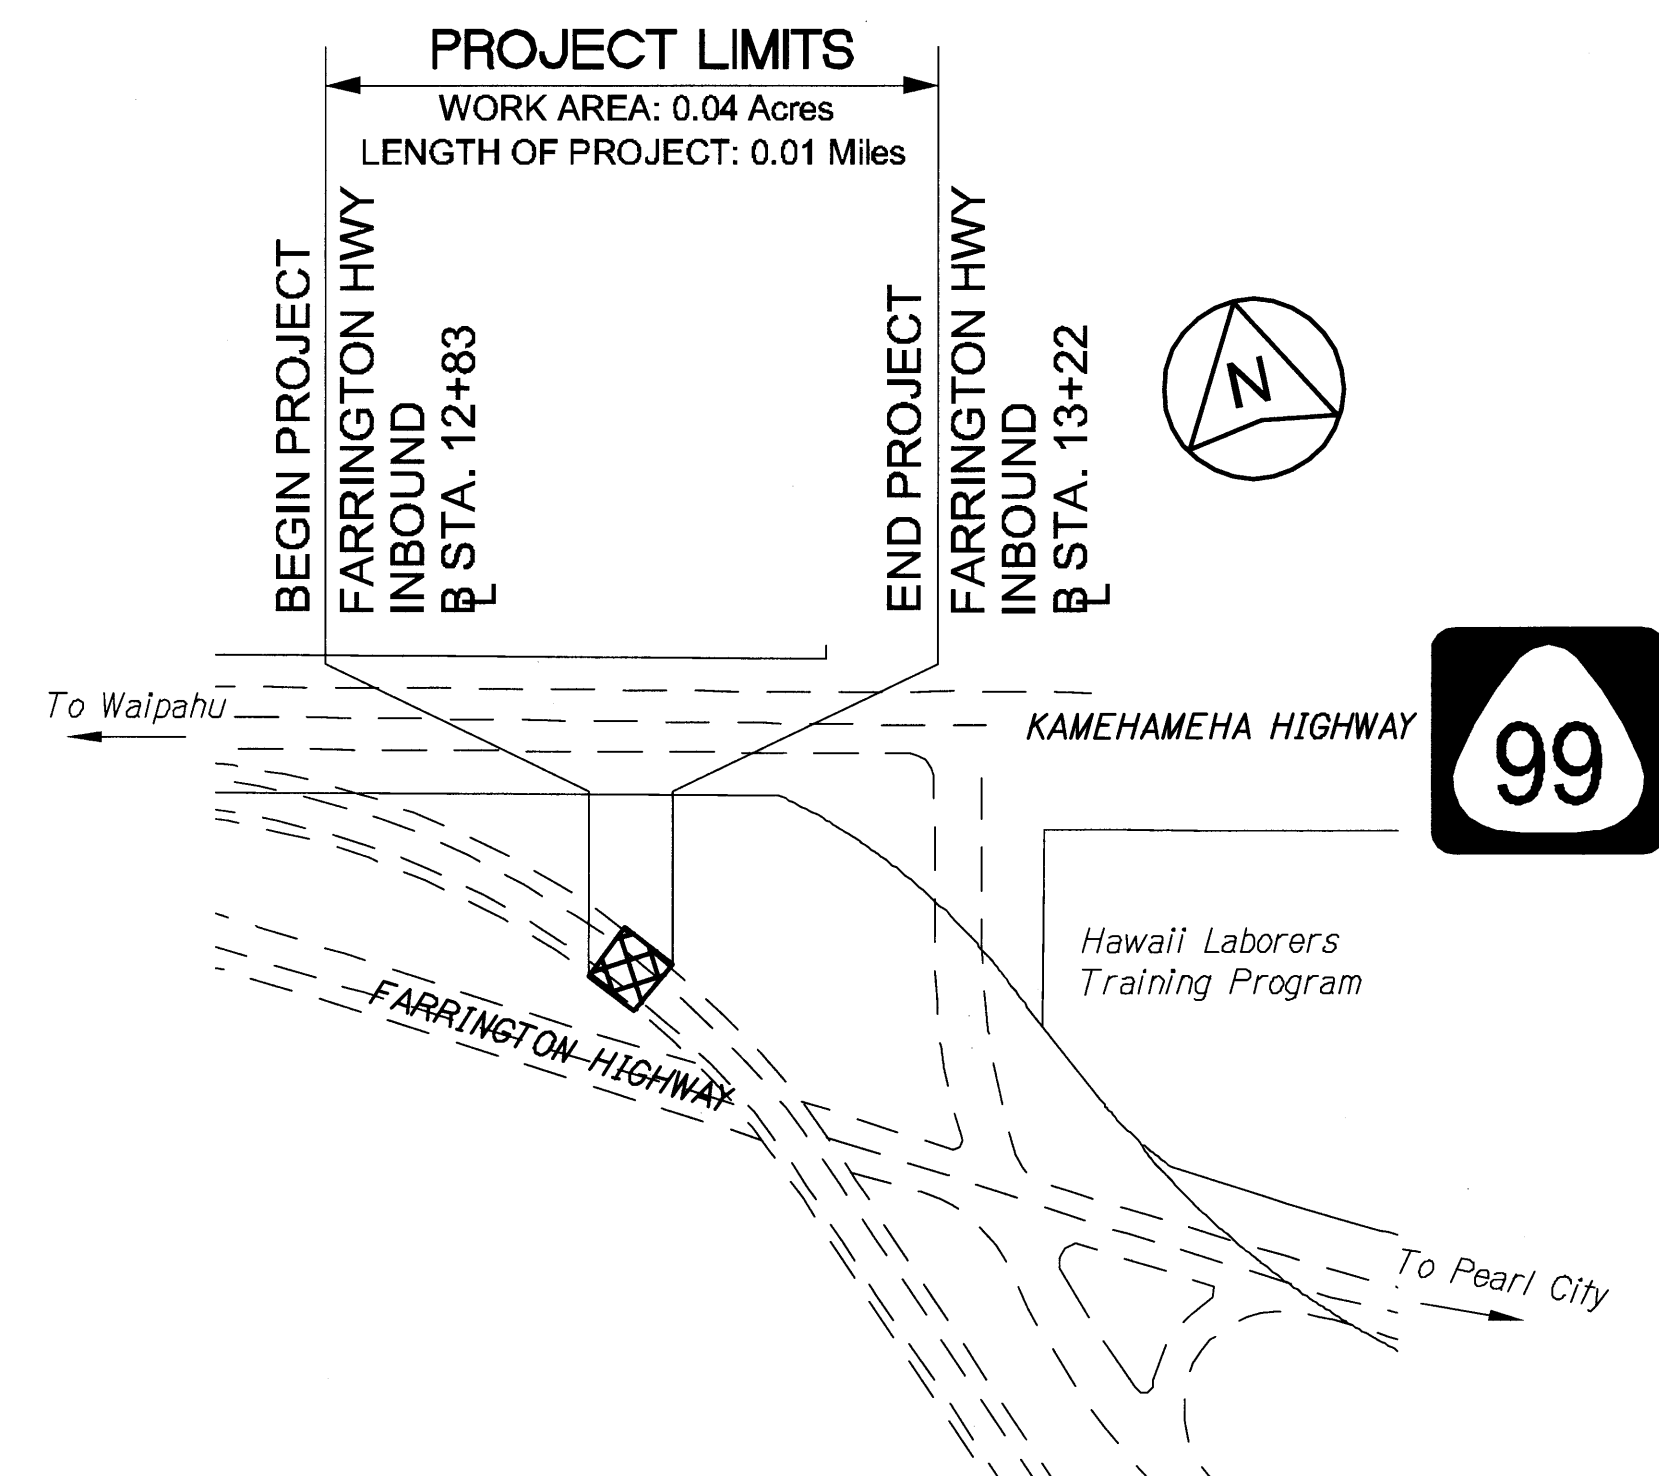

**FARRINGTON HIGHWAY
LOCATION PLAN - SITE 21**
NOT TO SCALE

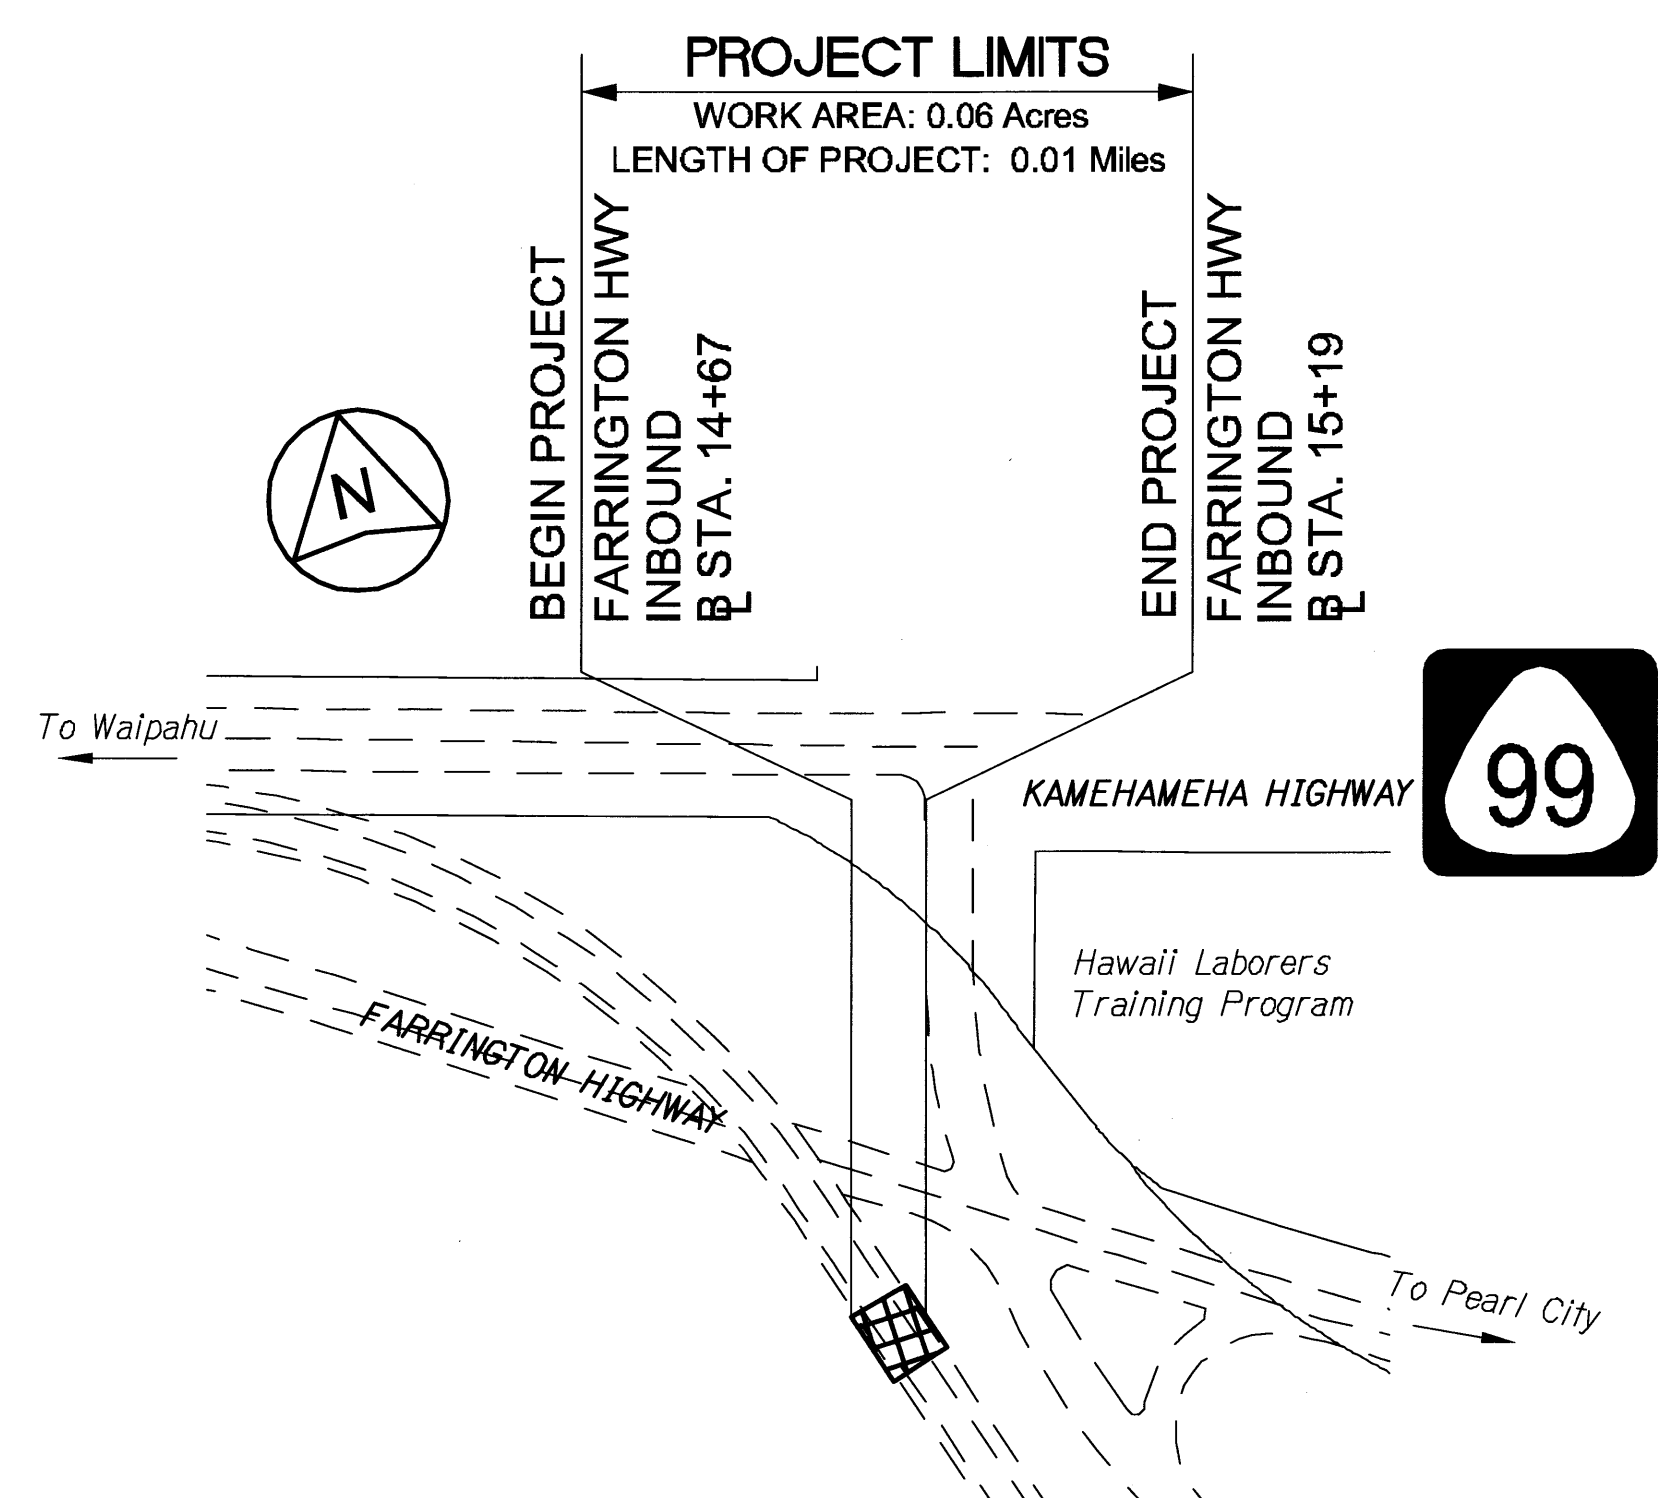

**FARRINGTON HIGHWAY
LOCATION PLAN - SITE 22**
NOT TO SCALE

FED. ROAD DIST. NO.	STATE	PROJ. NO.	FISCAL YEAR	SHEET NO.	TOTAL SHEETS
HAWAII	HAW.	HWY-O-01-12	2012	6	123

DATE	4/15/2012 10:55 AM
SURVEY PLOTTED BY	
DRAWN BY	
DESIGNED BY	
CHECKED BY	
NOTED BY	
NO.	

4/30/12

Signature

This work was prepared by me or under my supervision.

STATE OF HAWAII
DEPARTMENT OF TRANSPORTATION
HIGHWAYS DIVISION

**LOCATION PLAN
SITES 18-22**

*SLOPE IMPROVEMENTS FOR EROSION CONTROL
AT VARIOUS SITES ON OAHU, PHASE 5*

Project No. HWY-O-01-12
Date: April 2012

Scale: None

SHEET No. G-5 OF 5 SHEETS