


INDEX TO DRAWINGS	
SHEET NO.	DESCRIPTION
1	TITLE SHEET
2	STANDARD PLANS SUMMARY
3	LOCATION PLANS
4	GENERAL NOTES, LEGEND AND ABBREVIATIONS
5	CONSTRUCTION NOTES
6-8	UTILITY NOTES
9 - 11	WATER POLLUTION AND EROSION CONTROL NOTES AND DETAILS
12 - 13	TYPICAL DETAILS
14	GENERAL SITE PLAN
15 - 24	TEMPORARY EROSION CONTROL AND PERMANENT BMP PLANS, PROFILES AND DETAILS
25 - 37	LANDSCAPING NOTES, PLANS, DETAILS AND PLANT LIST
38 - 39	TRAFFIC CONTROL NOTES, LEGEND AND DETAILS
40 - 43	TRAFFIC CONTROL PLANS

FED. ROAD DIST. NO.	STATE	PROJ. NO.	FISCAL YEAR	SHEET NO.	TOTAL SHEETS
HAWAII	HAW.	HWY-O-05-14	2016	1	43

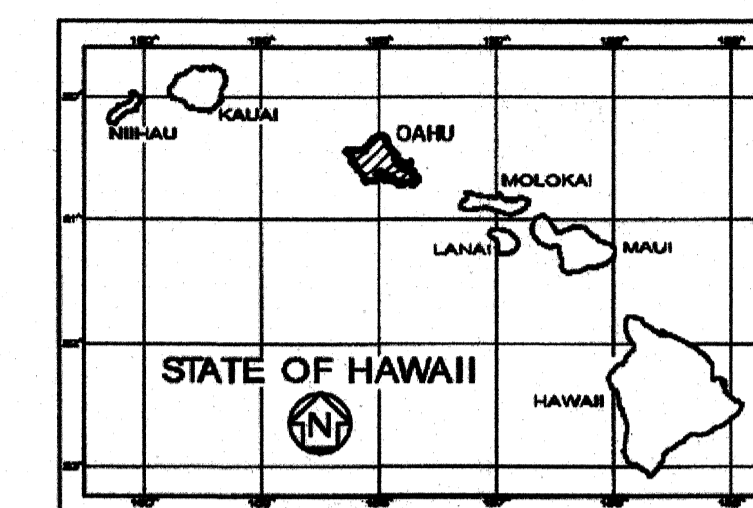


STATE OF HAWAII  
DEPARTMENT OF TRANSPORTATION  
HIGHWAYS DIVISION  
HONOLULU, HAWAII

PLANS FOR  
**SLOPE IMPROVEMENTS FOR EROSION CONTROL**  
AT VARIOUS SITES ON OAHU, PHASE 6  
**PROJECT NO. HWY-O-05-14**  
DISTRICT OF EWA  
ISLAND OF OAHU

CHANGES MADE DURING CONSTRUCTION HAVE BEEN INCORPORATED ON THESE PLANS EXCEPT CHANGES IN THE ORIGINAL THEORETICAL QUANTITIES. FOR ACTUAL QUANTITIES, REFER TO PROJECT LEDGER AND/OR COMPUTATION BOOK.

*[Signature]*  
RESIDENT ENGINEER

8/6/20  
DATE

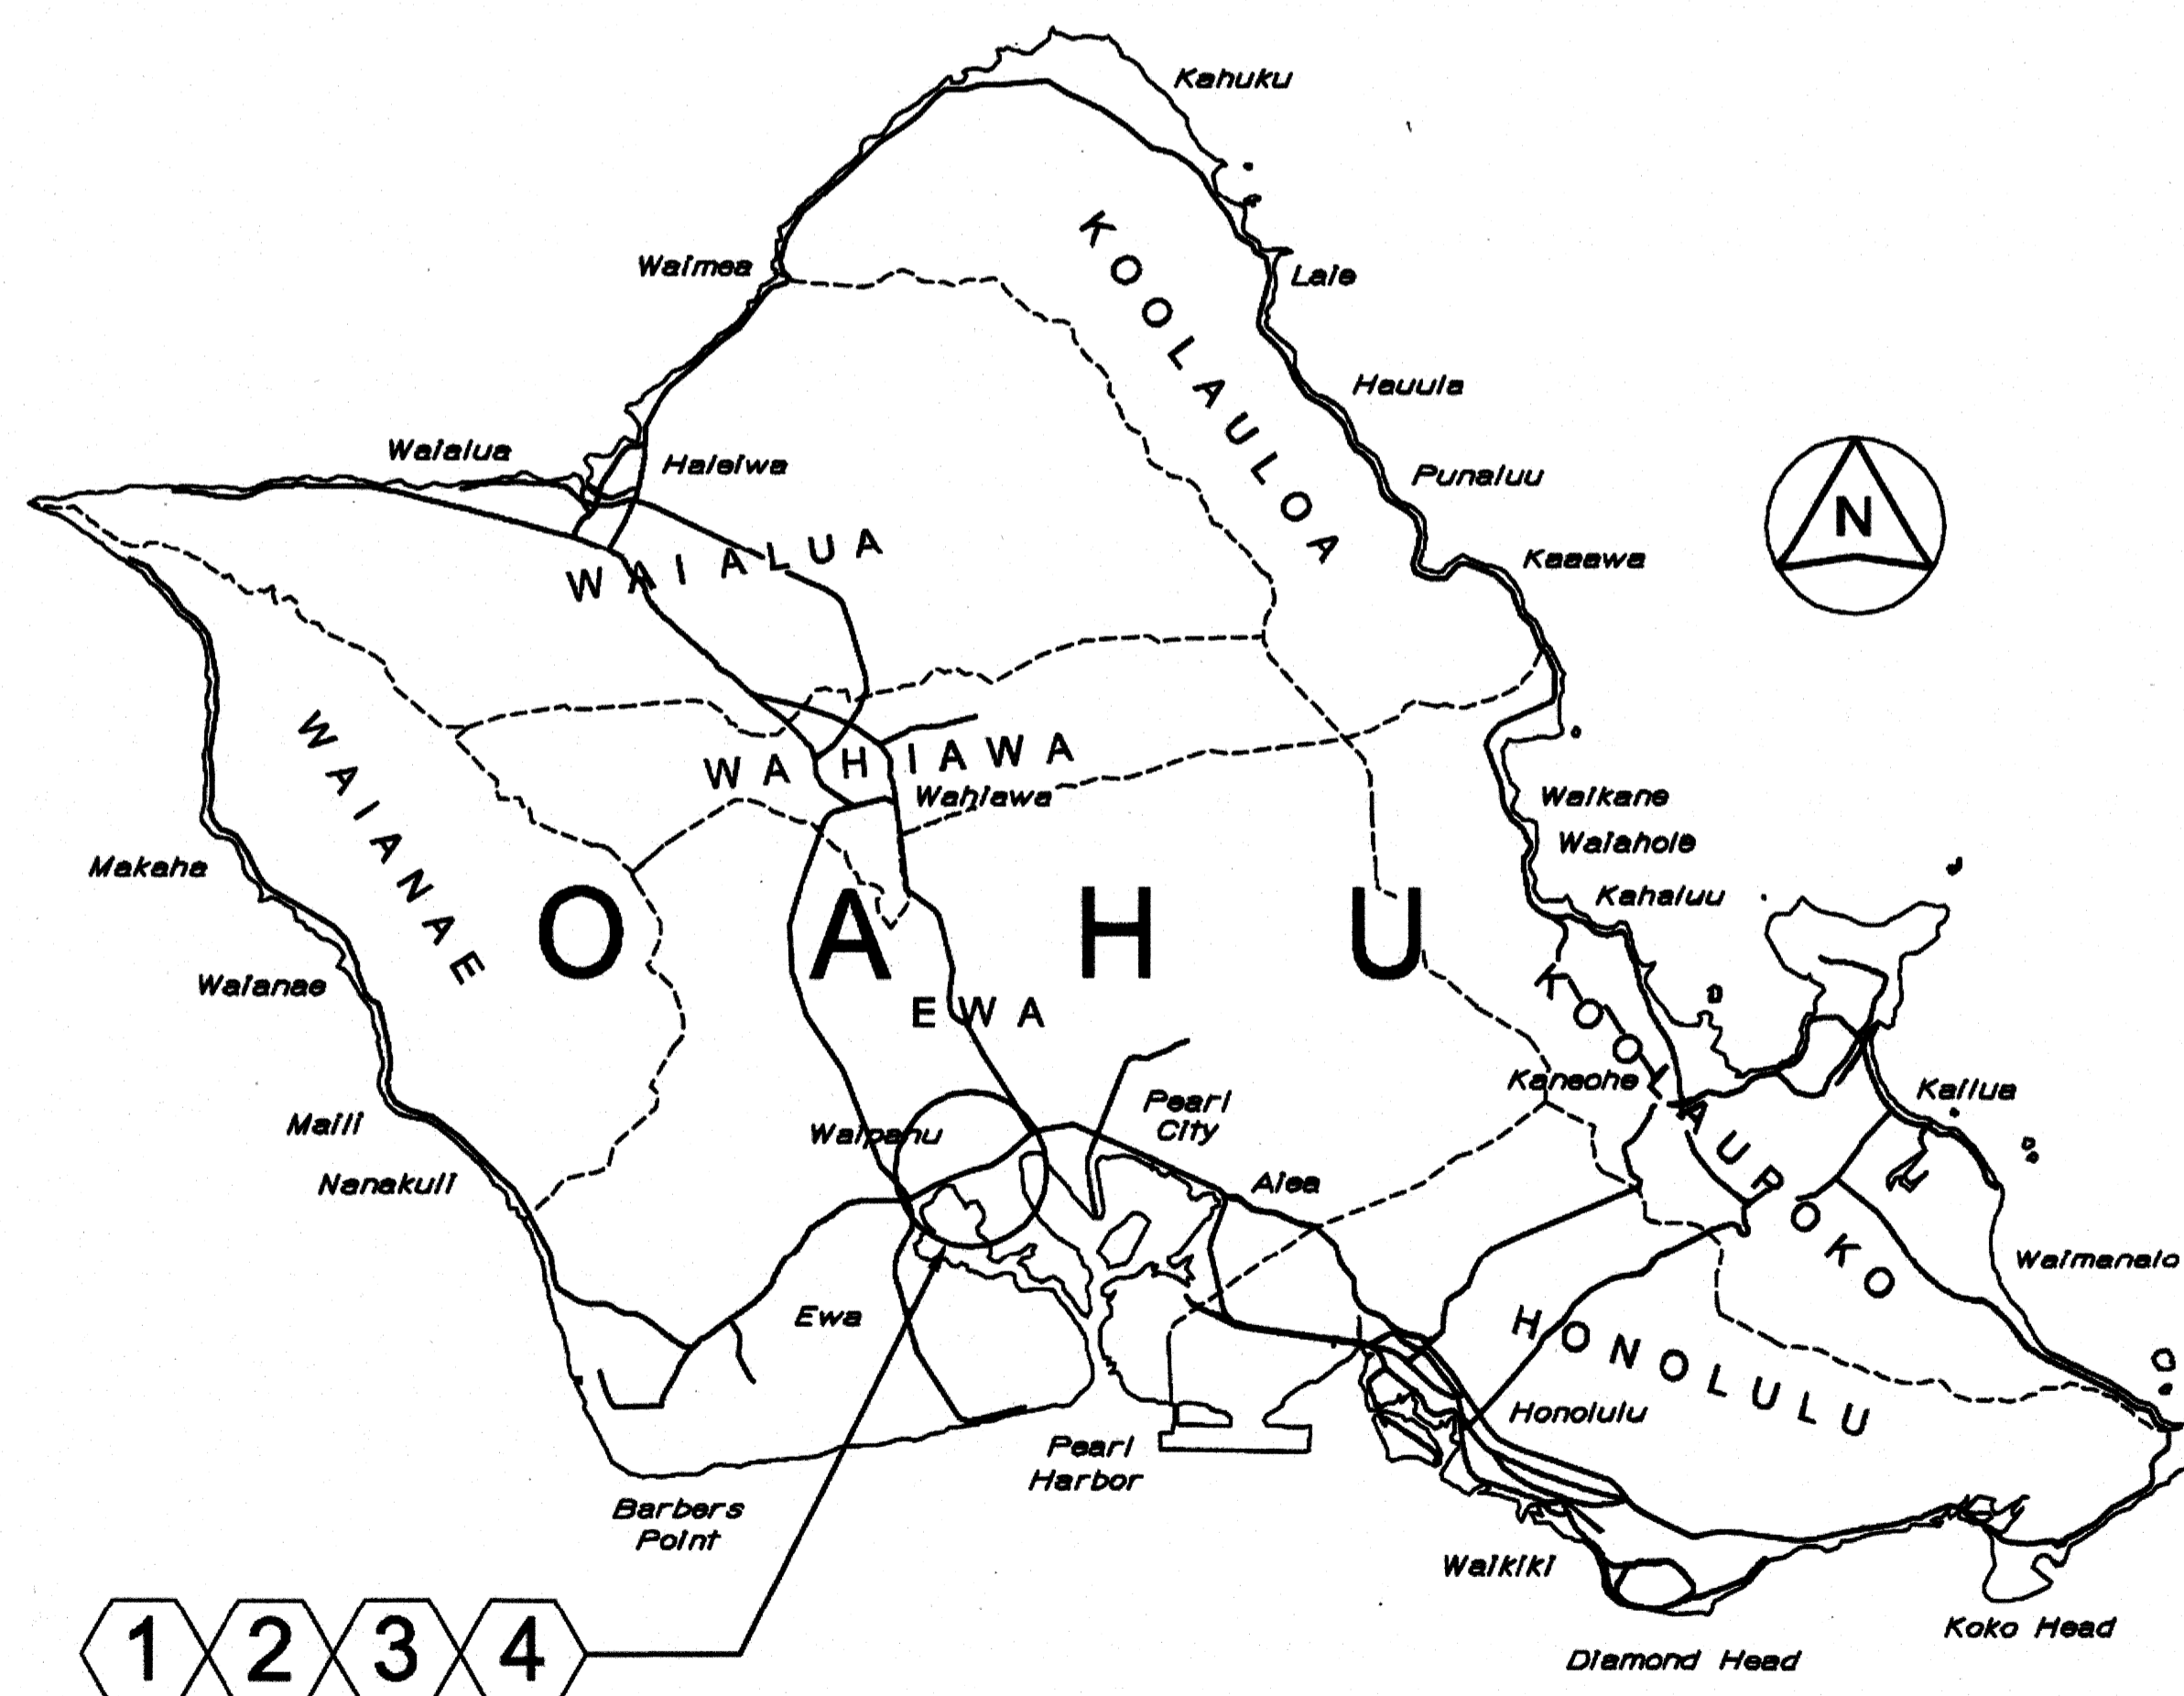

**PROJECT SITES**

- 1 LOCATION PLAN- PID 56  
INTERSTATE ROUTE H-1  
BEGIN MILEPOST: 7.31  
END MILEPOST: 7.56
- 2 LOCATION PLAN- PID 47  
INTERSTATE ROUTE H-1  
BEGIN MILEPOST: 6.69  
END MILEPOST: 6.89
- 3 LOCATION PLAN- PID 48  
INTERSTATE ROUTE H-1  
BEGIN MILEPOST: 6.41  
END MILEPOST: 6.65
- 4 LOCATION PLAN- PID 109  
INTERSTATE ROUTE H-1  
BEGIN MILEPOST: 6.42  
END MILEPOST: 6.66

**LEGEND FOR AS-BUILT POSTINGS**

- Squiggly line for as-built deletion
- Double line for as-built deletion
- Roadway Text for as-built posting

LIMITACO CONSULTING GROUP  
DESIGNED BY  
HWY-O-W  
MANAGED BY  
483-2569  
PHONE  
SEPT 2015  
DATE

TOTAL SHEET COUNT after "AS BUILT" postings.  
43 Sheets.

DEPARTMENT OF TRANSPORTATION  
STATE OF HAWAII  
APPROVED:  
*[Signature]*  
DIR. OF TRANSPORTATION DATE

"AS-BUILT"