


FED. ROAD DIST. NO.	STATE	PROJ. NO.	FISCAL YEAR	SHEET NO.	TOTAL SHEETS
HAWAII	HAW.	HWY-O-04-16	2016	14	60

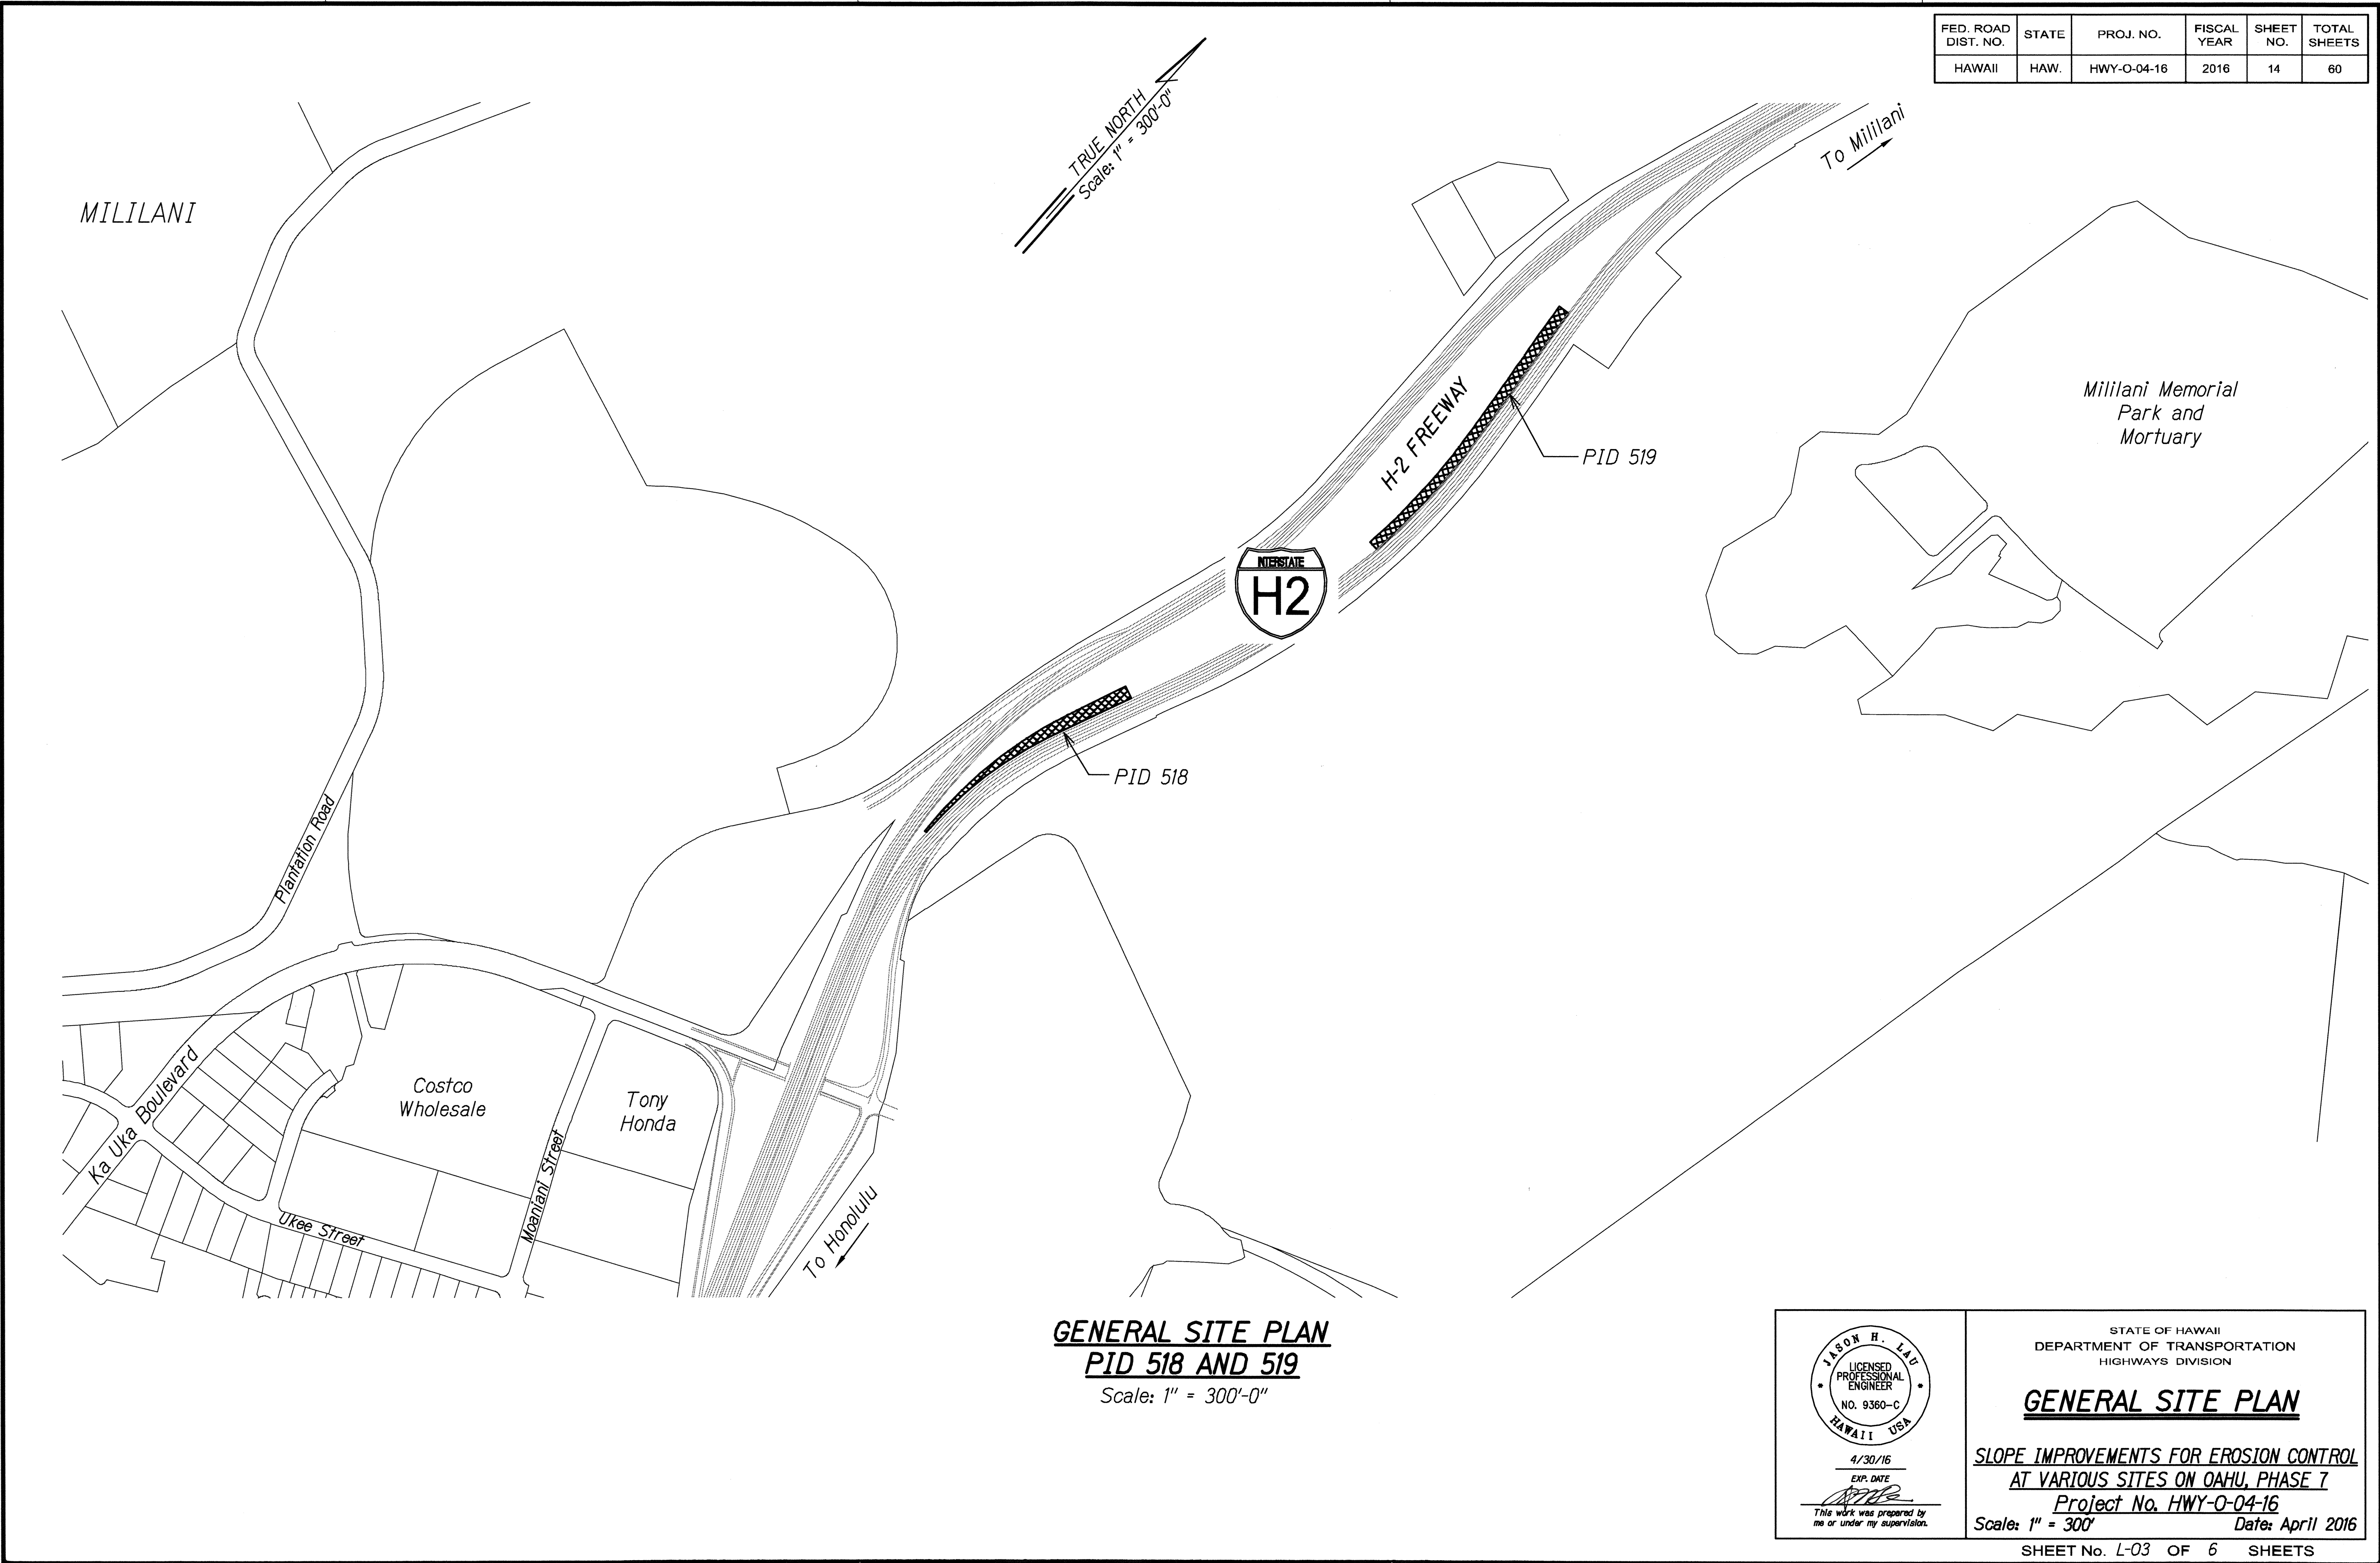

ORIGINAL PLAN	SURVEY PLOTTED BY	DATE
NOTE BOOK	DRAWN BY	
	DESIGNED BY	
	CHECKED BY	

01 GEN LOCATION MAPING 3/16/2016 2:56:59 PM

4/30/16
EXP. DATE

[Signature]

This work was prepared by me or under my supervision.

STATE OF HAWAII
DEPARTMENT OF TRANSPORTATION
HIGHWAYS DIVISION

GENERAL SITE PLAN

SLOPE IMPROVEMENTS FOR EROSION CONTROL AT VARIOUS SITES ON OAHU, PHASE 7


Project No. HWY-O-04-16

Scale: 1" = 300' Date: April 2016

SHEET No. L-03 OF 6 SHEETS

FED. ROAD DIST. NO.	STATE	PROJ. NO.	FISCAL YEAR	SHEET NO.	TOTAL SHEETS
HAWAII	HAW.	HWY-O-04-16	2016	15	60

TRUE NORTH
Scale: 1" = 300'-0"

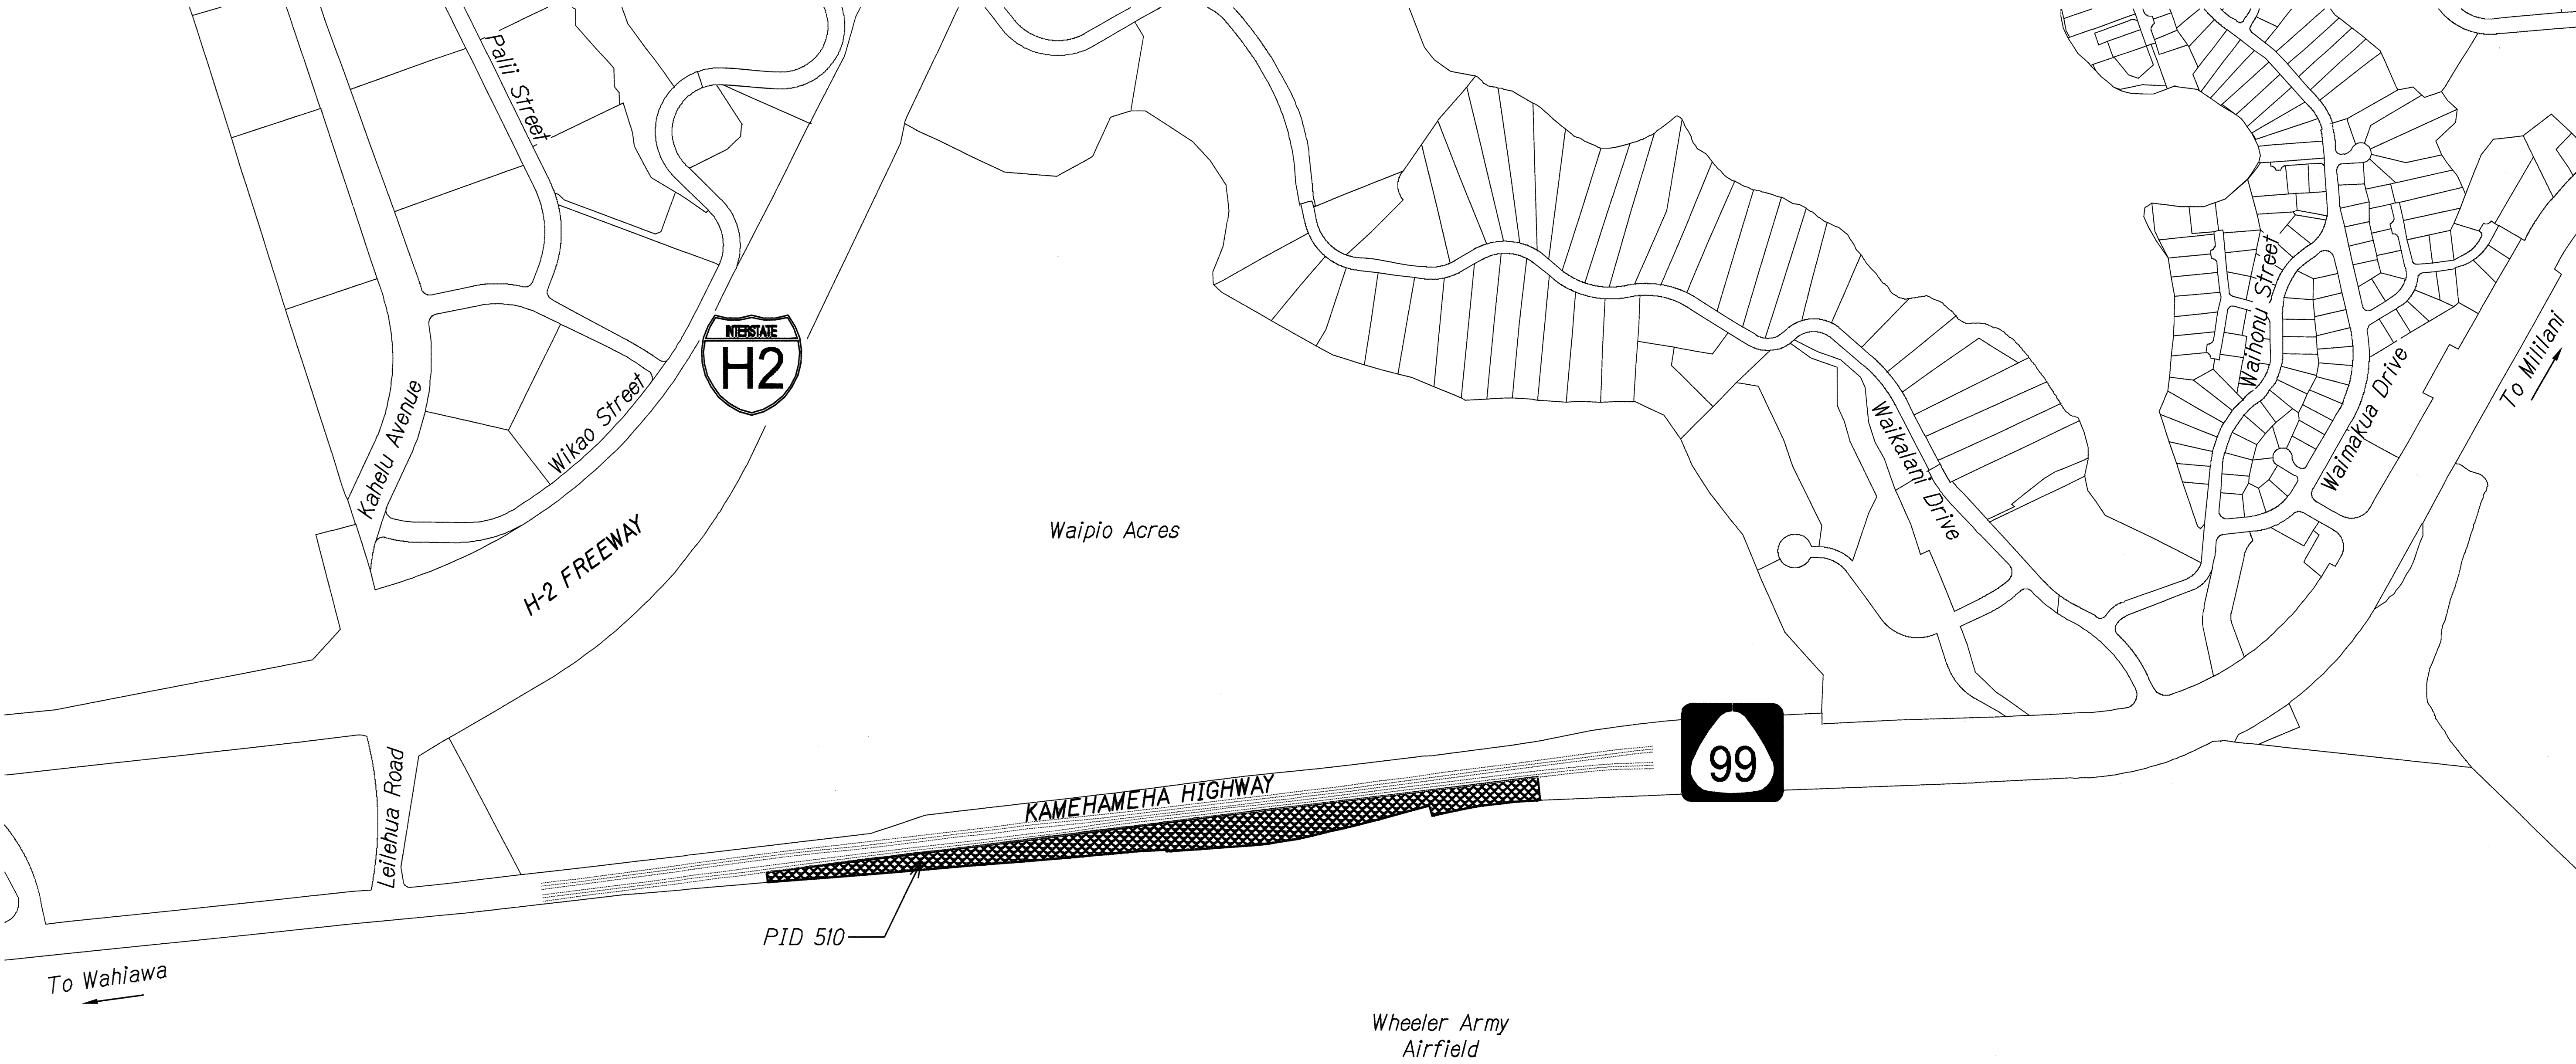

GENERAL SITE PLAN
PID 510
Scale: 1" = 300'-0"

ORIGINAL PLAN	SURVEY PLOTTED BY	DATE
NOTED BY	DRAWN BY	
DESIGNED BY	CHECKED BY	
NO. _____		

03 GEN LOCATION MAP/NO. 3/16/2016 2:06:29 PM

4/30/16
EXP. DATE
Jason H. Liu
This work was prepared by me or under my supervision.


STATE OF HAWAII
DEPARTMENT OF TRANSPORTATION
HIGHWAYS DIVISION

GENERAL SITE PLAN

SLOPE IMPROVEMENTS FOR EROSION CONTROL AT VARIOUS SITES ON OAHU, PHASE 7

Project No. HWY-O-04-16
Scale: 1" = 300' Date: April 2016

FED. ROAD DIST. NO.	STATE	PROJ. NO.	FISCAL YEAR	SHEET NO.	TOTAL SHEETS
HAWAII	HAW.	HWY-O-04-16	2016	16	60

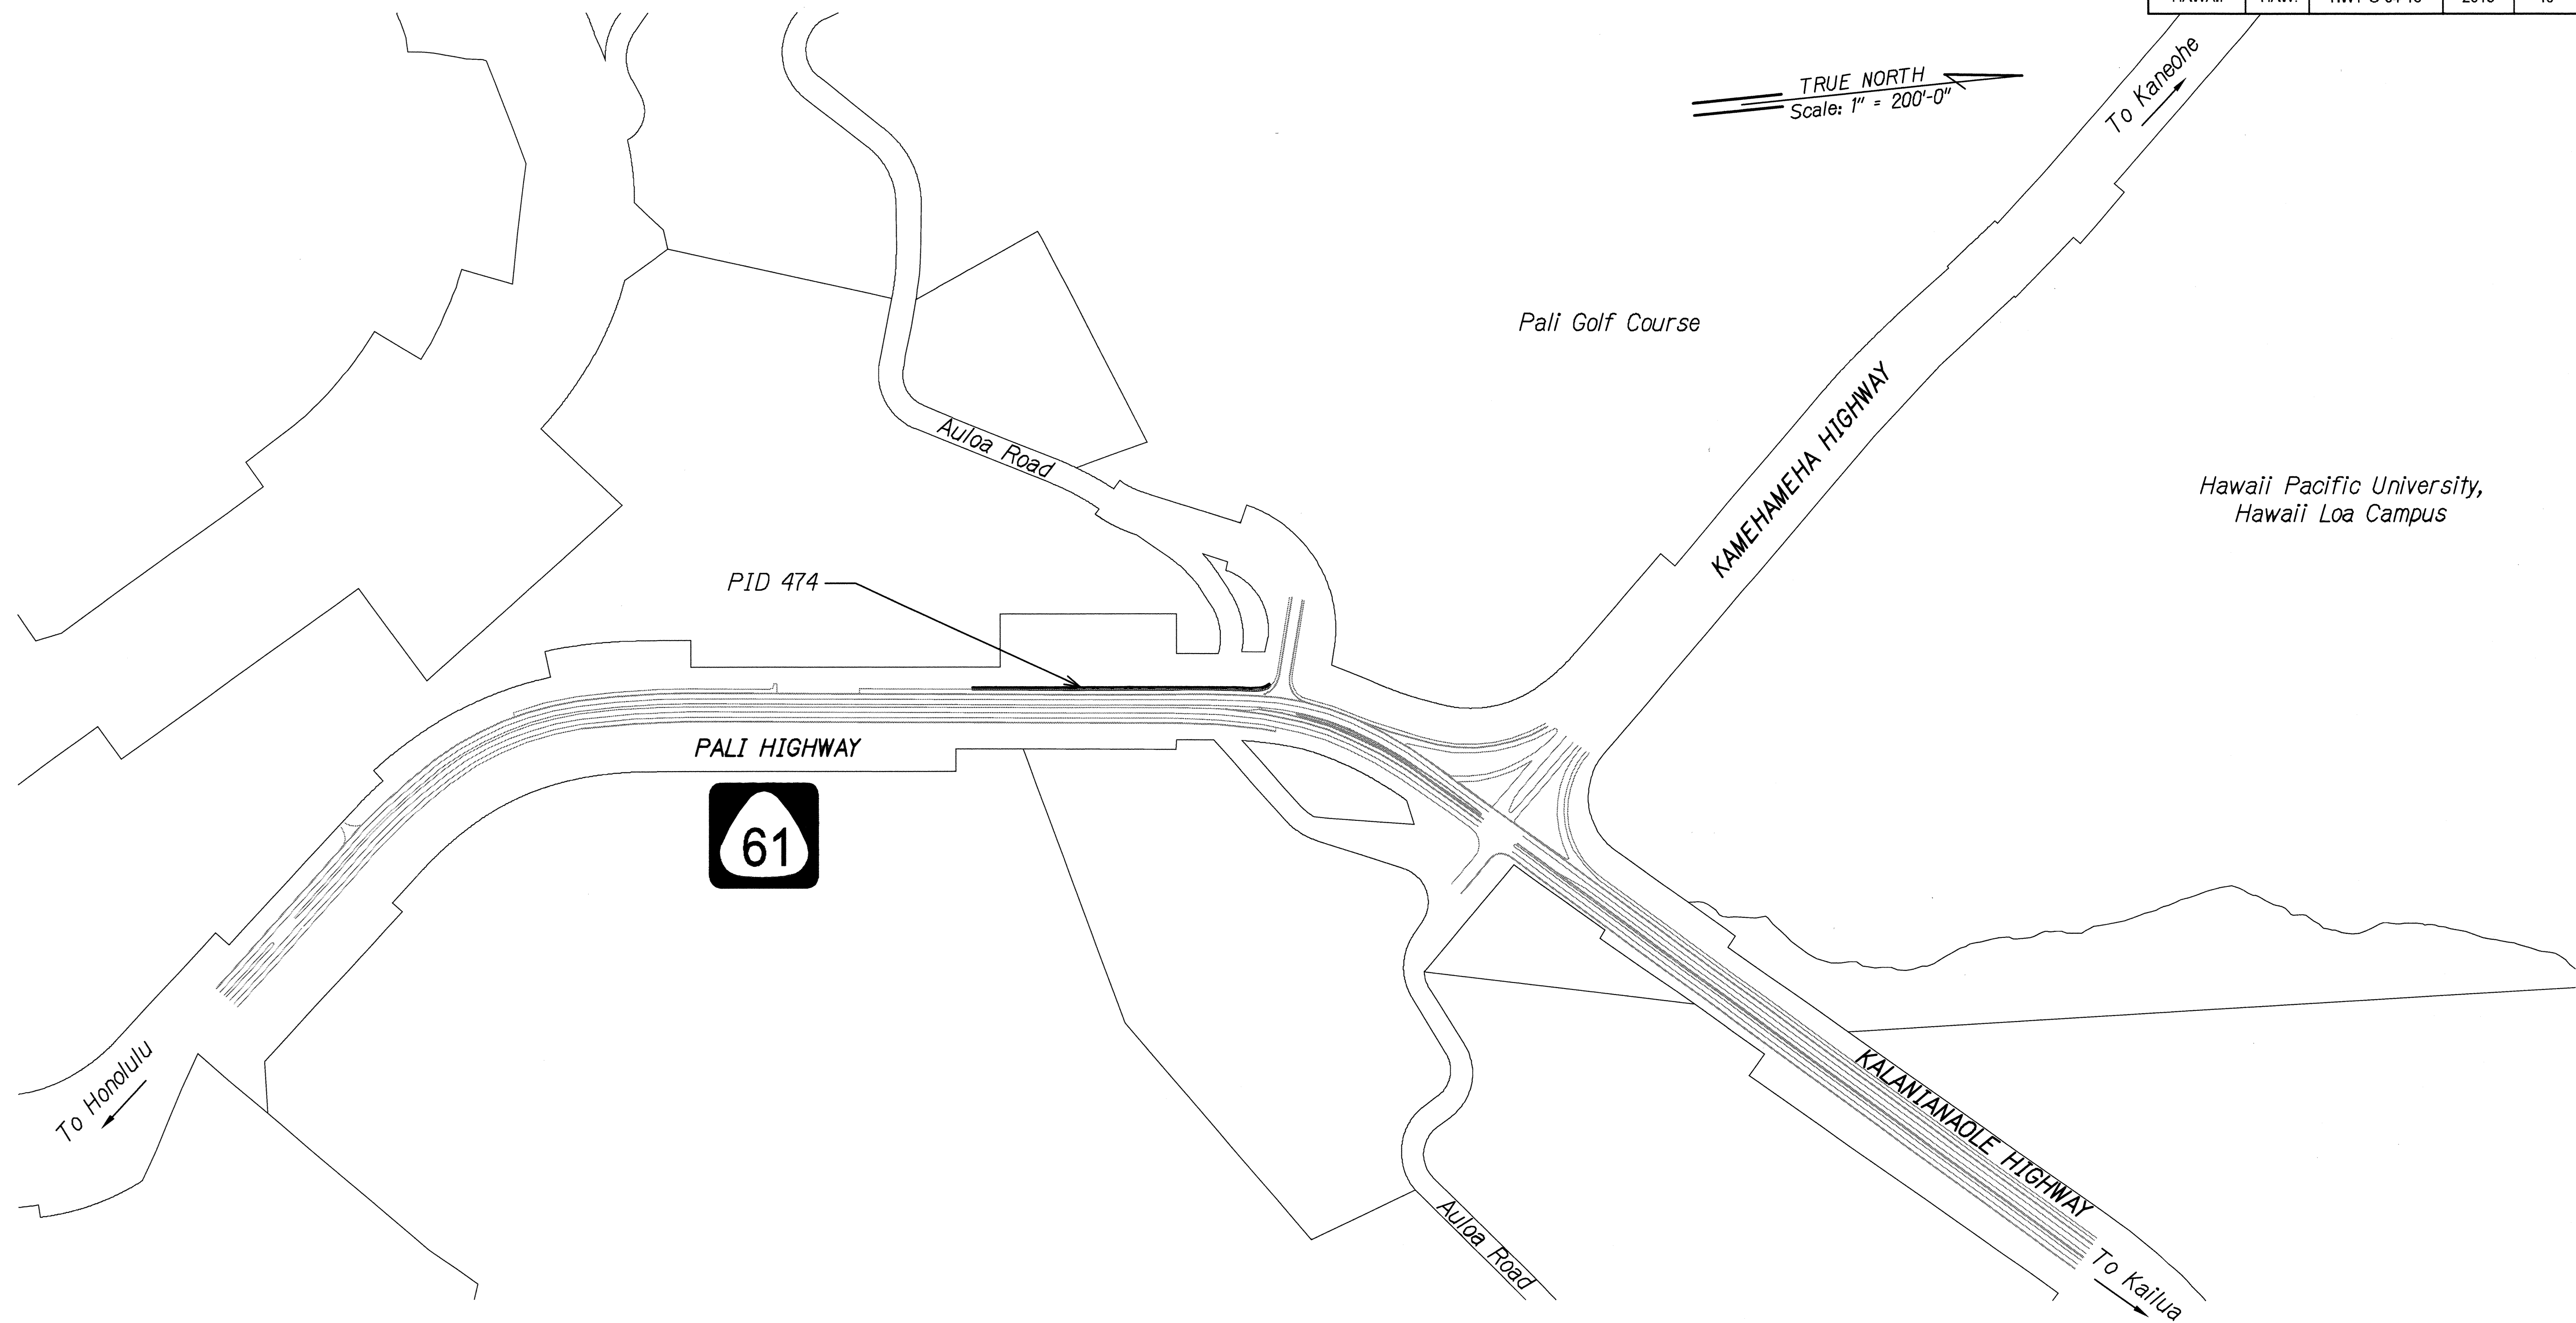

GENERAL SITE PLAN
PID 474
 Scale: 1" = 200'-0"

ORIGINAL PLAN	SURVEY PLOTTED BY	DATE
TRACED BY		
NOTE BOOK		
QUANTITIES BY		
CHECKED BY		
No.		

03.051 LOCATION MAP.DWG 3/16/2016 2:56:29 PM

4/30/16
DATE
This work was prepared by me or under my supervision.


STATE OF HAWAII
 DEPARTMENT OF TRANSPORTATION
 HIGHWAYS DIVISION

GENERAL SITE PLAN

**SLOPE IMPROVEMENTS FOR EROSION CONTROL
 AT VARIOUS SITES ON OAHU, PHASE 7**

Project No. HWY-O-04-16
 Scale: 1" = 200' Date: April 2016

FED. ROAD DIST. NO.	STATE	PROJ. NO.	FISCAL YEAR	SHEET NO.	TOTAL SHEETS
HAWAII	HAW.	HWY-O-04-16	2016	17	60

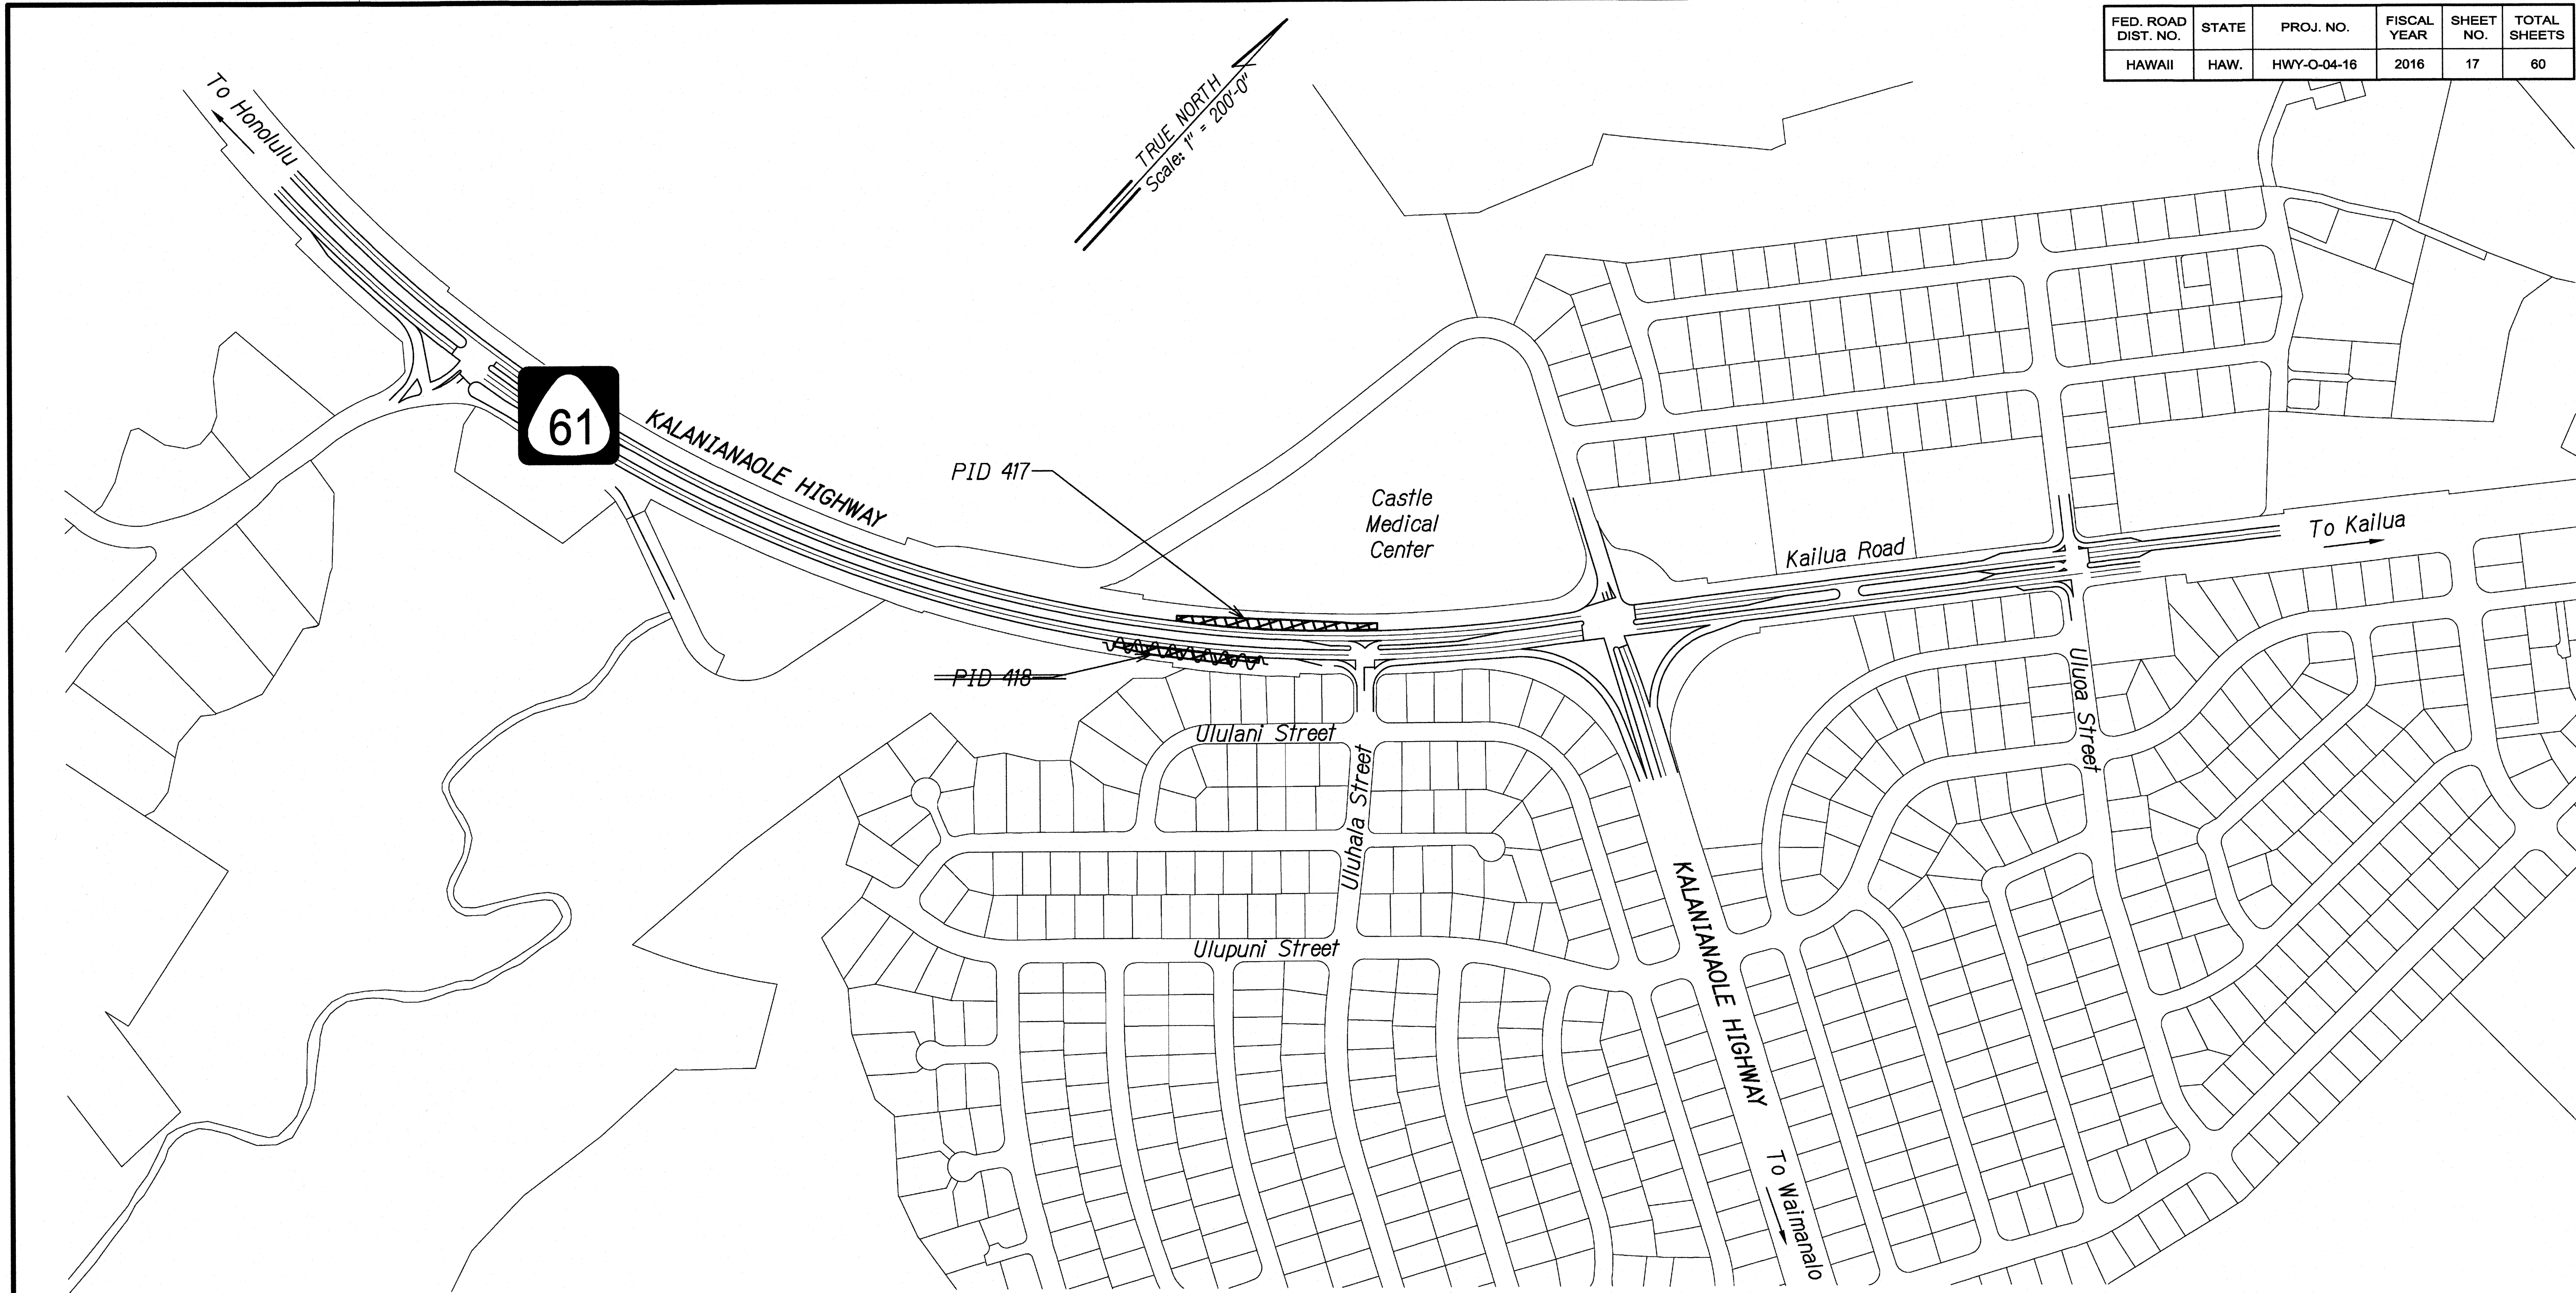

ORIGINAL PLAN	DATE
DESIGNED BY	
NOTED BY	
QUANTITIES BY	
CHECKED BY	
DATE	

03 GEN. LOCATION MAP/ENG. 1/13/2016 5:28:55 PM

GENERAL SITE PLAN
PID 417 AND 418
 Scale: 1" = 200'-0"

LEGEND FOR AS-BUILT POSTINGS	
	Squiggly line for as-built deletion
	Double line for as-built deletion
Roadway	Text for as-built posting

STATE OF HAWAII
 DEPARTMENT OF TRANSPORTATION
 HIGHWAYS DIVISION

GENERAL SITE PLAN

SLOPE IMPROVEMENTS FOR EROSION CONTROL
 AT VARIOUS SITES ON OAHU, PHASE 7
 Project No. HWY-O-04-16
 Scale: 1" = 200' Date: April 2016

SHEET No. L-06 OF 6 SHEETS