INDEX TO DRAWINGS
DESCRIPTION
TITLE SHEET
STANDARD PLANS SUMMARY
GENERAL NOTES, LEGEND AND ABBREVIATIONS
CONSTRUCTION NOTES
UTILITY NOTES
WATER POLLUTION AND EROSION CONTROL NOTES
LOCATION PLANS
GENERAL SITE PLANS
EROSION CONTROL PLANS AND DETAILS
LANDSCAPING PLANS, DETAILS, AND NOTES
TRAFFIC CONTROL NOTES AND LEGEND
TRAFFIC CONTROL PLANS

STATE OF HAWAII

DEPARTMENT OF TRANSPORTATION


HIGHWAYS DIVISION HONOLULU, HAWAII

"AS-BUILT"

PLANS FOR

FED. ROAD DIST. NO. STATE PROJ. NO. FISCAL SHEET NO. SHEETS HAWAII HAW. HWY-O-04-16 2016 1 60



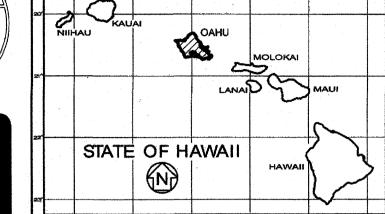




SLOPE IMPROVEMENTS FOR EROSION CONTROL

AT VARIOUS SITES ON OAHU, PHASE 7 PROJECT NO. HWY-O-04-16

DISTRICTS OF WAHIAWA, EWA, AND KOOLAUPOKO ISLAND OF OAHU

CHANGES MADE DURING CONSTRUCTION HAVE BEEN INCORPORATED ON THESE PLANS EXCEPT CHANGES IN THE ORIGINAL THEORETICAL QUANTITIES. FOR ACTUAL QUANTITIES, REFER TO PROJECT LEDGER AND/OR COMPUTATION BOOK.

Bon	
 RESIDENT	ENGINEER

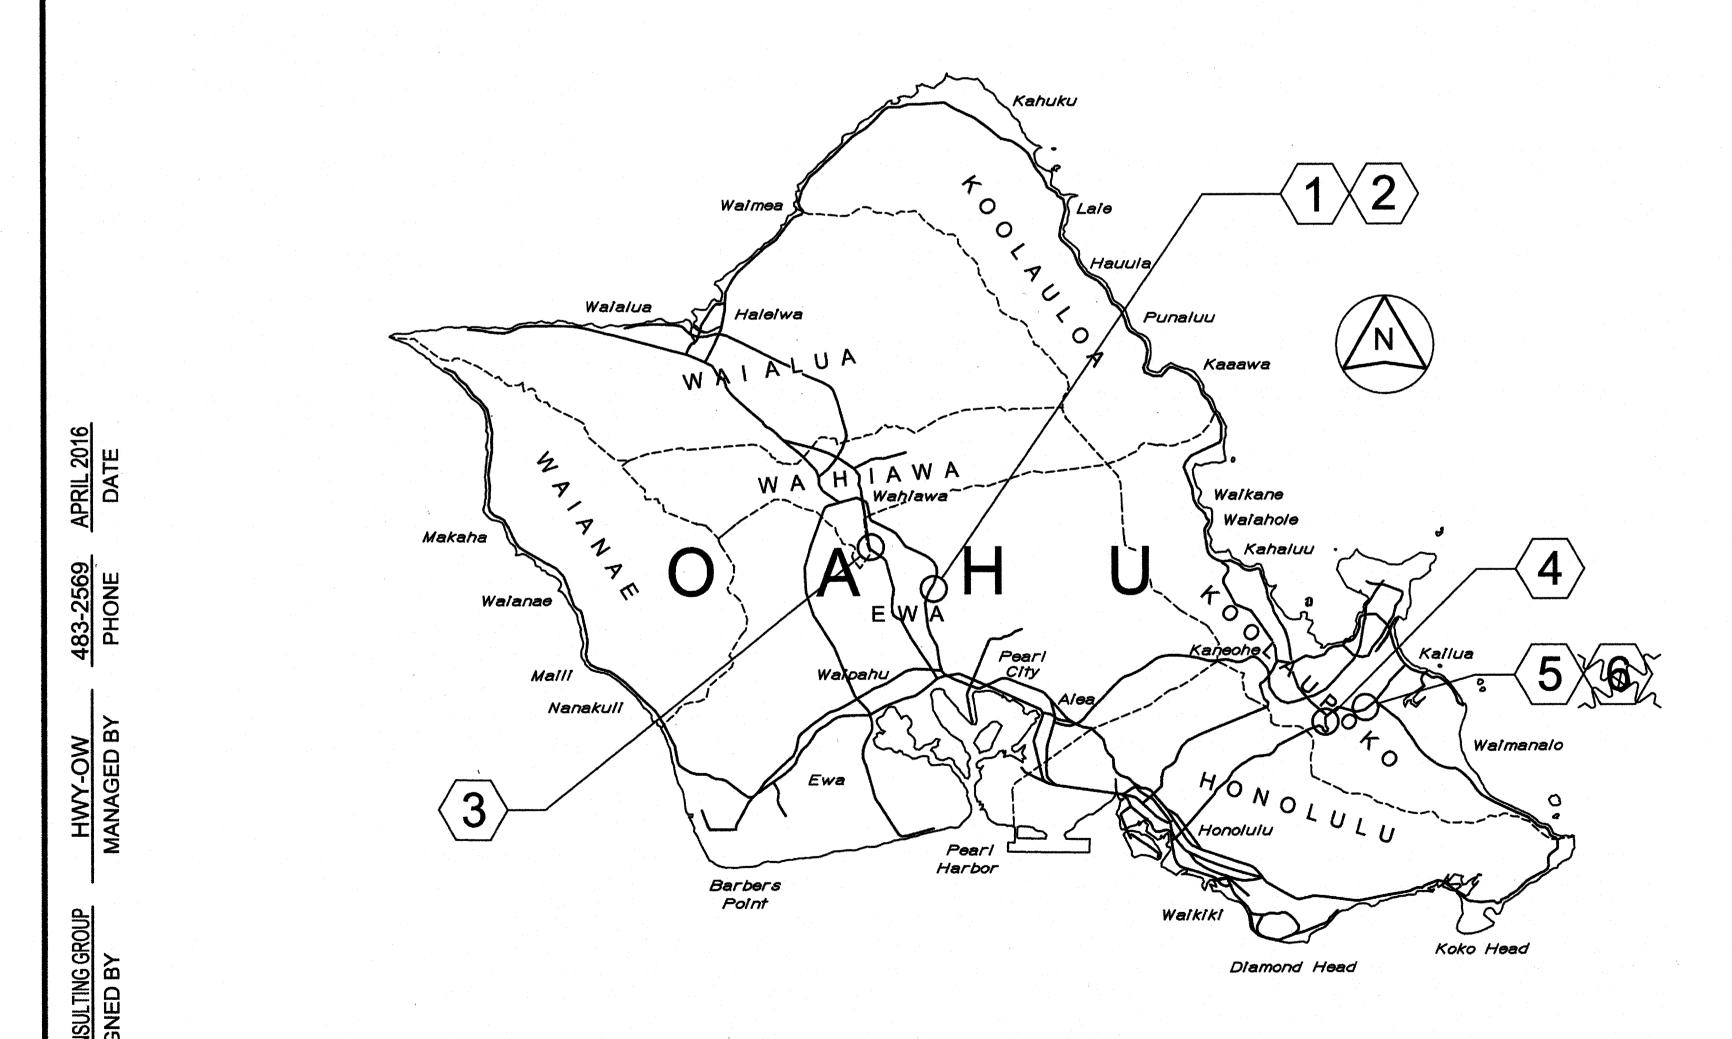

PROJECT SITES

- LOCATION PLAN PID 518
 INTERSTATE ROUTE H-2
 BEGIN MILEPOST: 2.68
 END MILEPOST: 2.94
- 2 LOCATION PLAN PID 519 INTERSTATE ROUTE H-2 BEGIN MILEPOST: 3.14 END MILEPOST: 3.28
- LOCATION PLAN PID 510 KAMEHAMEHA HIGHWAY 99 BEGIN MILEPOST: 11.16 END MILEPOST: 11.45
- LOCATION PLAN PID 474
 PALI HIGHWAY 61
 BEGIN MILEPOST: 7.51
 END MILEPOST: 7.60
- LOCATION PLAN PID 417
 KALANIANAOLE HIGHWAY 61
 BEGIN MILEPOST: 9.29
 END MILEPOST: 9.38
- 6 LOCATION PLAN PID 418

 KALANIANAOL F. HIGHWAY 61

 BEGIN MILEPOST: 9.25

 END MILEPOST: 9.31

•	
LEGEND	FOR AS-BUILT POSTINGS
~~~	Squiggly line for as-built deletion
-100.00	Double line for as-built deletion
Roadway	Text for as-built posting

TOTAL SHEET COUNT after "AS BUILT" postings.

60 Sheets.

DEPARTMENT OF TRANSPOR STATE OF HAWAII	TATION
APPROVED:	
Tarth	4-5-16
DIR. OF TRANSPORTATION	DATE