

STATE OF HAWAII
DEPARTMENT OF TRANSPORTATION
HIGHWAYS DIVISION

ADDENDUM NO. 2
for
SLOPE IMPROVEMENTS FOR EROSION CONTROL
AT VARIOUS SITES ON OAHU, PHASE 8
PROJECT NO. HWY-O-01-18

The following amendments shall be made to the Bid Documents:

The following are provided for your information.

A. PLANS

1. Add to Sheet EC-01 the "Bottom of Slope Anchor Trench Detail" shown in Attachment "A".


B. REQUESTS FOR CLARIFICATION

The following Requests for Clarification were received and the responses are listed below:


1. Question: Note #5 on Sheet EC-01 states "For temporary Type 3 ECM, anchor trenches are not required. In lieu of top anchor trench, install 2 rows of stakes along top edge, offset at 12" O.C." What about bottom edge and longitudinal edges?

Response: Note #5 only pertains to the treatment at the top edge. For installation of the remaining portions of the Erosion Control Matting, Specification Section 659.03(B)(4) still applies: "Install Type 3 temporary ECM using stakes to secure the matting to the slope face or work area as indicated on the plans and accordance with the manufacturer's installation design guidelines."

Please acknowledge receipt of this Addendum No. 2 by recording the date of its receipt in the space provided on page P-4 of the Proposal.

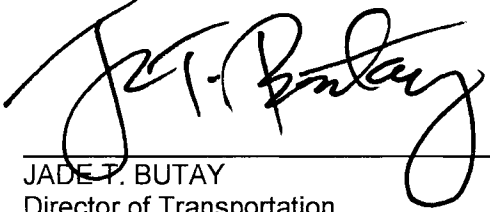

JADE T. BUTAY
Director of Transportation

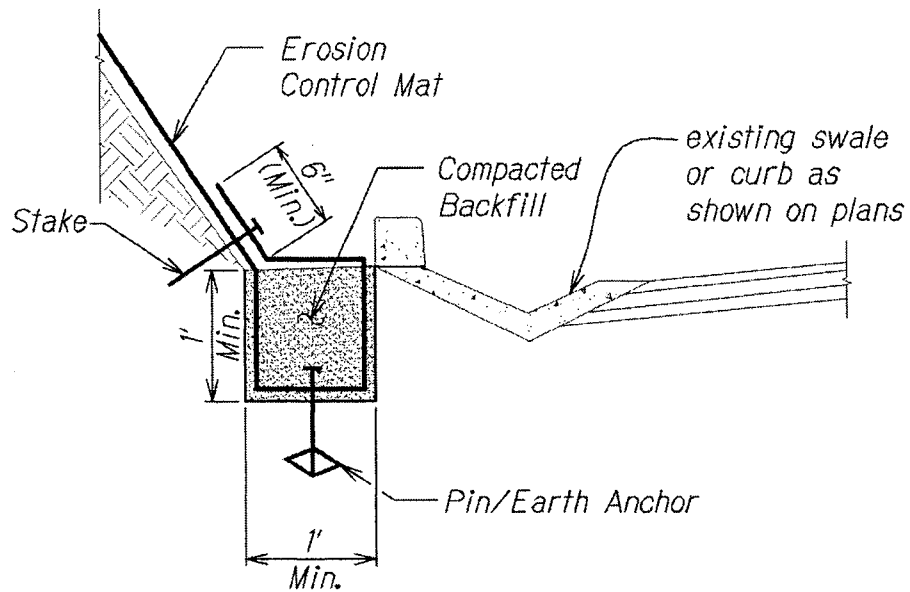

*BOTTOM OF SLOPE
ANCHOR TRENCH DETAIL*

Scale: Not to Scale

3
EC-01/EC-01