
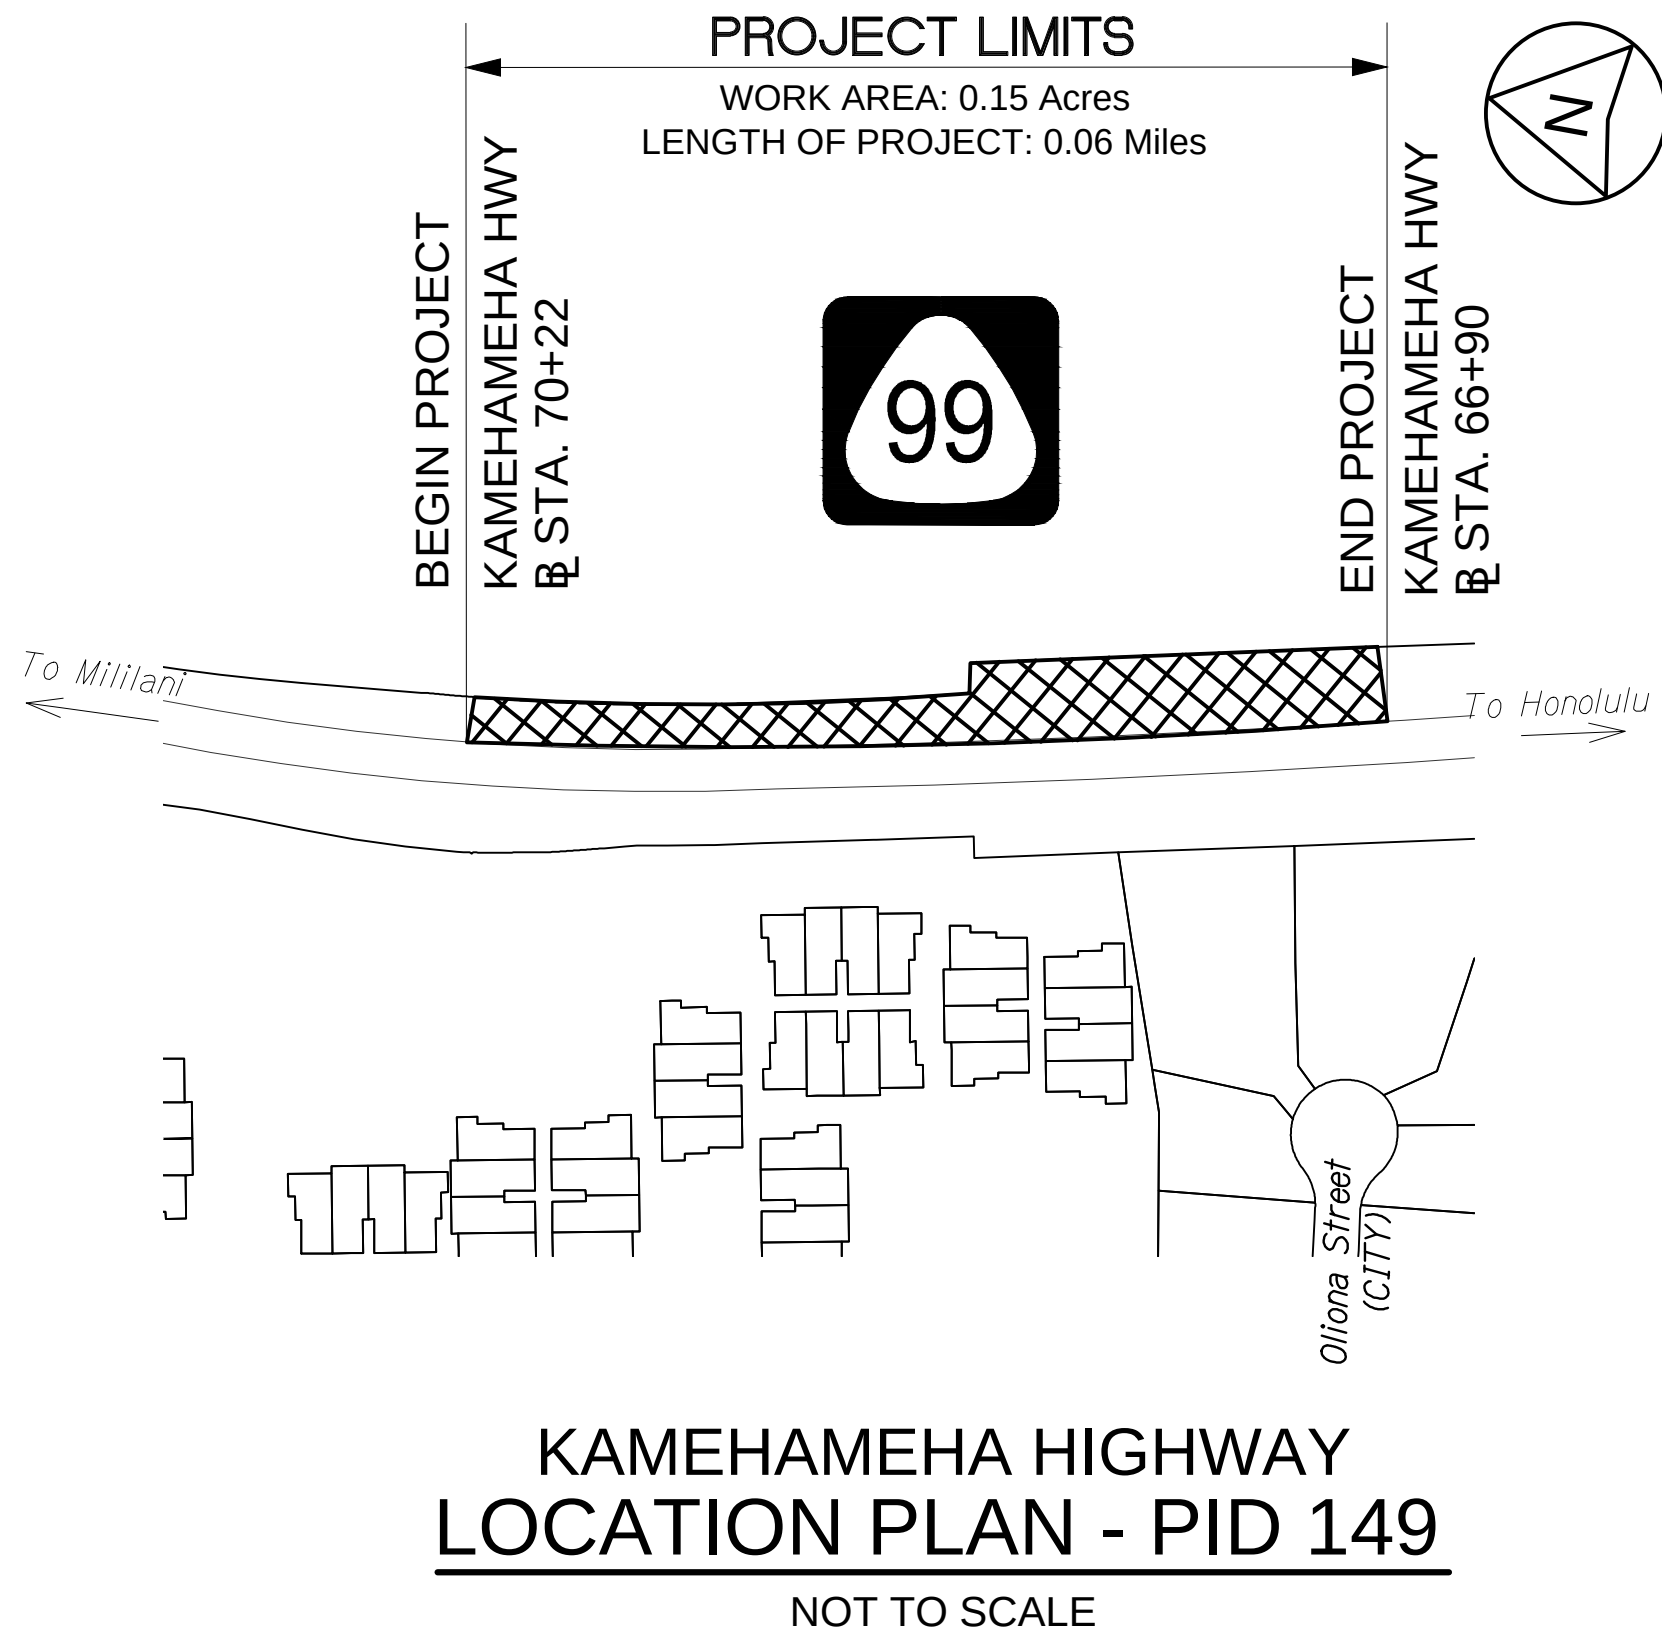
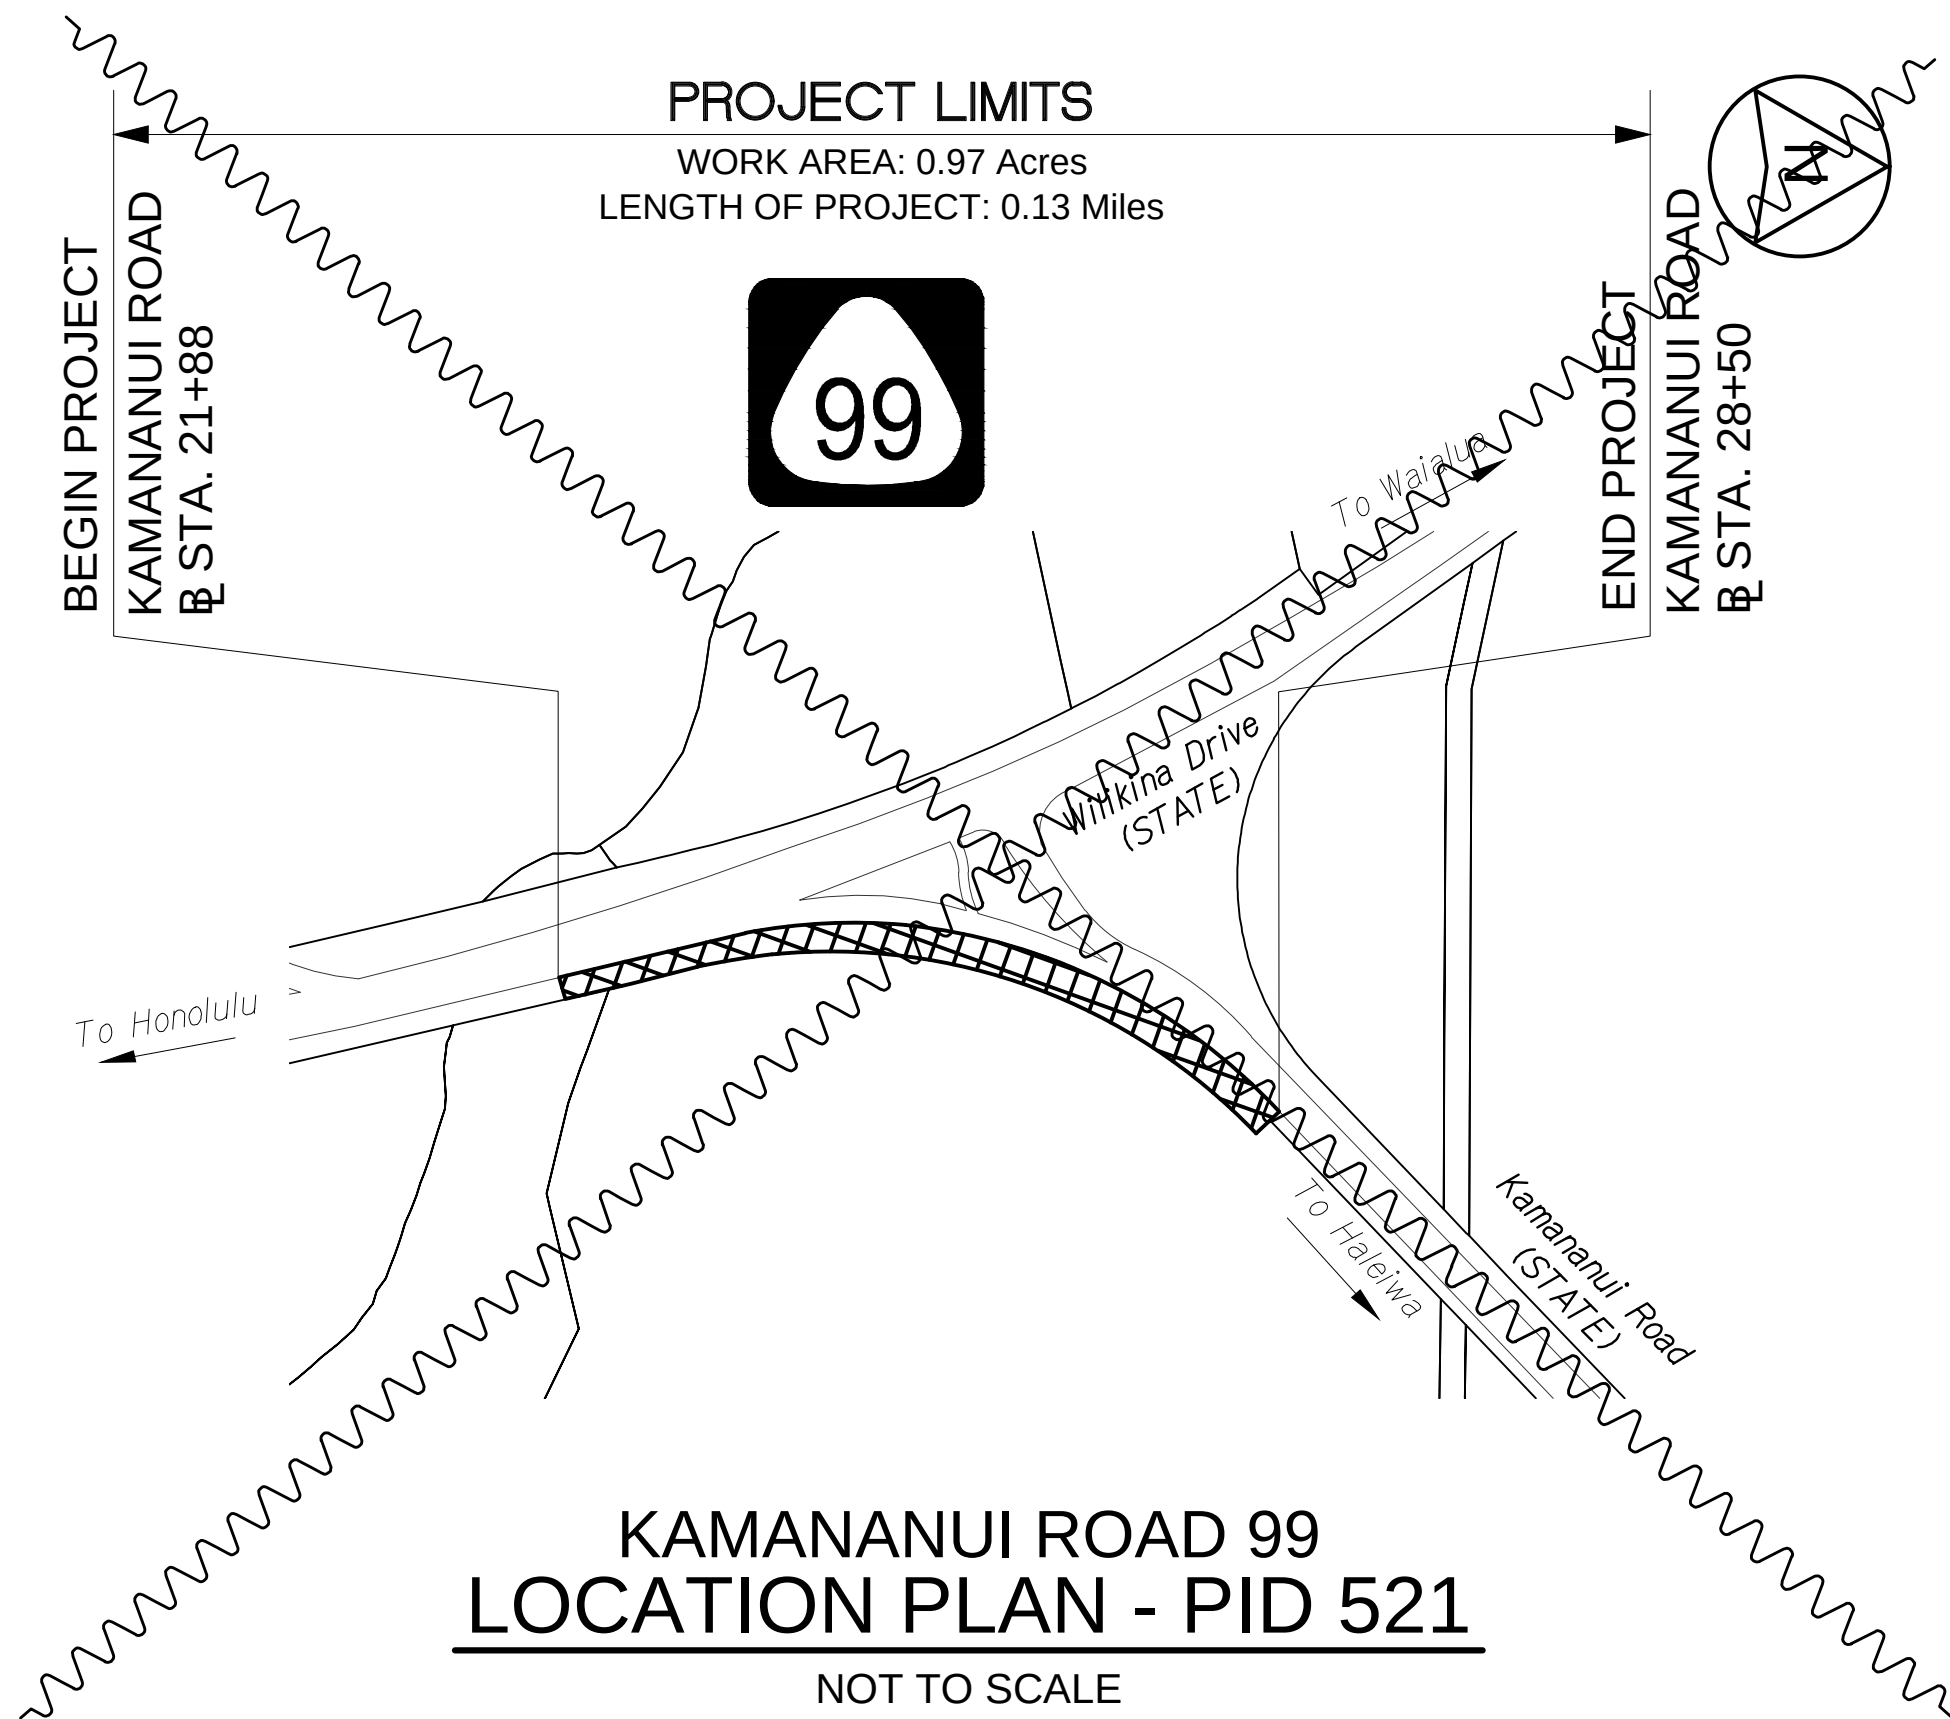


FED. ROAD DIST. NO.	STATE	PROJ. NO.	FISCAL YEAR	SHEET NO.	TOTAL SHEETS
HAWAII	HAW.	HWY-O-01-18	2018	3	65

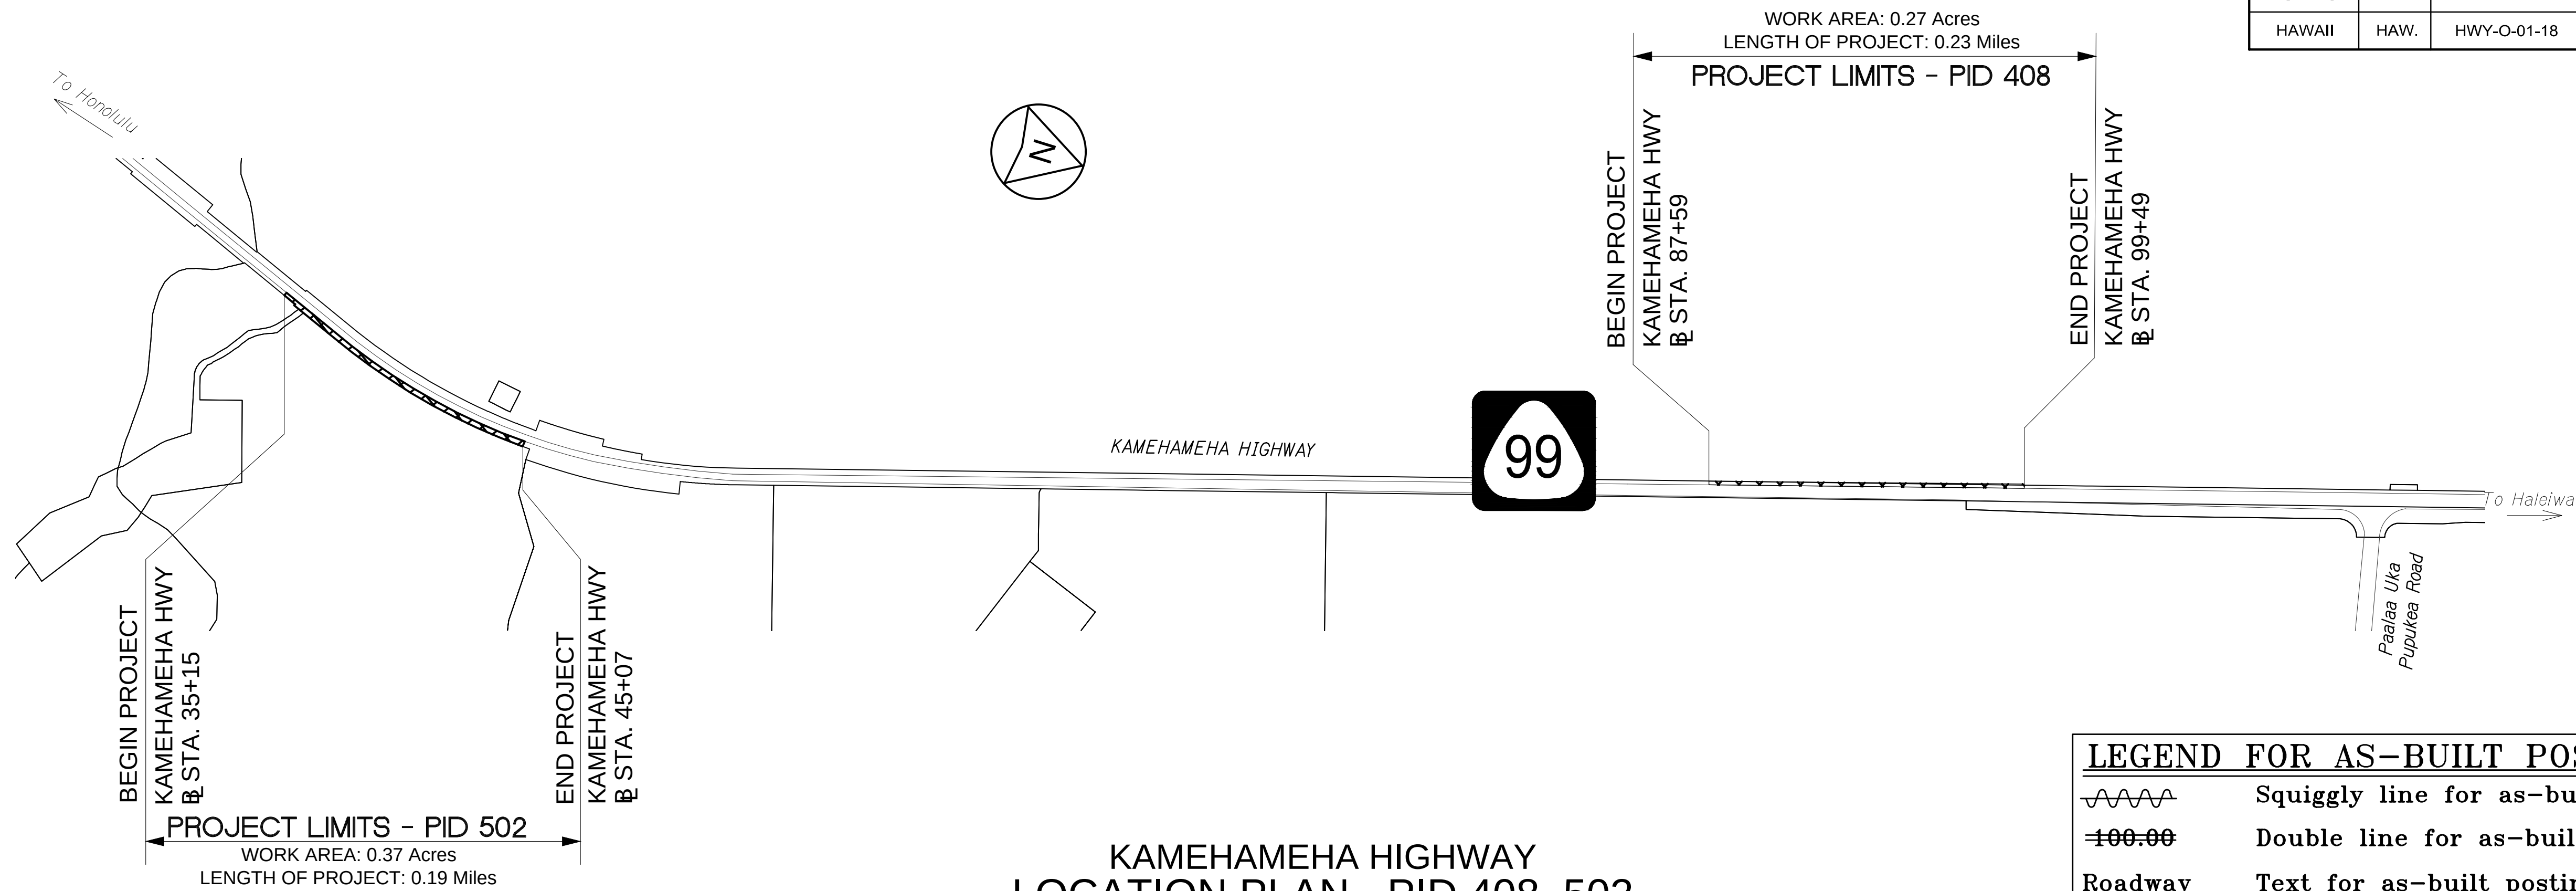



SURVEY PLOTTED BY: _____	DATE: _____
DESIGNED BY: _____	DESIGNED BY: _____
QUANTITIES BY: _____	QUANTITIES BY: _____
CHECKED BY: _____	CHECKED BY: _____
NO. _____	NO. _____

10 LOCATION PLAN - 4/12/2018 10:55 PM



STATE OF HAWAII
DEPARTMENT OF TRANSPORTATION
HIGHWAYS DIVISION
LOCATION PLAN
SLOPE IMPROVEMENTS FOR EROSION CONTROL
AT VARIOUS SITES ON OAHU, PHASE 8
Project No. HWY-O-01-18
Scale: None Date: April 2018

SHEET No. G-02 OF 3 SHEETS

FED. ROAD DIST. NO.	STATE	PROJ. NO.	FISCAL YEAR	SHEET NO.	TOTAL SHEETS
HAWAII	HAW.	HWY-O-01-18	2018	4	65

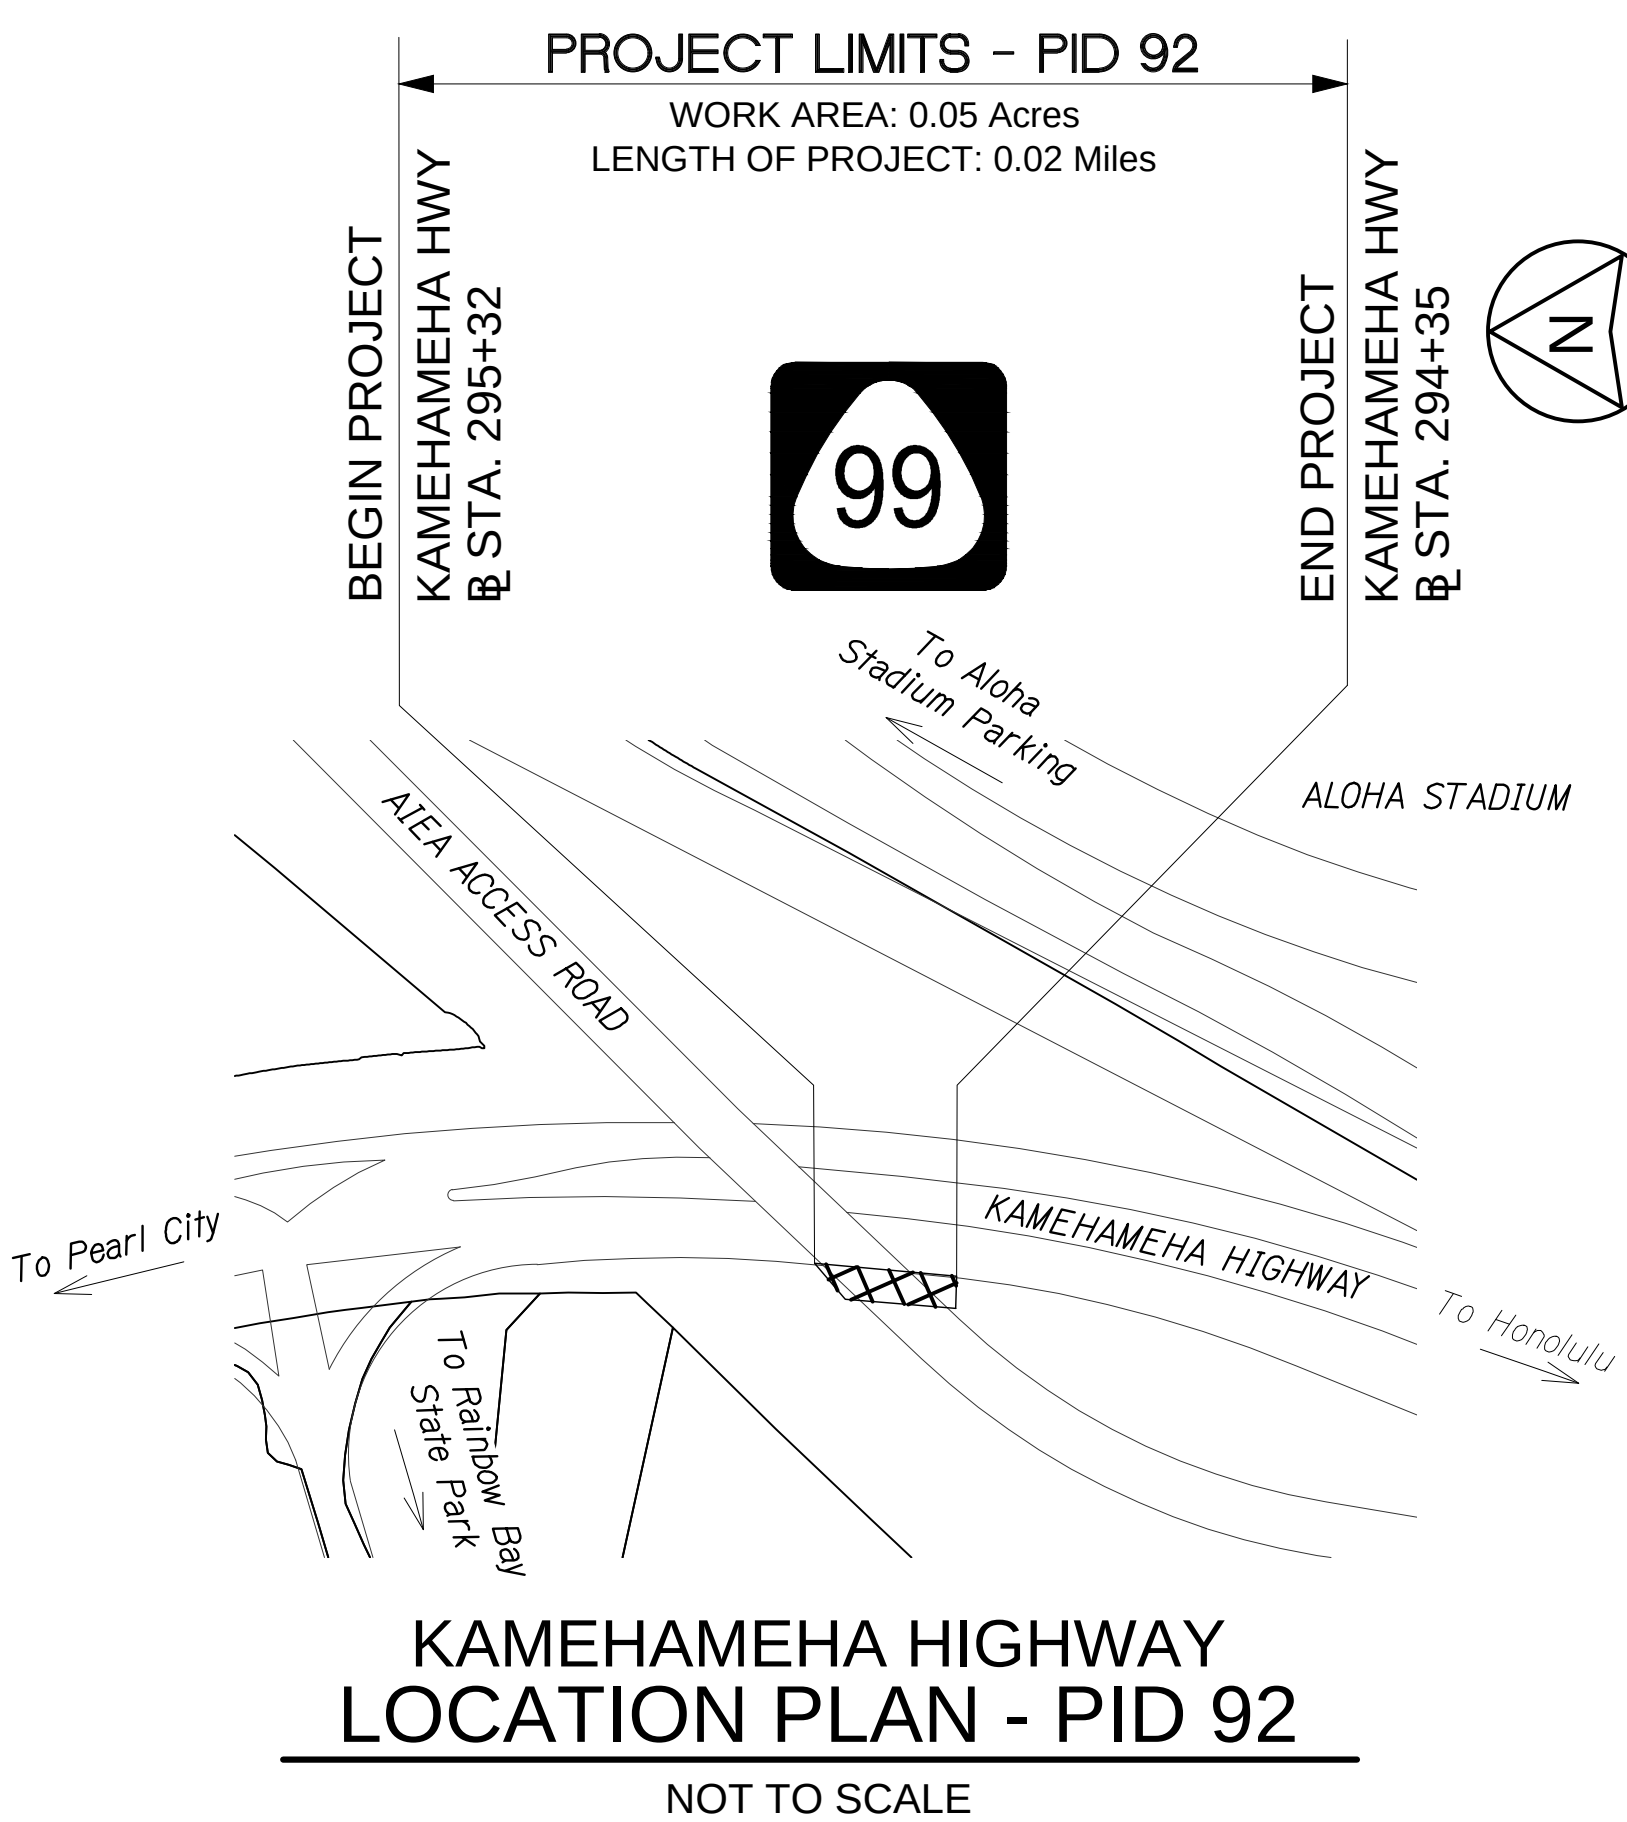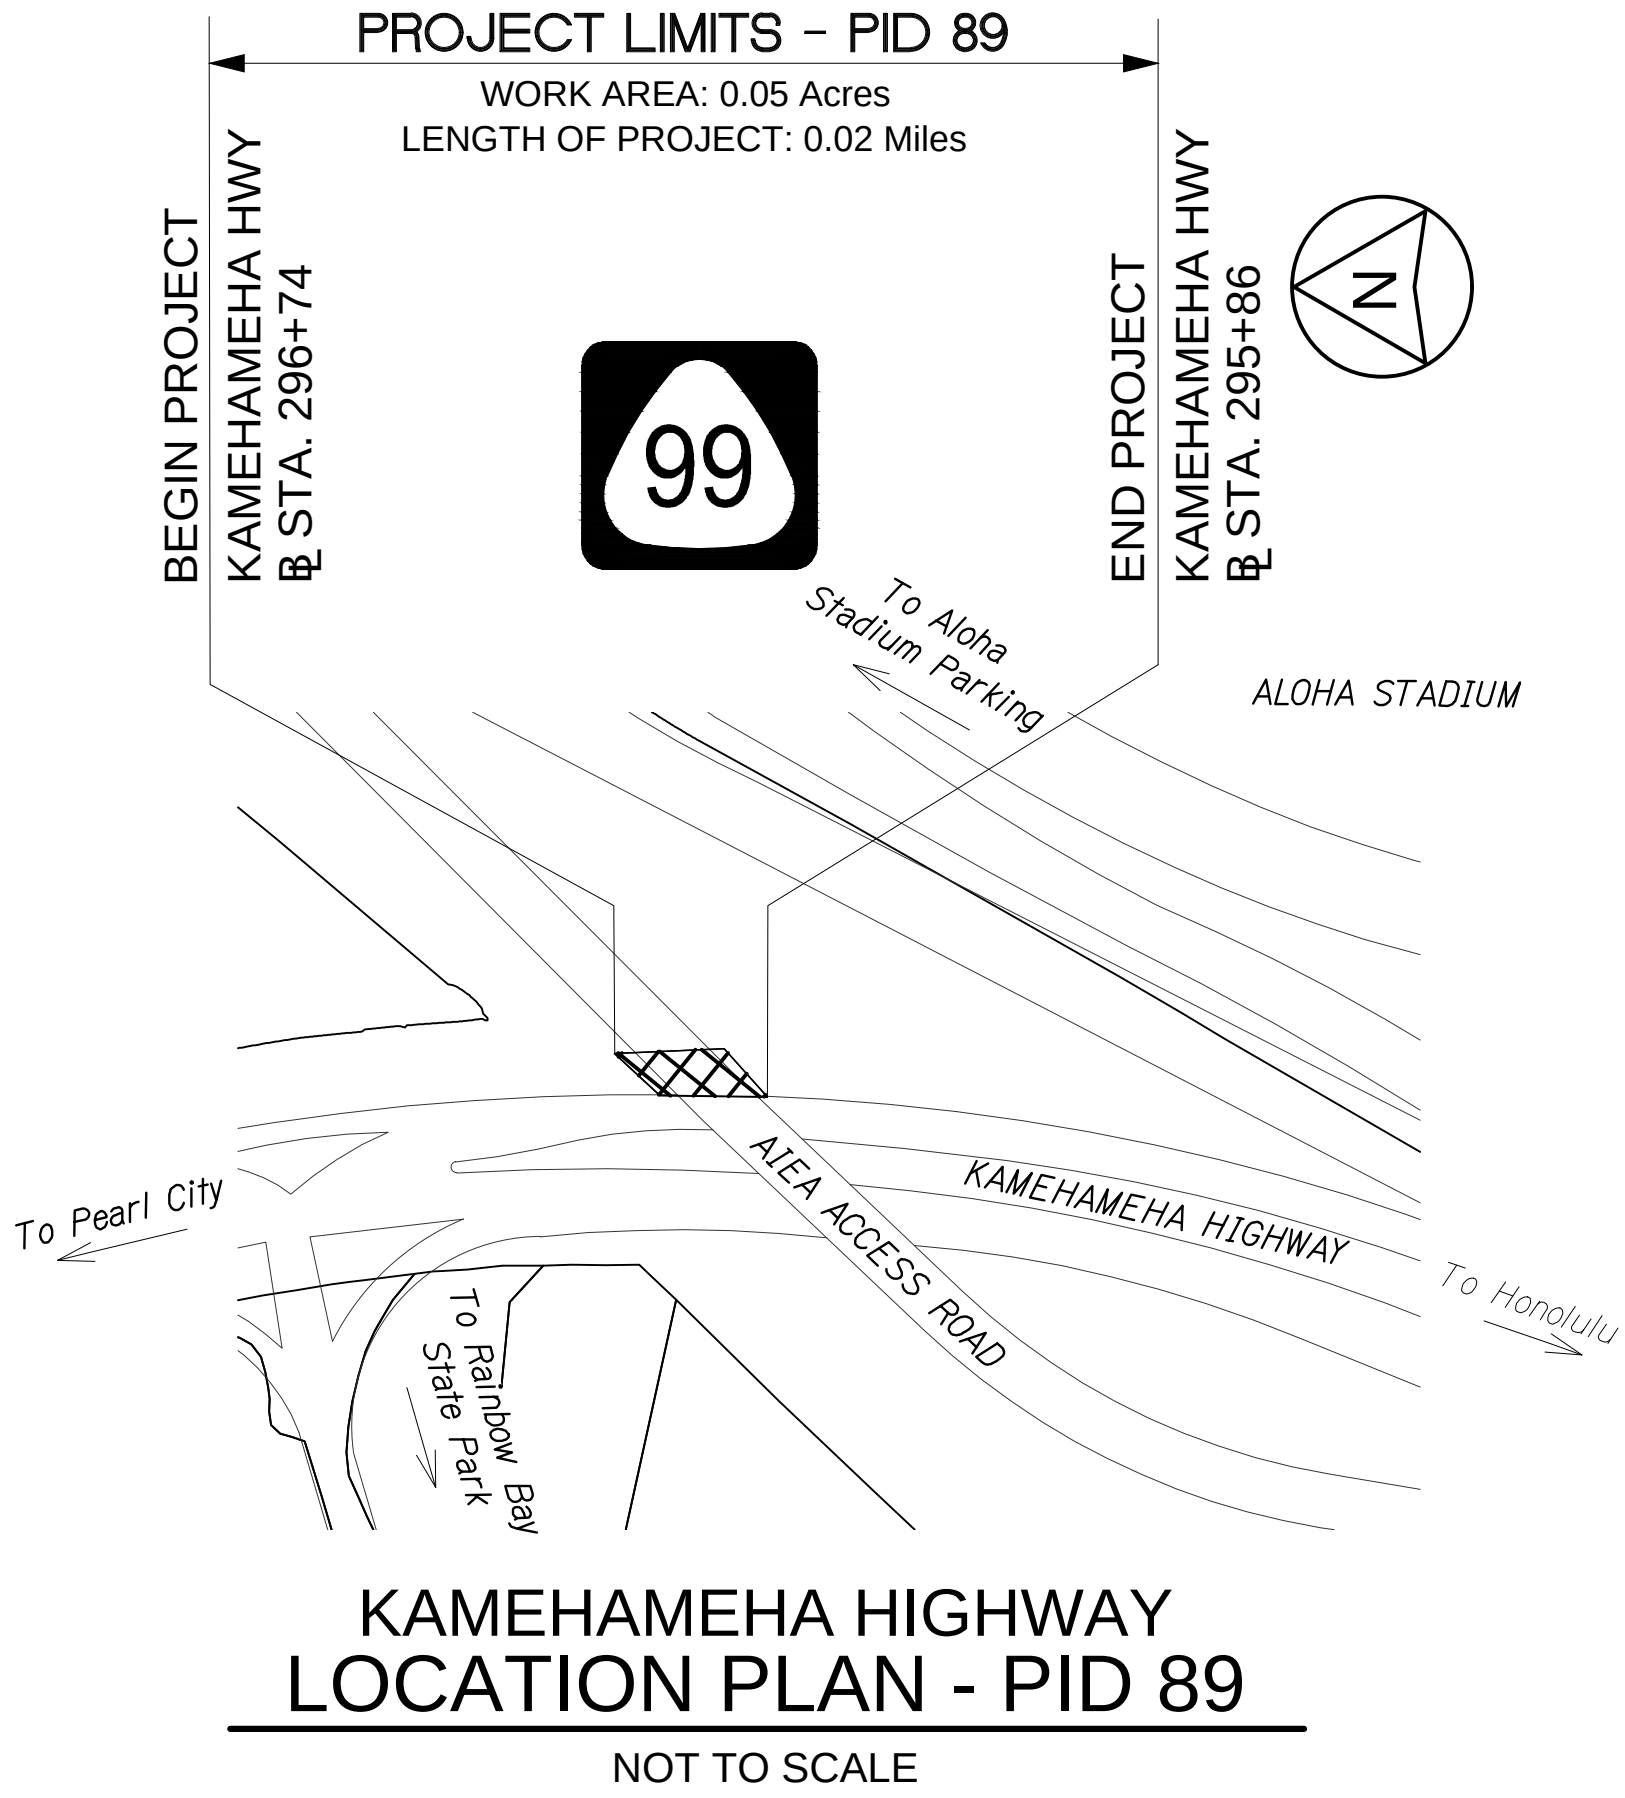

LEGEND FOR AS-BUILT POSTINGS	
	Squiggly line for as-built deletion
	Double line for as-built deletion
Roadway	Text for as-built posting

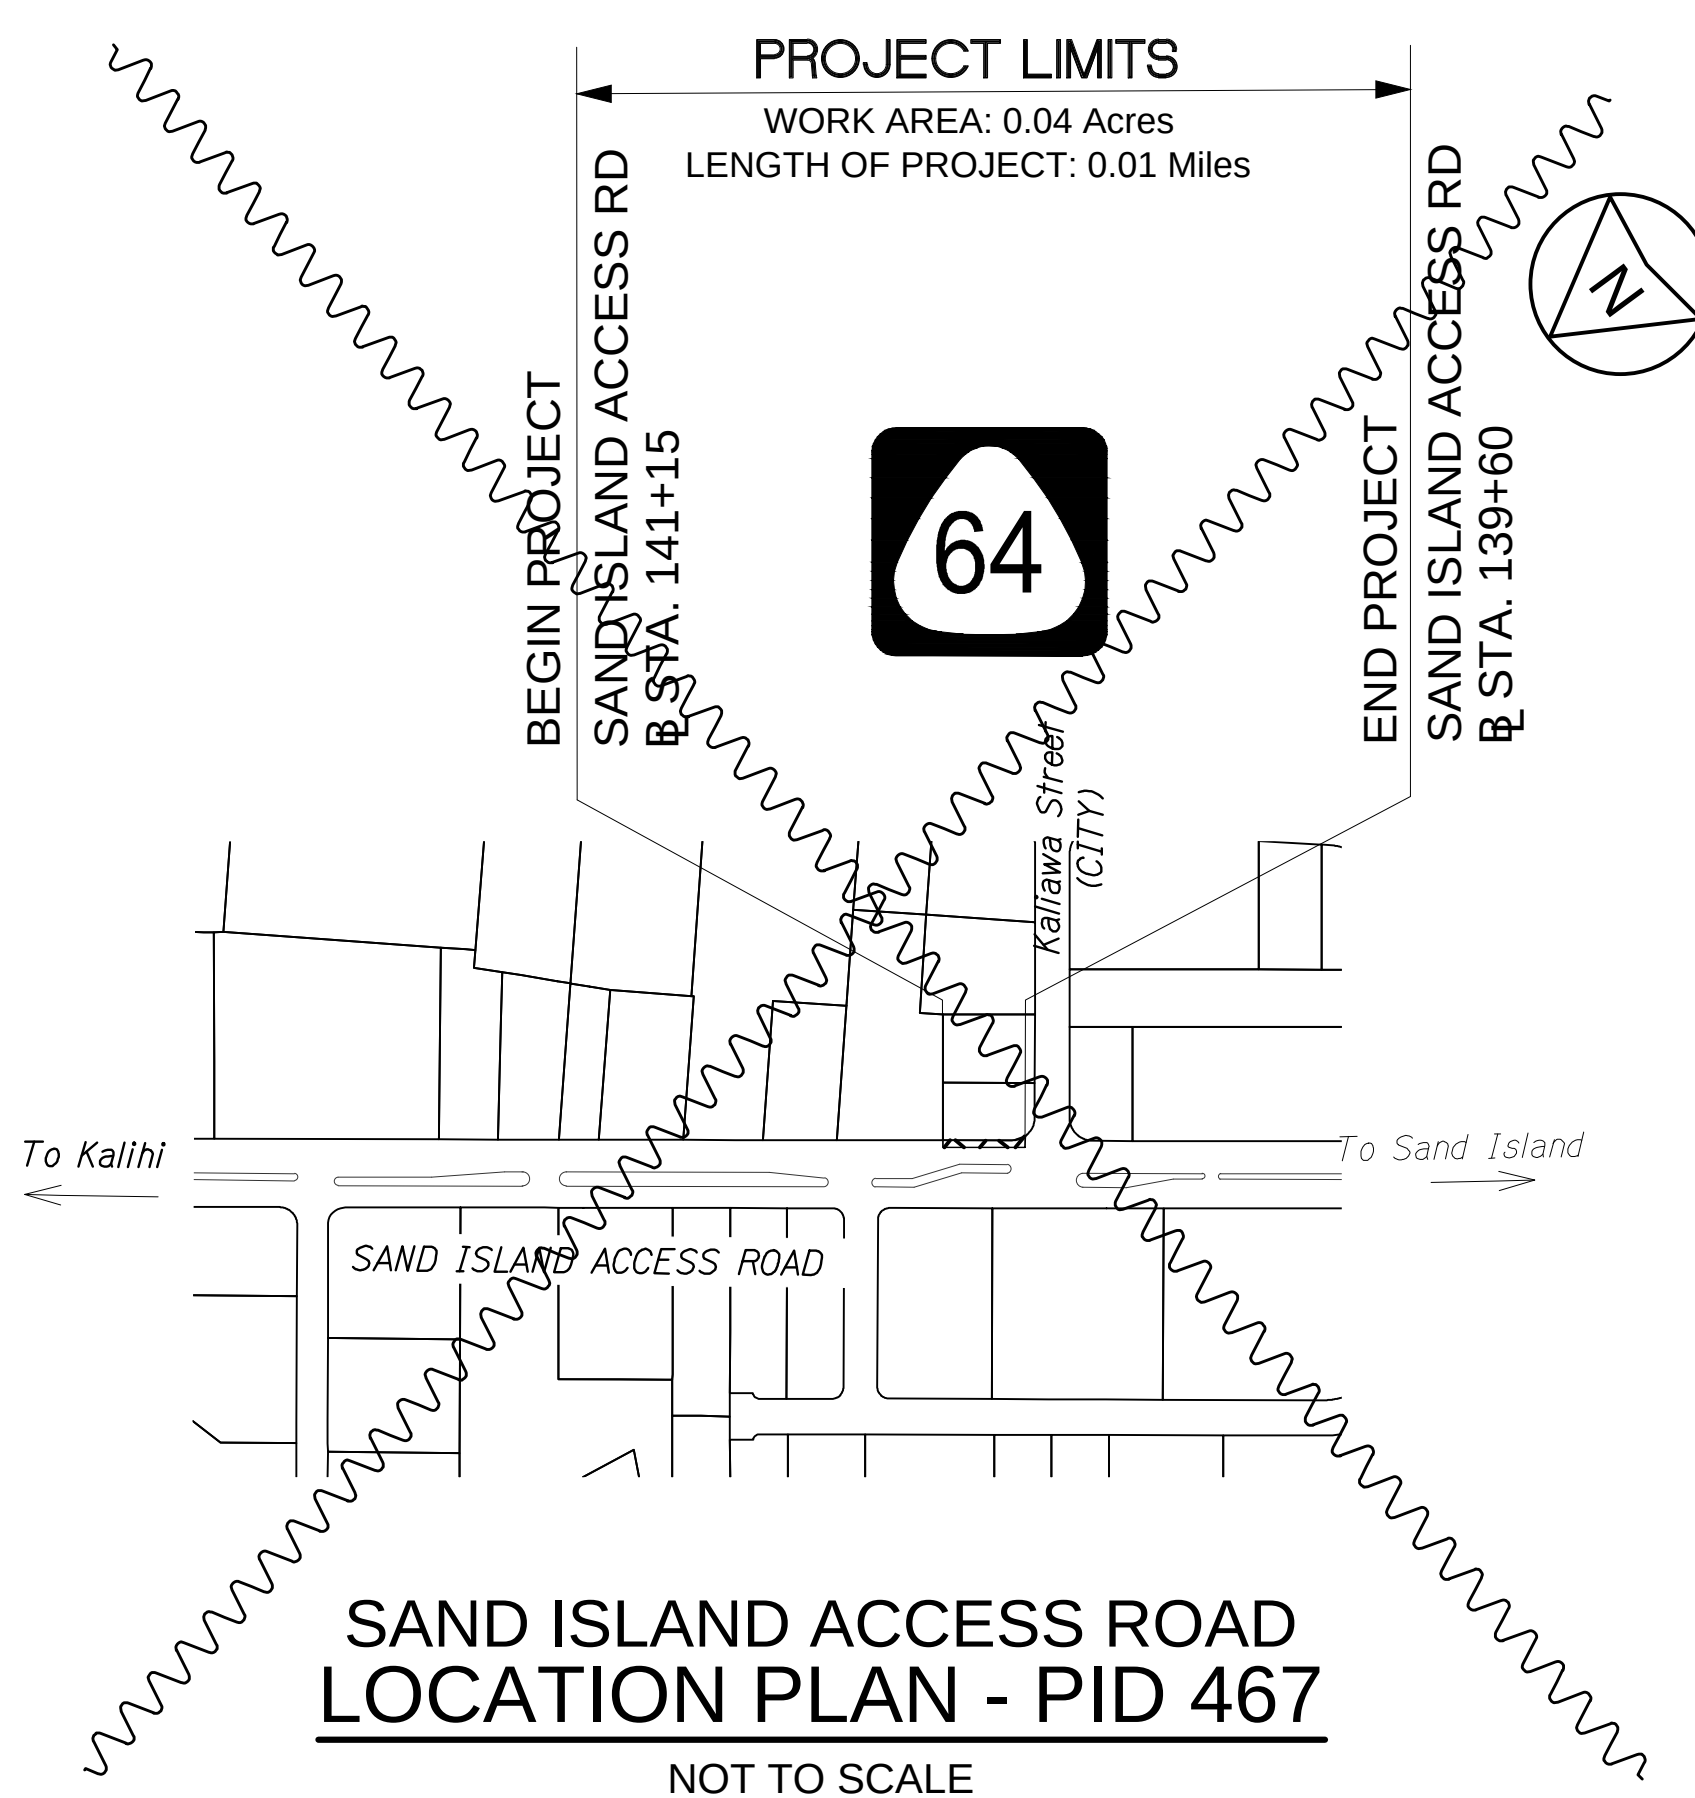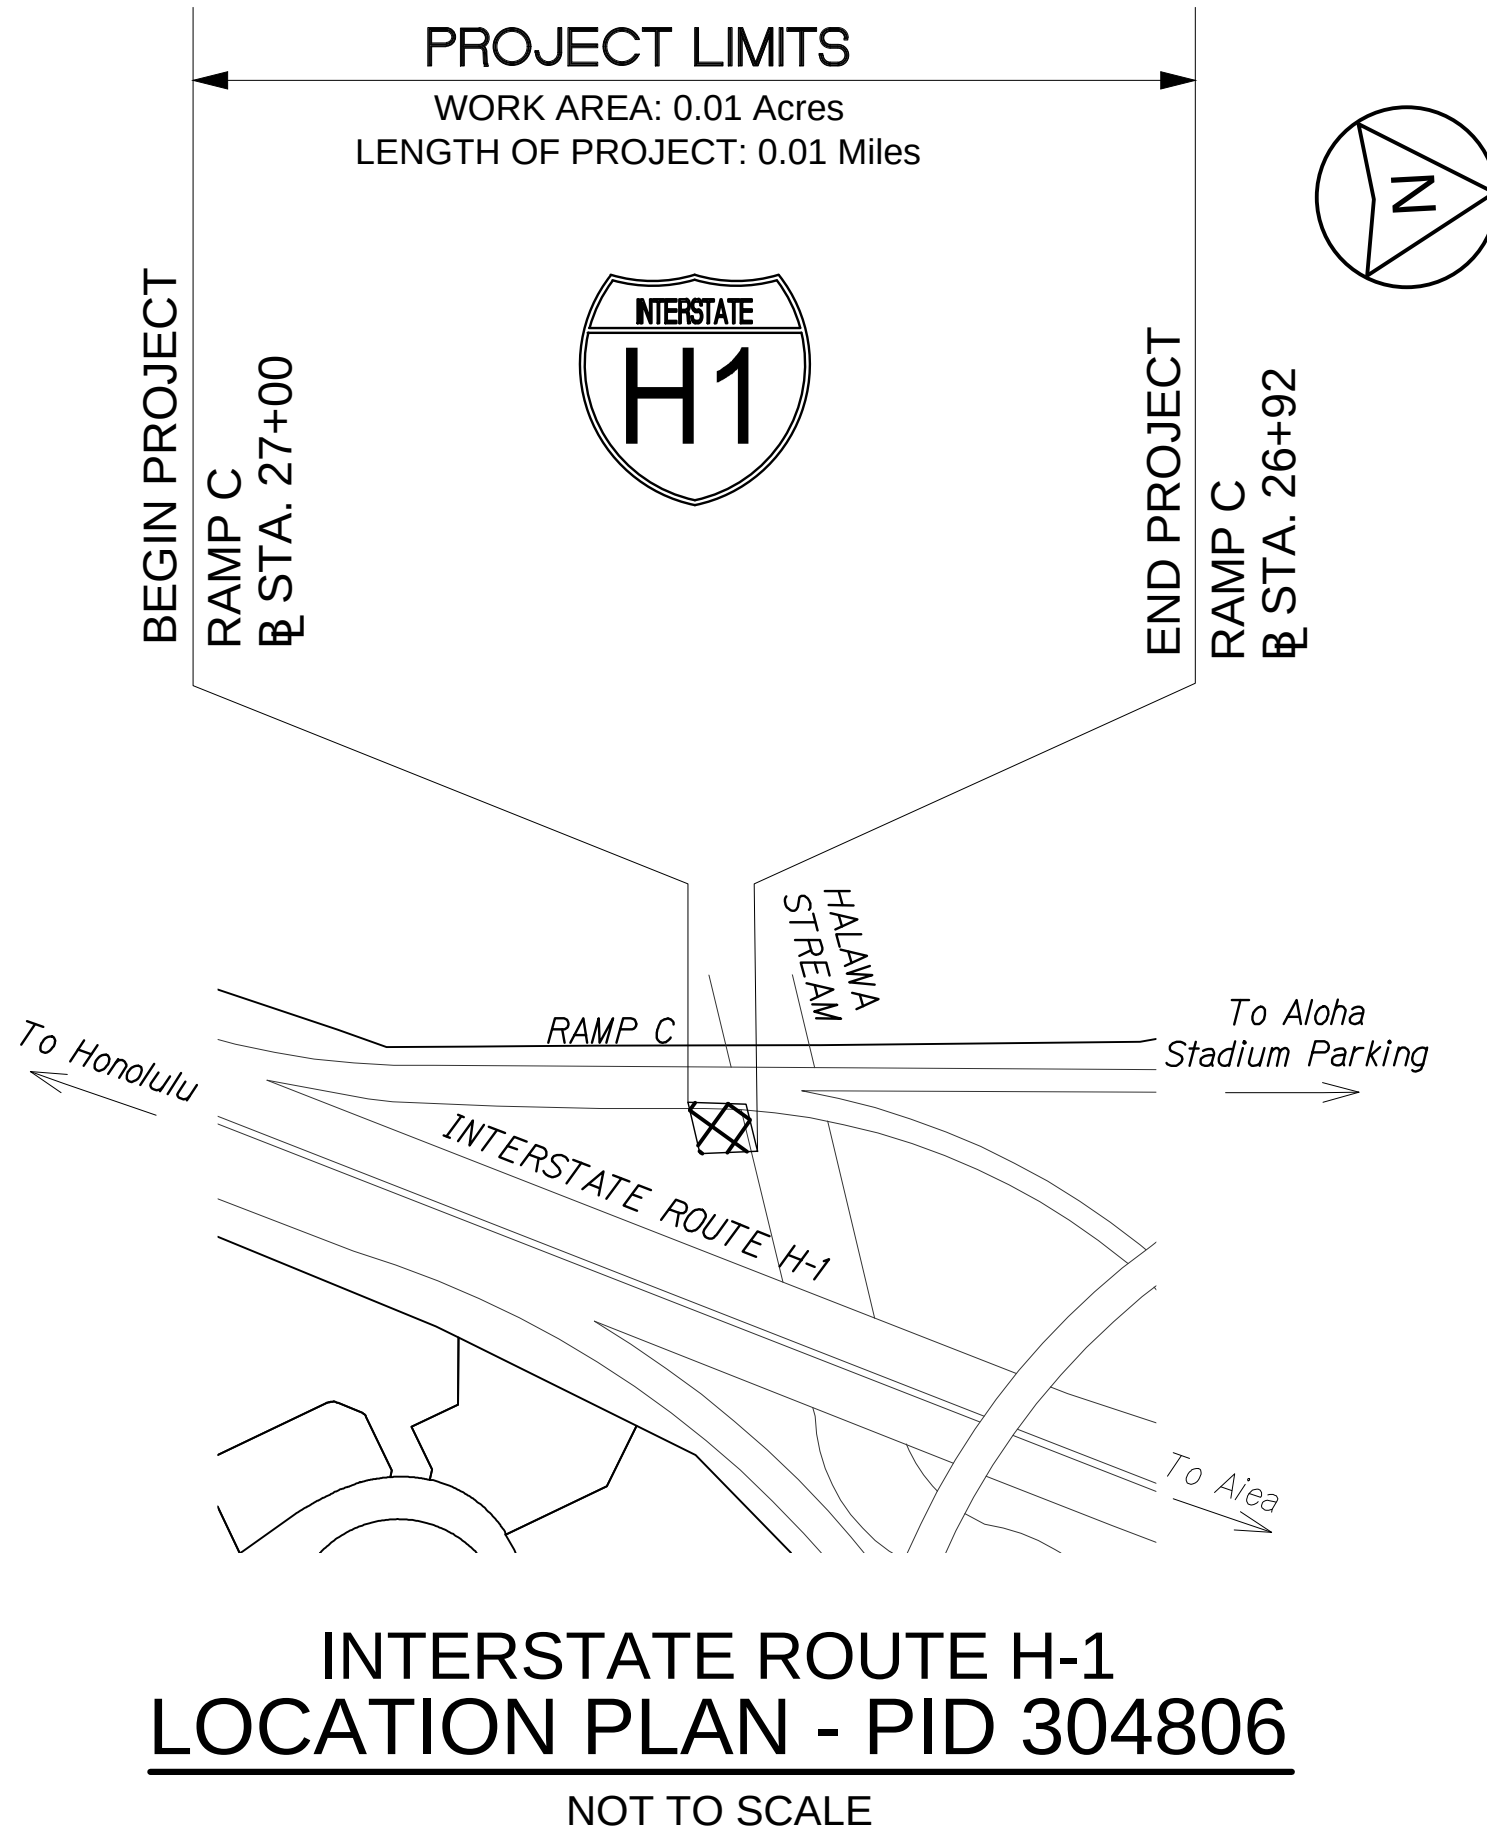

SURVEY PLOTTED BY: _____	DATE: _____
DRAWN BY: _____	DESIGNED BY: _____
NOTE BOOK: _____	QUANTITIES BY: _____
NO. _____	CHECKED BY: _____

10 LOCATION PLANING 4/12/2022 10:55 PM

4/30/18
This work was prepared by me or under my supervision.

STATE OF HAWAII
DEPARTMENT OF TRANSPORTATION
HIGHWAYS DIVISION

LOCATION PLAN

SLOPE IMPROVEMENTS FOR EROSION CONTROL
AT VARIOUS SITES ON OAHU, PHASE 8
Project No. HWY-O-01-18
Scale: None Date: April 2018