


INDEX TO DRAWINGS	
SHEET NO.	DESCRIPTION
1	TITLE SHEET
2	STANDARD PLANS SUMMARY
3-4	LOCATION PLANS
5	GENERAL NOTES, LEGEND AND ABBREVIATIONS
6	CONSTRUCTION NOTES
7-10	WATER POLLUTION AND EROSION CONTROL NOTES AND DETAILS
11-14	UTILITY NOTES
15-38	EROSION CONTROL PLANS AND DETAILS
39	BORING LOGS
40-51	LANDSCAPING PLANS, DETAILS, AND NOTES
52-55	TRAFFIC CONTROL NOTES AND LEGEND
56-65	TRAFFIC CONTROL PLANS

STATE OF HAWAII
DEPARTMENT OF TRANSPORTATION
HIGHWAYS DIVISION
HONOLULU, HAWAII

PLANS FOR
SLOPE IMPROVEMENTS FOR EROSION CONTROL
AT VARIOUS SITES ON OAHU, PHASE 8
PROJECT NO. HWY-O-01-18
DISTRICTS OF WAIALUA, WAHIAWA, EWA, AND HONOLULU
ISLAND OF OAHU

FED. ROAD DIST. NO.	STATE	PROJ. NO.	FISCAL YEAR	SHEET NO.	TOTAL SHEETS
HAWAII	HAW.	HWY-O-01-18	2018	1	65

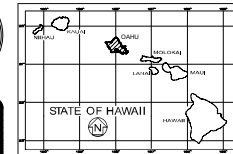

CHANGES MADE DURING CONSTRUCTION HAVE BEEN INCORPORATED ON THESE PLANS EXCEPT CHANGES IN THE ORIGINAL THEORETICAL QUANTITIES. FOR ACTUAL QUANTITIES, REFER TO PROJECT LEDGER AND/OR COMPUTATION BOOK.

Samuel P. Romo


May 10, 2022

RESIDENT ENGINEER

DATE

LEGEND FOR AS-BUILT POSTINGS

	Squiggly line for as-built deletion
	Double line for as-built deletion
	Text for as-built posting

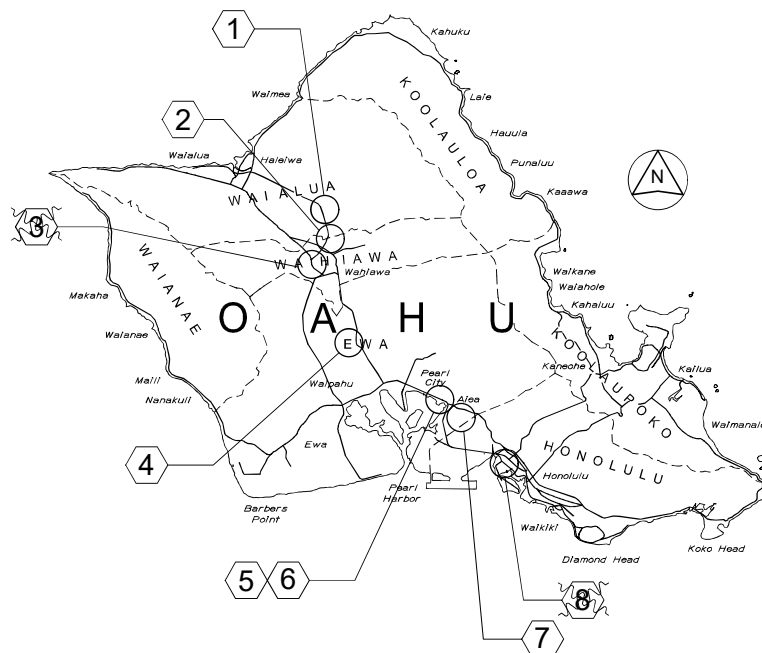

PROJECT SITES

- | | |
|--------------------------------------------------------------------------------------------------------------------------------|----------------------------------------------------------------------------------------------------------------------------------------|
| 1 LOCATION PLAN - PID 408
KAMEHAMEHA HIGHWAY 99
BEGIN MILEPOST: 4.99
END MILEPOST: 5.22 | 5 LOCATION PLAN - PID 89
KAMEHAMEHA HIGHWAY 99
BEGIN MILEPOST: 21.35
END MILEPOST: 21.36 |
| 2 LOCATION PLAN - PID 502
KAMEHAMEHA HIGHWAY 99
BEGIN MILEPOST: 5.83
END MILEPOST: 6.02 | 6 LOCATION PLAN - PID 92
KAMEHAMEHA HIGHWAY 99
BEGIN MILEPOST: 21.36
END MILEPOST: 21.37 |
| 3 LOCATION PLAN - PID 521
KAMEHAMEHA ROAD 99
BEGIN MILEPOST: 7.63
END MILEPOST: 7.79 | 7 LOCATION PLAN - PID 304806
INTERSTATE ROUTE H-1
BEGIN MILEPOST: 13.54
END MILEPOST: 13.54 |
| 4 LOCATION PLAN - PID 149
KAMEHAMEHA HIGHWAY 99
BEGIN MILEPOST: 14.12
END MILEPOST: 14.18 | 8 LOCATION PLAN - PID 467
SAND ISLAND ACCESS ROAD 64
BEGIN MILEPOST: 2.23
END MILEPOST: 2.22 |

UNIMCO CONSULTING GROUP
DESIGNED BY
HWY-O-01-18
MANAGED BY
483-2569
PHONE
APRIL 2018
DATE

DEPARTMENT OF TRANSPORTATION STATE OF HAWAII APPROVED: <i>Samuel P. Romo</i> APR 02 2018 MAR 29 2018 DIR. OF TRANSPORTATION DATE

"AS-BUILT"