


FED. ROAD DIST. NO.	STATE	PROJ. NO.	FISCAL YEAR	SHEET NO.	TOTAL SHEETS
HAWAII	HAW.	HWY-0-06-14	2016	22	62


Repair Schedule	
No.	Description
1	Spall in Invert 1'-6"x6"x3" Deep Throughout
2	Existing CRM to be Repaired
3	36"x6"x6" Deep Spall in Invert Sta 2+64
4	24"x6"x6" Deep Spall in Invert Sta 2+68
5	30"x5"x3" Deep Spall in Invert Sta 2+46
6	24"x6"x5" Deep Spall in Invert Sta 2+05
7	36"x3"x7" Deep Spall in Invert Sta 1+97
8	24"x12"x6" Deep Spall in Invert Sta 1+93
9	48"x35"x8" Deep Missing Invert Sta 1+89
10	48"x12"x6" Deep Missing Invert Sta 1+44

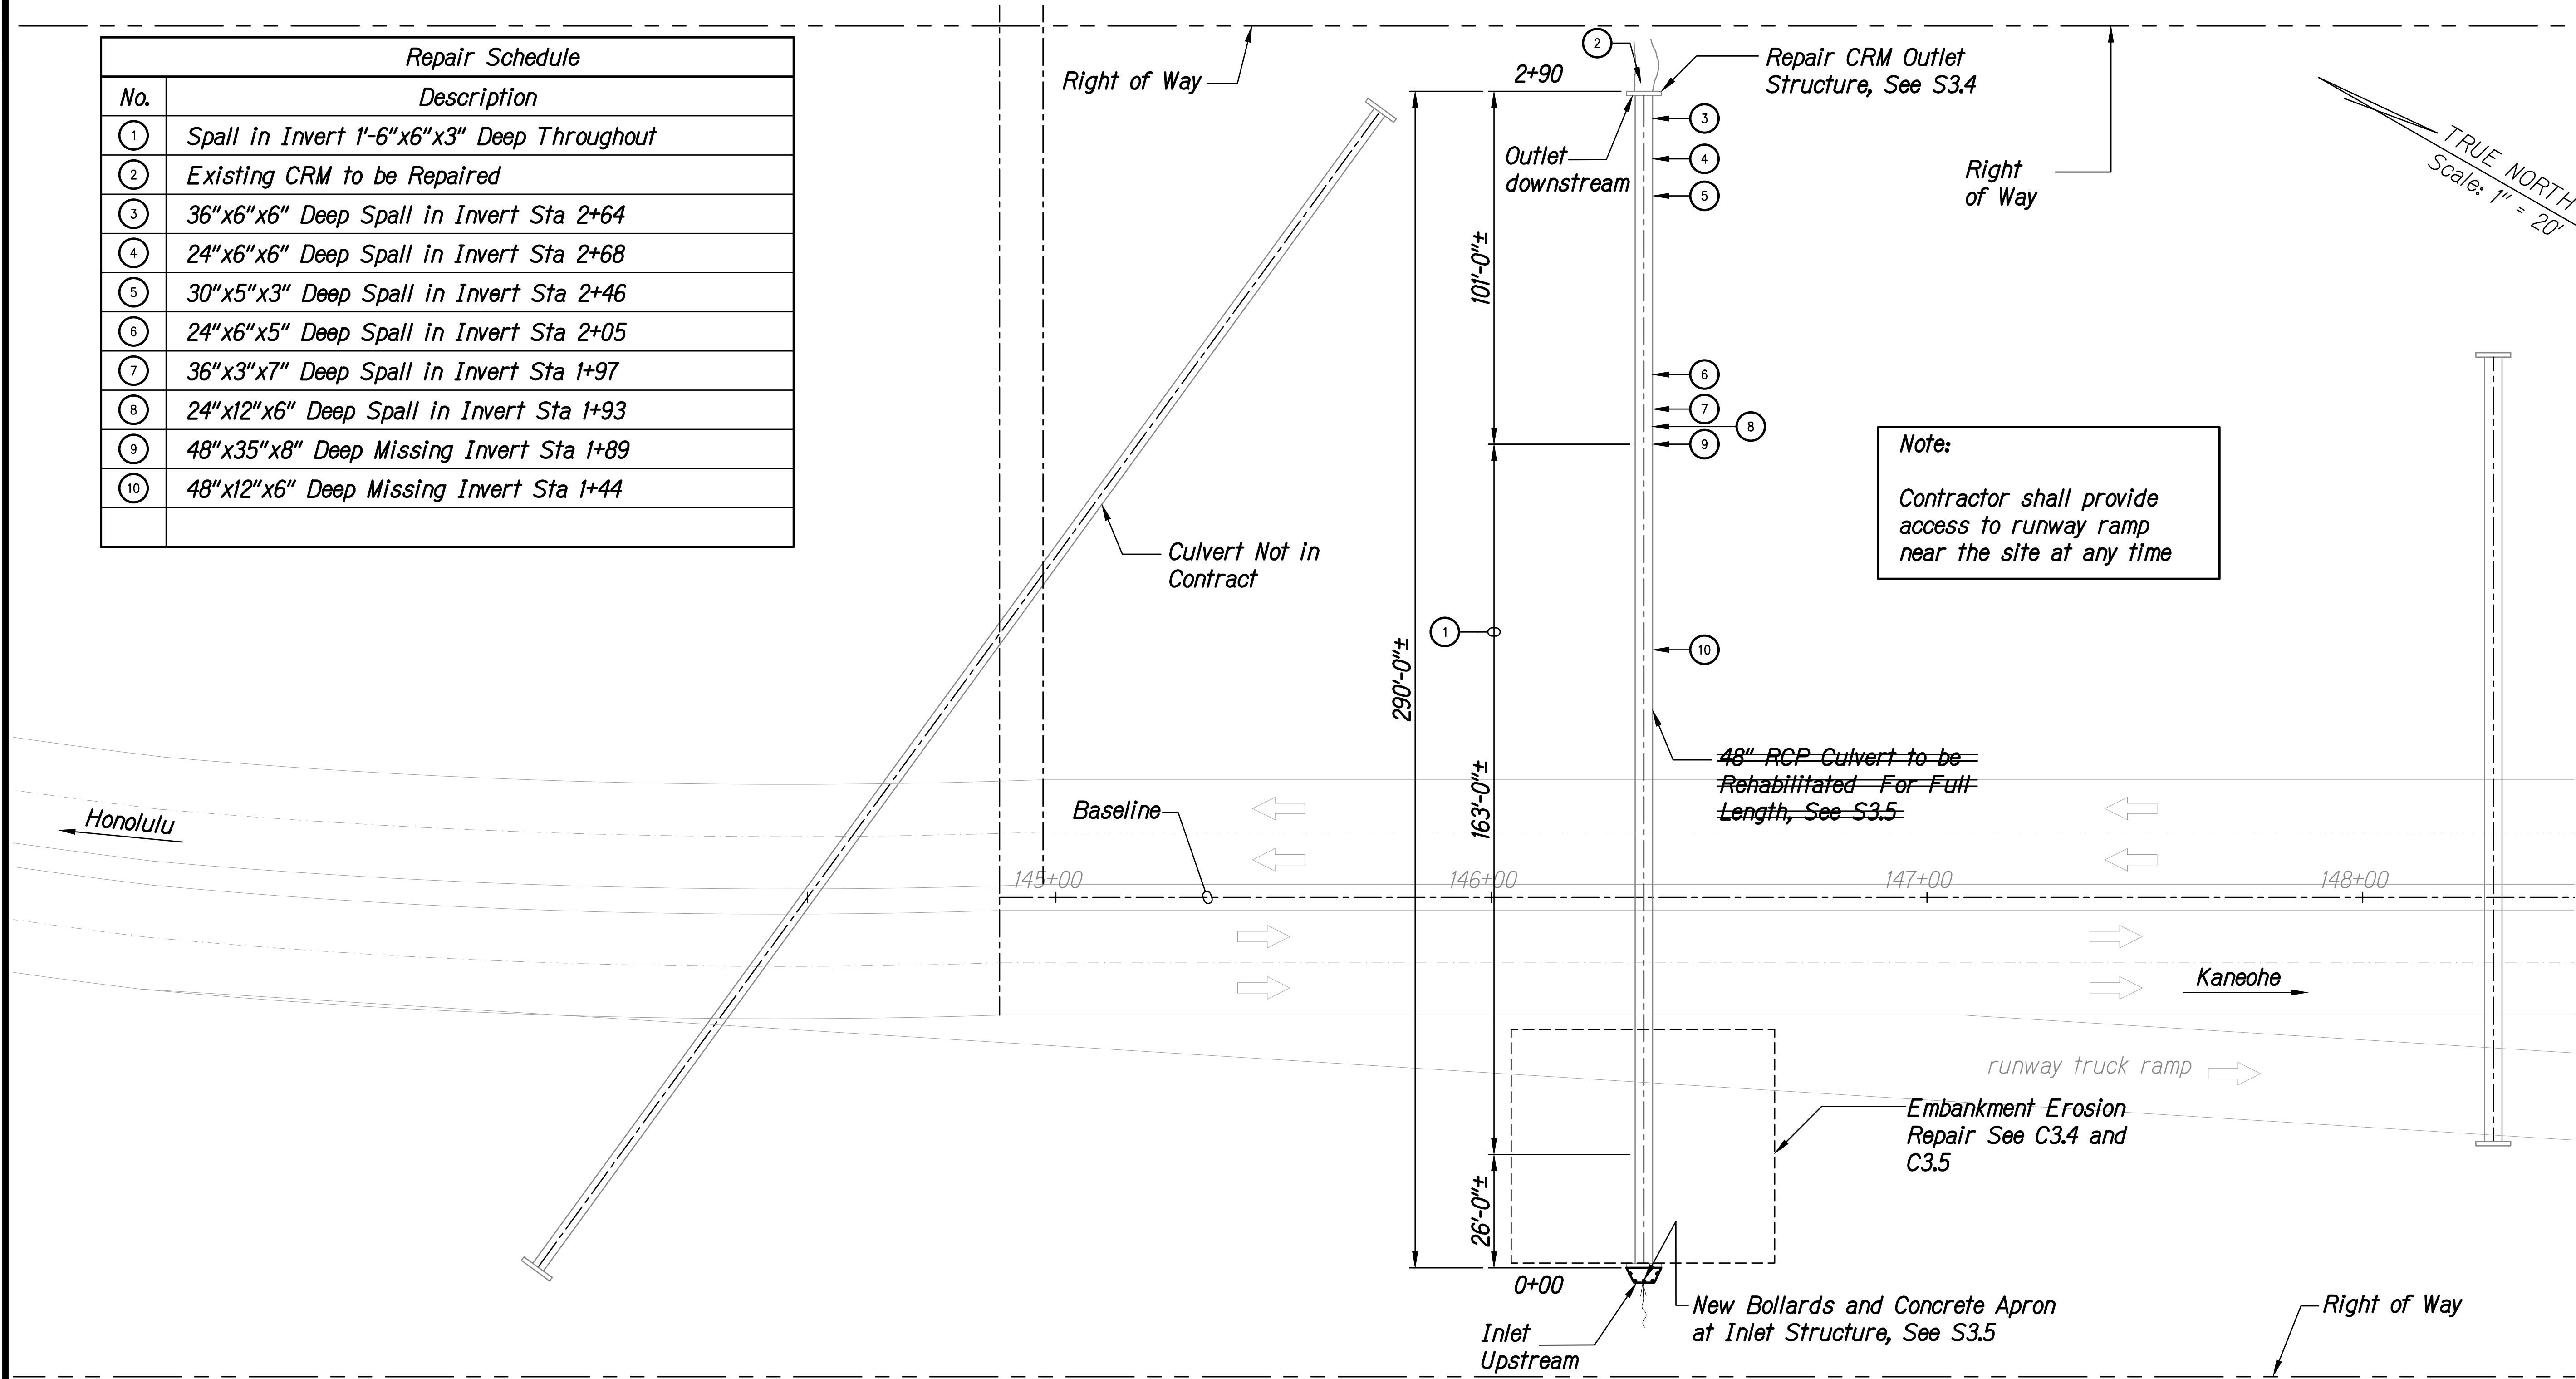

EXISTING CULVERT PLAN, MILE POST 6.70 (PALI HIGHWAY)  
Scale: 1" = 20'-0"

1  
S3.1 | S3.1

LEGEND FOR AS-BUILT POSTINGS	
	Squiggly line for as-built deletion
	Double line for as-built deletion
Roadway	Text for as-built posting

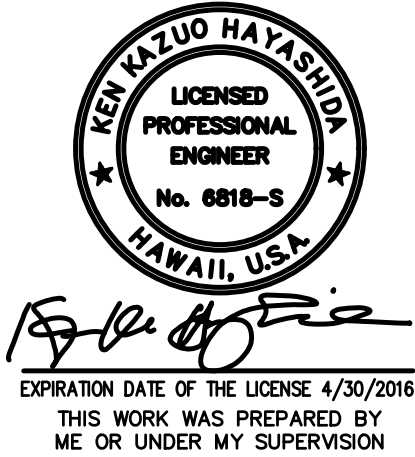

STATE OF HAWAII  
DEPARTMENT OF TRANSPORTATION  
HIGHWAYS DIVISION


**CULVERT PLAN, MILEPOST 6.70 (PALI HIGHWAY)**  
**CULVERT REMEDIATION AT VARIOUS LOCATIONS ON OAHU, PHASE 1**  
Project No. HWY-0-06-14

Scale: As Shown      Date: March 2016

SHEET No. **S3.1** OF 62 SHEETS

"AS-BUILT"


FED. ROAD DIST. NO.	STATE	PROJ. NO.	FISCAL YEAR	SHEET NO.	TOTAL SHEETS
HAWAII	HAW.	HWY-0-06-14	2016	23	62

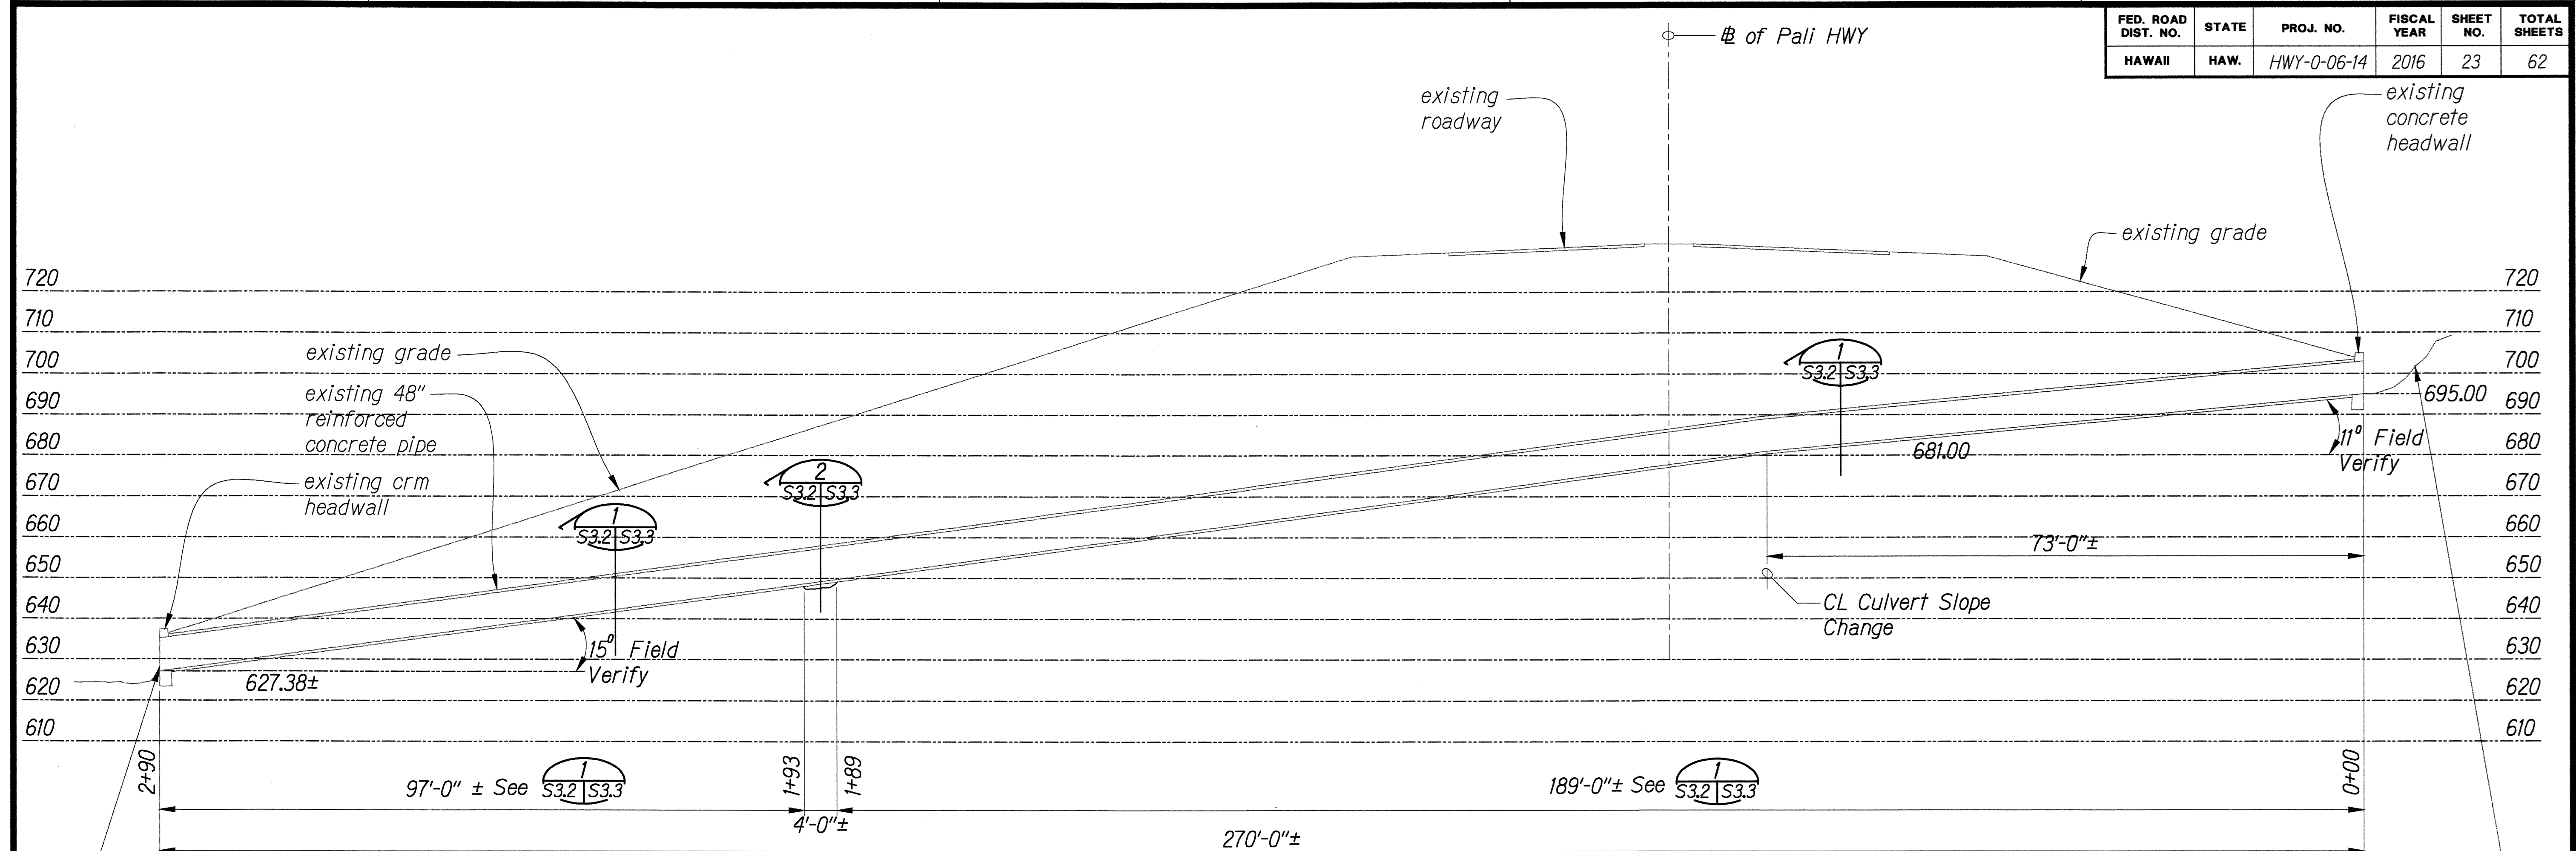

EXISTING CULVERT LONGITUDINAL SECTION, MILEPOST 6.70 (PALI HIGHWAY)  
Scale: 1" = 10'-0"

Damaged CRM Wall to be Repaired See Sht S3.4


Rock Buildup at Inlet to be Removed, See Sht S3.4

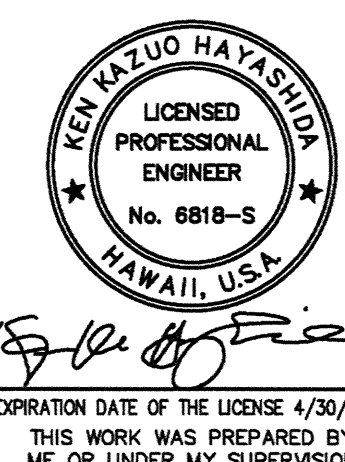


STATE OF HAWAII  
DEPARTMENT OF TRANSPORTATION  
HIGHWAYS DIVISION

**CULVERT LONG SECTION**  
**M.P. 6.70 (PALI HWY)**  
CULVERT REMEDIATION AT VARIOUS  
LOCATIONS ON OAHU, PHASE 1  
Project No. HWY-0-06-14  
Scale: As Shown      Date: March 2016  
SHEET No. S3.2 OF 62 SHEETS

FED. ROAD DIST. NO.	STATE	PROJ. NO.	FISCAL YEAR	SHEET NO.	TOTAL SHEETS
HAWAII	HAW.	HWY-0-06-14	2016	24	62

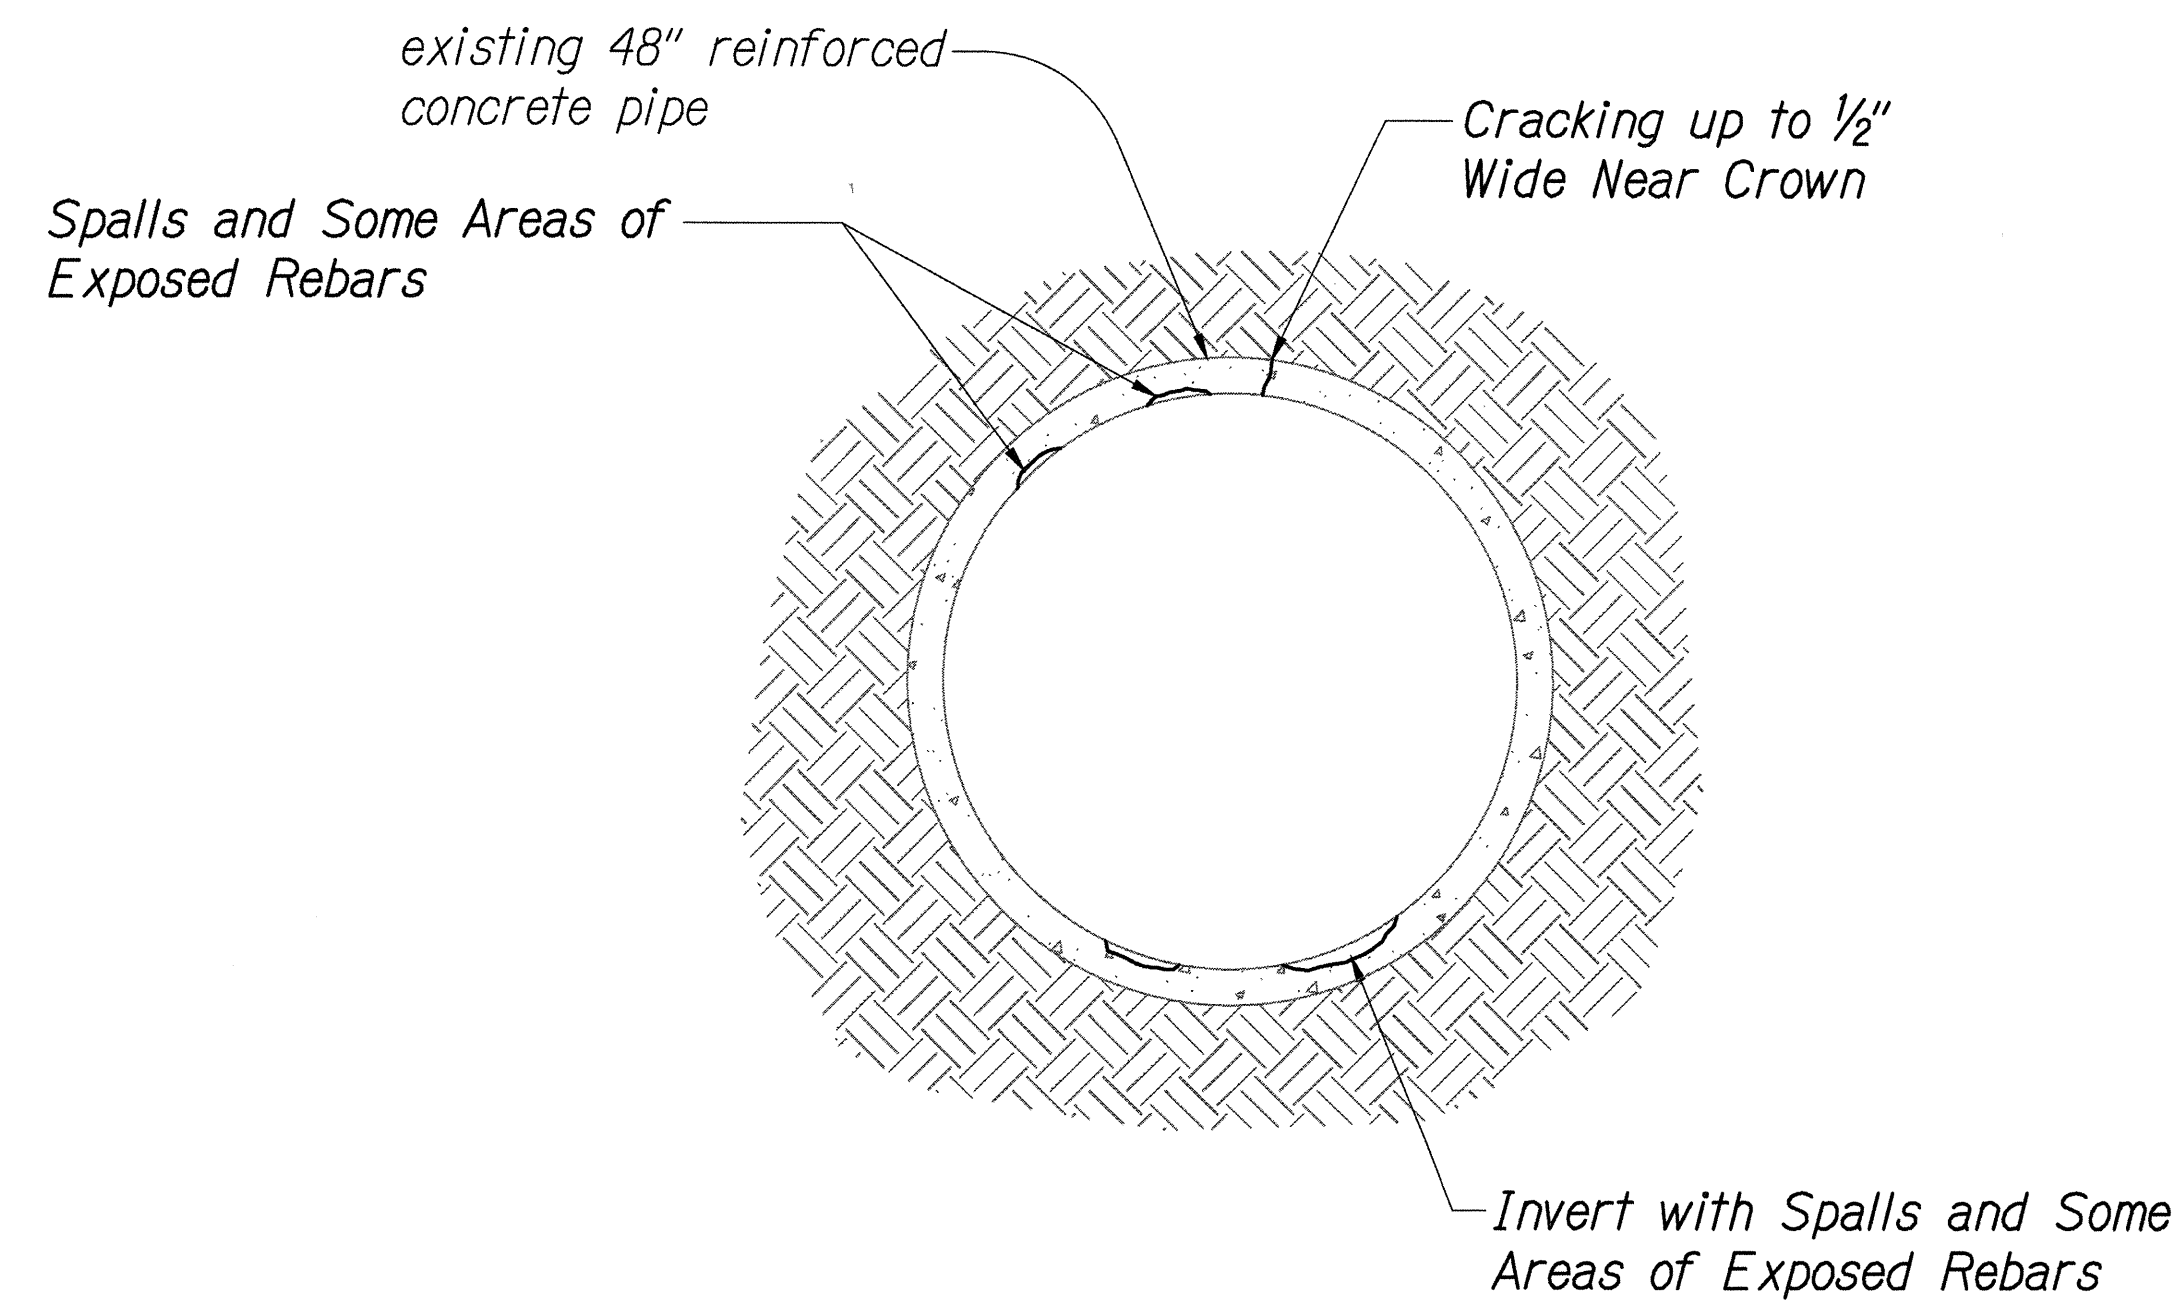


EXISTING CULVERT SECTION AT  
SHOWING TYPICAL DETERIORATION 1  
Scale 1"= 1'-4" S3.2 | S3.3

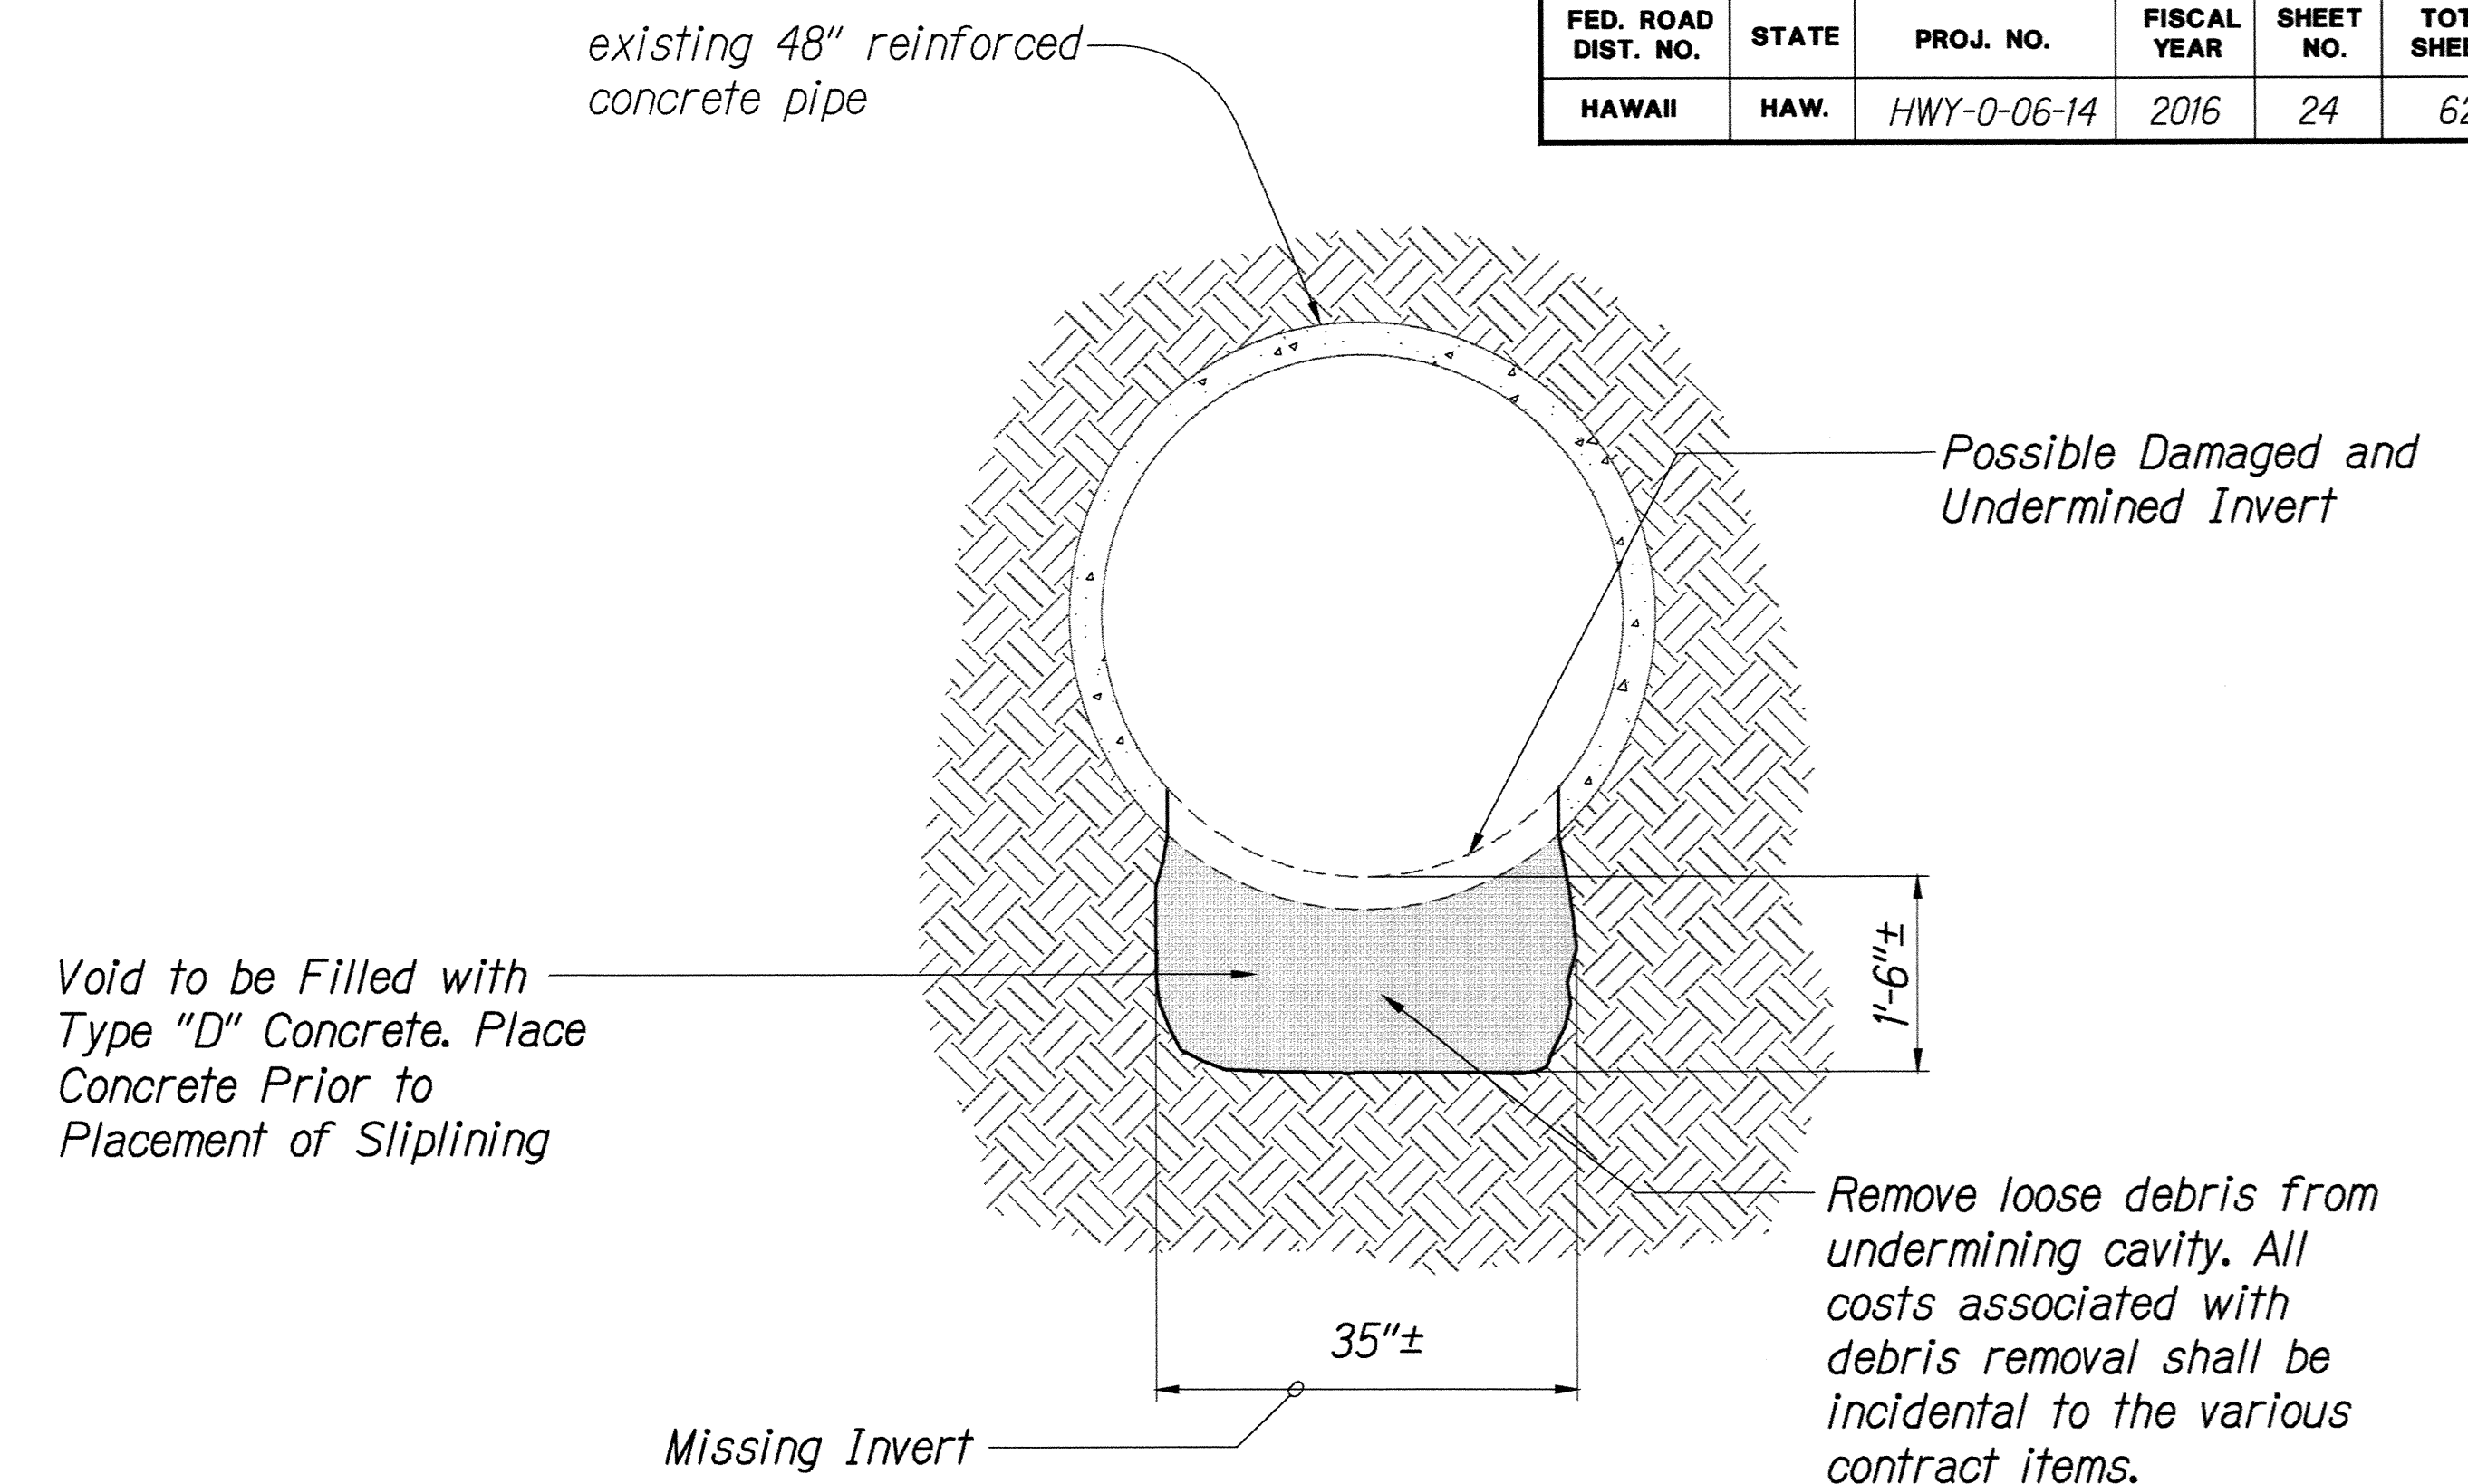

EXISTING CULVERT SECTION AT  
STA 1+89 TO STA 1+93 2  
Scale 1"= 1'-4" S3.2 | S3.3

Note:  
No Work Required For All Spalled  
Areas and Cracks.

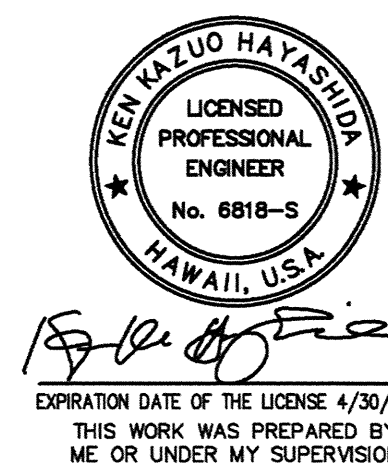

STATE OF HAWAII  
DEPARTMENT OF TRANSPORTATION  
HIGHWAYS DIVISION

**EX CULVERT M.P. 6.70**  
**(PALI HWY) SECTIONS**

CULVERT REMEDIATION AT VARIOUS  
LOCATIONS ON OAHU, PHASE 1




Project No. HWY-0-06-14

Scale: As Shown Date: March 2016

SHEET No. S3.3 OF 62 SHEETS






FED. ROAD DIST. NO.	STATE	PROJ. NO.	FISCAL YEAR	SHEET NO.	TOTAL SHEETS
HAWAII	HAW.	HWY-0-06-14	2016	25	62

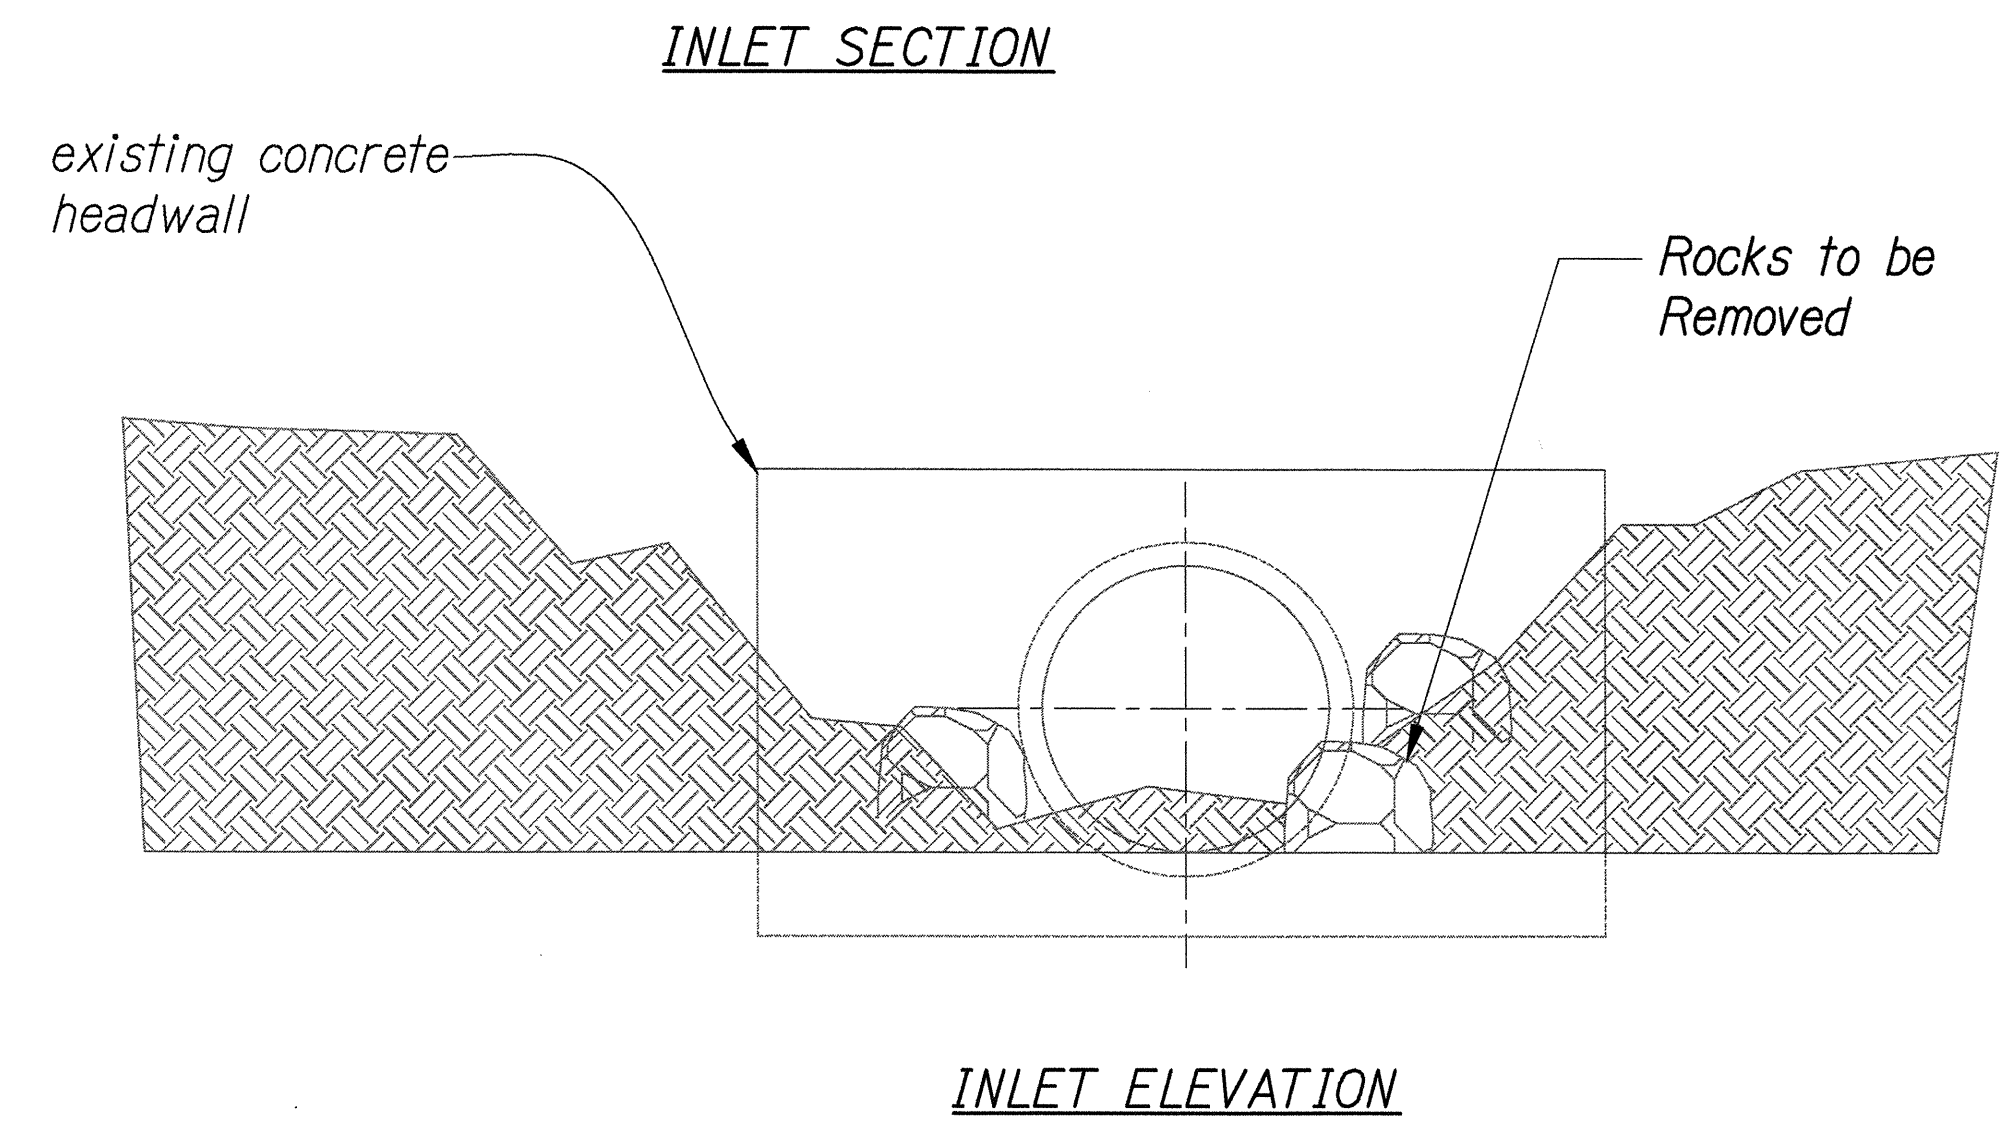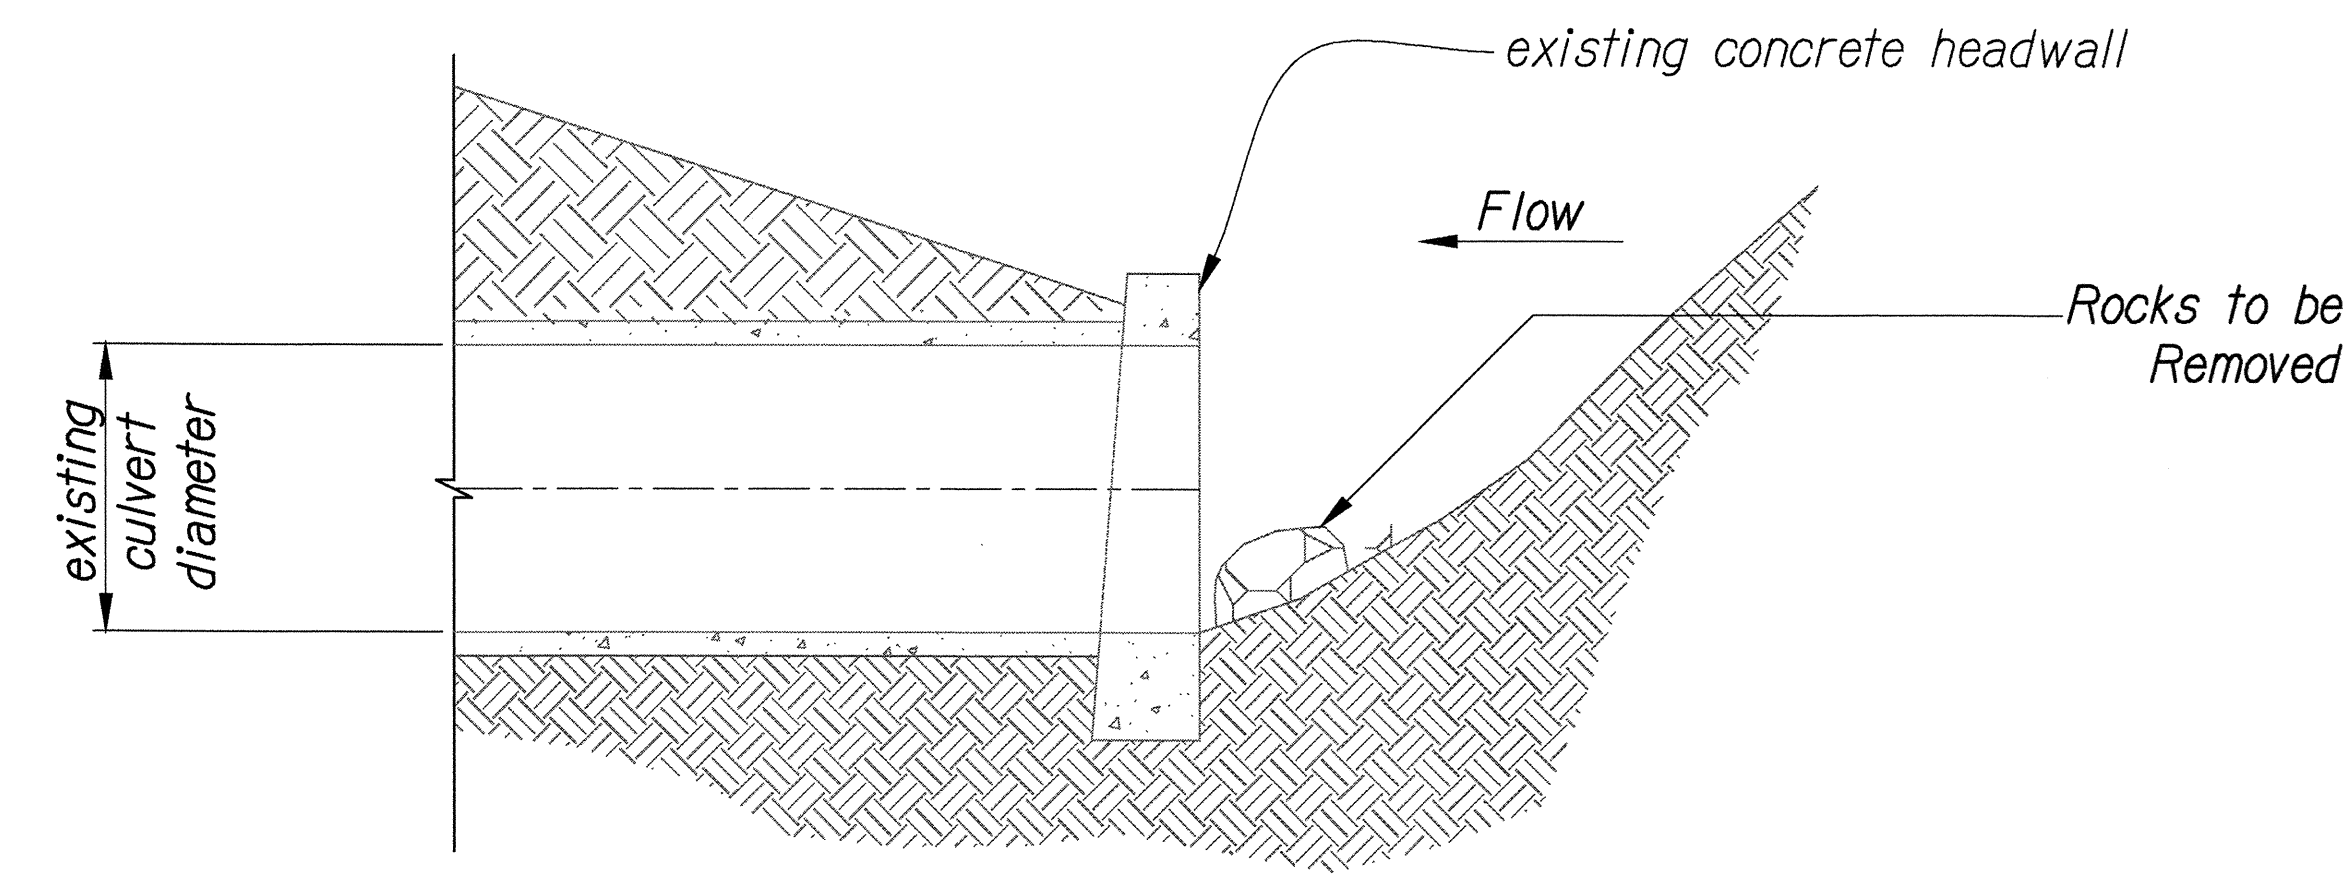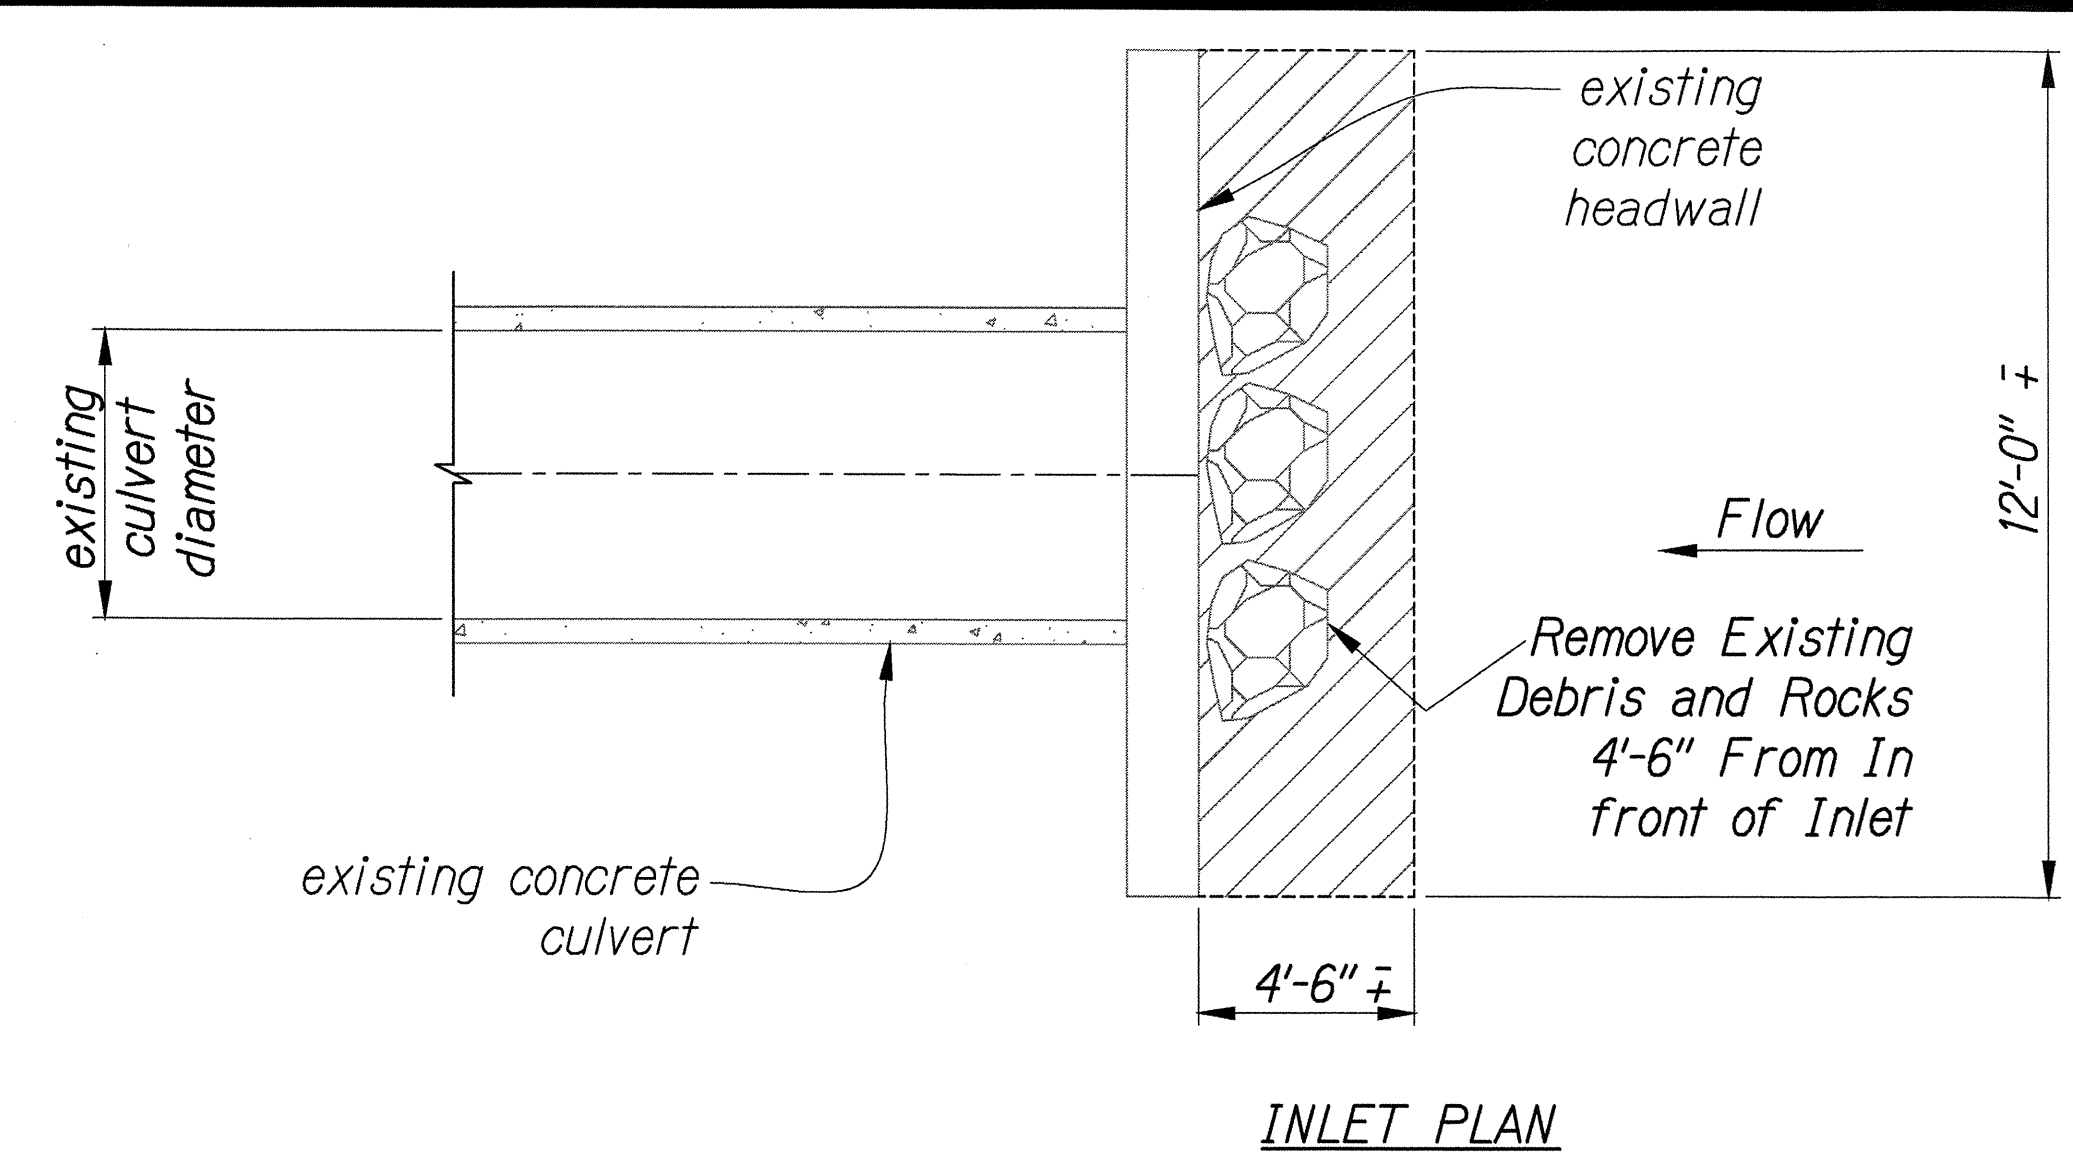

INLET STRUCTURE  
EXISTING CONDITION

Scale: 1" = 4'-0"


1  
S3.4 S3.4

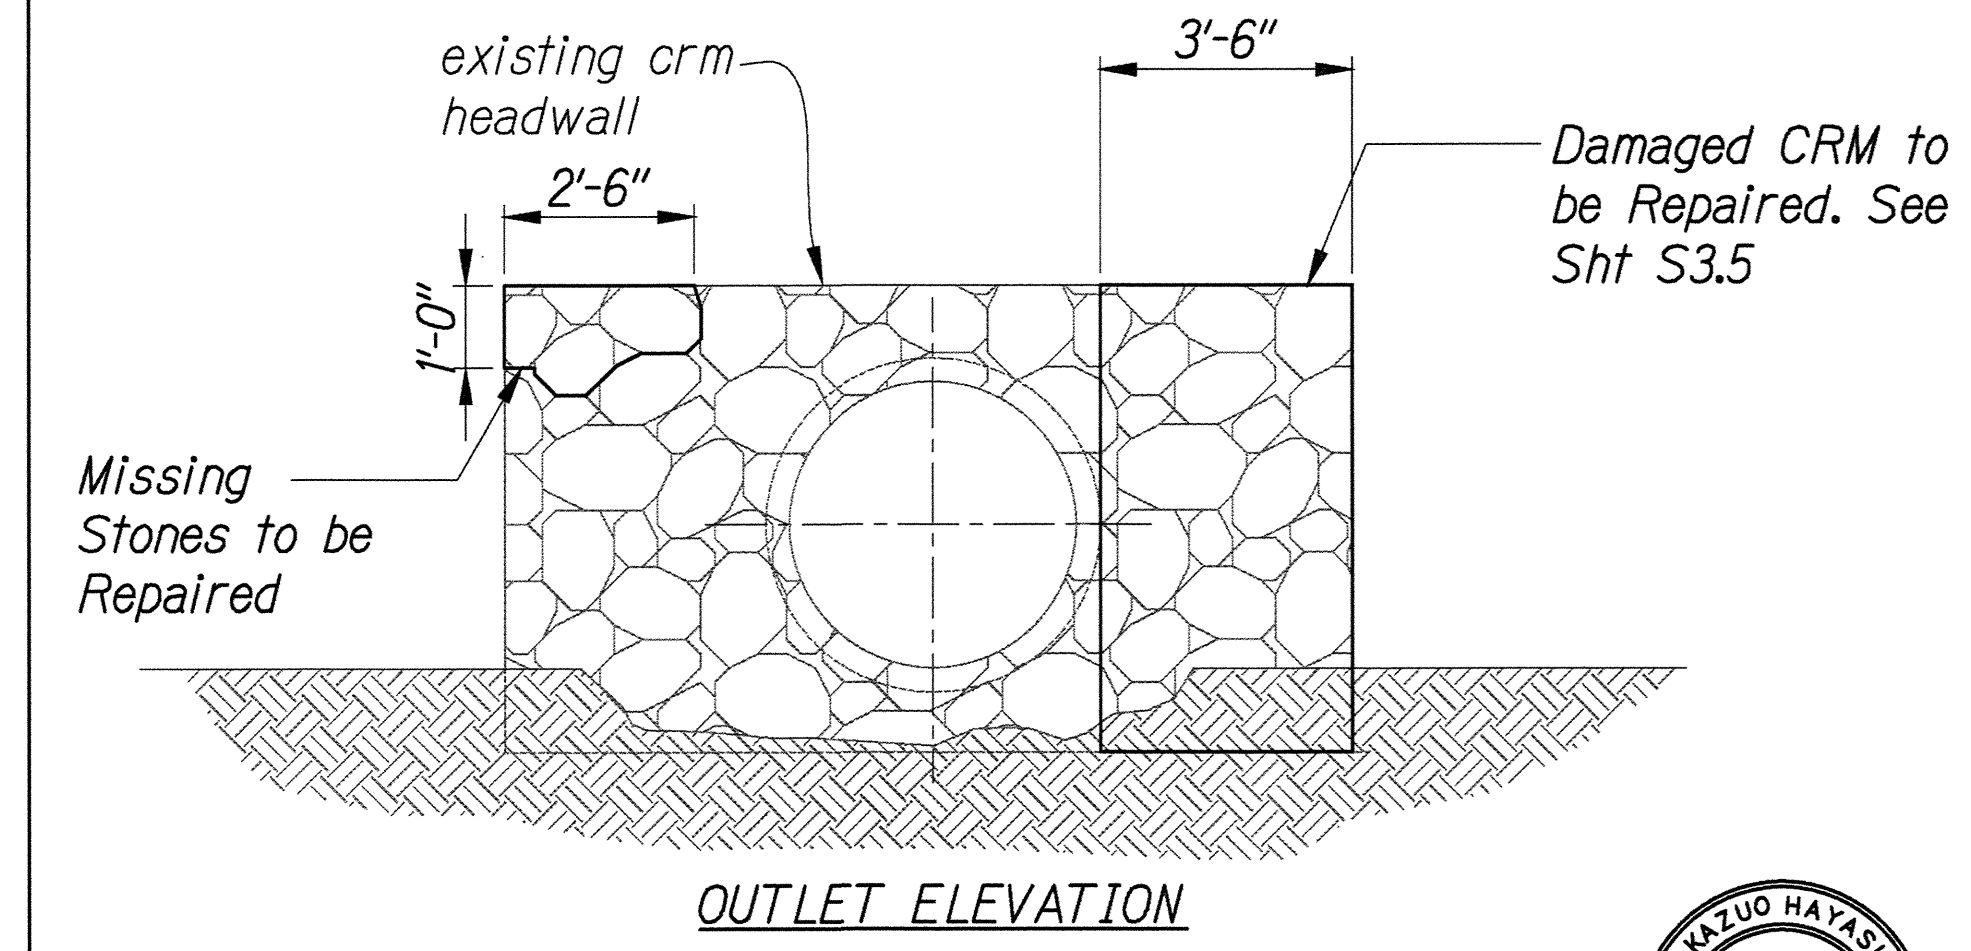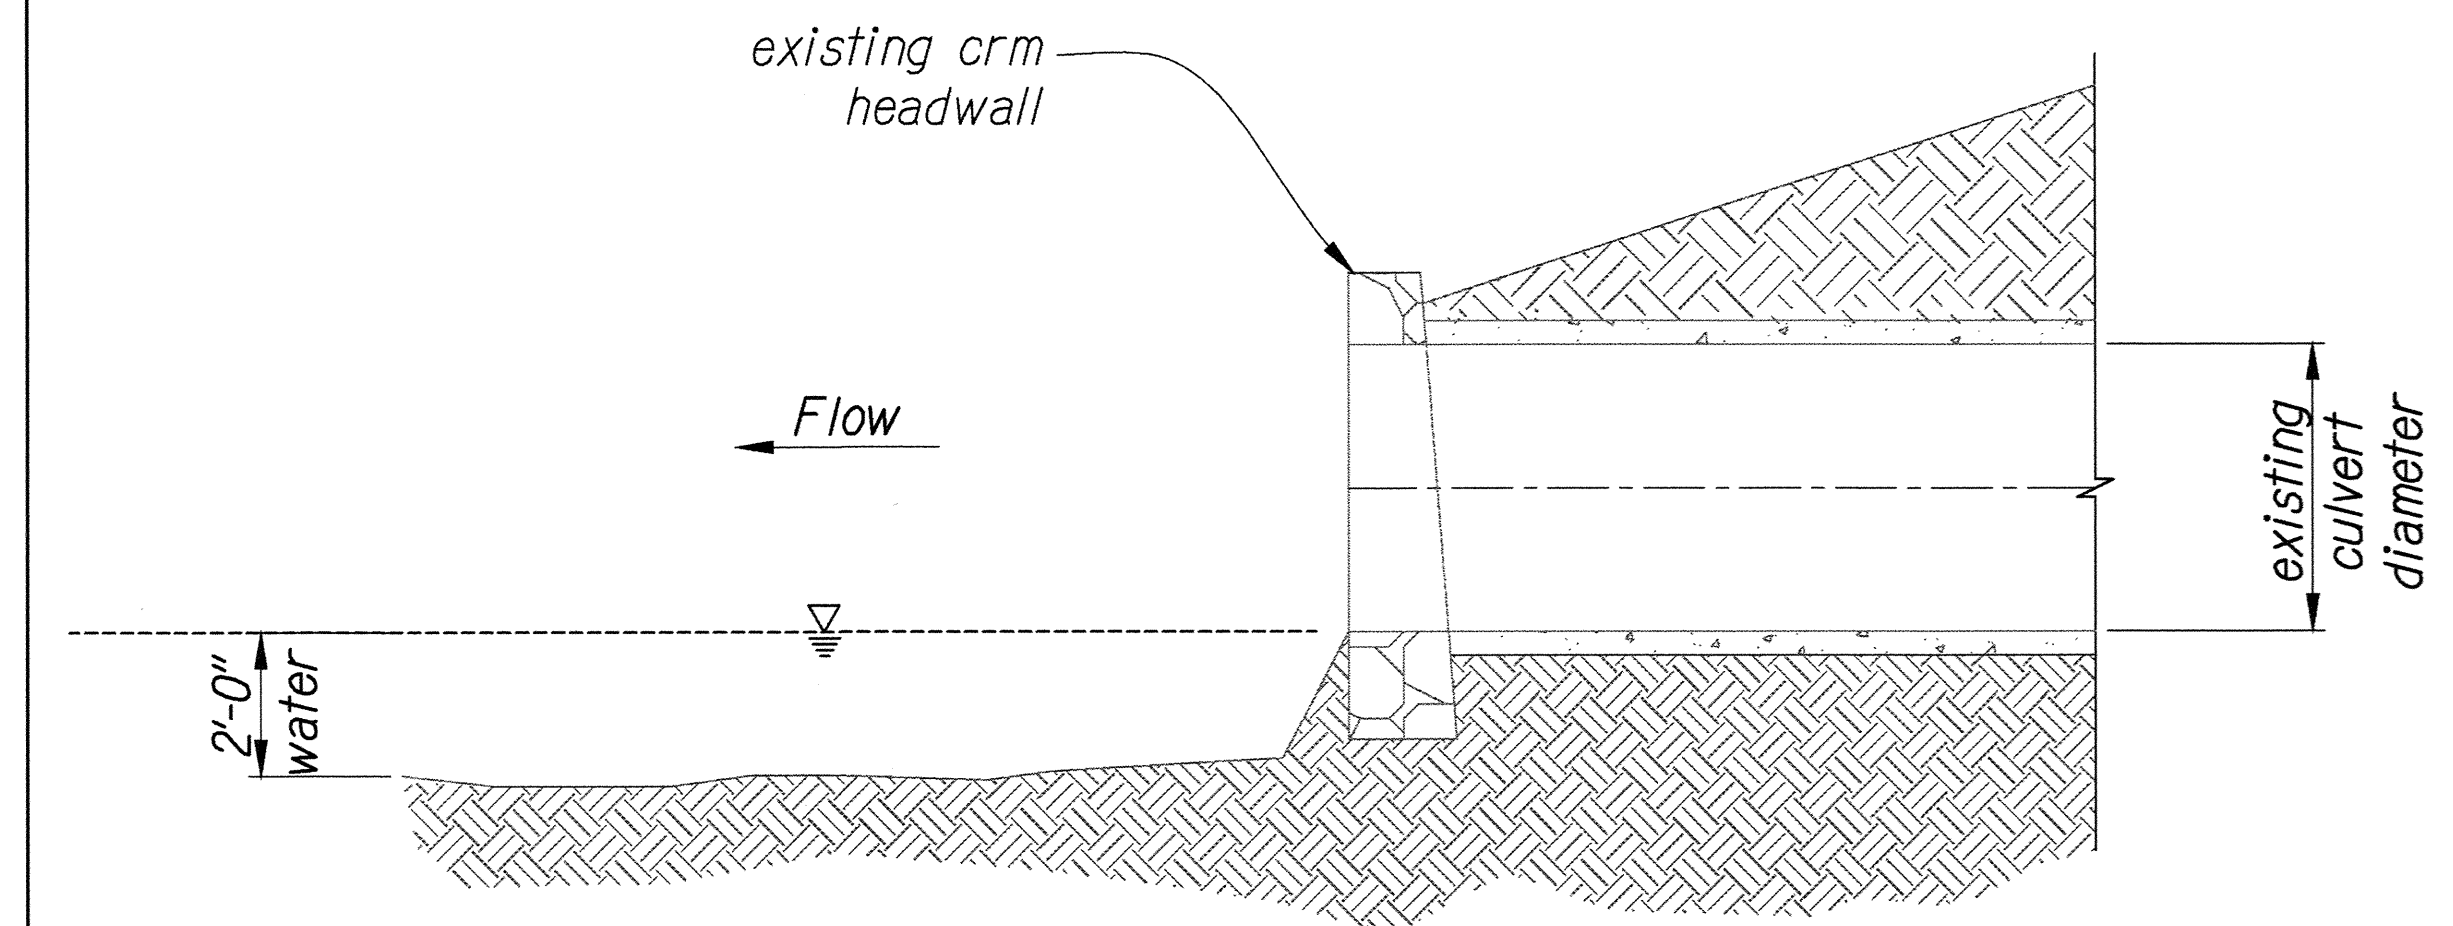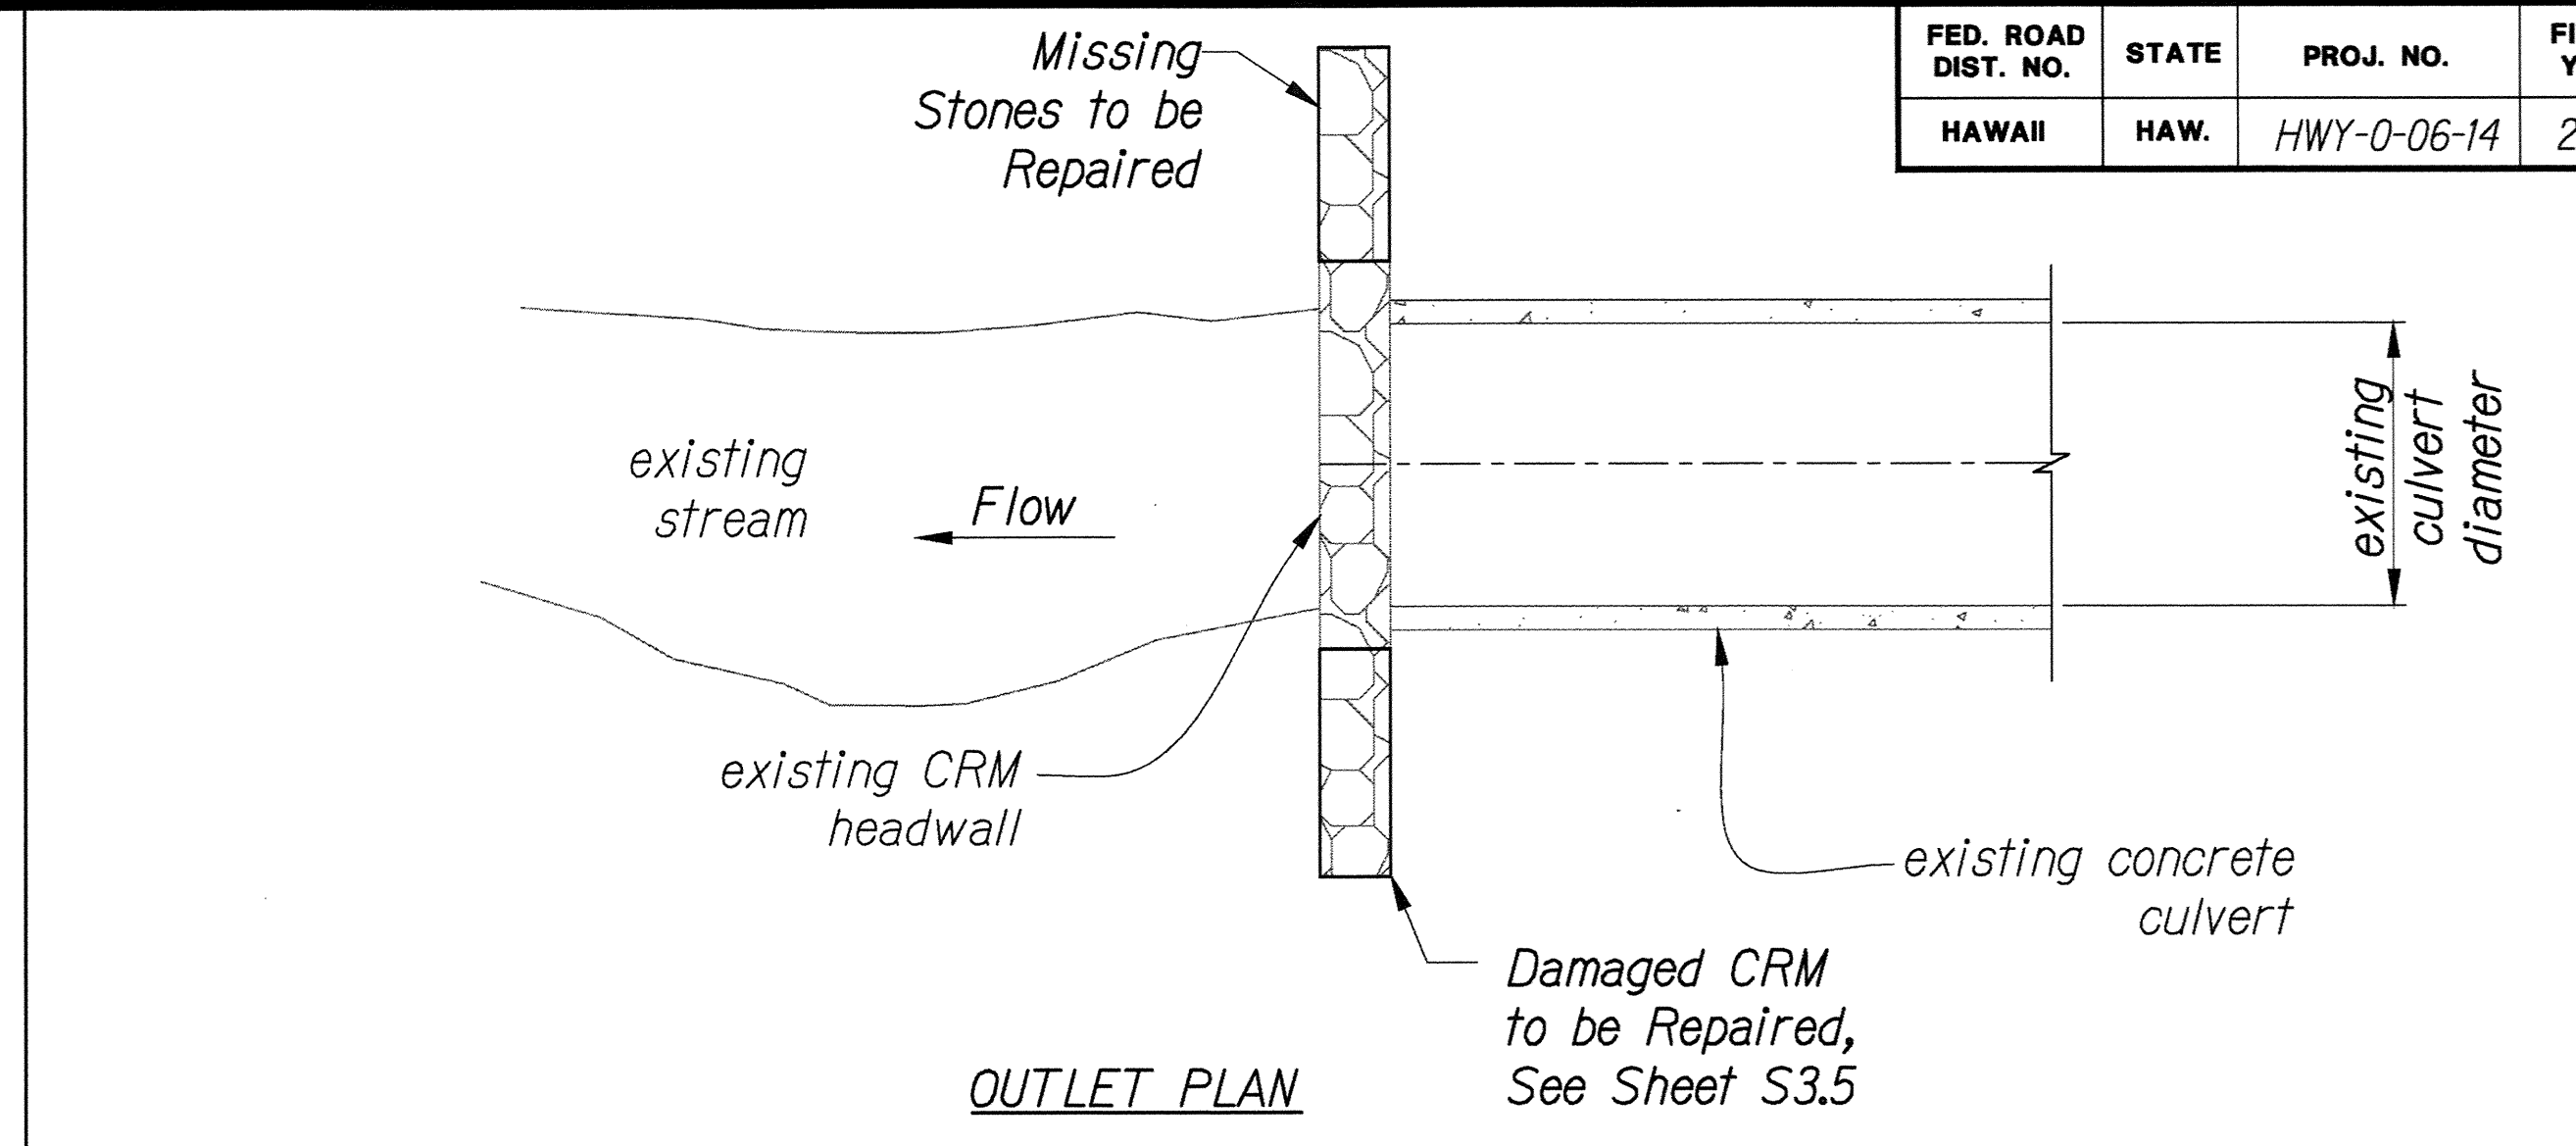

OUTLET STRUCTURE  
EXISTING CONDITION

Scale: 1" = 4'-0"

2  
S3.4 S3.4

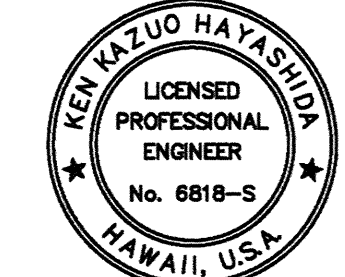

STATE OF HAWAII  
DEPARTMENT OF TRANSPORTATION  
HIGHWAYS DIVISION

**EX CULVERT M.P. 6.70 (PALI)**  
**INLET/OUTLET STRUCTURES**


CULVERT REMEDIATION AT VARIOUS  
LOCATIONS ON OAHU, PHASE 1

Project No. HWY-0-06-14

Scale: As Shown Date: March 2016

SHEET No. S3.4 OF 62 SHEETS

FED. ROAD DIST. NO.	STATE	PROJ. NO.	FISCAL YEAR	SHEET NO.	TOTAL SHEETS
HAWAII	HAW.	HWY-0-06-14	2016	26	62

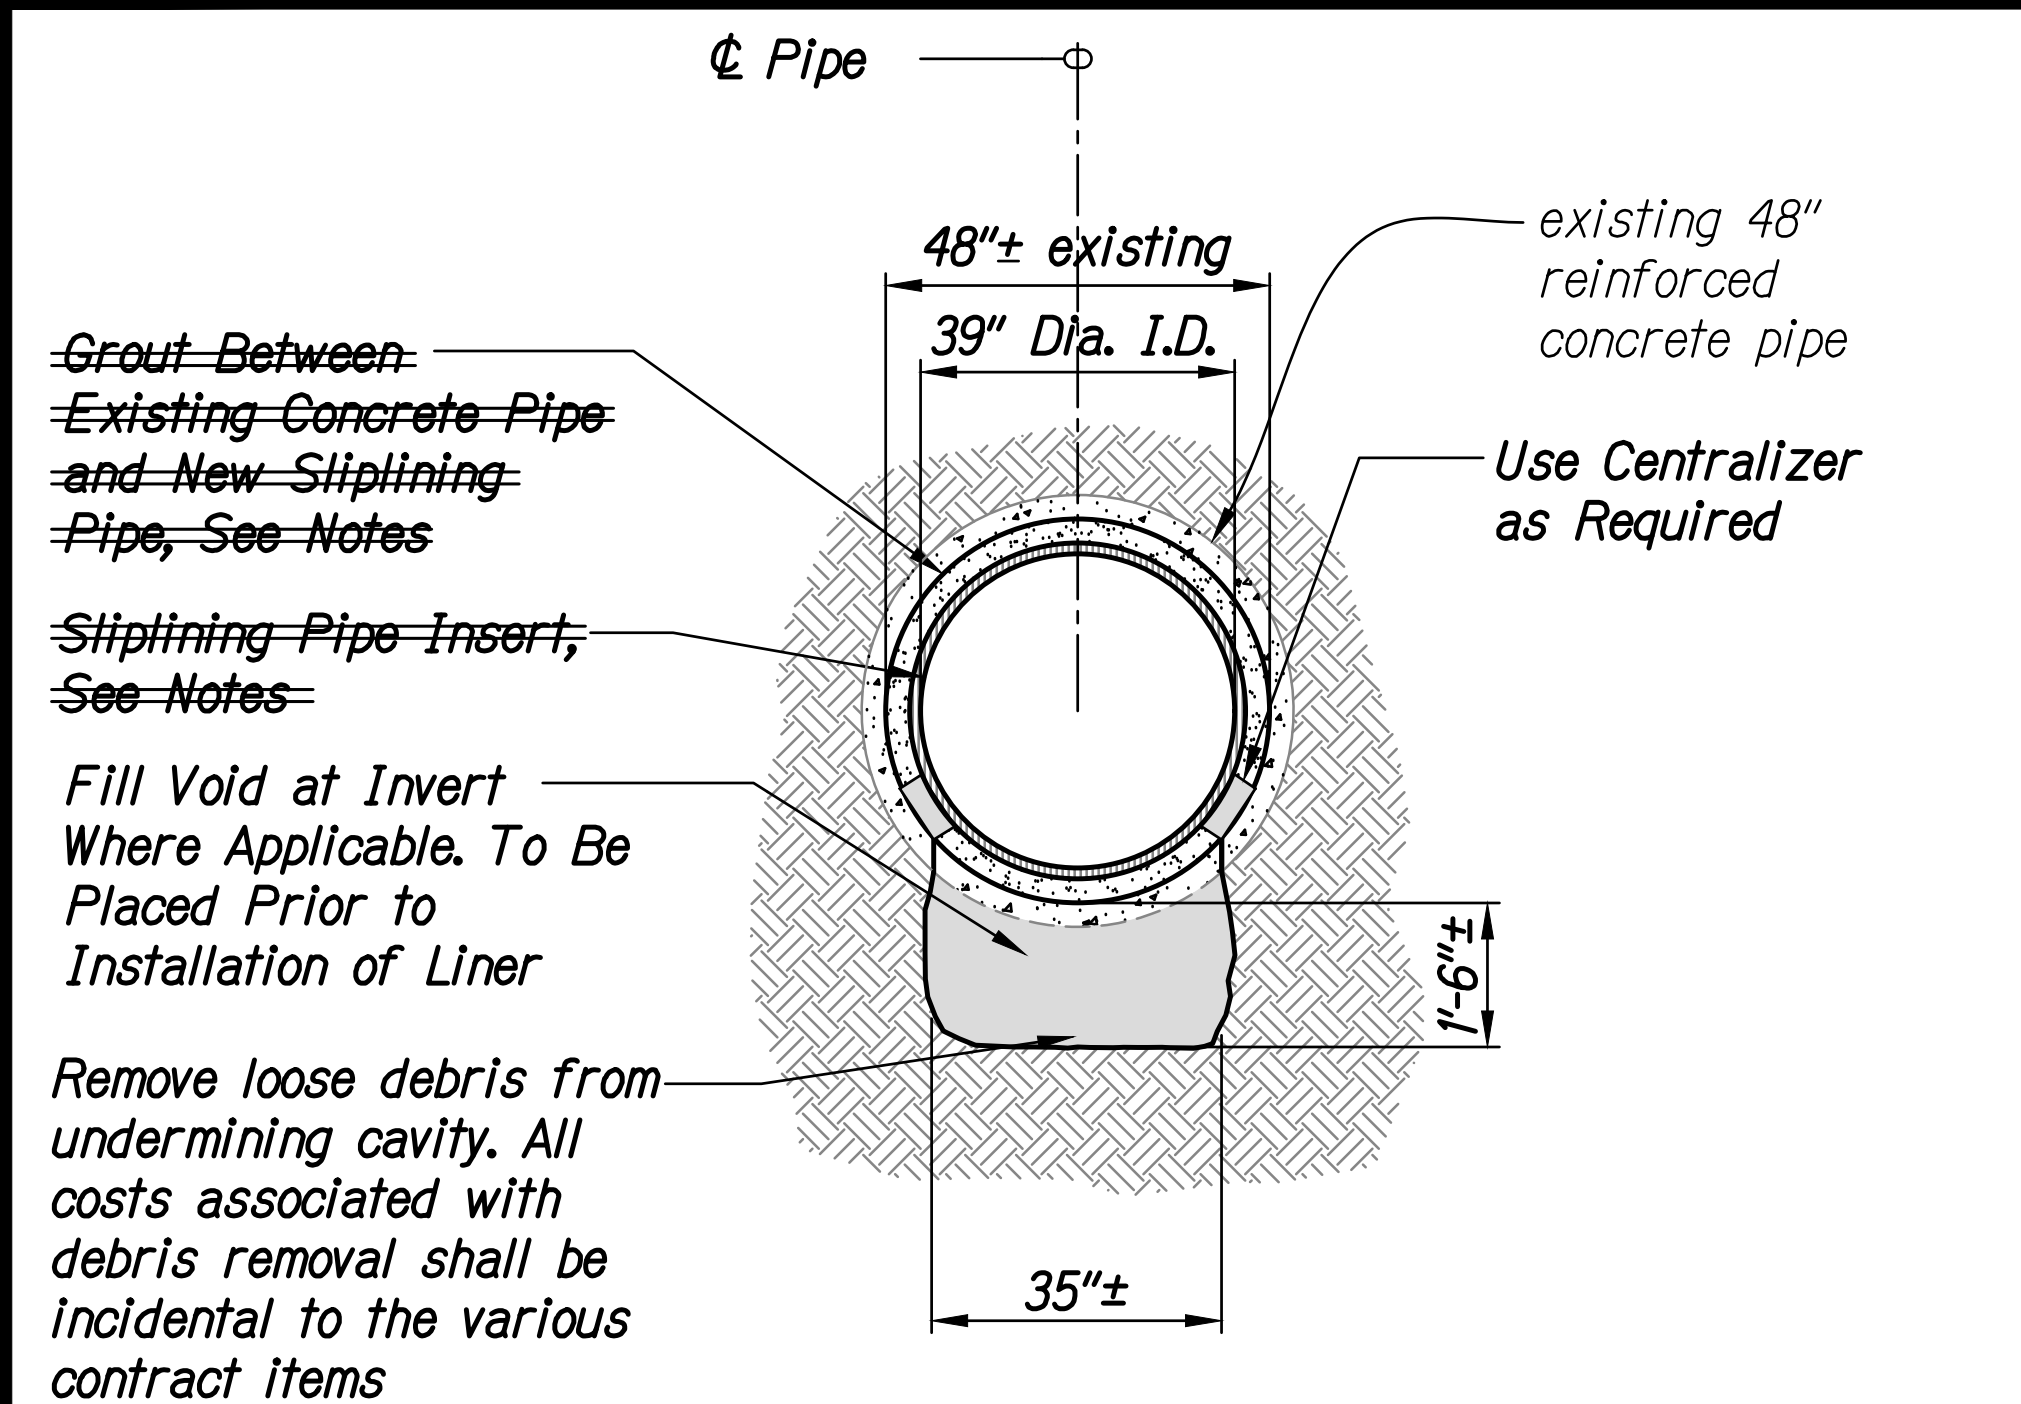


**TYPICAL PIPE REPAIR AND SLIPLINE DETAIL**  
Scale: 1" = 2'-0"

1  
S3.5 | S3.5

**Notes:**

- Contractor may use the following method for pipe rehabilitating :  
a. Sliplining pipe with High Density Polyethylene Pipe (HDPE)  
b. Sliplining pipe with Fiber Reinforced Polymer (FRP)  
c. Cured In Place Pipe (CIPP)
- Contractor to provide shop drawings, grouting method and specification, and structural calculation stamped by licensed structural engineer in State of Hawaii to Engineer for review and approval of selected rehabilitation method.
- Contractor to provide grout between the existing pipe and liner in sliplining rehabilitation method only CIPP rehabilitation method grouting is not required.
- Contractor to measure existing culvert to verify size of host pipe prior to ordering the material for rehabilitation.

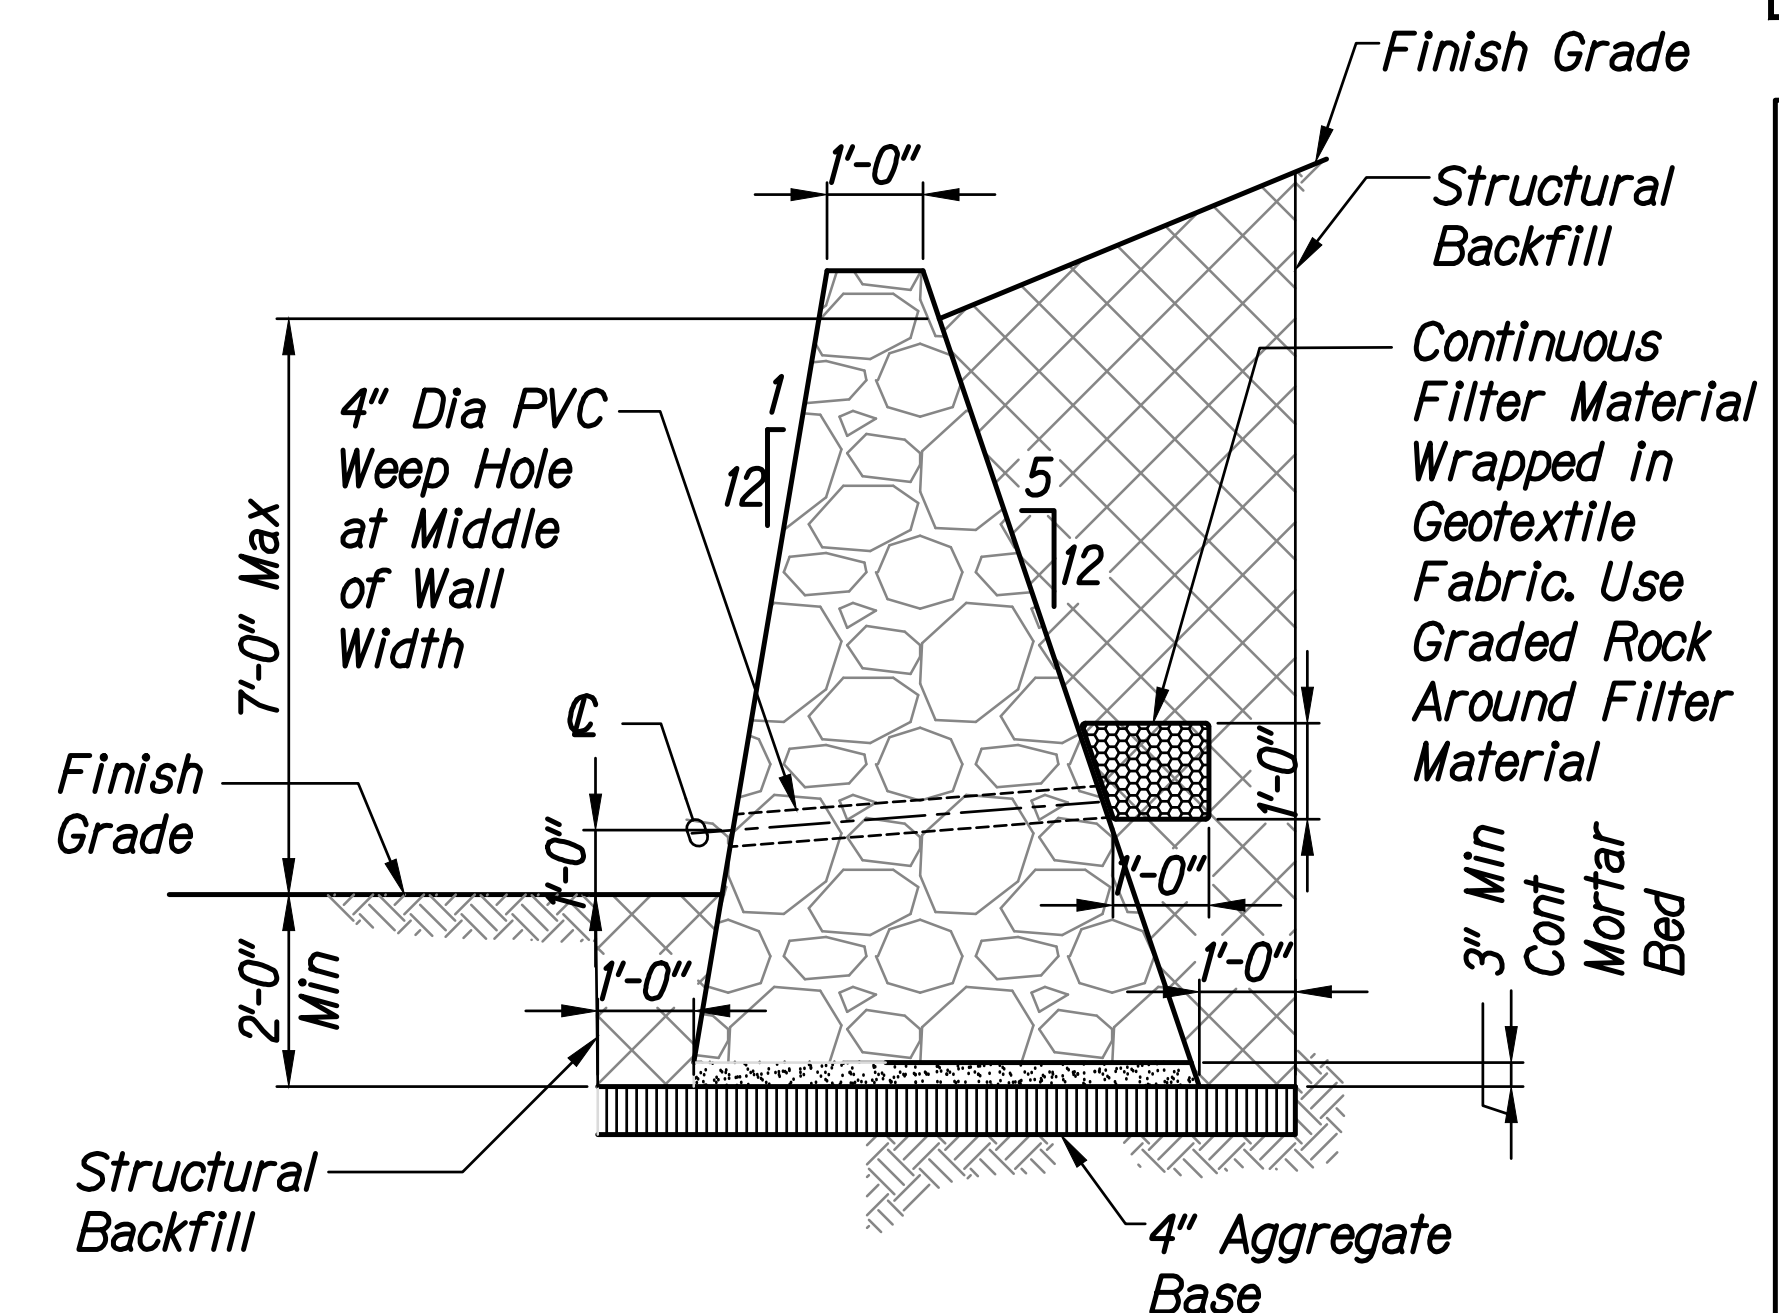


**OUTLET CRM WALL REPAIR**  
Scale: 1" = 2'-0"

2  
S3.4 | S3.5

**Cement Rubble Masonry (CRM) Notes:**


- Stones shall be clean, hard, sound, and durable. Each stone, except stones for filling or pinning interstices, shall have a thickness of not less than 6 inches and a width of not less than one and one half times the thickness or 12 inches, whichever is greater.
- Mortar shall be type "M" conforming to ASTM C270 and have a minimum compressive strength of 2,500 psi at 28 days.
- Cement rubble masonry shall be constructed by experienced workmen.
- Selected stones shall be roughly squared and pitched to lines at angles and ends of walls.
- Stones shall be wet thoroughly before laying.
- Stone joints shall overlap at least 6 inches and form a firm bond.
- Stones for bottom course shall be large, flat and fully bedded in mortar.
- Horizontal joints in the face of the wall shall not exceed 1 inch in thickness and vertical joints shall not exceed 2 inches in width.
- CRM wall base shall be founded on firm undisturbed soil or structural fill compacted to a minimum 95% relative compaction. Remove soft and/or loose material at the bottom of the excavation and fill with granular fill compacted to a minimum 95% relative compaction. Alternately, the CRM wall base may be extended down to the firm undisturbed soil.

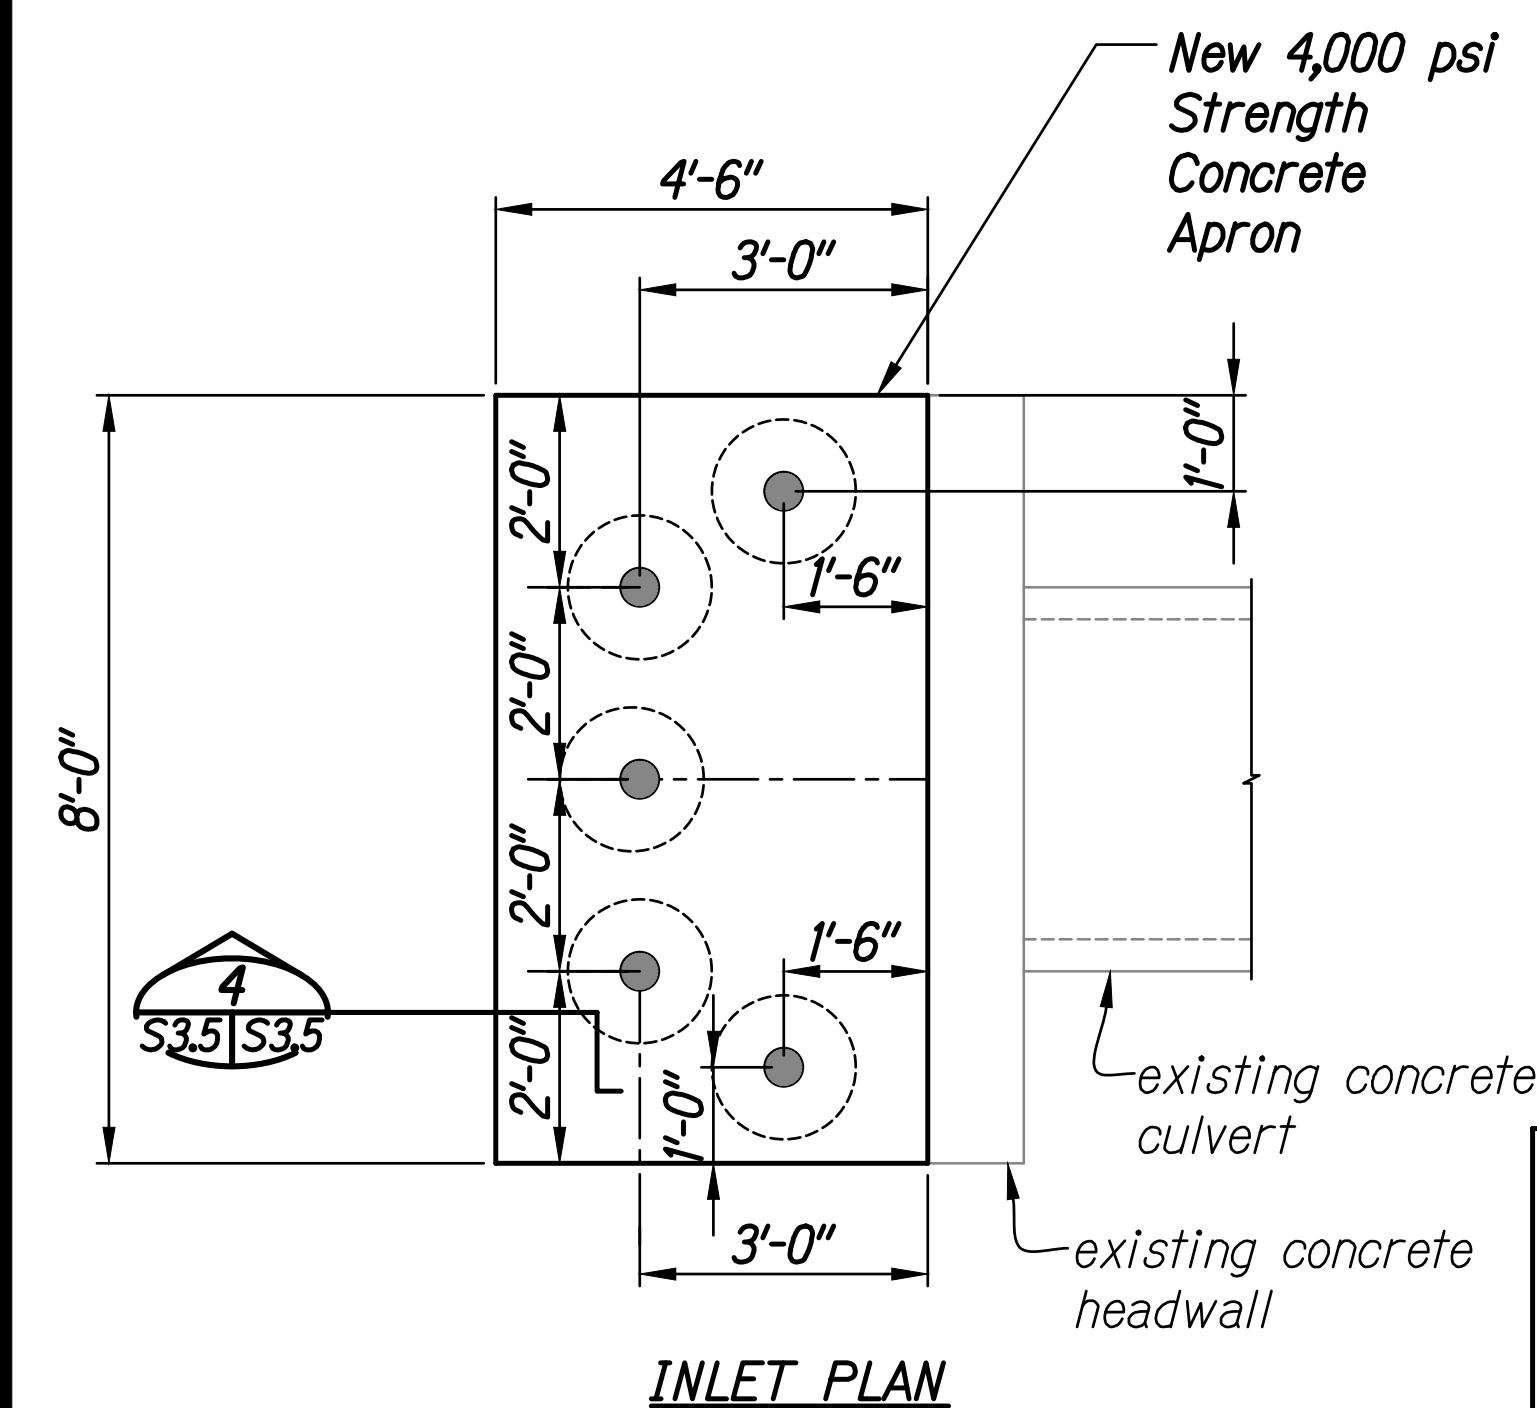

**INLET DEBRIS CATCHER PLAN VIEW**  
Scale: 1" = 2'-0"

3  
S3.1 | S3.5

**Note:**  
Cost to any excavation prior to placement of slab shall be incidental to other pay items.

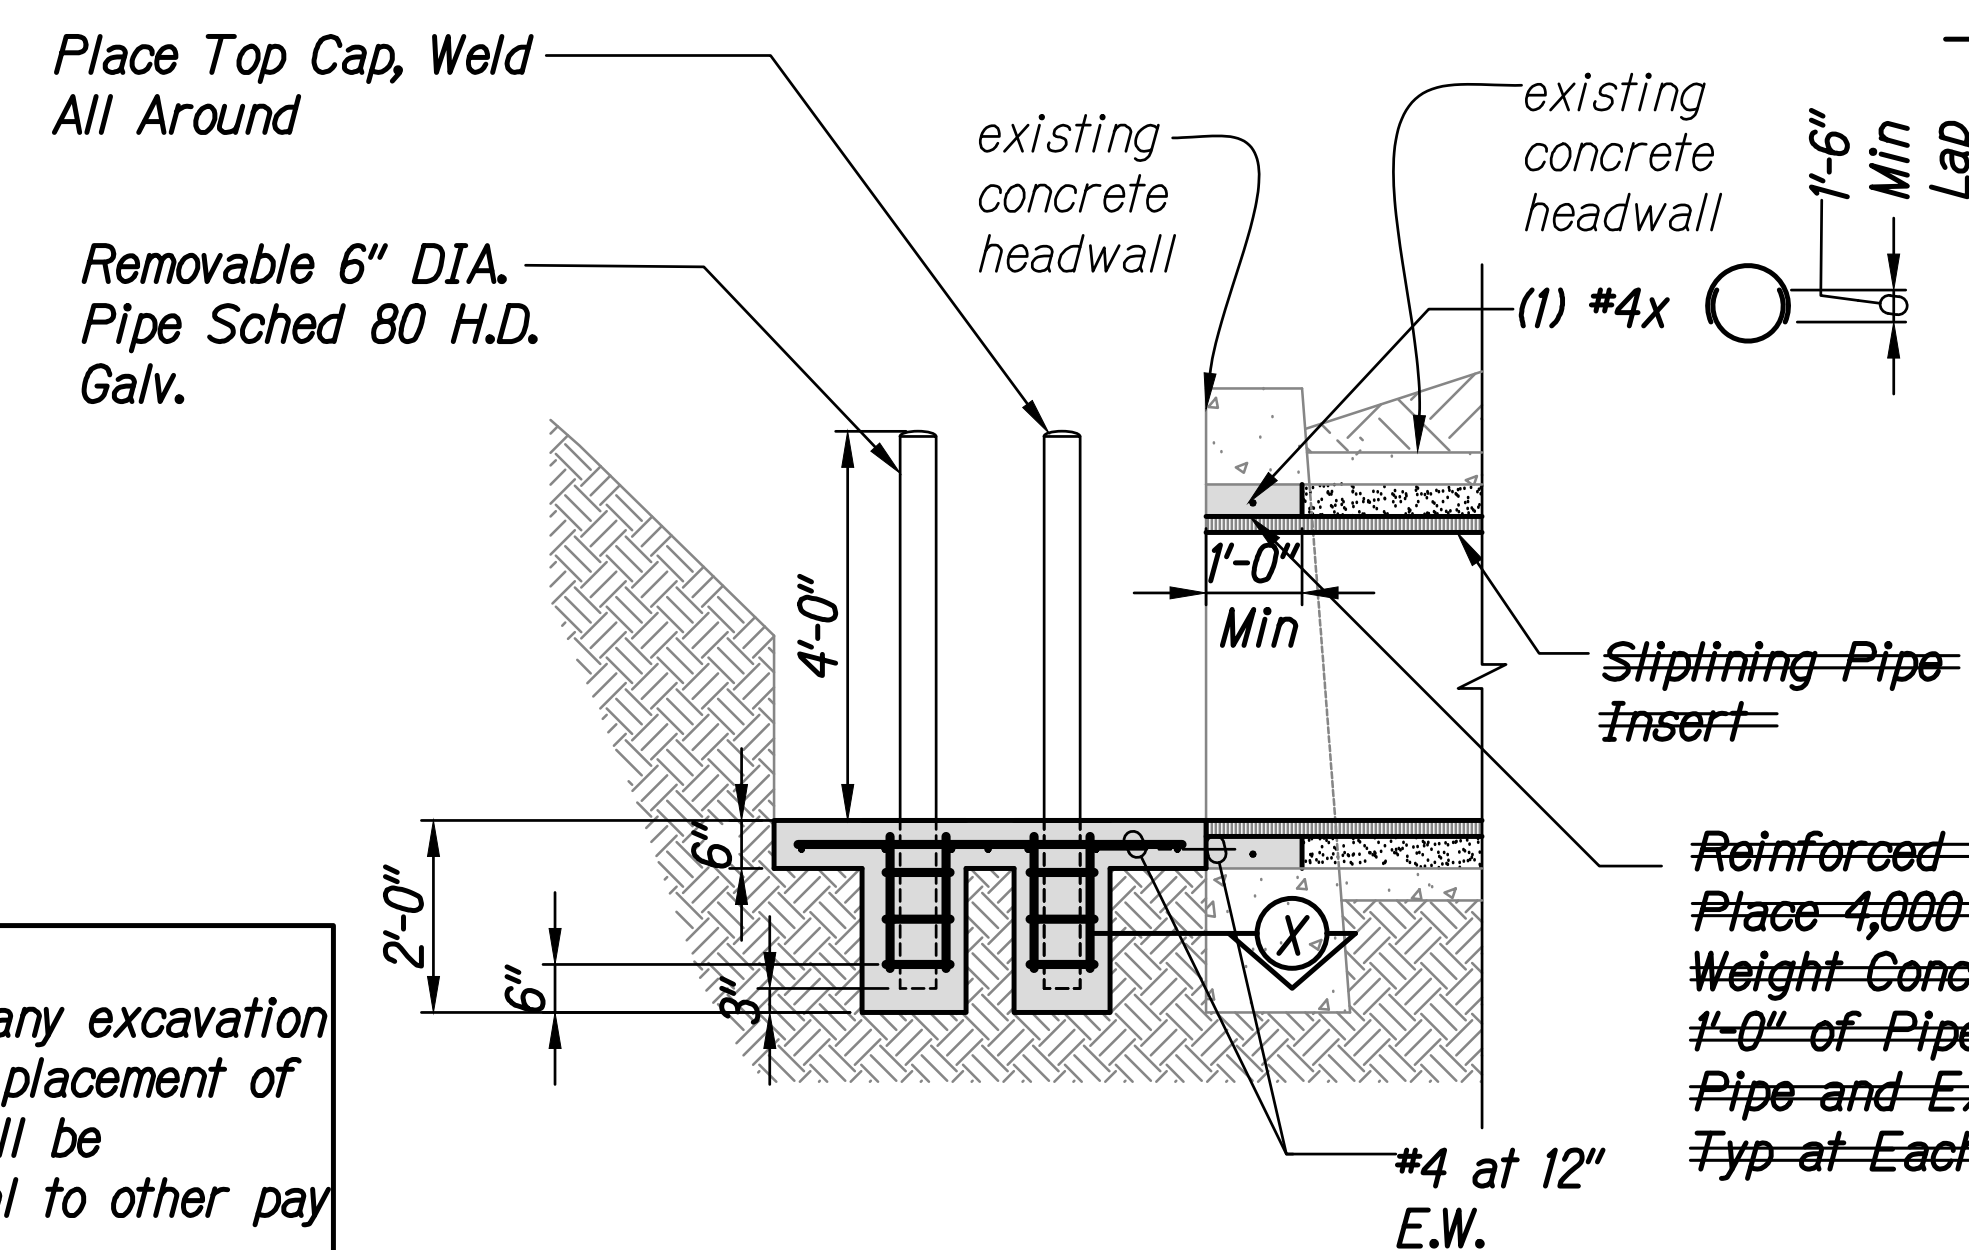


**SECTION**  
Scale: 1" = 2'-0"

4  
S3.5 | S3.5

**Note:**  
1-Reinforced Concrete Collar to be replaced with sealant for CIPP rehabilitation option  
2- Inlet Slab Overlay can be eliminated for CIPP rehabilitate option

LEGEND FOR AS-BUILT POSTINGS	
~~~~~	Squiggly line for as-built deletion
==	Double line for as-built deletion
Roadway	Text for as-built posting

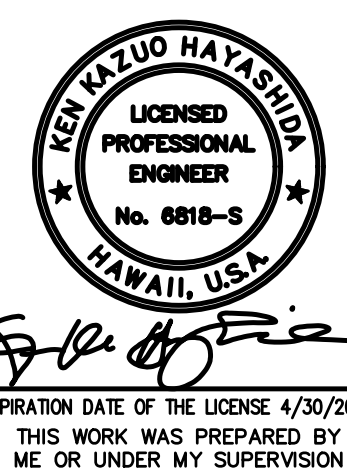


STATE OF HAWAII  
DEPARTMENT OF TRANSPORTATION  
HIGHWAYS DIVISION

**CULVERT M.P. 6.70 (PALI HWY)**  
**REPAIR DET AND SECTIONS**  
CULVERT REMEDIATION AT VARIOUS LOCATIONS ON OAHU, PHASE 1  
Project No. HWY-0-06-14  
Scale: As Shown Date: March 2016  
SHEET No. S3.5 OF 62 SHEETS




FED. ROAD DIST. NO.	STATE	PROJ. NO.	FISCAL YEAR	SHEET NO.	TOTAL SHEETS
HAWAII	HAW.	HWY-0-06-14	2016	27	62

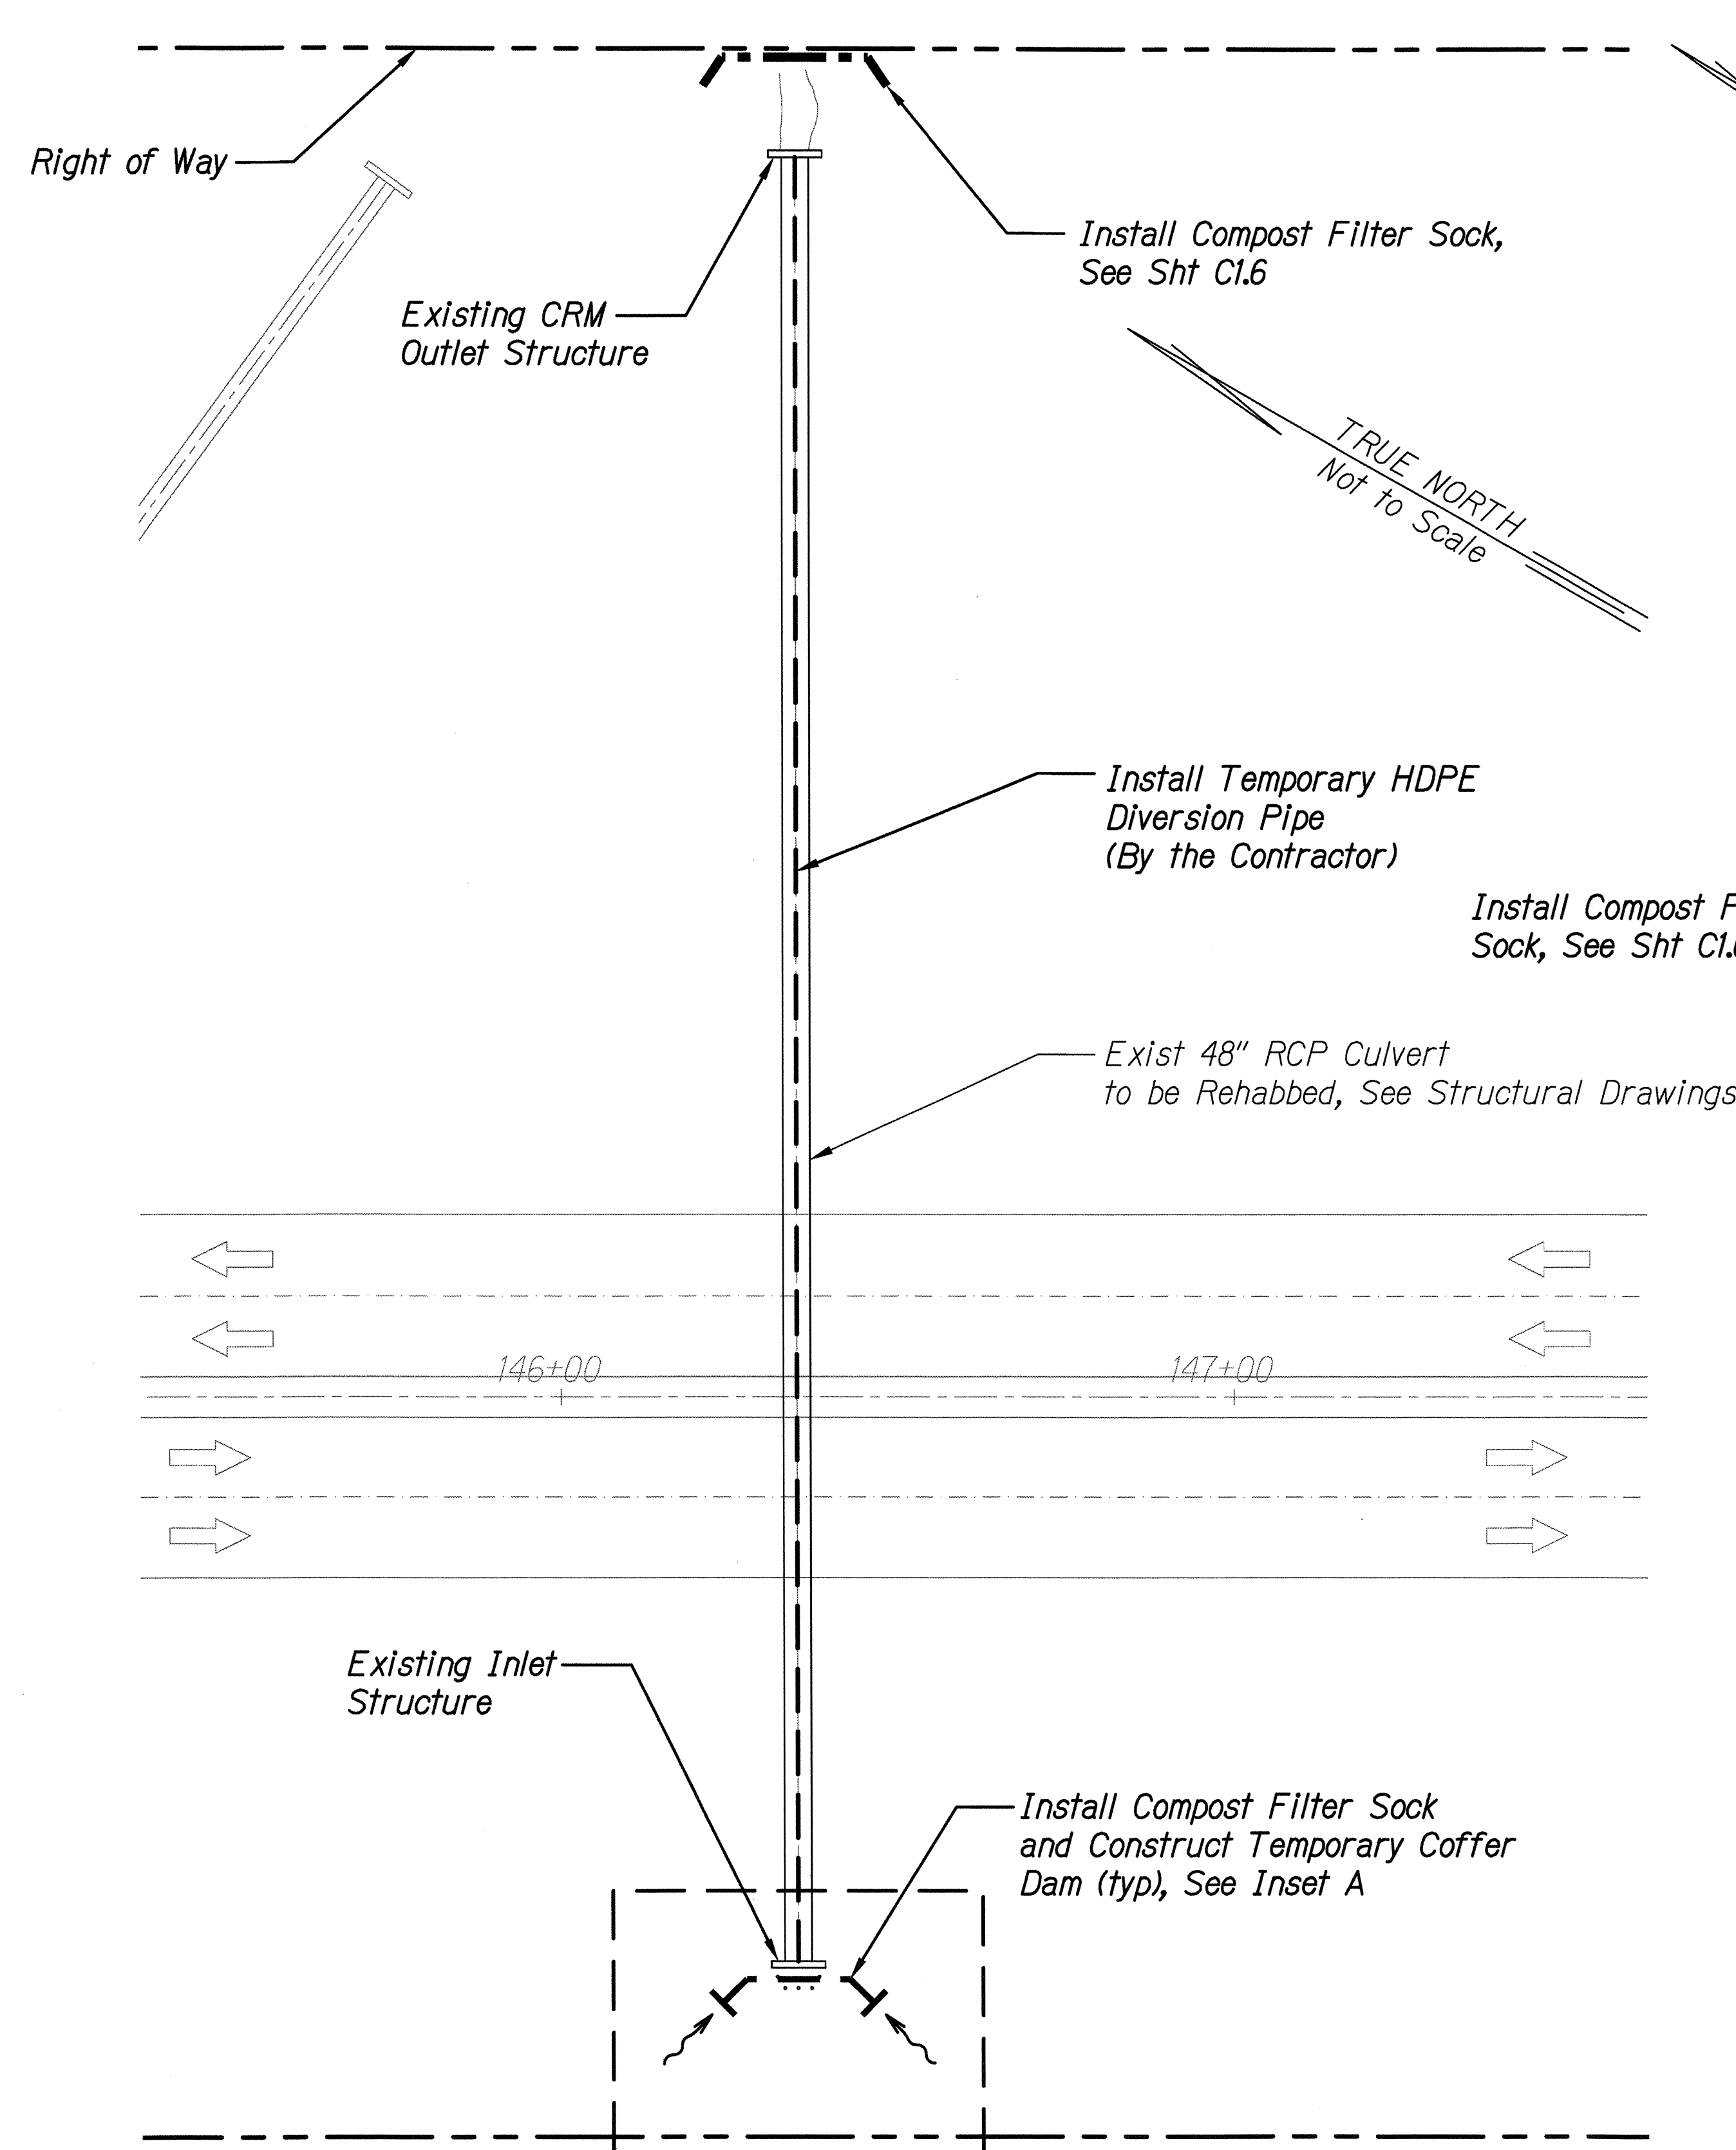


**Note:**  
Proposed BMP plan is provided to show general intent. Contractor shall submit BMP plan for review and approval by the Engineer prior to performing the work.

Plan  
Not to Scale

**MILEPOST 6.70 (PALI HIGHWAY), SITE SPECIFIC BMP**  
Scale: As Noted

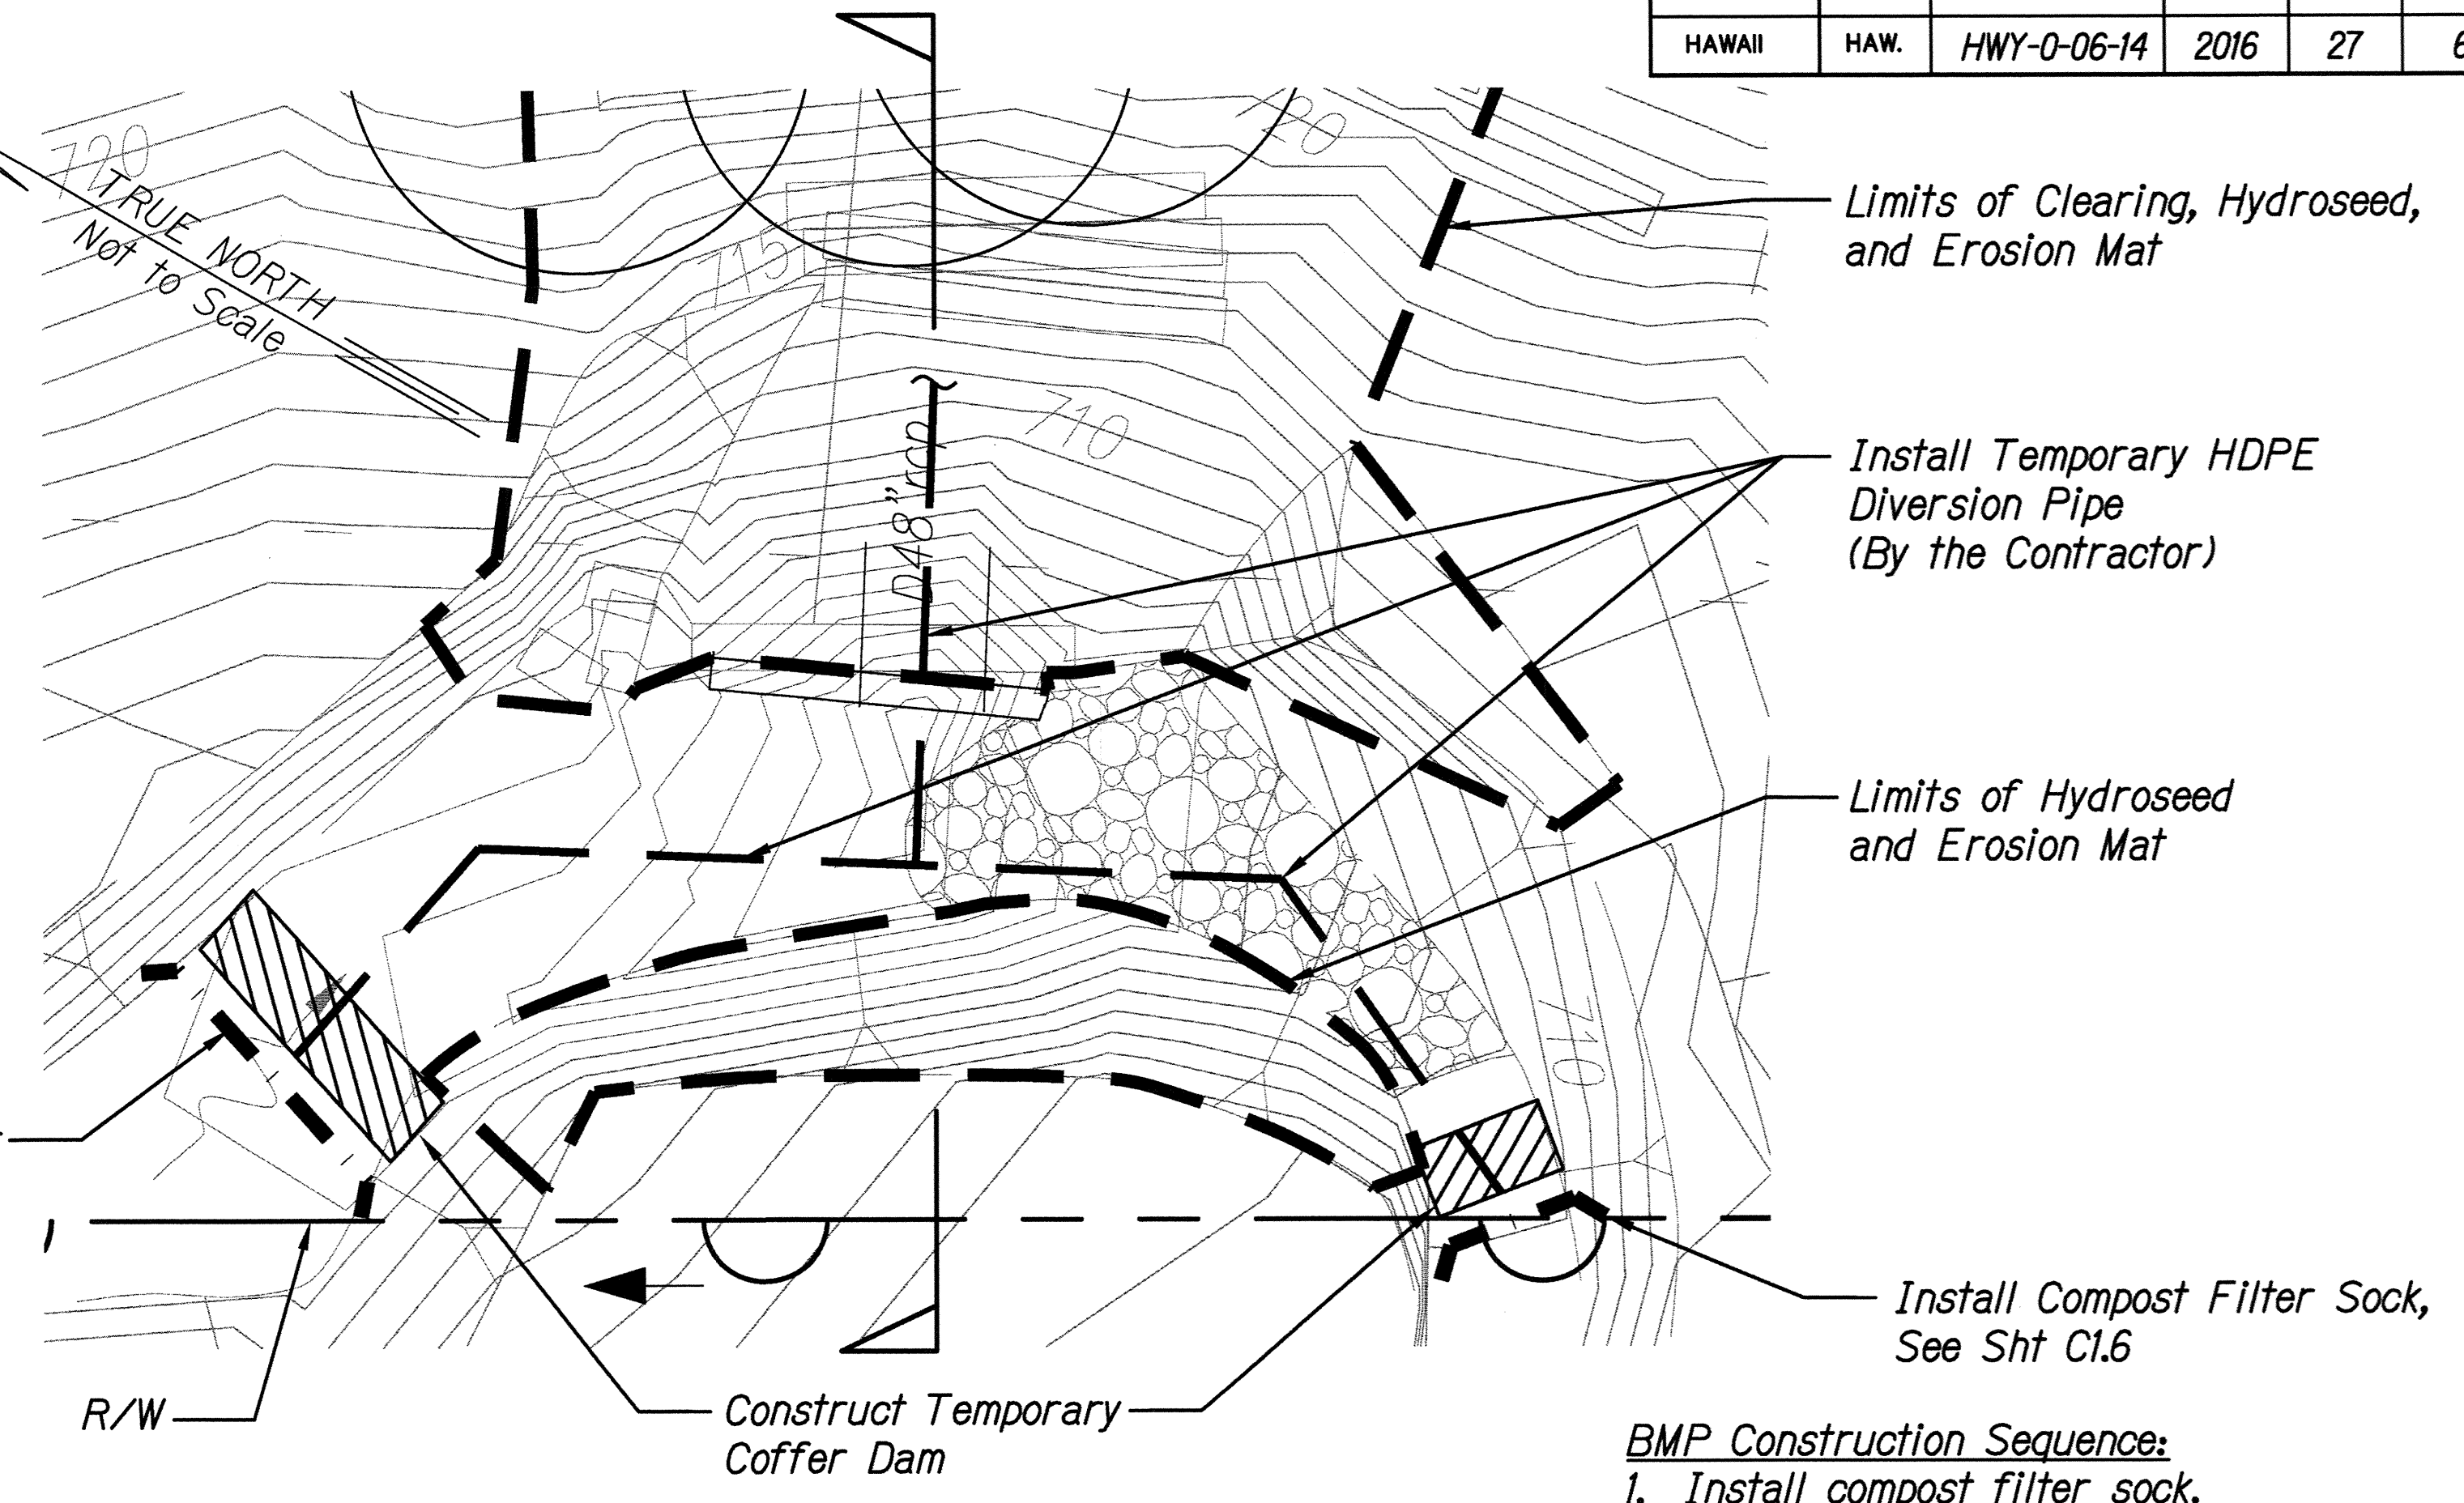


Inset A  
Not to Scale

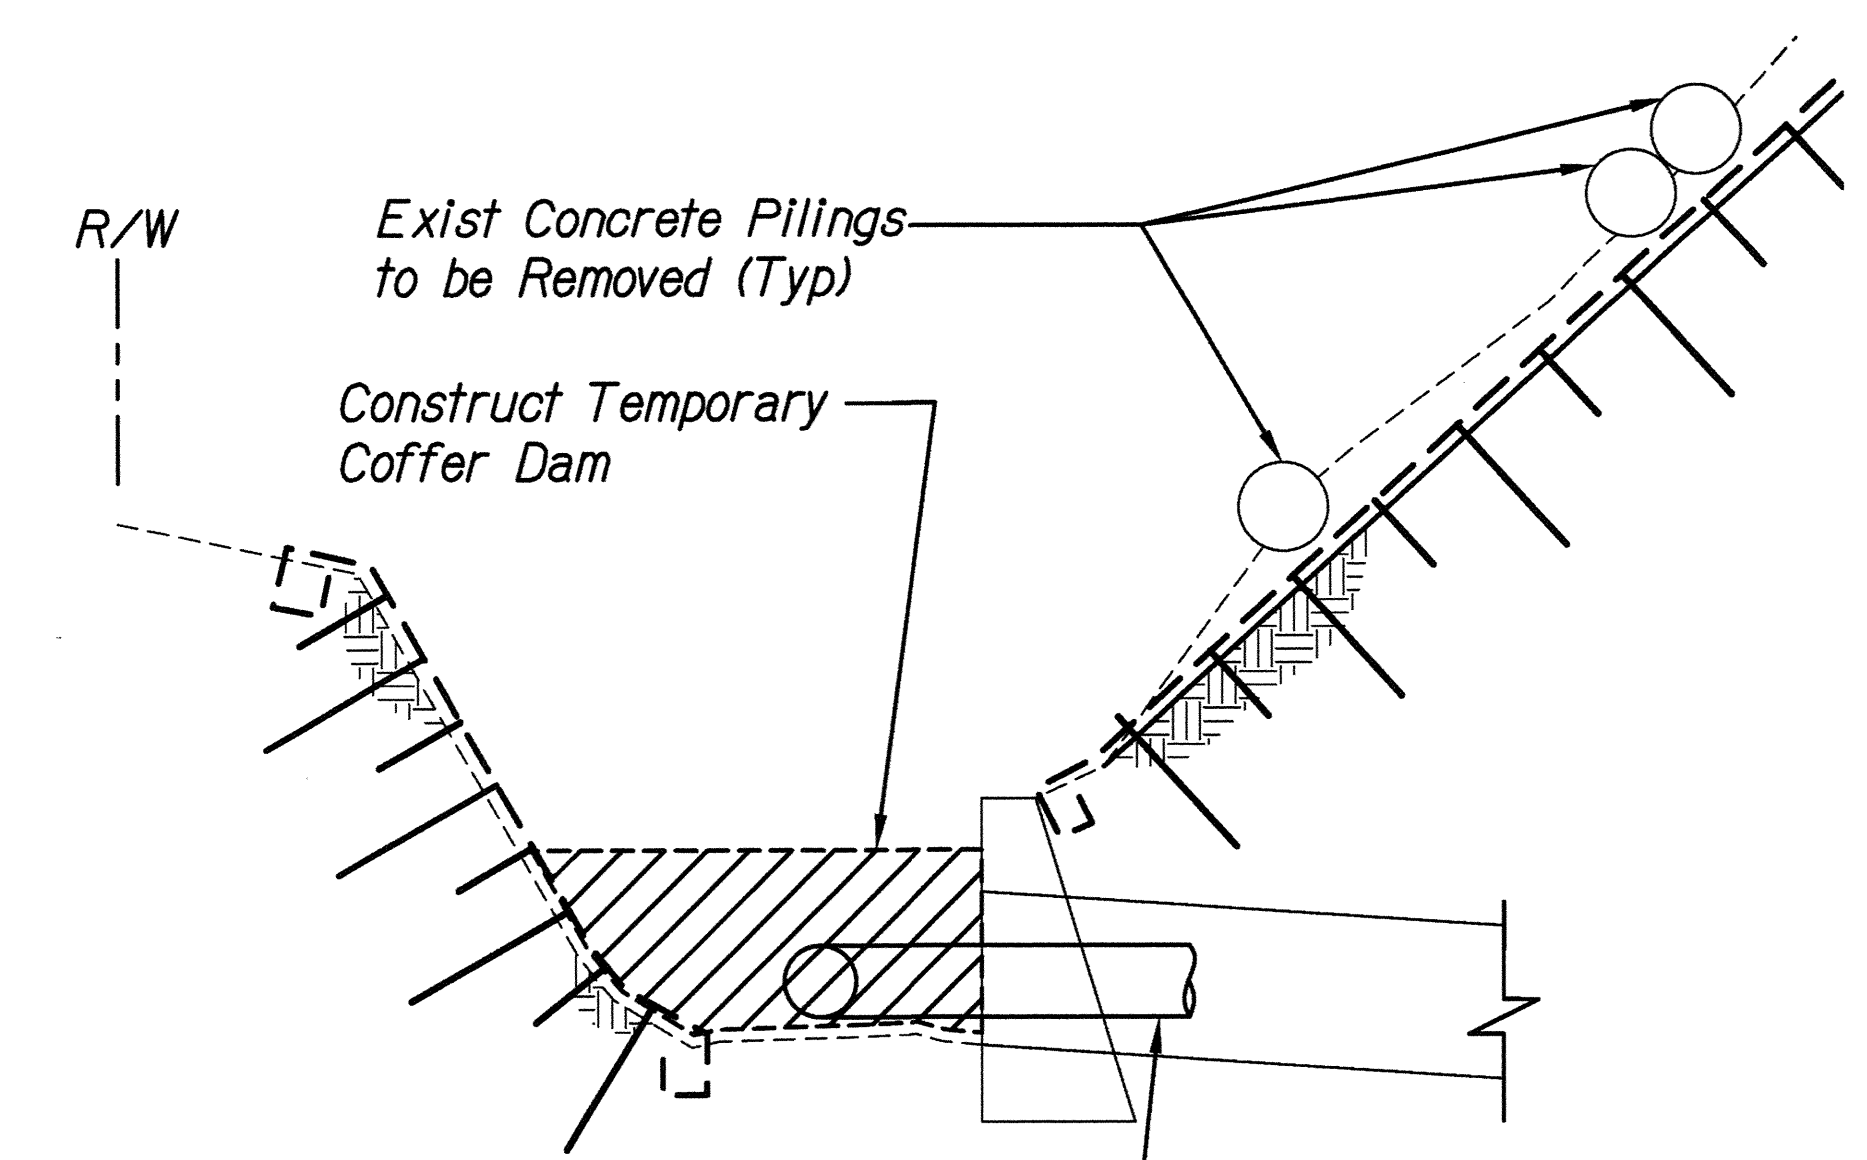

Section  
Not to Scale

- BMP Construction Sequence:**
1. Install compost filter sock.
  2. Remove and relocate rocks/boulders from inlet and remove and dispose of exist concrete pili from slope embankment.
  3. Construct temporary coffer dams and install stream diversion pipe.
  4. Remove debris from within invert cavity and backfill.
  5. Repair the pipe, see structural drawings.
  6. Repair damaged CRM outlet.
  7. Construct new inlet debris catchment.
  8. Grade slope at inlet. Hydro-seed and install erosion mat.
  9. Remove BMPs.

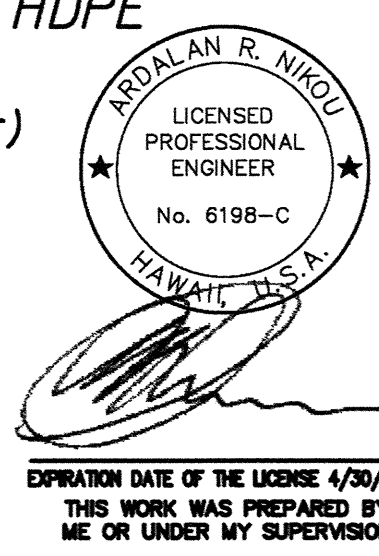

STATE OF HAWAII  
DEPARTMENT OF TRANSPORTATION  
HIGHWAYS DIVISION





**M.P. 6.70 (PALI HIGHWAY)**  
**SITE SPECIFIC BMP**

CULVERT REMEDIATION AT VARIOUS LOCATIONS ON OAHU, PHASE 1  
Project No. HWY-0-06-14  
Scale: As Shown Date: March 2016


SHEET No. C31 OF 62 SHEETS

FED. ROAD DIST. NO.	STATE	PROJ. NO.	FISCAL YEAR	SHEET NO.	TOTAL SHEETS
HAWAII	HAW.	HWY-0-06-14	2016	28	62

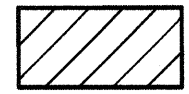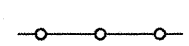Legend:



-  Designates Work Area
-  Traffic Rated Portable Barriers
-  Direction of Traffic
-  Sign (Shown Facing Left)

Note:  
See Traffic Control Notes and Table on Sheet C1.7

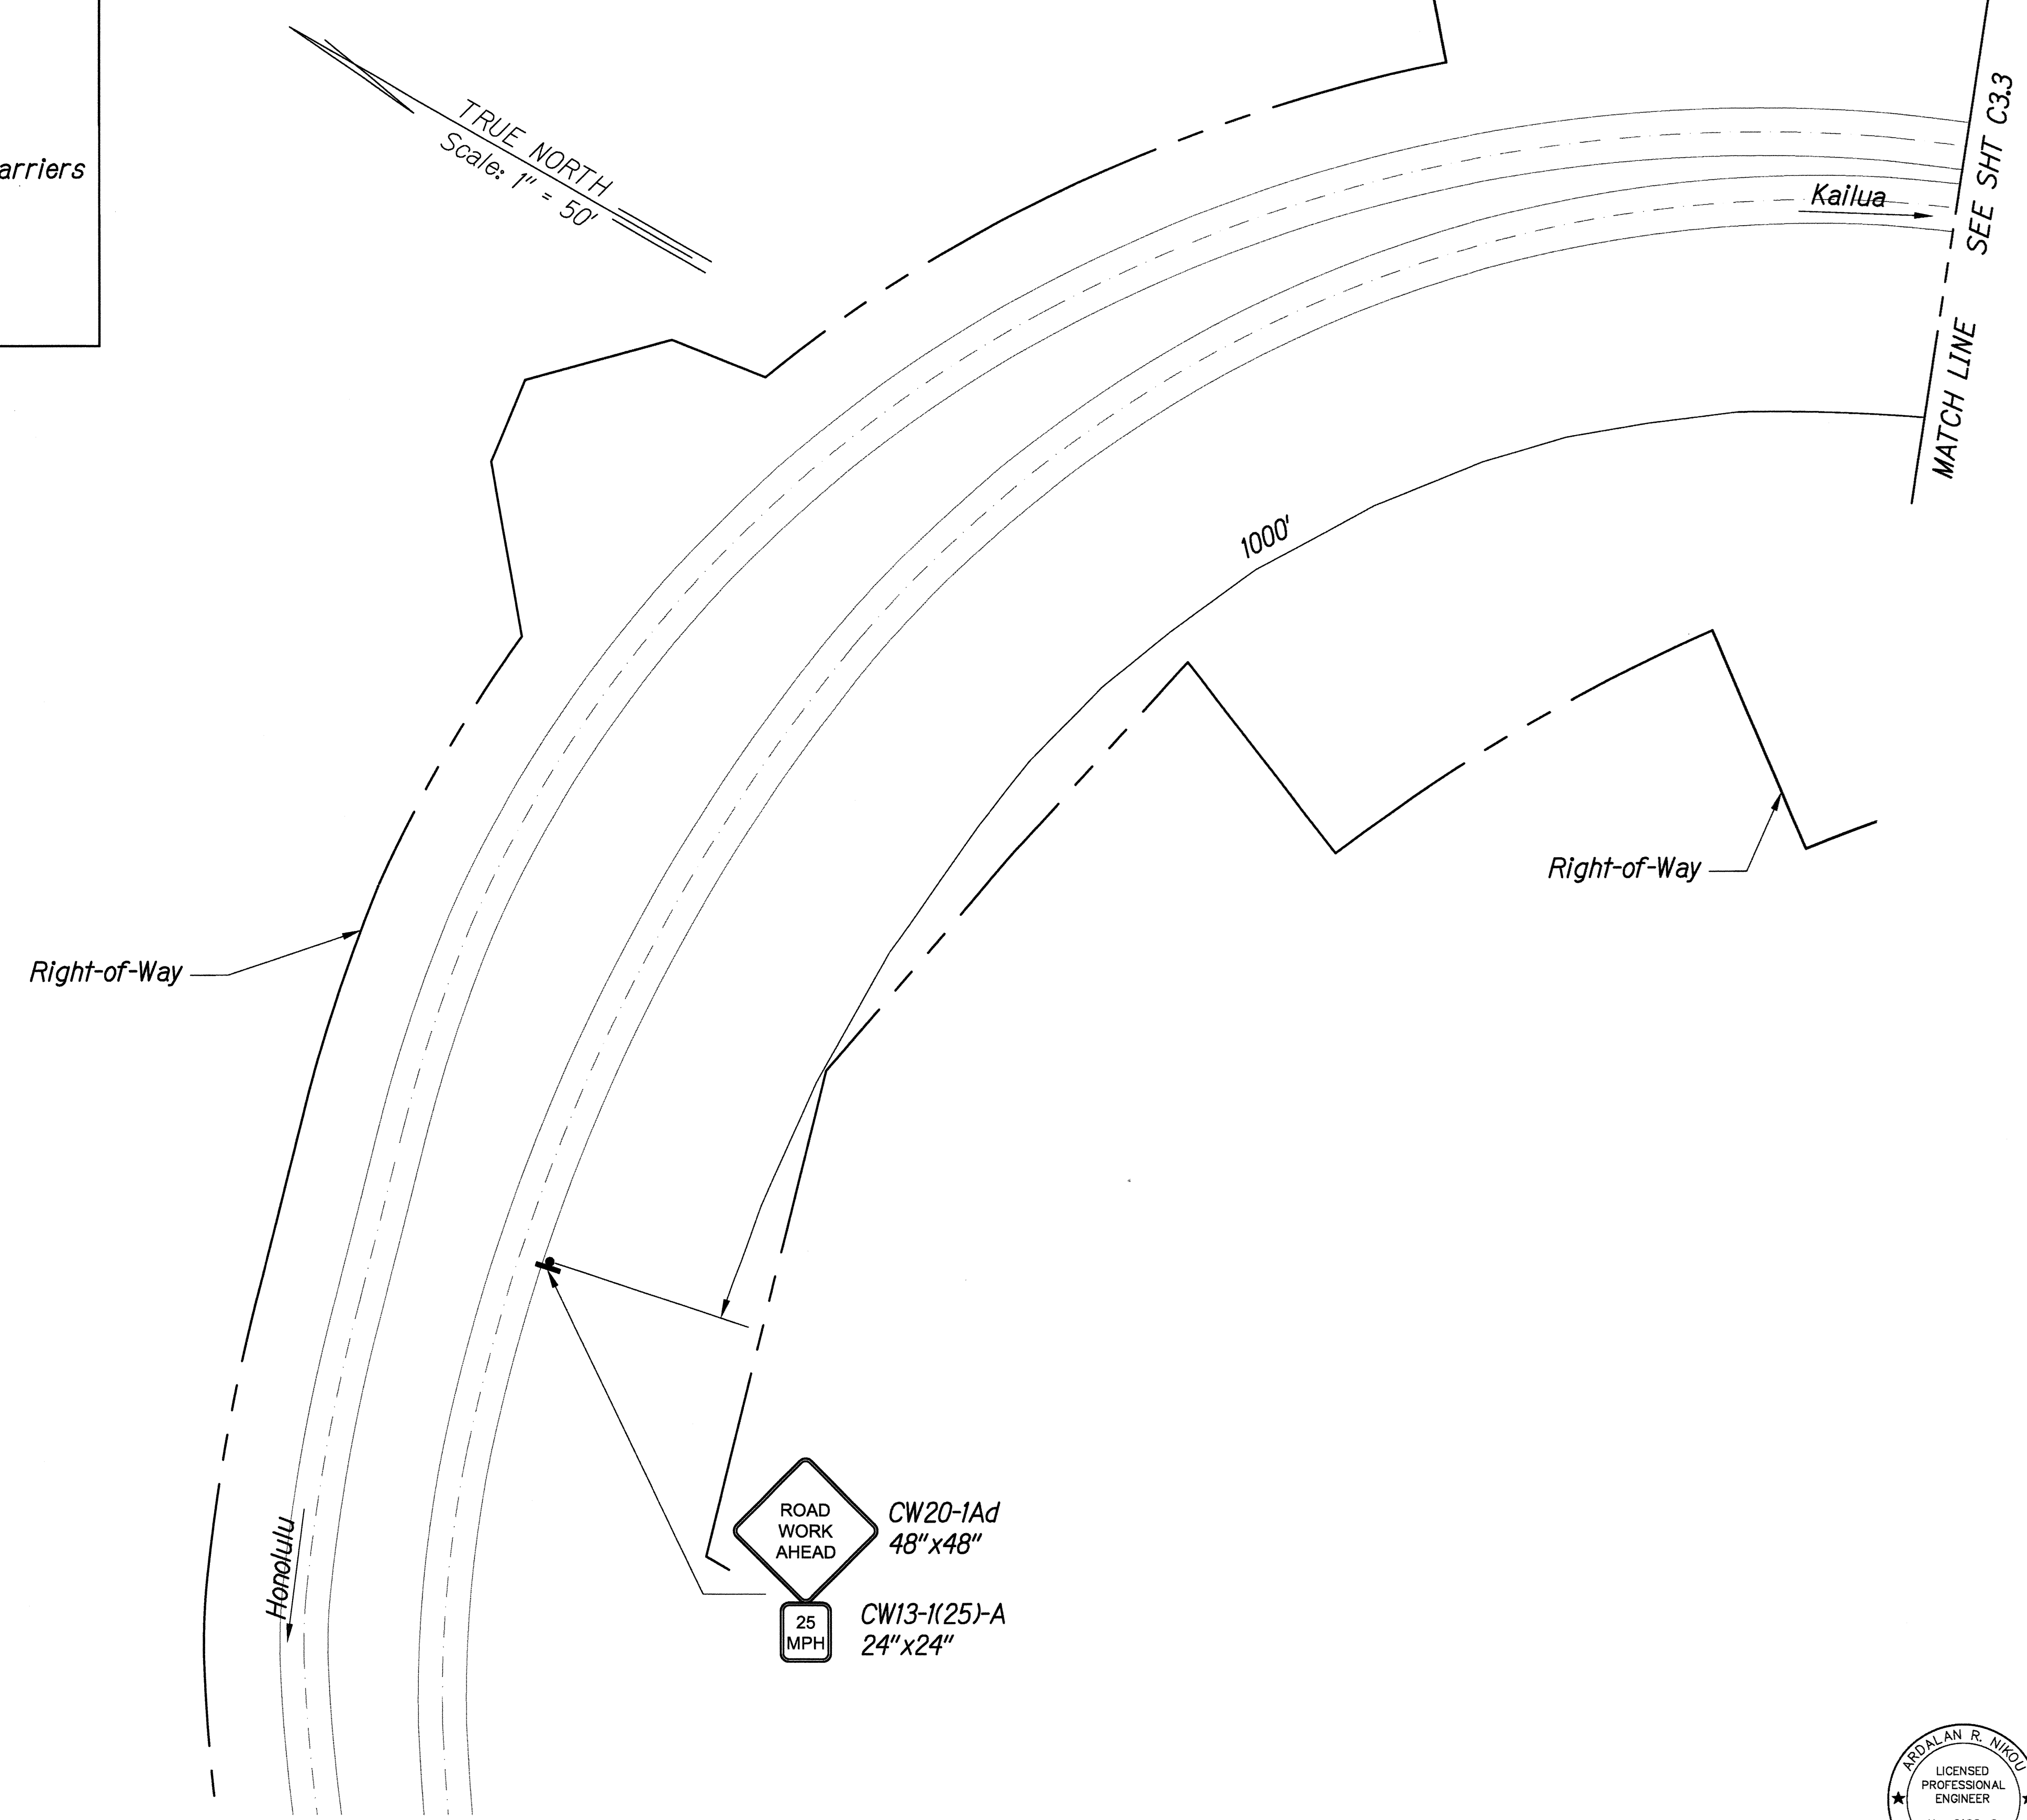

MILEPOST 6.70 (PALI HIGHWAY), TRAFFIC CONTROL PLAN  
Scale: 1" = 50'

1  
C3.2 C3.2

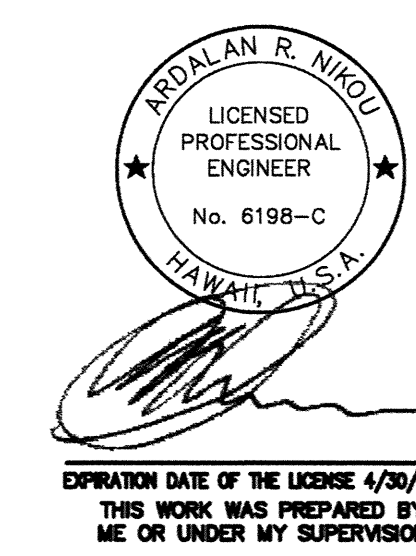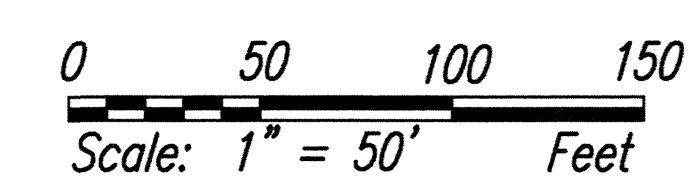

STATE OF HAWAII  
DEPARTMENT OF TRANSPORTATION  
HIGHWAYS DIVISION


**M.P. 6.70 (PALI HIGHWAY)**  
**TRAFFIC CONTROL PLAN-01**


CULVERT REMEDIATION AT VARIOUS  
LOCATIONS ON OAHU, PHASE 1  
Project No. HWY-0-06-14  
Scale: As Shown Date: March 2016


SHEET No. C3.2 OF 62 SHEETS


FED. ROAD DIST. NO.	STATE	PROJ. NO.	FISCAL YEAR	SHEET NO.	TOTAL SHEETS
HAWAII	HAW.	HWY-0-06-14	2016	29	62

Legend:

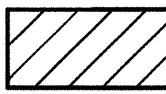
 Designates Work Area

 Traffic Rated Portable Barriers



 Direction of Traffic

 Sign (Shown Facing Left)

- Notes:
1. See Traffic Control Notes and Table on Sheet C1.7
  2. Contractor shall maintain access for Runaway Truck Ramp at all times and provide for additional safety and protection as necessary.

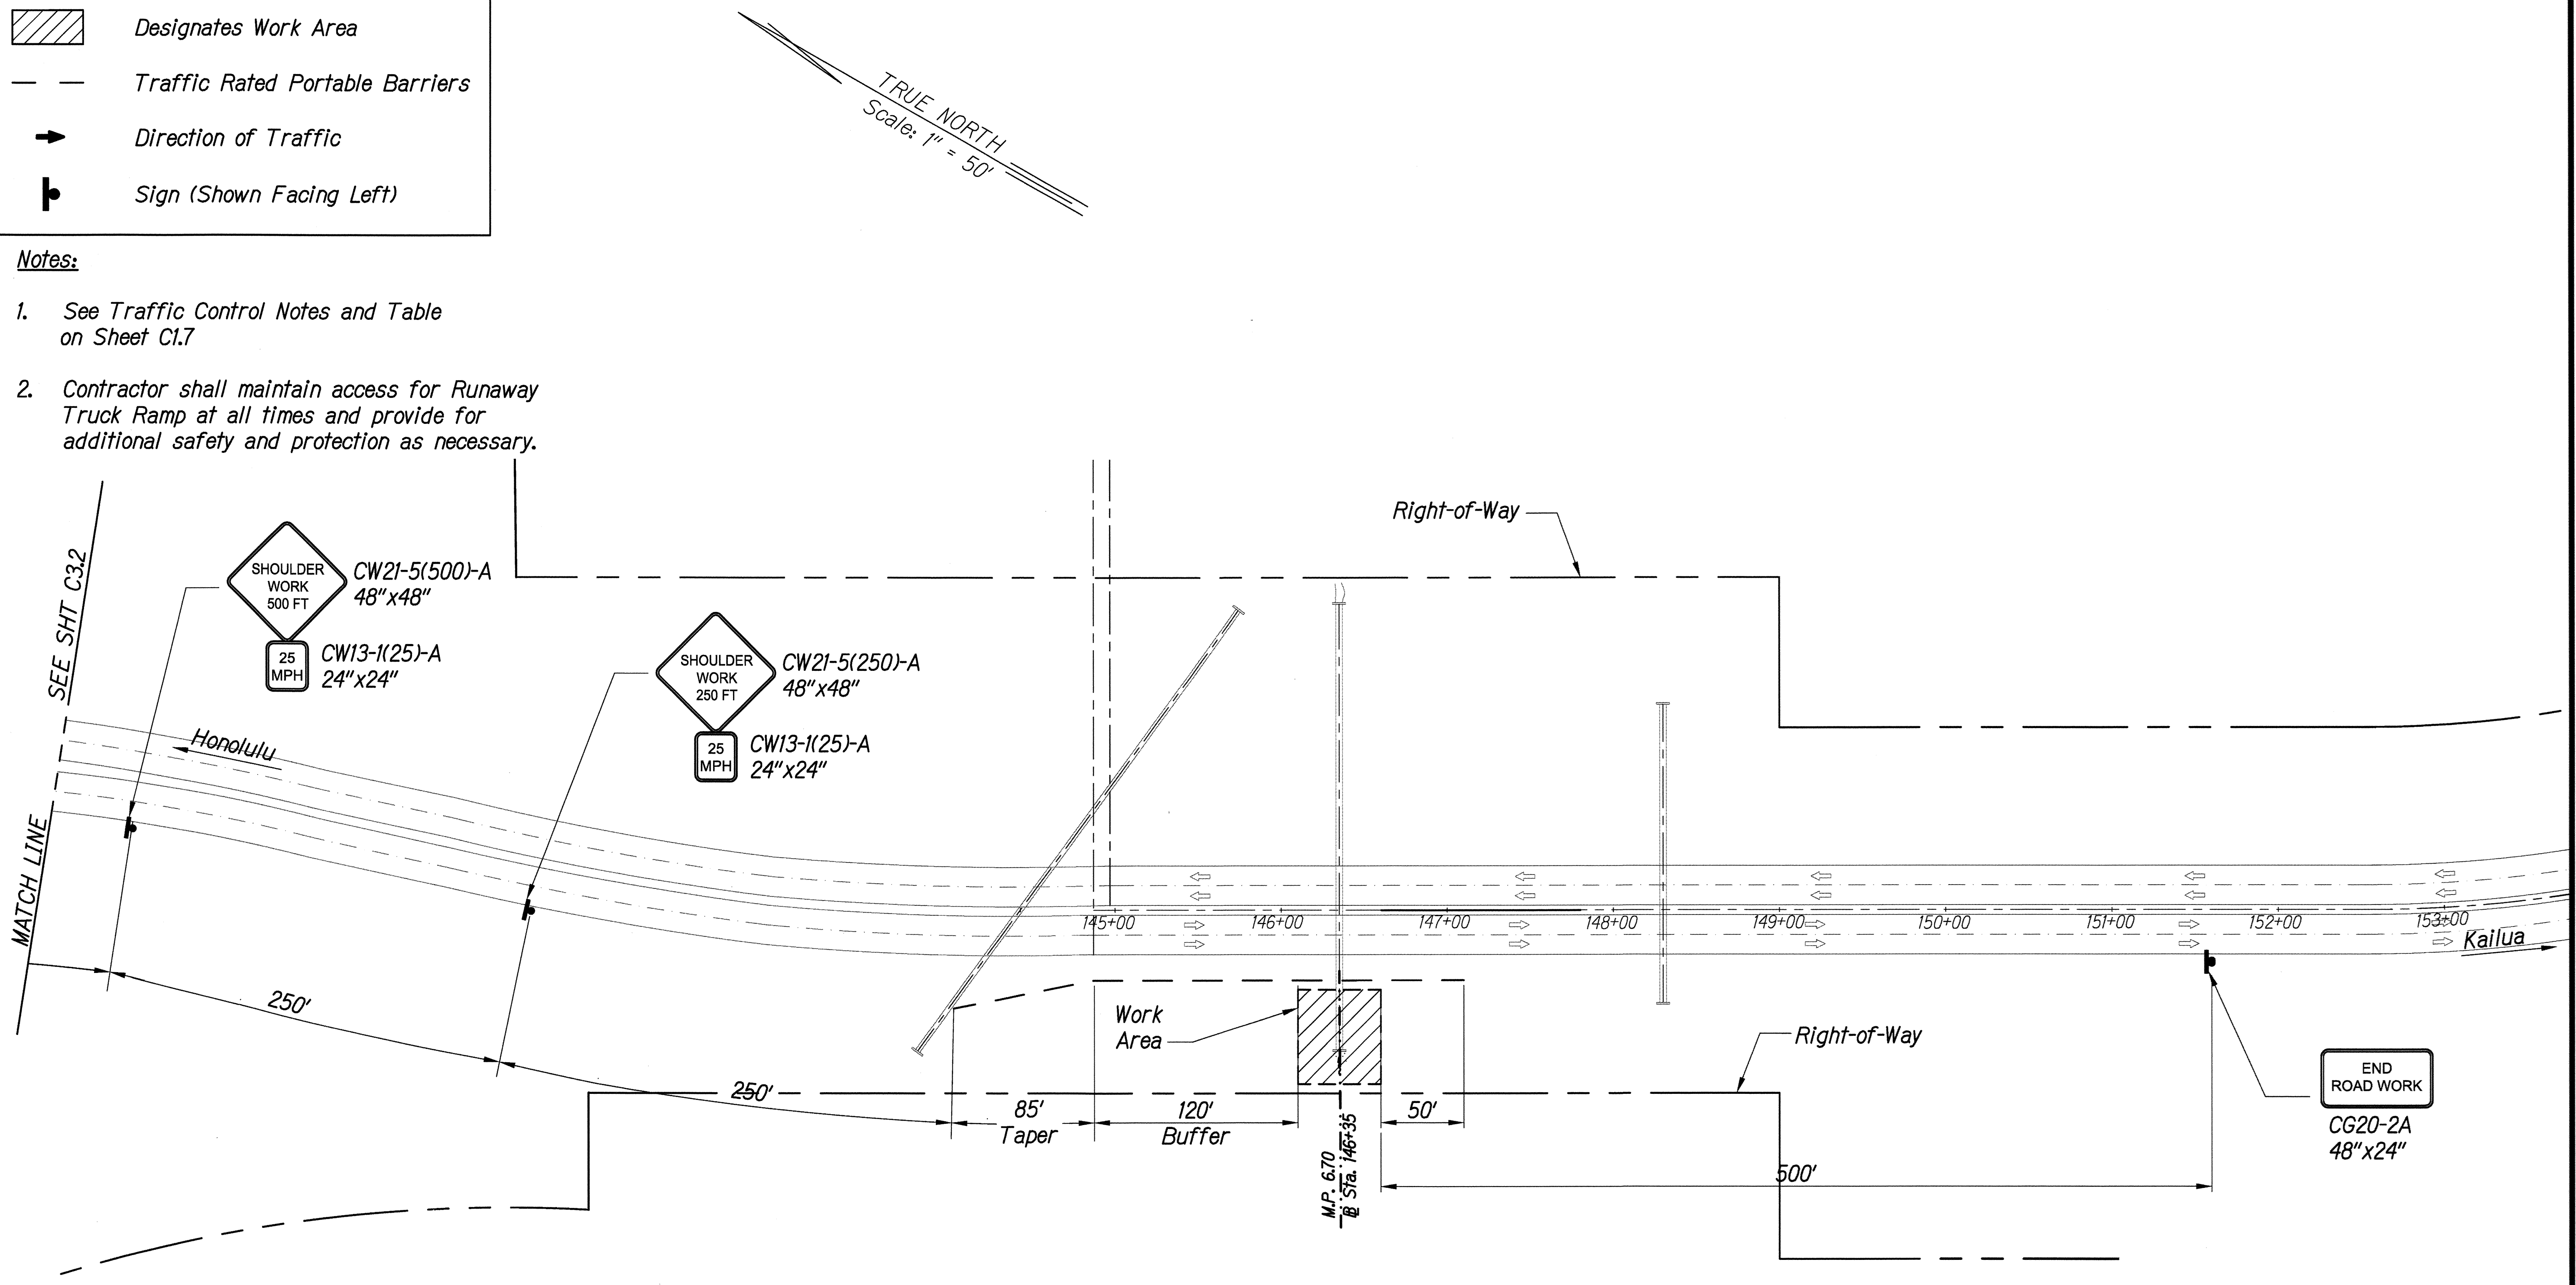

MILEPOST 6.70 (PALI HIGHWAY), TRAFFIC CONTROL PLAN  
Scale: 1" = 50'

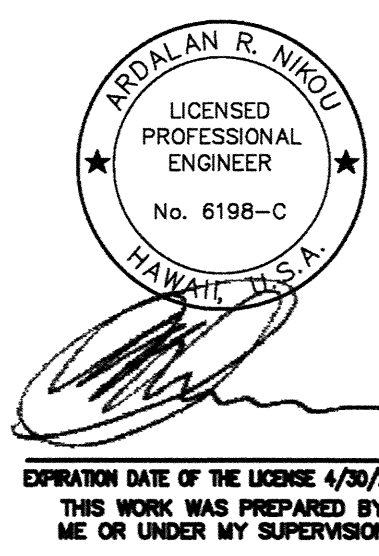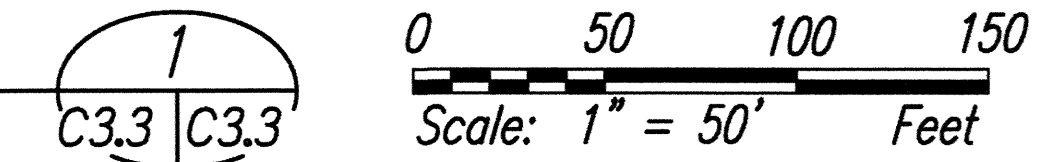

STATE OF HAWAII  
DEPARTMENT OF TRANSPORTATION  
HIGHWAYS DIVISION


**M.P. 6.70 (PALI HIGHWAY)**  
**TRAFFIC CONTROL PLAN-02**

CULVERT REMEDIATION AT VARIOUS  
LOCATIONS ON OAHU, PHASE 1  
Project No. HWY-0-06-14  
Scale: As Shown Date: March 2016


SHEET No. C3.3 OF 62 SHEETS



FED. ROAD DIST. NO.	STATE	PROJ. NO.	FISCAL YEAR	SHEET NO.	TOTAL SHEETS
HAWAII	HAW.	HWY-0-06-14	2016	30	62

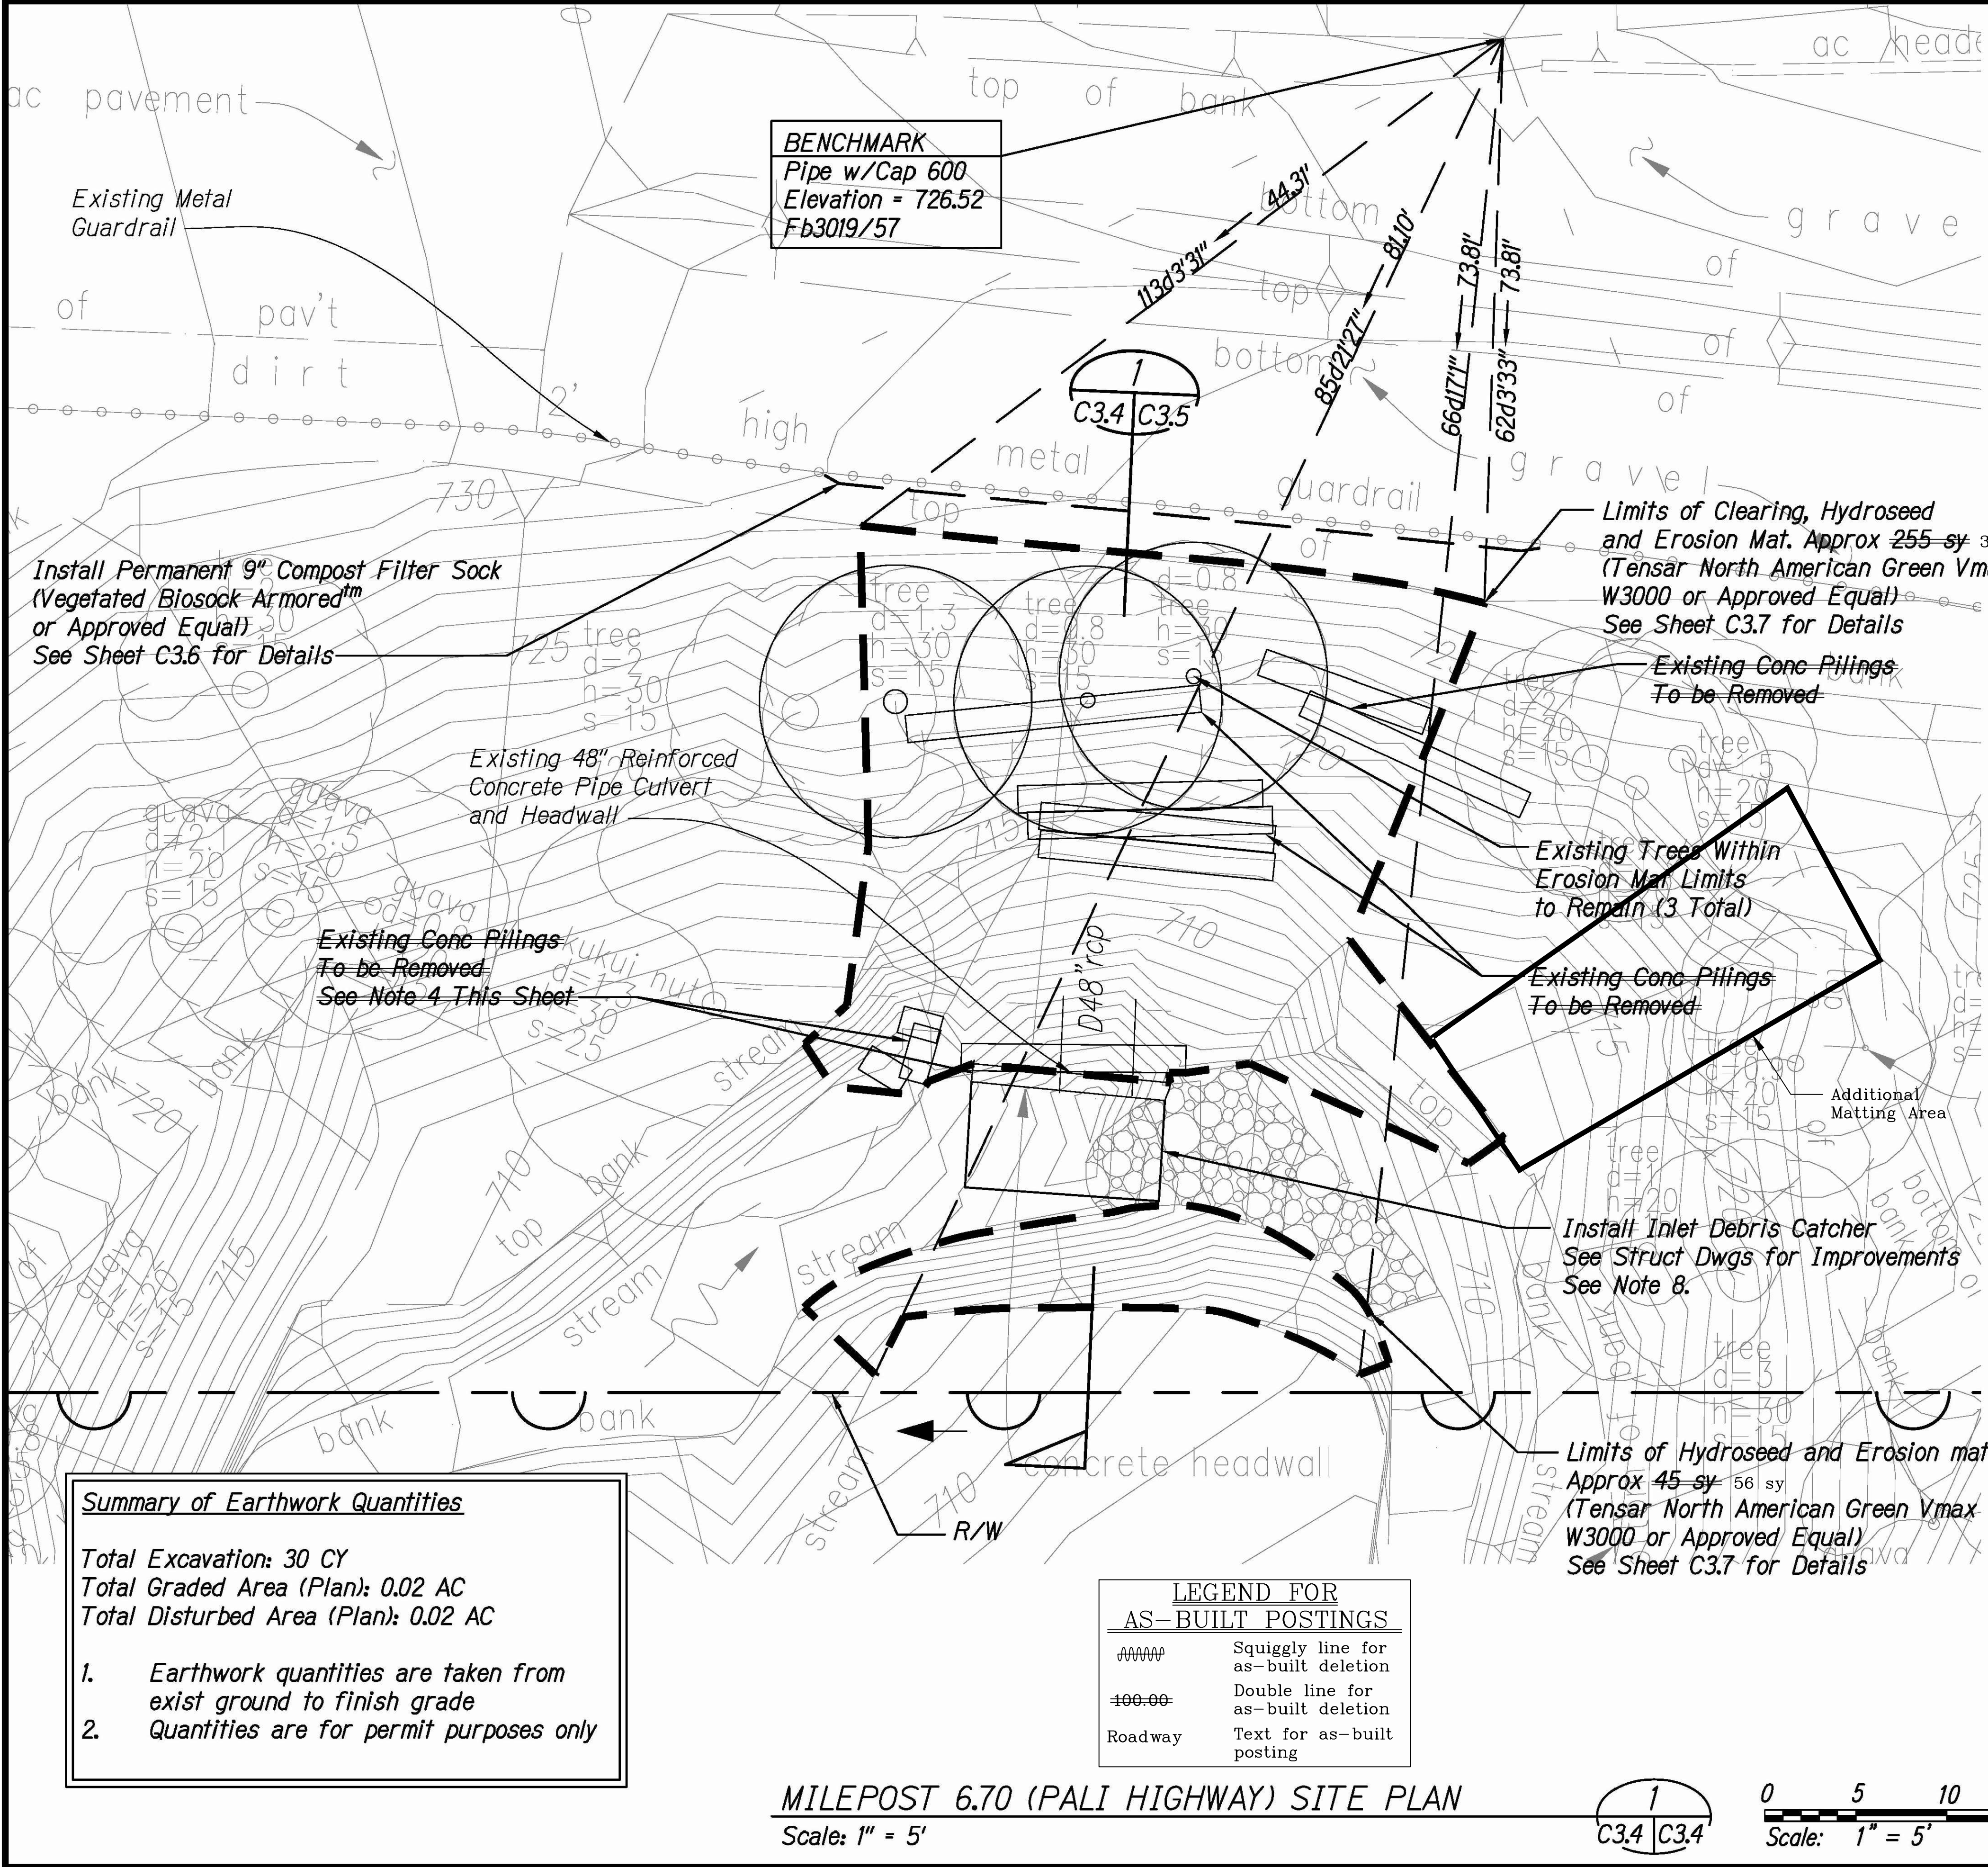

- Notes:**
- BMP's shall be in place and functional prior to the start of construction work and in accordance with sheet C1.6 and manufacturer's recommendations, whichever is more stringent.
  - Erosion Mat limits are shown in plan view. Contractor shall account for all slope irregularities when performing work and installing construction materials.
  - Unless otherwise noted on the plans, remove existing trees (12" in diameter or smaller) and vegetation within erosion mat limits, remove existing concrete pilings, grade back any vertical and/or overhanging soil areas, provide a smooth slope surface, and hydroseed prior to erosion mat installation.
  - Removal and disposal of cut trees, vegetation, and concrete pilings at an approved location shall be done at no additional cost to the State.
  - Contractor shall provide a detail for installation of erosion mat around protected trees identified on the plan per manufacturer recommendations for review by the Engineer.
  - Contractor shall stake-out the proposed erosion mat areas in the field for review and approval by the Engineer prior to erosion mat installation.
  - Contractor shall maintain access and clearance to existing Runaway Truck Ramp at all times during construction.
  - Contractor shall exercise caution when removing the existing rock buildup for the inlet debris catcher installation (see structural drawings for details). Any rock removal by the Contractor that exposes bare soil or creates an unstable situation shall be immediately brought to the attention of the Engineer for corrective action.

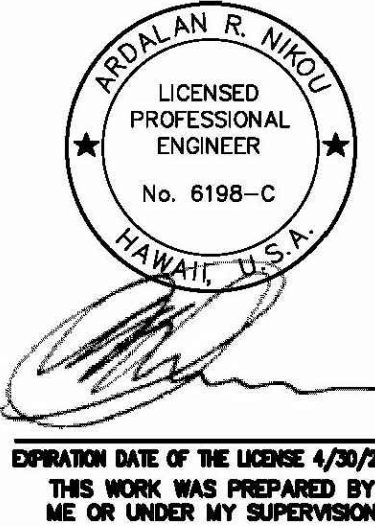

STATE OF HAWAII  
DEPARTMENT OF TRANSPORTATION  
HIGHWAYS DIVISION


**M.P. 6.70 (PALI HIGHWAY)**  
**SITE PLAN**

CULVERT REMEDIATION AT VARIOUS  
LOCATIONS ON OAHU, PHASE 1  
Project No. HWY-0-06-14  
Scale: As Shown Date: March 2016


SHEET No. C34 OF 62 SHEETS



FED. ROAD DIST. NO.	STATE	PROJ. NO.	FISCAL YEAR	SHEET NO.	TOTAL SHEETS
HAWAII	HAW.	HWY-0-06-14	2016	31	62


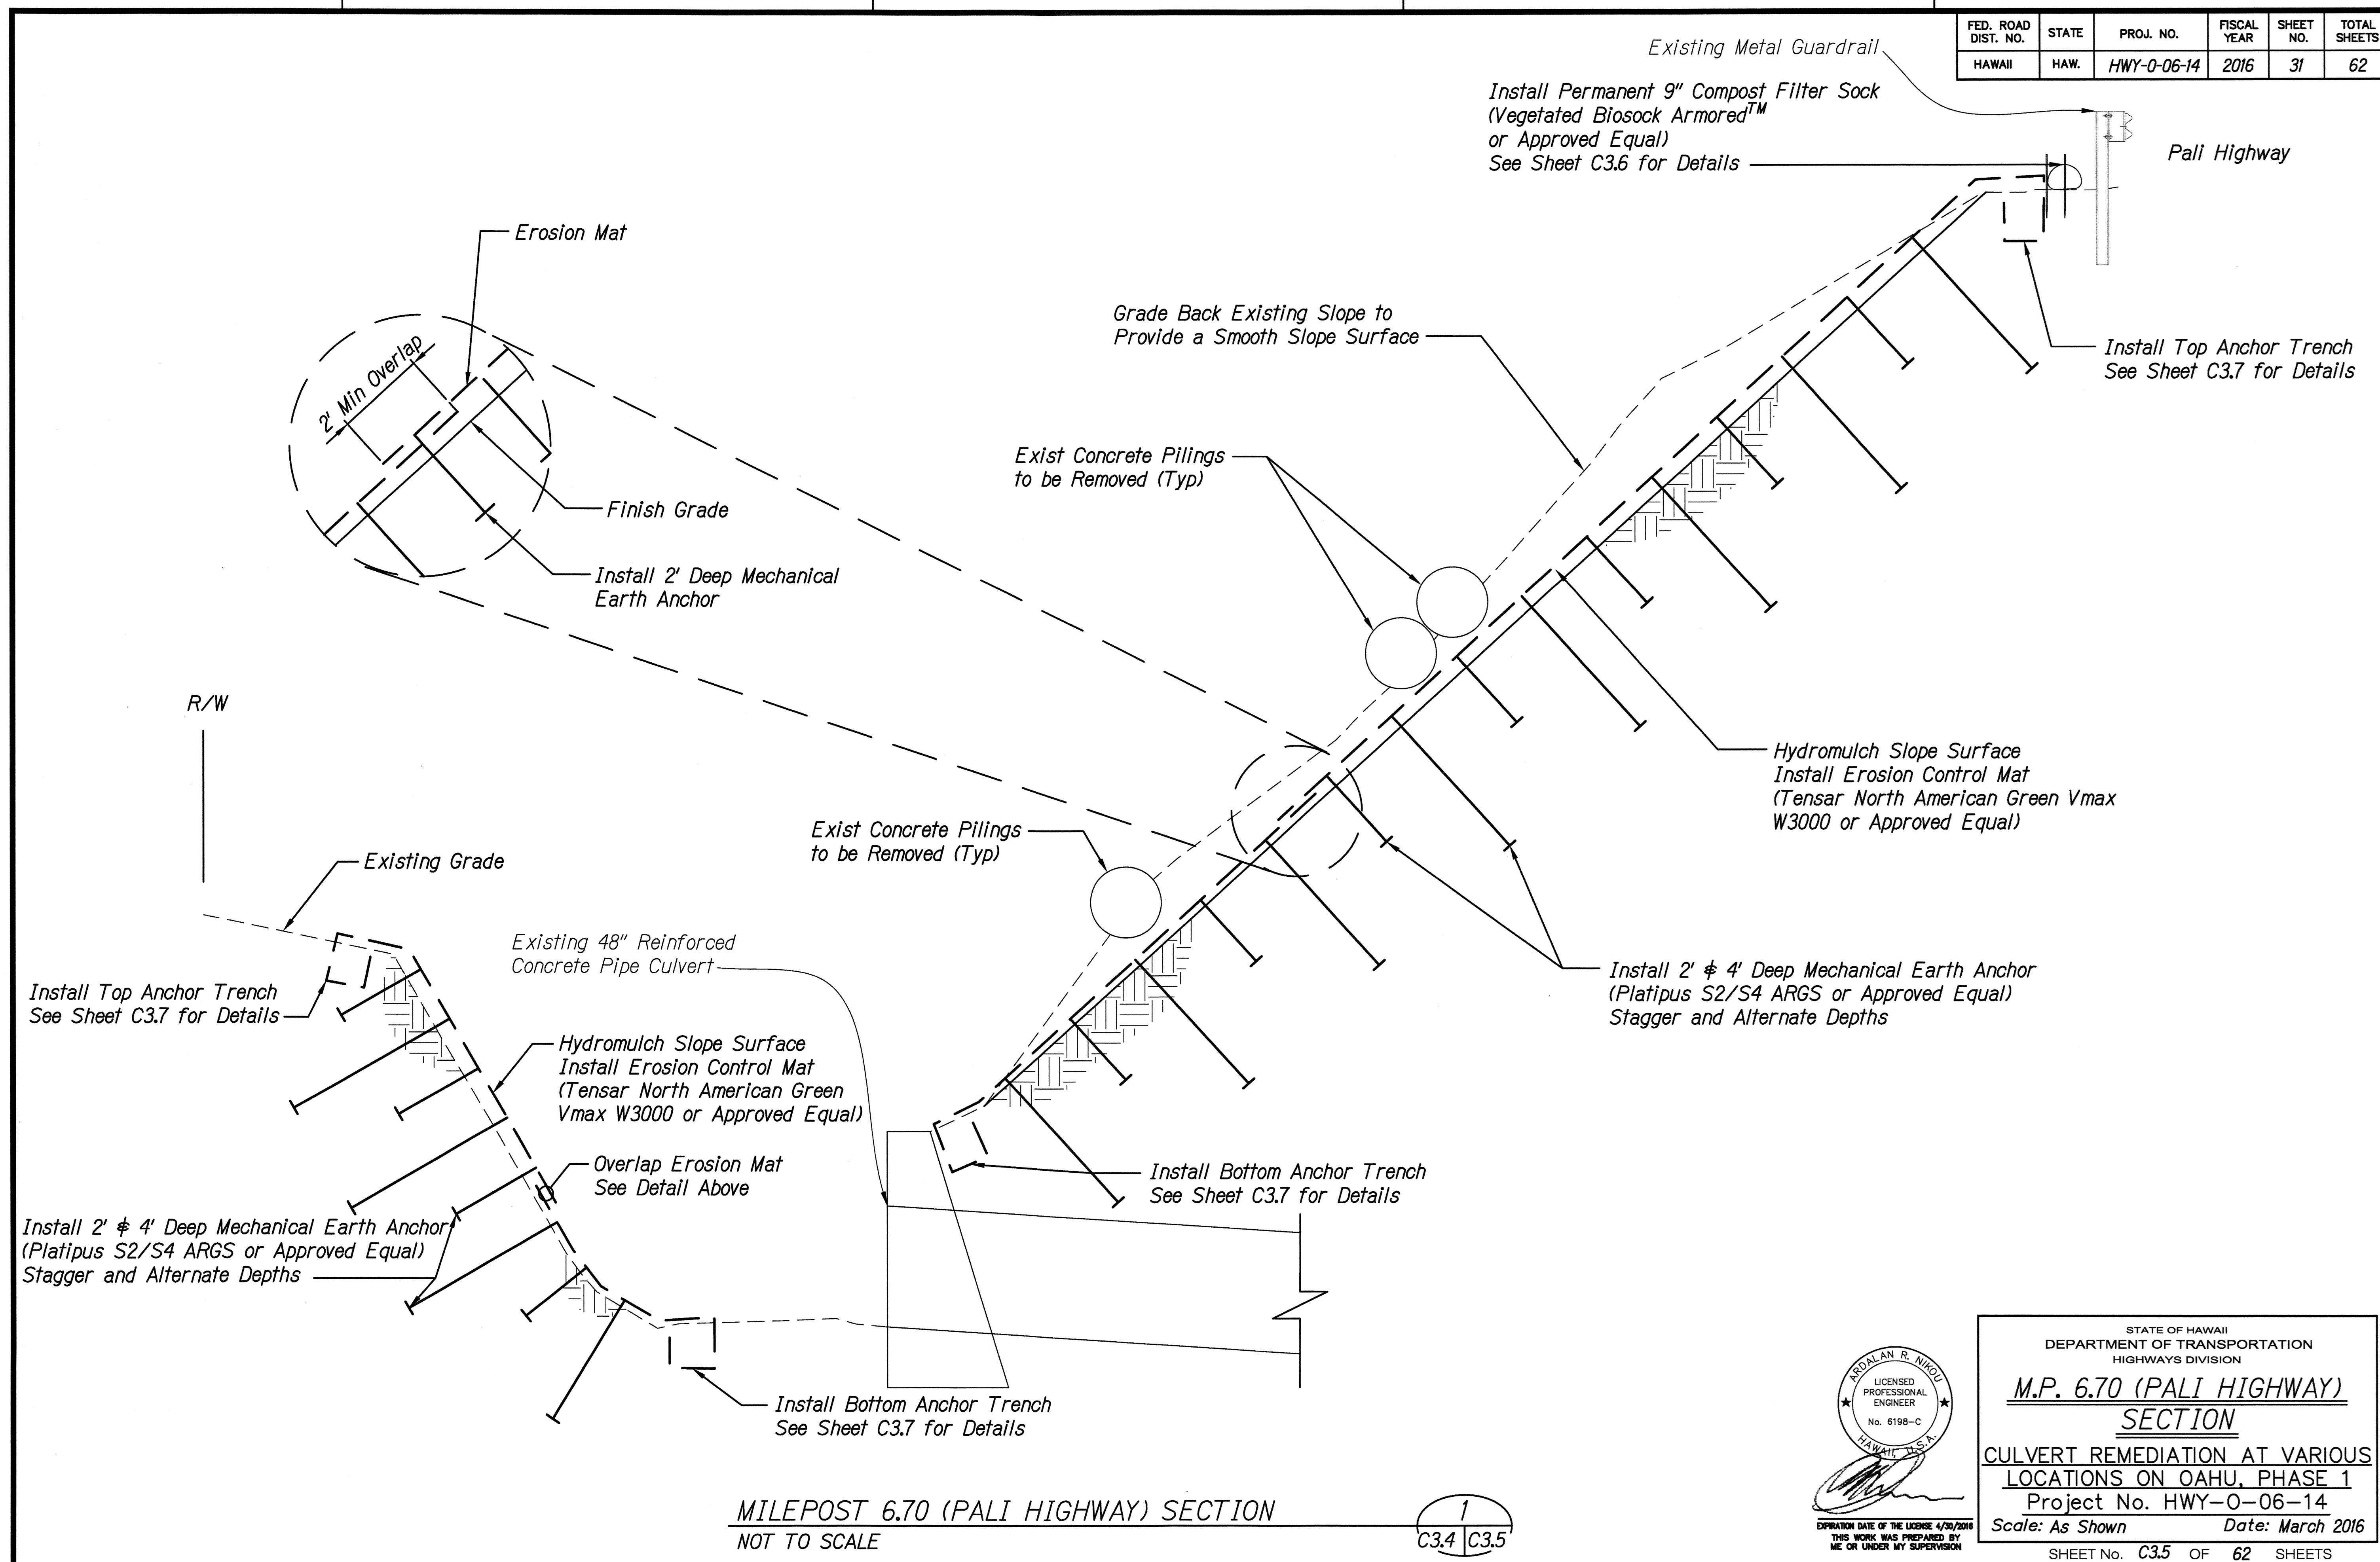


FED. ROAD DIST. NO.	STATE	PROJ. NO.	FISCAL YEAR	SHEET NO.	TOTAL SHEETS
HAWAII	HAW.	HWY-0-06-14	2016	32	62

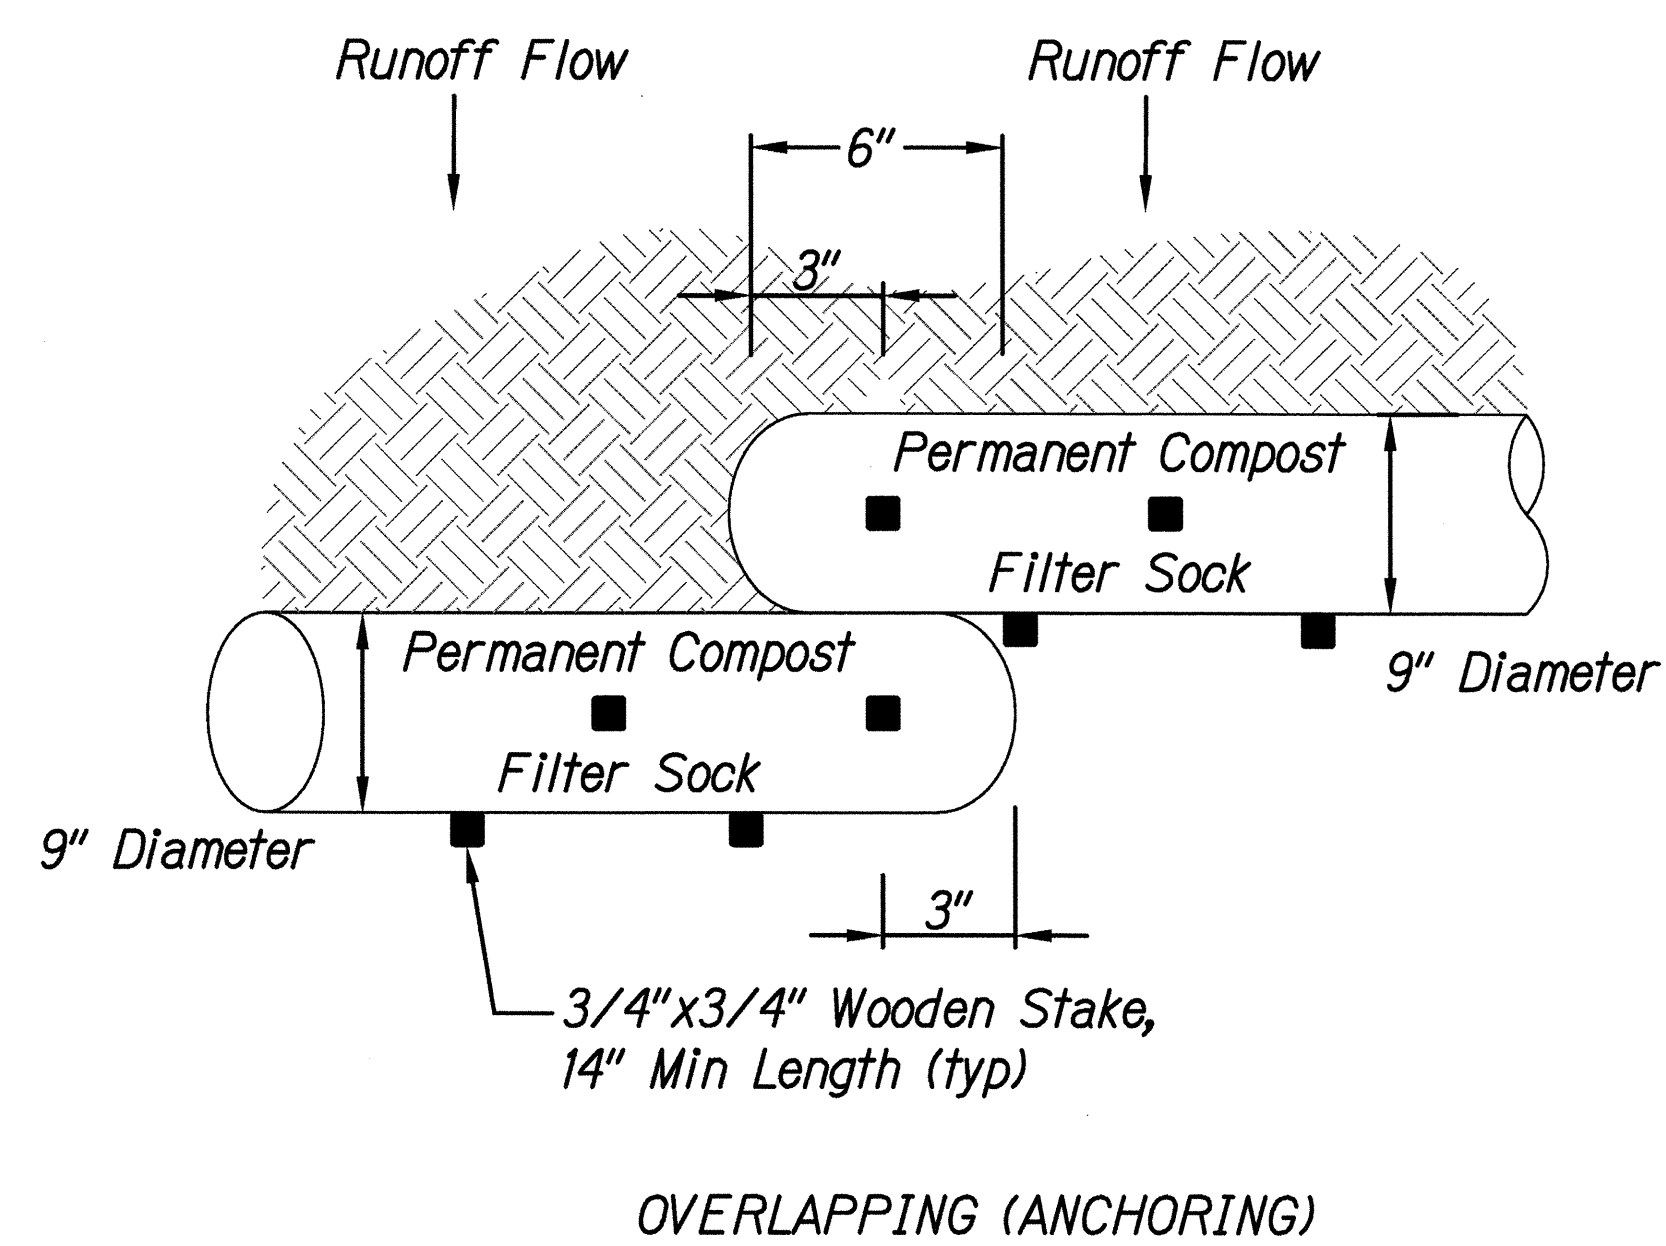



### Compost Filter Sock Notes:

1. Permanent compost filter sock adjacent to guardrail at top of slope shall be vegetated with seed and wrapped with a bi-axial geogrid (Vegetated Biosock Armored™ or approved equal).
2. Details provided as a minimum requirement. Contractor also to adhere to manufacturer's installation instructions.
3. Compost shall not contain biosolids and should be consistent with EPA guidelines.

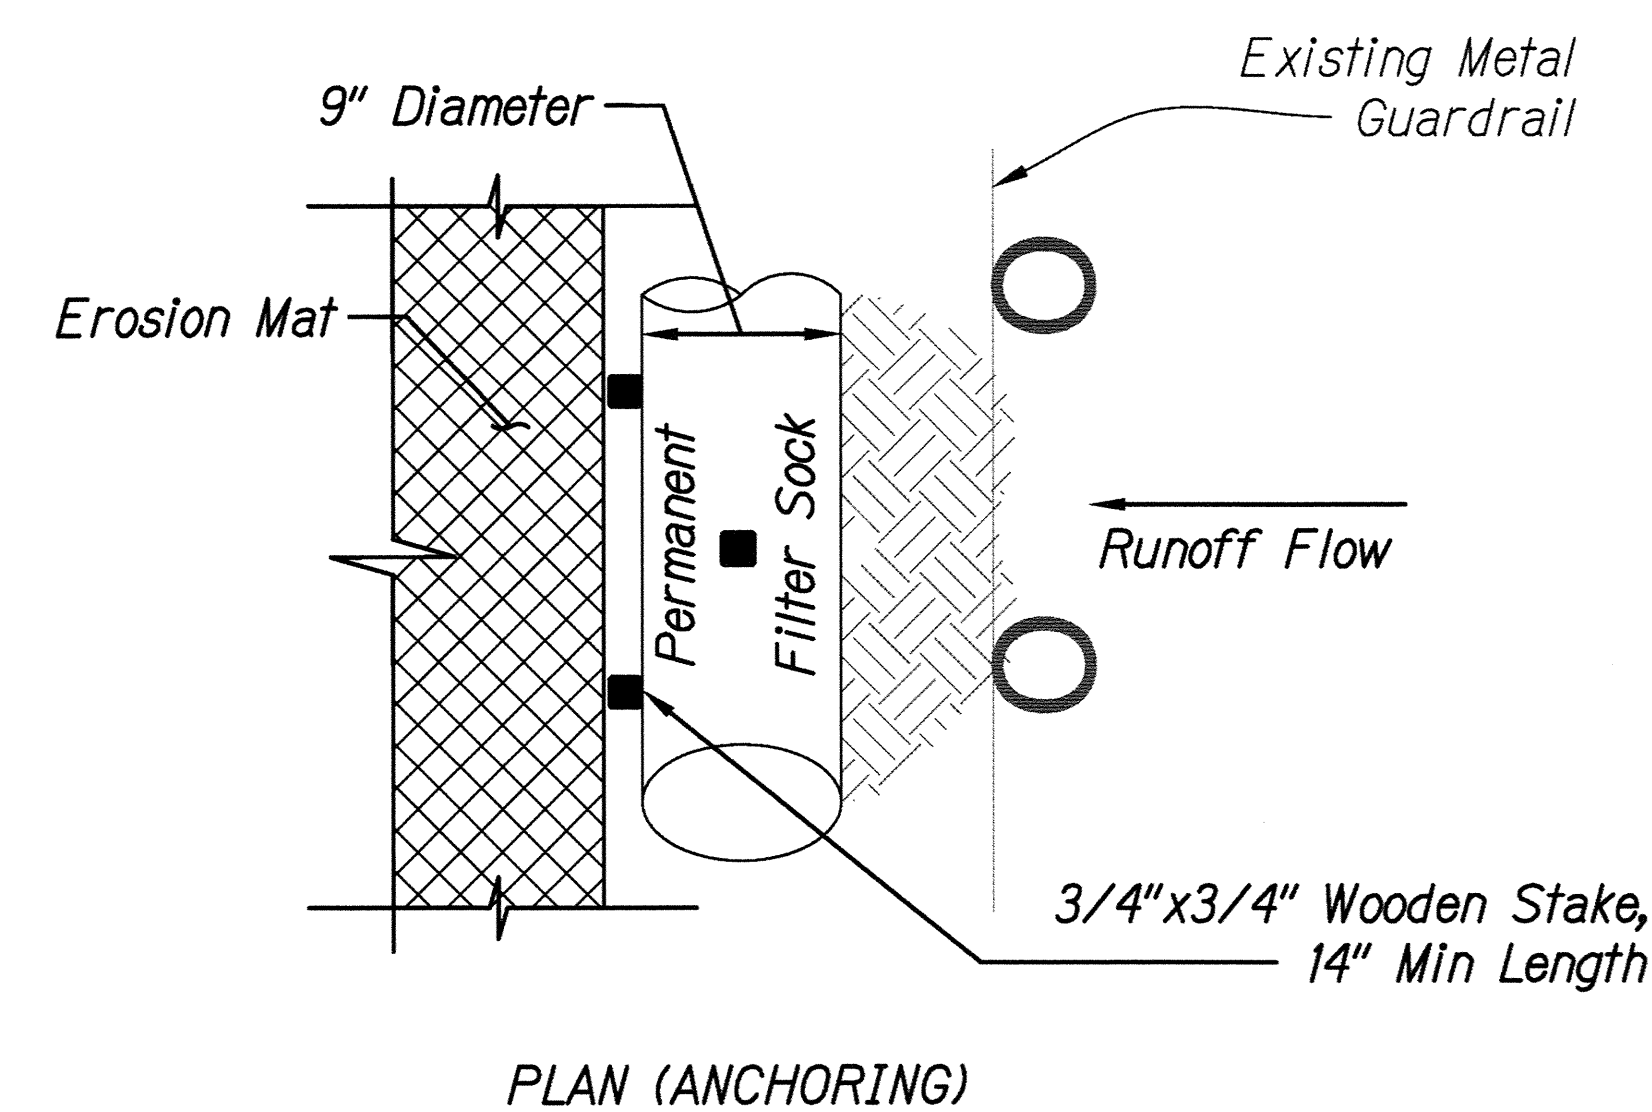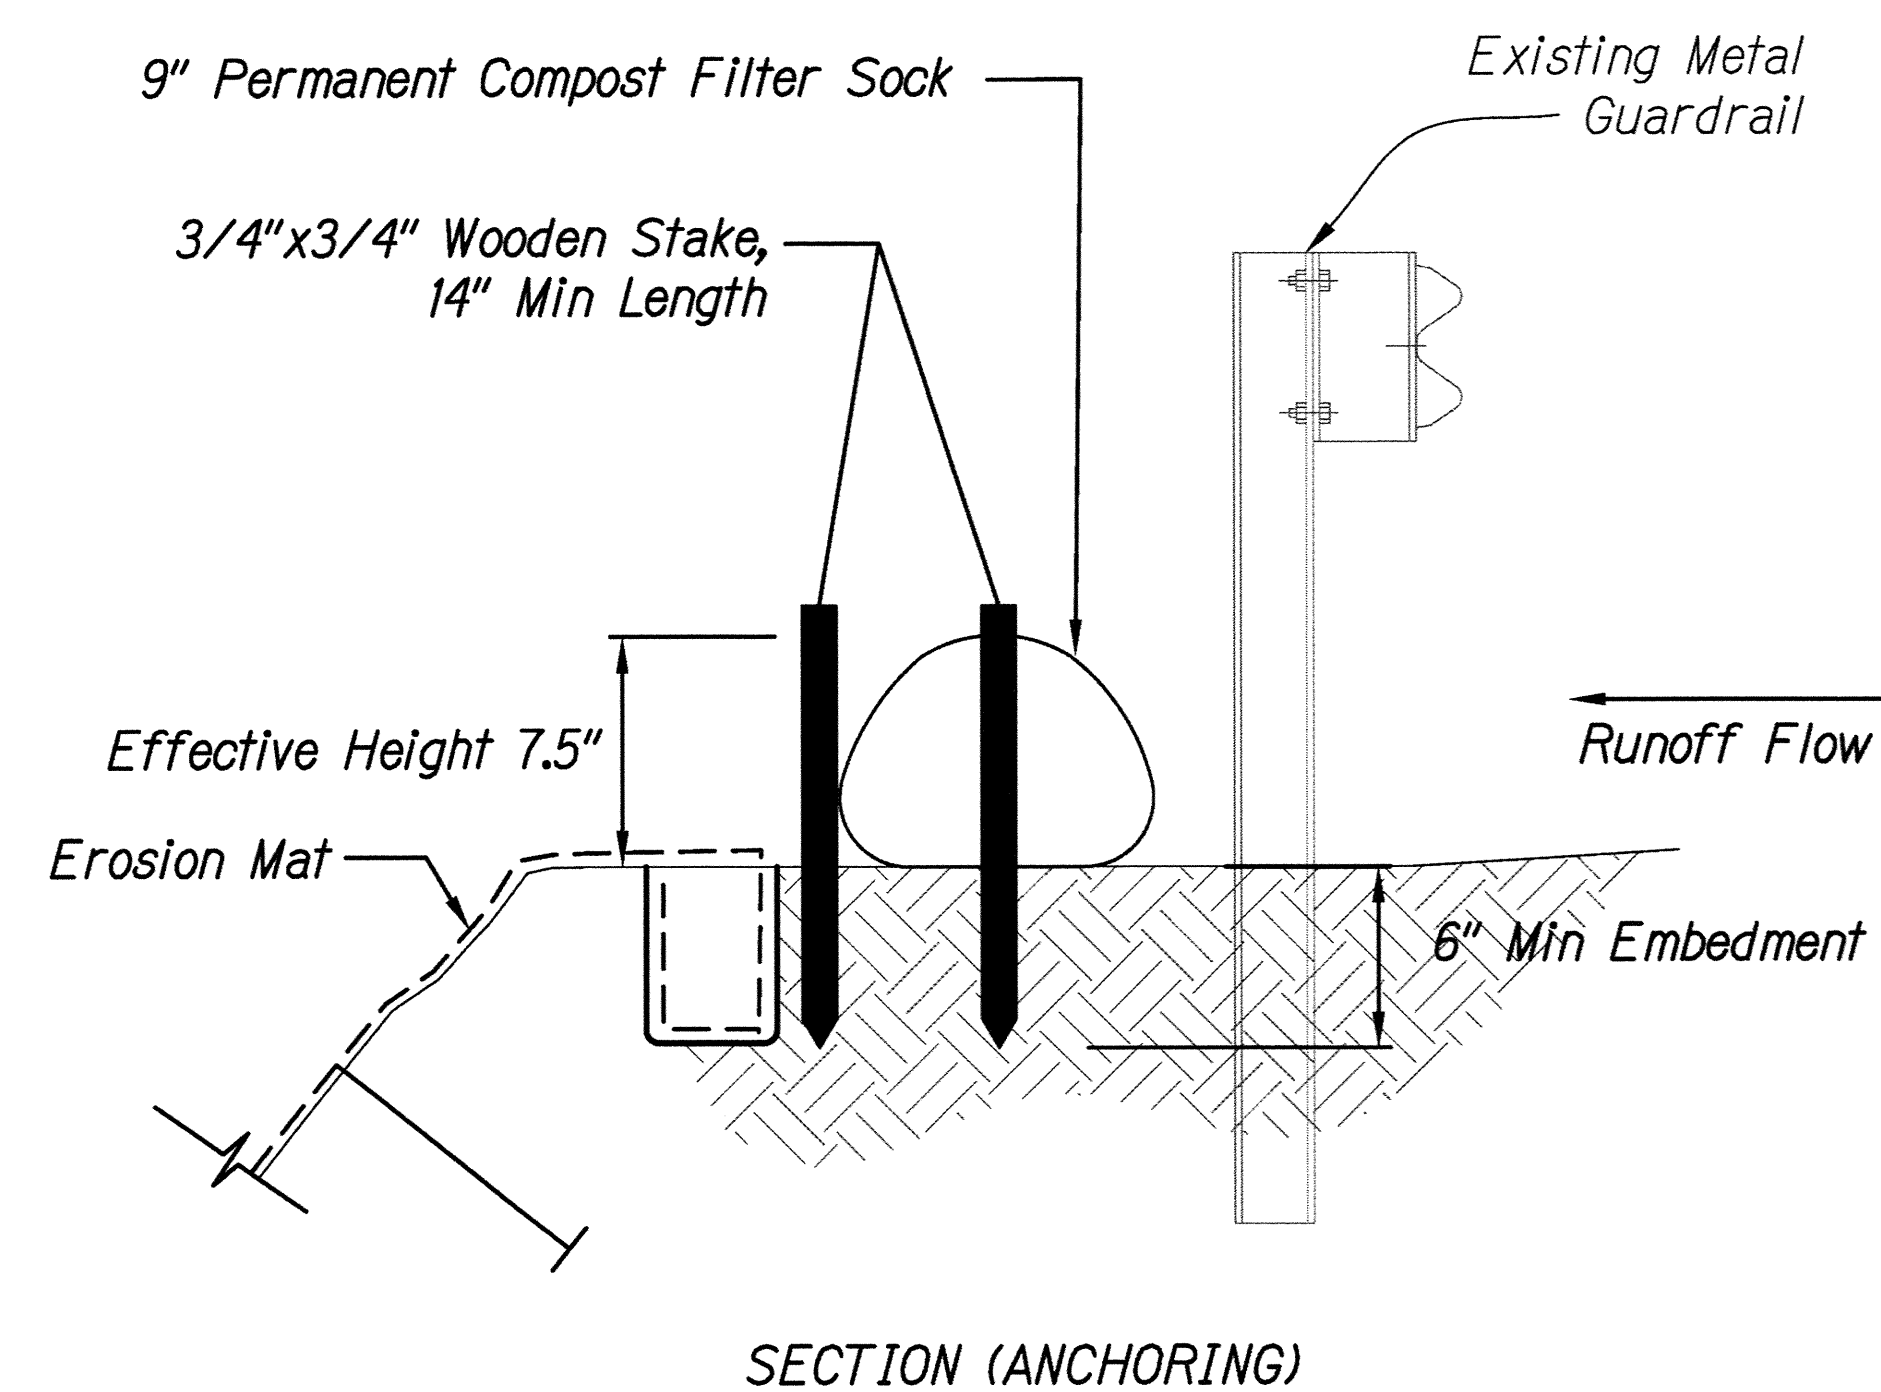

### COMPOST FILTER SOCK DETAILS

Not to Scale

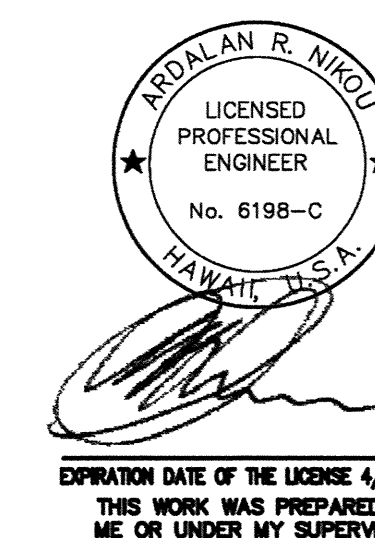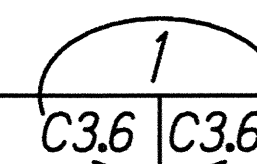

STATE OF HAWAII  
DEPARTMENT OF TRANSPORTATION  
HIGHWAYS DIVISION





**COMPOST FILTER  
SOCK DETAILS**

CULVERT REMEDIATION AT VARIOUS  
LOCATIONS ON OAHU, PHASE 1  
Project No. HWY-0-06-14  
Scale: As Shown Date: March 2016

SHEET No. C3.6 OF 62 SHEETS



FED. ROAD DIST. NO.	STATE	PROJ. NO.	FISCAL YEAR	SHEET NO.	TOTAL SHEETS
HAWAII	HAW.	HWY-0-06-14	2016	33	62

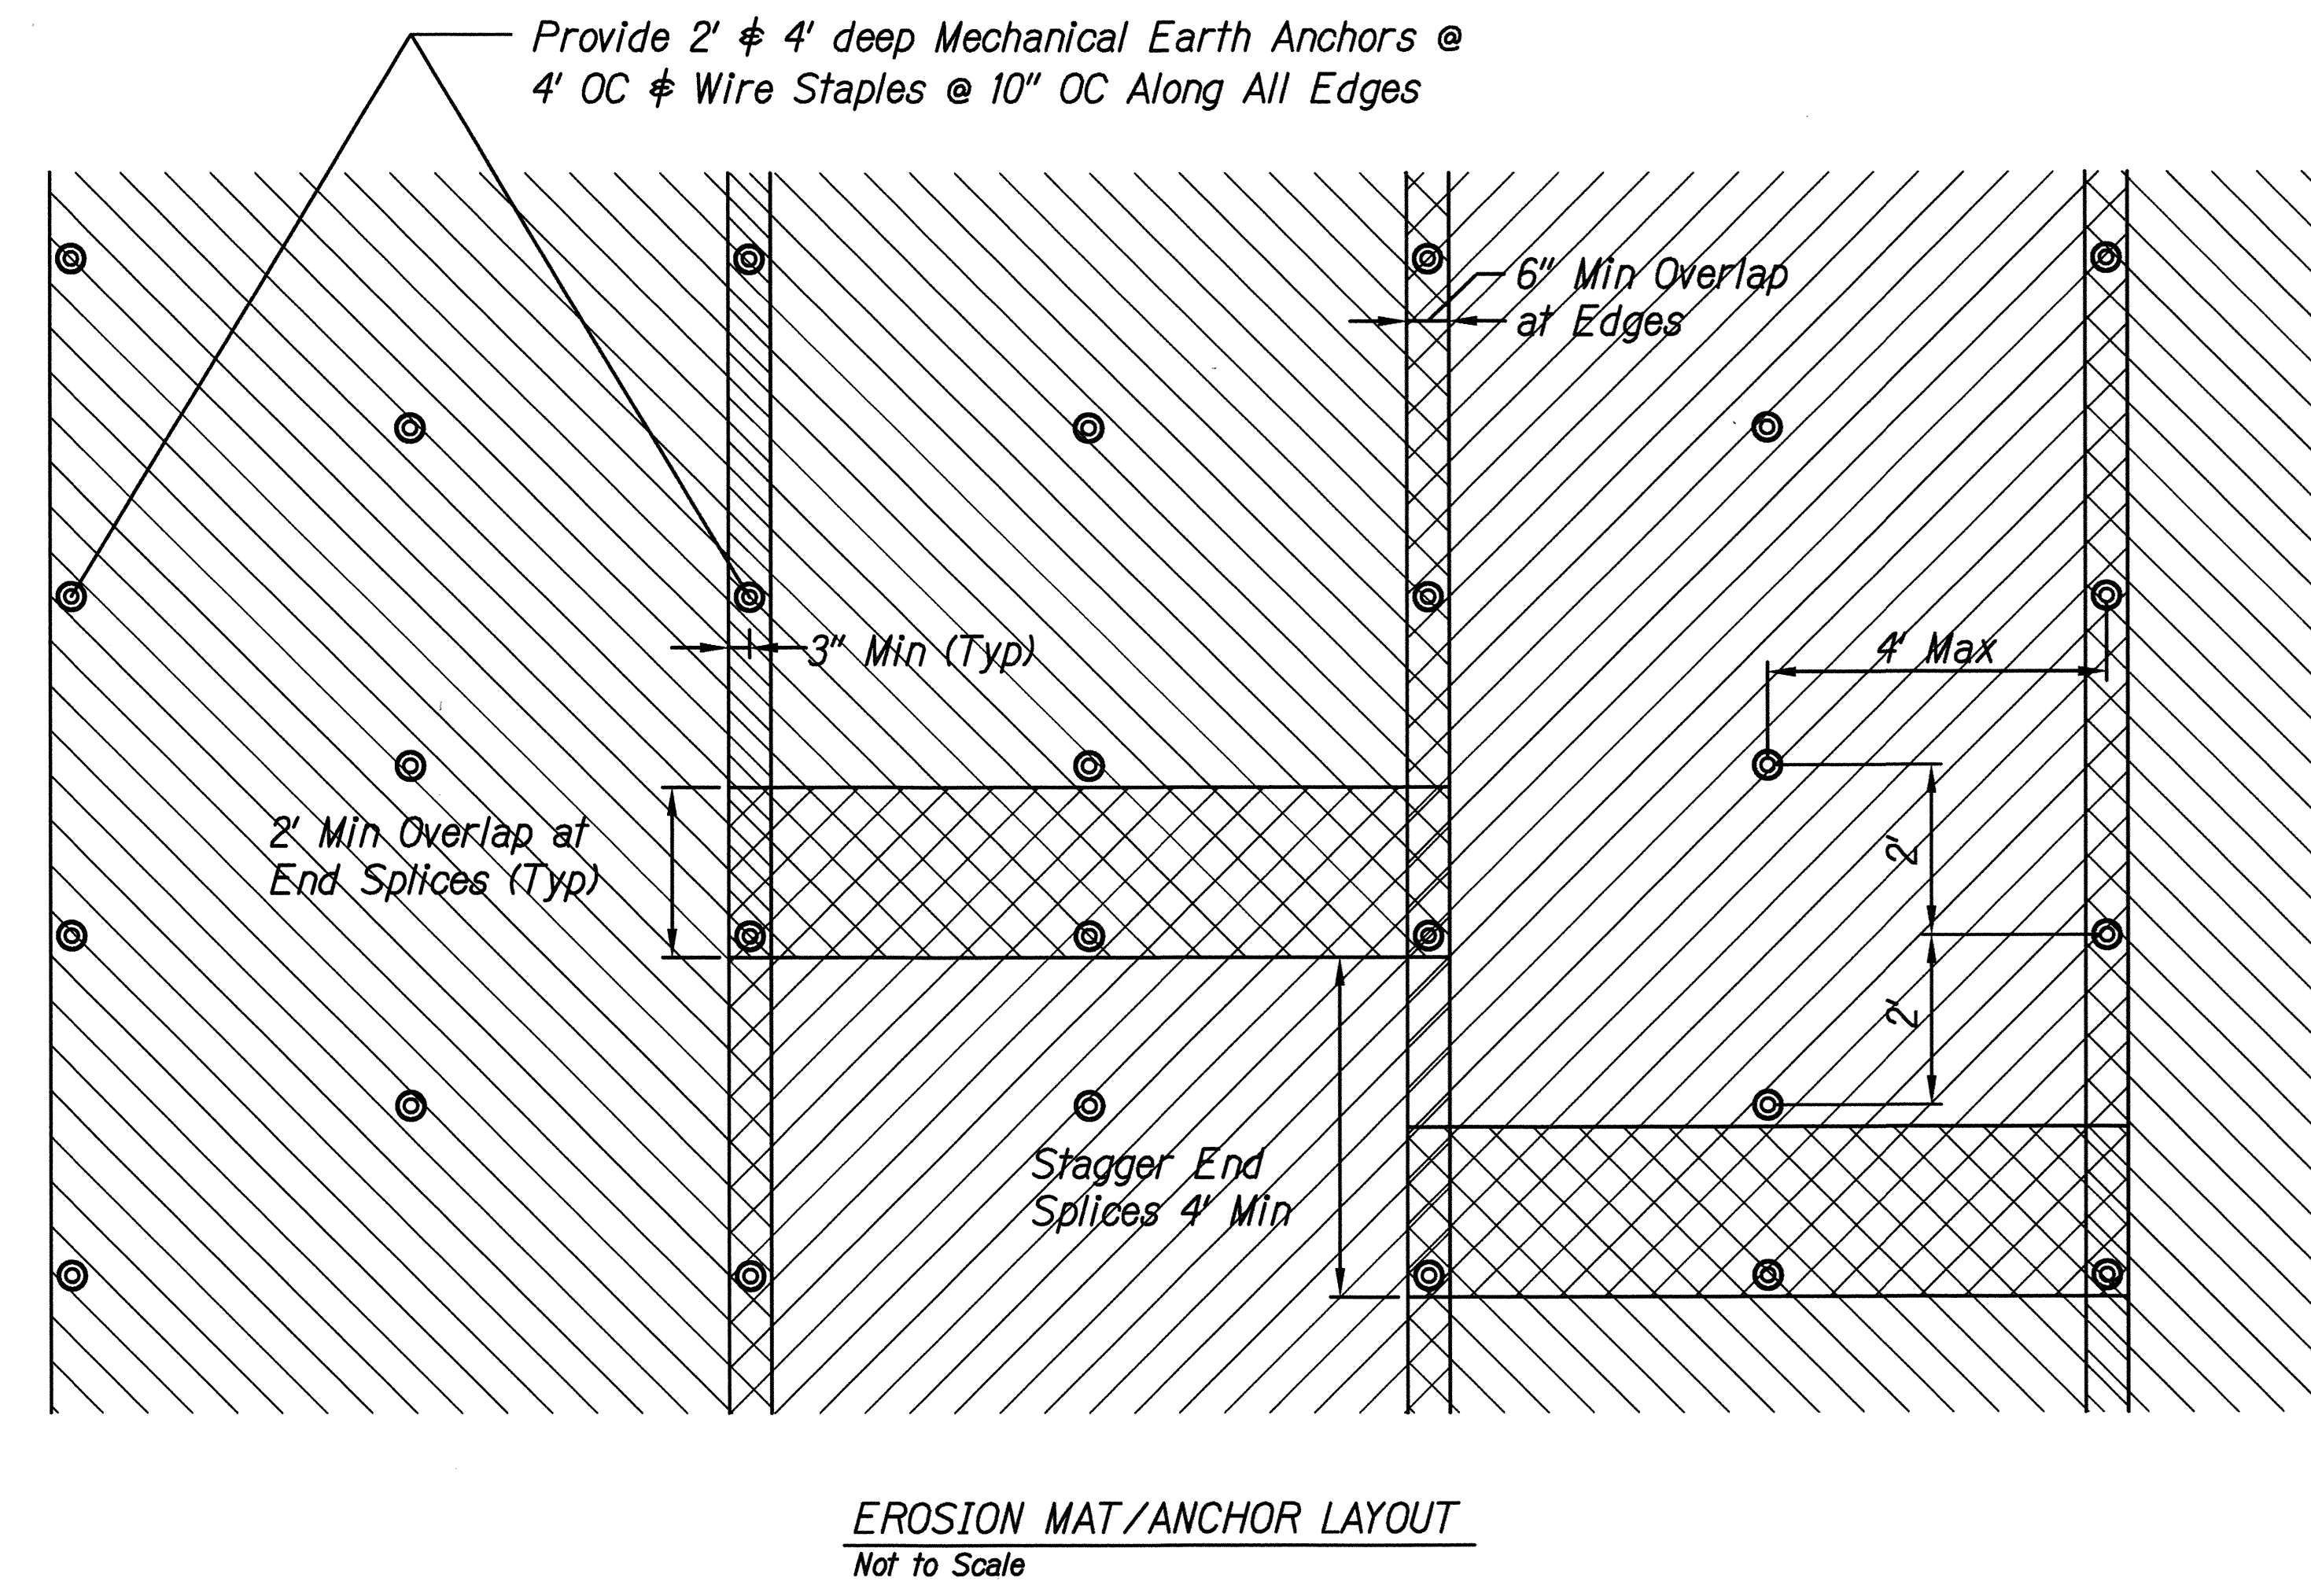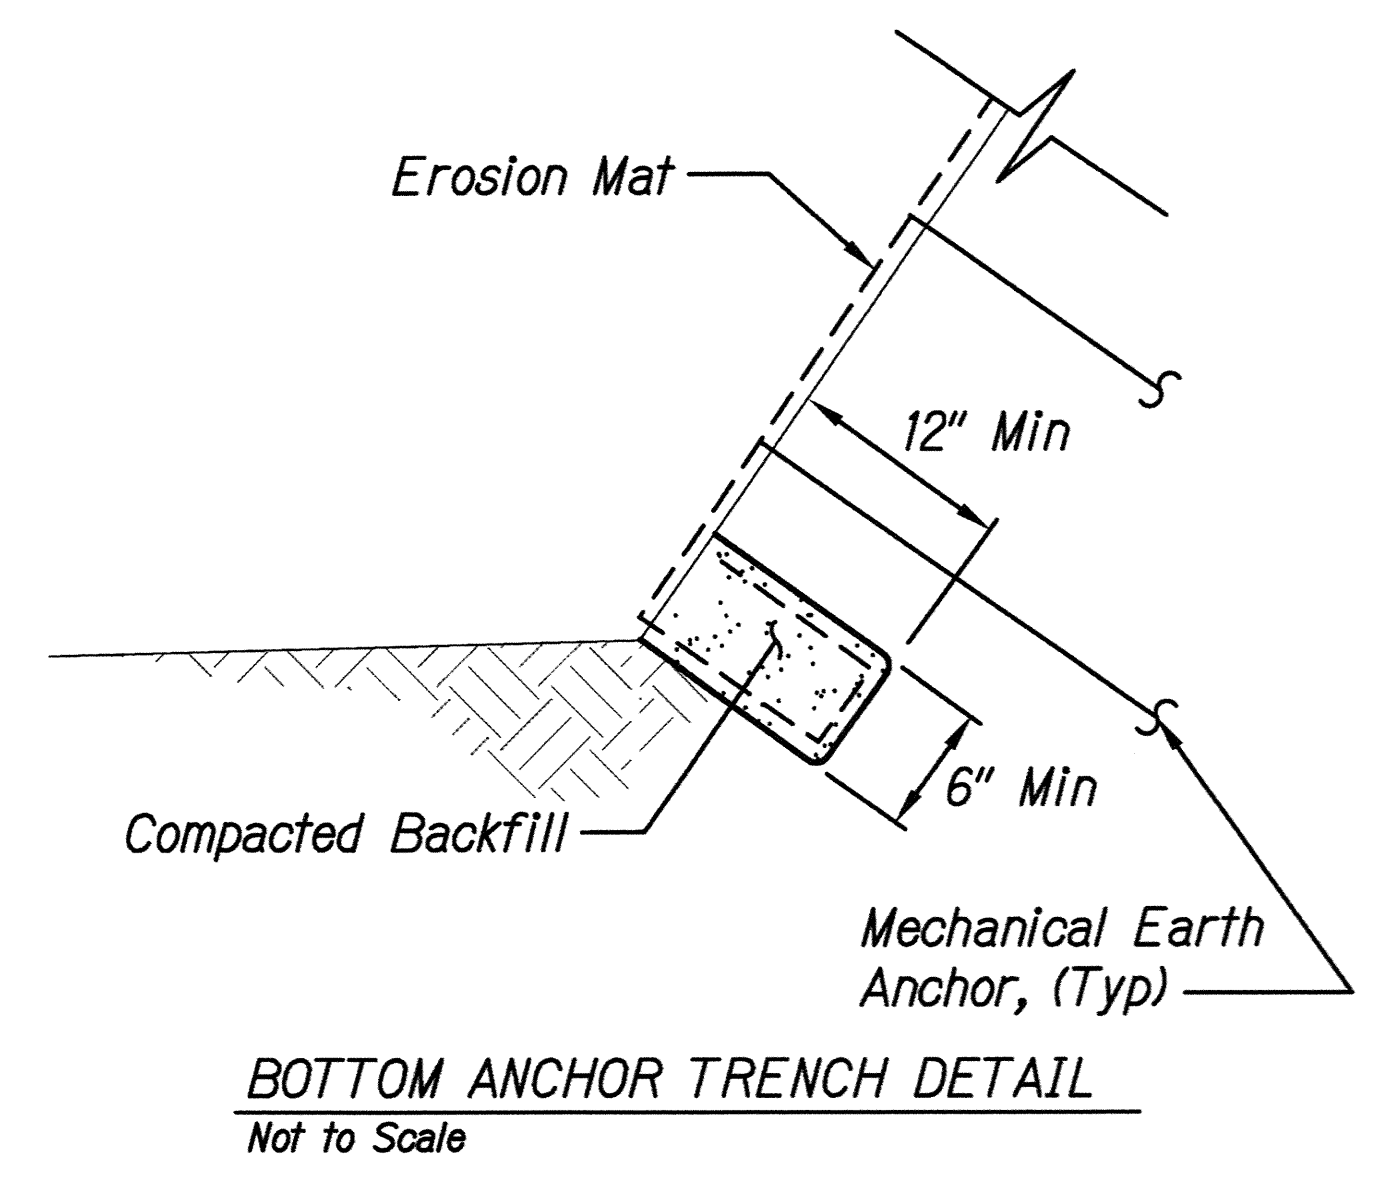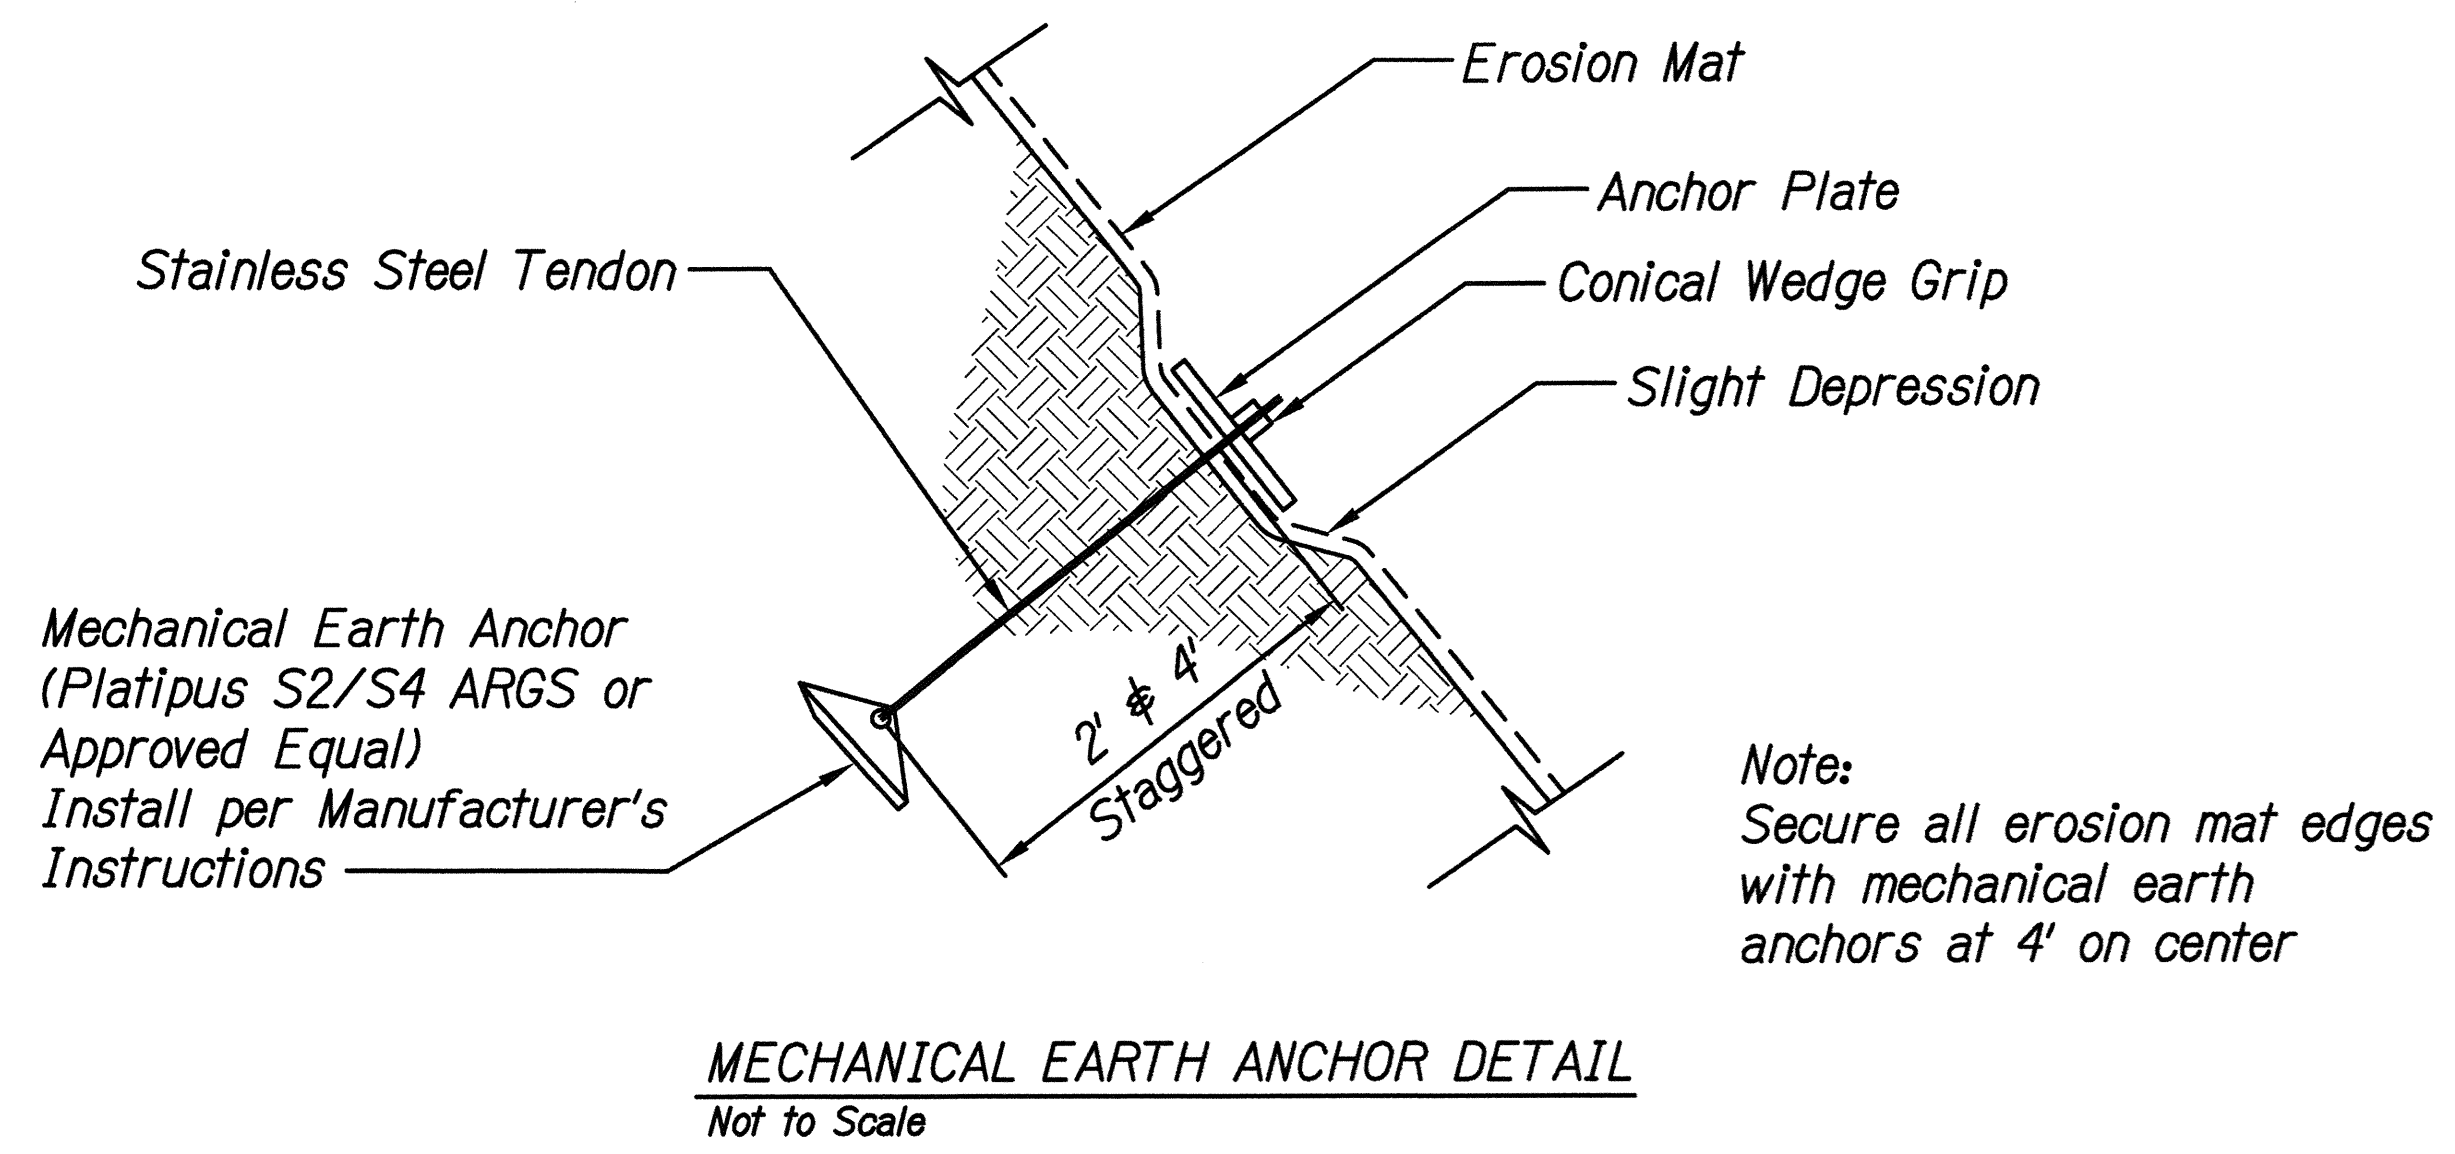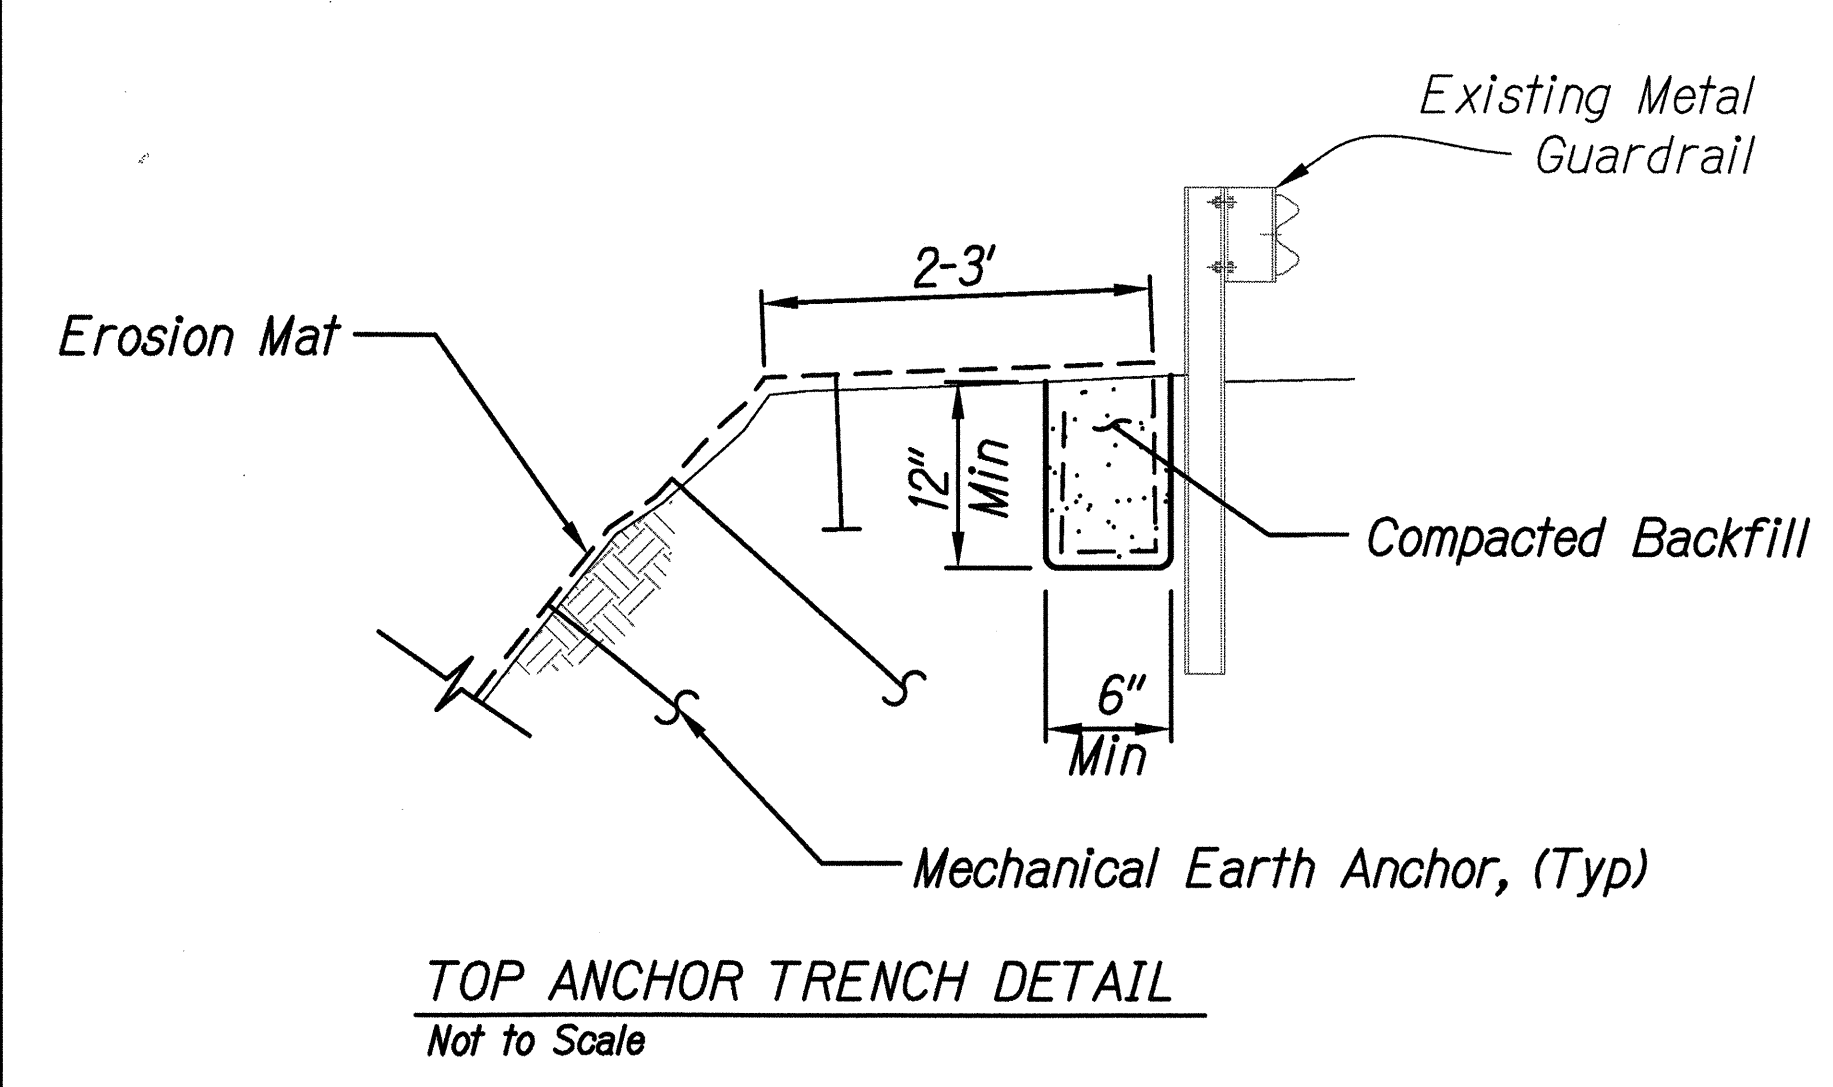

EROSION MAT DETAILS  
Not to Scale

1  
C3.7 C3.7

ARJALAN R. NIKOU  
LICENSED PROFESSIONAL ENGINEER  
No. 6198-C  
HAWAII, U.S.A.

EXPIRATION DATE OF THE LICENSE 4/30/2016  
THIS WORK WAS PREPARED BY ME OR UNDER MY SUPERVISION

STATE OF HAWAII  
DEPARTMENT OF TRANSPORTATION  
HIGHWAYS DIVISION

EROSION MAT DETAILS  
CULVERT REMEDIATION AT VARIOUS LOCATIONS ON OAHU, PHASE 1  
Project No. HWY-0-06-14  
Scale: As Shown      Date: March 2016

SHEET No. C3.7 OF 62 SHEETS