
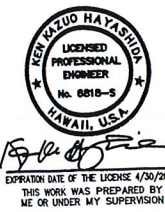


P:\Drafting\2016-05-12_2372 Culvert Inspections\2015-02-04_2372 Culvert Inspections Pkg 1\2372_S3-2.dwg, 5/12/2016 11:23:53 AM, tamanaha

FED. ROAD DIST. NO.	STATE	PROJ. NO.	FISCAL YEAR	SHEET NO.	TOTAL SHEETS
HAWAII	HAW.	HWY-0-06-14	2016	ADD. 23	62

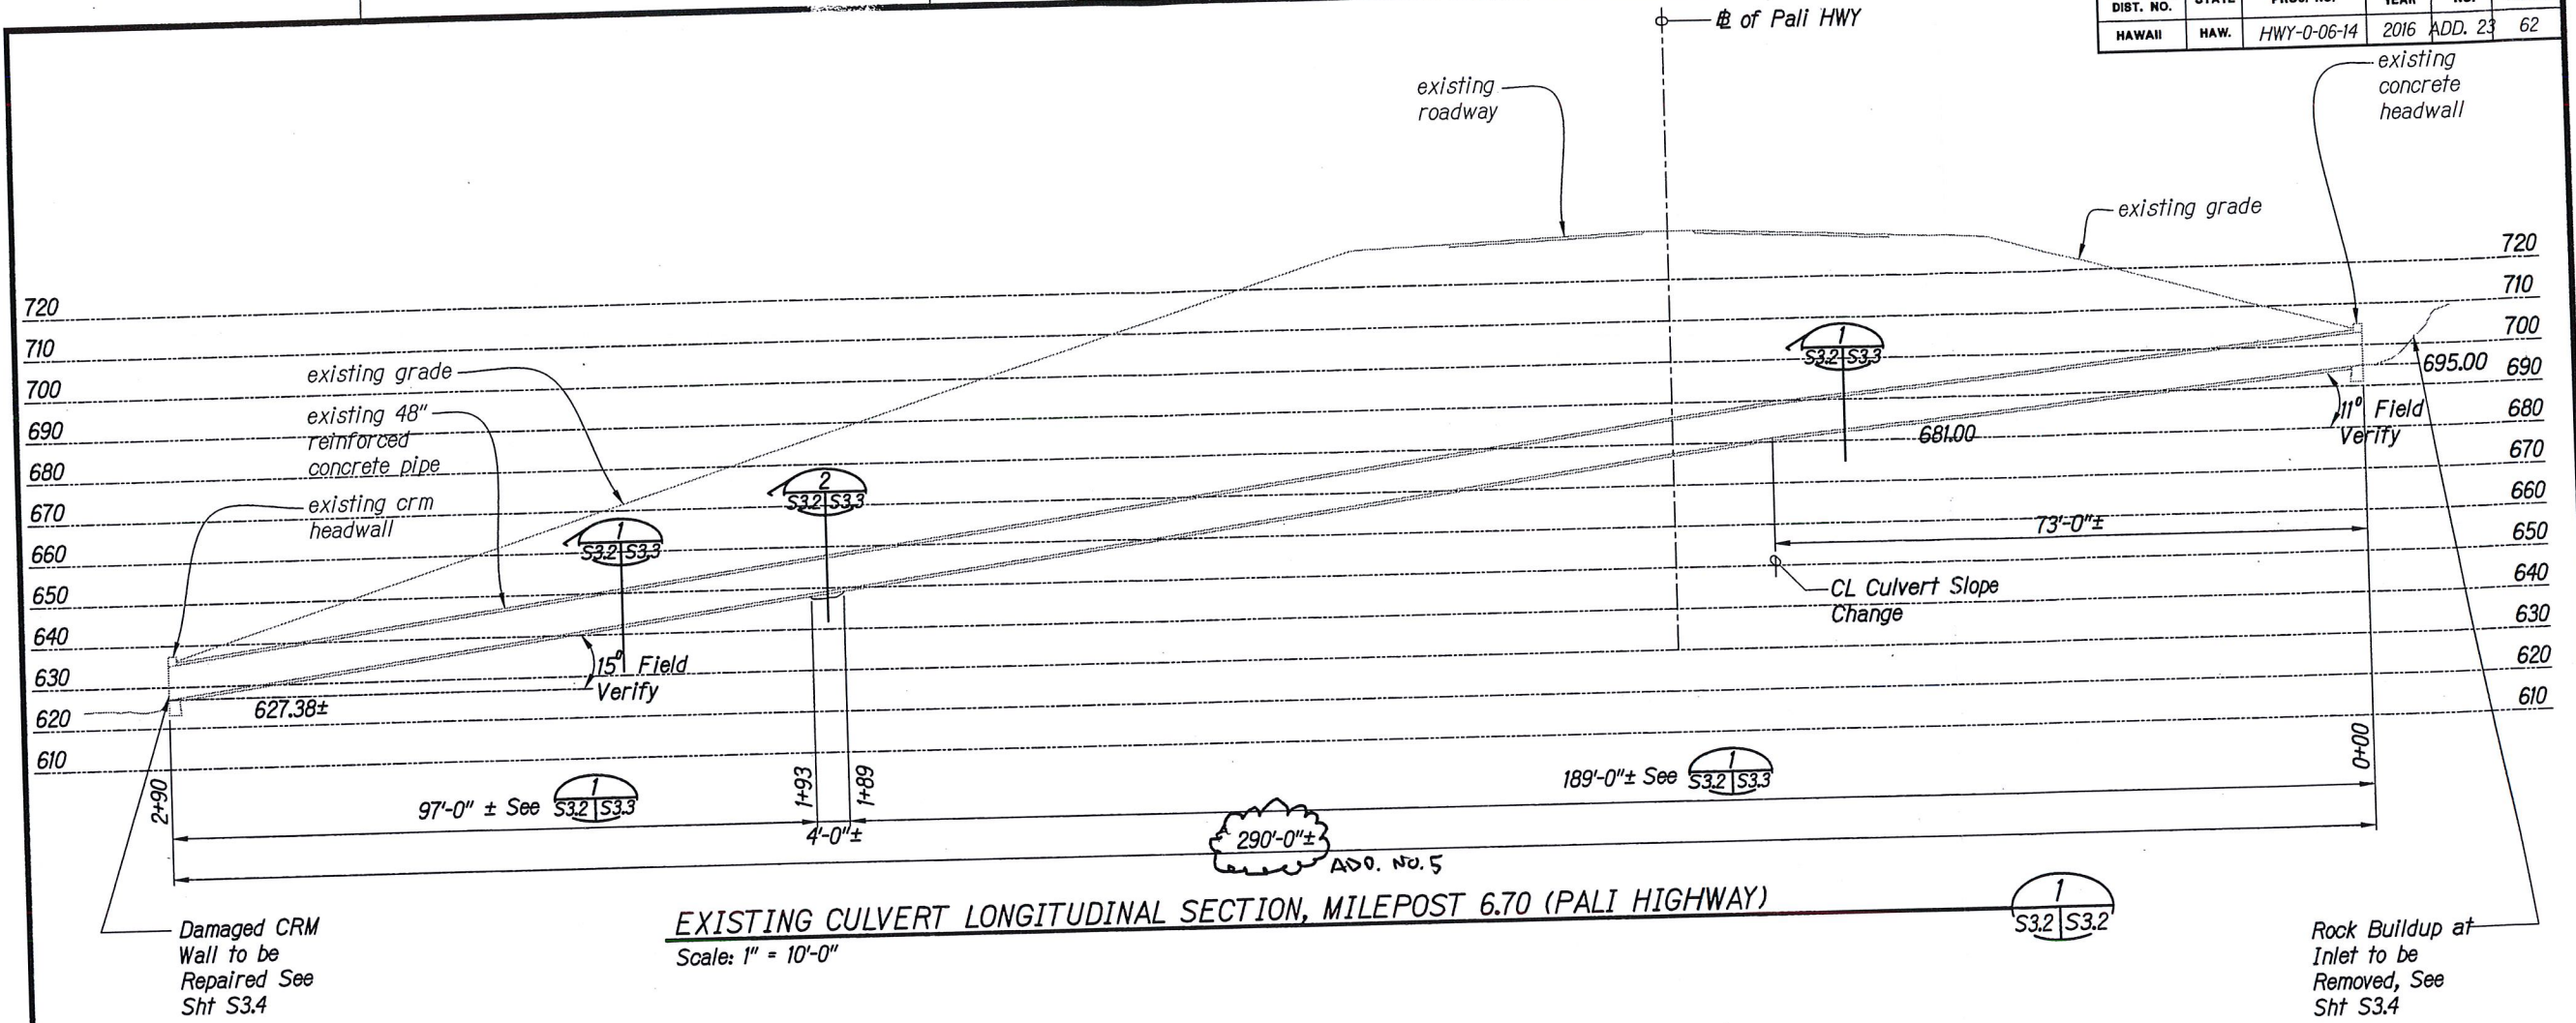

STATE OF HAWAII
DEPARTMENT OF TRANSPORTATION
HIGHWAYS DIVISION

CULVERT LONG SECTION
M.P. 6.70 (PALI HWY)

CULVERT REMEDIATION AT VARIOUS
LOCATIONS ON OAHU, PHASE 1

Project No. HWY-0-06-14

Scale: As Shown Date: March 2016

SHEET No. S3.2 OF 62 SHEETS