

INDEX TO DRAWINGS	
SHEET NO.	DESCRIPTION
1	TITLE SHEET
2	LOCATION MAPS
3-11	NOTES
12-21	CULVERT MILEPOST 14.60 (H3)
22-33	CULVERT MILEPOST 6.70 (PALI HWY)
34-42	CULVERT MILEPOST 1.30 (KALANIANA'OLE HWY)
43-53	CULVERT MILEPOST 2.40 (KALANIANA'OLE HWY)
54-62	CULVERT MILEPOST 4.66 (LIKELIKE HWY)

STATE OF HAWAII

DEPARTMENT OF TRANSPORTATION

HIGHWAYS DIVISION

HONOLULU, HAWAII

"AS-BUILT"

PLANS FOR

CULVERT REMEDIATION AT VARIOUS



LOCATIONS ON OAHU, PHASE 1

PROJECT NO. HWY-O-06-14

DISTRICTS OF EWA, HONOLULU, KOOLAUPOKO

ISLAND OF OAHU

FED. ROAD DIST. NO.	STATE	PROJ. NO.	FISCAL YEAR	SHEET NO.	TOTAL SHEETS
HAWAII	HAW.	HWY-O-06-14	2016	1	62

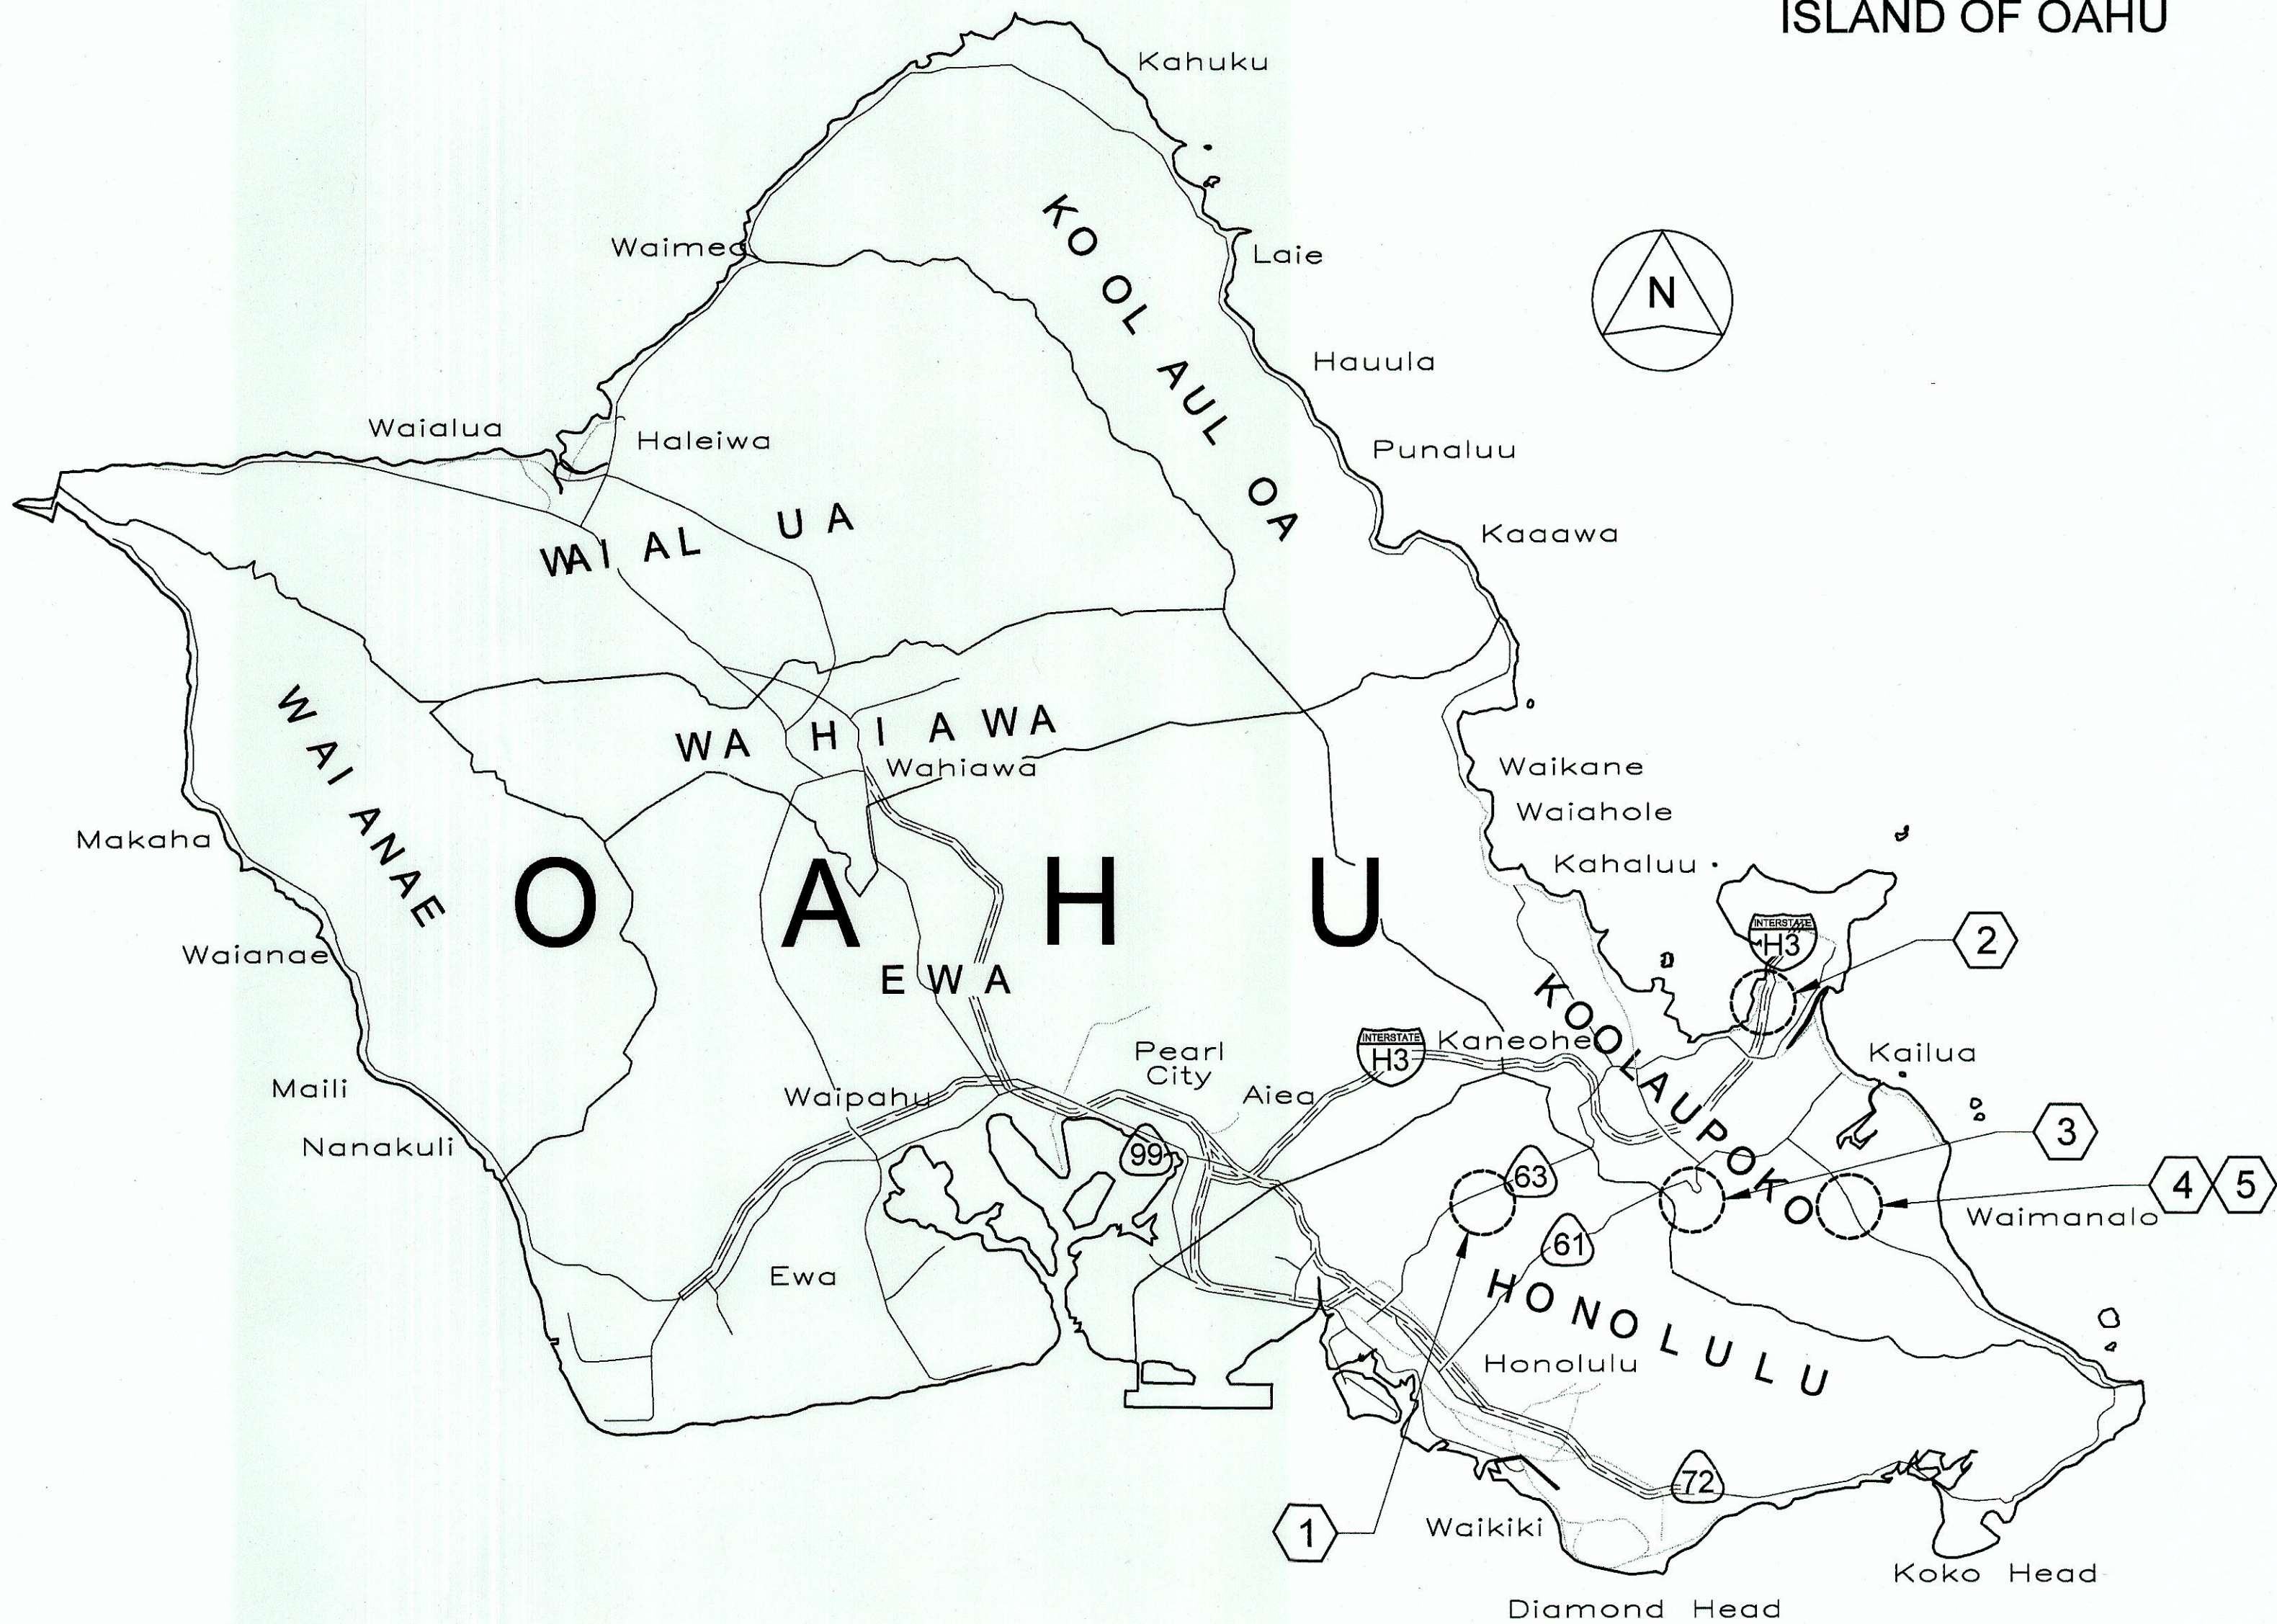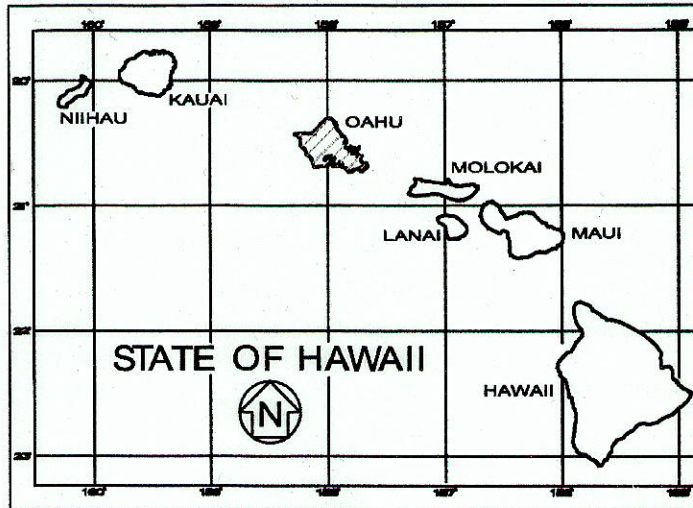

PROJECT SITES

- 1

LIKELIKE HWY: ROUTE 63  
MILEPOST 4.66 (PID 400083)
- 2

JOHN A. BURNS FREEWAY: H-3  
MILEPOST 14.60 (PID 400135)
- 3

PALI HWY: ROUTE 61  
MILEPOST 6.70 (PID 400241)
- 4

KALANIANA'OLE HWY: ROUTE 72  
MILEPOST 1.30 (PID 400139)
- 5

KALANIANA'OLE HWY: ROUTE 72  
MILEPOST 2.40 (PID 400383)

FEDERAL AND INTERSTATE PROJECTS PREVIOUSLY  
CONSTRUCTED OR UNDER CONSTRUCTION

CHANGES MADE DURING CONSTRUCTION HAVE BEEN  
INCORPORATED ON THESE PLANS EXCEPT CHANGES  
IN THE ORIGINAL THEORETICAL QUANTITIES. FOR  
ACTUAL QUANTITIES, REFER TO PROJECT LEDGER  
AND/OR COMPUTATION BOOK.

RESIDENT ENGINEER

DATE

DEPARTMENT OF TRANSPORTATION

STATE OF HAWAII

APPROVED

DIR. OF TRANSPORTATION

DATE