

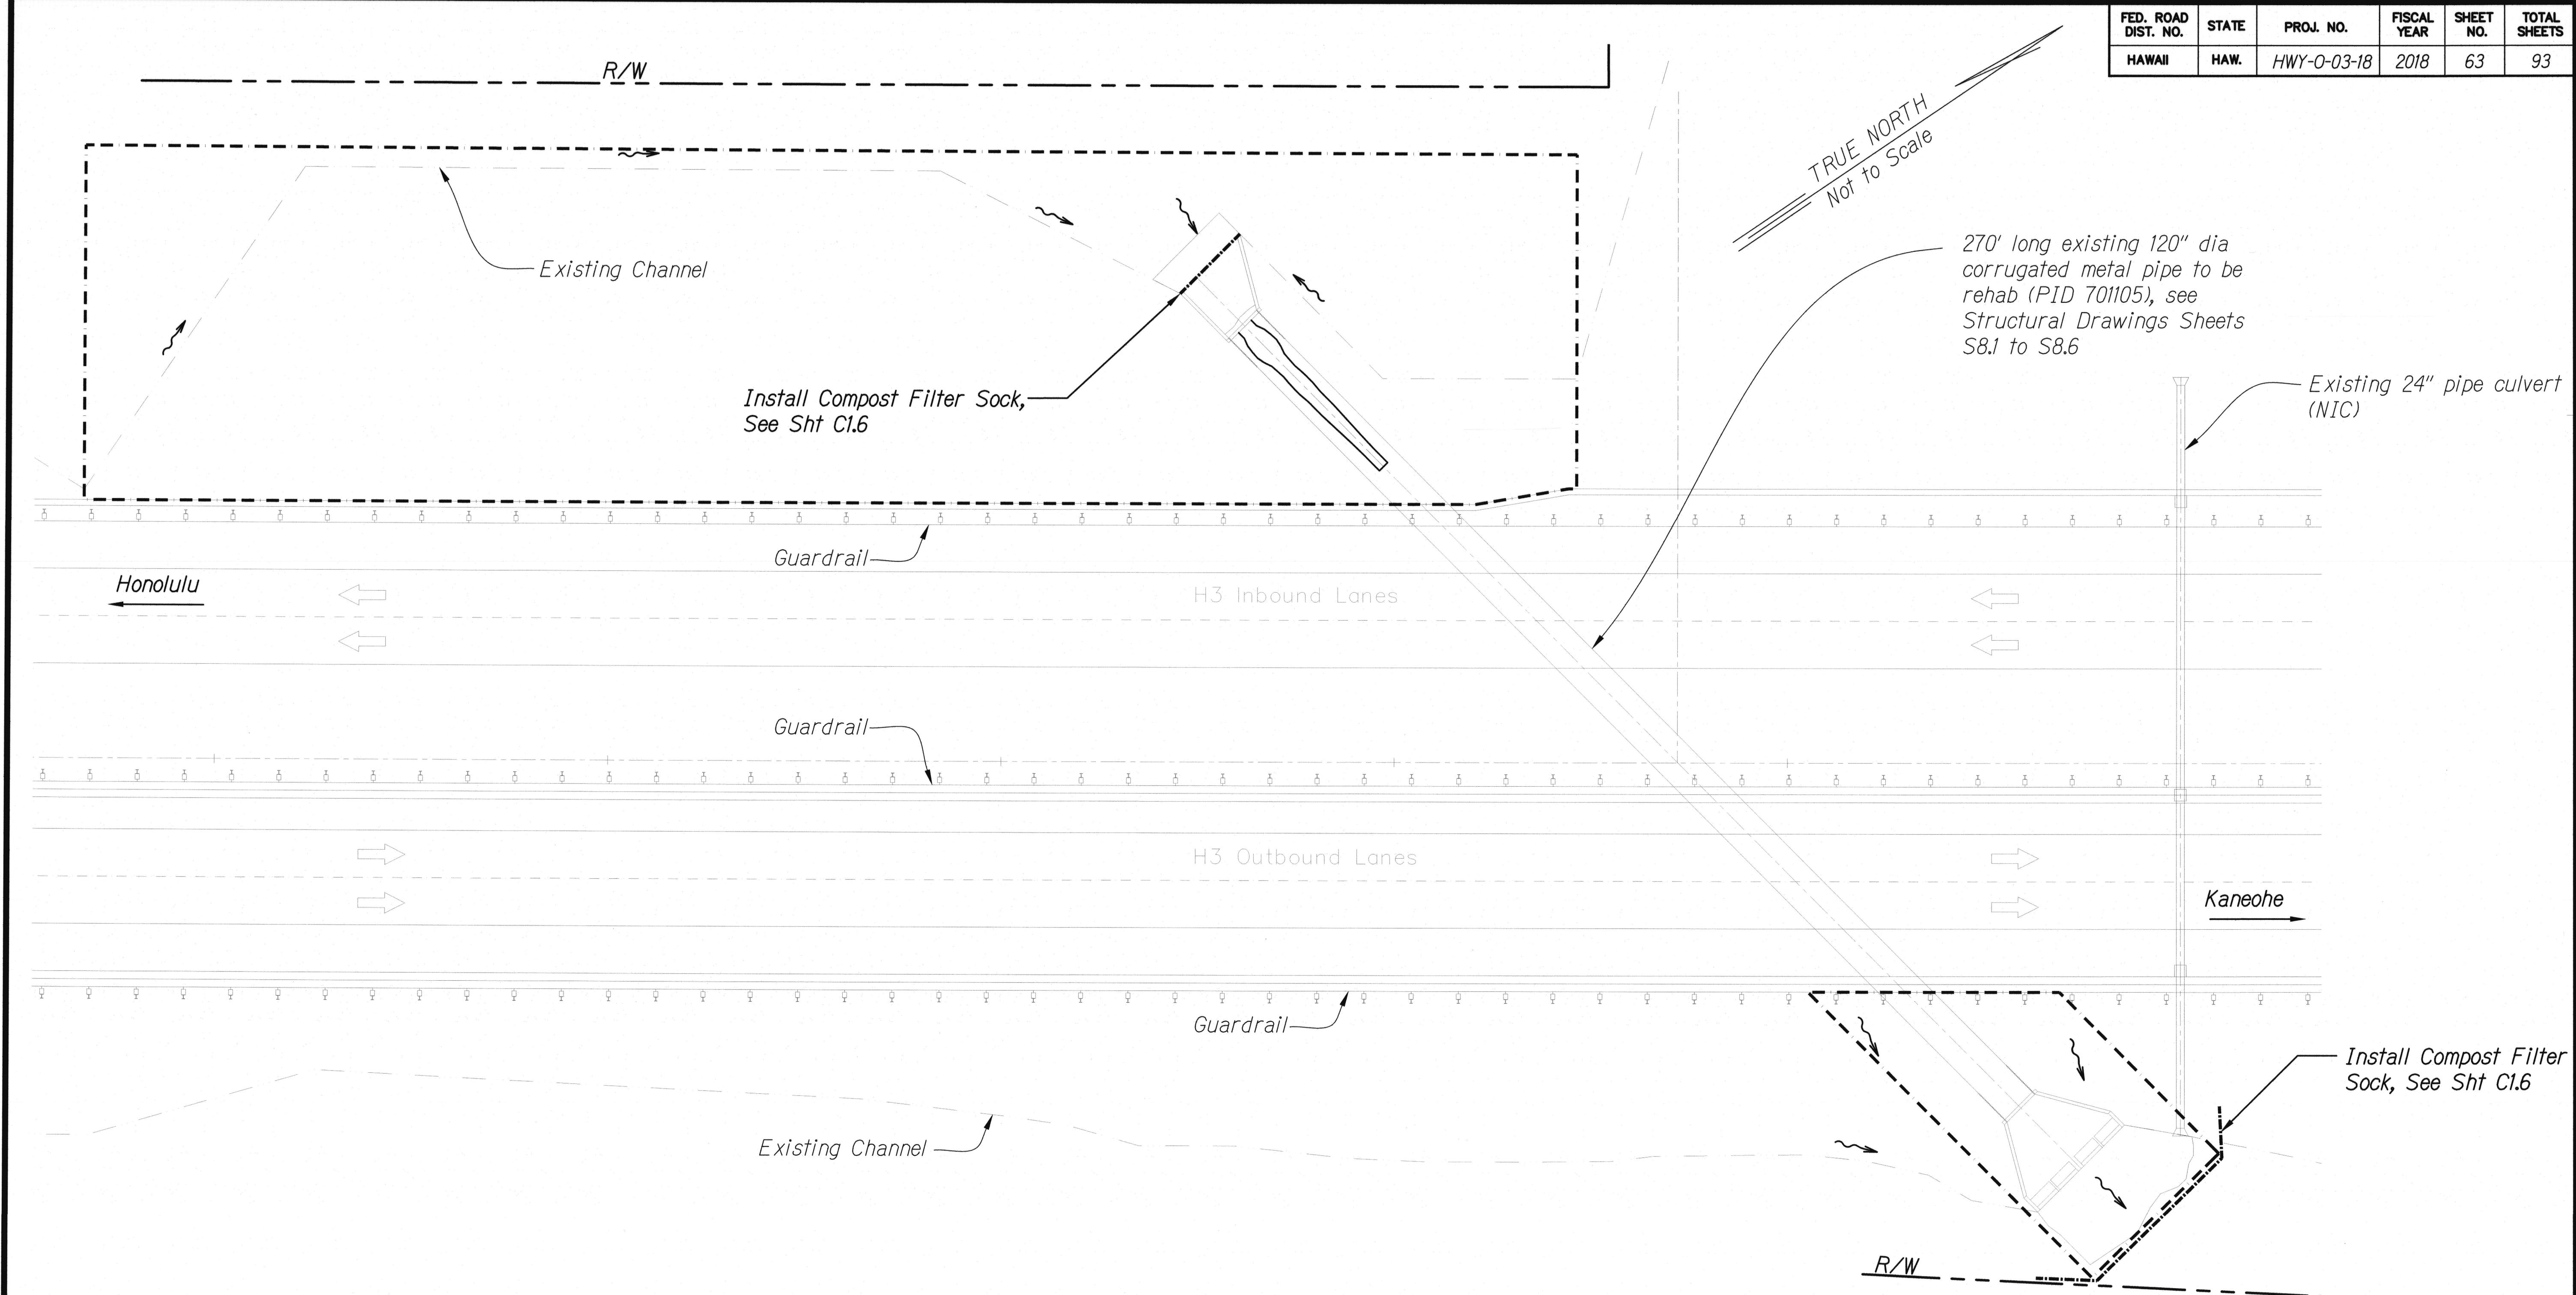


FED. ROAD DIST. NO.	STATE	PROJ. NO.	FISCAL YEAR	SHEET NO.	TOTAL SHEETS
HAWAII	HAW.	HWY-0-03-18	2018	63	93

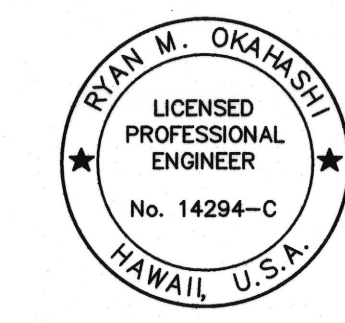

- Notes:**
1. Proposed BMP plan is provided to show general intent. Contractor shall submit BMP plan for review and approval by the Engineer prior to performing the work.
 2. BMP's shall be in place and functional prior to the start of construction work and in accordance with sheet C1.6 and manufacturer's recommendations, whichever is more stringent.

MILEPOST 12.56 (H3) SITE SPECIFIC BMP
Not to Scale

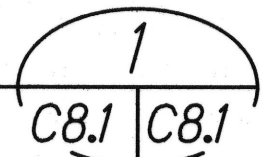

R.M. Okahashi
EXPIRATION DATE OF THE LICENSE 4/30/2018
THIS WORK WAS PREPARED BY
ME OR UNDER MY SUPERVISION

STATE OF HAWAII
DEPARTMENT OF TRANSPORTATION
HIGHWAYS DIVISION

**Site Specific BMP, Milepost
12.56 (H3) PID No. 701105**



**CULVERT REMEDIATION AT VARIOUS
LOCATIONS ON OAHU, PHASE 2**

Project No. HWY-0-03-18

Scale: As Shown Date: March 2018

SHEET No. **C8.1** OF 12 SHEETS

FED. ROAD DIST. NO.	STATE	PROJ. NO.	FISCAL YEAR	SHEET NO.	TOTAL SHEETS
HAWAII	HAW.	HWY-0-03-18	2018	ADD. 64	93

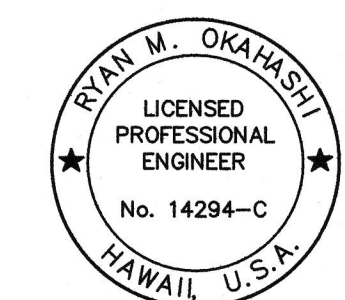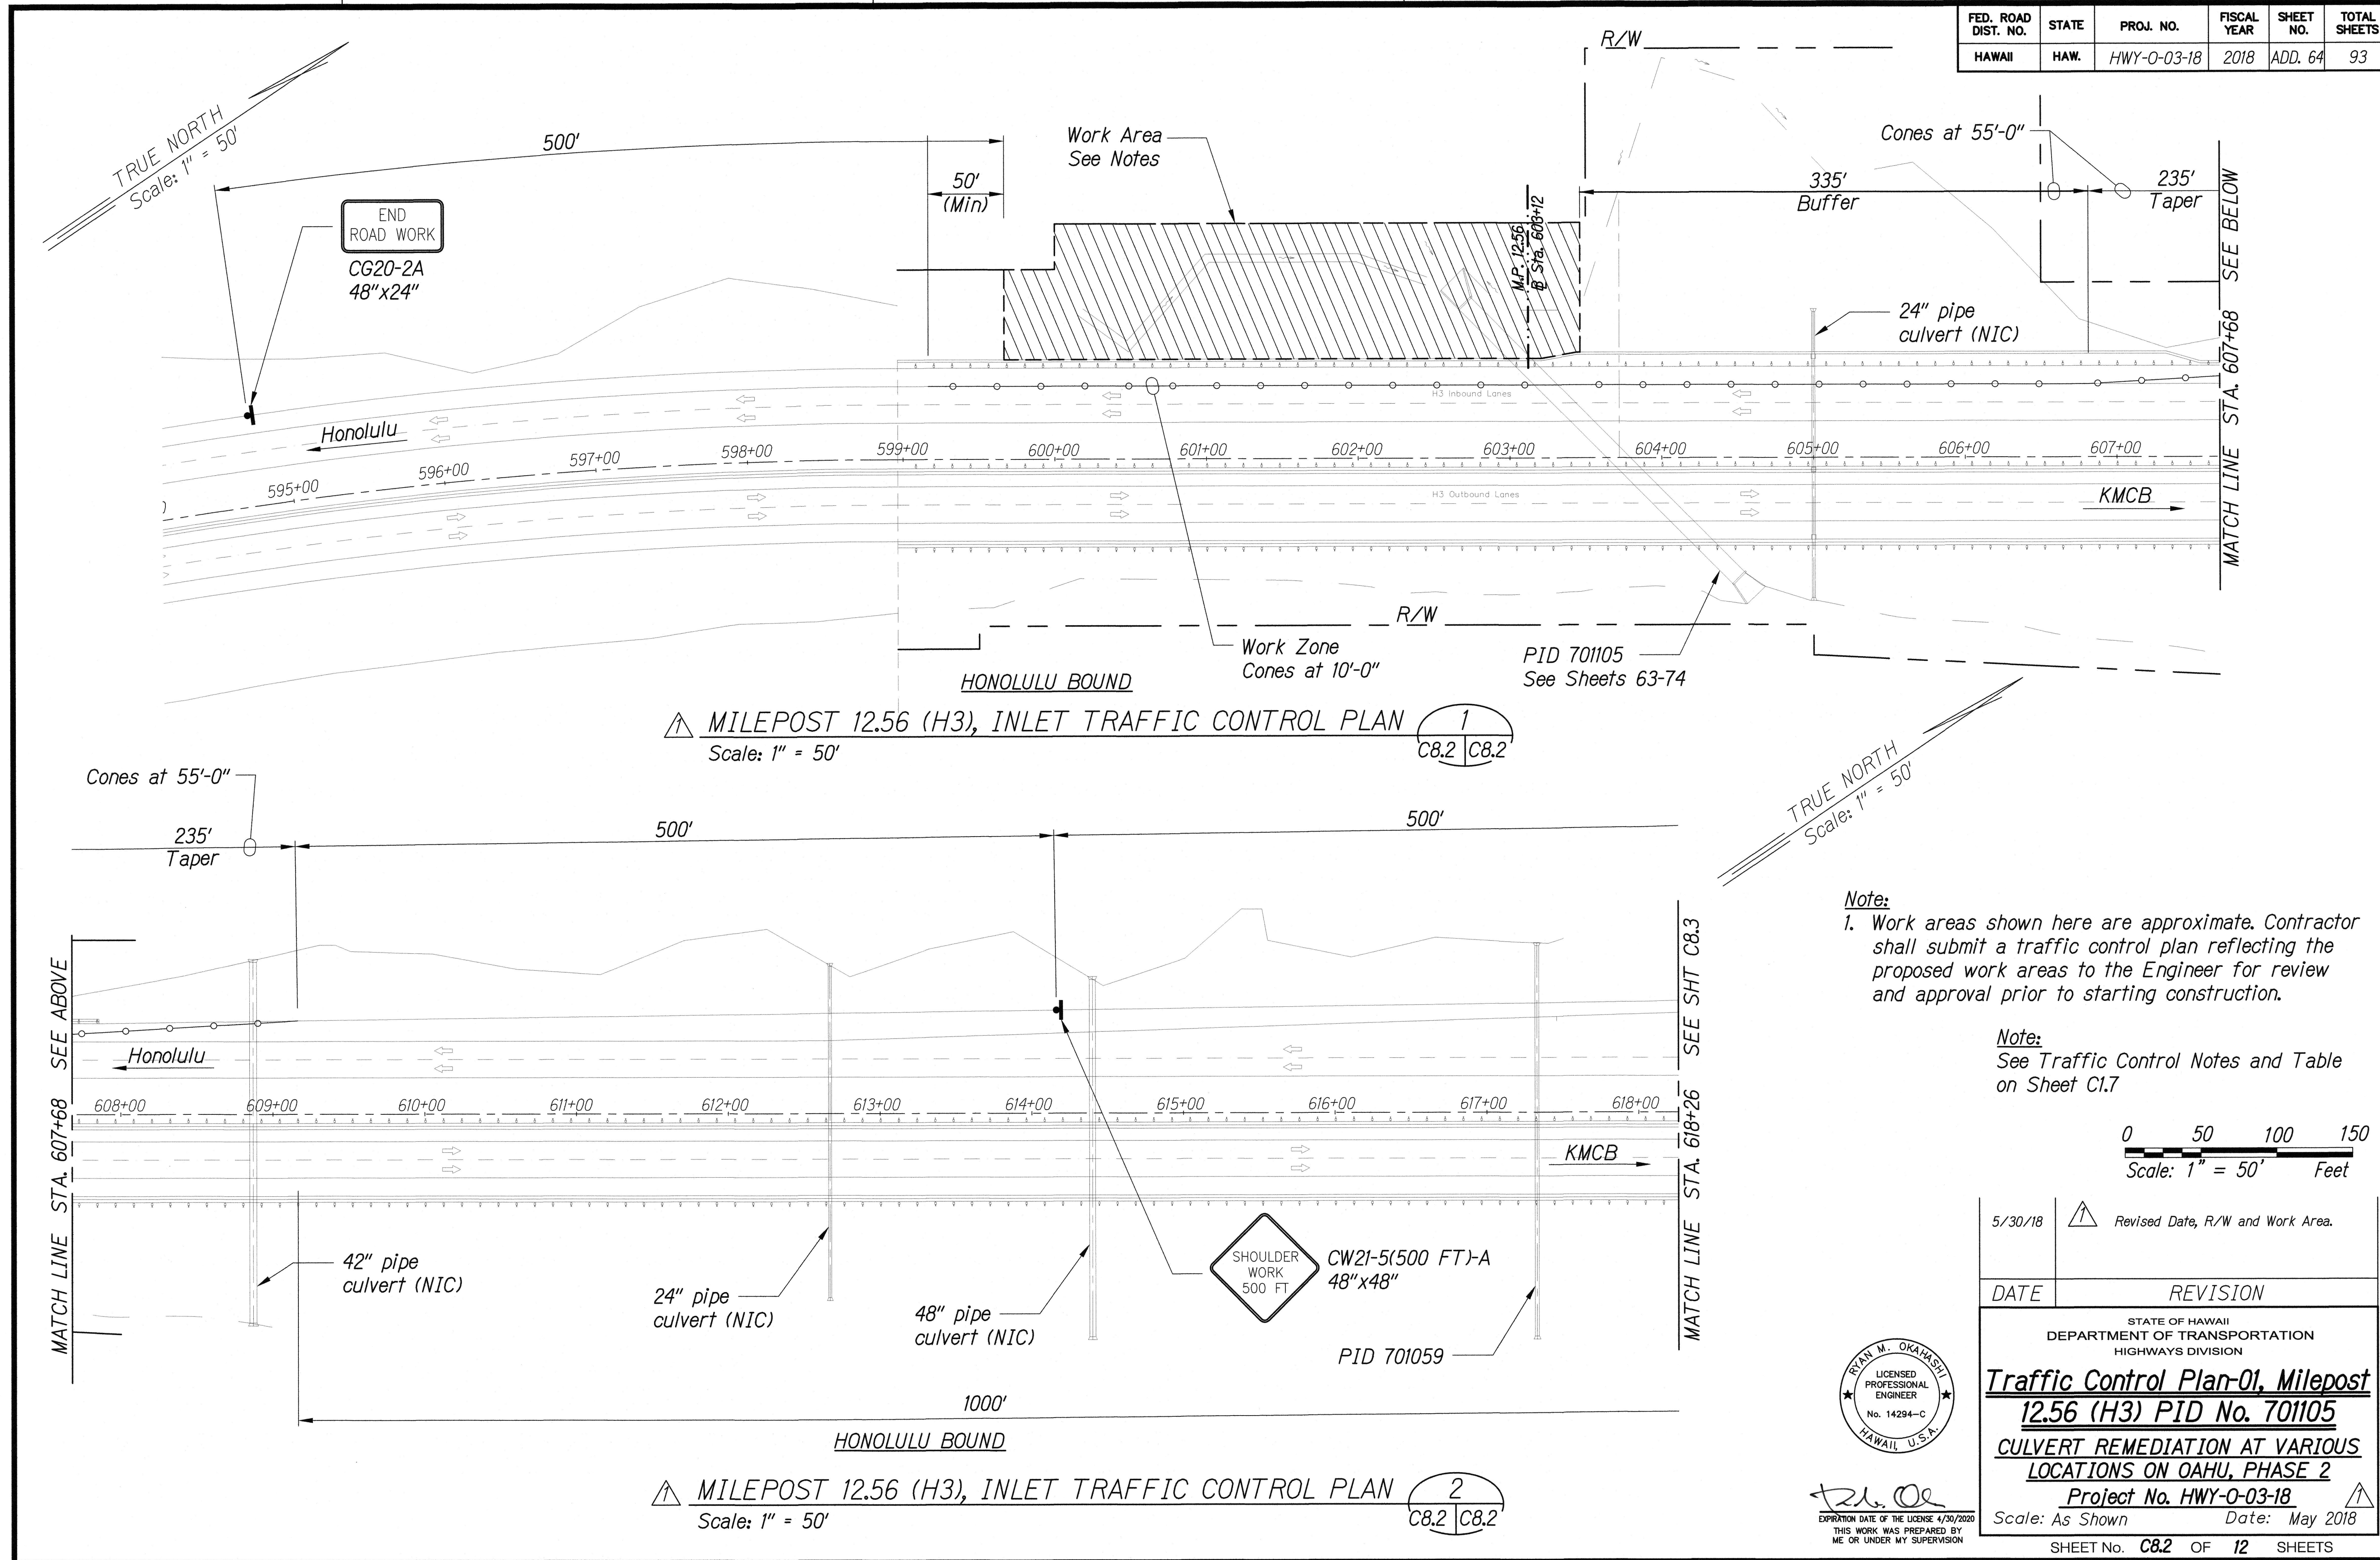


EXPIRATION DATE OF THE LICENSE 4/30/2020
 THIS WORK WAS PREPARED BY
 ME OR UNDER MY SUPERVISION


5/30/18 Revised Date, R/W and Work Area.

DATE	REVISION
STATE OF HAWAII DEPARTMENT OF TRANSPORTATION HIGHWAYS DIVISION Traffic Control Plan-01, Milepost 12.56 (H3) PID No. 701105 CULVERT REMEDIATION AT VARIOUS LOCATIONS ON OAHU, PHASE 2 Project No. HWY-0-03-18	
Scale: As Shown	Date: May 2018
SHEET No. C8.2 OF 12 SHEETS	

FED. ROAD DIST. NO.	STATE	PROJ. NO.	FISCAL YEAR	SHEET NO.	TOTAL SHEETS
HAWAII	HAW.	HWY-0-03-18	2018	65	93

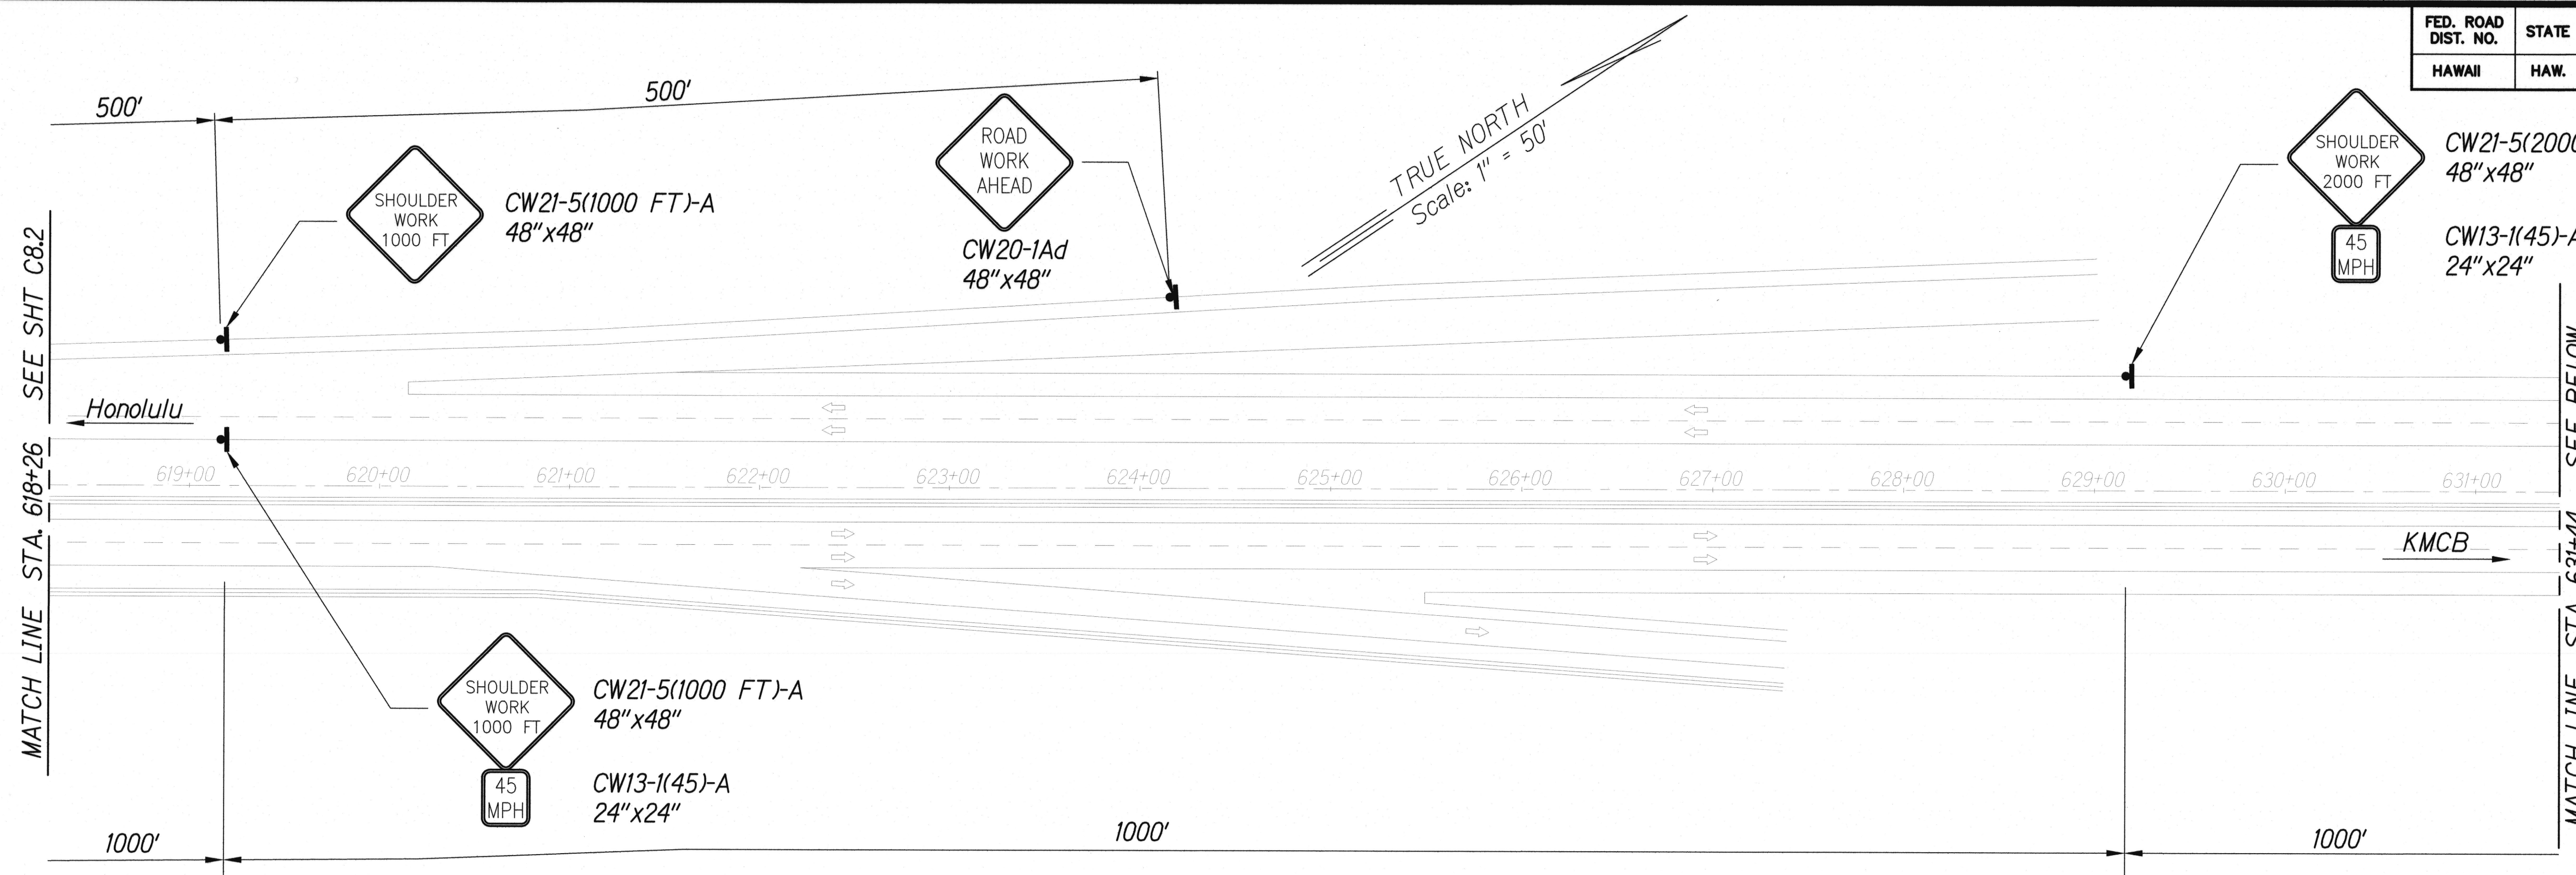


HONOLULU BOUND
MILEPOST 12.56 (H3), INLET TRAFFIC CONTROL PLAN 1
 Scale: 1" = 50' C8.3 | C8.3

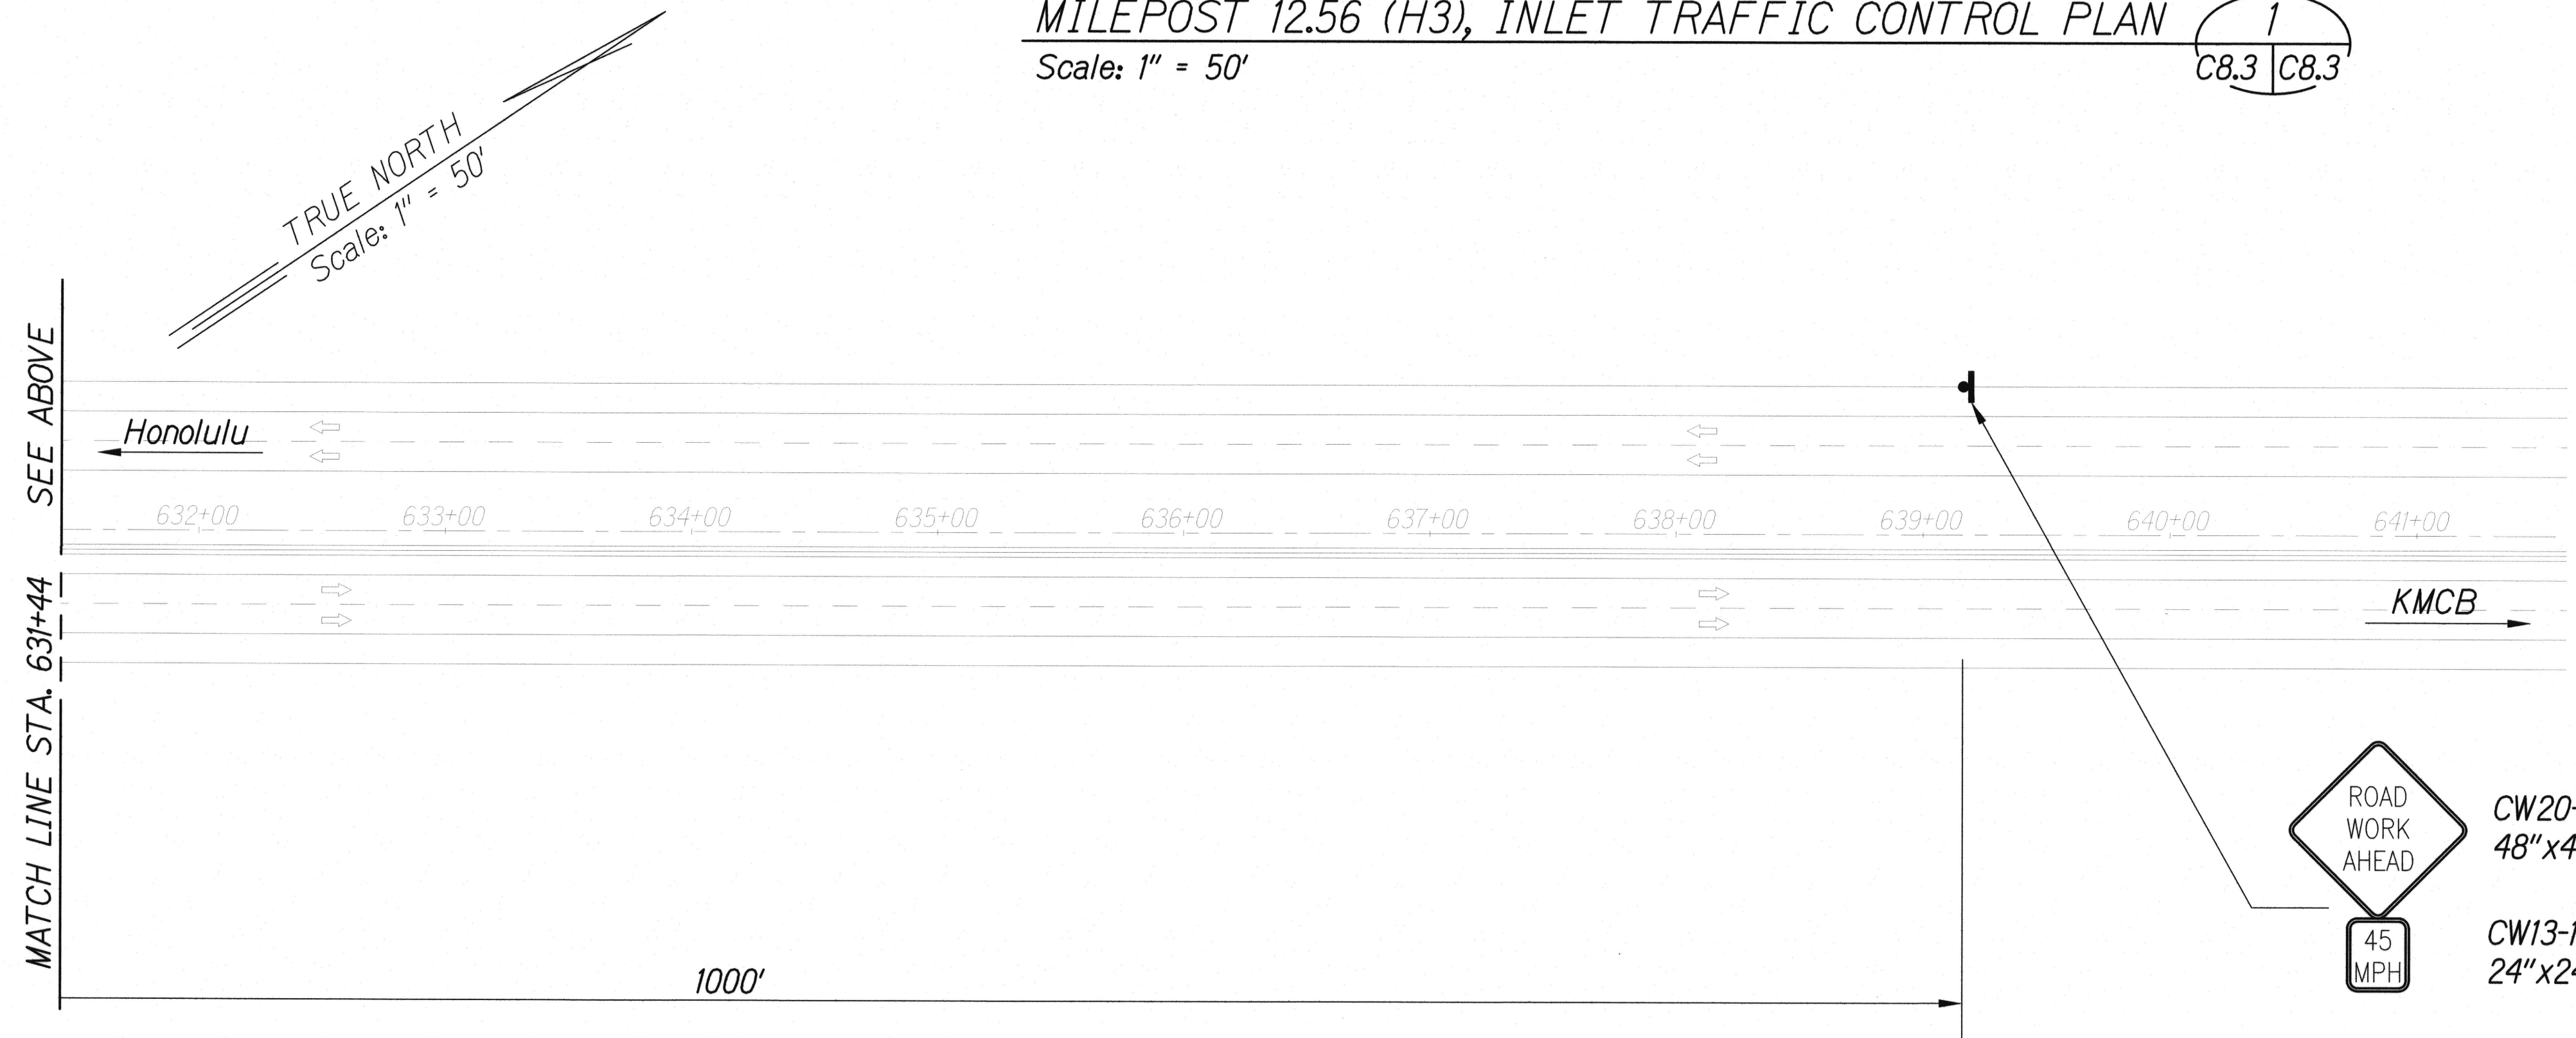

HONOLULU BOUND
MILEPOST 12.56 (H3), INLET TRAFFIC CONTROL PLAN 2
 Scale: 1" = 50' C8.3 | C8.3

Note:
 See Traffic Control Notes and Table on Sheet C1.7

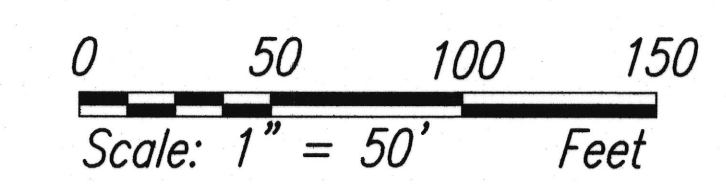

R.M.O.
EXPIRATION DATE OF THE LICENSE 4/30/2018
 THIS WORK WAS PREPARED BY ME OR UNDER MY SUPERVISION

STATE OF HAWAII
DEPARTMENT OF TRANSPORTATION
HIGHWAYS DIVISION

Traffic Control Plan-02, Milepost 12.56 (H3) PID No. 701105


CULVERT REMEDIATION AT VARIOUS LOCATIONS ON OAHU, PHASE 2

Project No. HWY-0-03-18


Scale: As Shown Date: March 2018

SHEET No. **C8.3** OF **12** SHEETS

FED. ROAD DIST. NO.	STATE	PROJ. NO.	FISCAL YEAR	SHEET NO.	TOTAL SHEETS
HAWAII	HAW.	HWY-O-03-18	2018	66	93

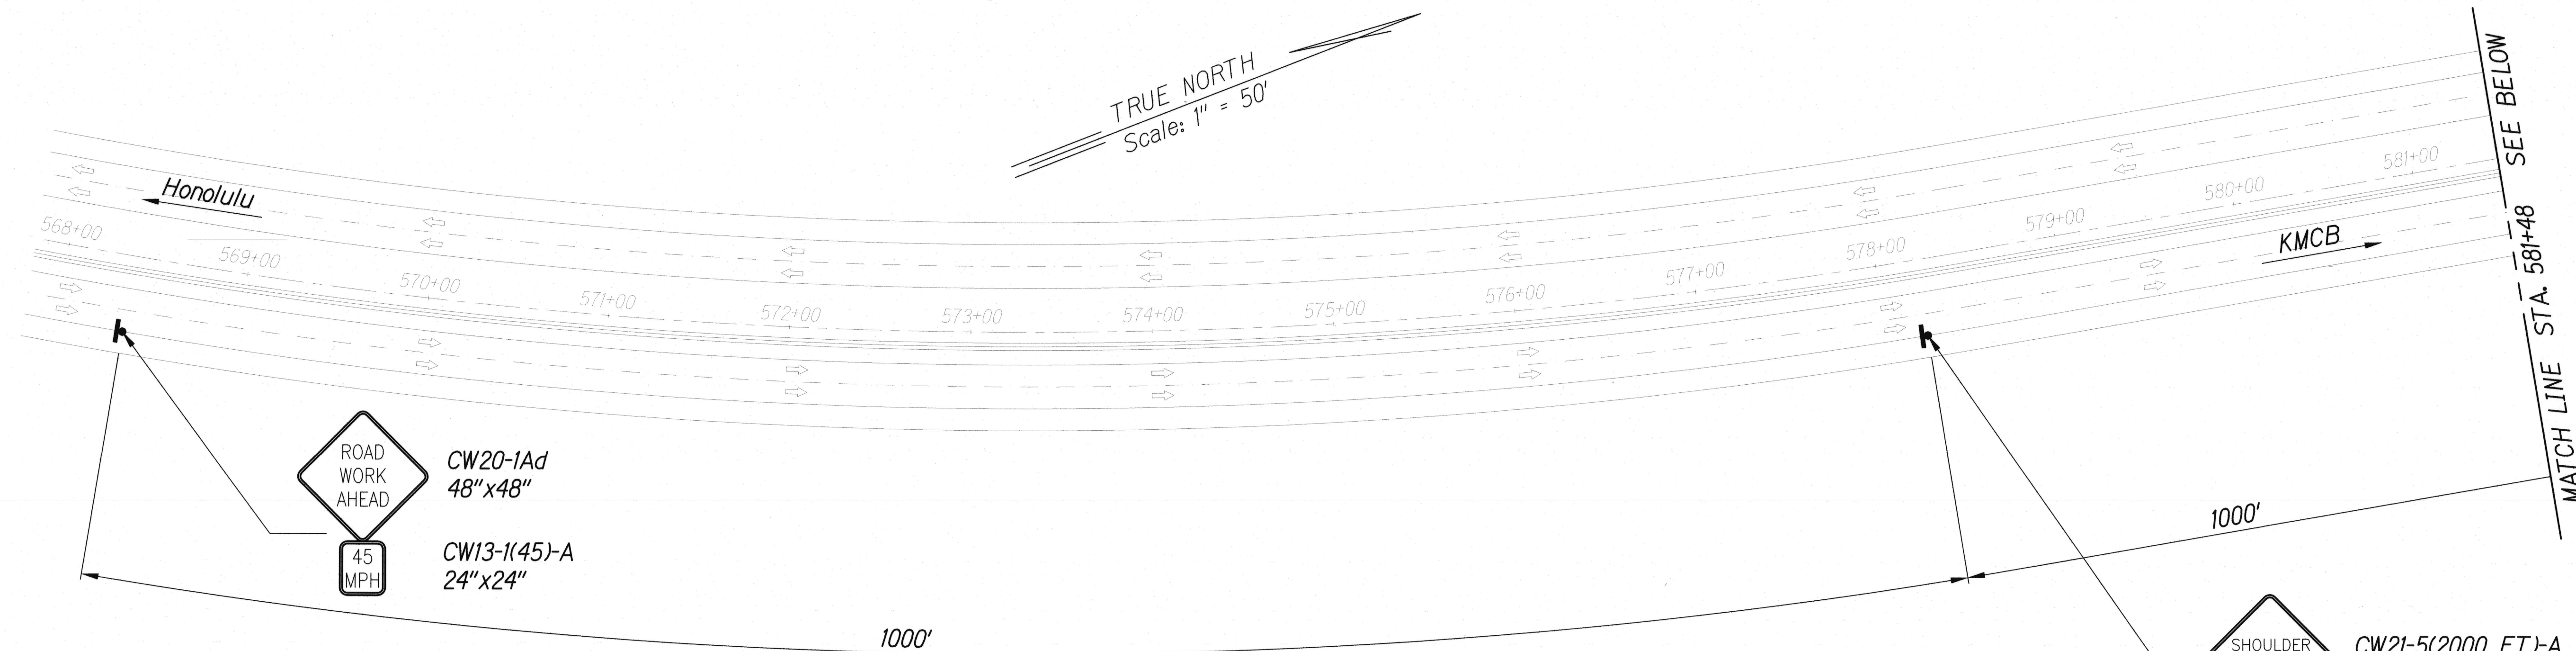

KMCB BOUND
MILEPOST 12.56 (H3), OUTLET TRAFFIC CONTROL PLAN 1
 Scale: 1" = 50' C8.4 C8.4

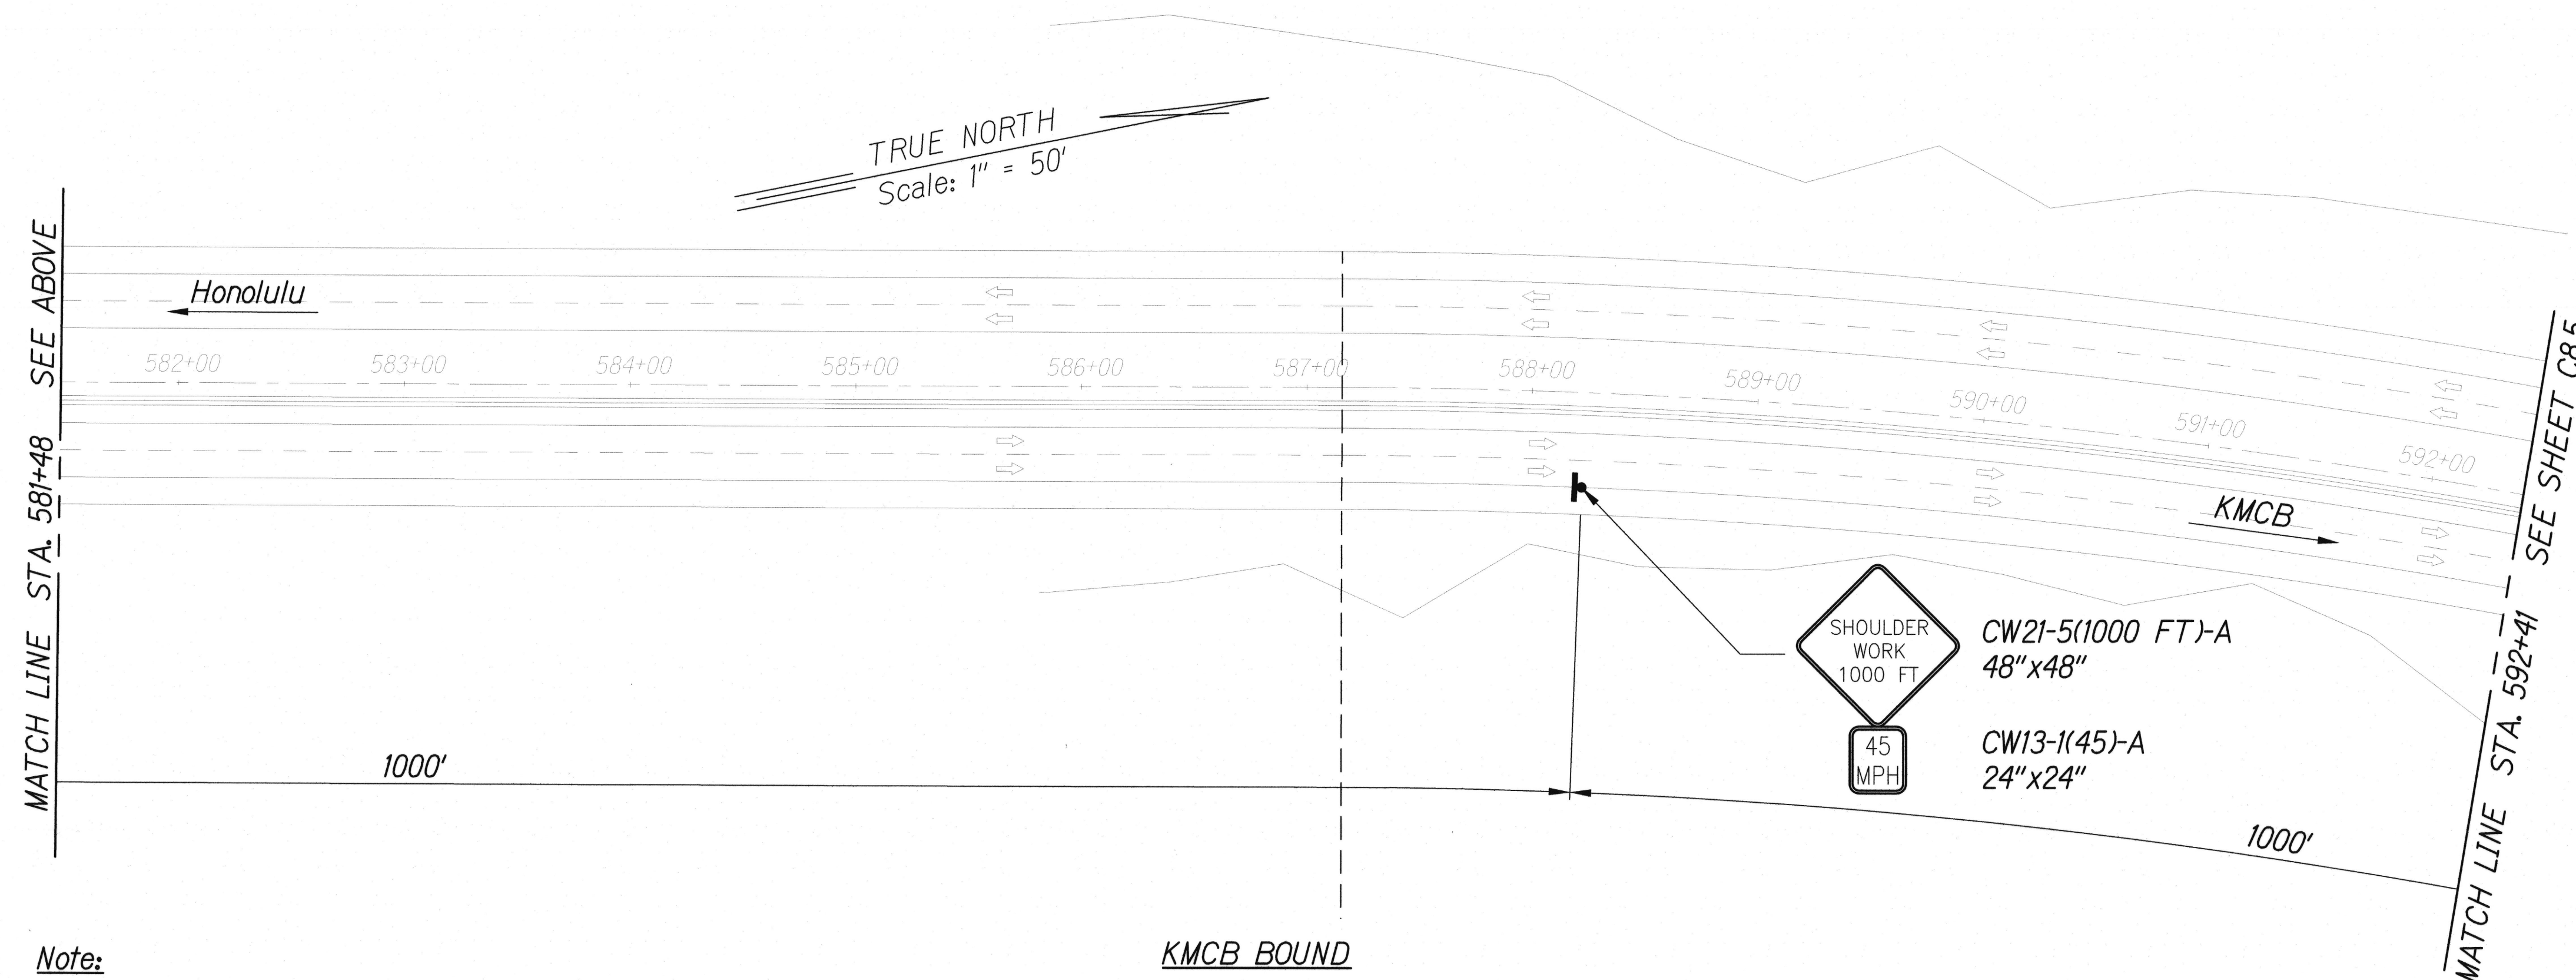

KMCB BOUND
MILEPOST 12.56 (H3), OUTLET TRAFFIC CONTROL PLAN 2
 Scale: 1" = 50' C8.4 C8.4

Note:
 See Traffic Control Notes and Table
 on Sheet C1.7

0 50 100 150
 Scale: 1" = 50' Feet



R.M.O.
 EXPIRATION DATE OF THE LICENSE 4/30/2018
 THIS WORK WAS PREPARED BY
 ME OR UNDER MY SUPERVISION

STATE OF HAWAII
 DEPARTMENT OF TRANSPORTATION
 HIGHWAYS DIVISION

Traffic Control Plan-03, Milepost
12.56 (H3) PID No. 701105


CULVERT REMEDIATION AT VARIOUS
LOCATIONS ON OAHU, PHASE 2

Project No. HWY-O-03-18


Scale: As Shown Date: March 2018

SHEET No. **C8.4** OF **12** SHEETS

FED. ROAD DIST. NO.	STATE	PROJ. NO.	FISCAL YEAR	SHEET NO.	TOTAL SHEETS
HAWAII	HAW.	HWY-0-03-18	2018	ADD. 67	93

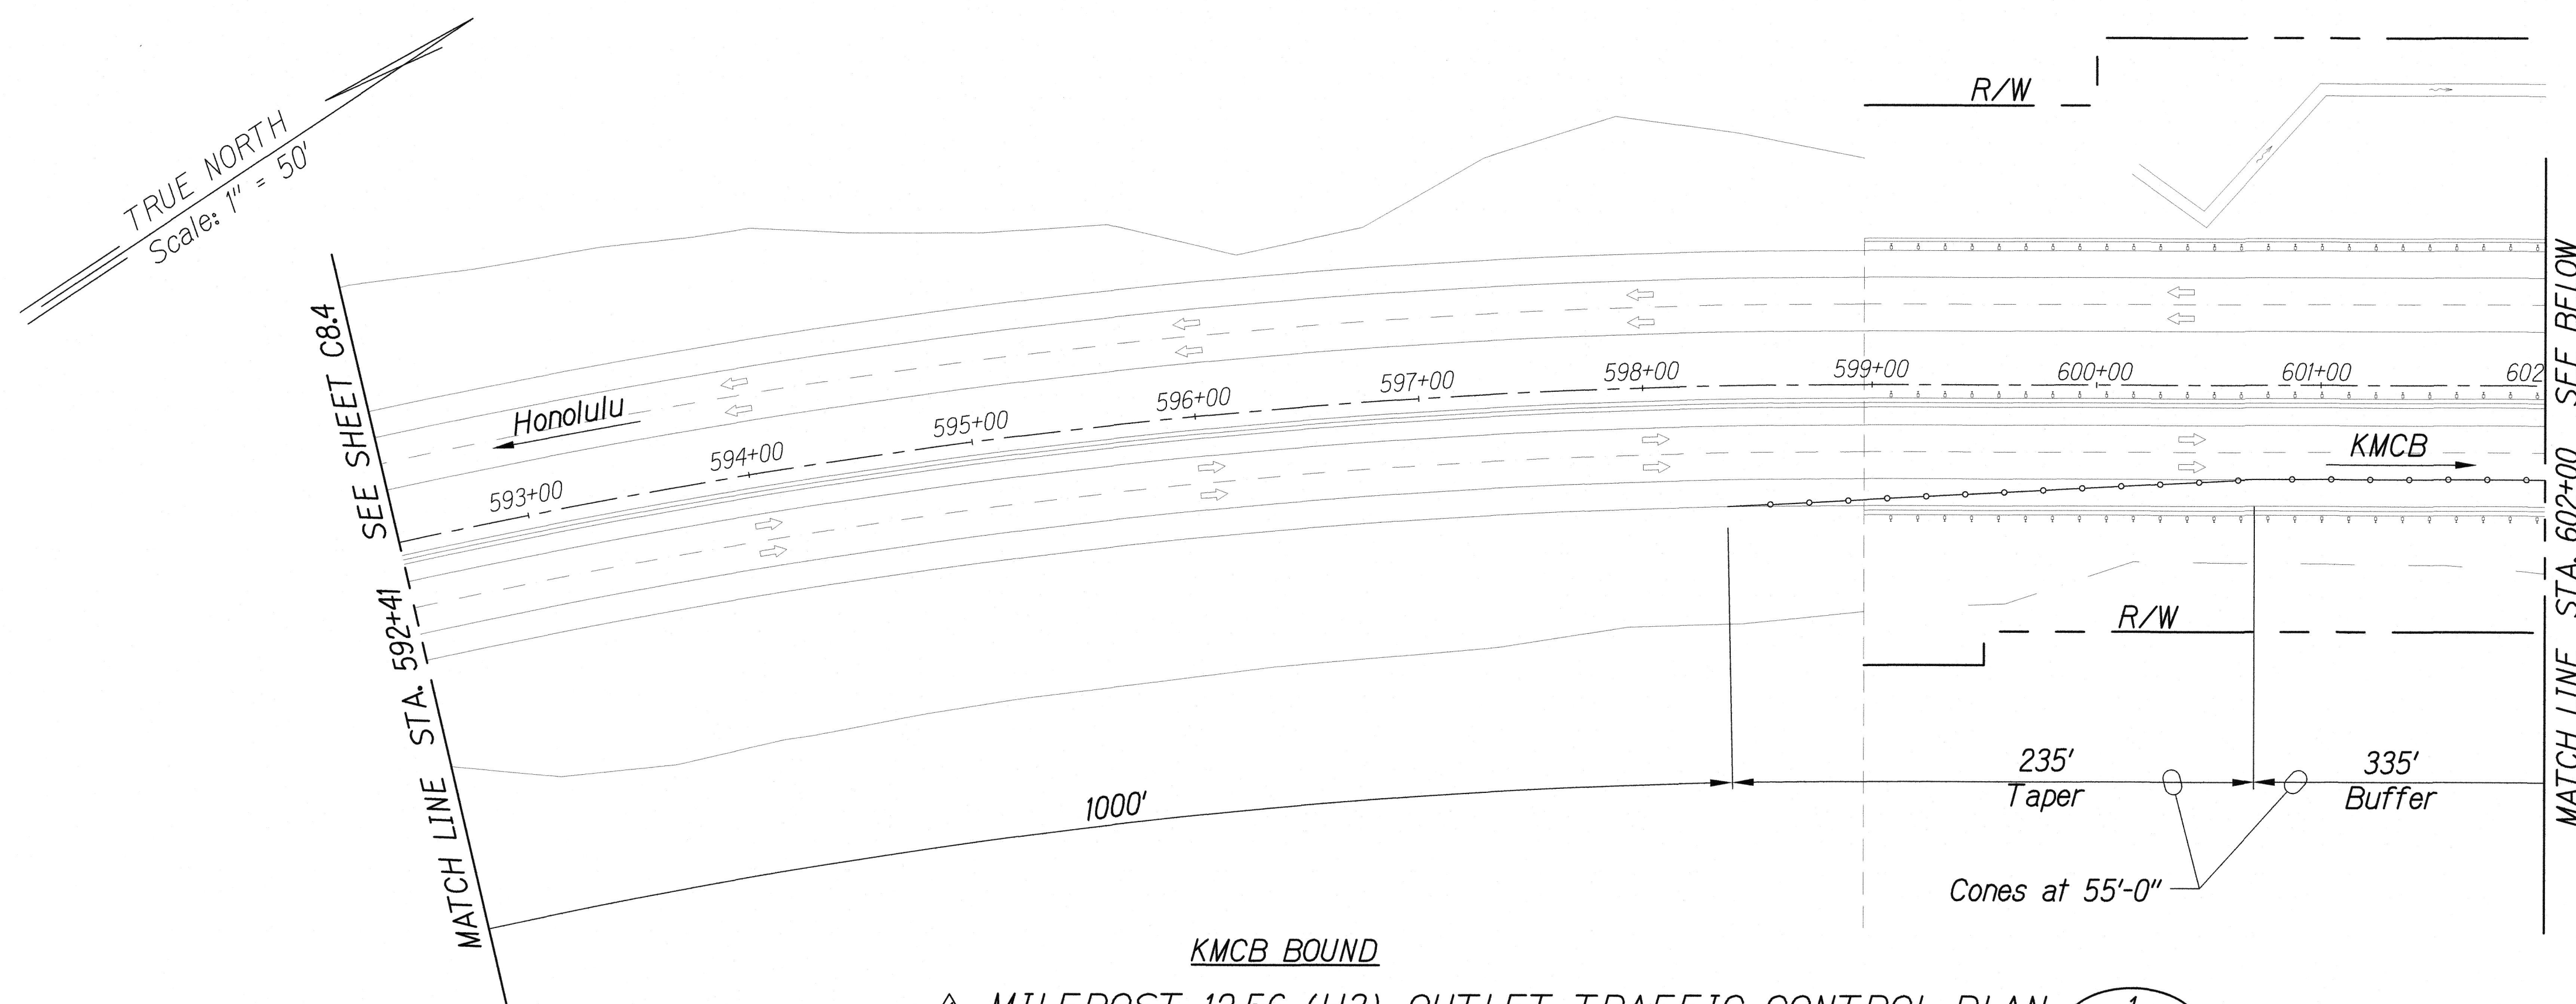

Note:
1. Work areas shown here are approximate. Contractor shall submit a traffic control plan reflecting the proposed work areas to the Engineer for review and approval prior to starting construction.

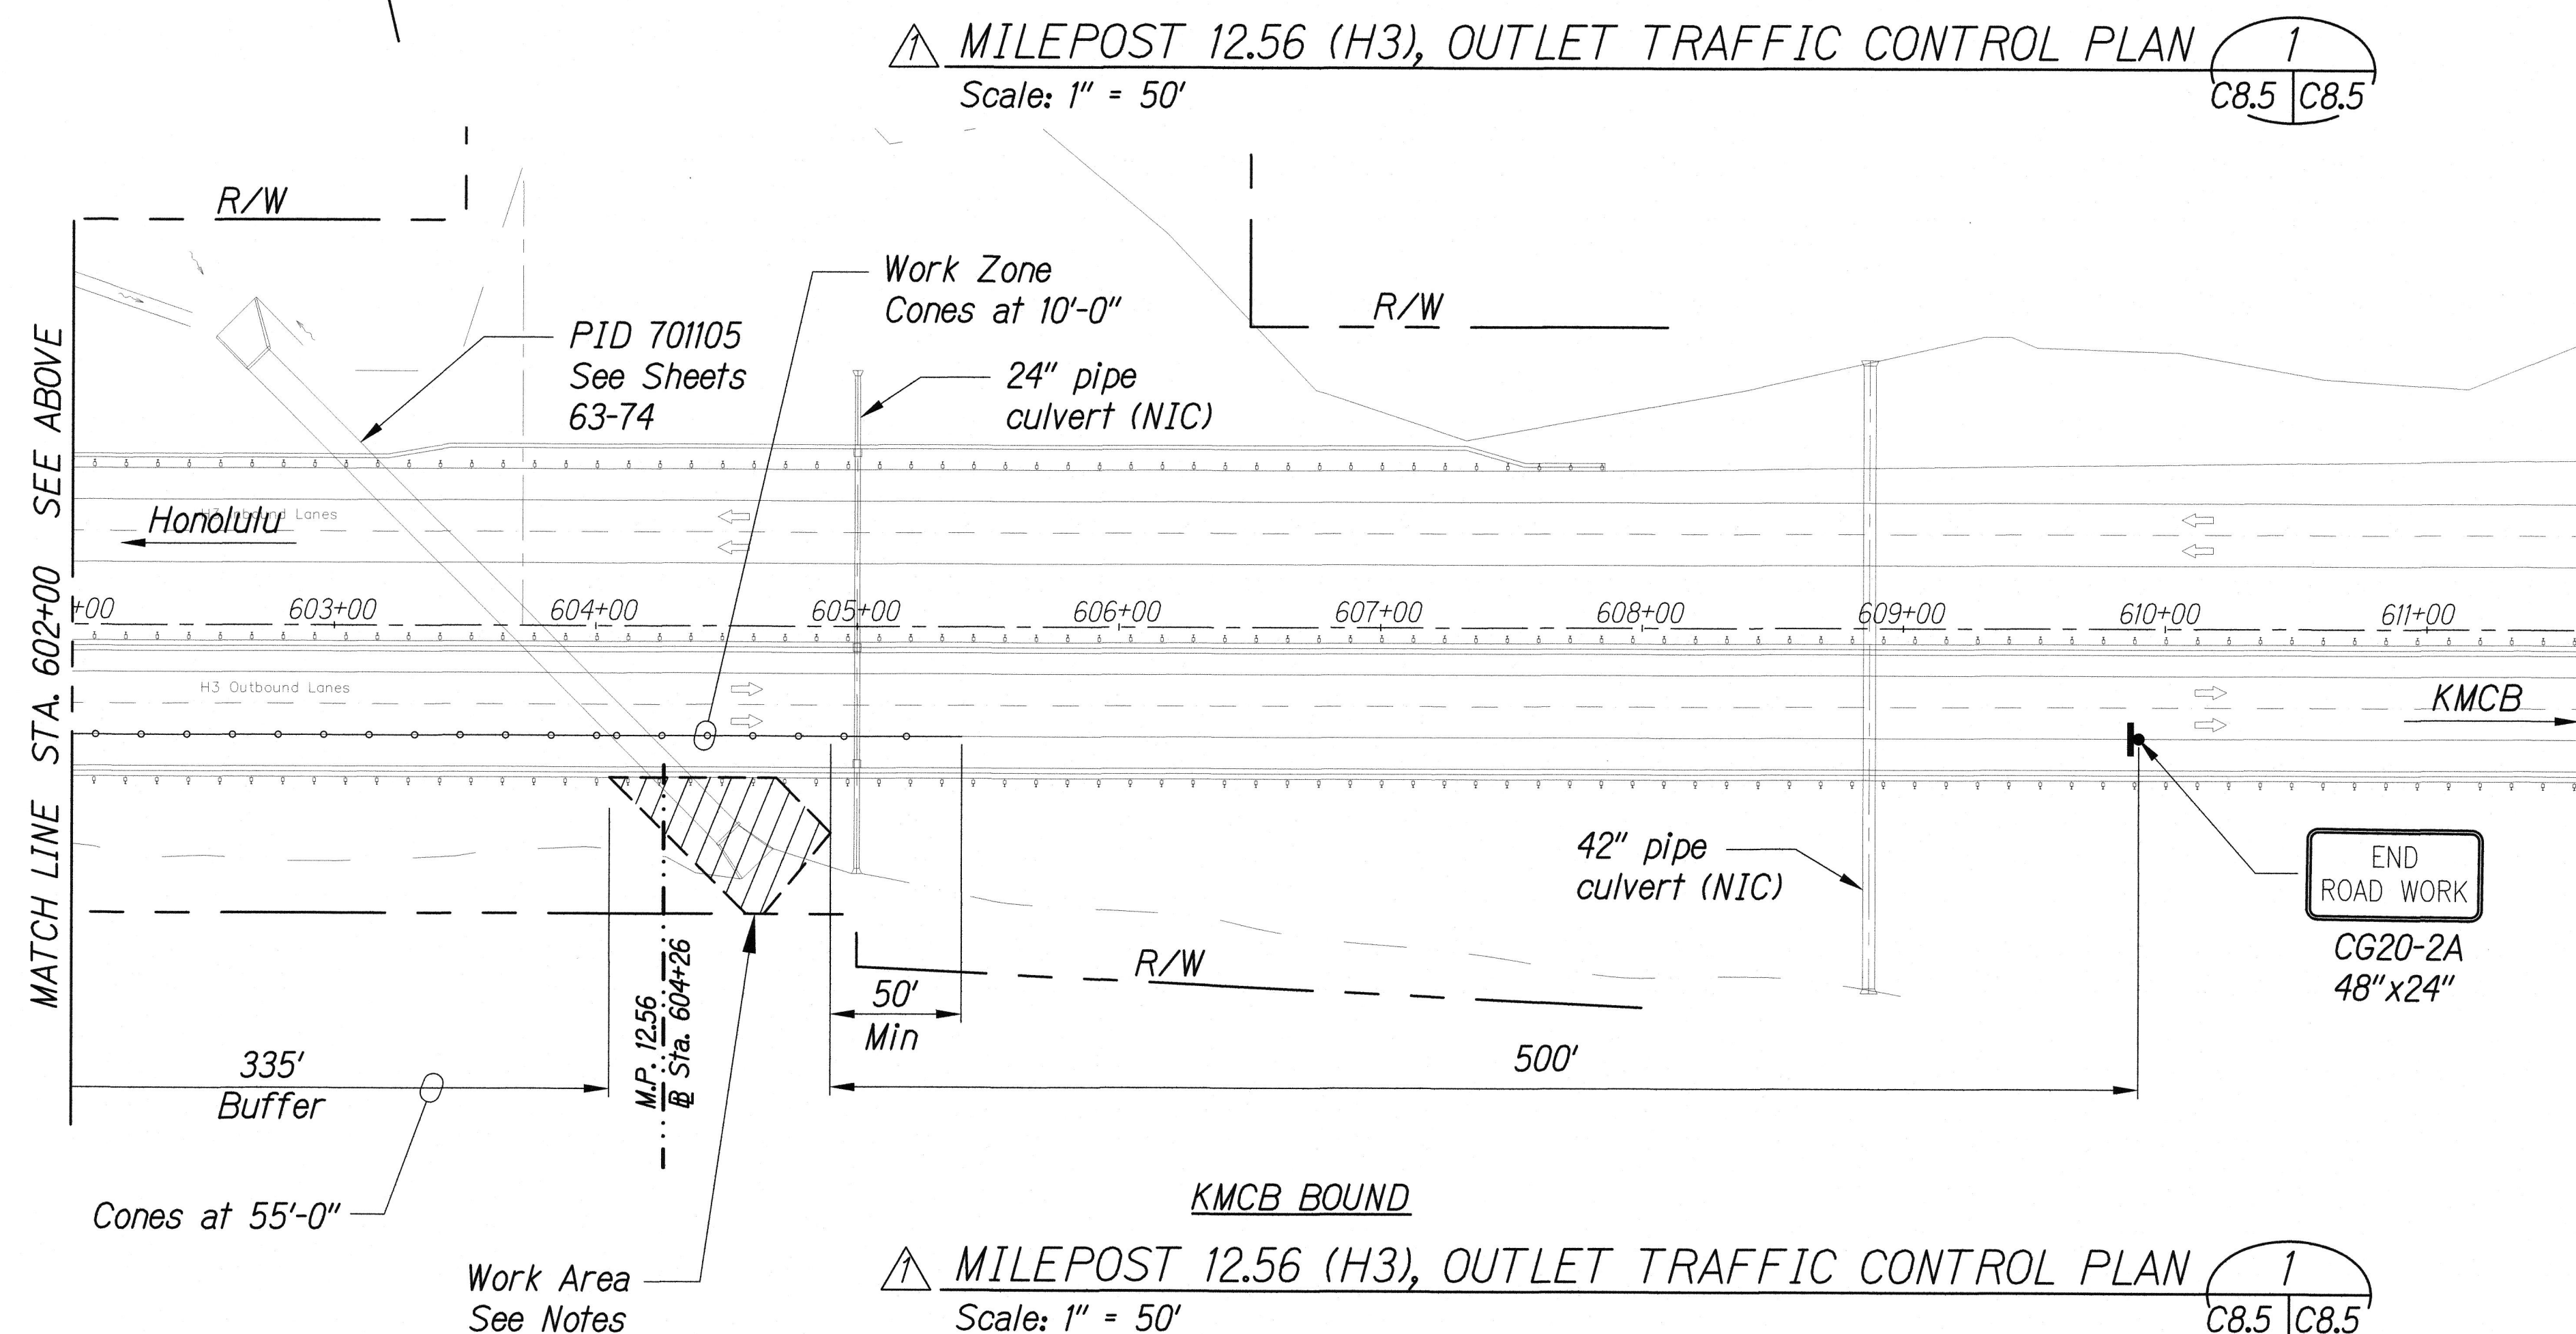

Note:
See Traffic Control Notes and Table on Sheet C1.7


0 50 100 150
Scale: 1" = 50' Feet

5/30/18	Revised Date and R/W.
DATE	REVISION
STATE OF HAWAII DEPARTMENT OF TRANSPORTATION HIGHWAYS DIVISION	
Traffic Control Plan-04, Milepost 12.56 (H3) PID No. 701105	
CULVERT REMEDIATION AT VARIOUS LOCATIONS ON OAHU, PHASE 2	
Project No. HWY-0-03-18	
Scale: As Shown	Date: May 2018
SHEET No. C8.5 OF 12 SHEETS	



R. Okahashi
EXPIRATION DATE OF THE LICENSE 4/30/2020
THIS WORK WAS PREPARED BY ME OR UNDER MY SUPERVISION

FED. ROAD DIST. NO.	STATE	PROJ. NO.	FISCAL YEAR	SHEET NO.	TOTAL SHEETS
HAWAII	HAW.	HWY-0-03-18	2018	ADD. 68	93

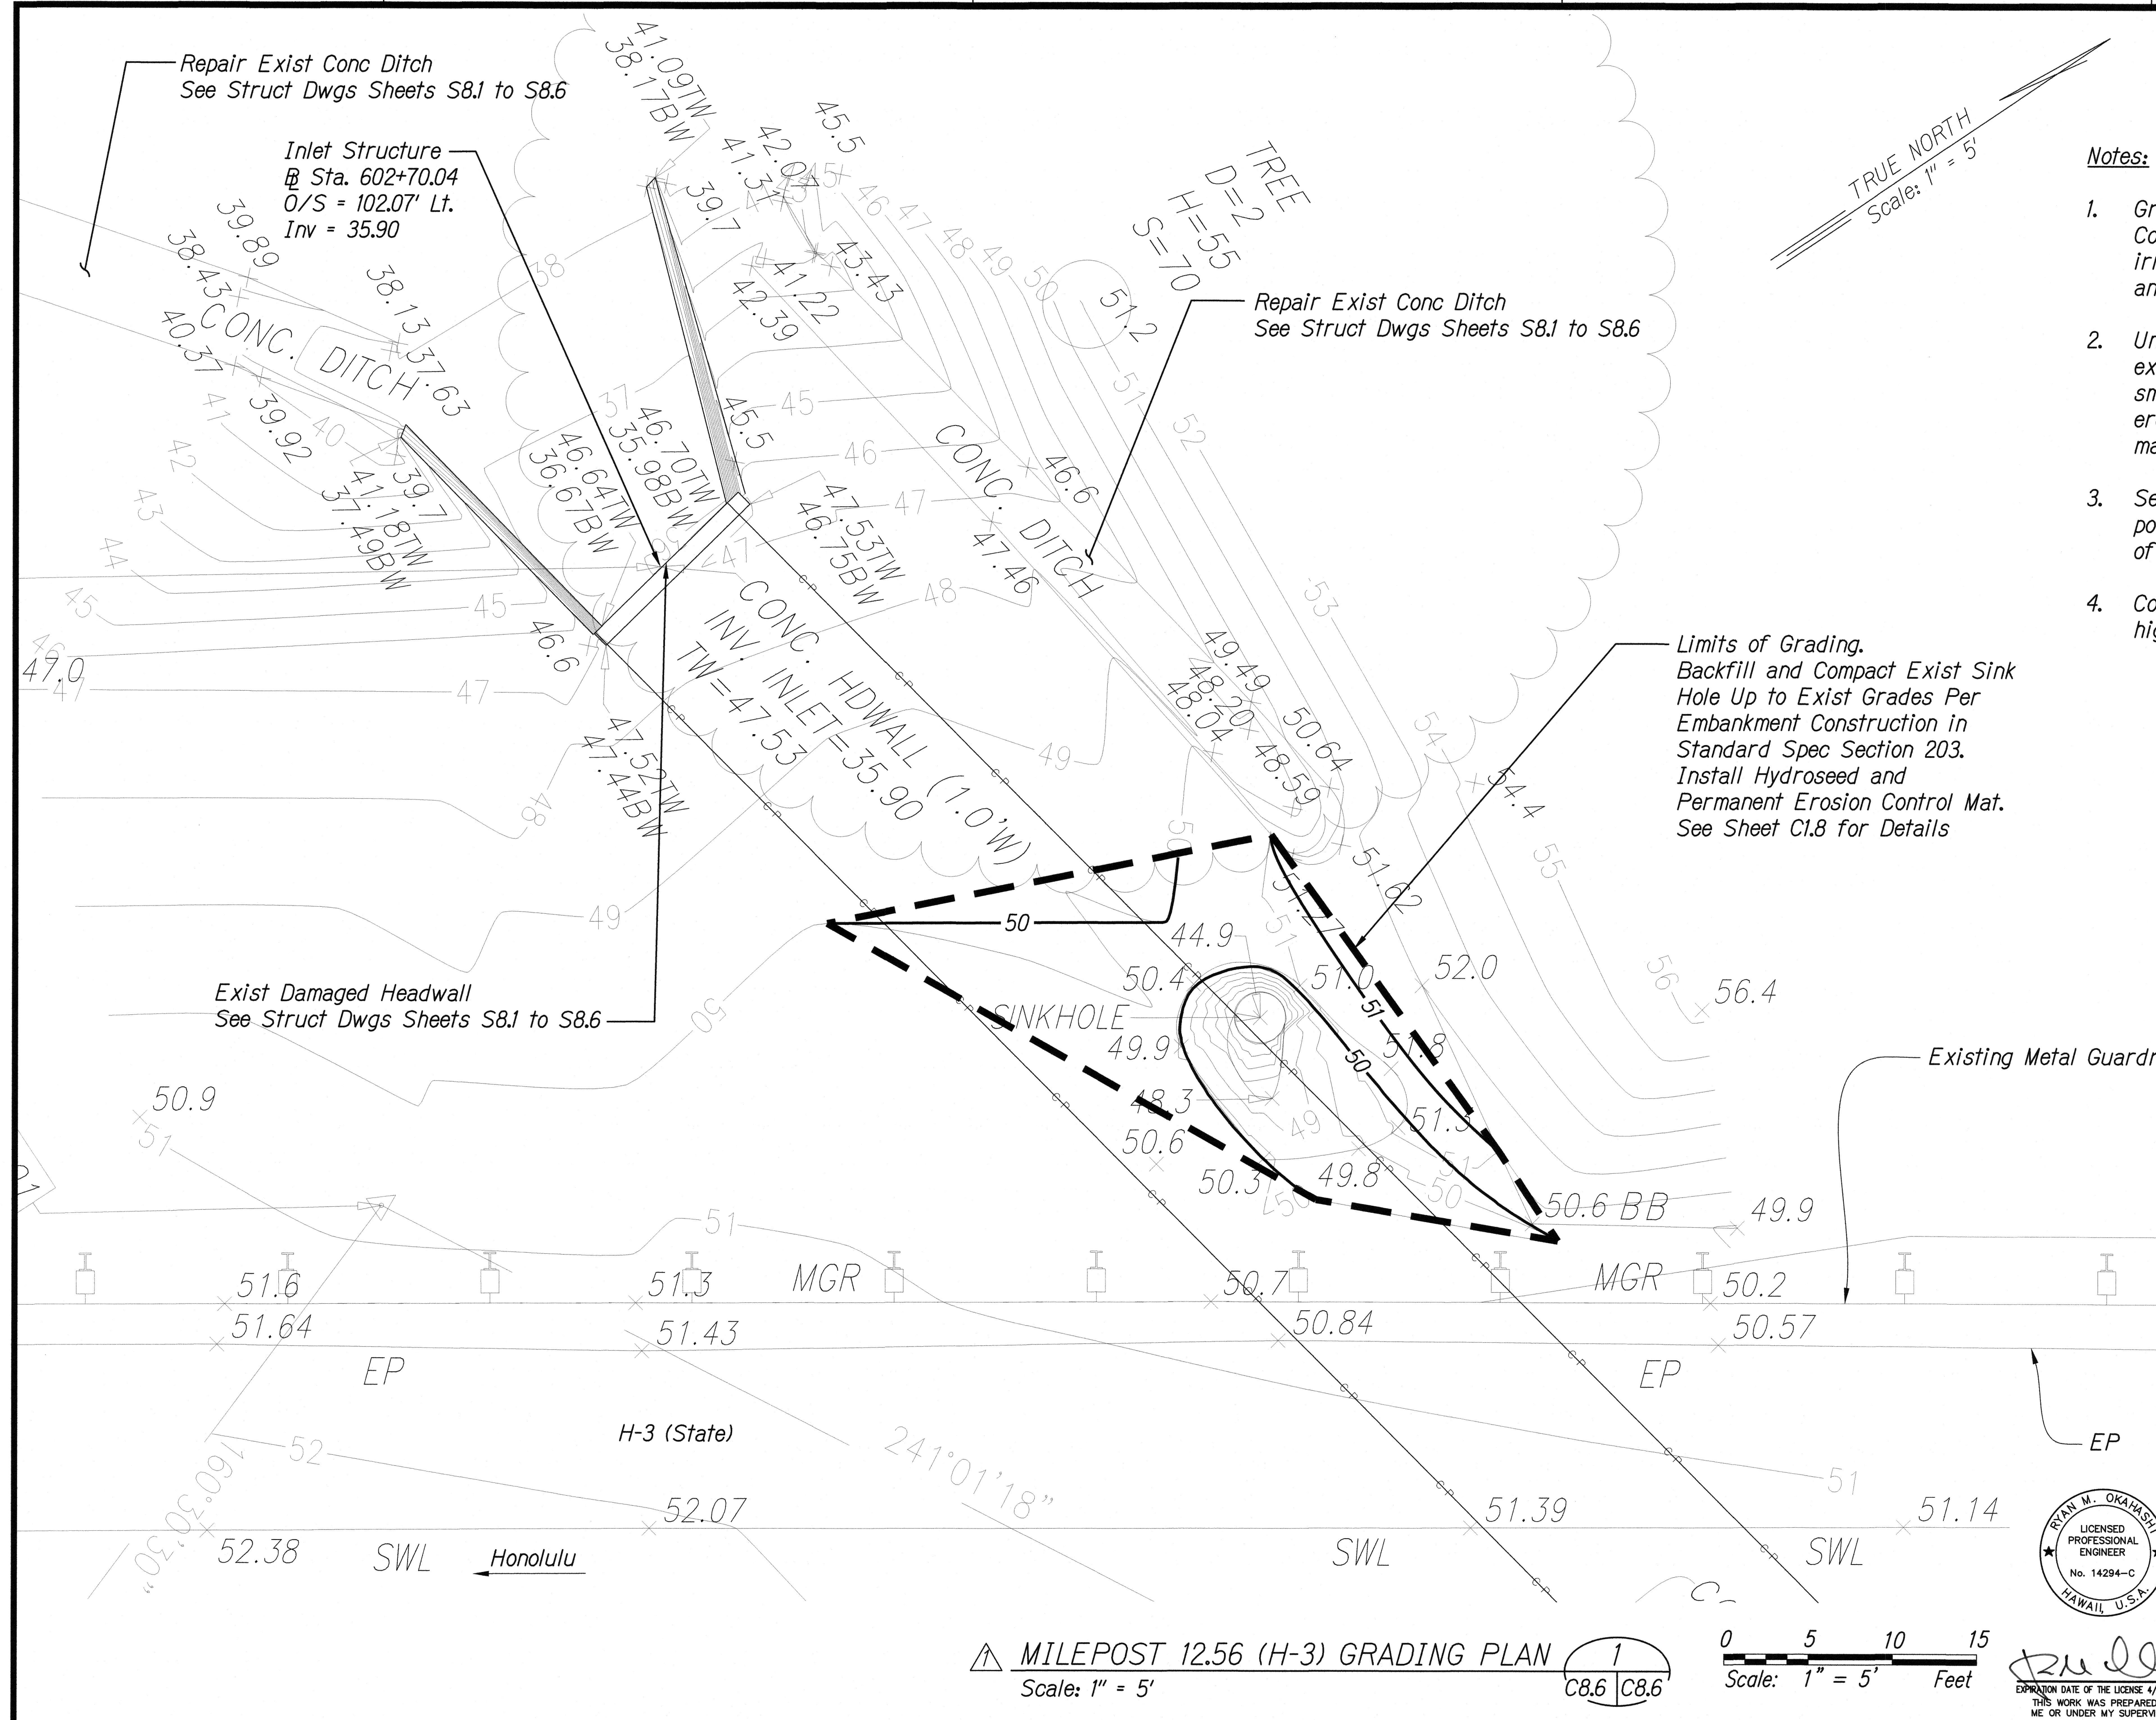


Notes:

- Grading limits are shown in plan view. Contractor shall account for all slope irregularities when performing grading work and installing construction materials.
- Unless otherwise noted on the plans, remove existing trees at ground (12" diameter or smaller) and vegetation within grading and erosion mat limits. Hydroseed prior to erosion mat installation.
- See H-3 MP 14.10 Site Plan on Sheet C3.4 for potential staging areas within the State Right of Way
- Contractor shall protect all existing signs, highway lighting and conduits in the work area.

Estimated Quantities	
Cut	2.49 CY
Fill	5.06 CY
Earthwork	7.55 CY

▲ MILEPOST 12.56 (H-3) GRADING PLAN
Scale: 1" = 5'

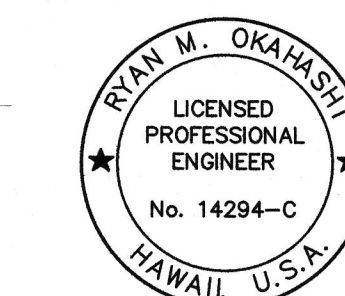

5/30/18	▲ Revised Date and Plan with Topo.
DATE	REVISION

STATE OF HAWAII
DEPARTMENT OF TRANSPORTATION
HIGHWAYS DIVISION

**Grading Plan, Milepost
12.56 (H3) PID No. 701015**


**CULVERT REMEDIATION AT VARIOUS
LOCATIONS ON OAHU, PHASE 2**

Project No. HWY-0-03-18


Scale: As Shown Date: May 2018

SHEET No. C8.6 OF 12 SHEETS

FED. ROAD DIST. NO.	STATE	PROJ. NO.	FISCAL YEAR	SHEET NO.	TOTAL SHEETS
HAWAII	HAW.	HWY-0-03-18	2018	69	93

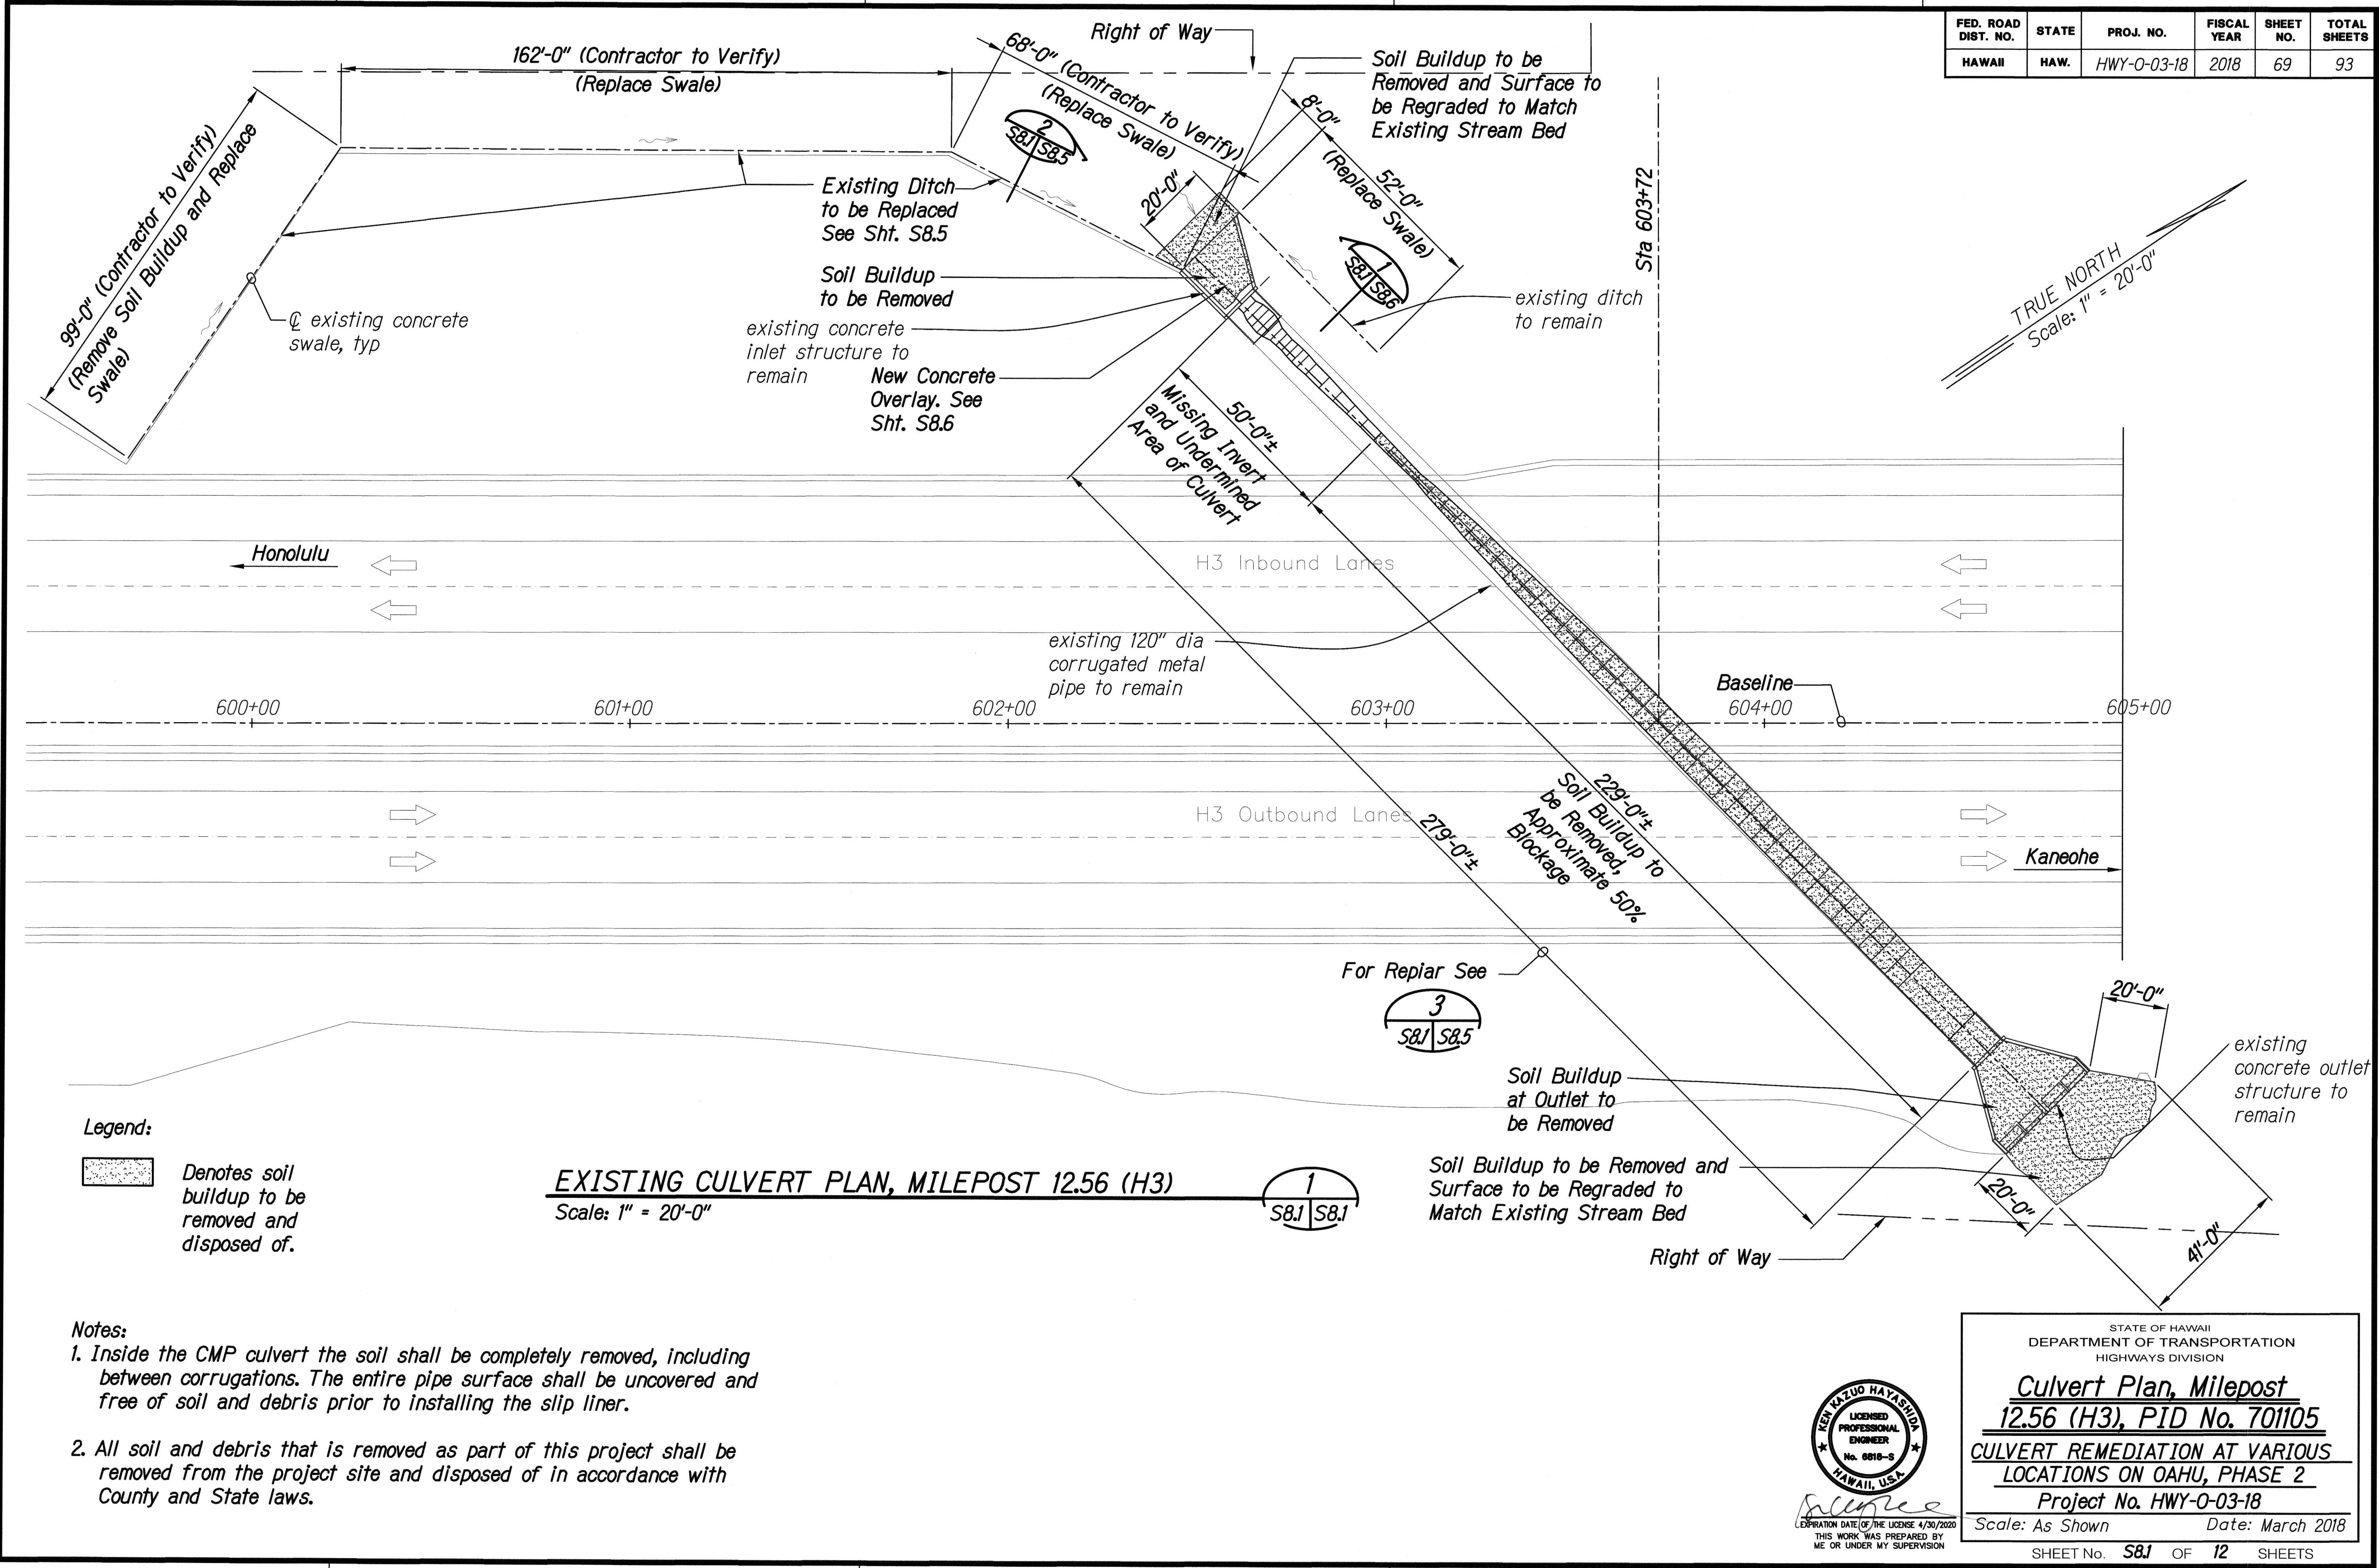


FED. ROAD DIST. NO.	STATE	PROJ. NO.	FISCAL YEAR	SHEET NO.	TOTAL SHEETS
HAWAII	HAW.	HWY-O-03-18	2018	70	93

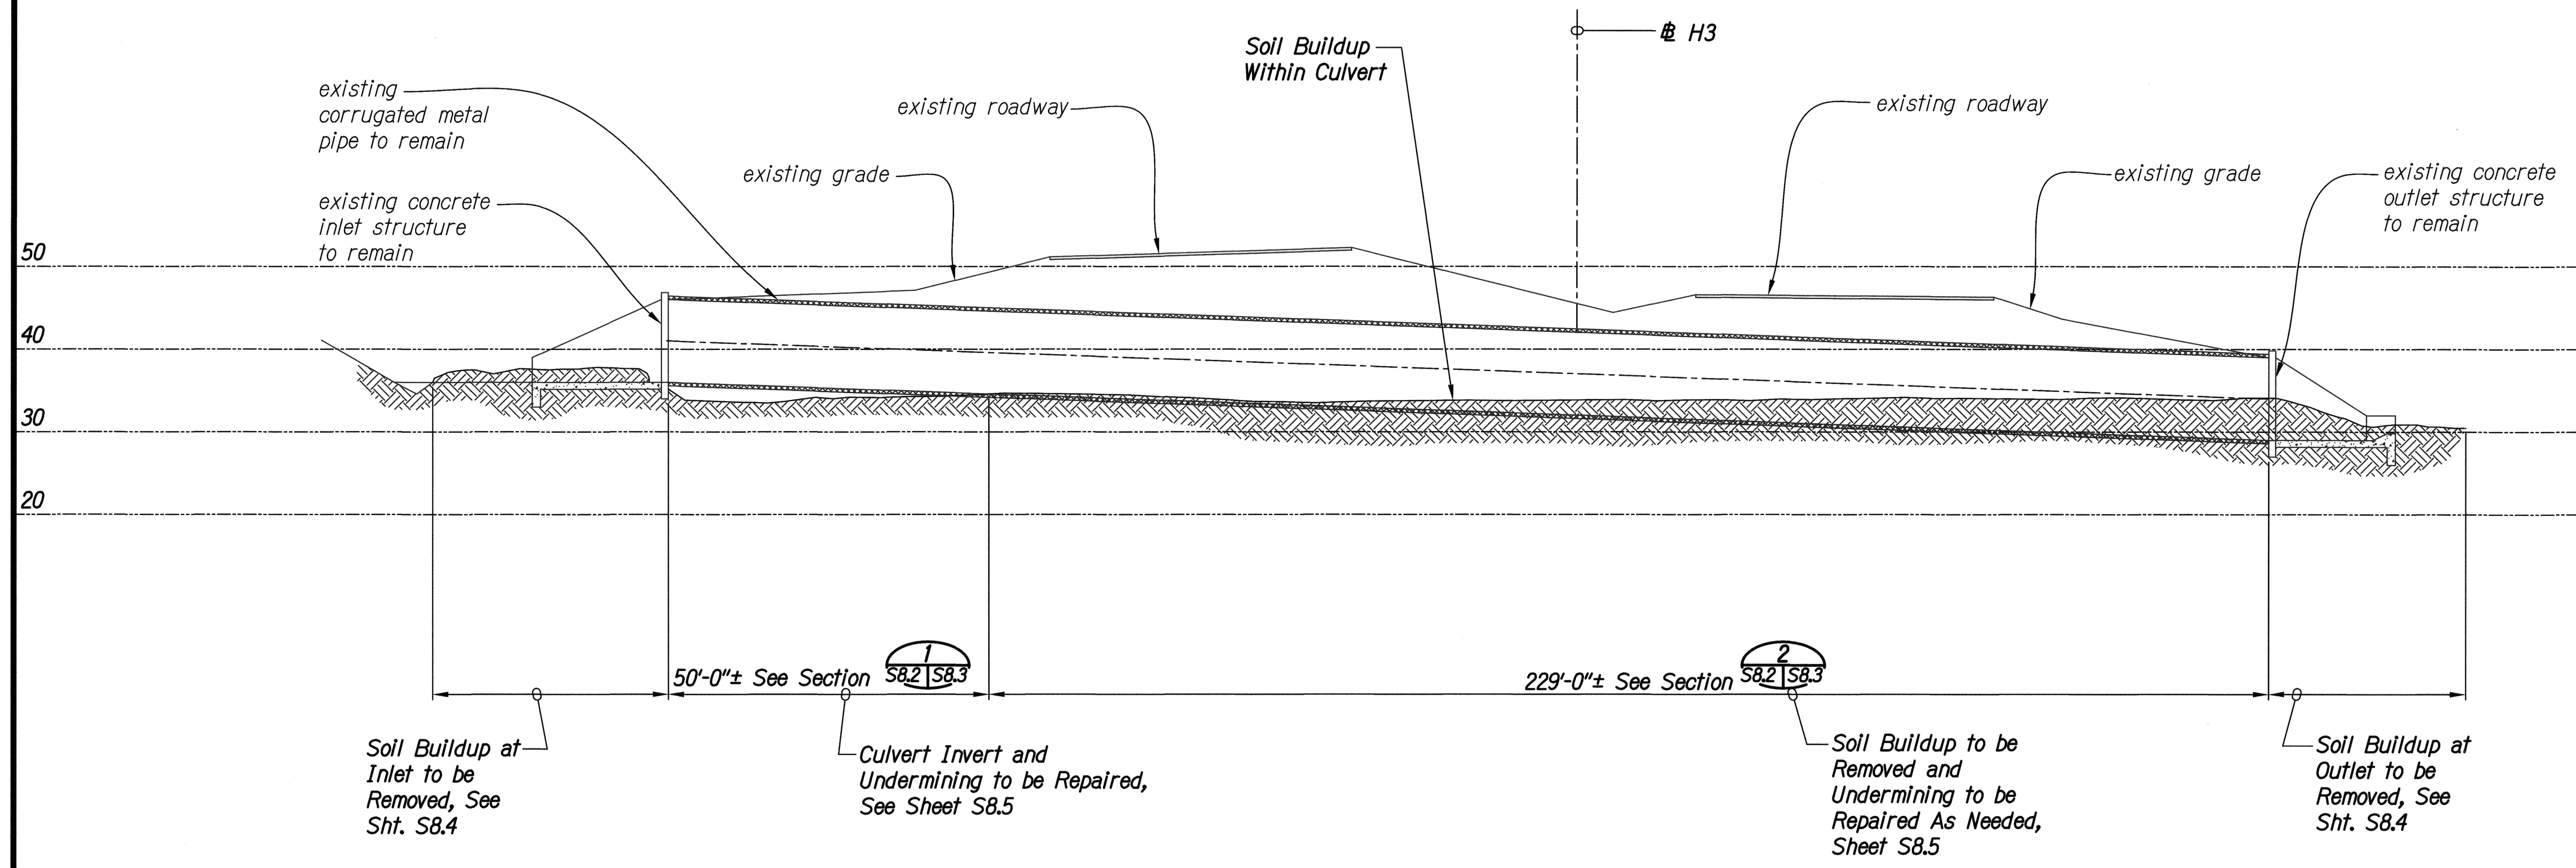

CULVERT LONGITUDINAL SECTION, MILEPOST 12.56 (H3)
Scale: 1" = 20'-0"

1
S8.2 | S8.2

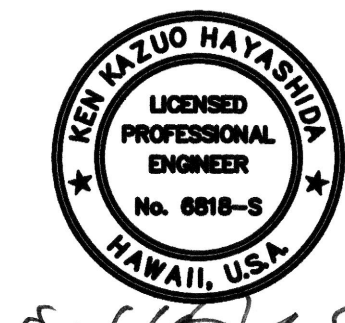

EXPIRATION DATE OF THE LICENSE 4/30/2020
THIS WORK WAS PREPARED BY
ME OR UNDER MY SUPERVISION

STATE OF HAWAII
DEPARTMENT OF TRANSPORTATION
HIGHWAYS DIVISION

Culvert Section
M.P.12.56 (H3) PID No. 701105
CULVERT REMEDIATION AT VARIOUS
LOCATIONS ON OAHU, PHASE 2
Project No. HWY-O-03-18



Scale: As Shown Date: March 2018

SHEET No. **S8.2** OF **12** SHEETS

FED. ROAD DIST. NO.	STATE	PROJ. NO.	FISCAL YEAR	SHEET NO.	TOTAL SHEETS
HAWAII	HAW.	HWY-0-03-18	2018	71	93


Note:

Provide temporary supports as needed after soil removal and prior to installation of sliplining pipe.

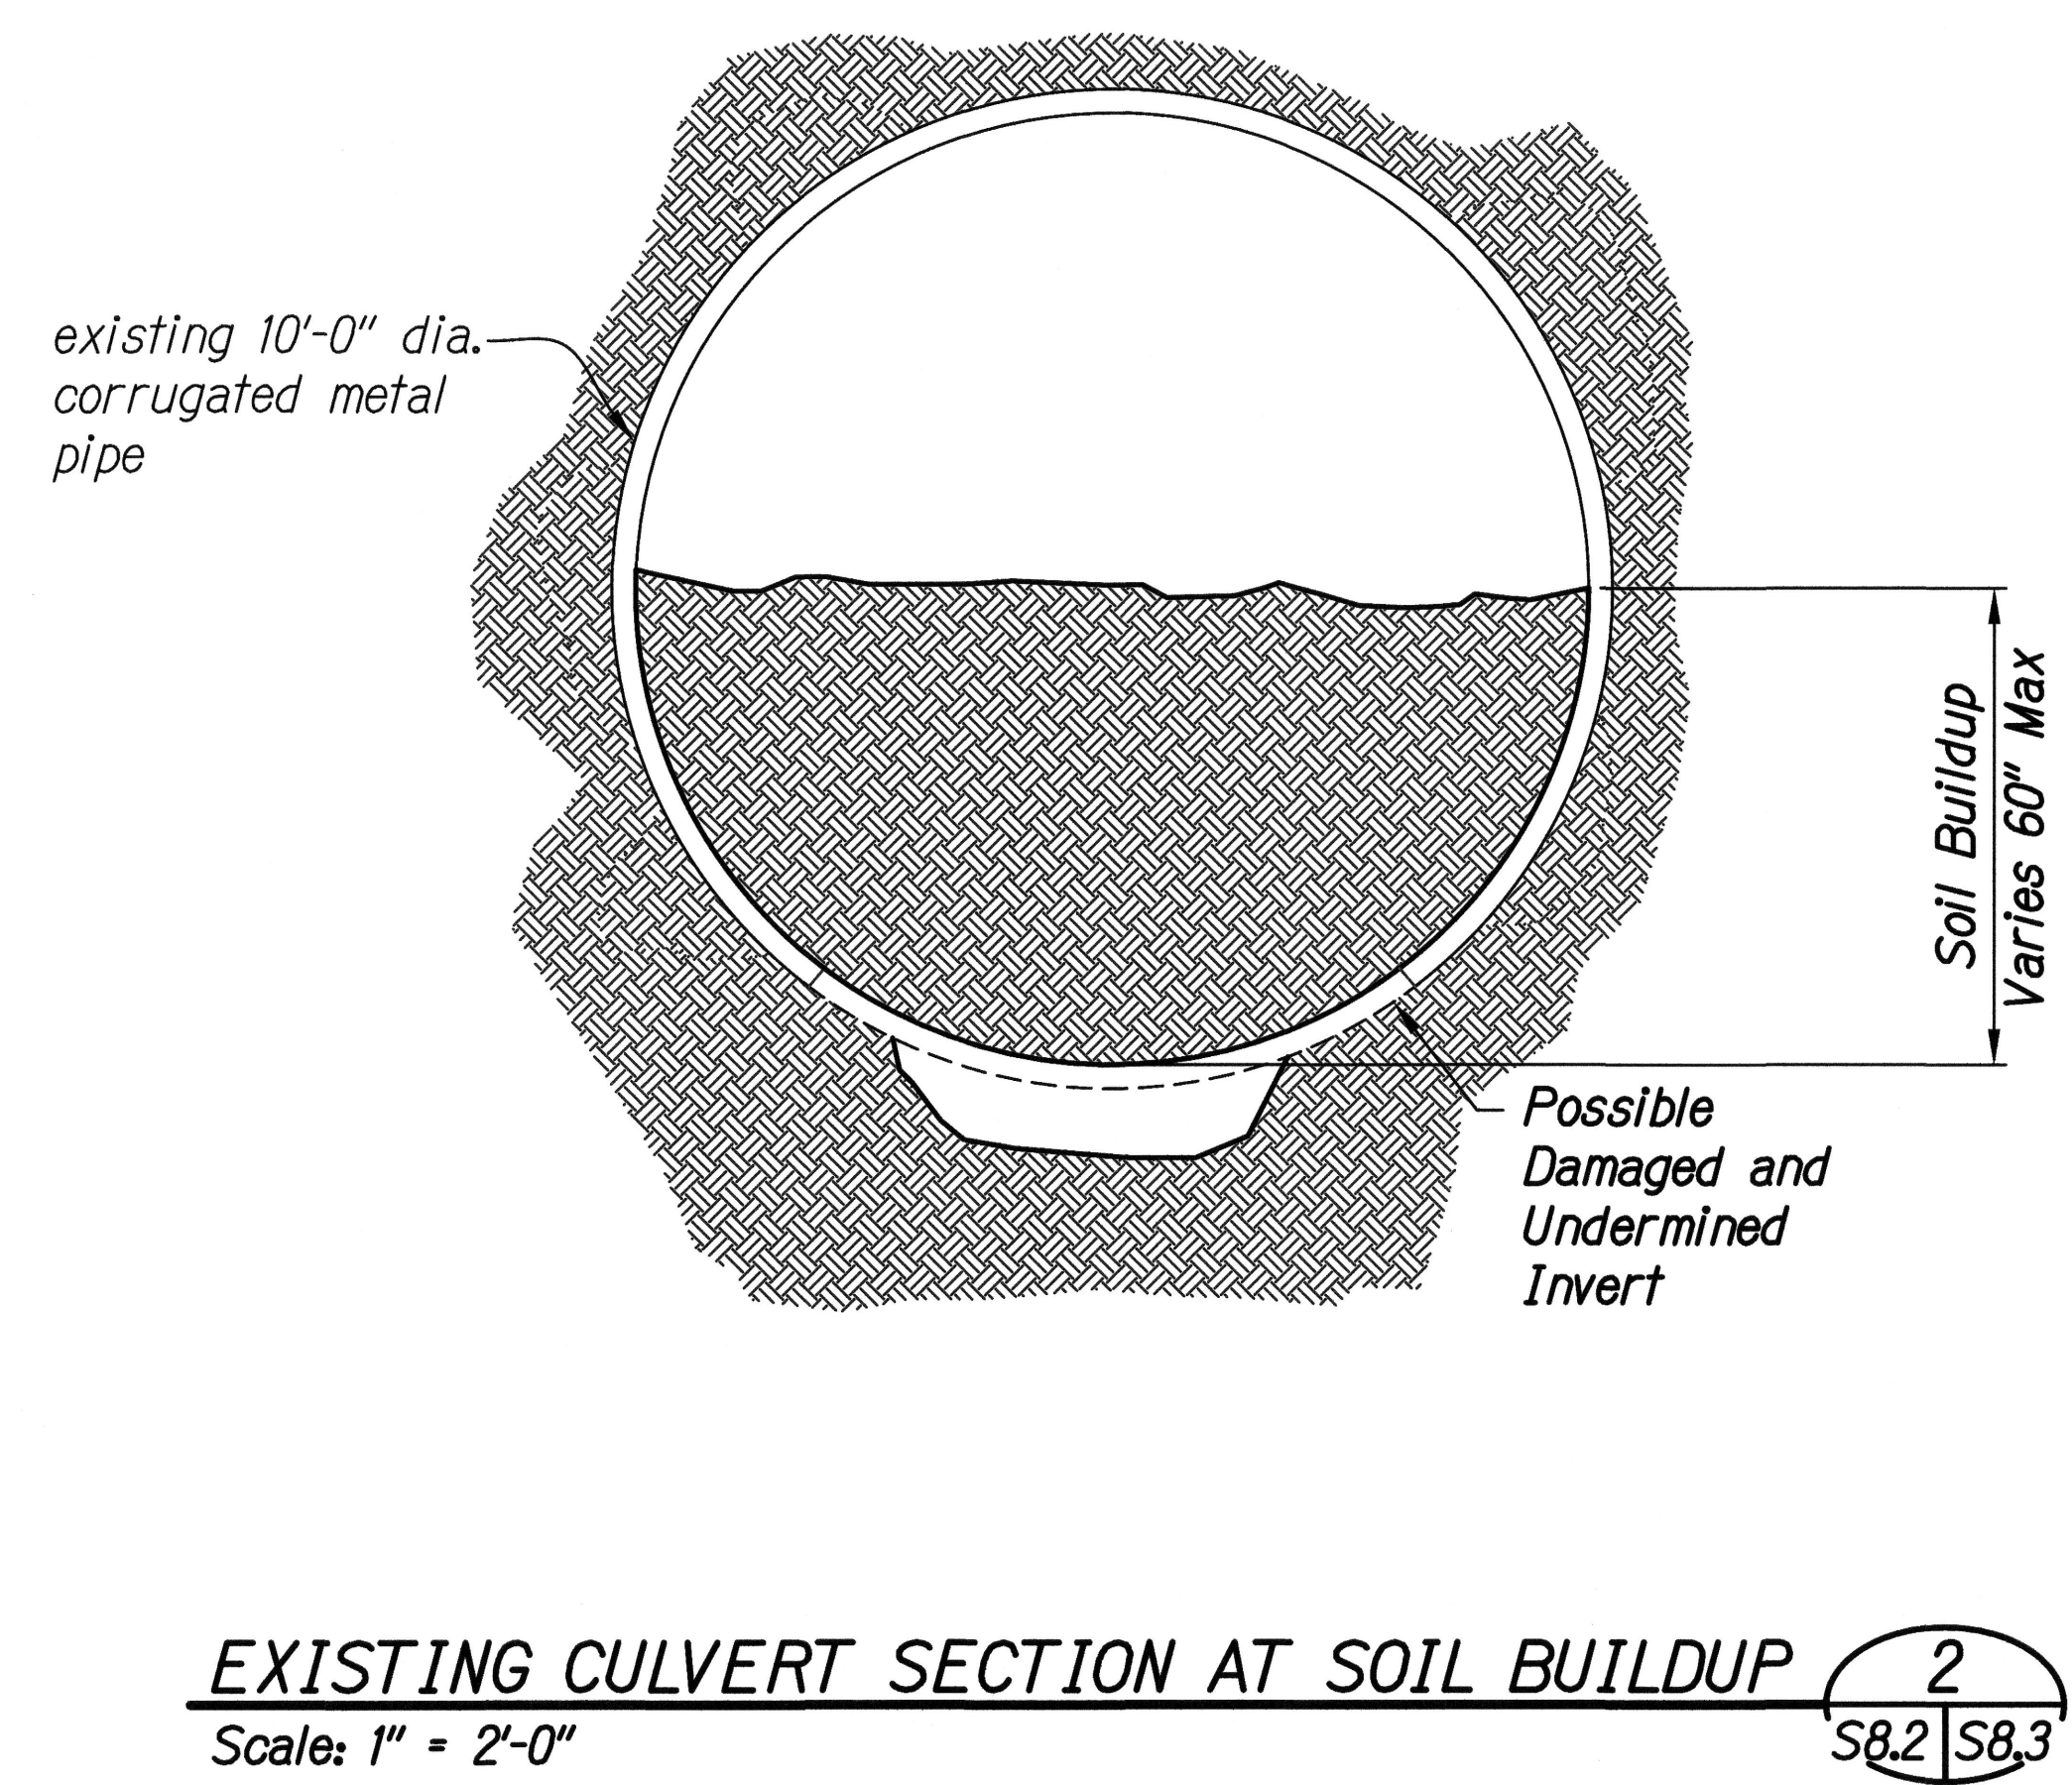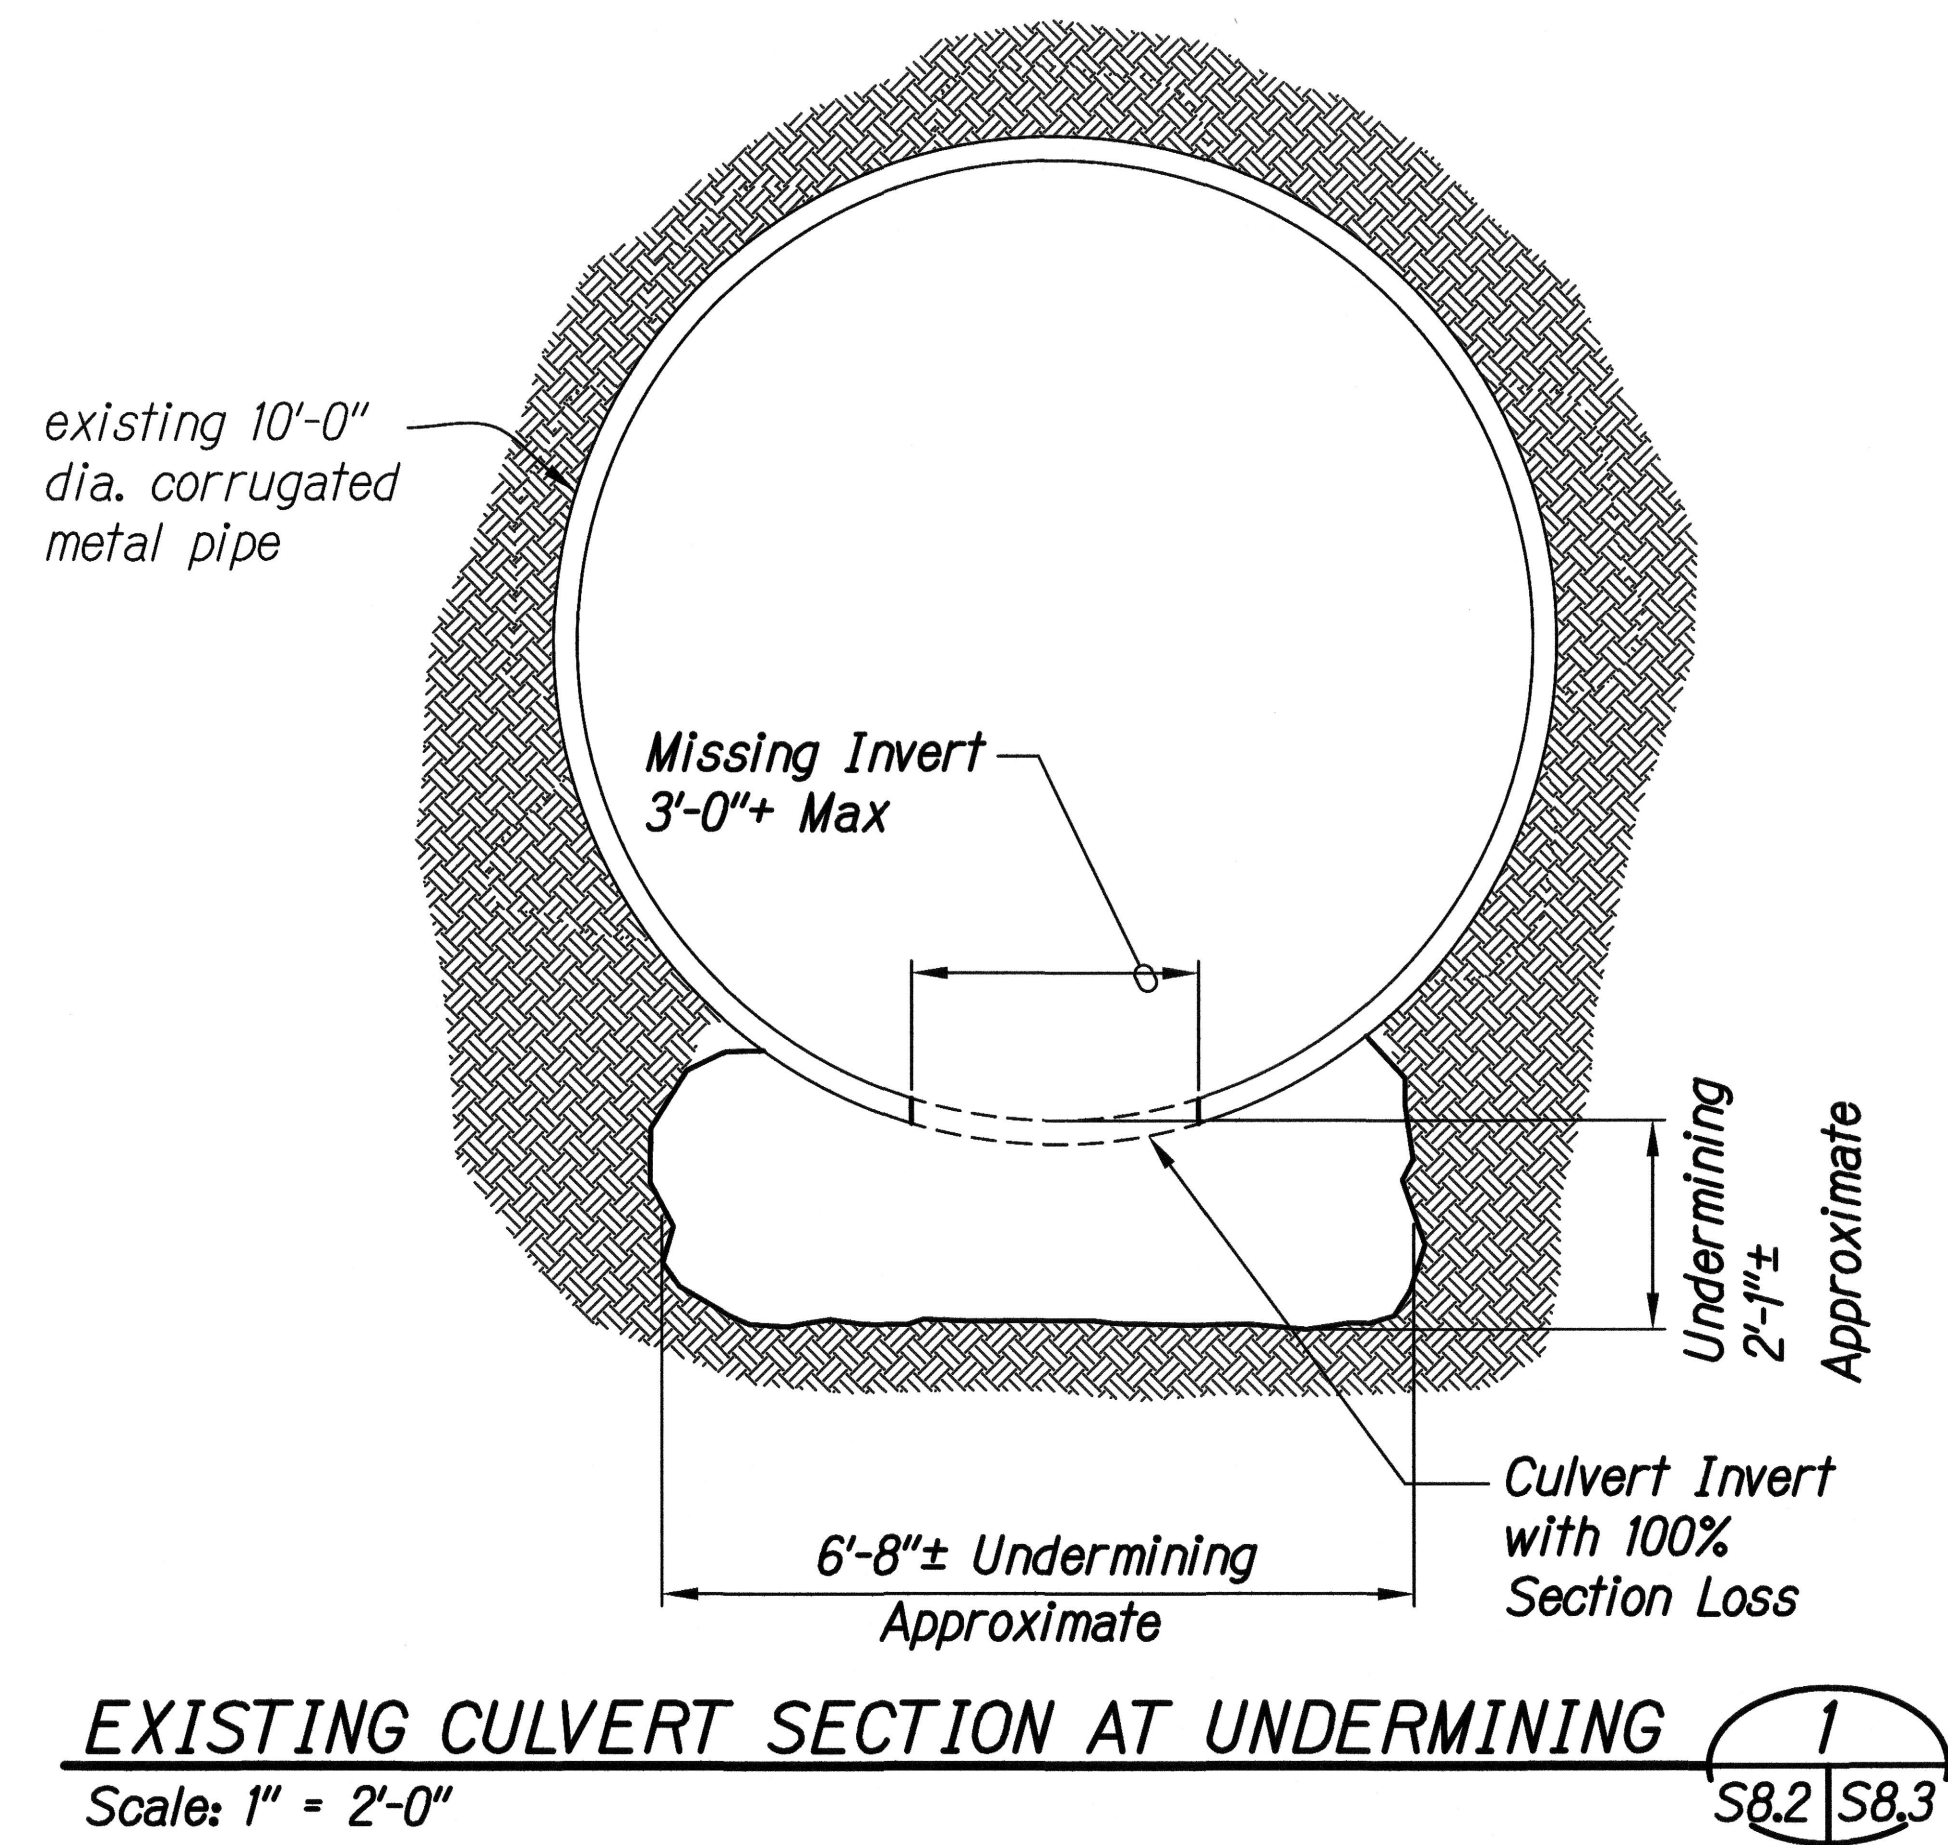

Note:

After the removal of the soil from the culvert is complete, the Engineer will conduct an inspection of the culvert invert. If additional invert repairs are required, beyond what is quantified herein, the contractor shall make the repairs in accordance with Sht. S8.5.



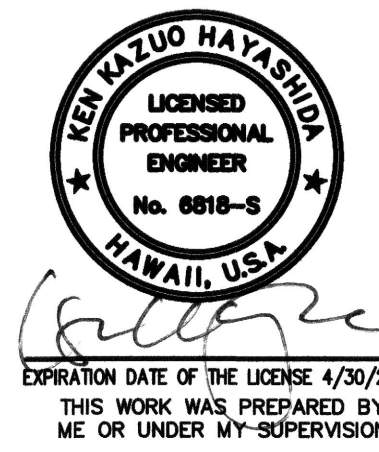


STATE OF HAWAII
DEPARTMENT OF TRANSPORTATION
HIGHWAYS DIVISION




Existing Culvert Sections
M.P.T 12.56 (H3) PID No. 701105
CULVERT REMEDIATION AT VARIOUS LOCATIONS ON OAHU, PHASE 2
Project No. HWY-0-03-18
Scale: As Shown Date: March 2018

SHEET No. **S8.3** OF **12** SHEETS


FED. ROAD DIST. NO.	STATE	PROJ. NO.	FISCAL YEAR	SHEET NO.	TOTAL SHEETS
HAWAII	HAW.	HWY-O-03-18	2018	72	93

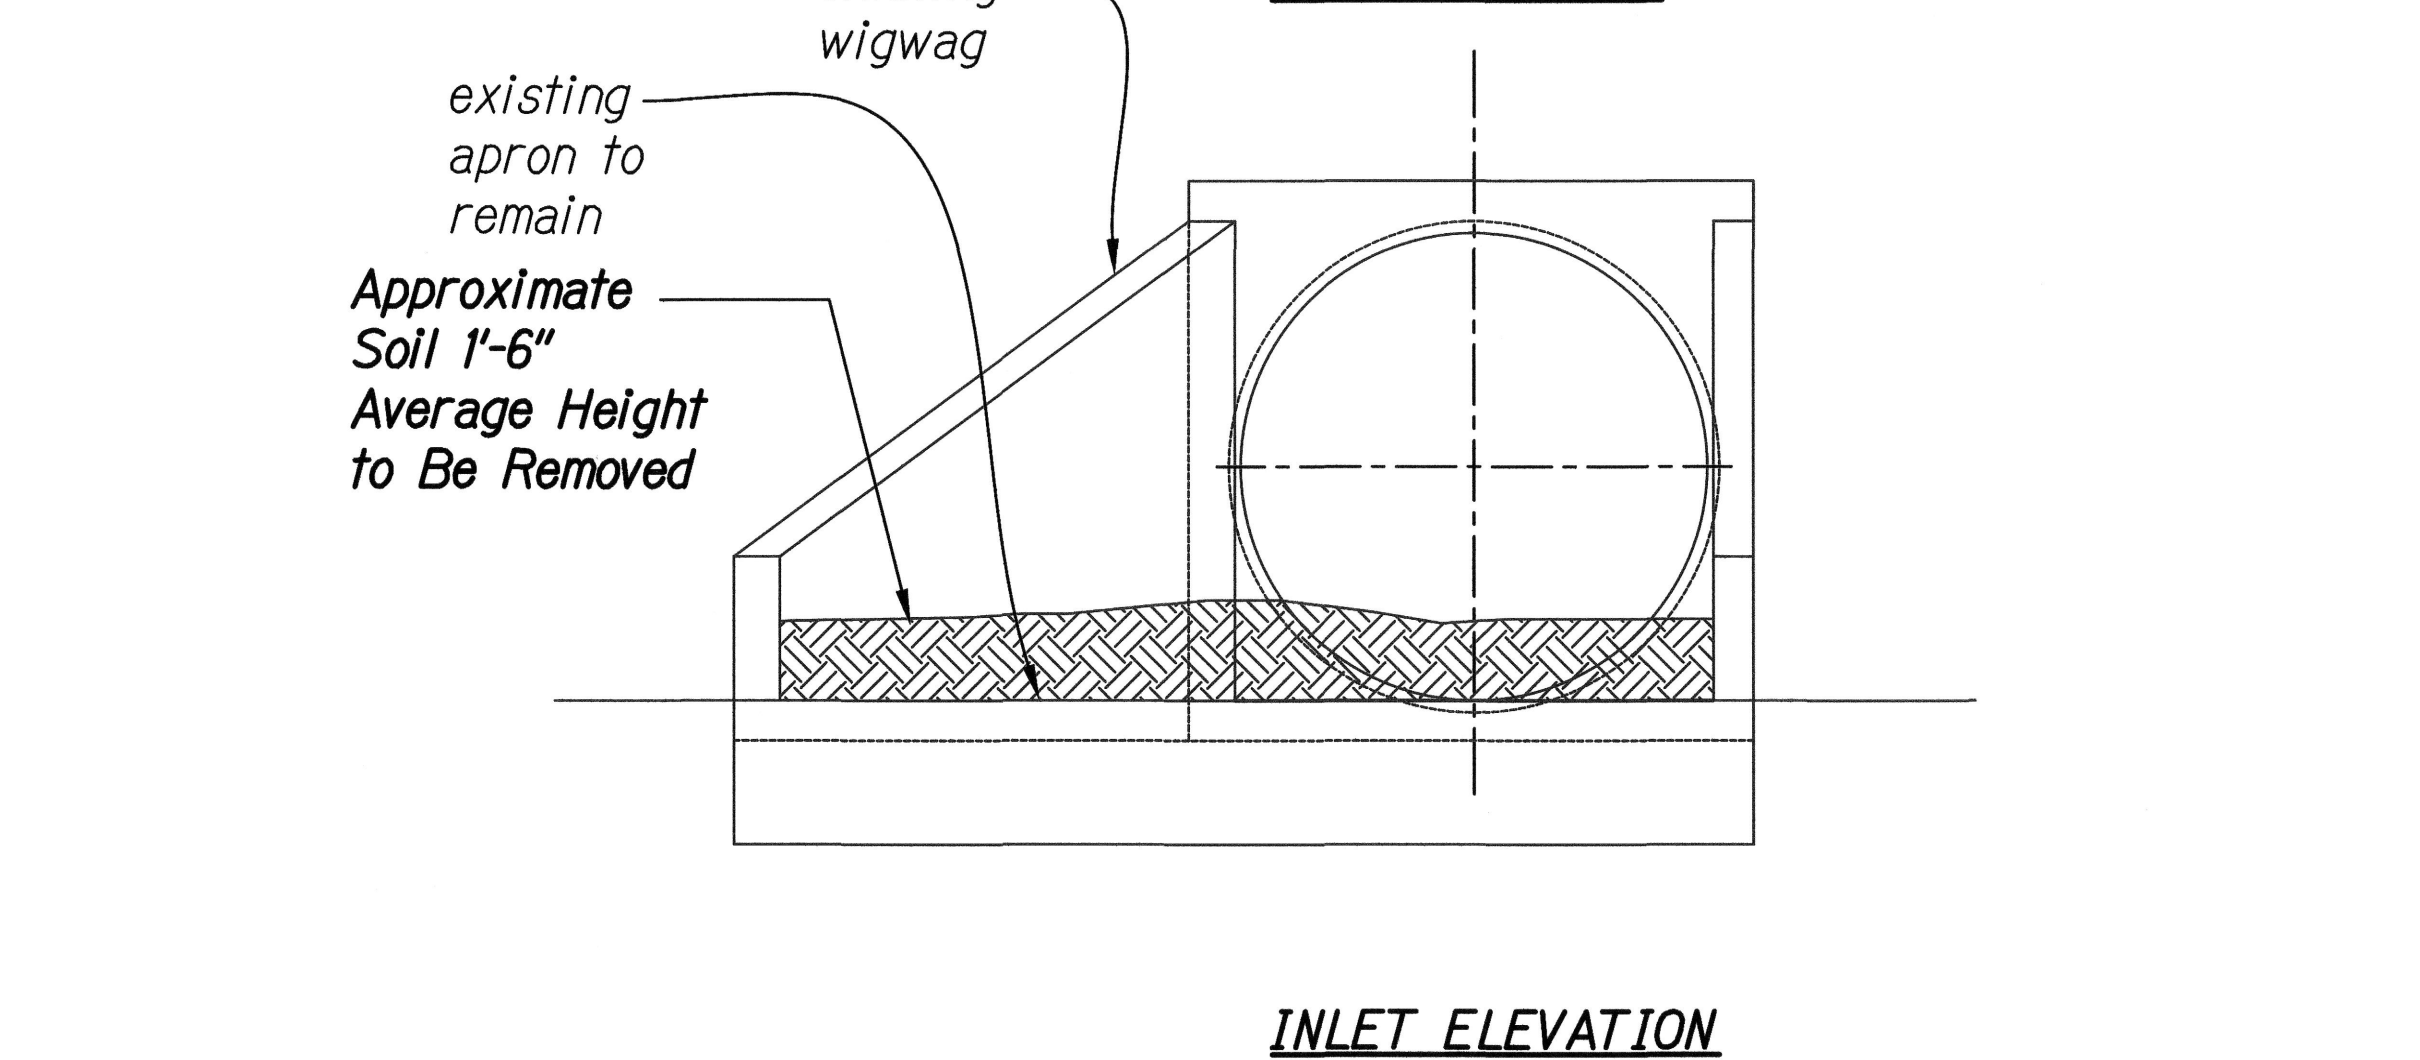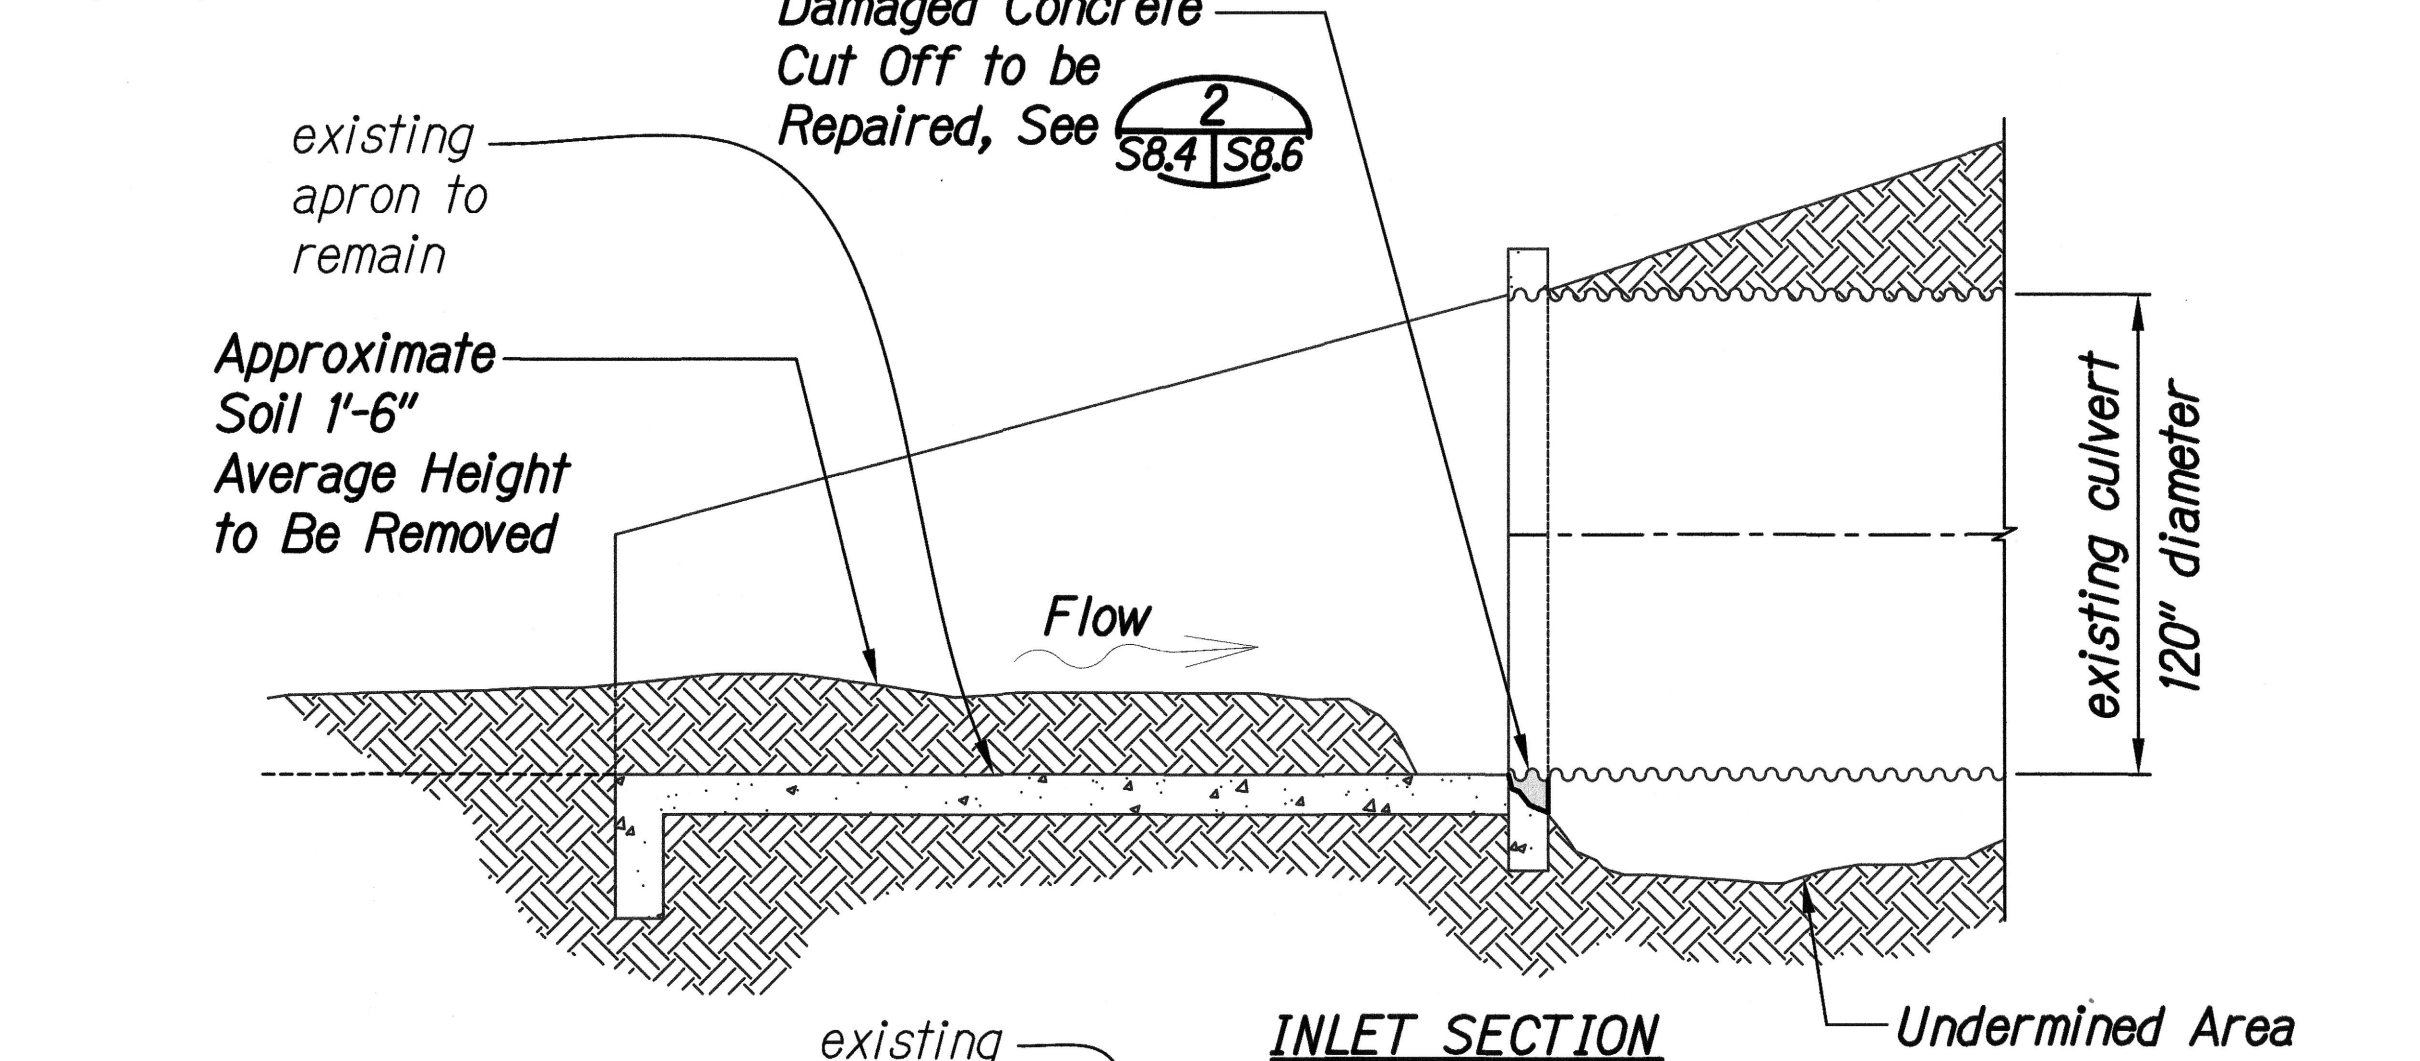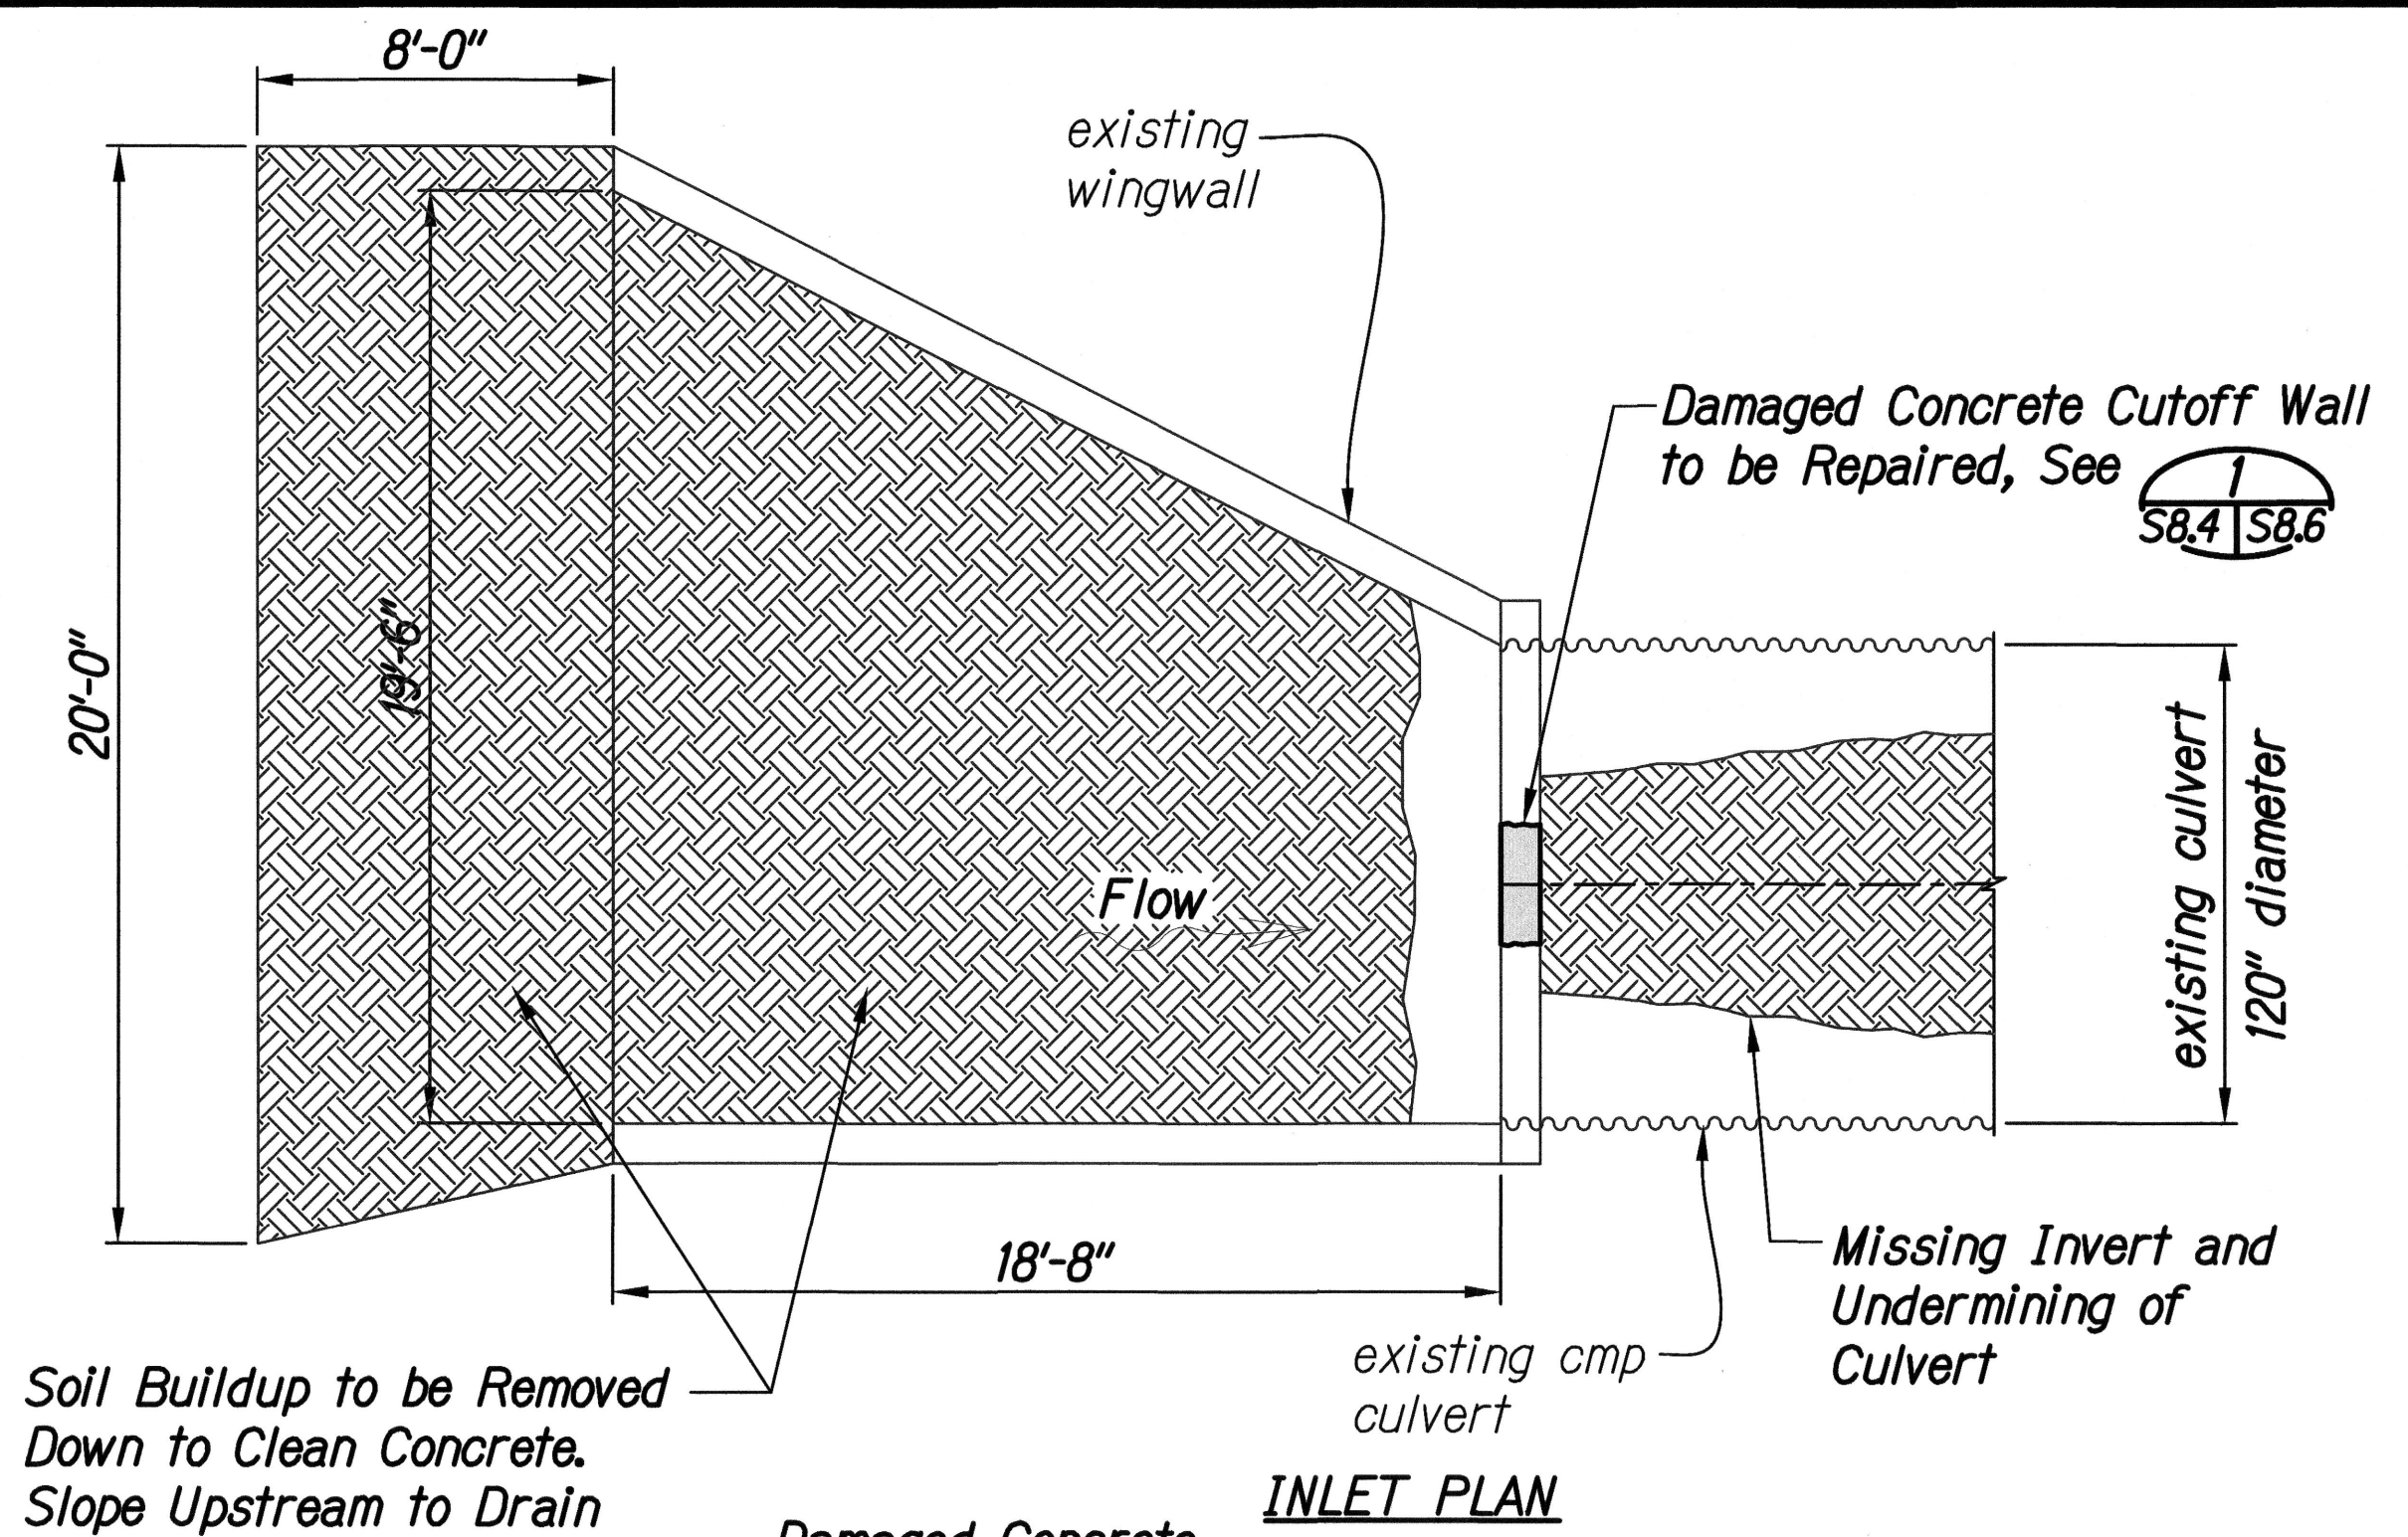

INLET STRUCTURE EXISTING CONDITION
Scale: 1" = 4'-0"
1
S8.4 S8.4

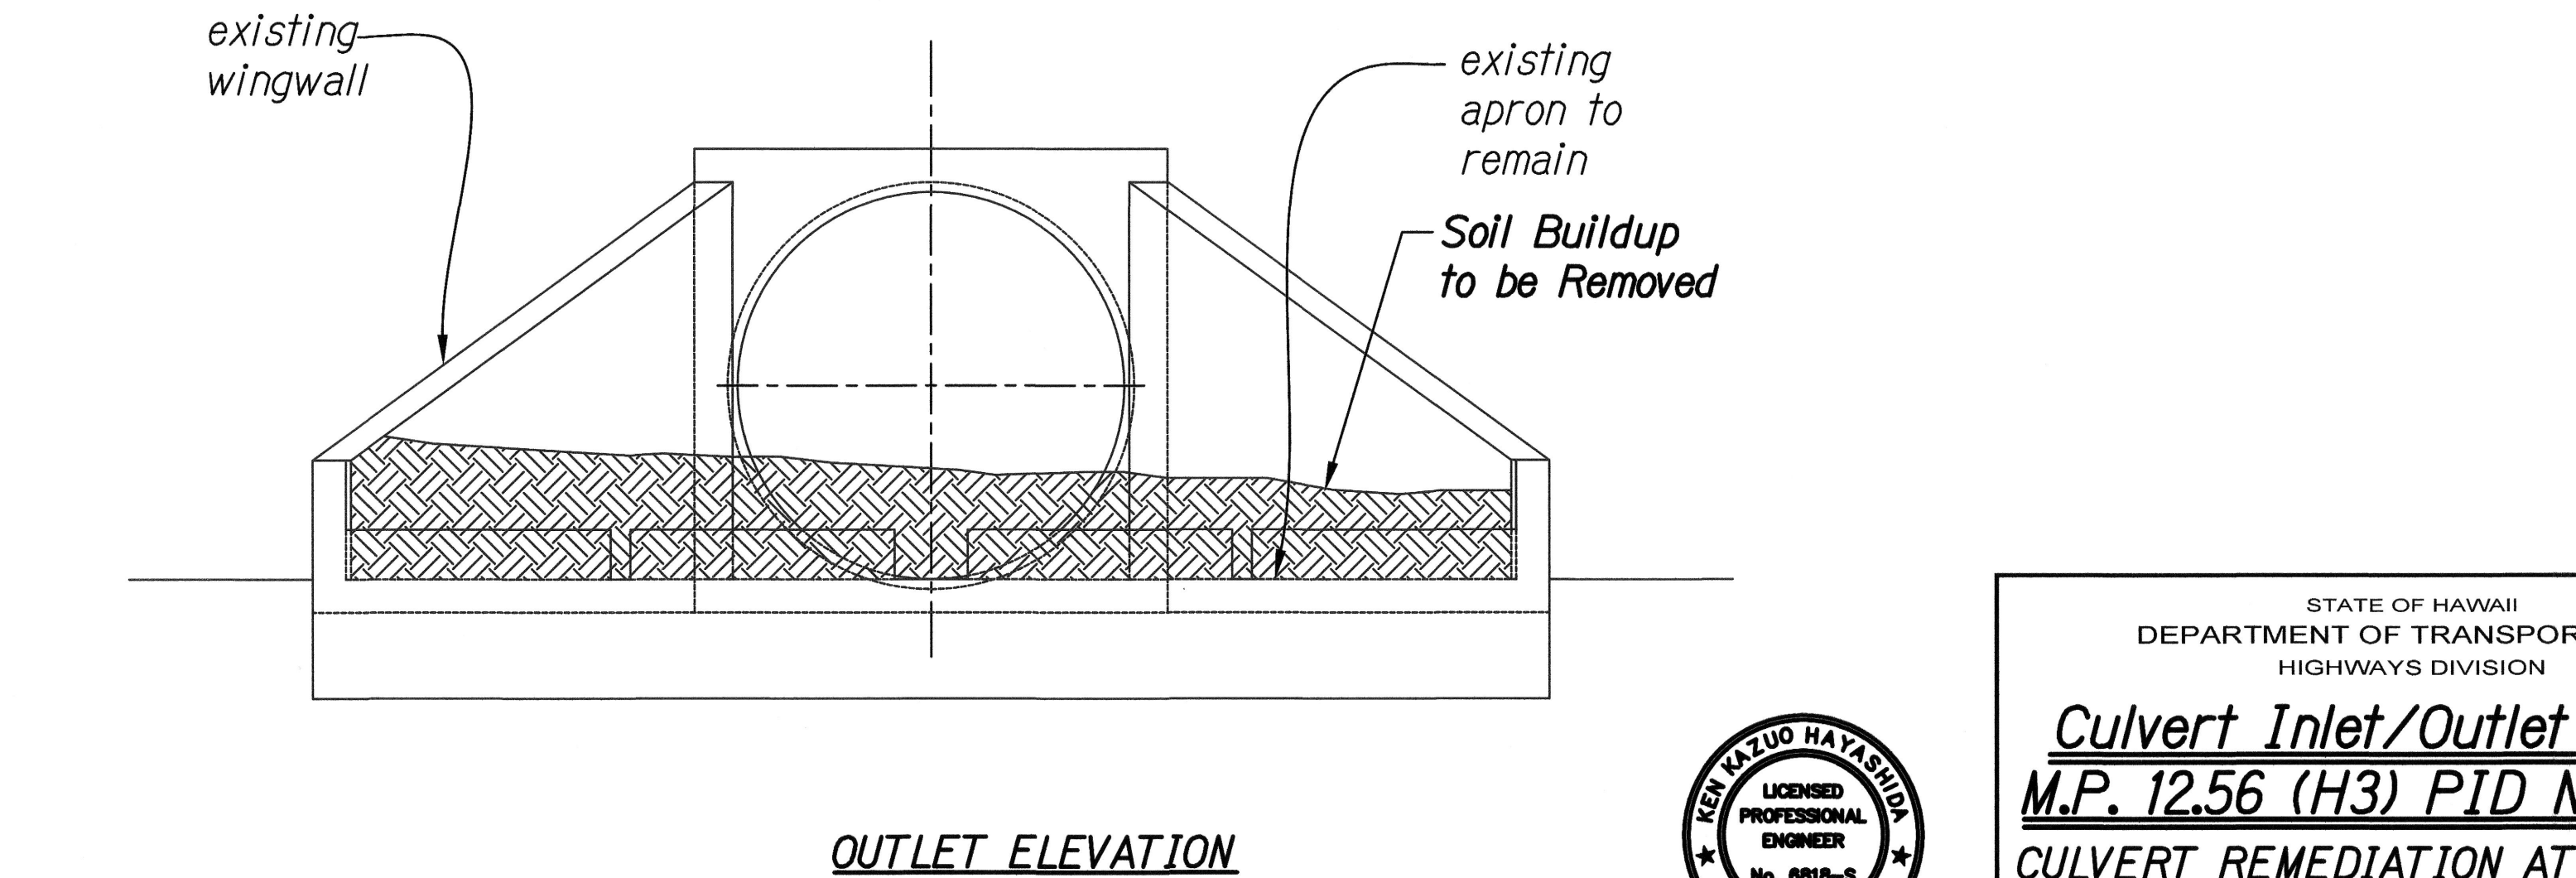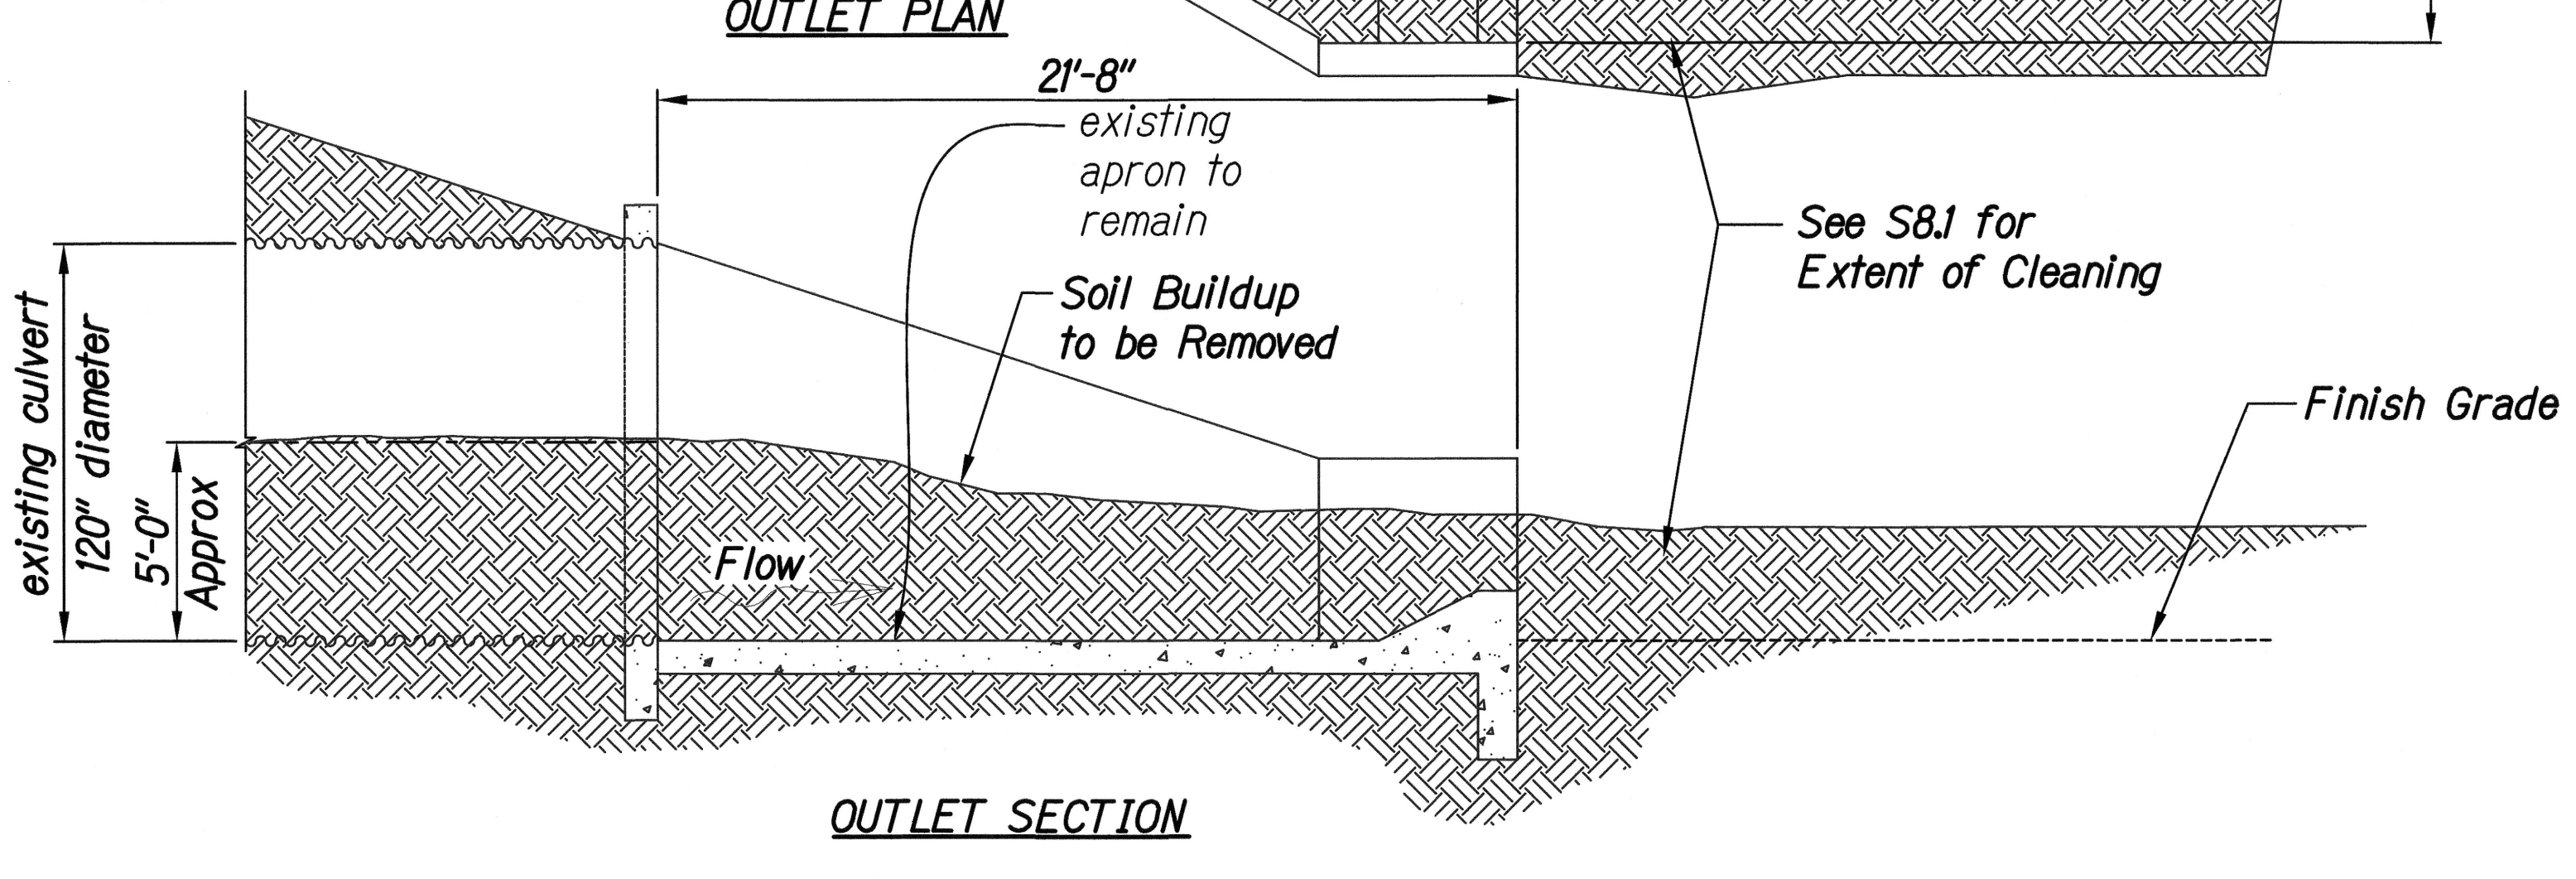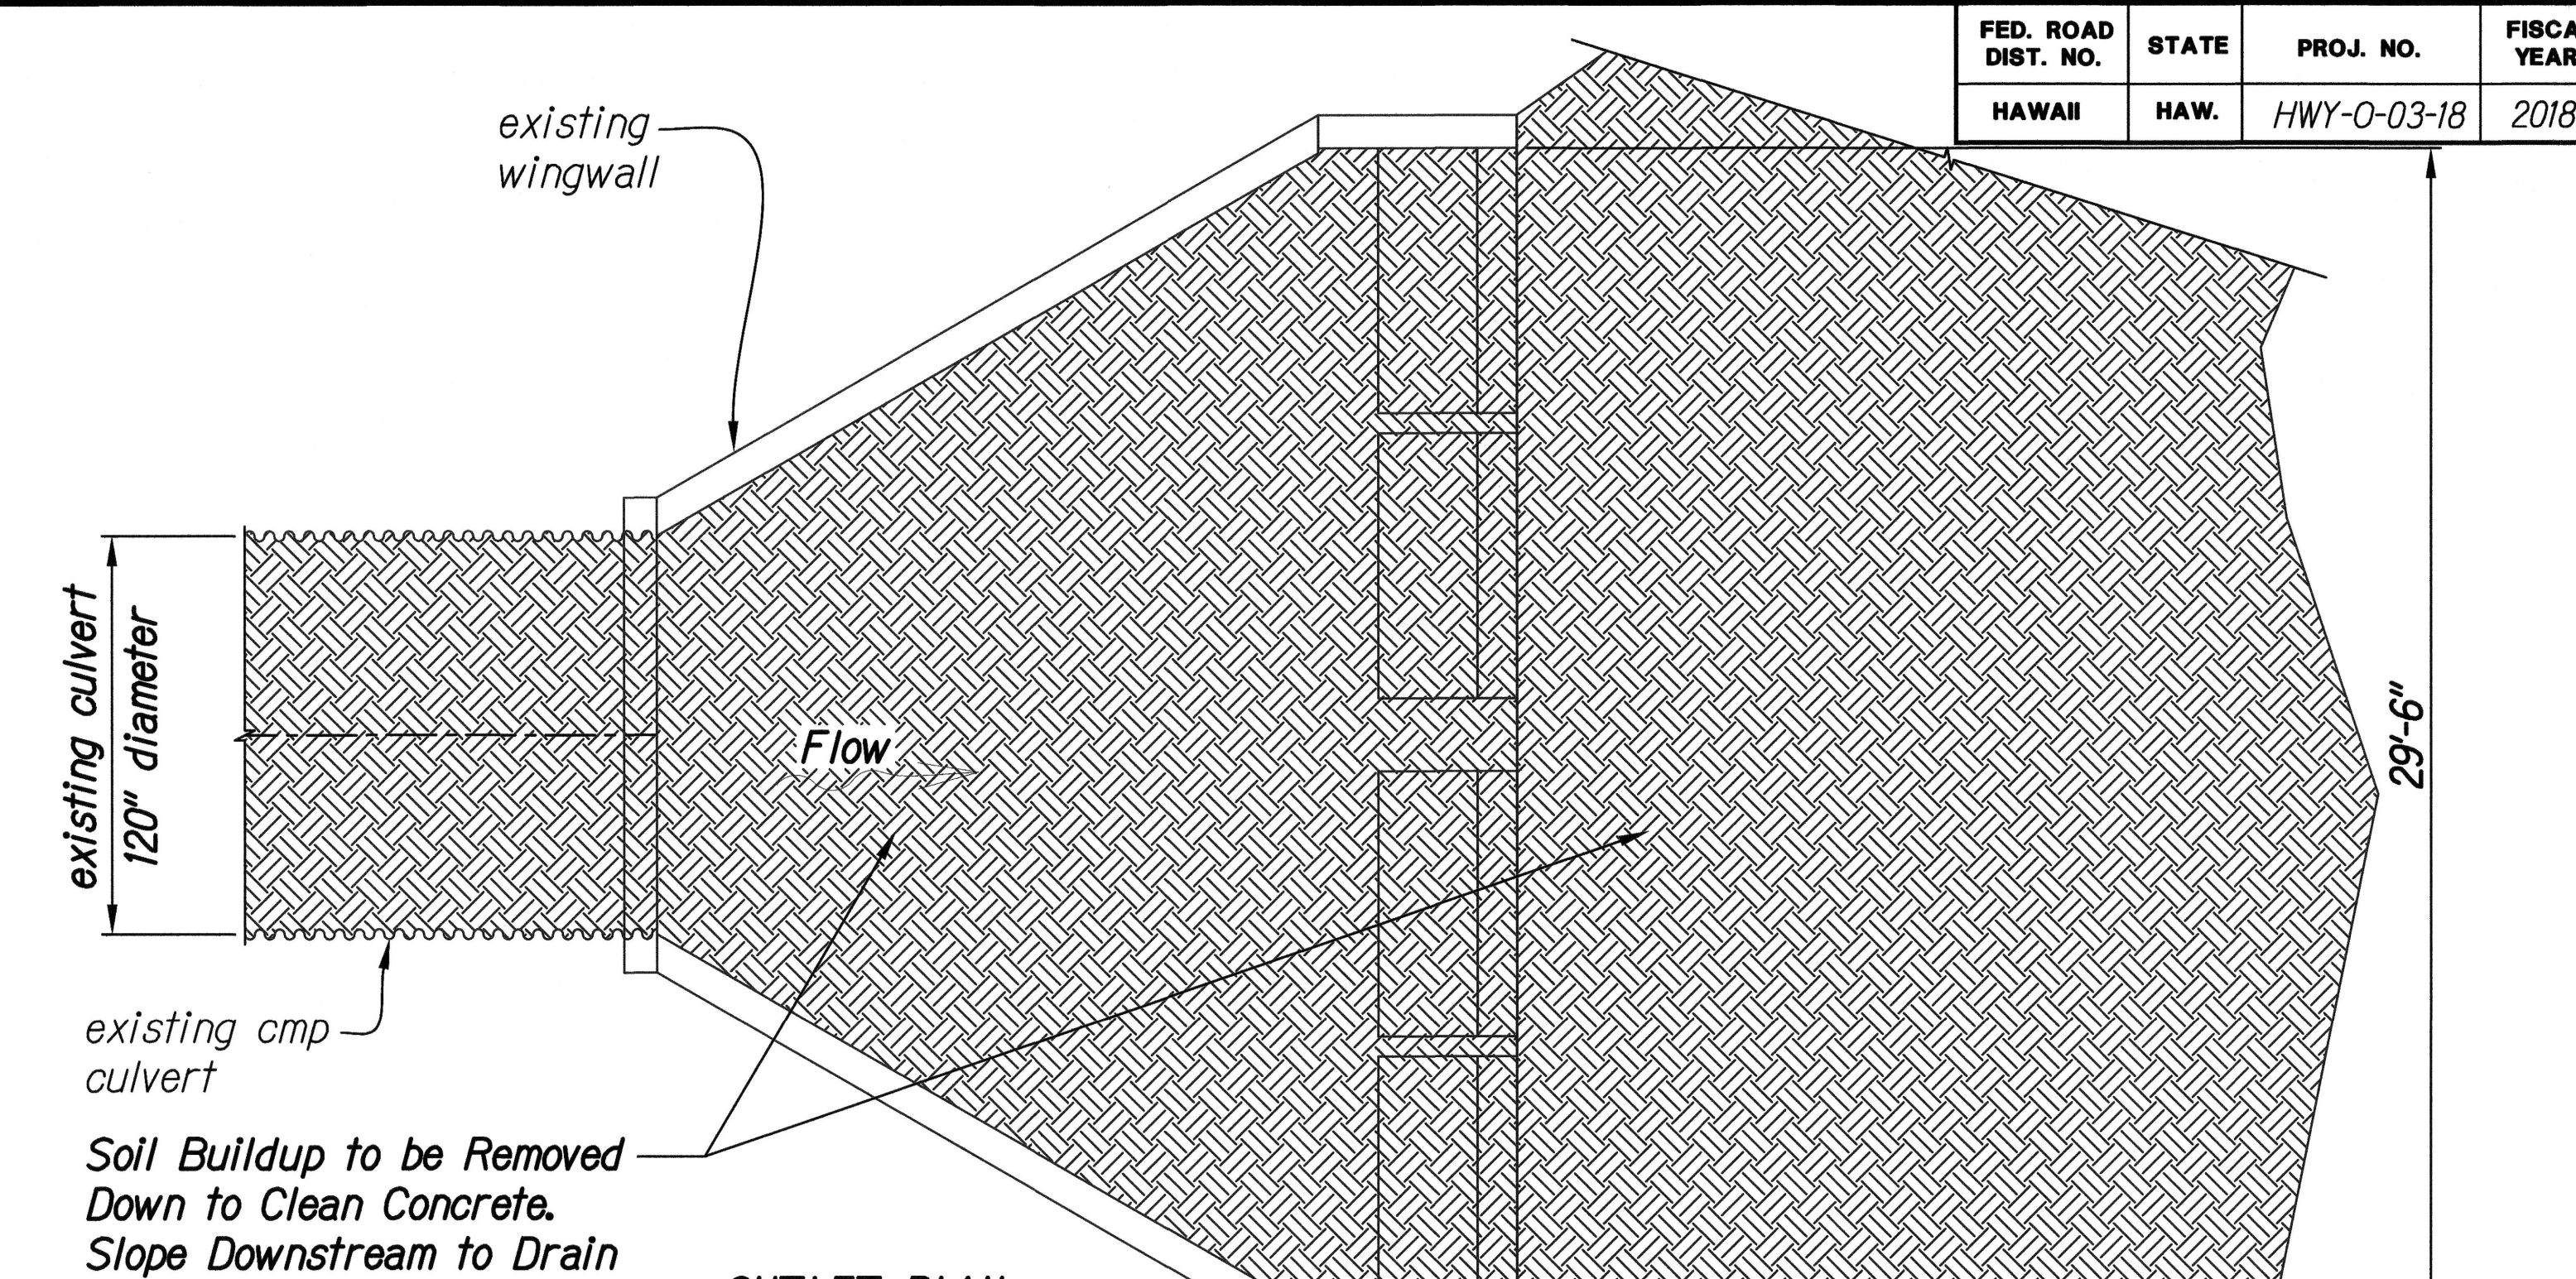


OUTLET STRUCTURE EXISTING CONDITION
Scale: 1" = 4'-0"
2
S8.4 S8.4

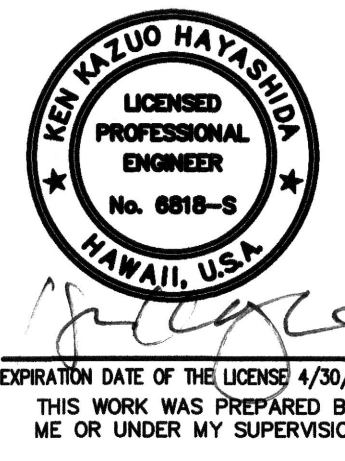

STATE OF HAWAII
DEPARTMENT OF TRANSPORTATION
HIGHWAYS DIVISION

Culvert Inlet/Outlet Details
M.P. 12.56 (H3) PID No. 701105
CULVERT REMEDIATION AT VARIOUS LOCATIONS ON OAHU, PHASE 2
Project No. HWY-O-03-18
Scale: As Shown Date: March 2018
SHEET No. **S8.4** OF **12** SHEETS


FED. ROAD DIST. NO.	STATE	PROJ. NO.	FISCAL YEAR	SHEET NO.	TOTAL SHEETS
HAWAII	HAW.	HWY-0-03-18	2018	73	93

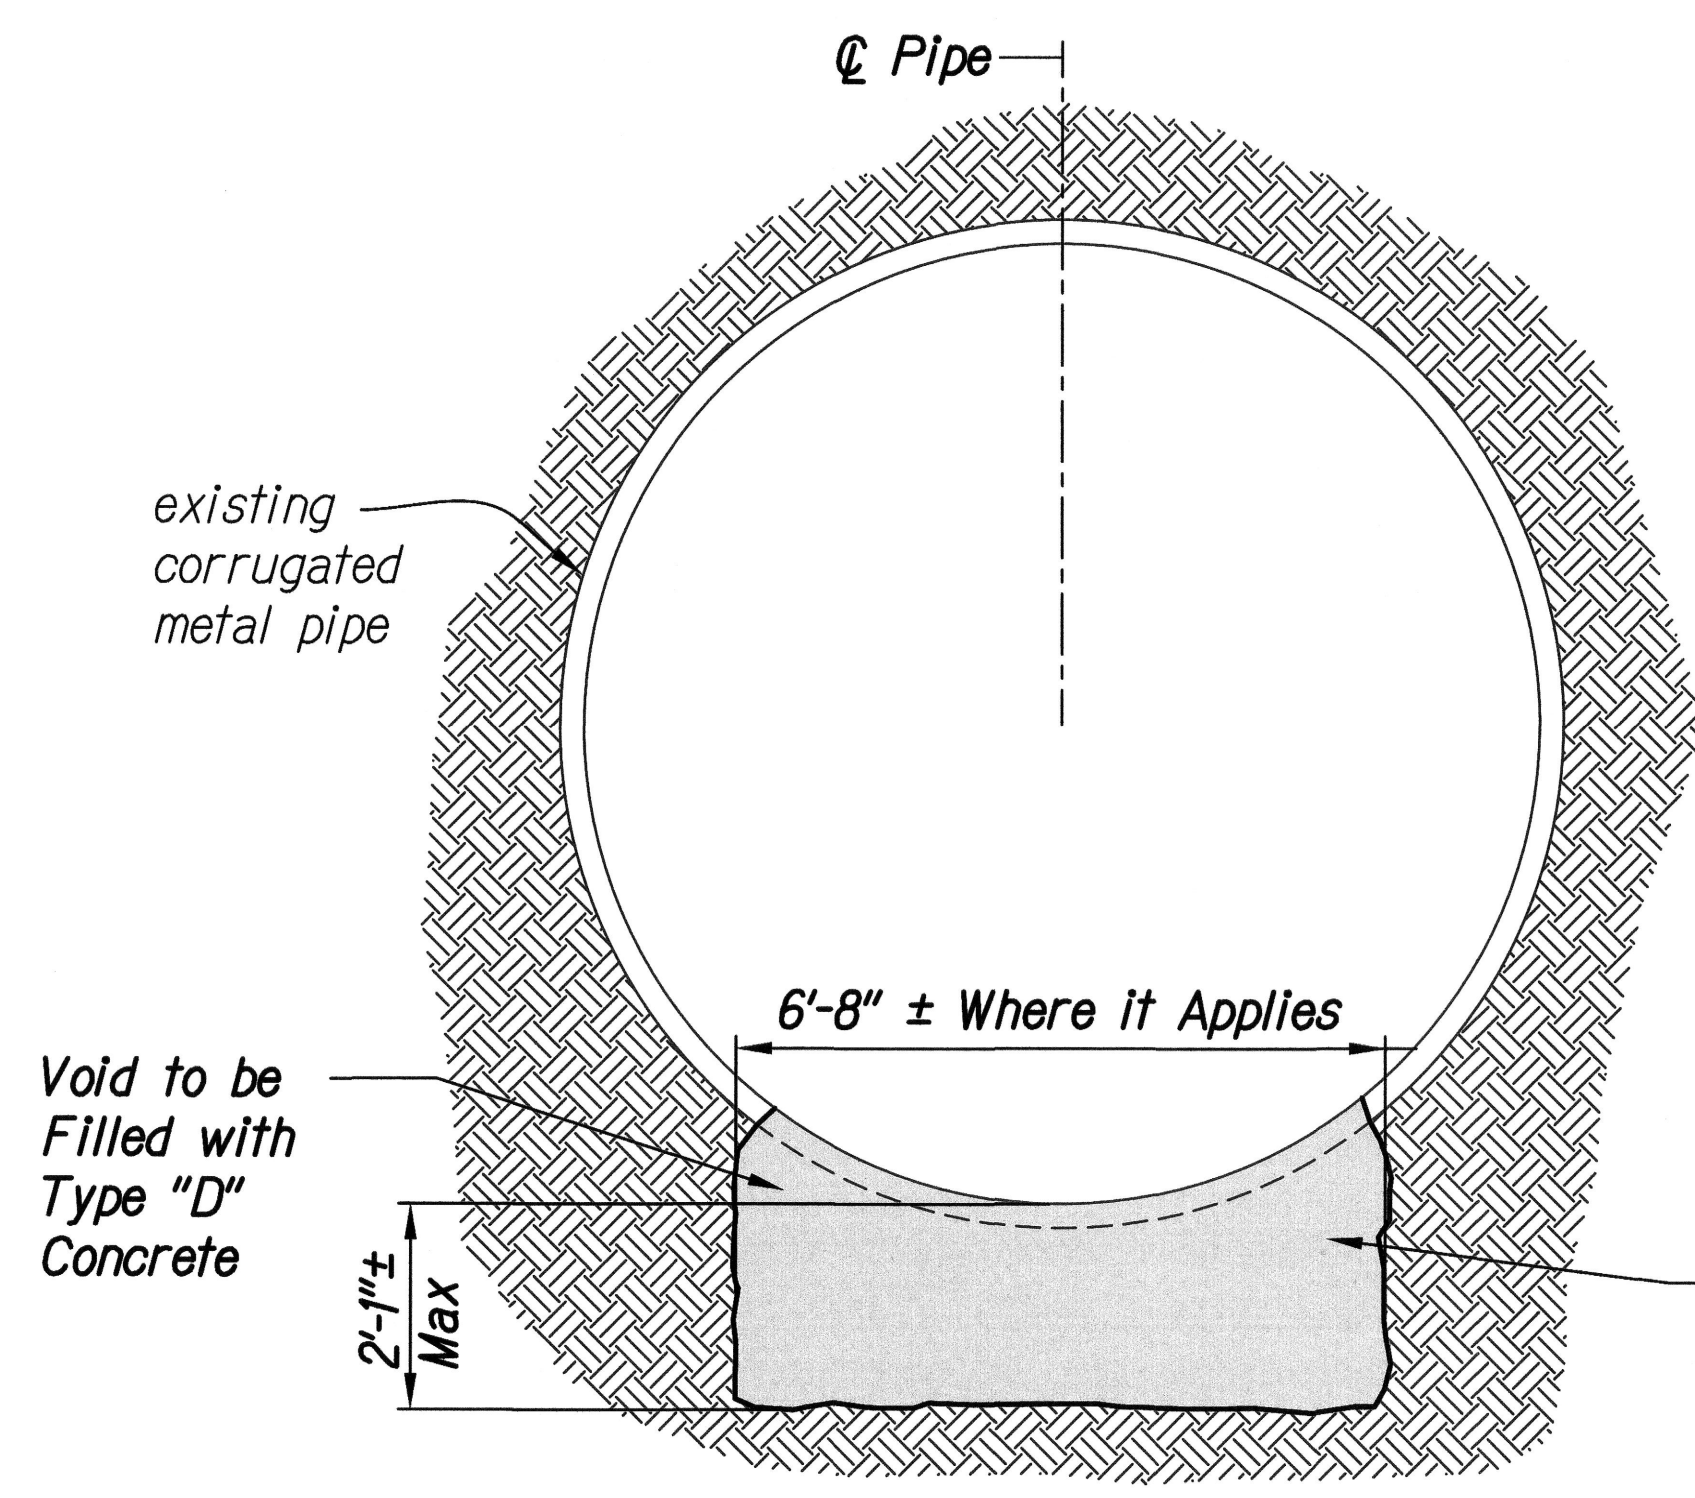

TYPICAL VOID AND UNDERMINING REPAIR SECTION

Scale: 1" = 2'-0"


1
S8.1, S8.2 | S8.5

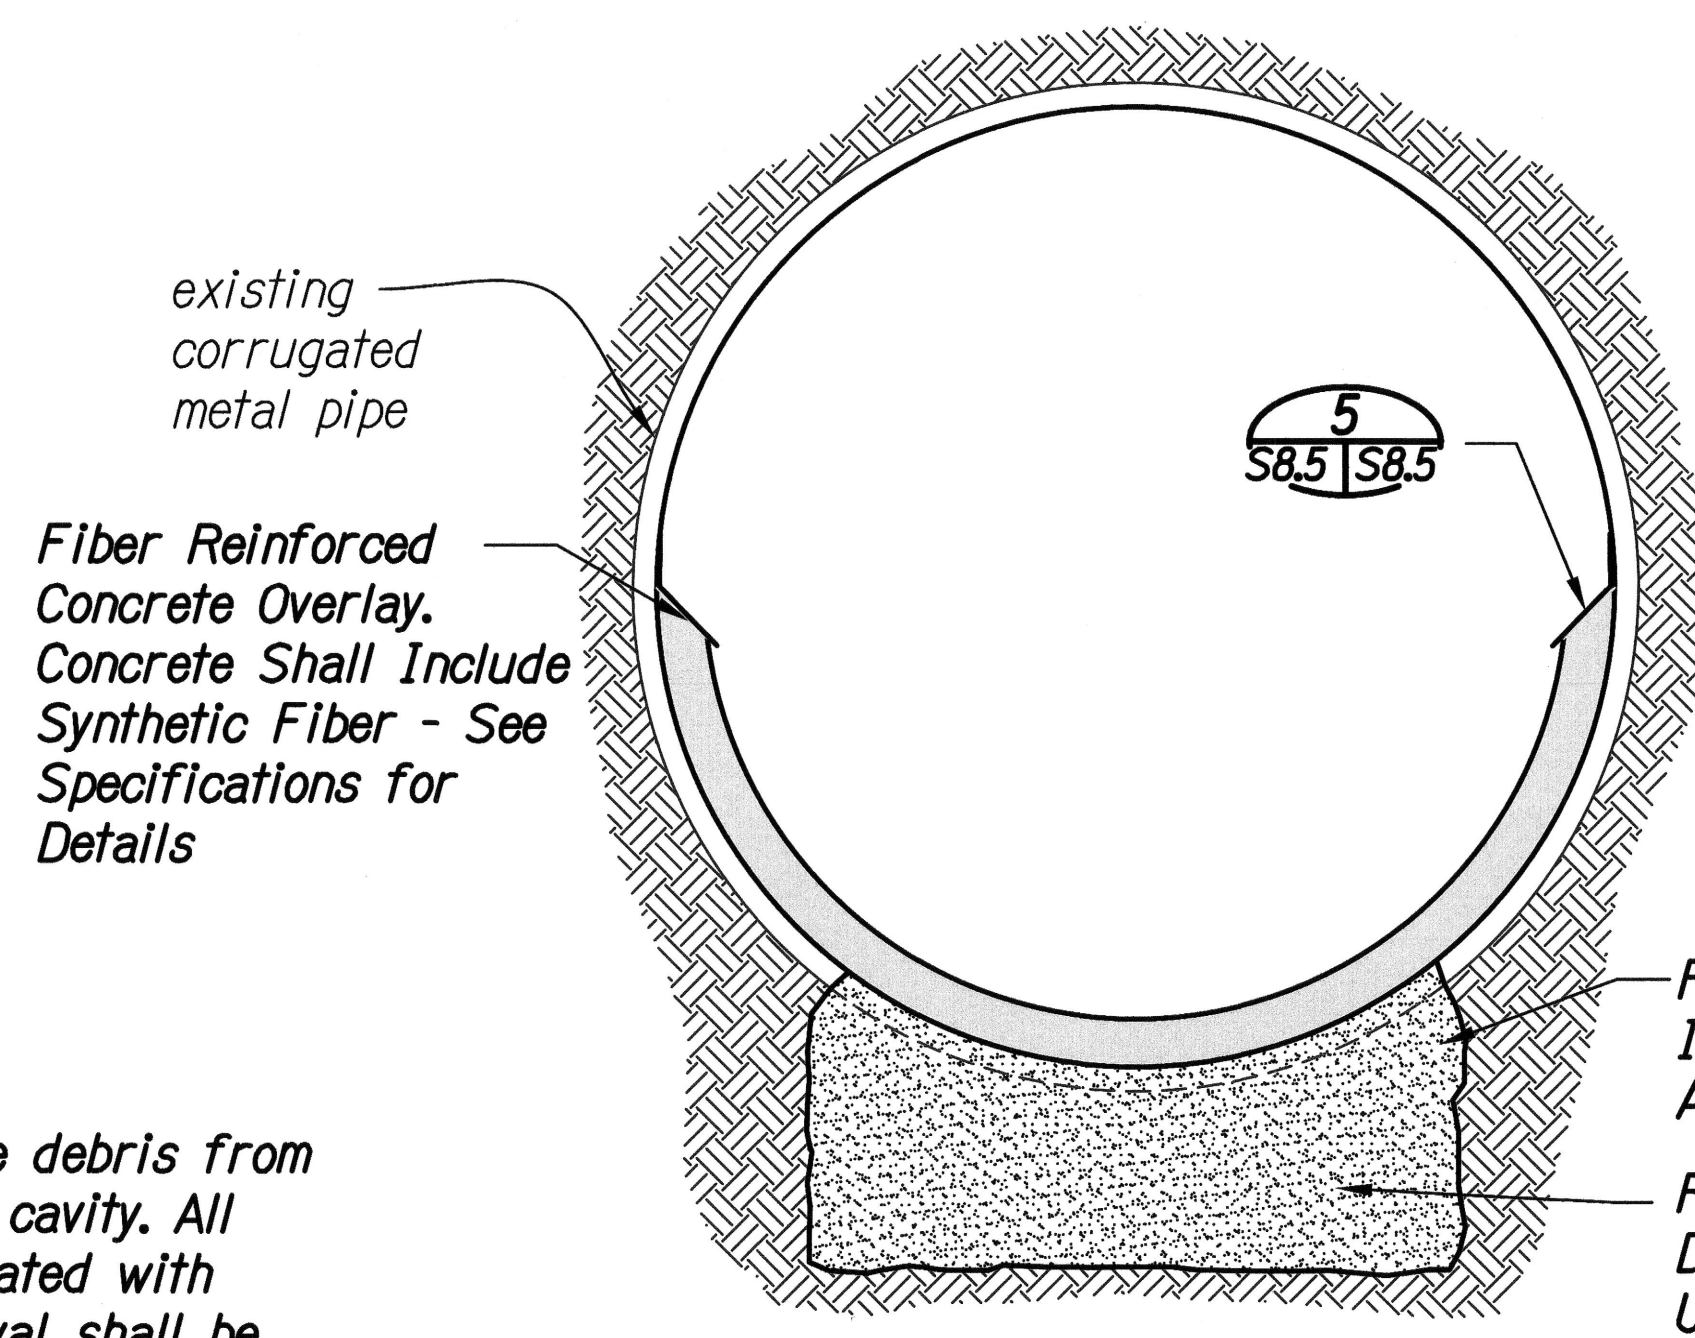

TYPICAL PIPE REPAIR SECTION

Scale: 1" = 2'-0"

3
S8.1, S8.2 | S8.5

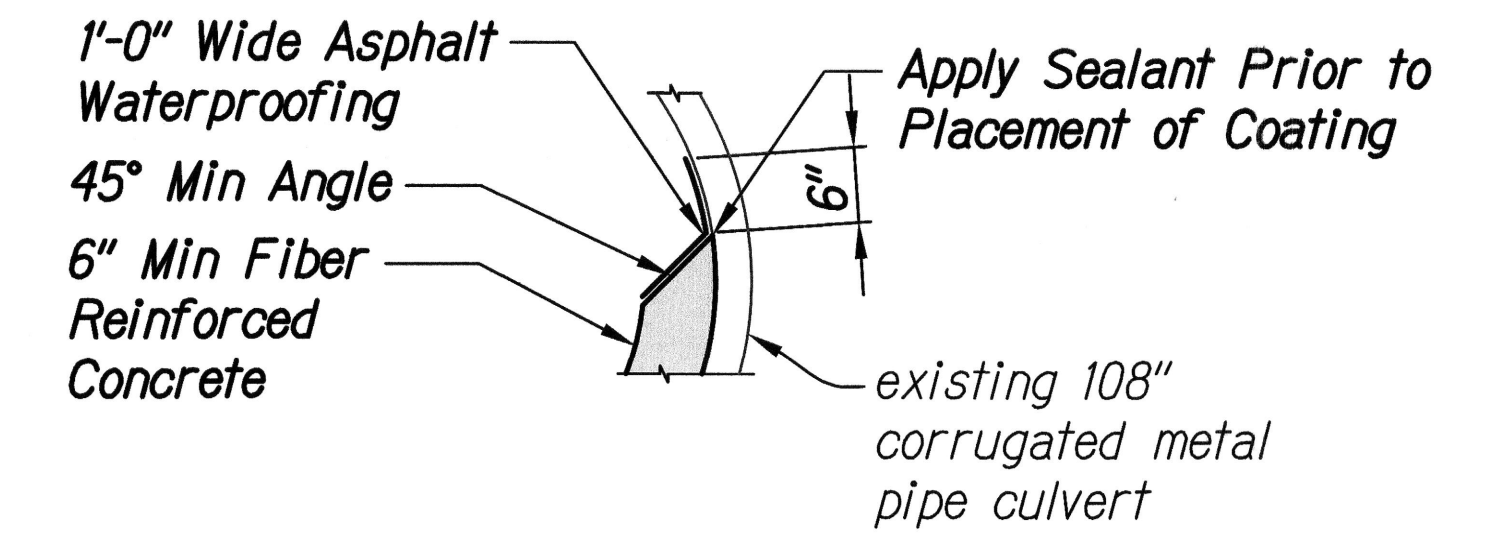


- Notes:**
1. Voids under the structural plate shall be filled with fiber reinforced concrete. The concrete shall be troweled to form a smooth, dense surface finish.
 2. Apply two coats of one-foot wide asphalt waterproofing to both sides of the concrete lining and scores after the new concrete lining has cured. The finish coating shall be a continuous film free of voids, gaps or pin holes.

DETAIL

Scale: 1" = 2'-0"

5
S8.5 | S8.5

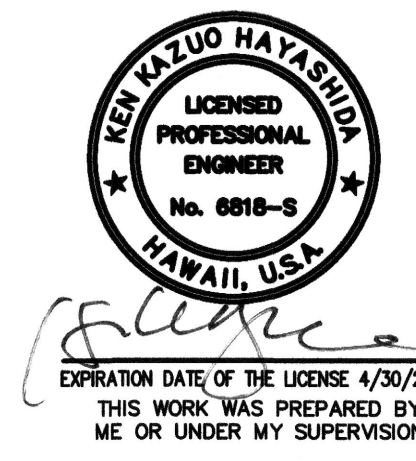


STATE OF HAWAII
DEPARTMENT OF TRANSPORTATION
HIGHWAYS DIVISION

Culvert Repair Details
M.P.12.56 (H3) PID. No. 701105
CULVERT REMEDIATION AT VARIOUS LOCATIONS ON OAHU, PHASE 2
Project No. HWY-0-03-18

Scale: As Shown Date: March 2018

SHEET No. **S8.5** OF **12** SHEETS


FED. ROAD DIST. NO.	STATE	PROJ. NO.	FISCAL YEAR	SHEET NO.	TOTAL SHEETS
HAWAII	HAW.	HWY-O-03-18	2018	74	93

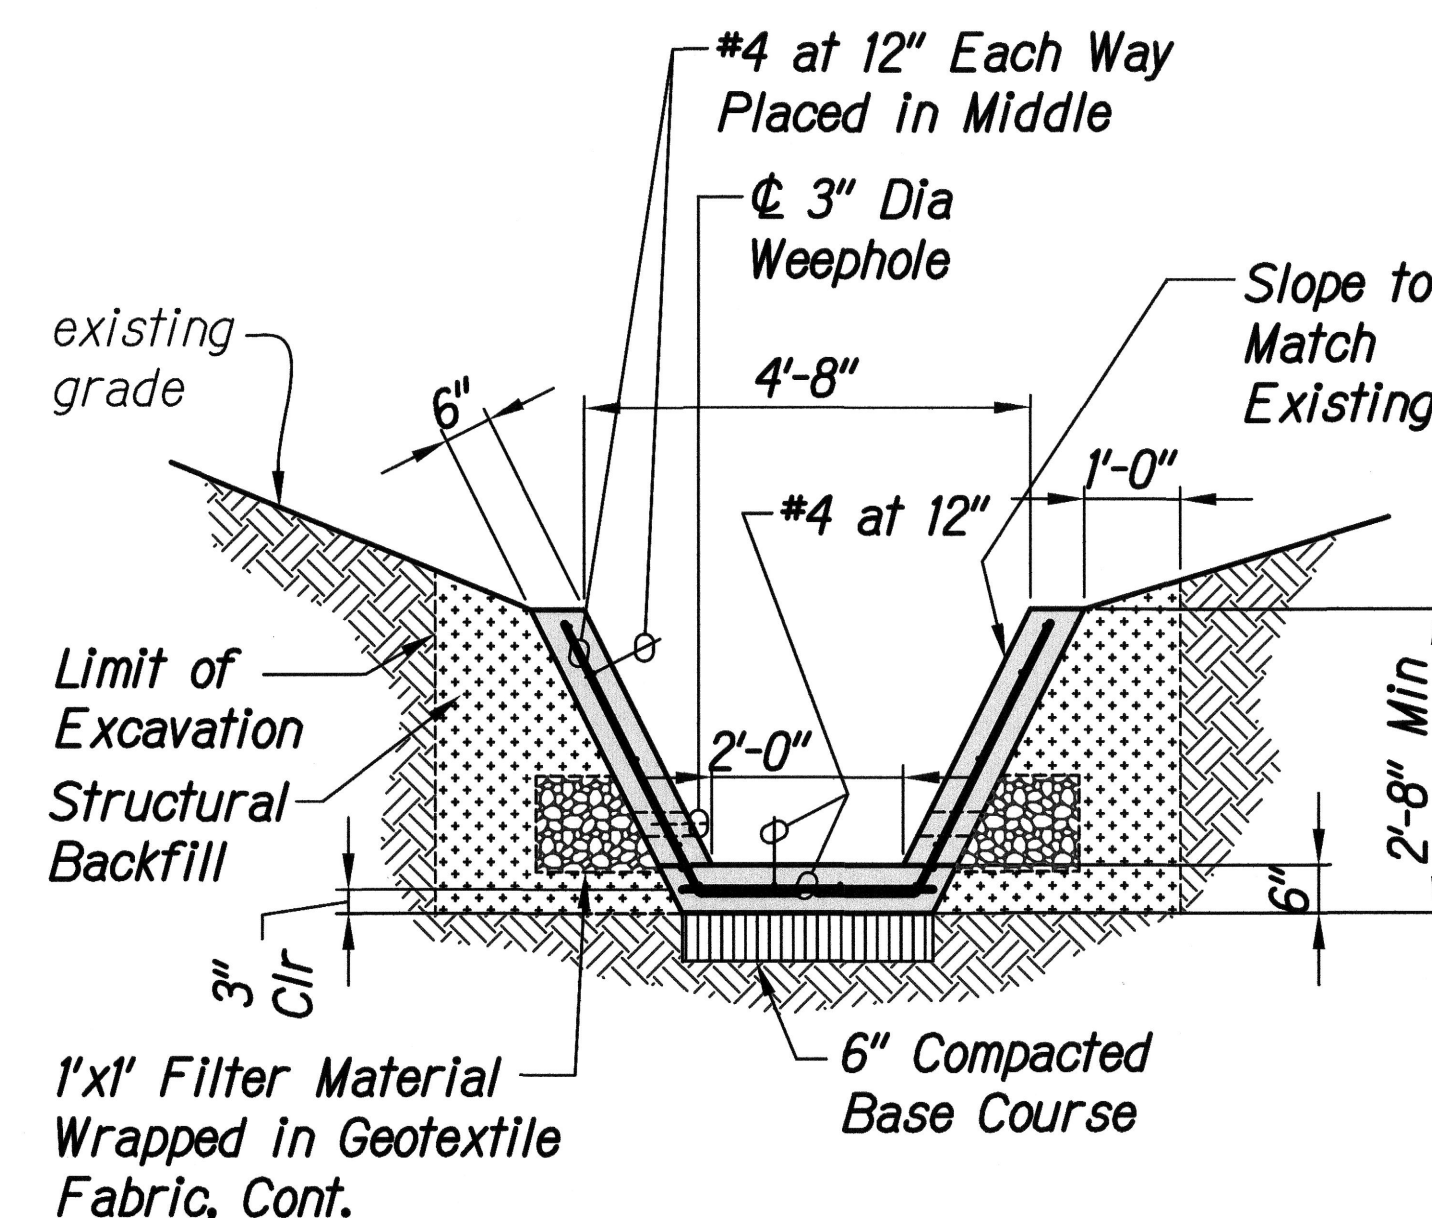

NEW CONCRETE DITCH DETAIL

Scale: 1" = 2'-0"

1
S8.1 | S8.6

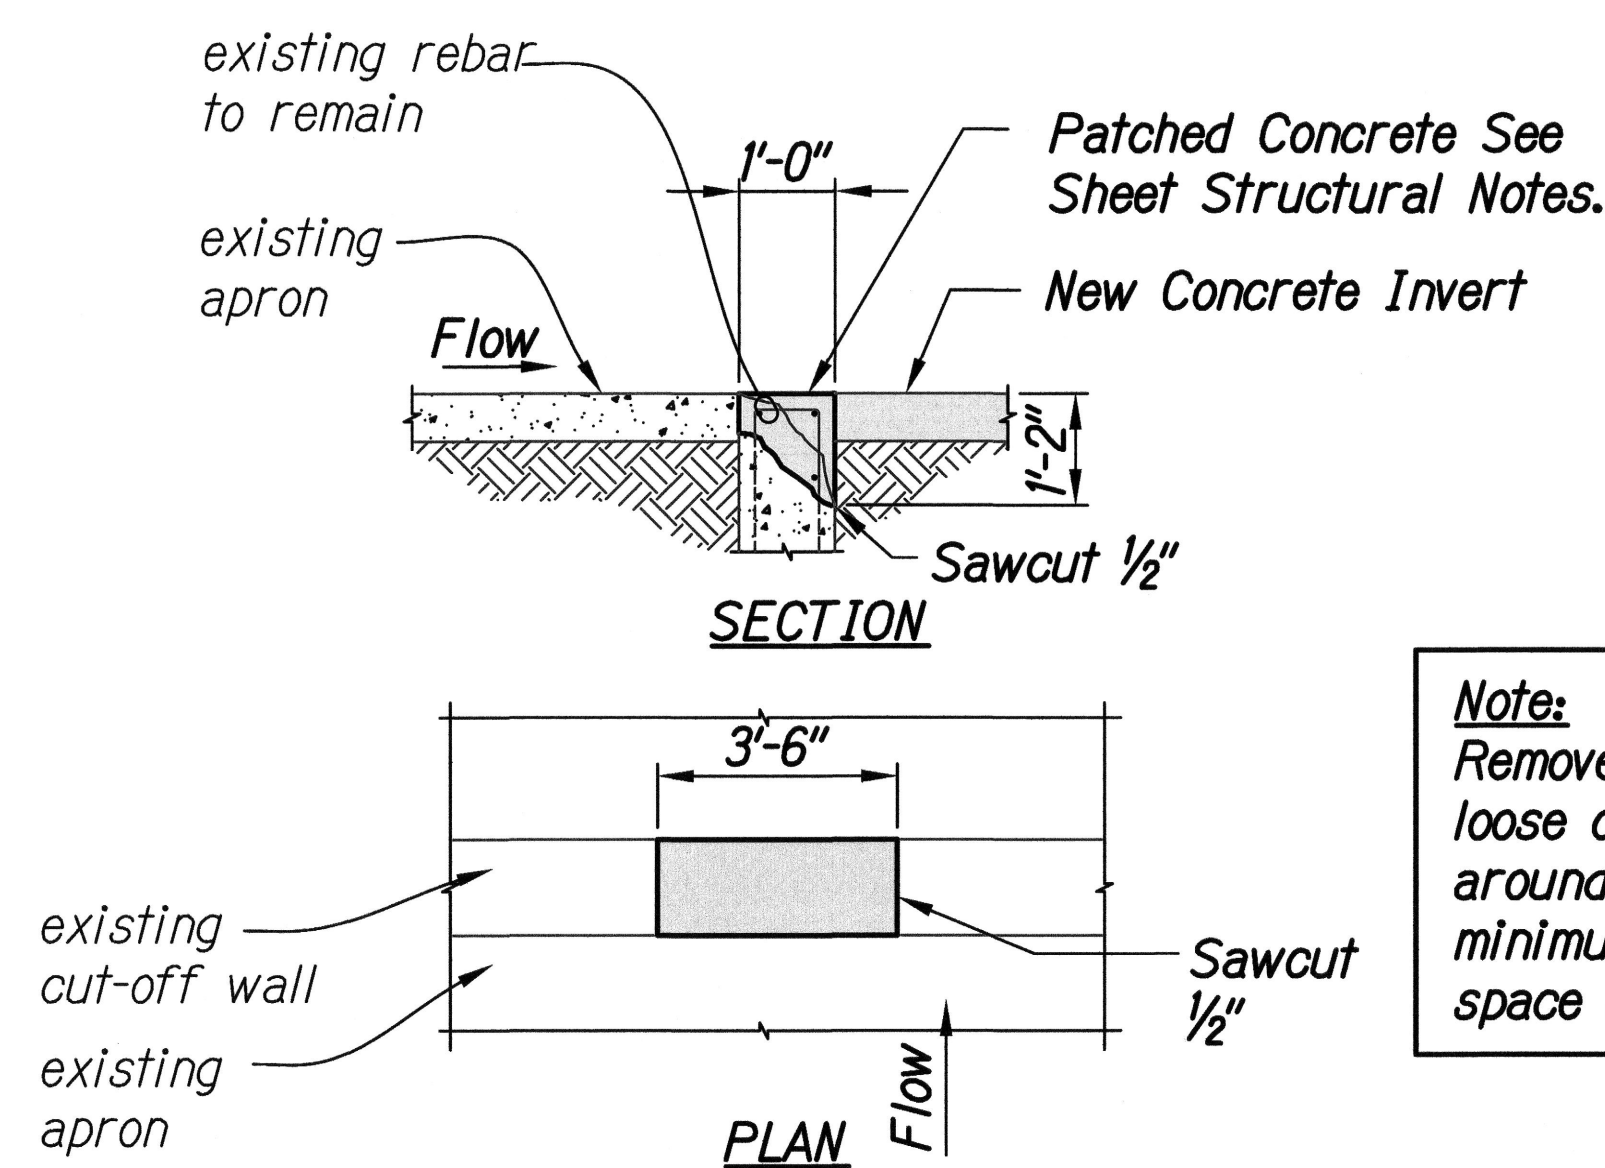


INVERT SPALL REPAIR

Scale: 1" = 2'-0"

2
S8.4 | S8.6


Note:
Remove all unsound and loose concrete from around rebar. Create minimum 3/4" annular space around rebar.

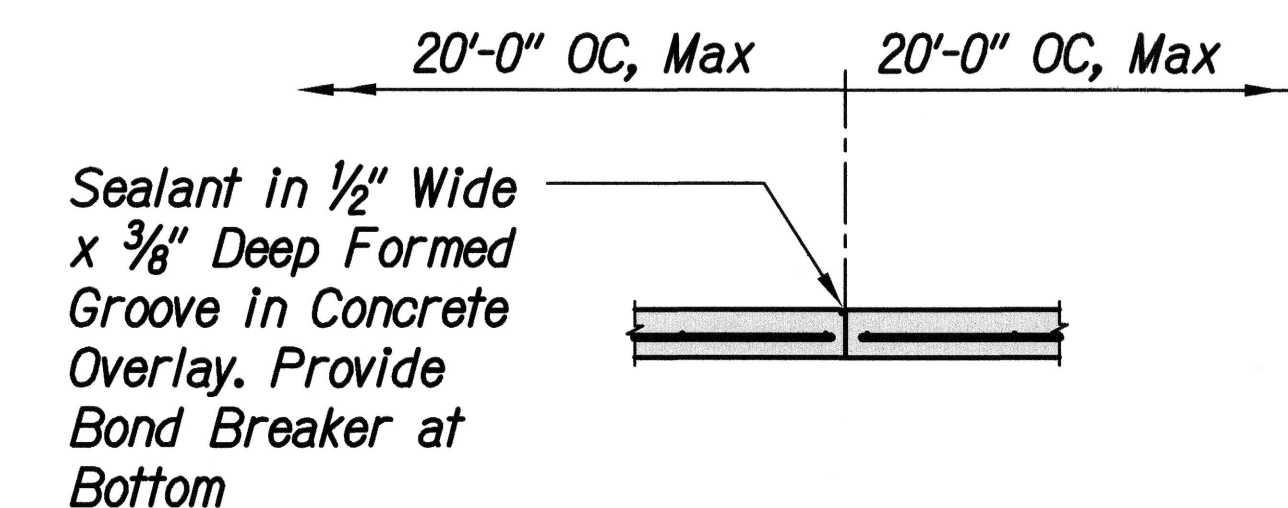

EXPANSION JOINT DETAIL

Scale: 1" = 2'-0"

3
S8.6 | S8.6

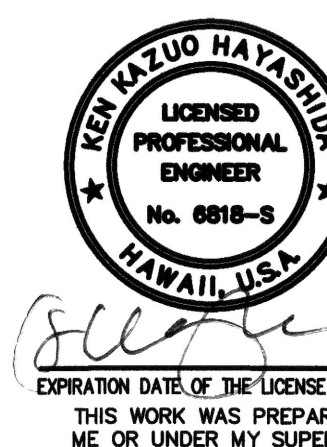

STATE OF HAWAII
DEPARTMENT OF TRANSPORTATION
HIGHWAYS DIVISION

Culvert Inlet Detail
M.P.12.56 (H3) PID No. 701105
CULVERT REMEDIATION AT VARIOUS LOCATIONS ON OAHU, PHASE 2
Project No. HWY-O-03-18

Scale: As Shown Date: March 2018

SHEET No. **S8.6** OF **12** SHEETS