

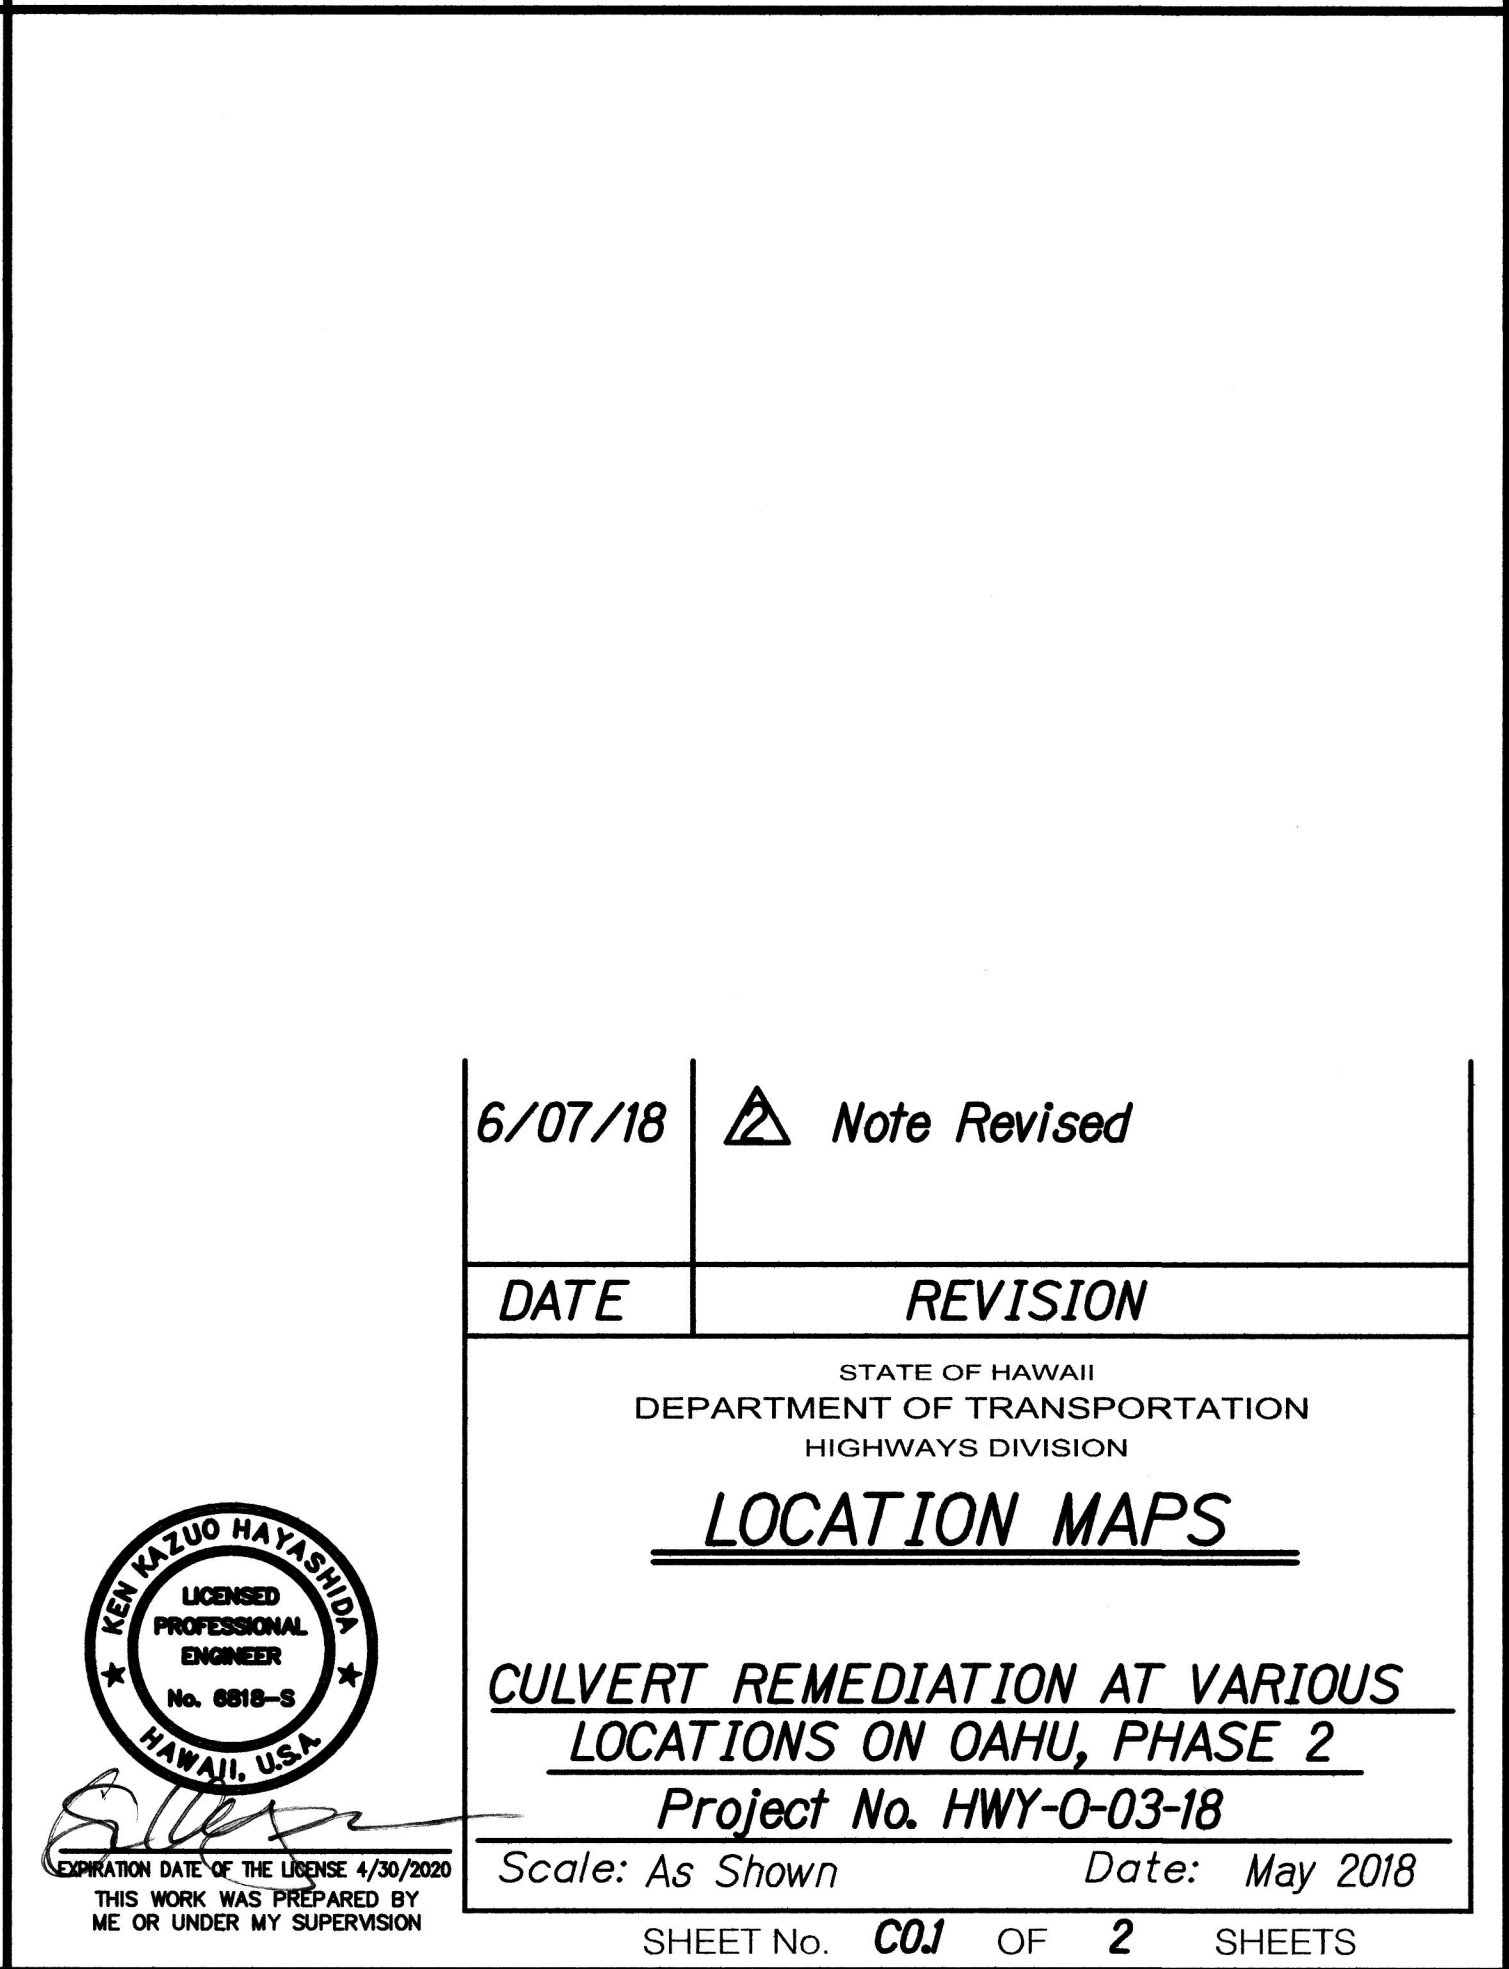
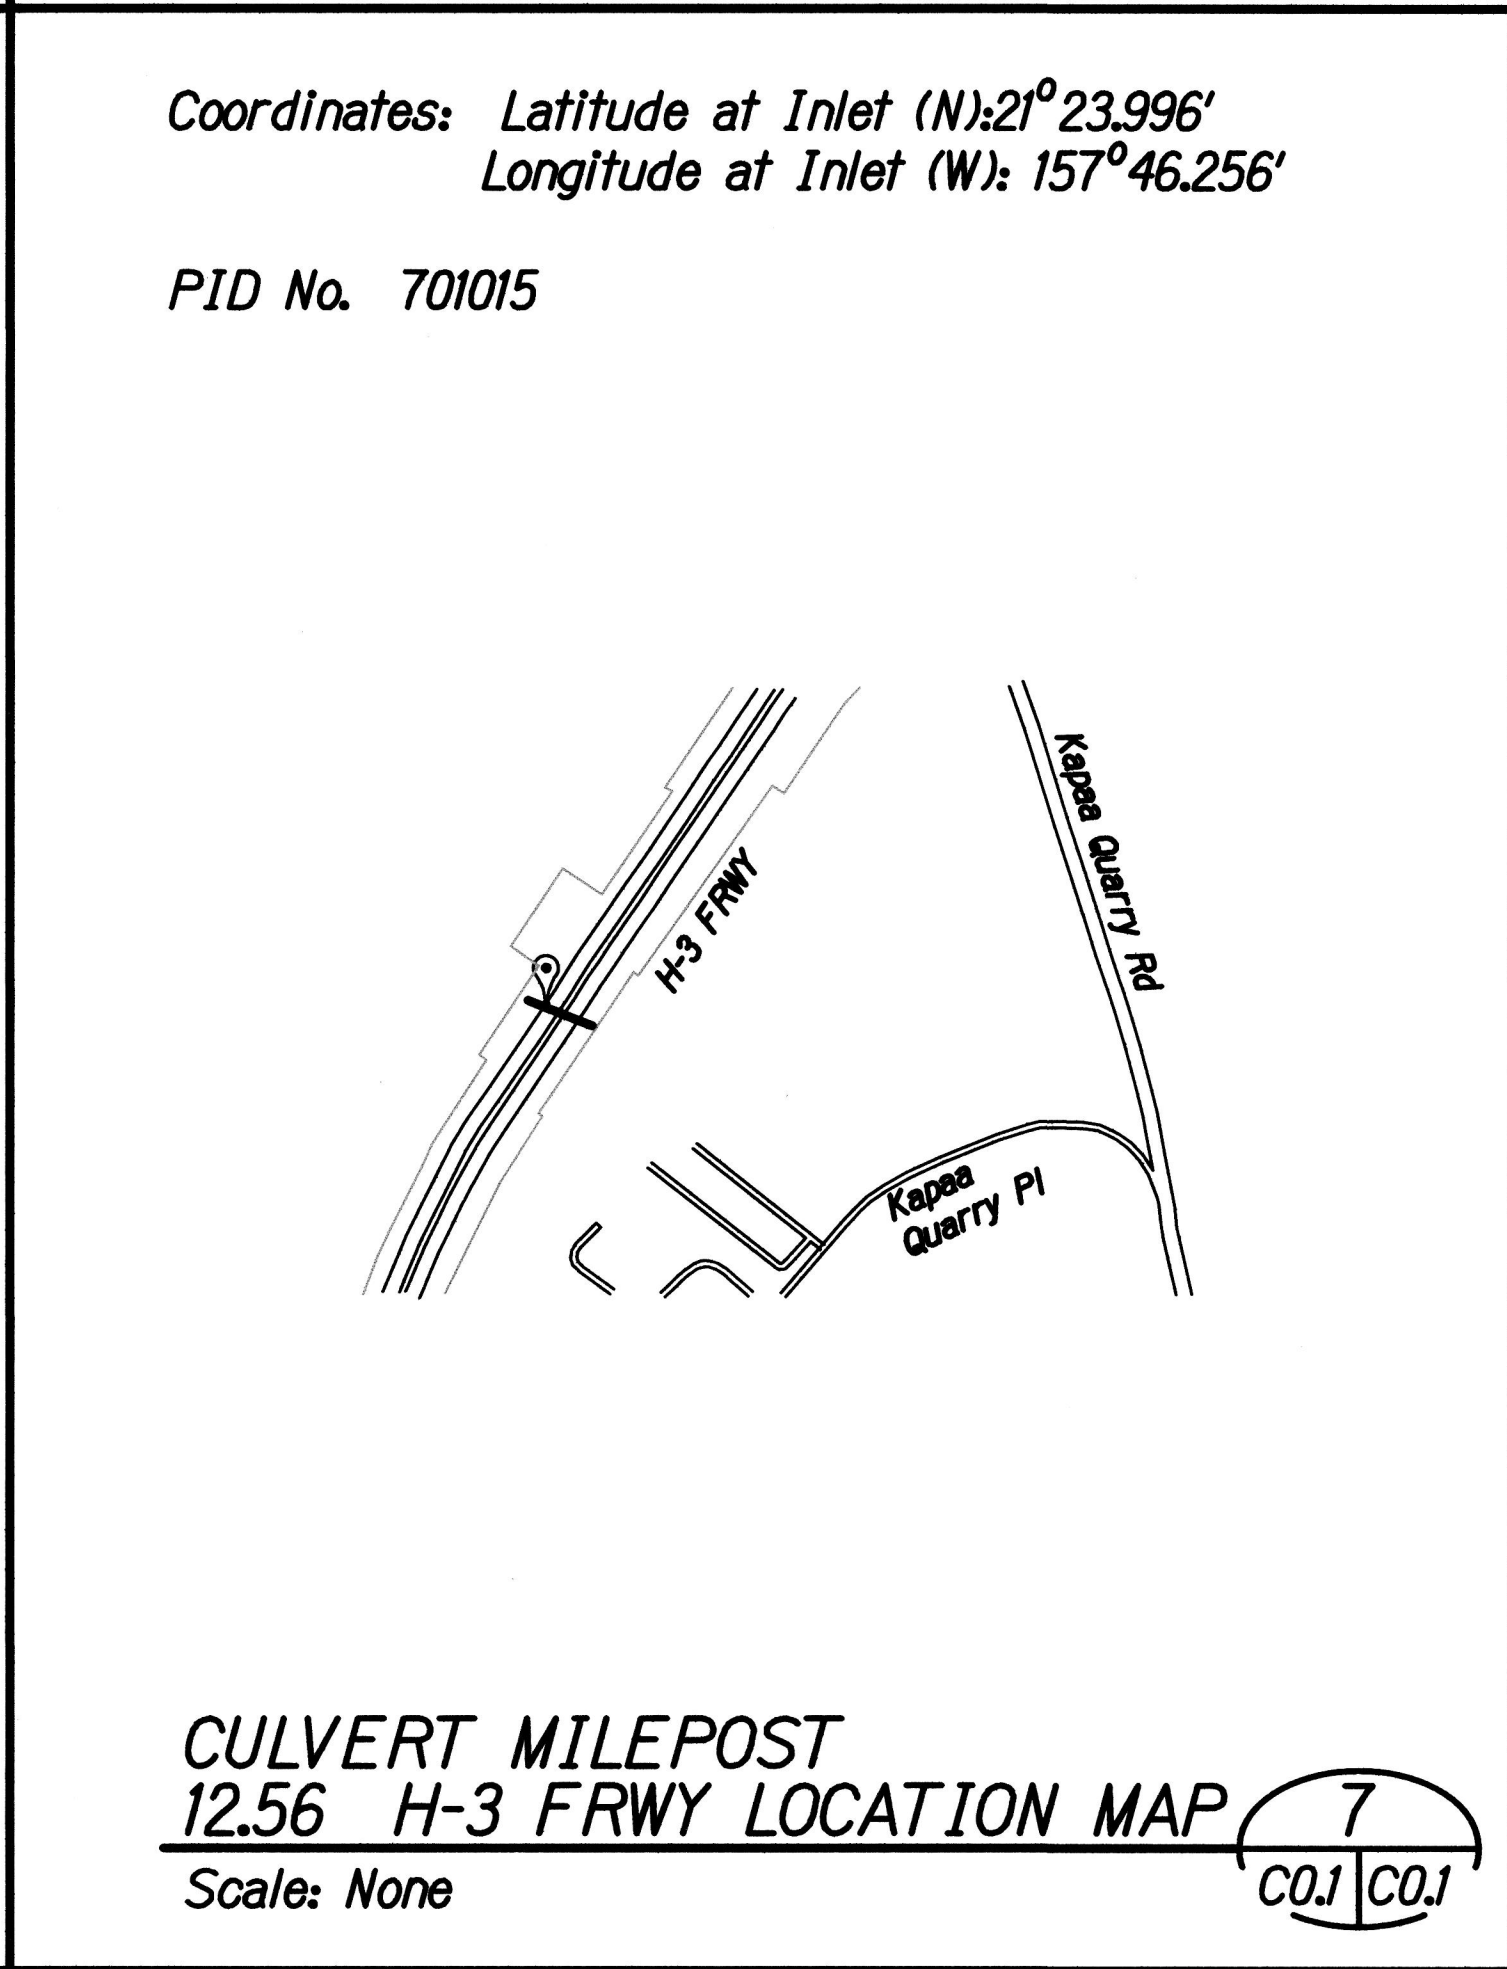
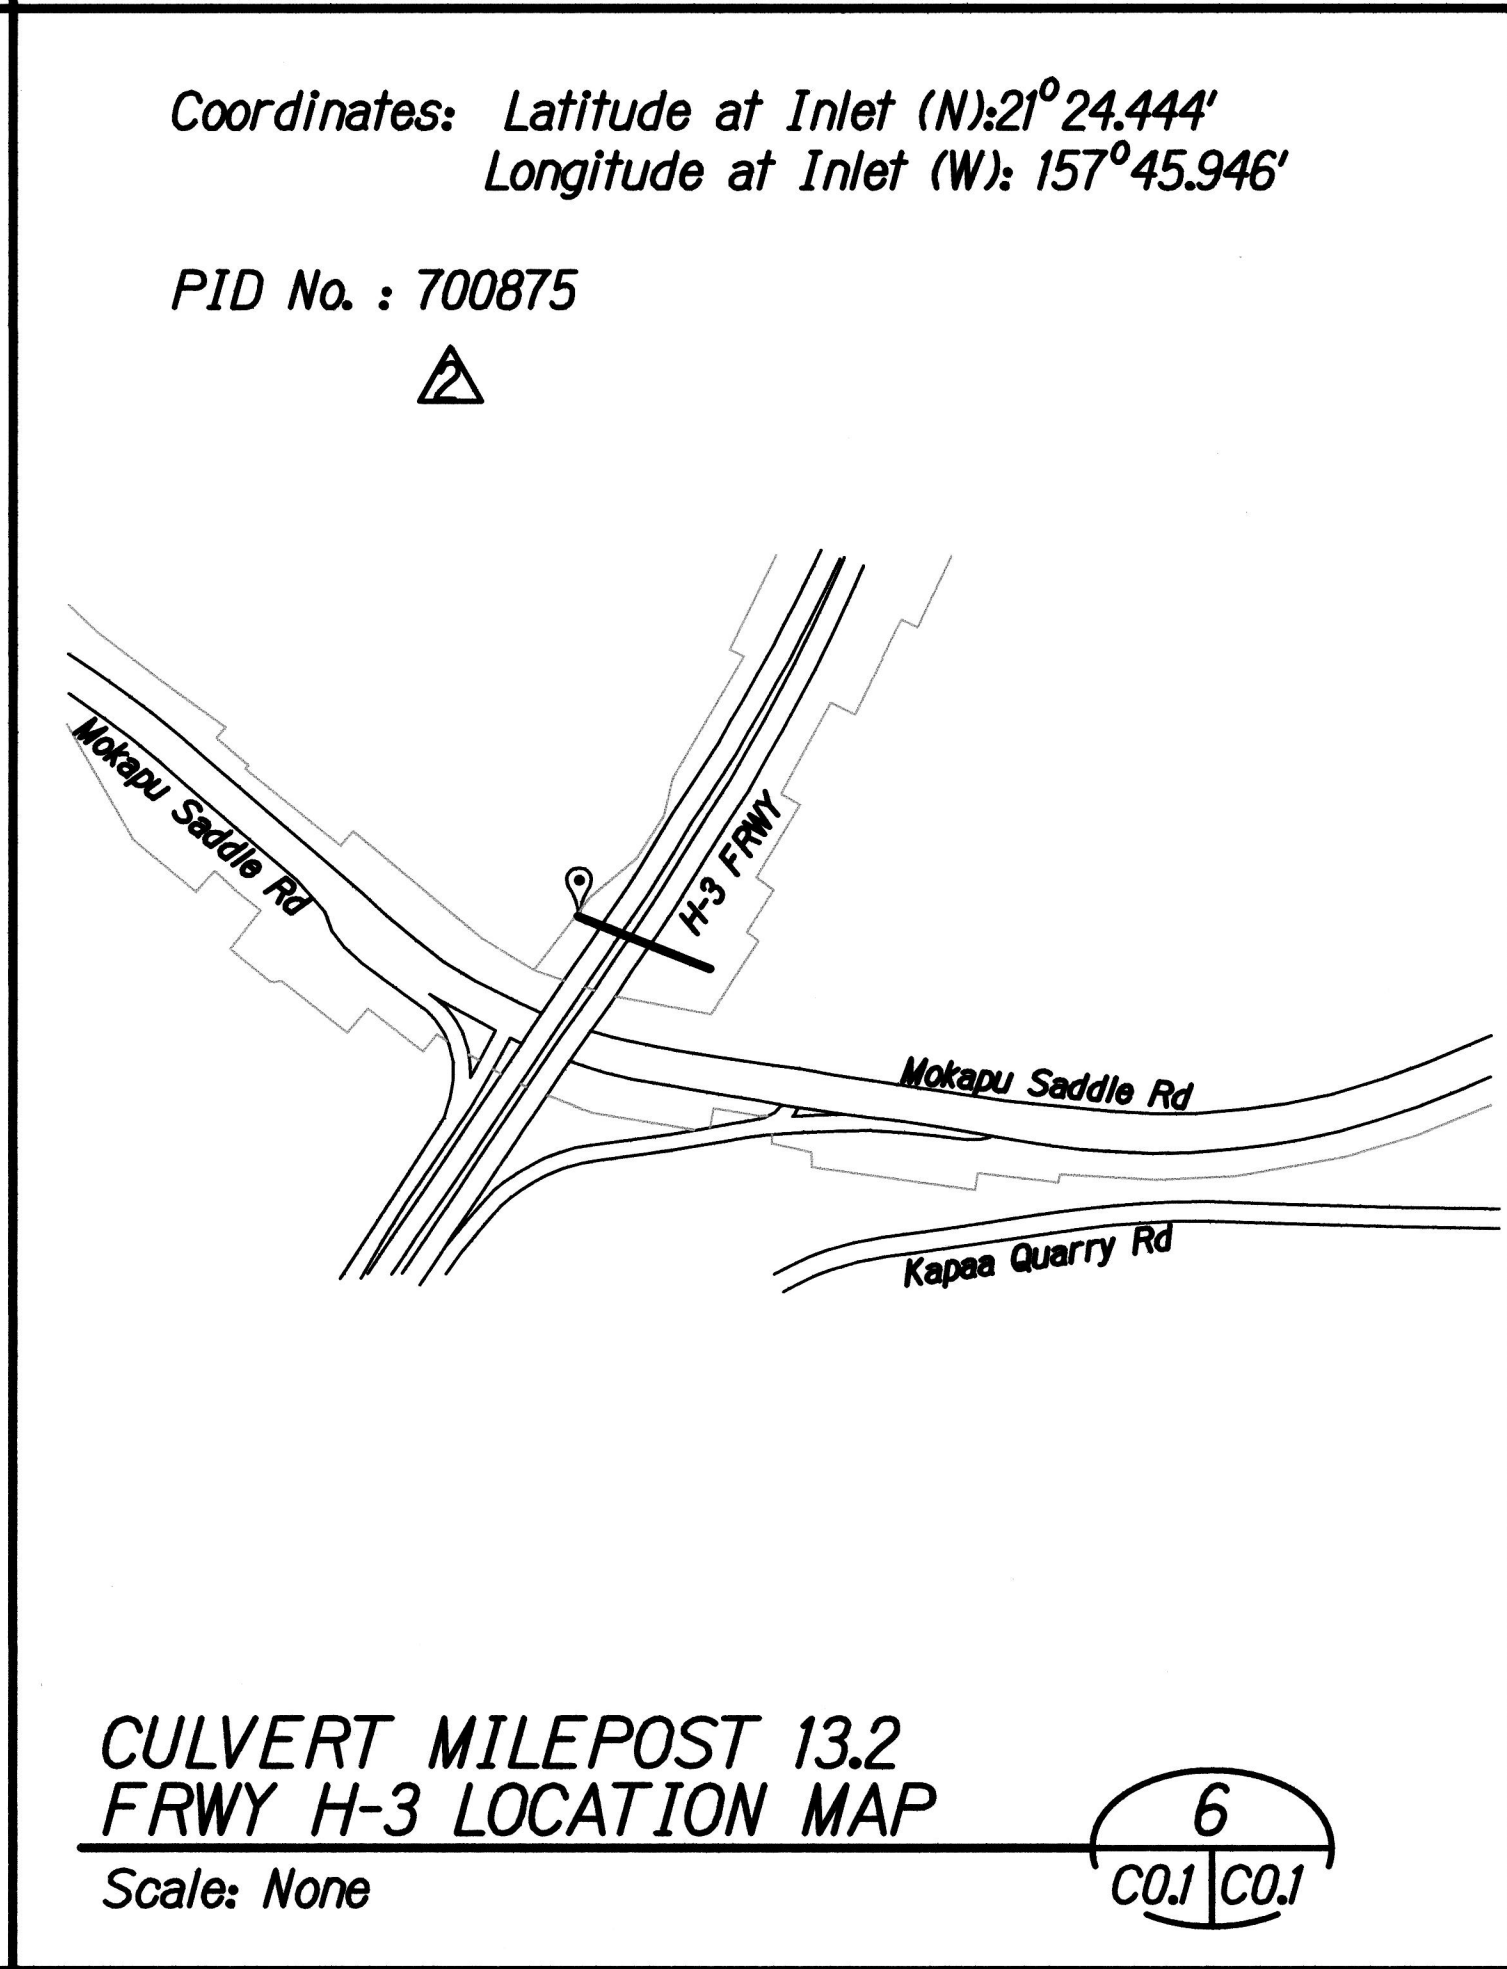
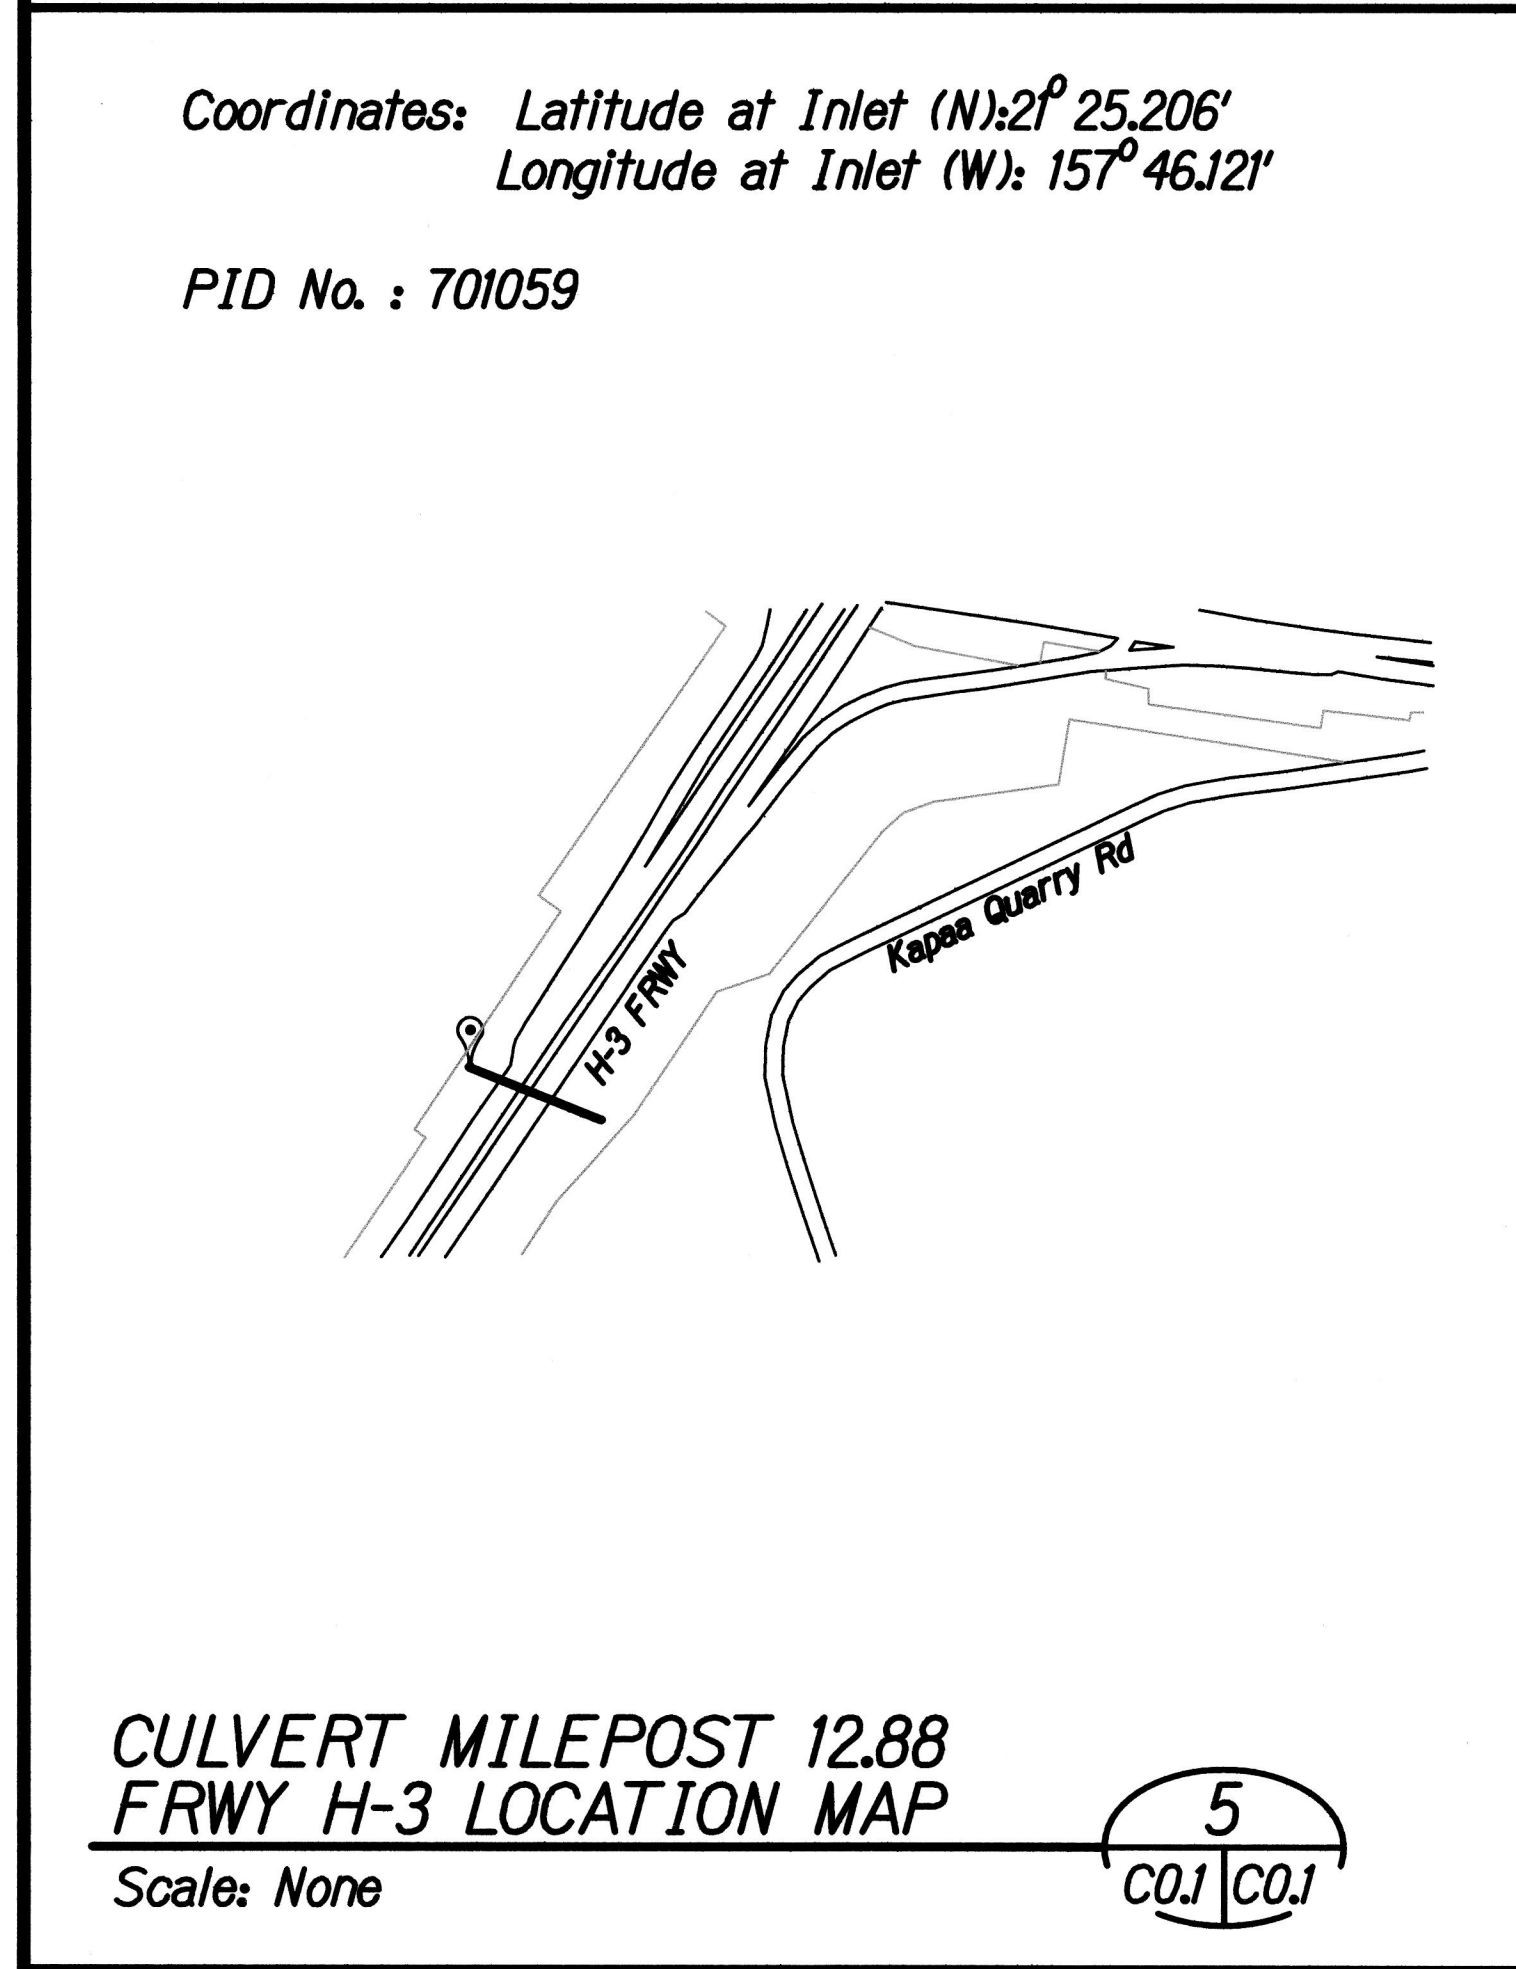
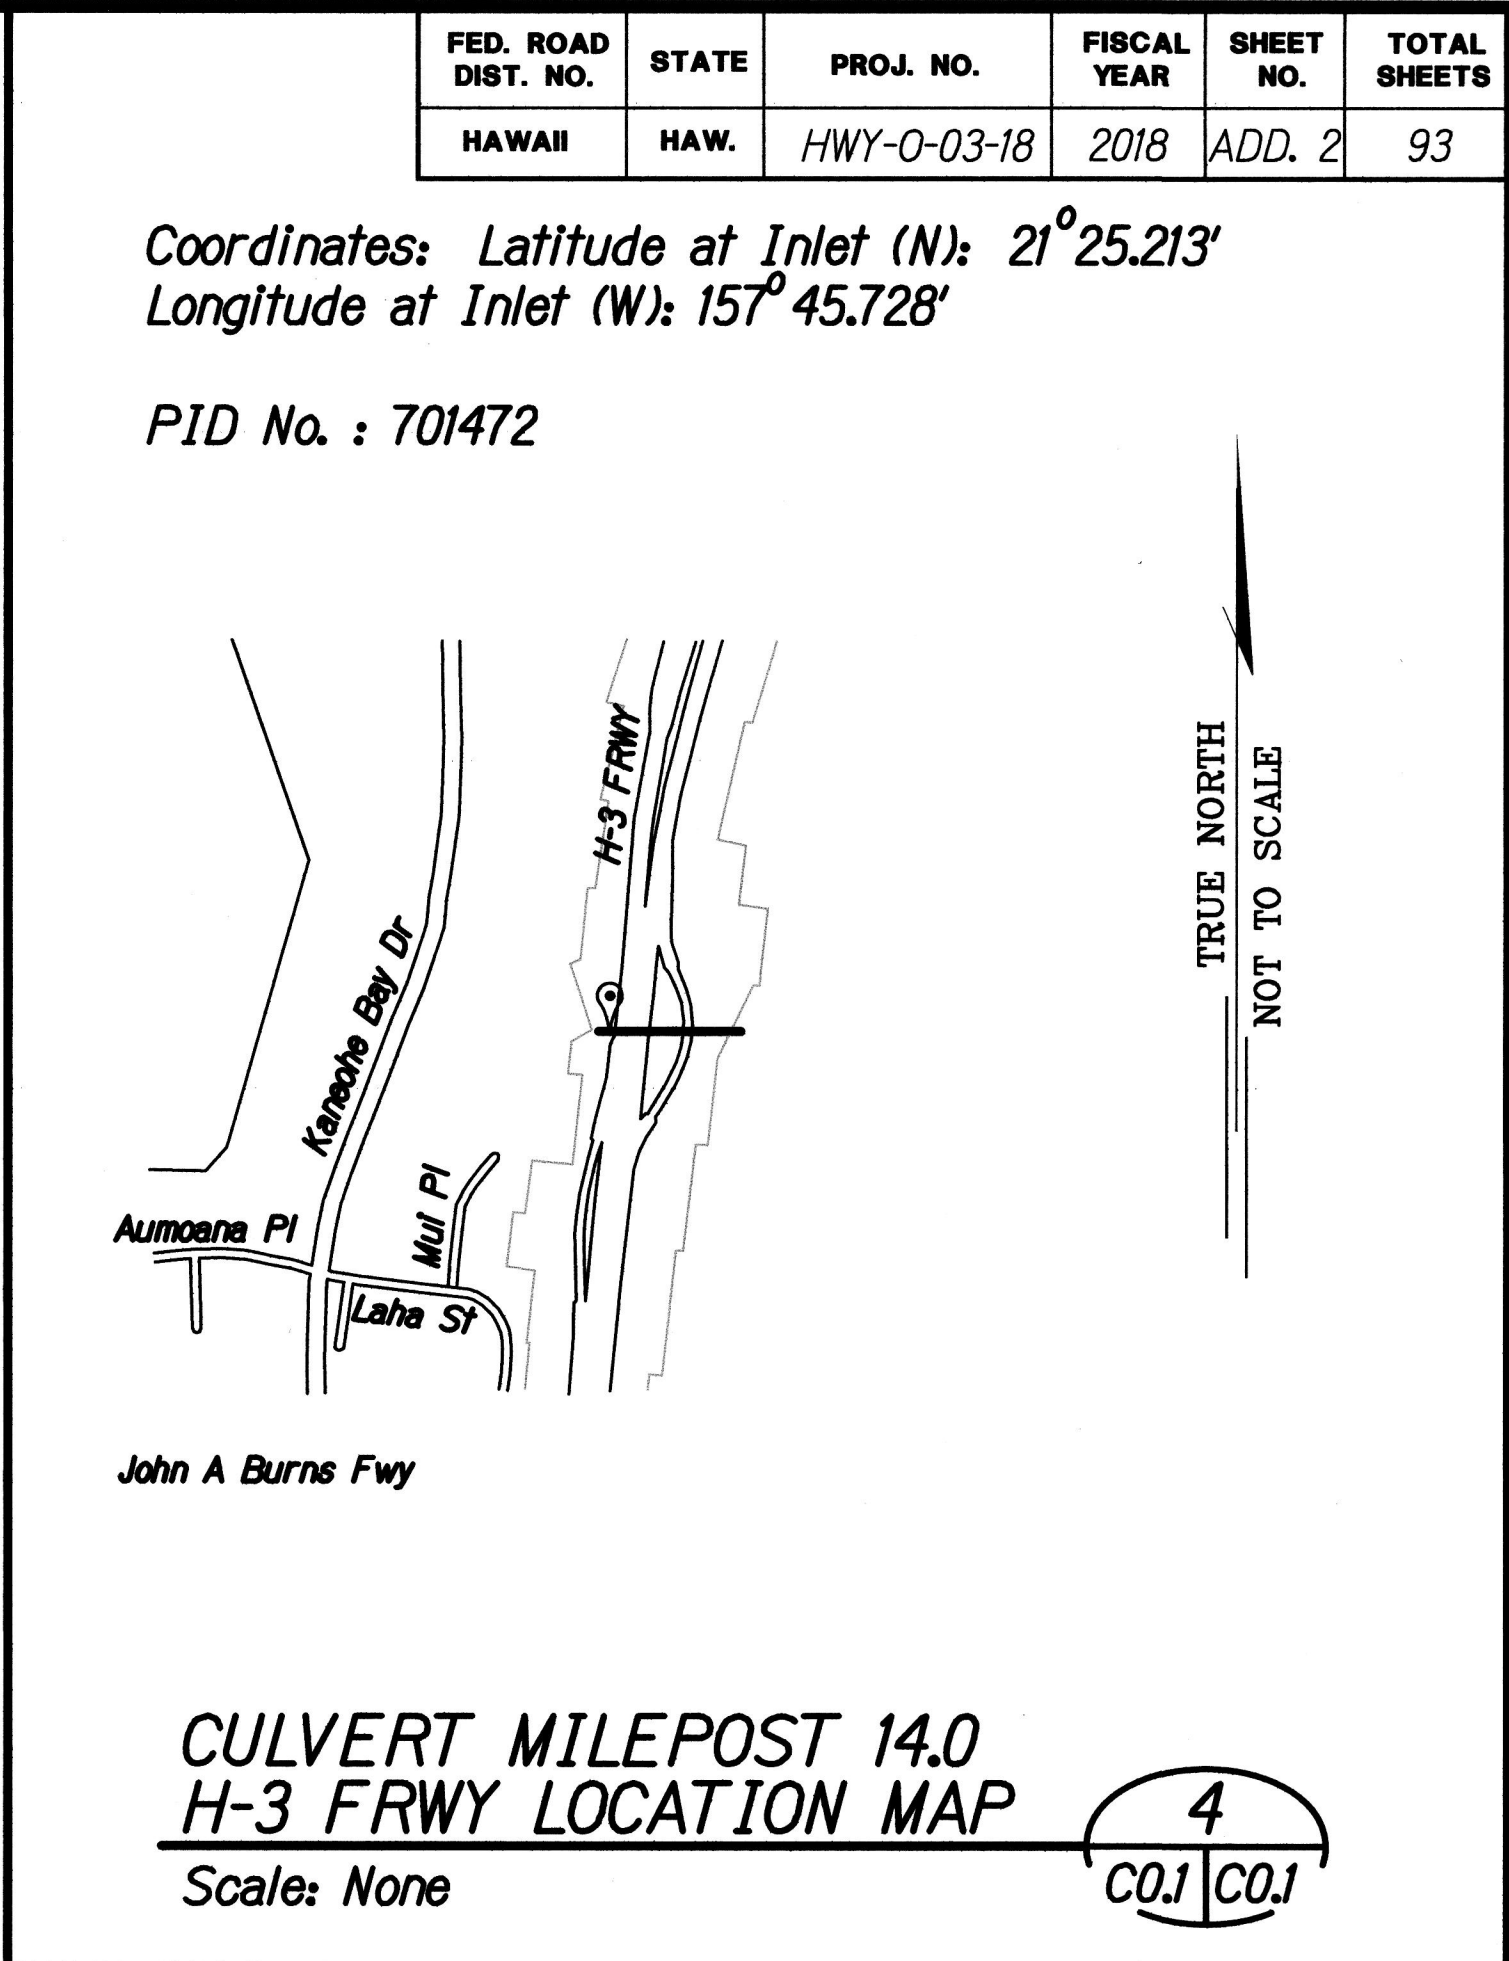
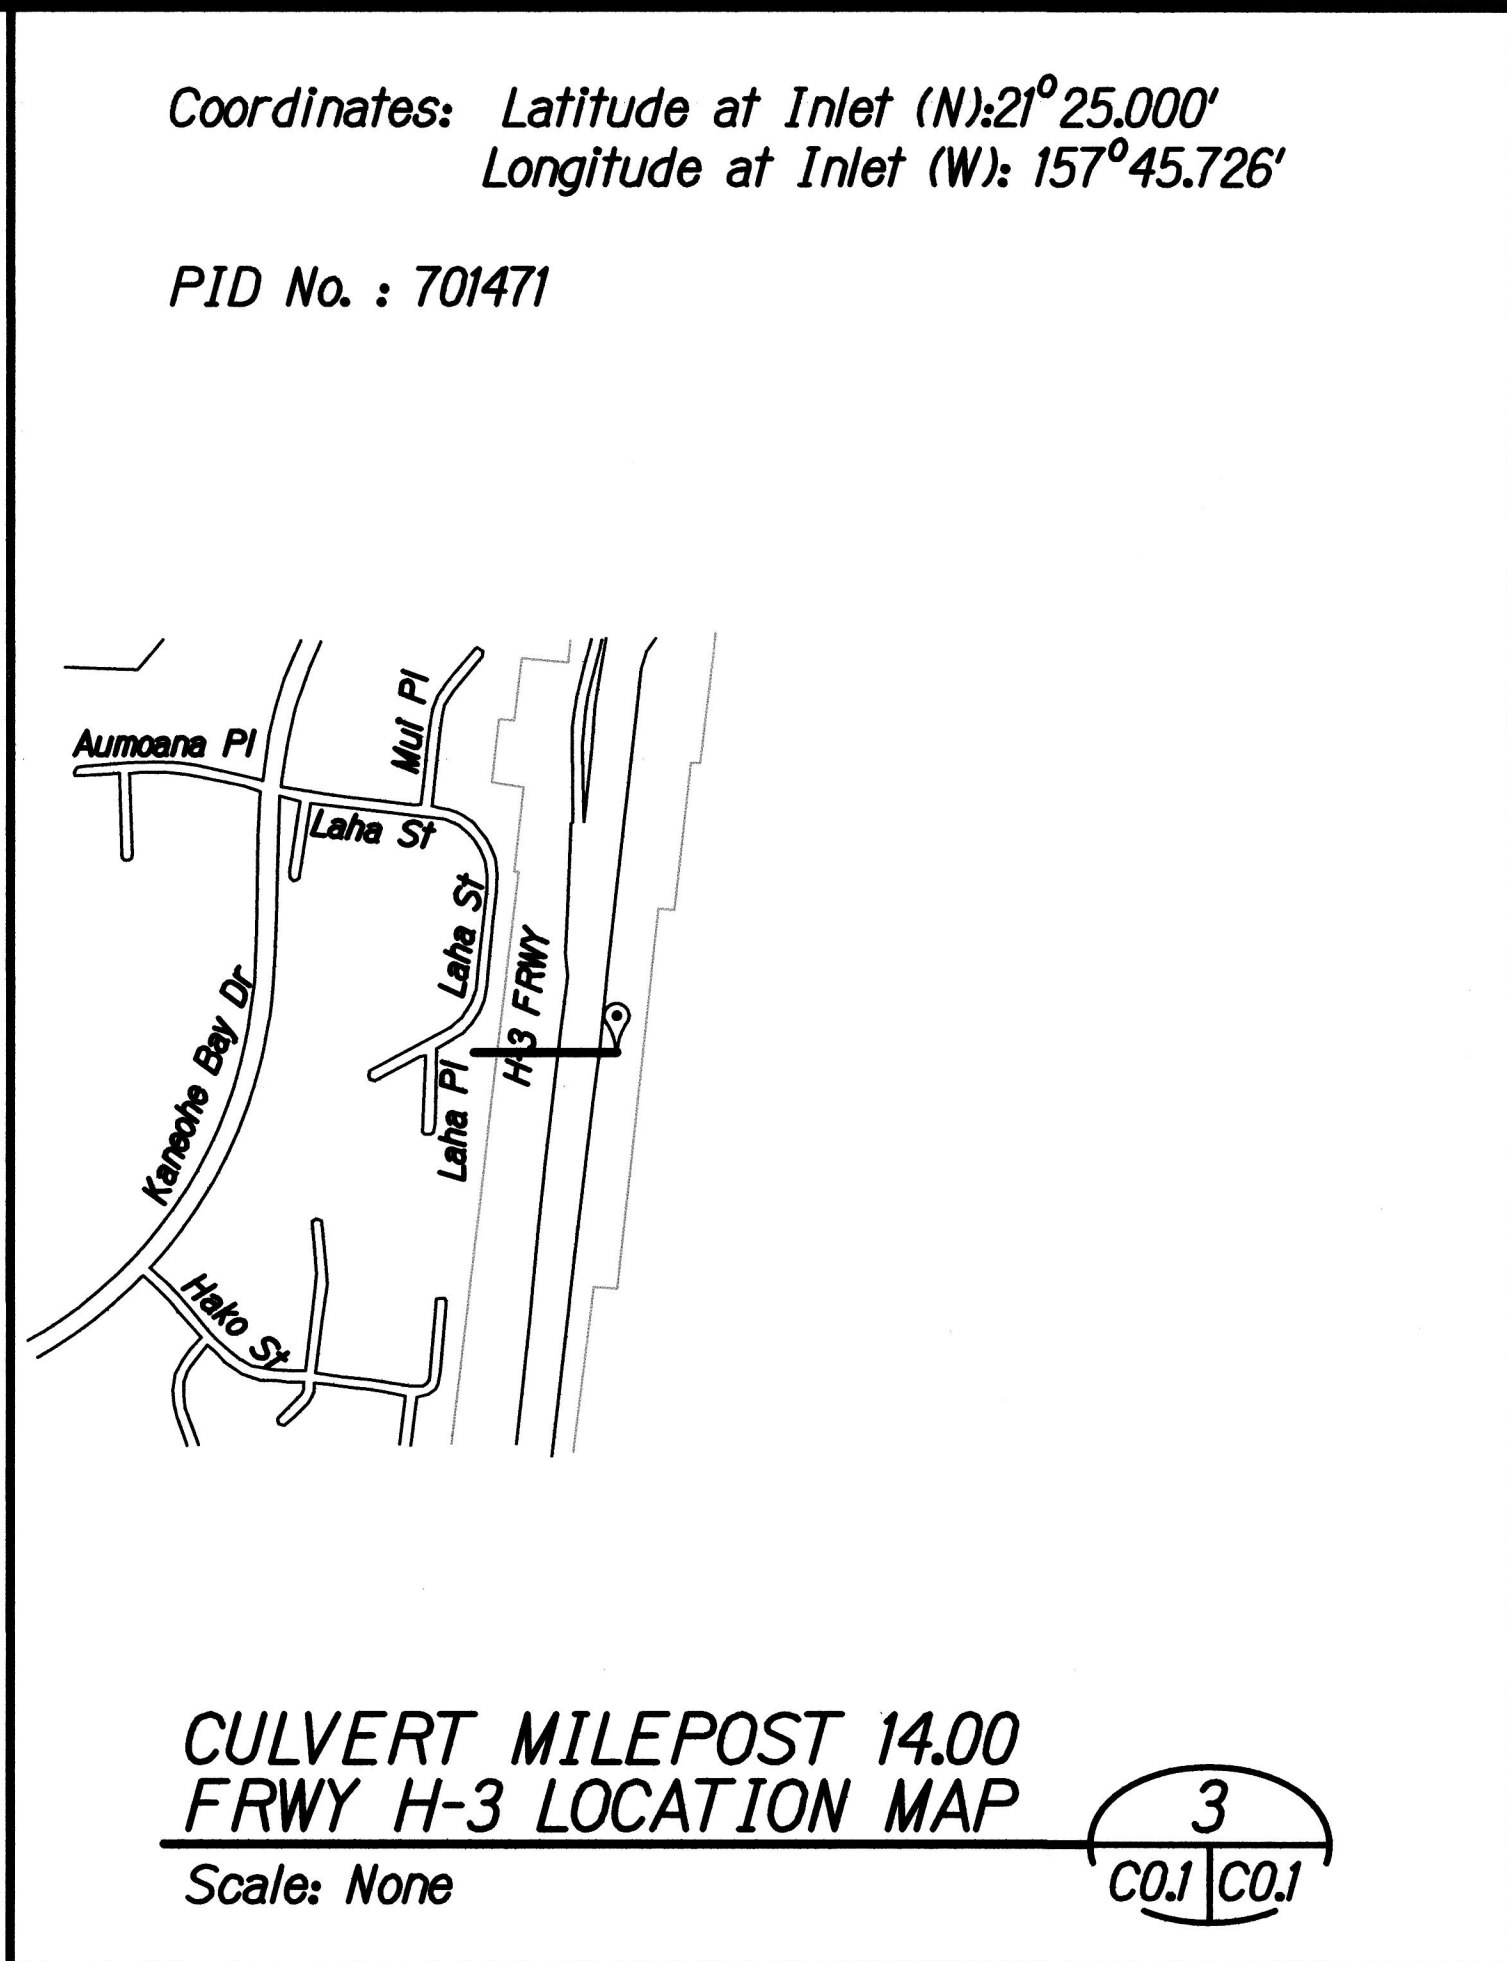
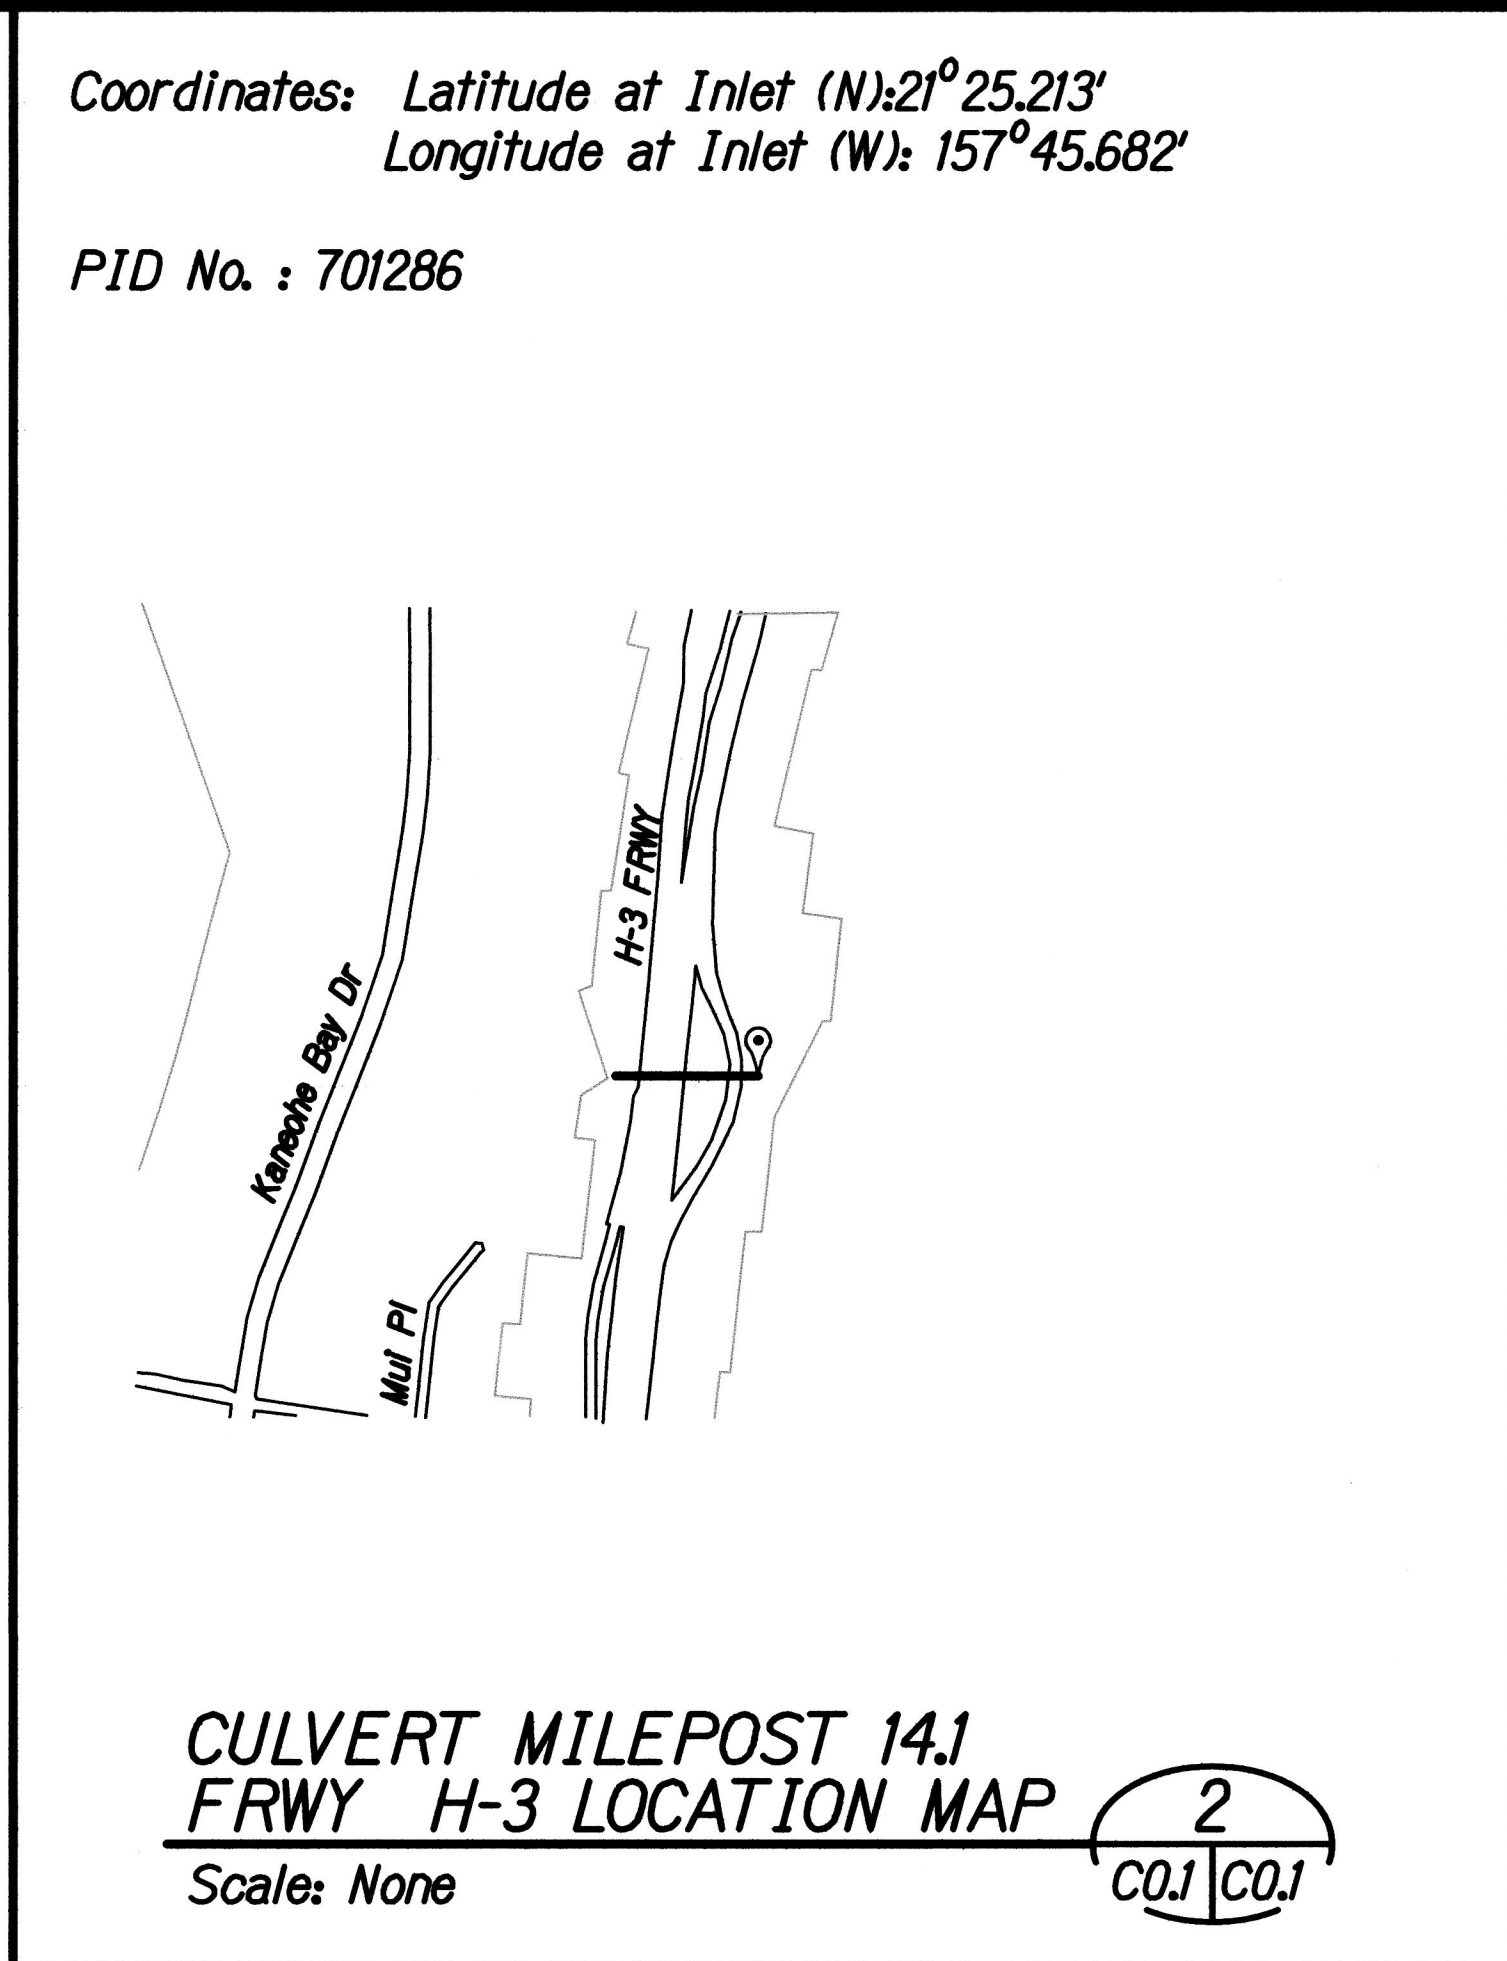
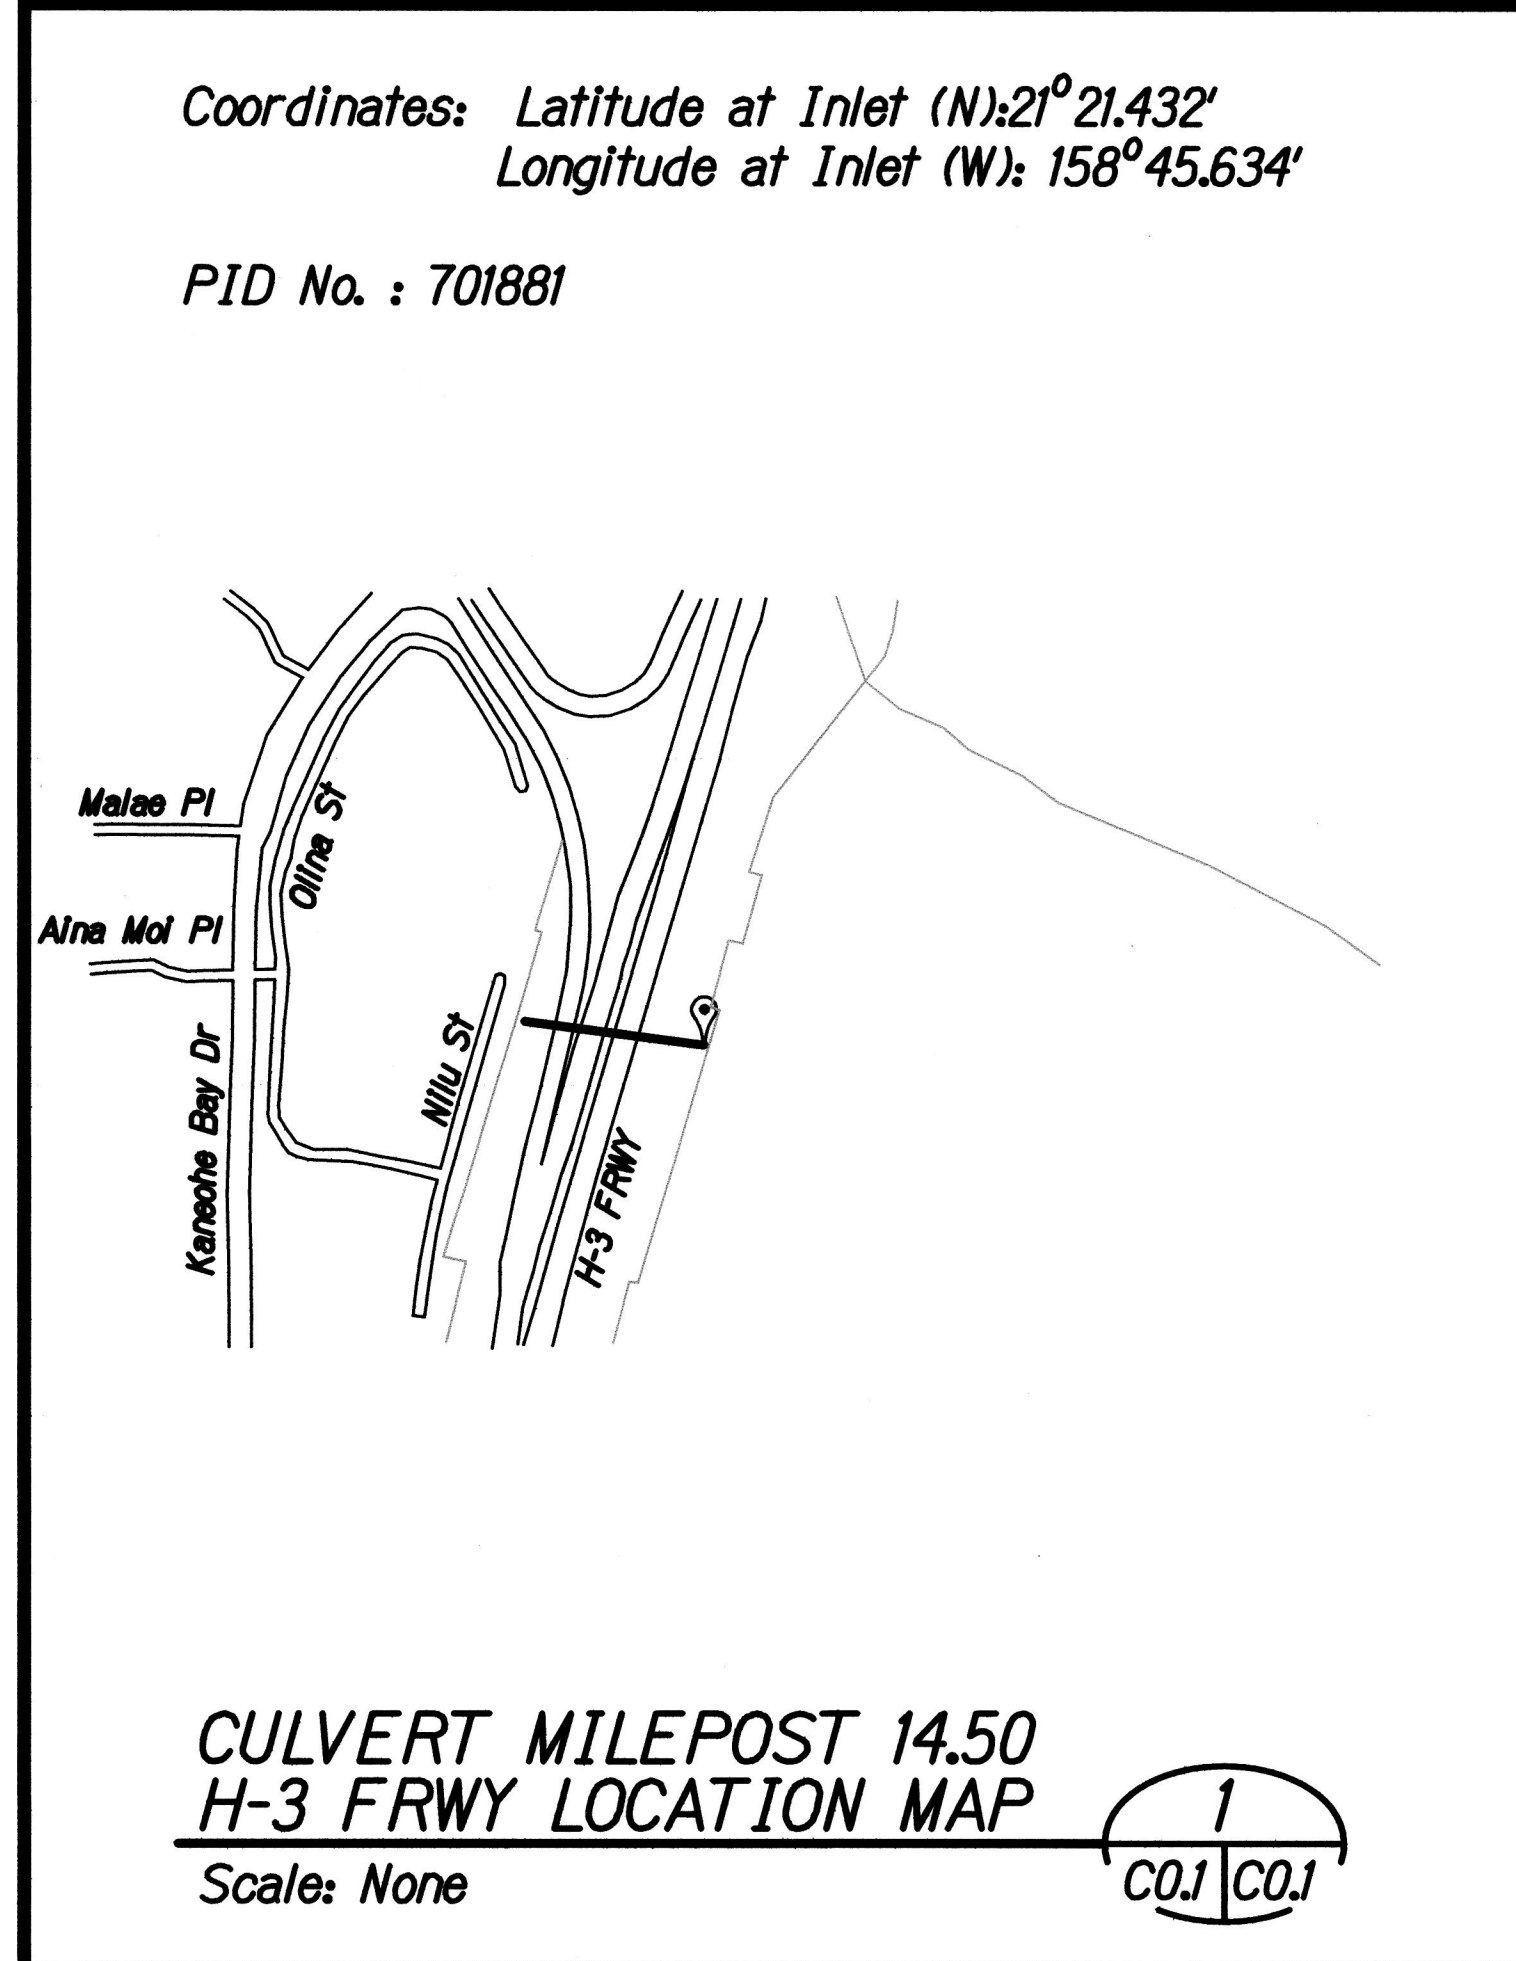
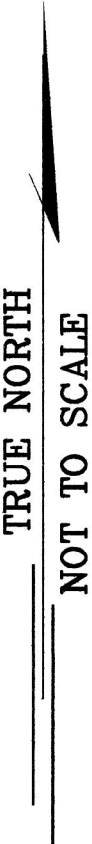
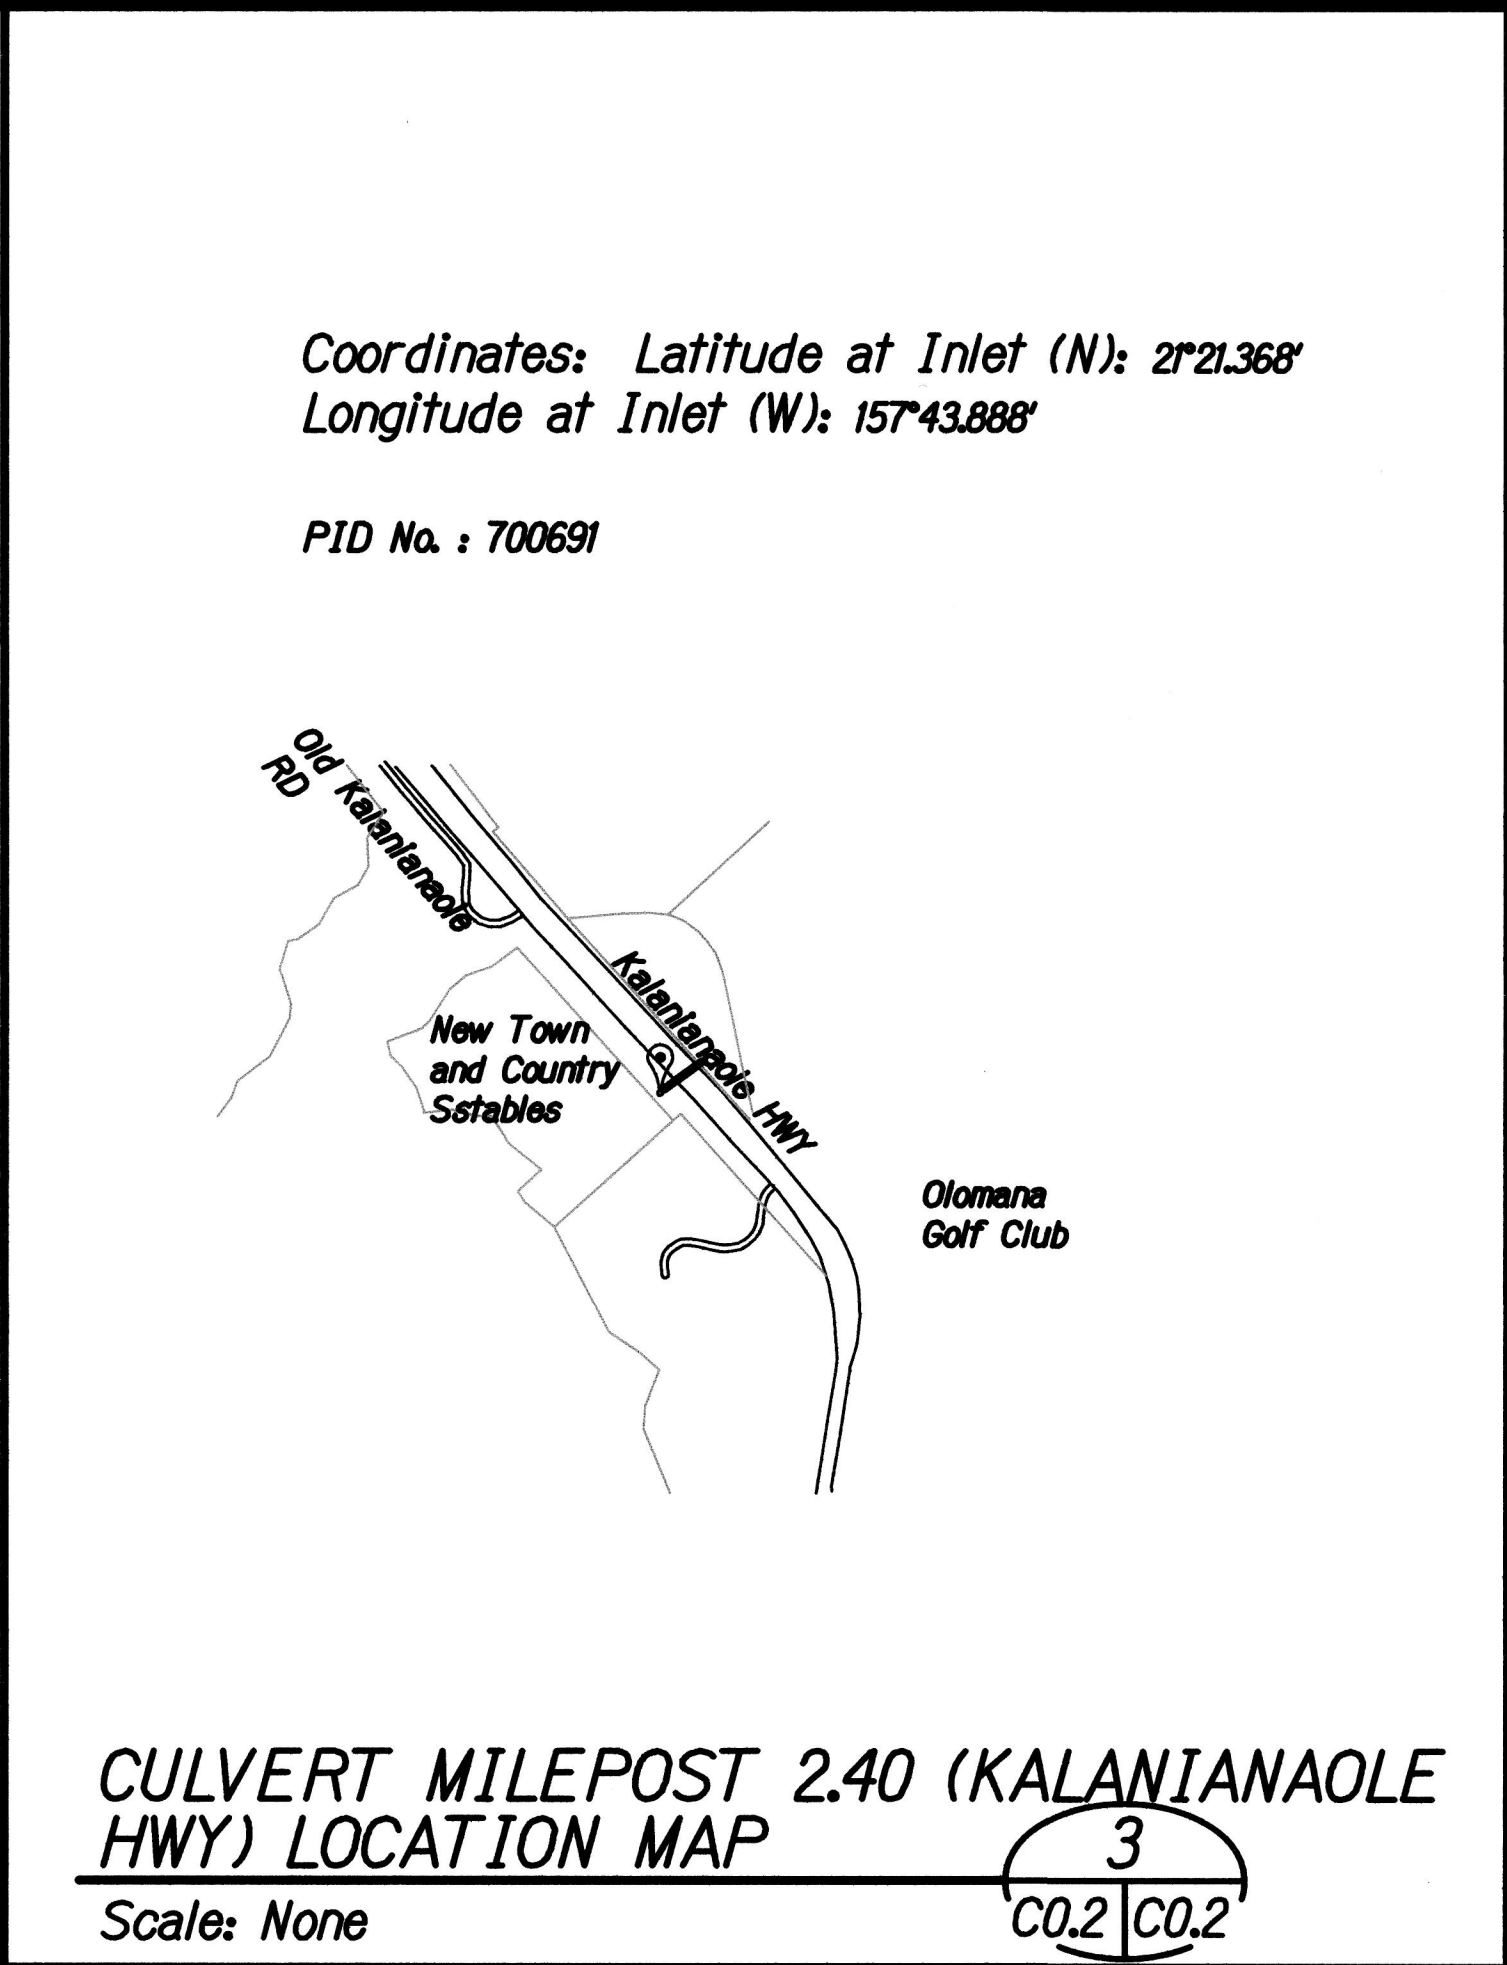


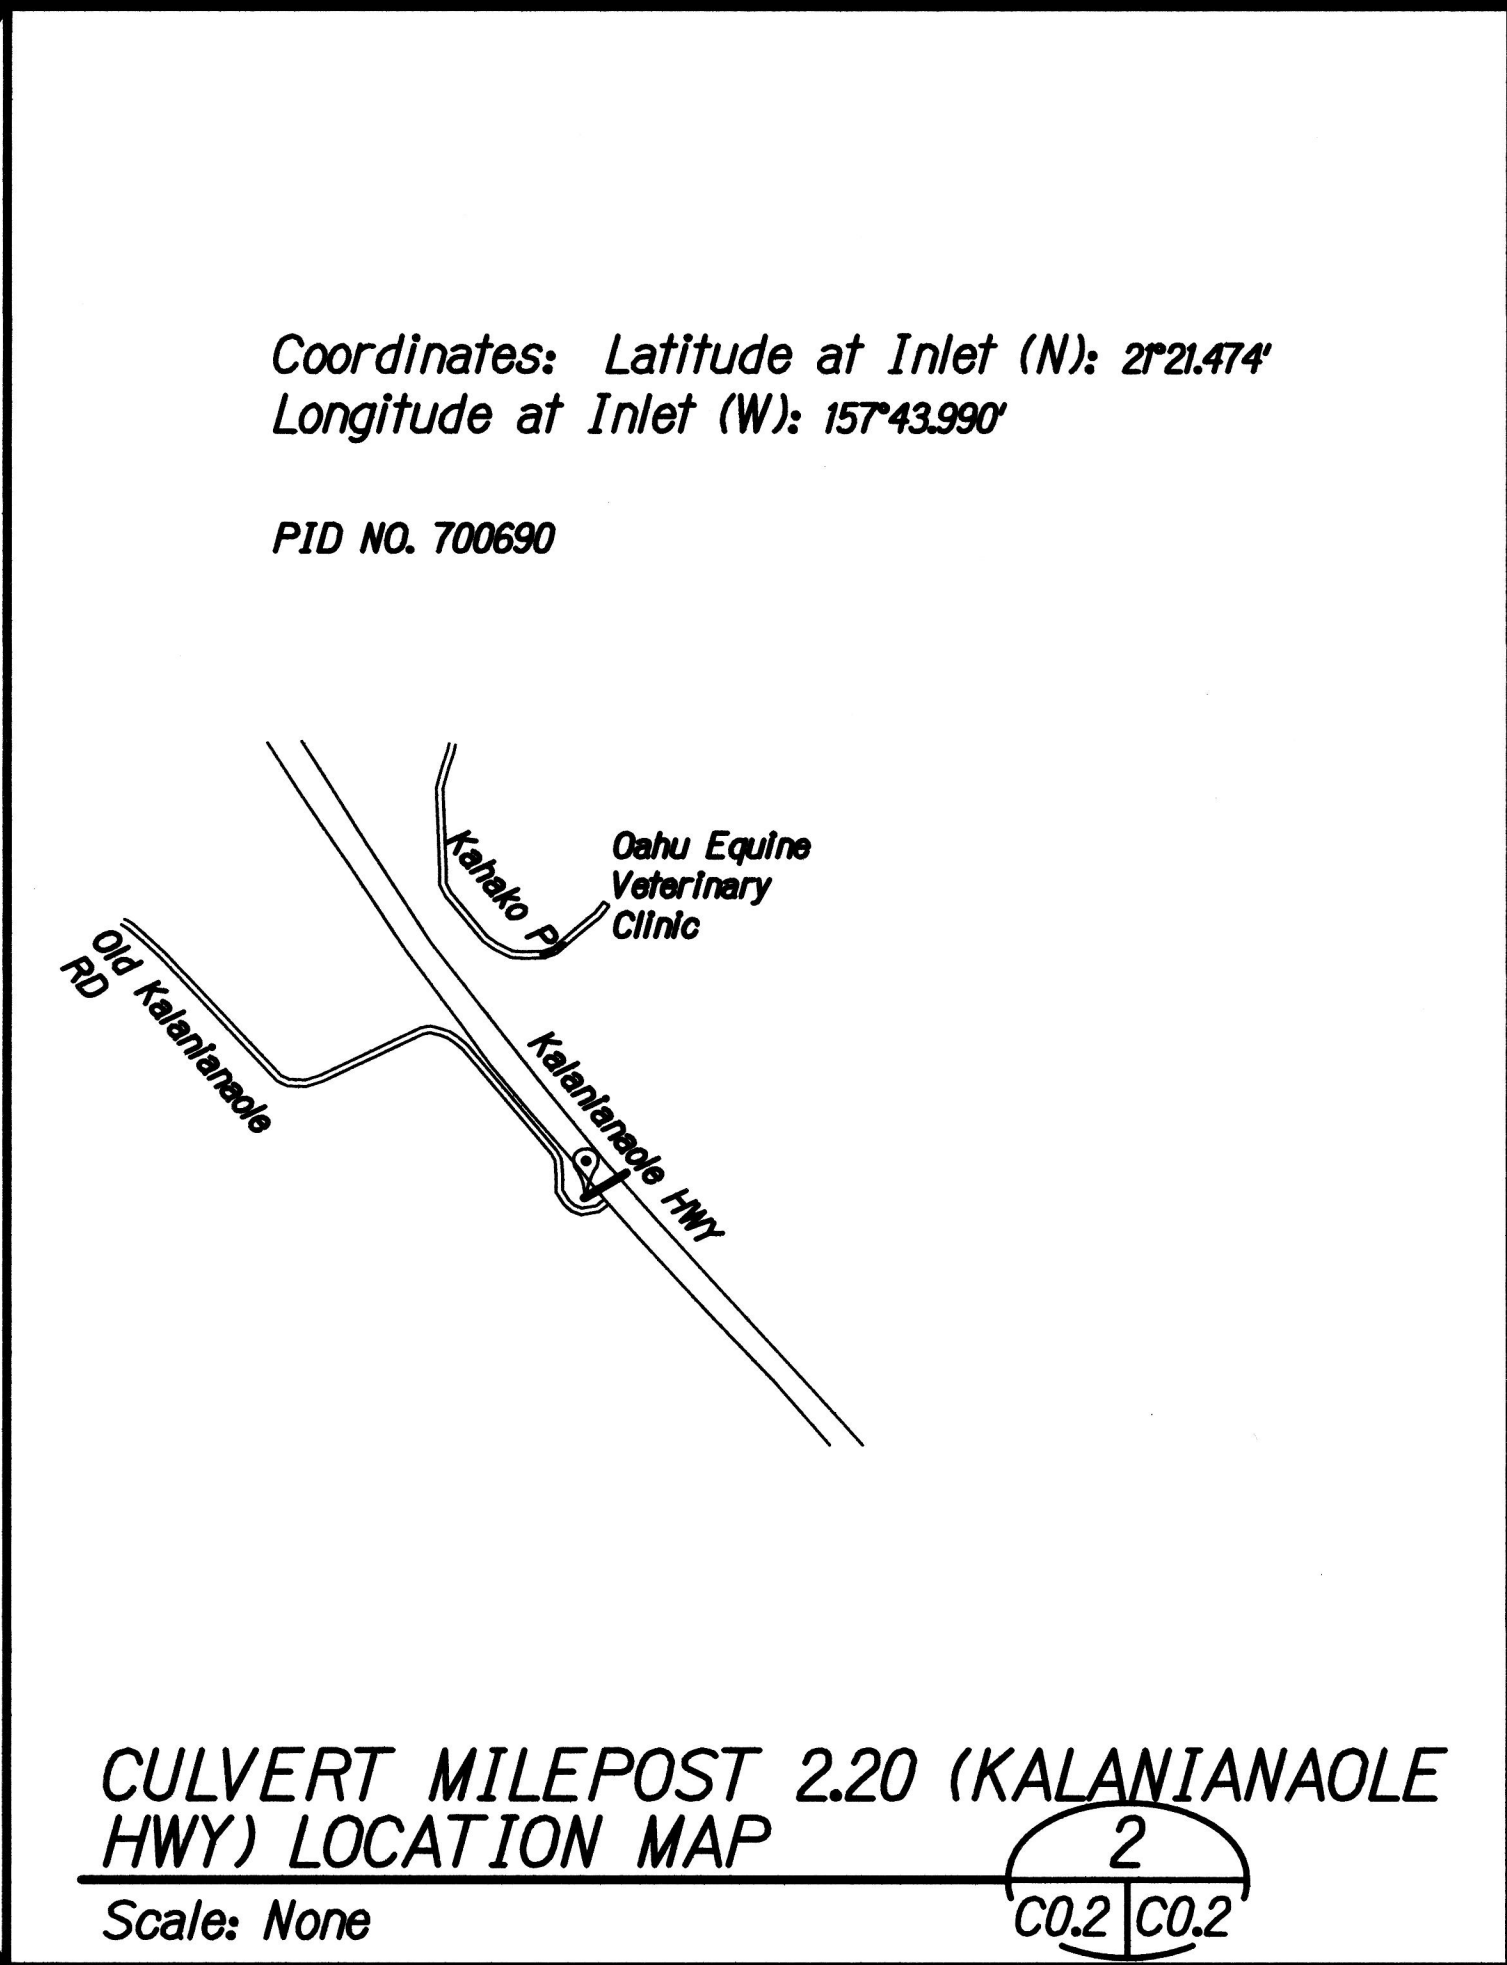

FED. ROAD DIST. NO.	STATE	PROJ. NO.	FISCAL YEAR	SHEET NO.	TOTAL SHEETS
HAWAII	HAW.	HWY-0-03-18	2018	ADD. 3	93

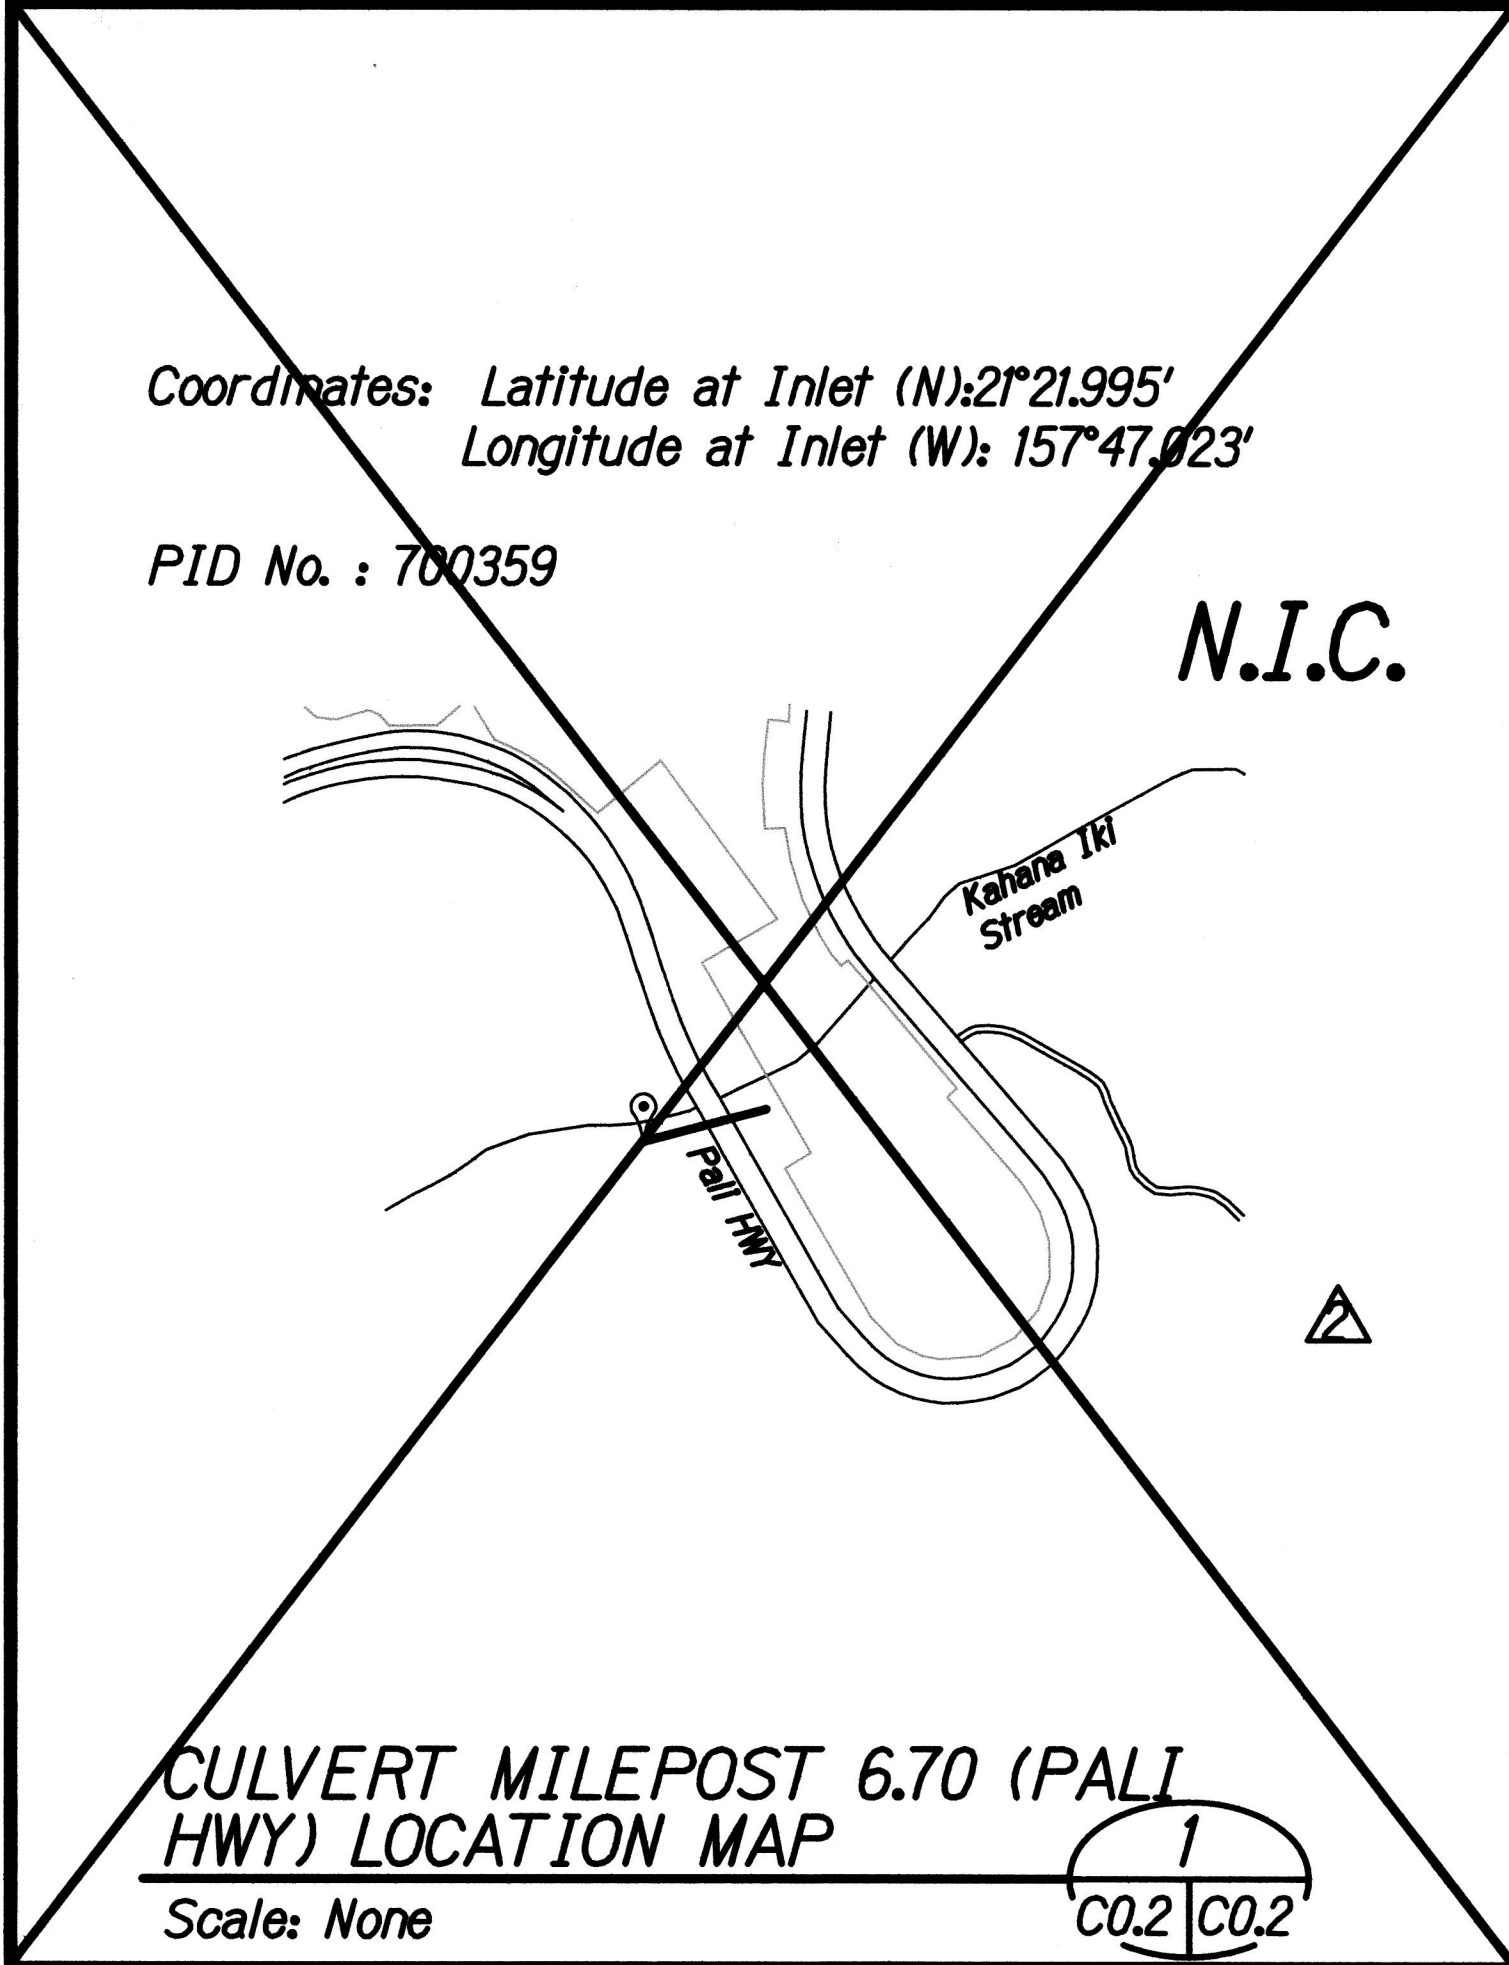

6/07/18	Site Deleted
DATE	REVISION
STATE OF HAWAII DEPARTMENT OF TRANSPORTATION HIGHWAYS DIVISION LOCATION MAPS CULVERT REMEDIATION AT VARIOUS LOCATIONS ON OAHU, PHASE 2 Project No. HWY-0-03-18 Scale: As Shown Date: May 2018 SHEET No. C0.2 OF 2 SHEETS	