


INDEX TO DRAWINGS		
SHEET NO.	DESCRIPTION	PID NO.
1	TITLE SHEET	
2-3	LOCATION MAPS	
4-14	NOTES AND TYPICAL DETAILS	
15-23	CULVERT MILEPOST 14.50 (H3)	701881 700881
24-31	CULVERT MILEPOST 14.10 (H3)	701286
32-39	CULVERT MILEPOST 14.00 (H3)	701471
40-42	CULVERT MILEPOST 14.00 (H3)	701472
43-51	CULVERT MILEPOST 12.88 (H3)	701059
52-62	CULVERT MILEPOST 13.20 (H3)	700875
63-74	CULVERT MILEPOST 12.56 (H3)	701105 701015
75-80	CULVERT MILEPOST 6.70 (PALI)	700359
81-86	CULVERT MILEPOST 2.20 (KAL)	700690
87-93	CULVERT MILEPOST 2.40 (KAL)	700691

STATE OF HAWAII
DEPARTMENT OF TRANSPORTATION
HIGHWAYS DIVISION
HONOLULU, HAWAII
"AS-BUILT"
PLANS FOR
CULVERT REMEDIATION AT VARIOUS
LOCATIONS ON OAHU, PHASE 2

PROJECT NO. HWY-O-03-18
DISTRICT OF KOOLAUPOKO
ISLAND OF OAHU

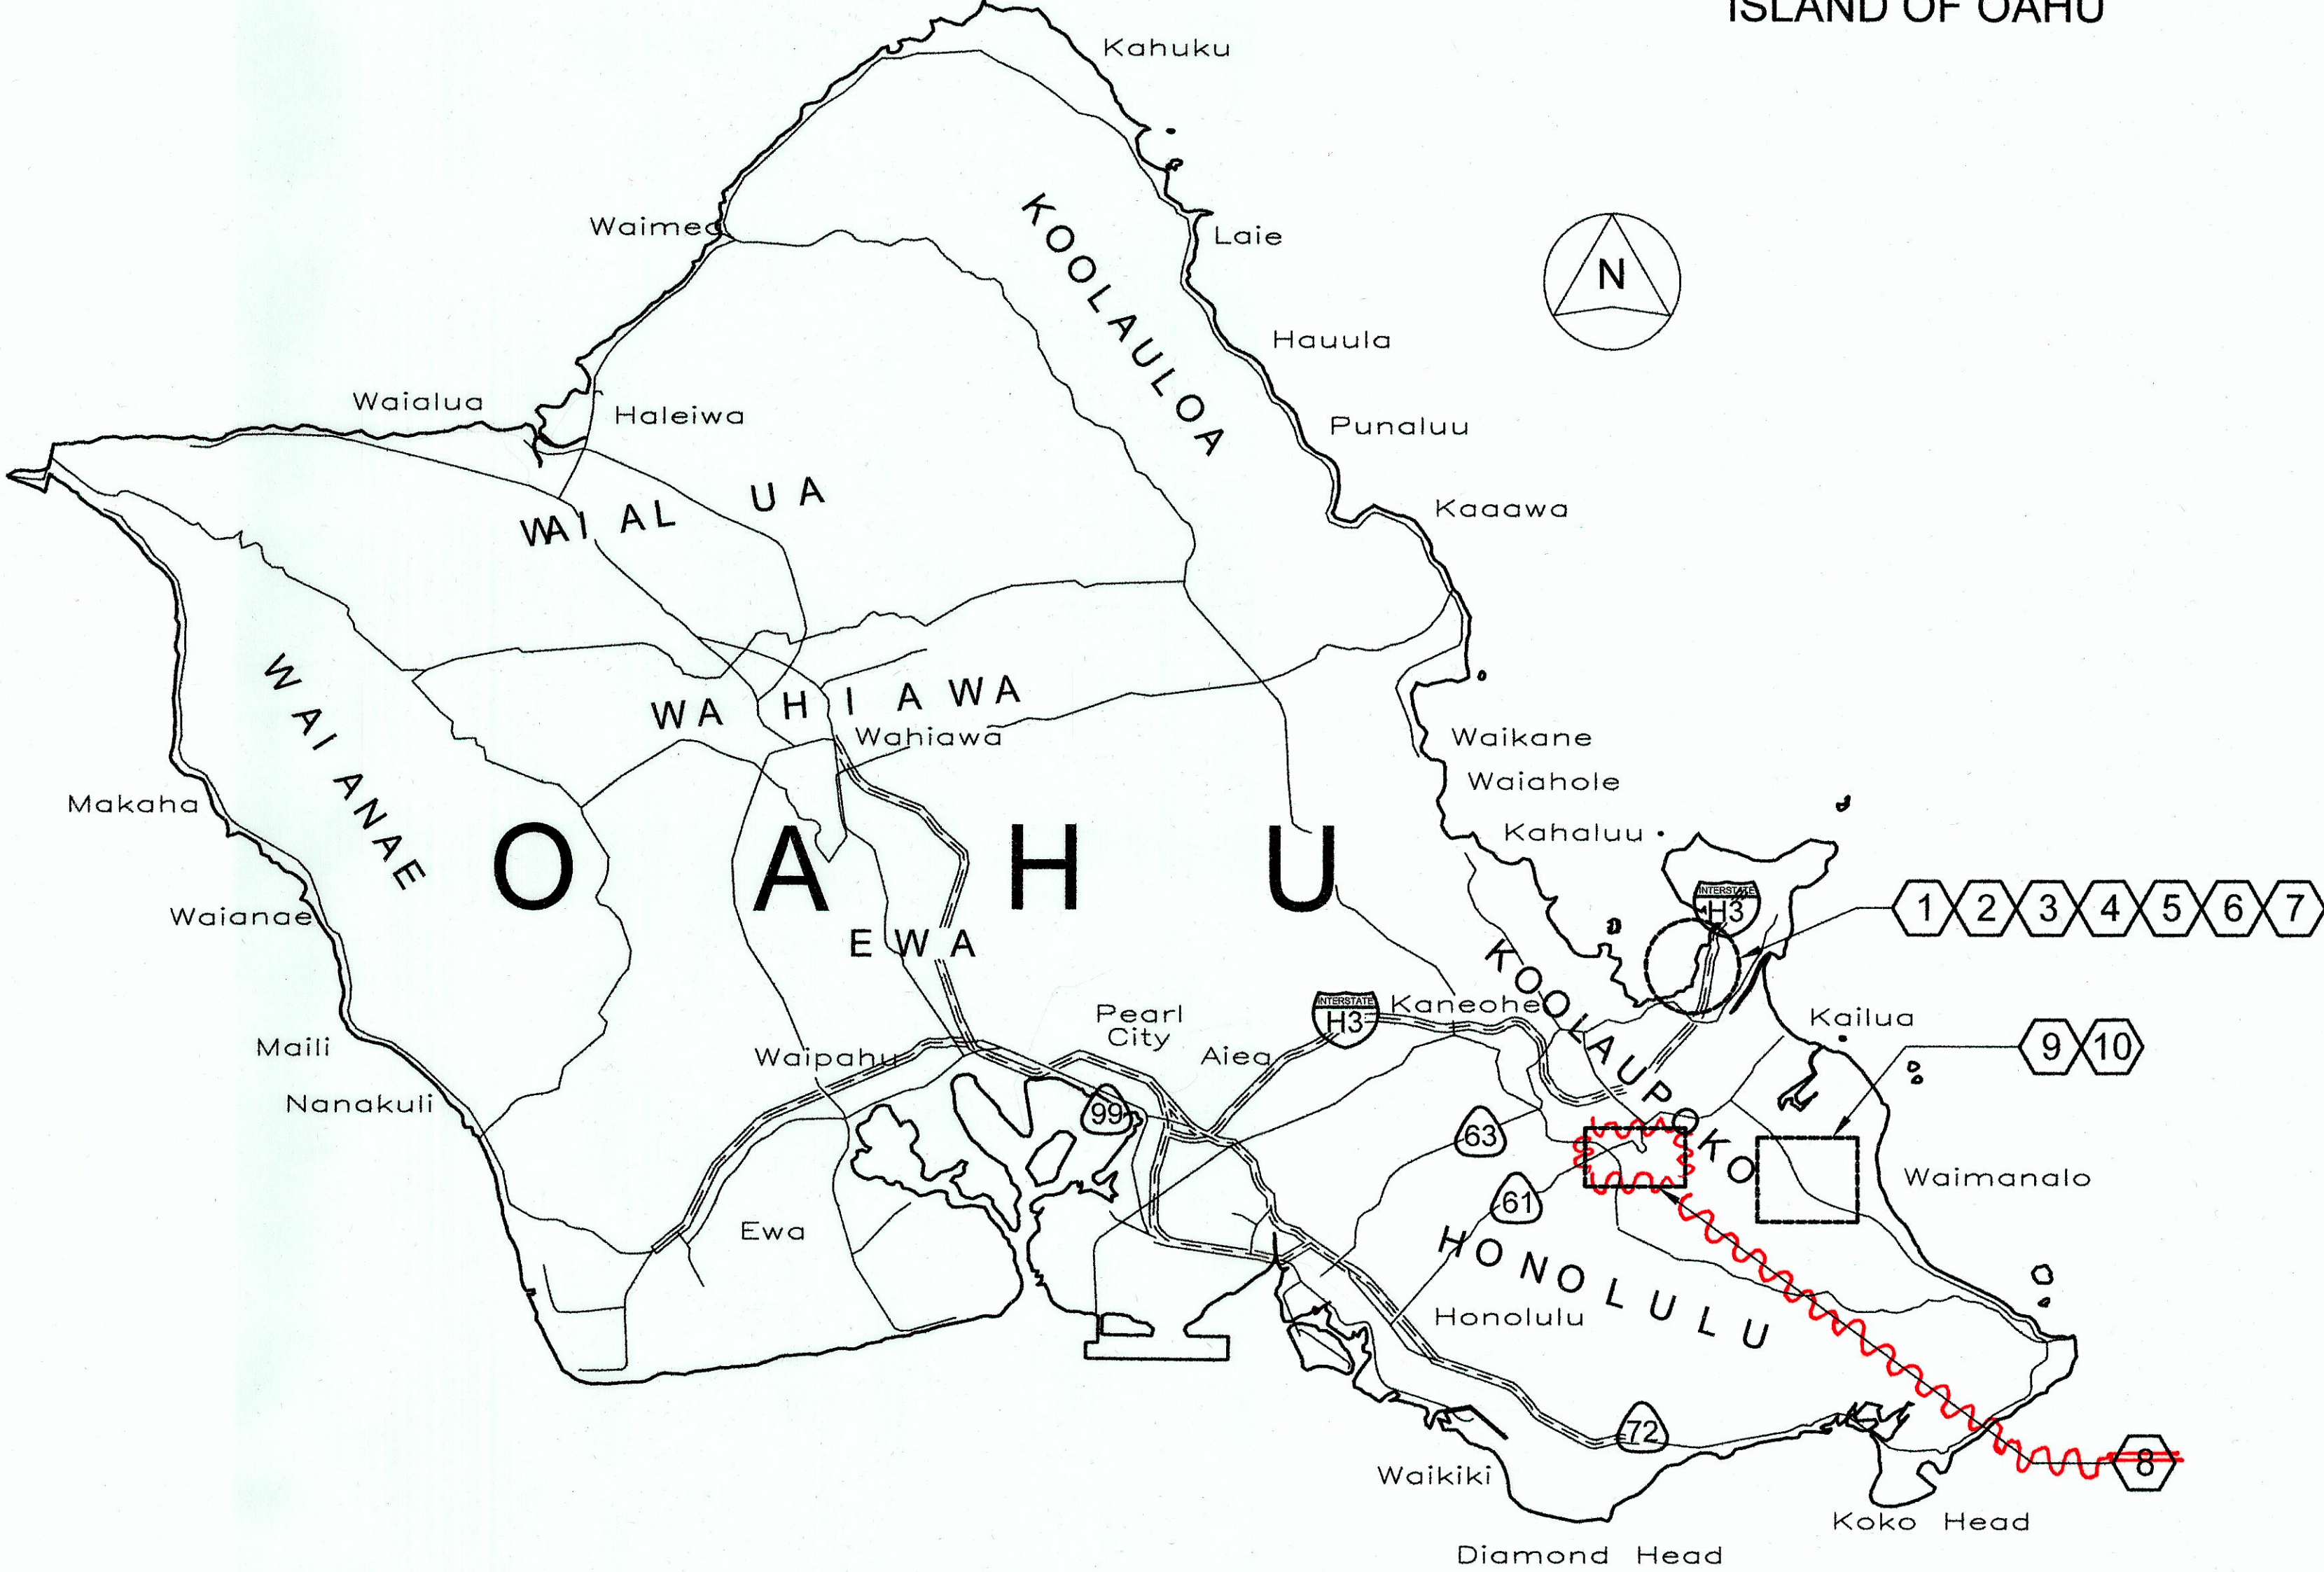

- PROJECT SITES**
- 1 JOHN A. BURNS FREEWAY: H-3
MILEPOST 14.50 - PID ~~701881~~ 700881
 - 2 JOHN A. BURNS FREEWAY: H-3
MILEPOST 14.10- PID 701286
 - 3 JOHN A. BURNS FREEWAY: H-3
MILEPOST 14.00 - 36" CMP- PID 701471
 - 4 JOHN A. BURNS FREEWAY: H-3
MILEPOST 14.00 - 24" CMP- PID 701472
 - 5 JOHN A. BURNS FREEWAY: H-3
MILEPOST 12.88 - PID 701059
 - 6 JOHN A. BURNS FREEWAY: H-3
MILEPOST 13.2 - PID 700875
 - 7 JOHN A. BURNS FREEWAY: H-3
MILEPOST 12.56- PID ~~701105~~ 701015
 - ~~8 PALI HIGHWAY MILEPOST 6.70 - 61- PID 700359 - N.I.C.~~
 - 9 KALANIANAOLE HIGHWAY MILEPOST 2.20: 72- PID 700690
 - 10 KALANIANAOLE HIGHWAY MILEPOST 2.40 :72- PID 700691

FEDERAL AND INTERSTATE PROJECTS PREVIOUSLY
CONSTRUCTED OR UNDER CONSTRUCTION

CHANGES MADE DURING CONSTRUCTION HAVE BEEN
INCORPORATED ON THESE PLANS EXCEPT CHANGES
IN THE ORIGINAL THEORETICAL QUANTITIES. FOR
ACTUAL QUANTITIES, REFER TO PROJECT LEDGER
AND/OR COMPUTATION BOOK.

[Signature] 4/21/20
RESIDENT ENGINEER DATE

DEPARTMENT OF TRANSPORTATION
STATE OF HAWAII
APPROVED:
[Signature] 4/12/18
S.W. DIR. OF TRANSPORTATION DATE

FED. ROAD DIST. NO.	STATE	PROJ. NO.	FISCAL YEAR	SHEET NO.	TOTAL SHEETS
HAWAII	HAW.	HWY-O-03-18	2018	1	93

