




FED. ROAD DIST. NO.	STATE	PROJ. NO.	FISCAL YEAR	SHEET NO.	TOTAL SHEETS
HAWAII	HAW.	HWY-O-04-14M	2014	3	67

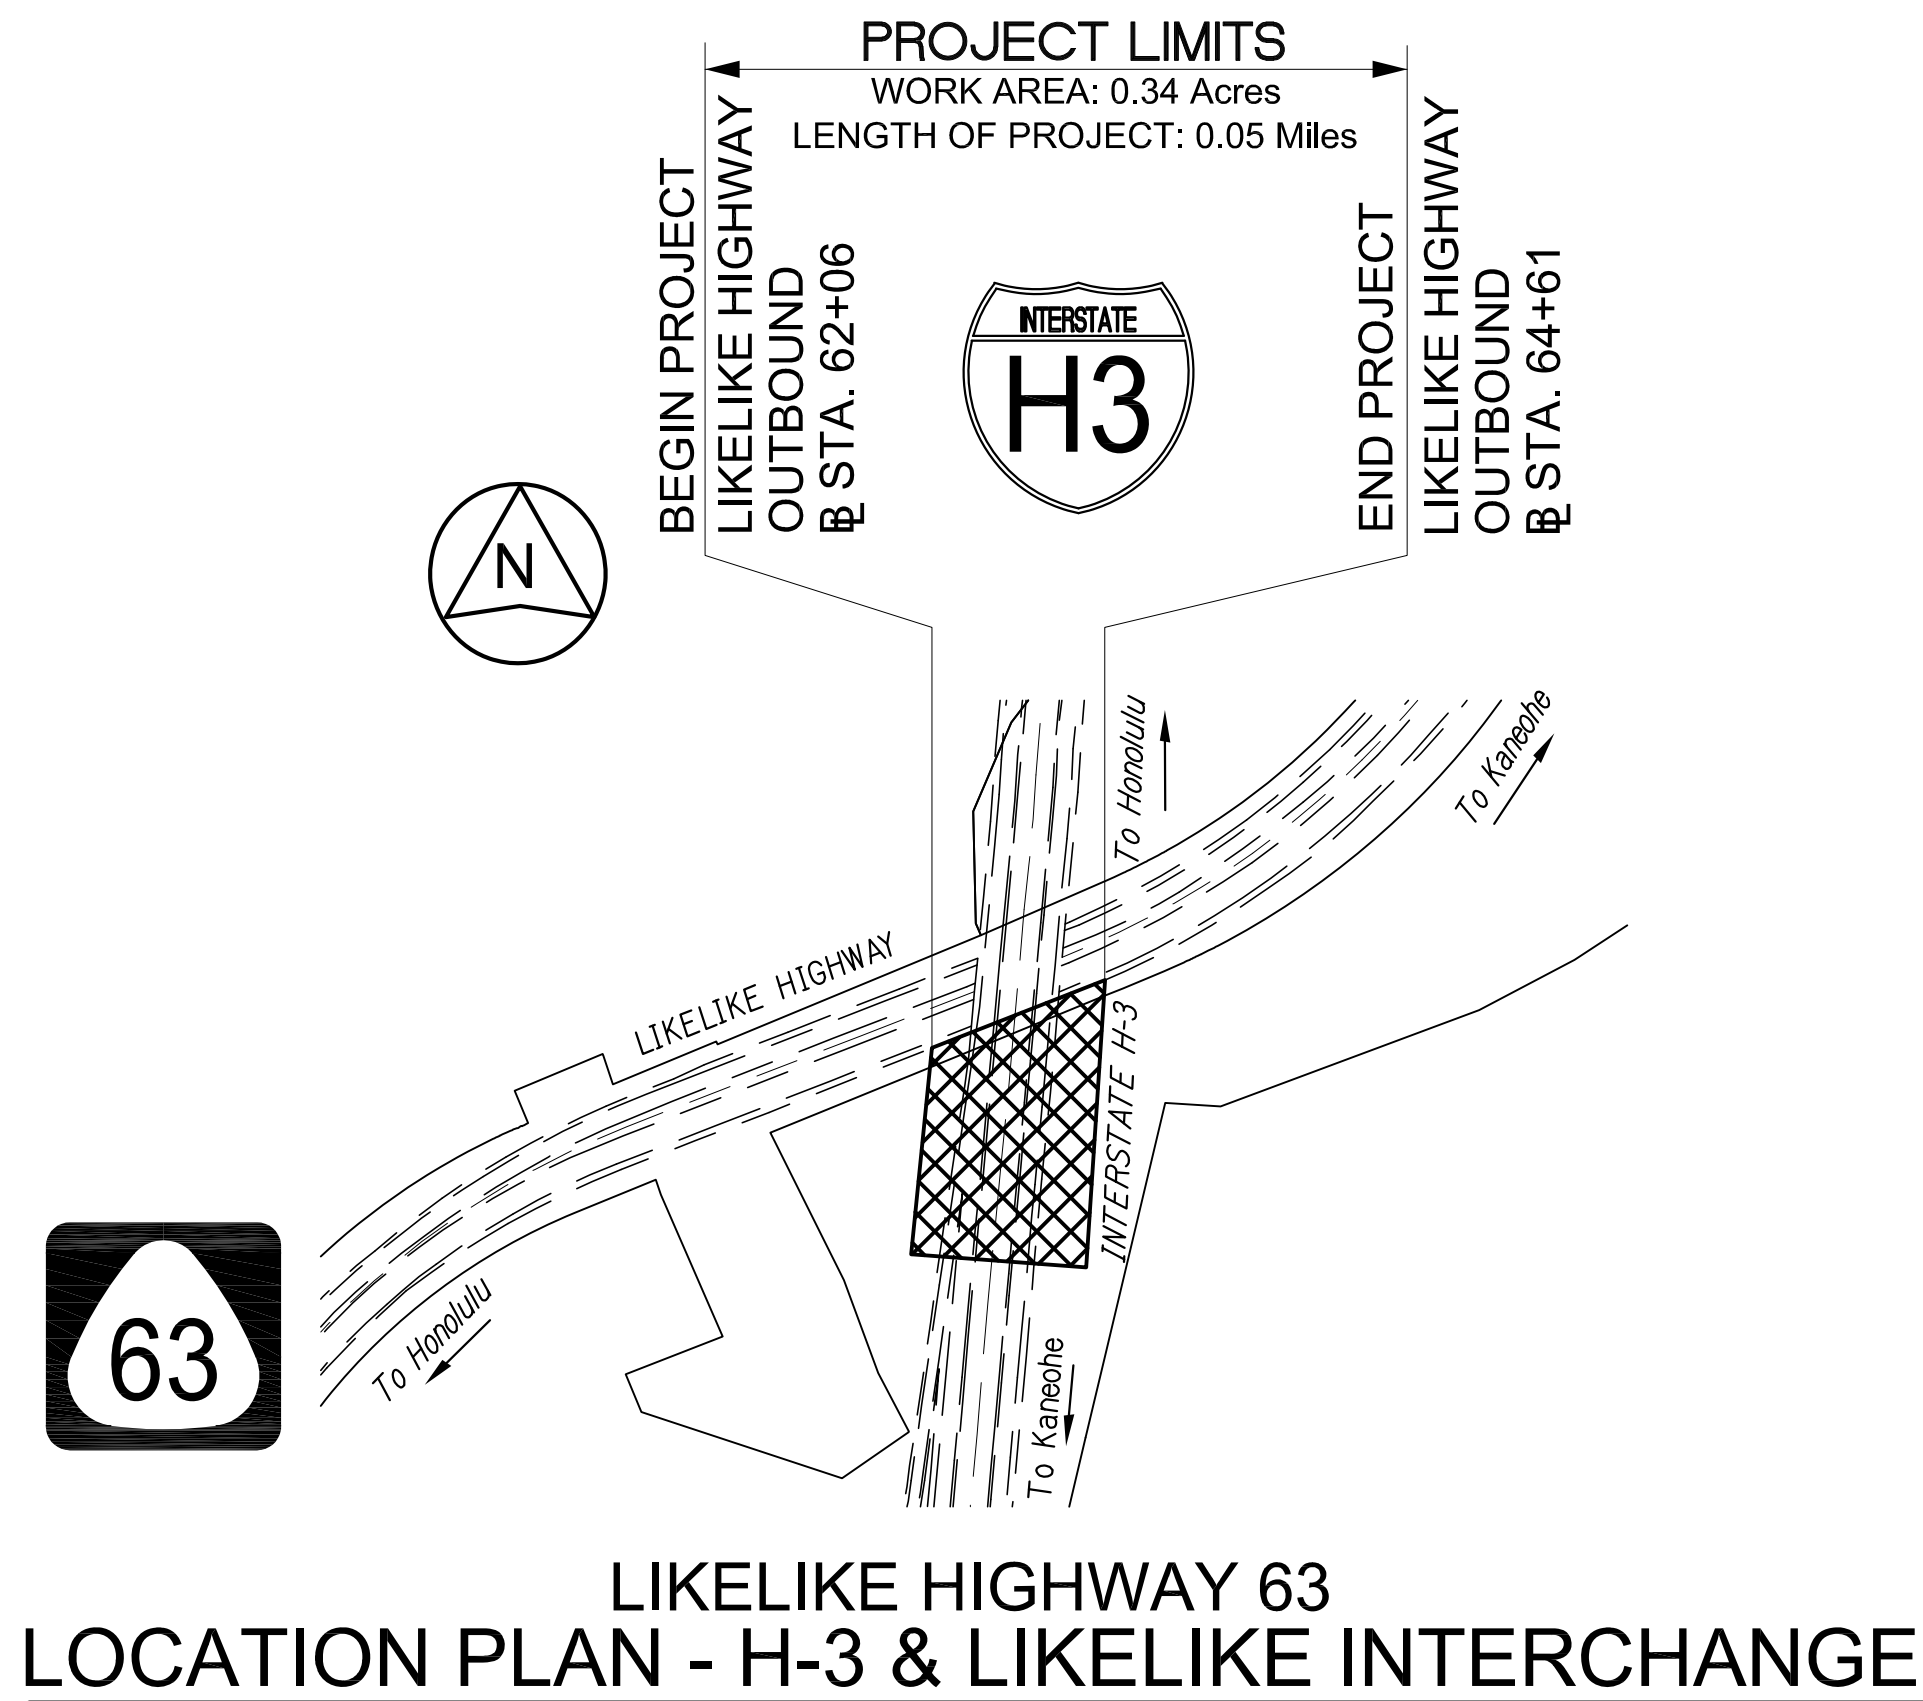


NOT TO SCALE

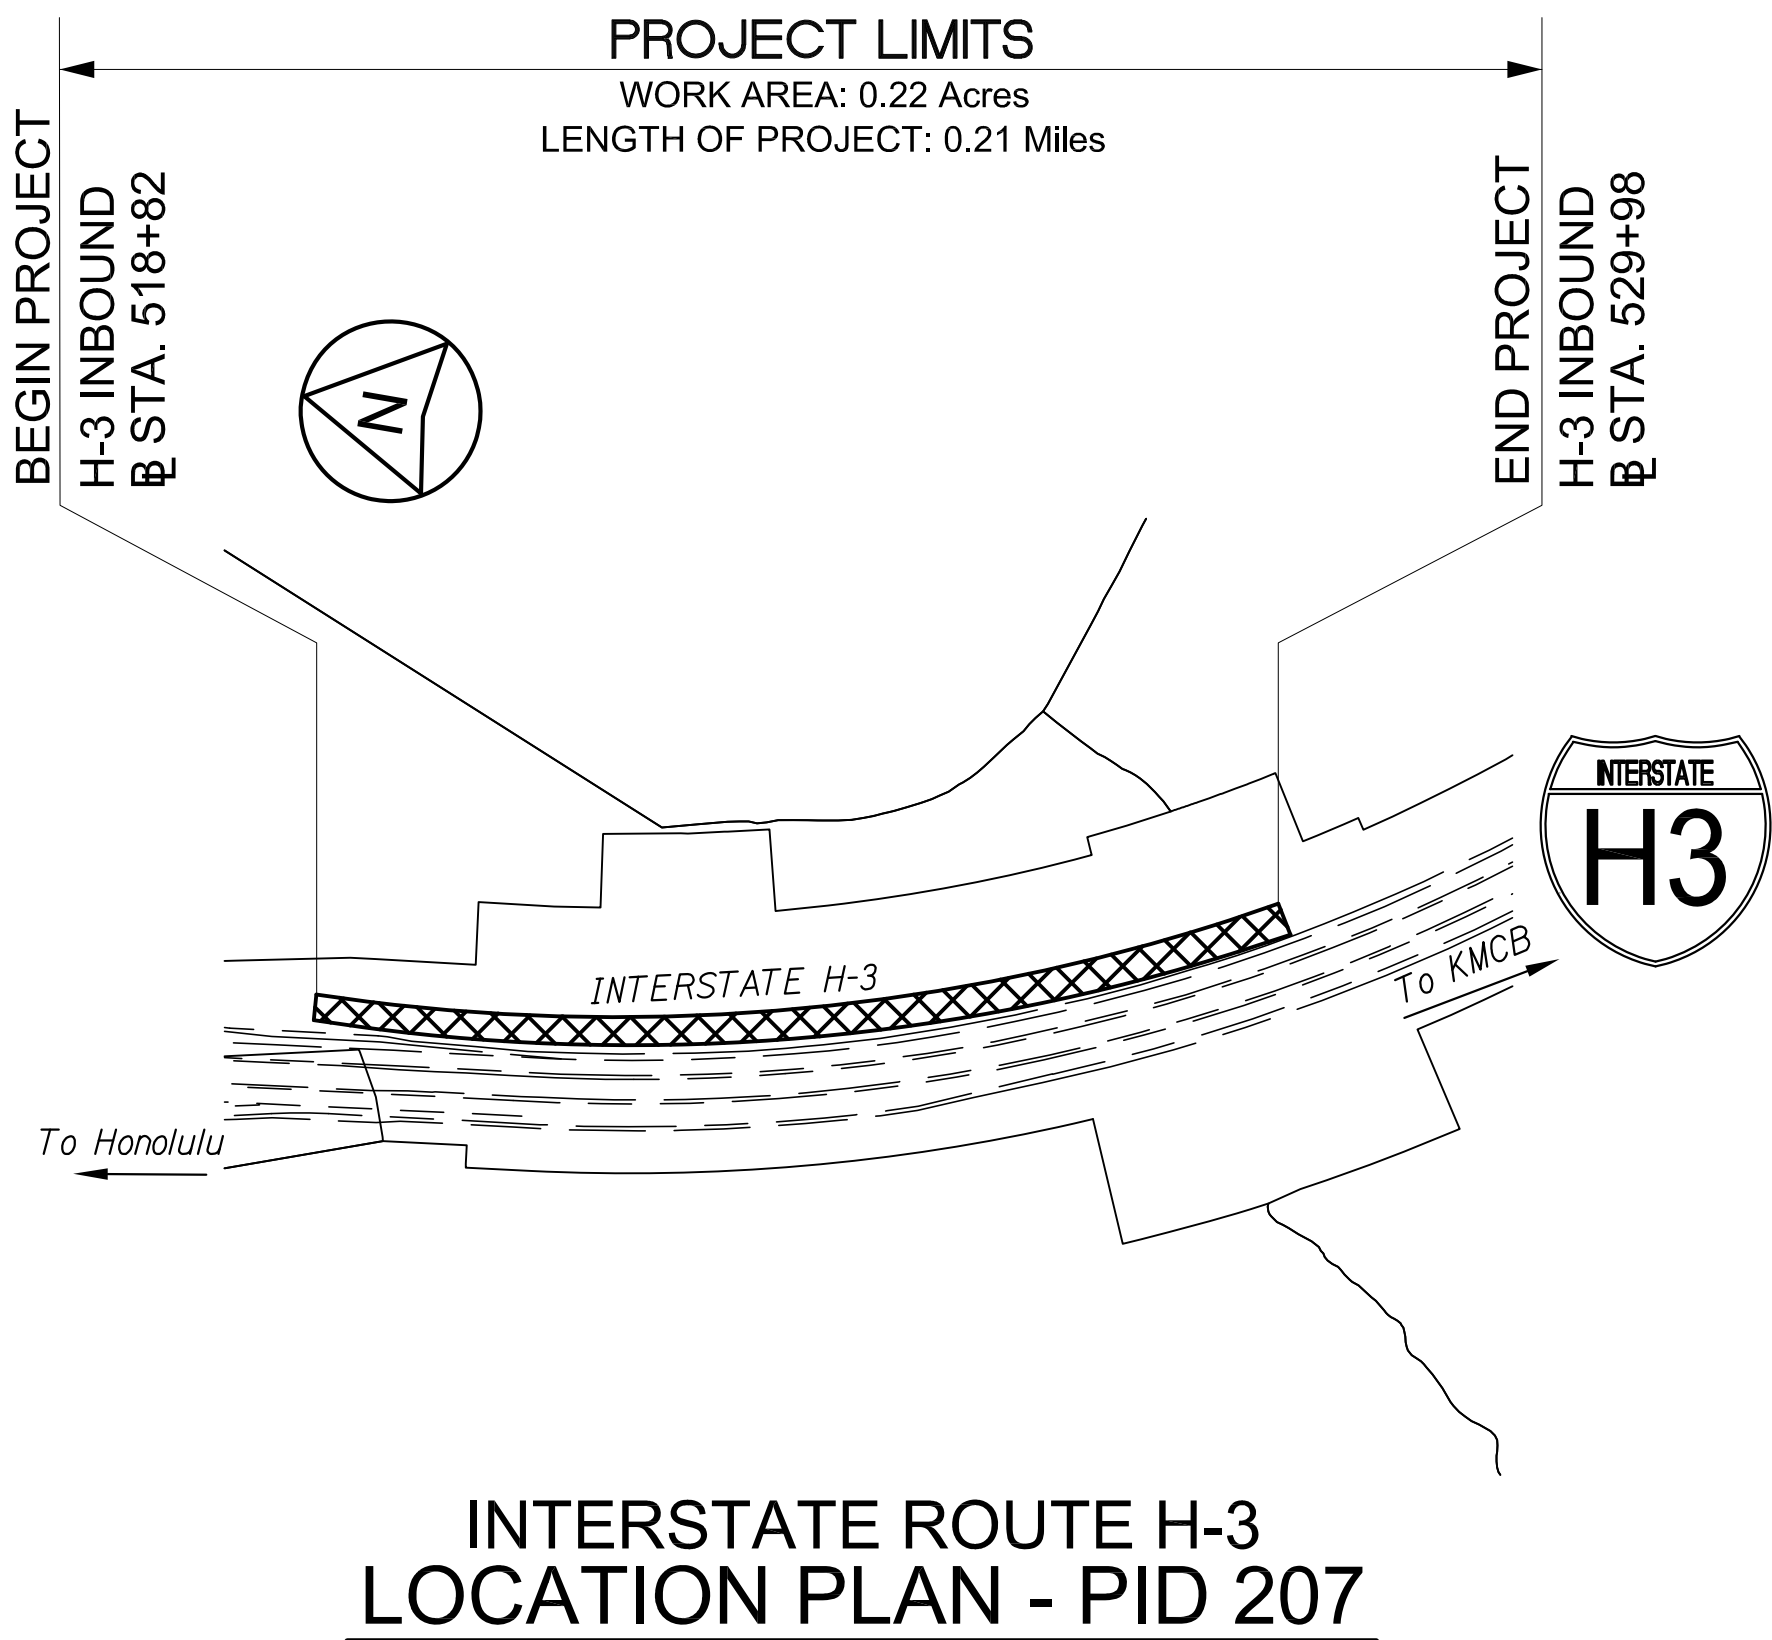


NOT TO SCALE

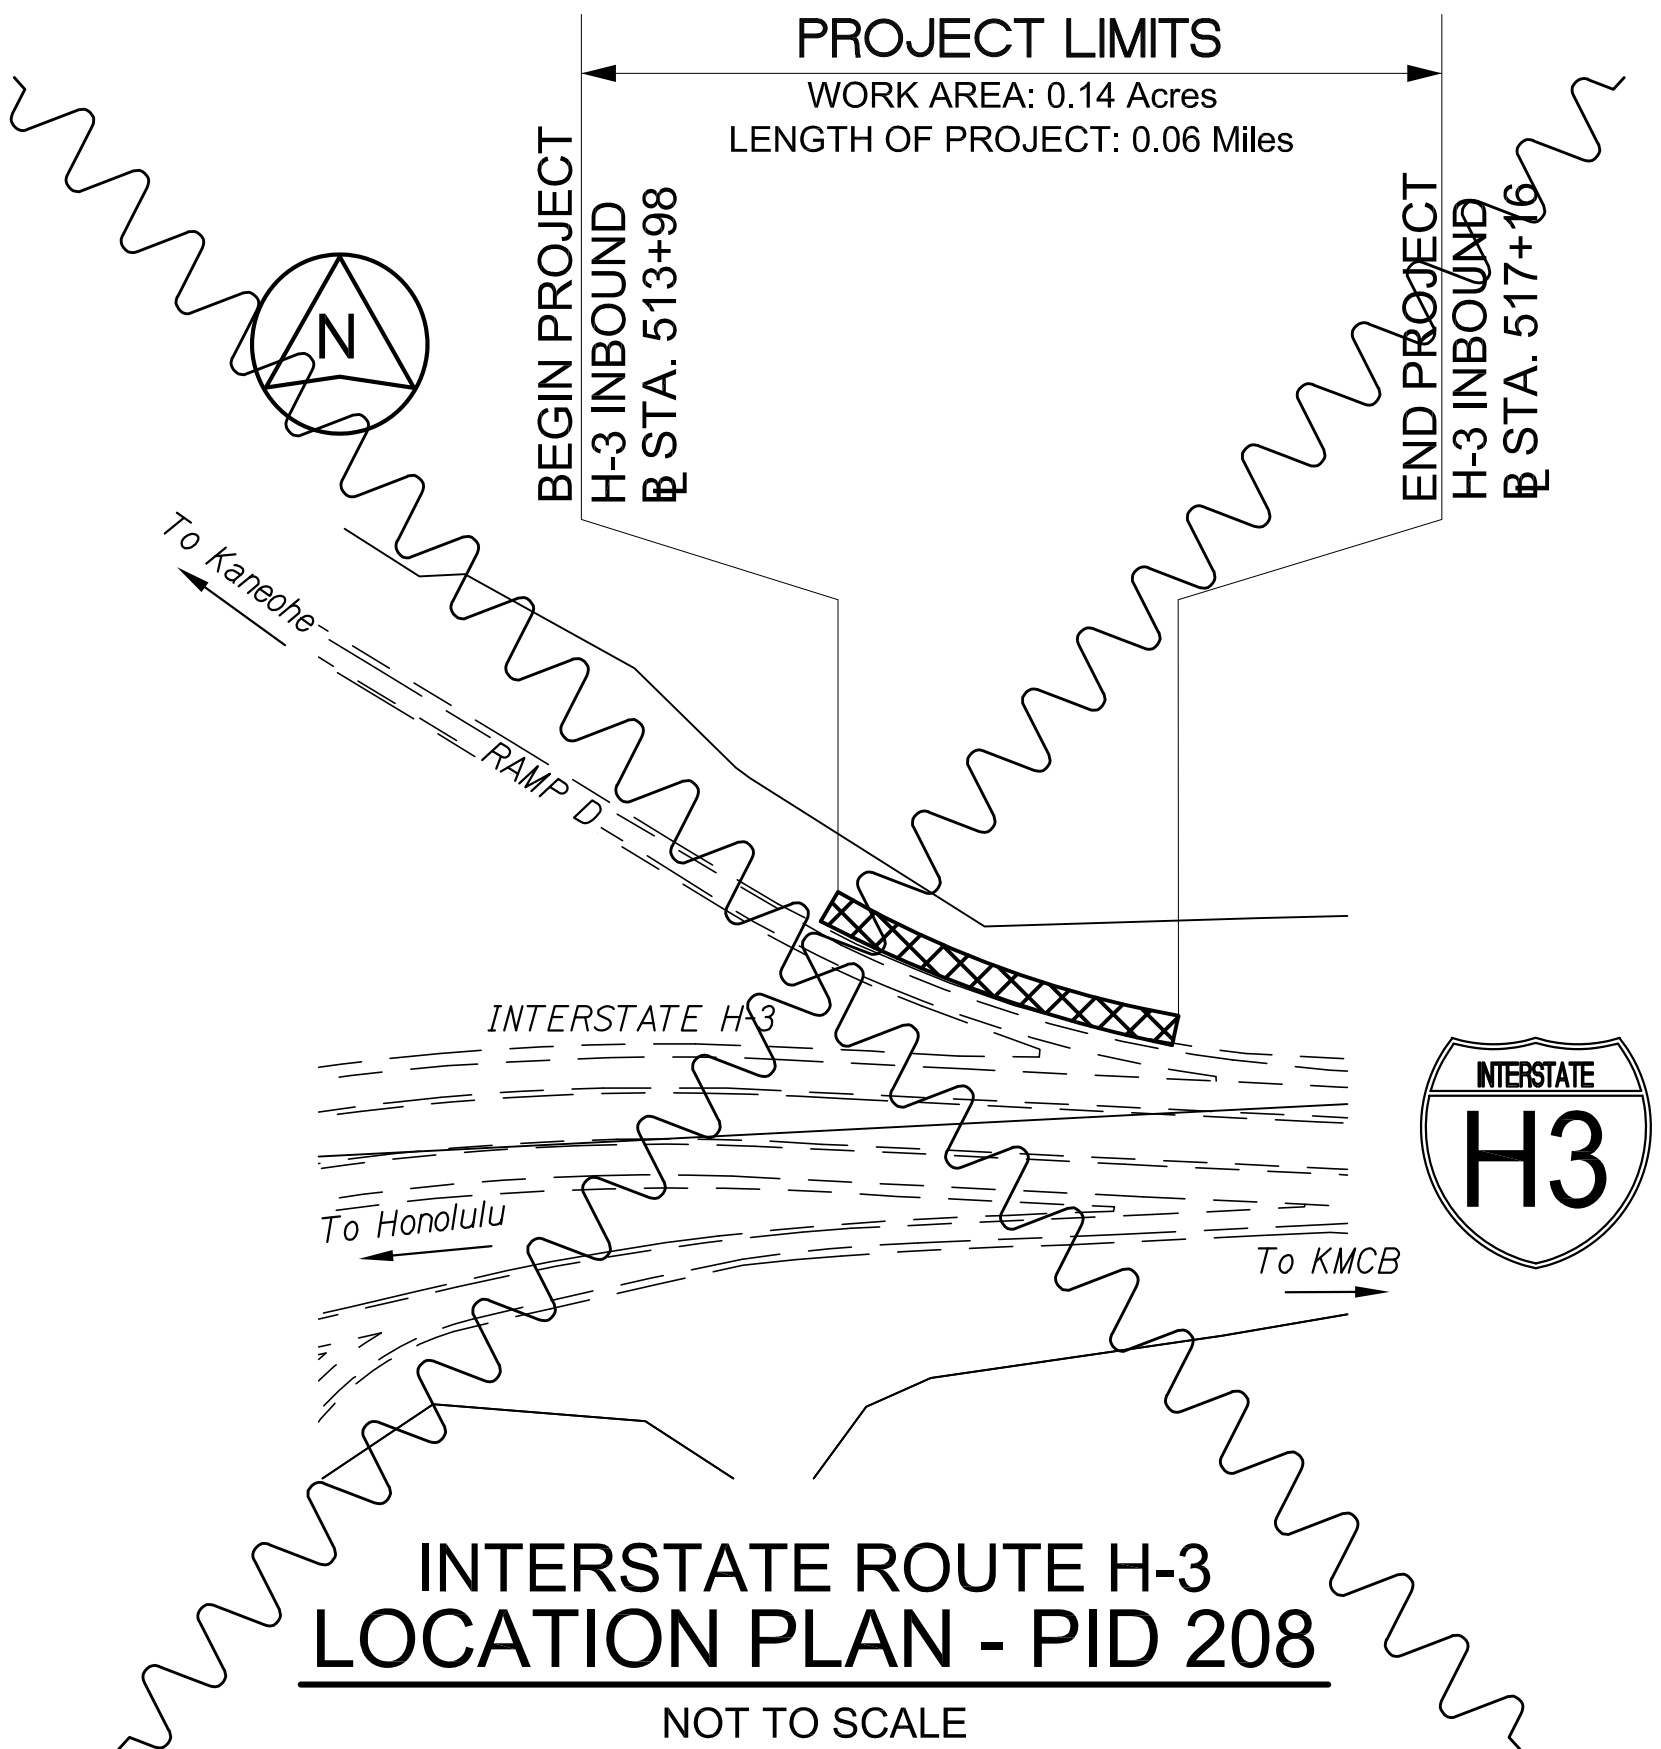

NOT TO SCALE

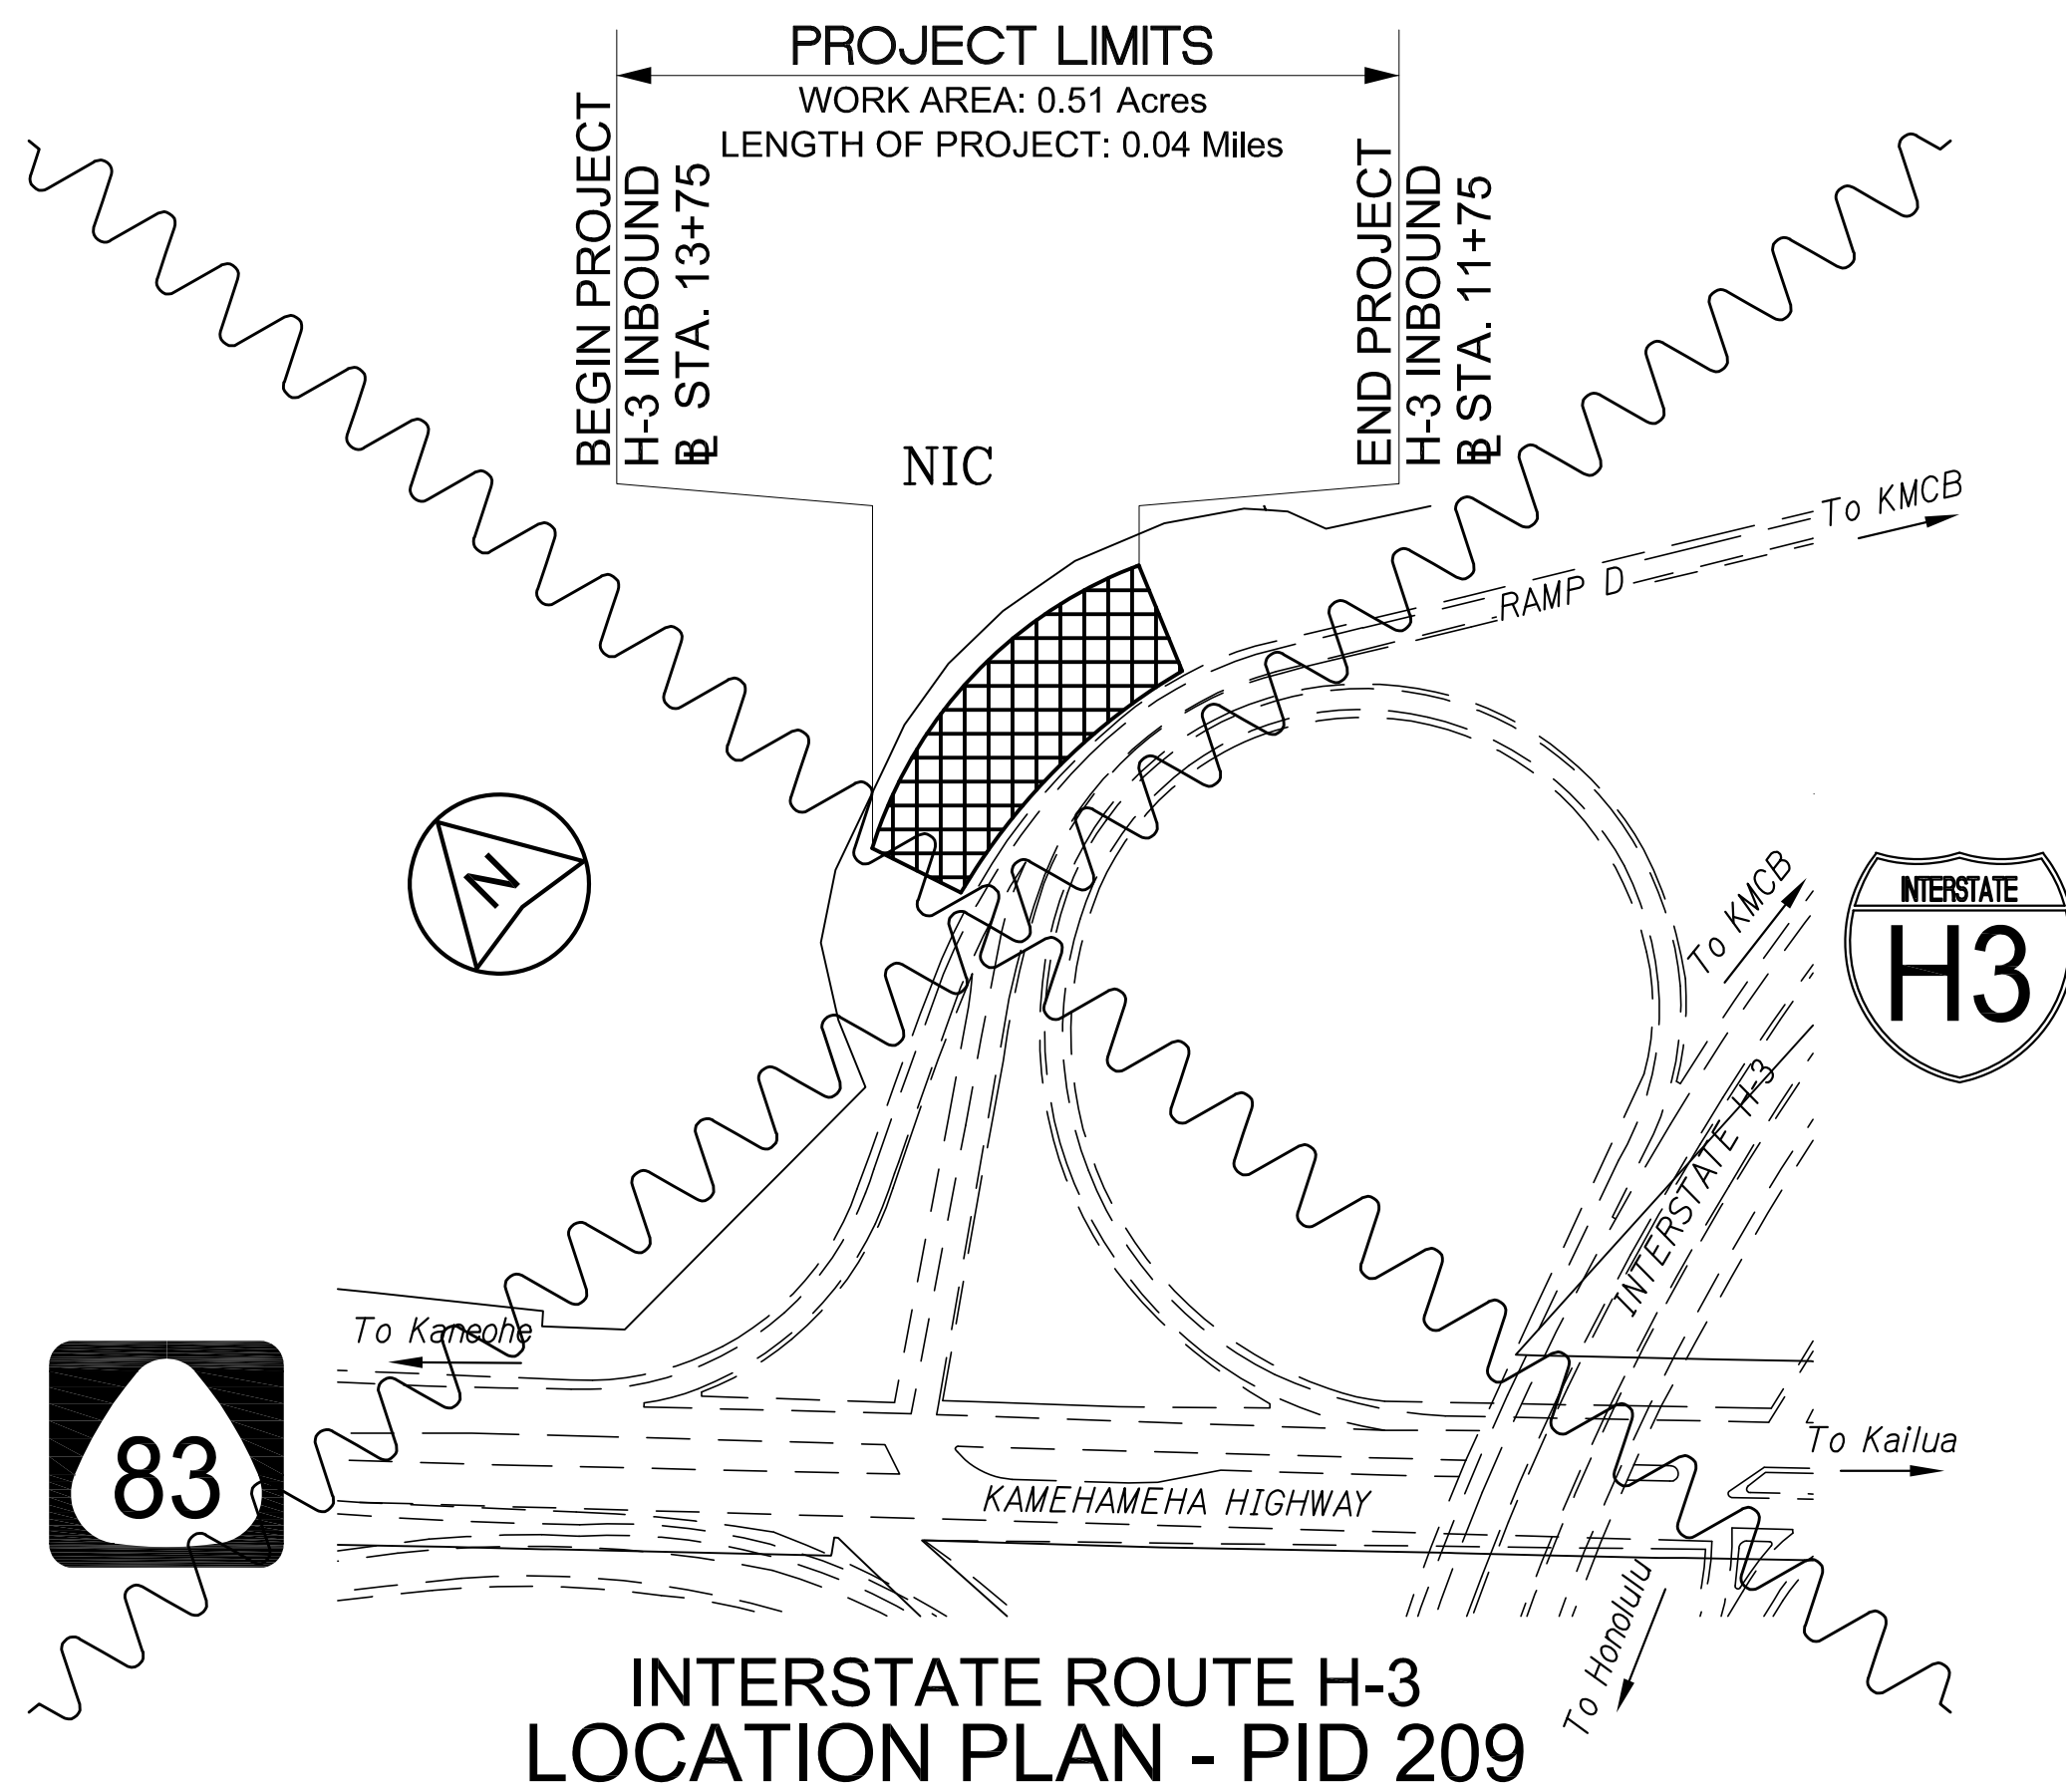

NOT TO SCALE

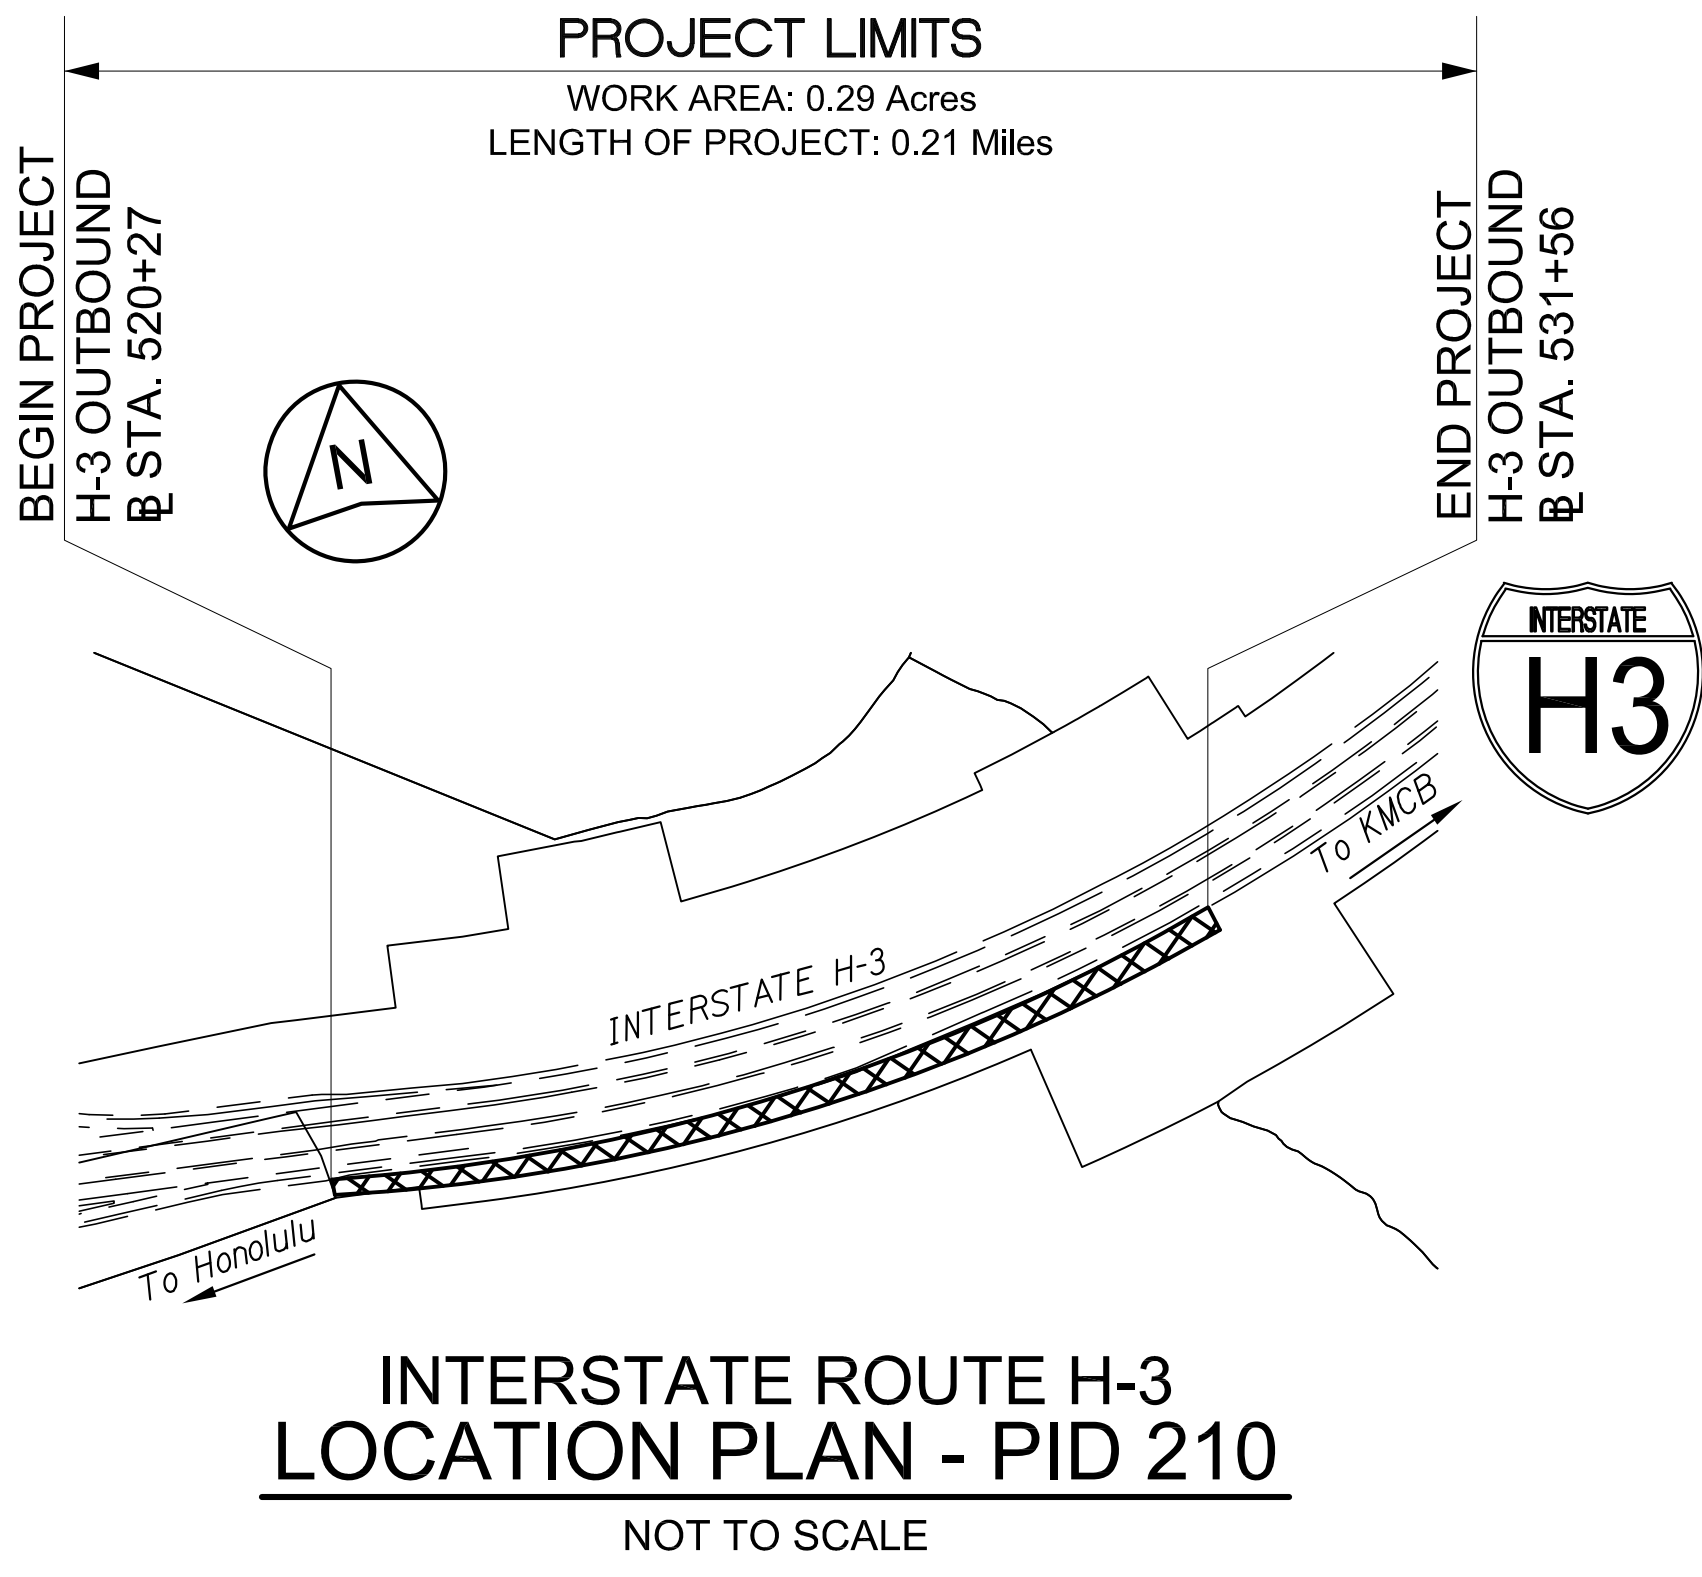

NOT TO SCALE

LEGEND FOR AS-BUILT POSTINGS	
	Squiggly line for as-built deletion
	Double line for as-built deletion
Roadway	Text for as-built posting


STATE OF HAWAII
DEPARTMENT OF TRANSPORTATION
HIGHWAYS DIVISION

LOCATION PLAN

**KANEOHE WATERSHED STORM WATER
BEST MANAGEMENT PRACTICES ON OAHU**

Project No. HWY-O-04-14M
Scale: Not to Scale
Date: March 2014


FED. ROAD DIST. NO.	STATE	PROJ. NO.	FISCAL YEAR	SHEET NO.	TOTAL SHEETS
HAWAII	HAW.	HWY-O-04-14M	2014	4	67

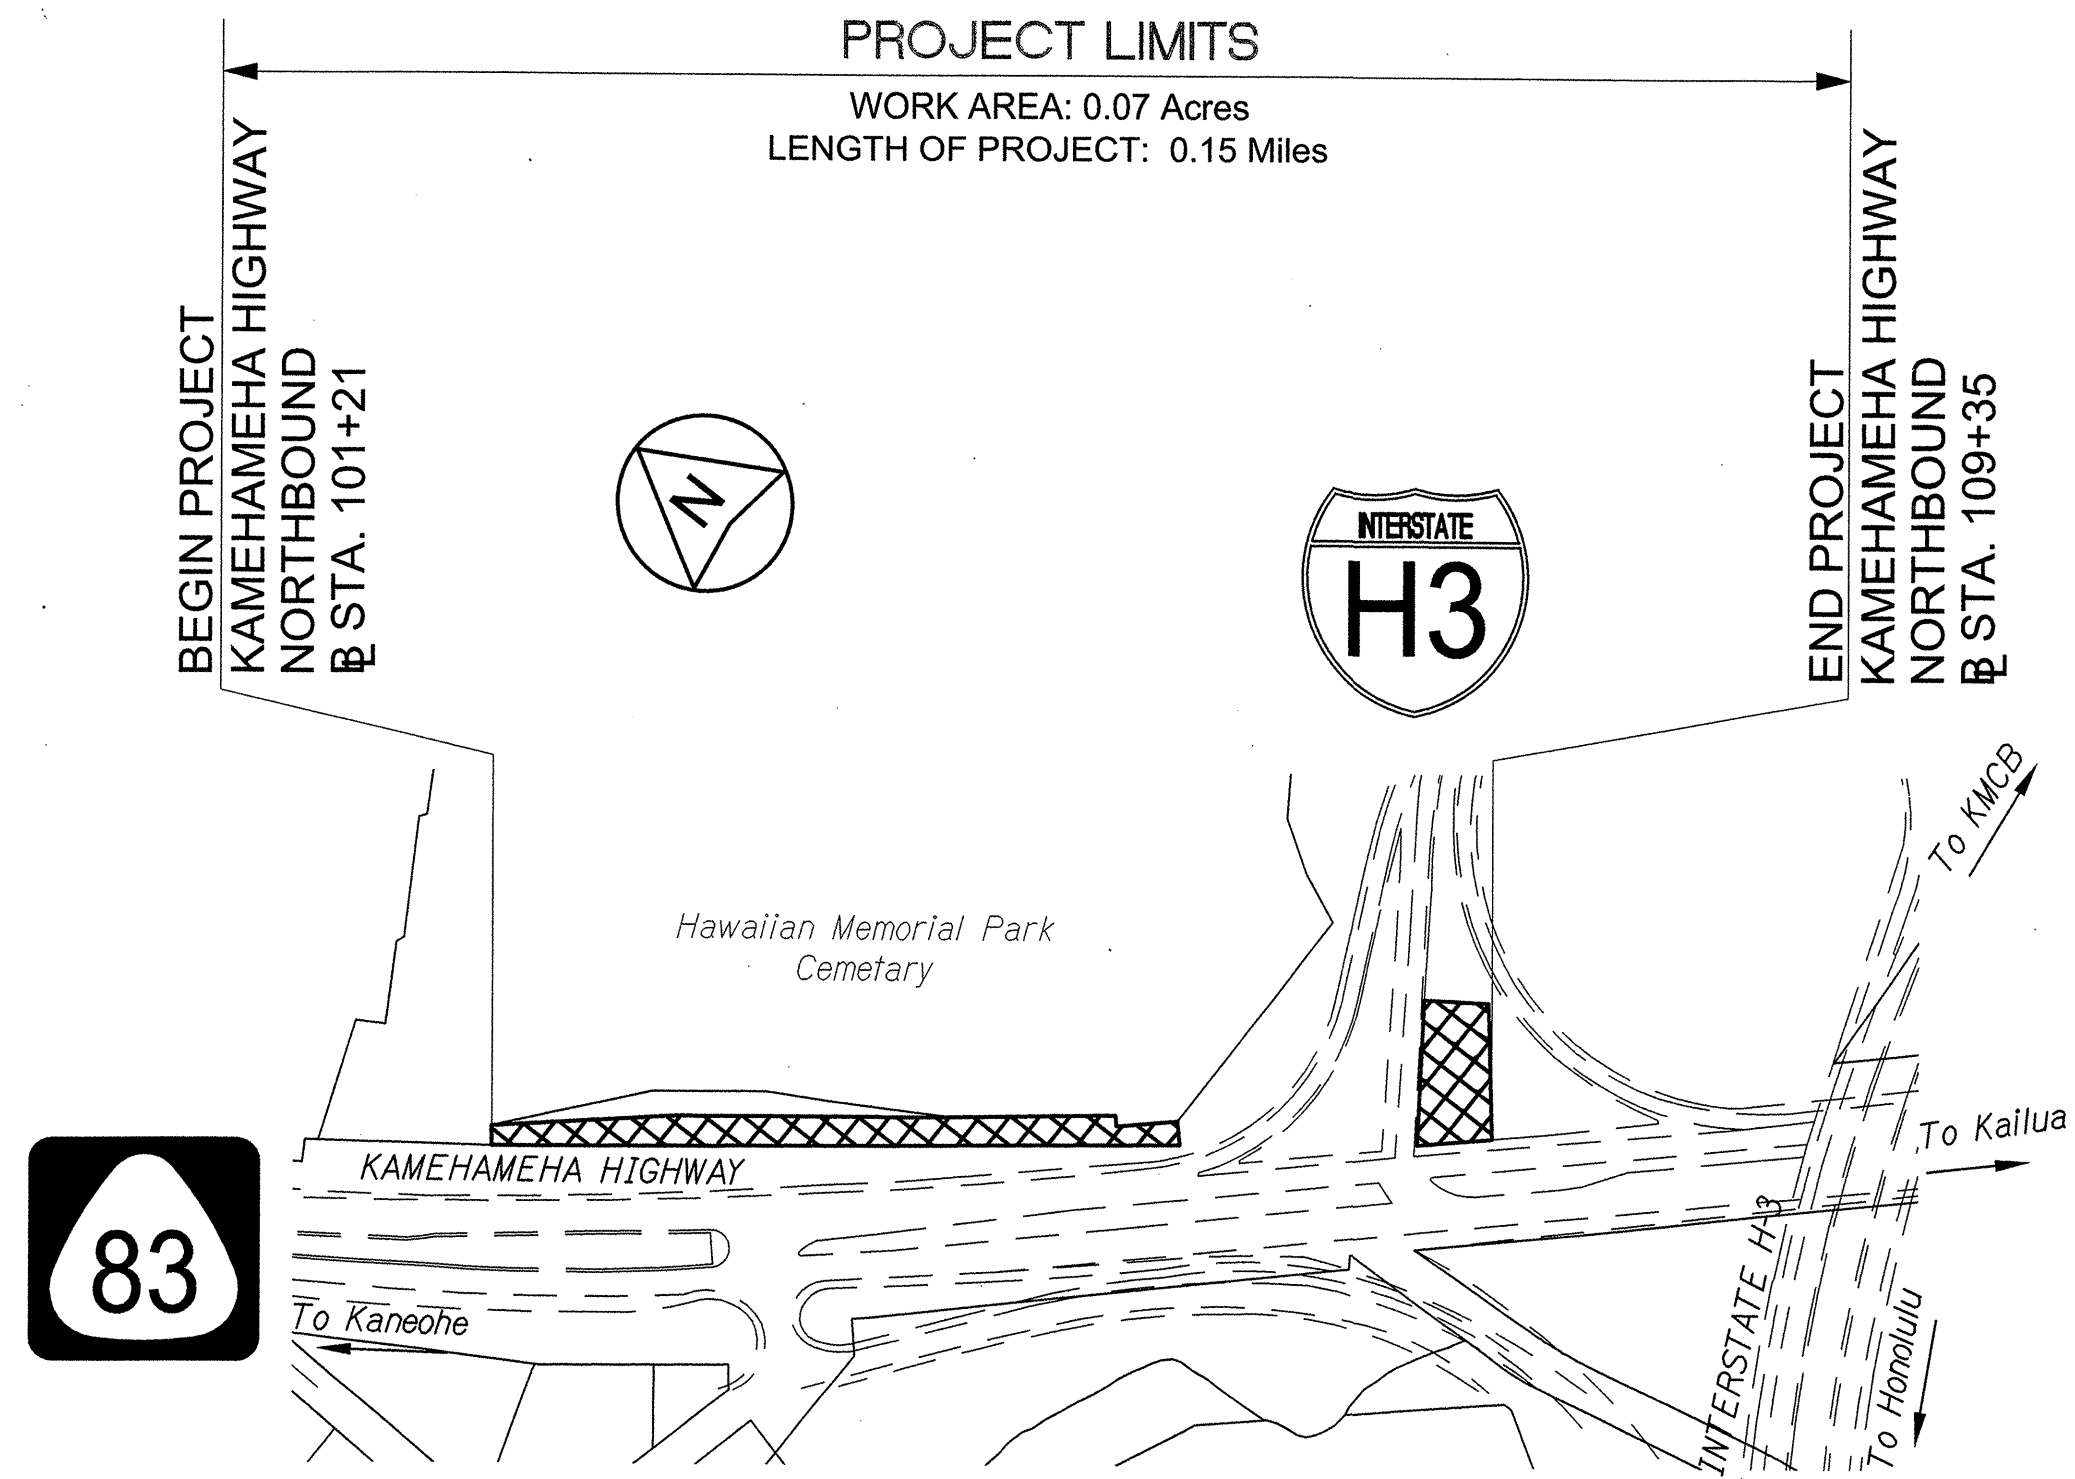

KAMAHEMEHA HIGHWAY 83
LOCATION PLAN - PID 1008
NOT TO SCALE

ORIGINAL PLAN	SURVEY PLOTTED BY	DATE
NOTE BOOK	DESIGNED BY	
	QUANTITIES BY	
	CHECKED BY	

01 LOCATION PLAN.DWG 3/3/2014 10:46:00 AM

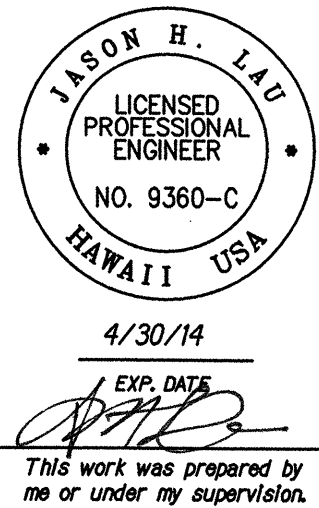

STATE OF HAWAII
DEPARTMENT OF TRANSPORTATION
HIGHWAYS DIVISION

LOCATION PLAN

Kaneohe Watershed Storm Water
Best Management Practices on Oahu
Project No. HWY-O-04-14M
Scale: Not to Scale Date: March 2014

SHEET No. G-03 OF 3 SHEETS