INDEX TO DRAWINGS					
SHEET NO.	DESCRIPTION				
1	TITLE SHEET				
2	STANDARD PLANS SUMMARY				
3-4	LOCATION PLANS				
5	GENERAL NOTES, LEGEND AND ABBREVIATIONS				
6	CONSTRUCTION NOTES				
7-9	UTILITY NOTES				
10-13	WATER POLLUTION AND EROSION CONTROL NOTES AND DETAILS				
14	STRUCTURAL NOTES				
15-24	TYPICAL DETAILS				
25-26	-26 GENERAL SITE PLAN				
27-44	TEMPORARY EROSION CONTROL AND PERMANENT BMP PLANS, PROFILES AND DETAILS				
45	SOIL BORING LOGS				
46-55	LANDSCAPING NOTES, PLANS, DETAILS AND PLANT LISTS				
56-59	TRAFFIC CONTROL NOTES, DETAILS AND LEGEND				
60-67	TRAFFIC CONTROL PLANS				

MARCH 2014 DATE

483-2569 PHONE

HWY-O MANAGED E

LIMTIACO CONSULTING GROU DESIGNED BY

Waialua

Y

Maili

Nanakuli

Barbers

Point

Waianae

Makaha

STATE OF HAWAII

DEPARTMENT OF TRANSPORTATION

HIGHWAYS DIVISION HONOLULU, HAWAII

PLANS FOR

KANEOHE WATERSHED STORM WATER BEST MANAGEMENT PRACTICES ON OAHU

PROJECT NO. HWY-O-04-14M

DISTRICT OF KOOLAUPOKO ISLAND OF OAHU

 $\langle 5 \rangle \langle 6 \rangle$

Waimanalo

Koko Head

Hauula

0

Pearl City

Pearl Harbor

YHYI A W A

Wahiawa ~ -

Punaluu


Waikane


Waiahole

Diamond Head

FED. ROAD DIST. NO.	STATE	PROJ. NO.	FISCAL YEAR	SHEET NO.	TOTAL SHEETS
HAWAII	HAW.	HWY-O-04-14M	2014	1	67



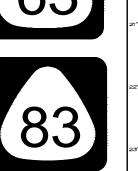

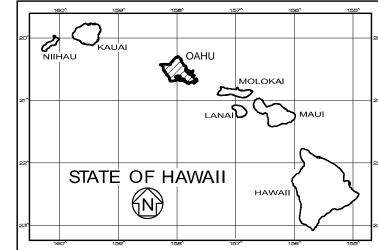



CHANGES MADE DURING CONSTRUCTION HAVE BEEN INCORPORATED ON THESE PLANS EXCEPT CHANGES IN THE ORIGINAL THEORETICAL QUANTITIES. FOR ACTUAL QUANTITIES, REFER TO PROJECT LEDGER AND/OR COMPUTATION BOOK.

Jul 27, 2021

RESIDENT ENGINEER

DATE

PROJECT SITES

INTERCHANGE LIKELIKE HIGHWAY 63 BEGIN MILEPOST: 7.50 **END MILEPOST: 7.55**

BEGIN MILEPOST: 10.90 END MILEPOST: 10.94

LOCATION PLAN - PID 207 INTERSTATE ROUTE H-3 BEGIN MILEPOST: 11.84 END MILEPOST: 12.05

LOCATION PLAN - PID 210 **INTERSTATE ROUTE H-3 BEGIN MILEPOST: 11.87 END MILEPOST: 12.08**

LOCATION PLAN - PID 208 INTERSTATE ROUTE H-3 BEGIN MILEPOST: 11.00 END MILEPOST: 11.06

LOCATION PLAN - PID 1008 KAMEHAMEHA HIGHWAY 83 BEGIN MILEPOST: 42.80 END MILEPOST: 42.89

LEGEND FOR AS-BUILT POSTINGS ~~~ 100.00 Double line for as-built deletion Roadway Text for as-built posting

TOTAL SHEET COUNT after "AS BUILT" postings. <u>69</u> Sheets.

Squiggly line for as-built deletion

DEPARTMENT OF TRANSPORTATION STATE OF HAWAII APPROVED: Aum & Talut 3/20/14 DIR. OF TRANSPORTATION