
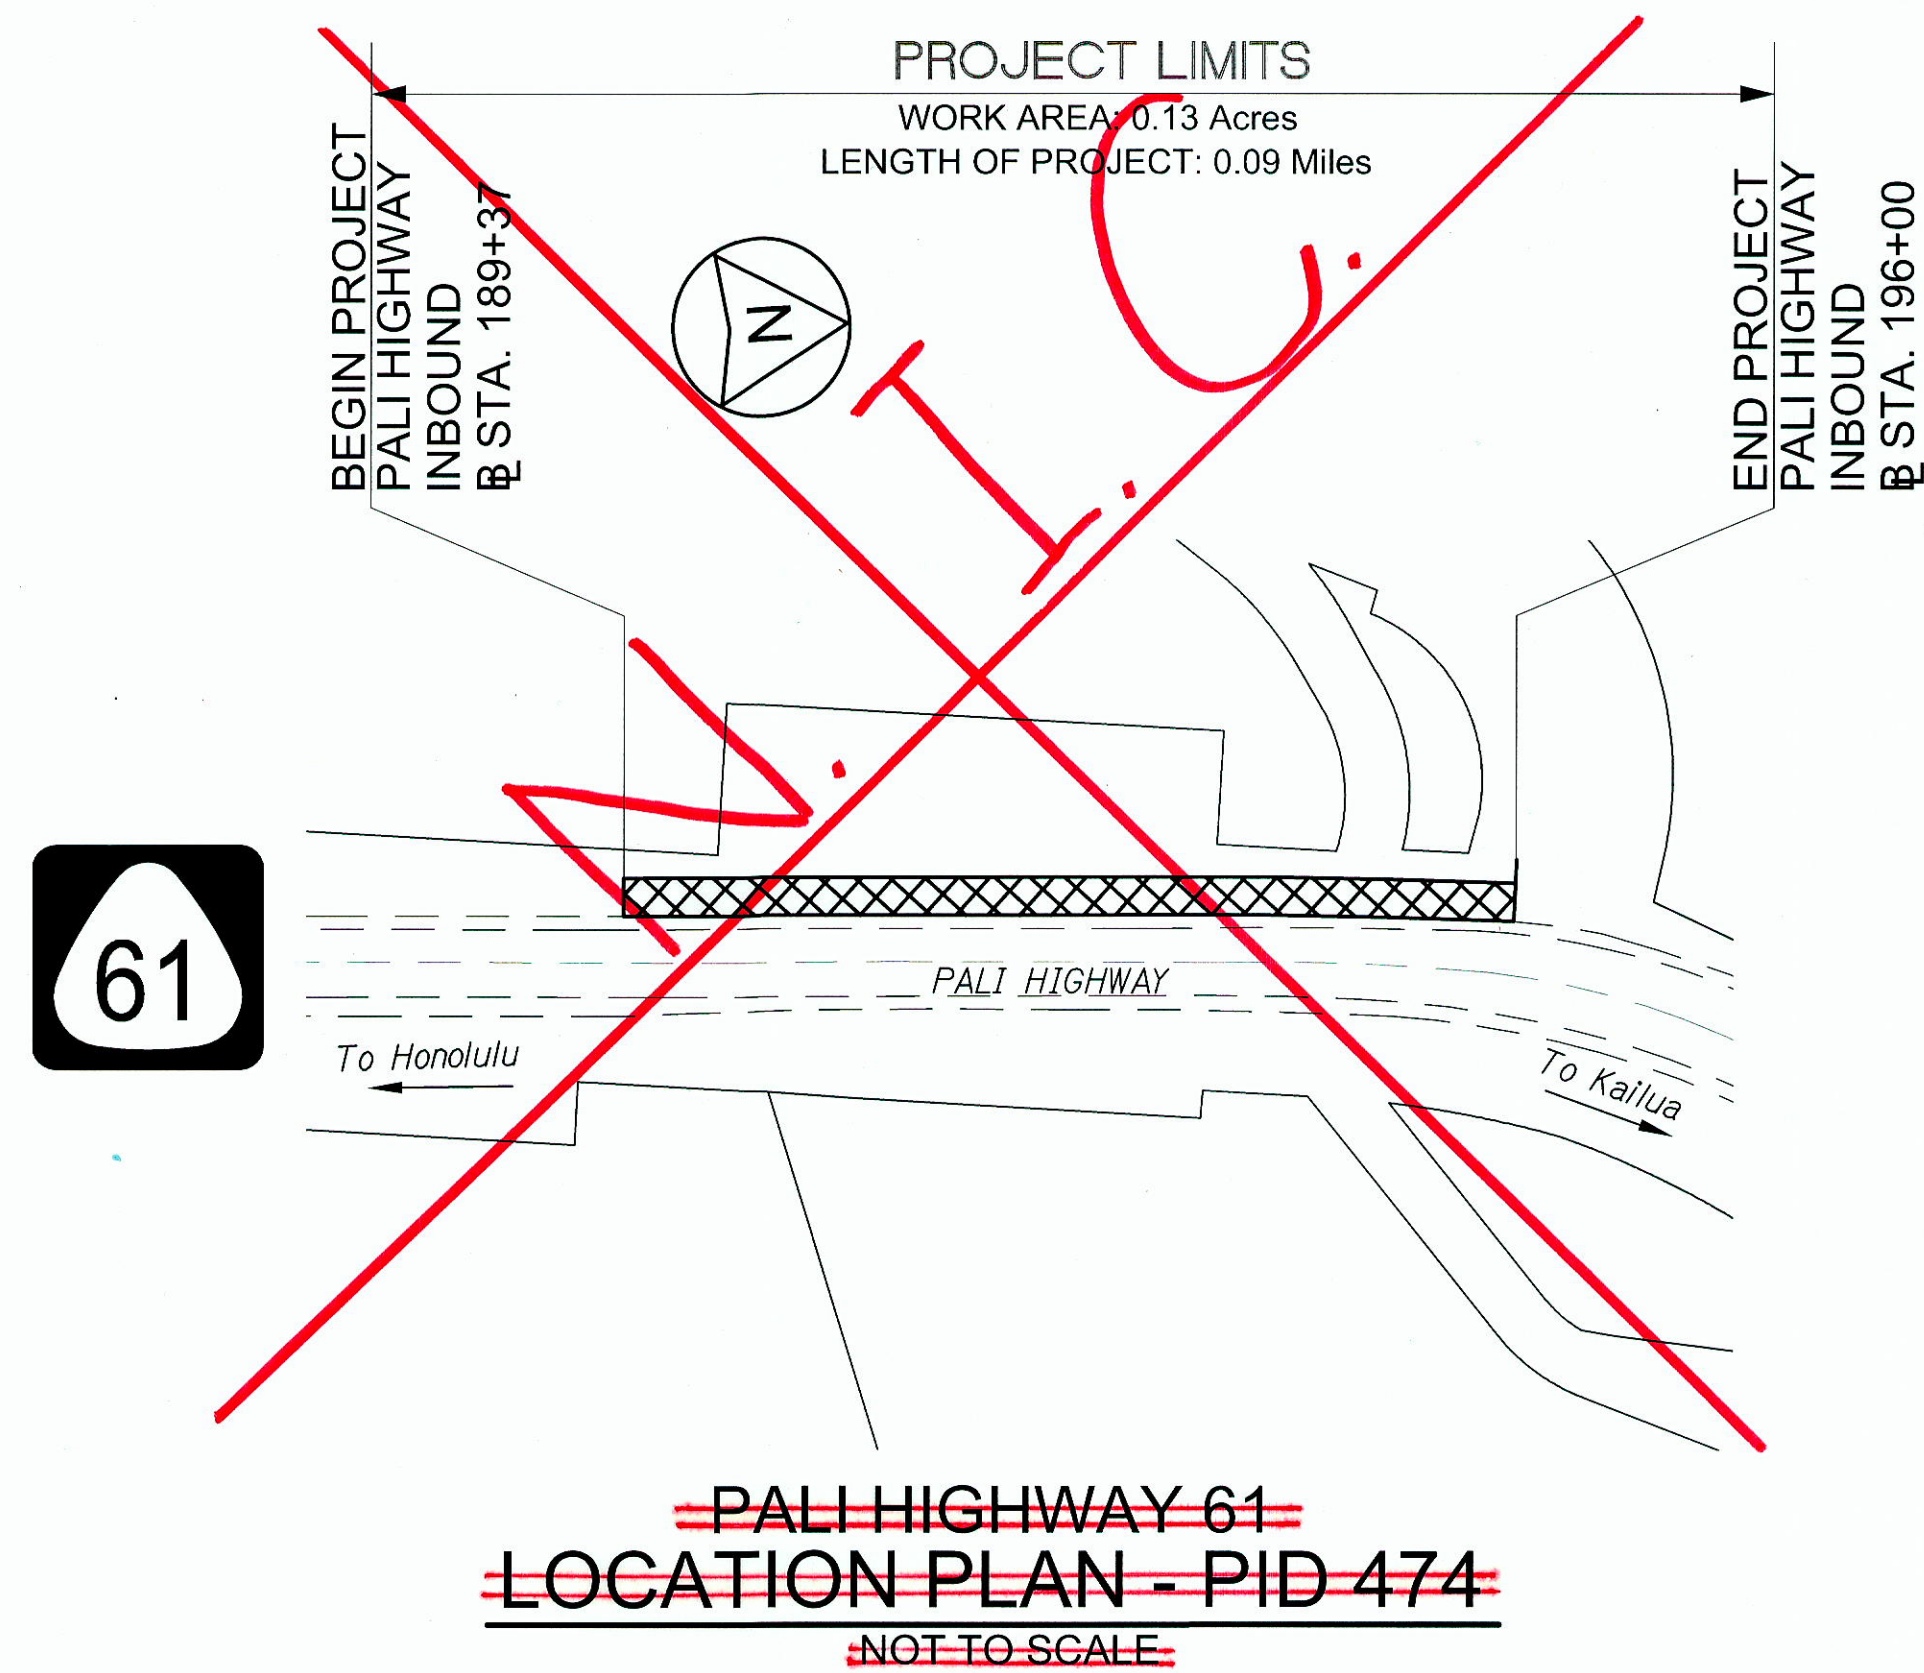


01_LOCATION PLAN.DWG 4/24/2013 2:33:08 PM

FED. ROAD DIST. NO.	STATE	PROJ. NO.	FISCAL YEAR	SHEET NO.	TOTAL SHEETS
HAWAII	HAW.	HWY-O-07-14M	2014	4	51

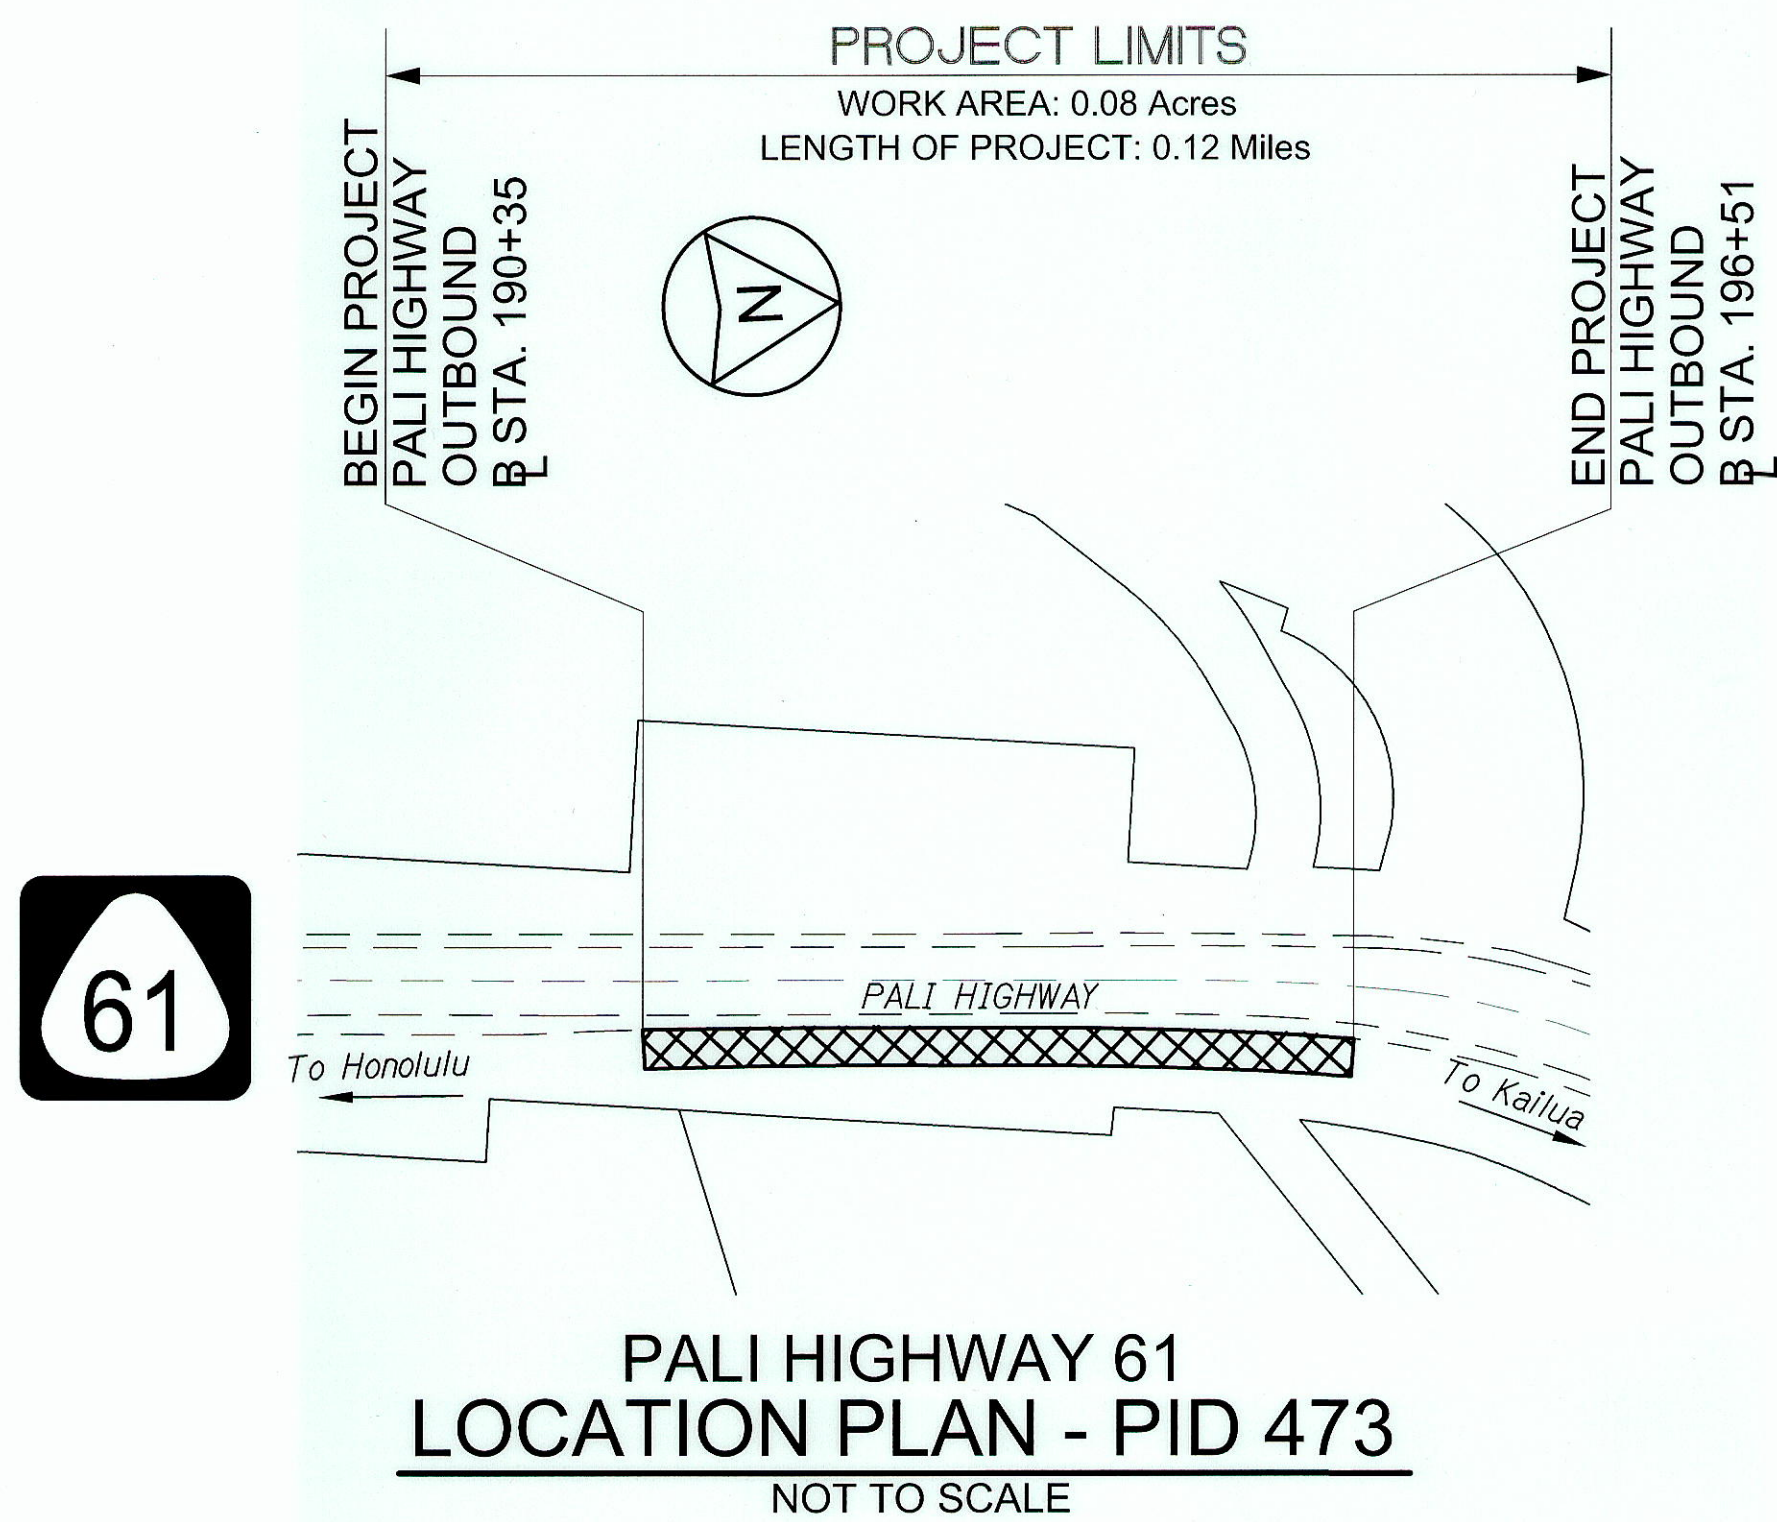

ORIGINAL PLAN	SURVEY PLOTTED BY	DATE
DESIGNED BY		
NOTED BY		
CHECKED BY		

01 LOCATION PLAN.DWG 4/24/2013 2:50:58 PM

4/30/16
EXP. DATE

Jason H. Lau
This work was prepared by me or under my supervision.

STATE OF HAWAII
DEPARTMENT OF TRANSPORTATION
HIGHWAYS DIVISION

LOCATION PLAN

KAWAINUI WATERSHED STORM WATER
BEST MANAGEMENT PRACTICES ON OAHU
Project No. HWY-O-07-14M
Scale: Not to Scale Date: April 2014

"AS-BUILT"