INDEX TO DRAWINGS	
SHEET NO.	DESCRIPTION
1	TITLE SHEET
2	STANDARD PLANS SUMMARY
3-4	LOCATION PLANS
5	GENERAL NOTES, LEGEND AND ABBREVIATIONS
6	CONSTRUCTION NOTES
7-9	UTILITY NOTES
10-13	WATER POLLUTION AND EROSION CONTROL NOTES AND DETAILS
14-15	STRUCTURAL NOTES
16-21	TYPICAL DETAILS
22-24	GENERAL SITE PLANS
25-34	TEMPORARY EROSION CONTROL AND PERMANENT BMP PLANS, PROFILES AND DETAILS
35-43	LANDSCAPING NOTES, PLANS, DETAILS AND PLANT LIST
44-47	TRAFFIC CONTROL NOTES, LEGEND AND DETAILS
48-51	TRAFFIC CONTROL PLANS

STATE OF HAWAII

DEPARTMENT OF TRANSPORTATION

HIGHWAYS DIVISION HONOLULU, HAWAII




PLANS FOR


KAWAINUI WATERSHED STORM WATER BEST MANAGEMENT PRACTICES ON OAHU PROJECT NO. HWY-O-07-14M

DISTRICT OF KOOLAUPOKO ISLAND OF OAHU

PROJ. NO. HWY-O-07-14M



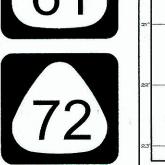

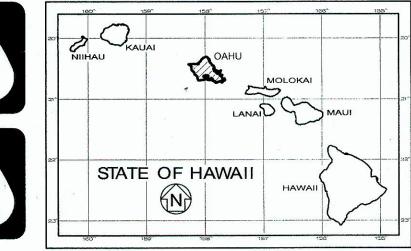




PROJECT SITES

- **LOCATION PLAN PID 125 KALANIANAOLE HIGHWAY 72 BEGIN MILEPOST: 0.85** END MILEPOST: 0.93
- **LOCATION PLAN PID 214 INTERSTATE ROUTE H-3** BEGIN MILEPOST: 13.32 **END MILEPOST: 13.38**
- **LOCATION PLAN PID 215** INTERSTATE ROUTE H-3 BEGIN MILEPOST: 11.60 **END MILEPOST: 11.67**
- **LOCATION PLAN PID 9003 INTERSTATE ROUTE H-3 BEGIN MILEPOST: 12.30 END MILEPOST: 12.39**
- **LOCATION PLAN PID 473** PALI HIGHWAY 61 **BEGIN MILEPOST: 7.51** END MILEPOST: 7.63
- **LOCATION PLAN PID 474** PALI HIGHWAY 61 **BEGIN MILEPOST: 7.51** END MILEPOST: 7.60

ACTUAL CHANTIFIES, REFER TO PROJECT LEDGER

DEPARTMENT OF TRANSPORTATION STATE OF HAWAII APPROVED:

anna. Jalust 4/22/14 for DIR. OF TRANSPORTATION

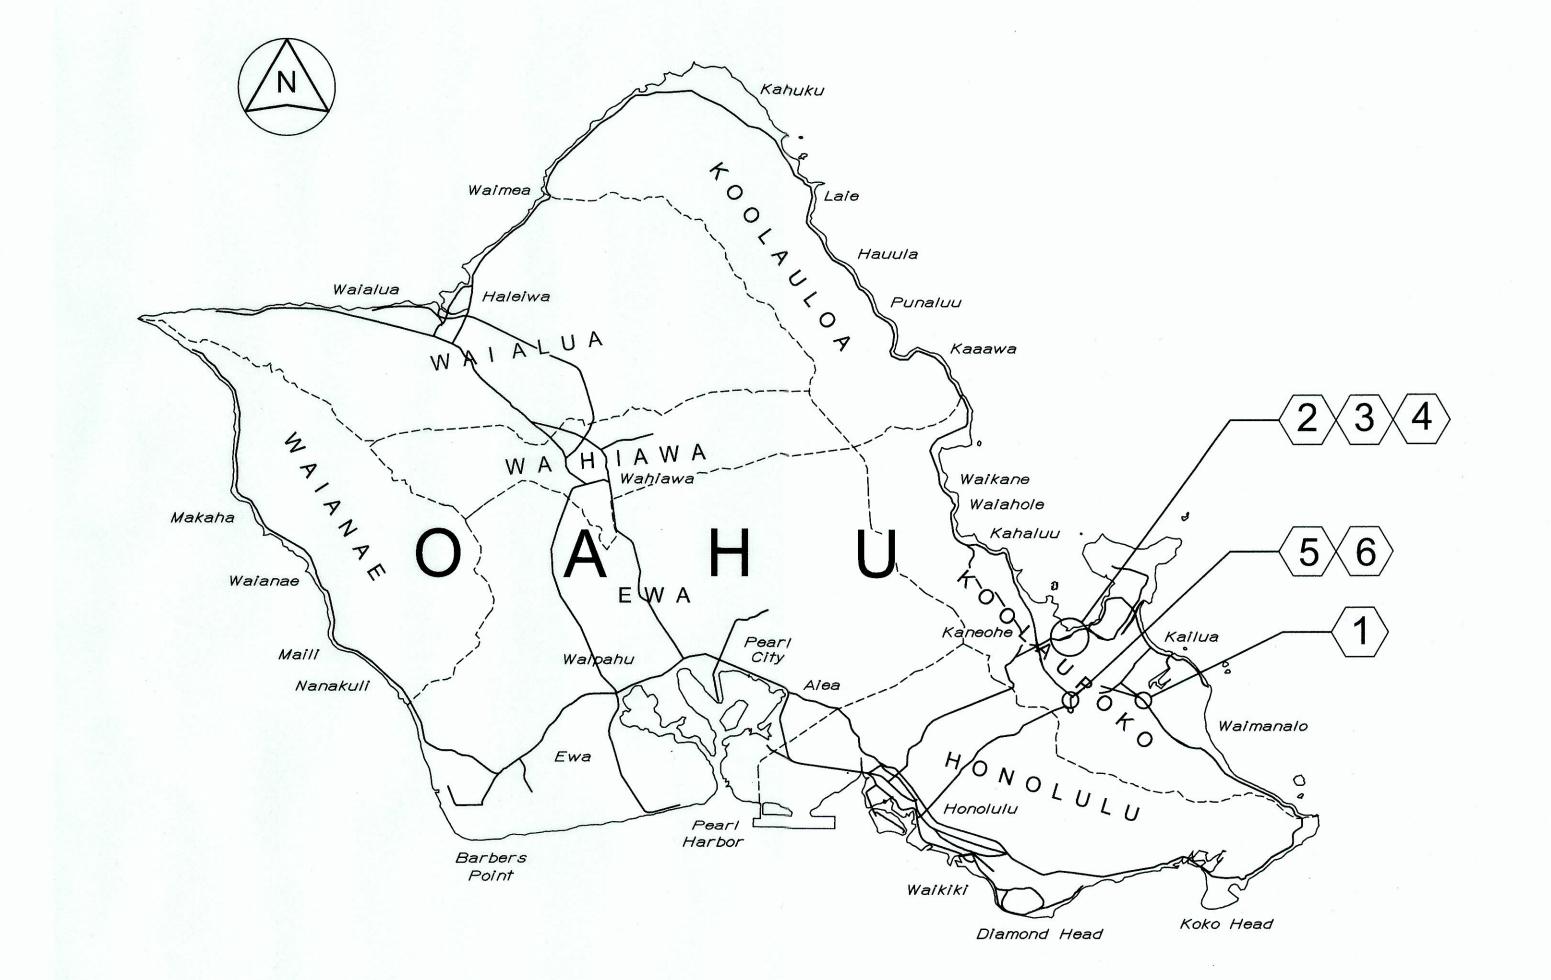

DATE