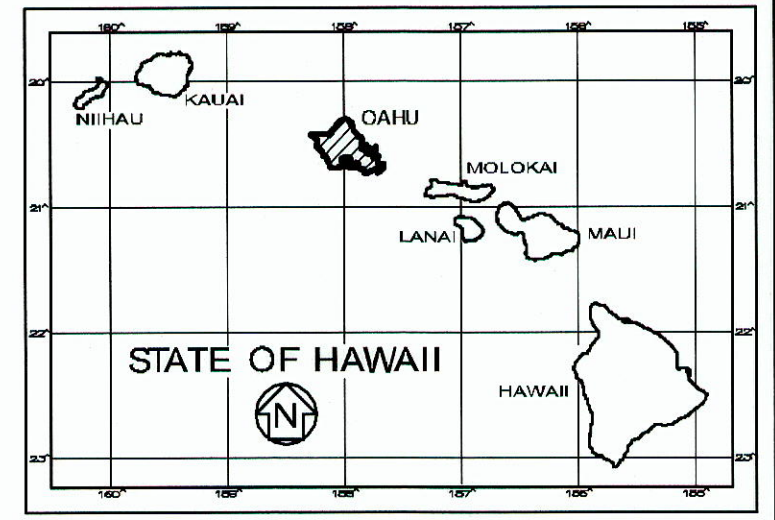


|                                   |               |                 |                 |
|-----------------------------------|---------------|-----------------|-----------------|
| <u>LIIMITACO CONSULTING GROUP</u> | <u>HWY-OW</u> | <u>483-2569</u> | <u>MAY 2015</u> |
| DESIGNED BY                       | MANAGED BY    | PHONE           | DATE            |

[illegible]

- 1 LOCATION PLAN - PID 445  
INTERSTATE ROUTE H-2  
BEGIN MILEPOST: 2.49  
END MILEPOST: 2.60
- 2 LOCATION PLAN - PID 230  
INTERSTATE ROUTE H-2  
BEGIN MILEPOST: 2.49  
END MILEPOST: 2.58
- 3 LOCATION PLAN - PID 241  
INTERSTATE ROUTE H-2  
BEGIN MILEPOST: 2.49  
END MILEPOST: 2.55
- 4 LOCATION PLAN - PID 57  
INTERSTATE ROUTE H-1  
BEGIN MILEPOST: 7.73  
END MILEPOST: 7.82
- 5 LOCATION PLAN - PID 110  
INTERSTATE ROUTE H-1  
BEGIN MILEPOST: 7.28  
END MILEPOST: 7.47
- 6 LOCATION PLAN - PID 907  
INTERSTATE ROUTE 750  
BEGIN MILEPOST: 7.92  
END MILEPOST: 8.05  
INTERSTATE ROUTE 99  
BEGIN MILEPOST: 9.08  
END MILEPOST: 9.10

CHANGES MADE DURING CONSTRUCTION HAVE BEEN INCORPORATED ON THESE PLANS EXCEPT CHANGES IN THE ORIGINAL THEORETICAL QUANTITIES. FOR ACTUAL QUANTITIES, REFER TO PROJECT LEDGER AND/OR COMPLETION BOOK.

8/29/19  
DATE

DEPARTMENT OF TRANSPORTATION  
STATE OF HAWAII

APPROVED: Randy J. McCarroll 5/11/10  
DIR. OF TRANSPORTATION DATE