INDEX TO DRAWINGS	
SHEET NO.	DESCRIPTION
1	TITLE SHEET
2	STANDARD PLANS SUMMARY
3 - 4	LOCATION PLANS
5	GENERAL NOTES, LEGEND AND ABBREVIATIONS
6	CONSTRUCTION NOTES
7 - 9	UTILITY NOTES
10 - 13	WATER POLLUTION AND EROSION CONTROL NOTES
14 - 15	STRUCTURAL NOTES
16 - 17	TYPICAL DETAILS
18 - 46	TEMPORARY EROSION CONTROL AND PERMANENT BMP PLANS AND DETAILS
47 - 57	LANDSCAPING PLANS, DETAILS, AND NOTES
58 - 62	TRAFFIC CONTROL NOTES
63 - 71	TRAFFIC CONTROL PLANS

### STATE OF HAWAII

## DEPARTMENT OF TRANSPORTATION

HIGHWAYS DIVISION HONOLULU, HAWAII

### PLANS FOR

# CENTRAL OAHU BEST MANAGEMENT PRACTICES

ERODED SLOPE REPAIRS, PHASE 2 PROJECT NO. HWY-O-06-15M


DISTRICTS OF EWA AND KOOLAUPOKO ISLAND OF OAHU

### 0 PC. Waialua Punaluu MAY 2015 DATE H I A W A WA Waiahole Makaha Walanae Kaneohe Maili Nanakuli HWY-OW MANAGED BY HONOLULU Barbers Point Waikiki Koko Head $\langle 6 \rangle \langle 7 \rangle$ Diamond Head

# FED. ROAD DIST. NO. STATE PROJ. NO. FISCAL SHEET TOTAL SHEETS HAWAII HAW. HWY-O-06-15M 2015 1 71





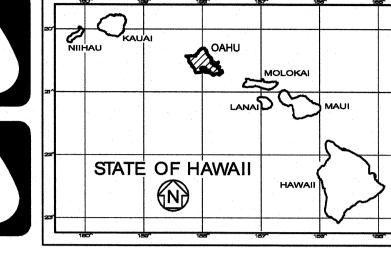



#### PROJECT SITES

- LOCATION PLAN PID 150
  KAMEHAMEHA HIGHWAY
  BEGIN MILEPOST: 14.11
  END MILEPOST: 14.17
- 2 LOCATION PLAN PID 987 INTERSTATE ROUTE H-1 BEGIN MILEPOST: 6.04 END MILEPOST: 6.04
- CATION PLAN PID 988
  INTERSTATE ROUTE H-1
  BEGIN MILEPOST: 6.05
  END MILEPOST: 6.05
- 4 LOCATION PLAN PID 239
  INTERSTATE ROUTE H-2
  BEGIN MILEPOST: 2.20
  END MILEPOST: 2.45
- 5 LOCATION PLAN PID 446
  INTERSTATE ROUTE H-2
  BEGIN MILEPOST: 2.37
  END MILEPOST: 2.47

- 6 LOCATION PLAN PID 450, INTERSTATE ROUTE H-1
  BEGIN MILEPOST: 11.29
  END MILEPOST: 11.46
- 7 LOCATION PLAN PID 450B INTERSTATE ROUTE H-1 BEGIN MILEPOST: 11.44 END MILEPOST: 11.46
- 8 LOCATION PLAN PID 224 KALANIANAOLE HIGHWAY BEGIN MILEPOST: 8.05 END MILEPOST: 8.15
- 9 LOCATION PLAN PID 301161 KALANIANAOLE HIGHWAY BEGIN MILEPOST: 0.61 END MILEPOST: 0.61

CHANGES MADE DURING CONSTRUCTION HAVE BEEN INCORPORATED ON THESE PLANS EXCEPT CHANGES IN THE ORIGINAL THEORETICAL QUANTITIES. FOR ACTUAL QUANTITIES, REFER TO PROJECT LEDGER AND/OR COMPUTATION BOOK.

RESIDENT ENGINEER

DATE

DEPARTMENT OF TRANSPORTATION STATE OF HAWAII

APPROVED?

DIR. OF TRANSPORTATION DATE