
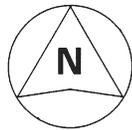


"AS-BUILT"

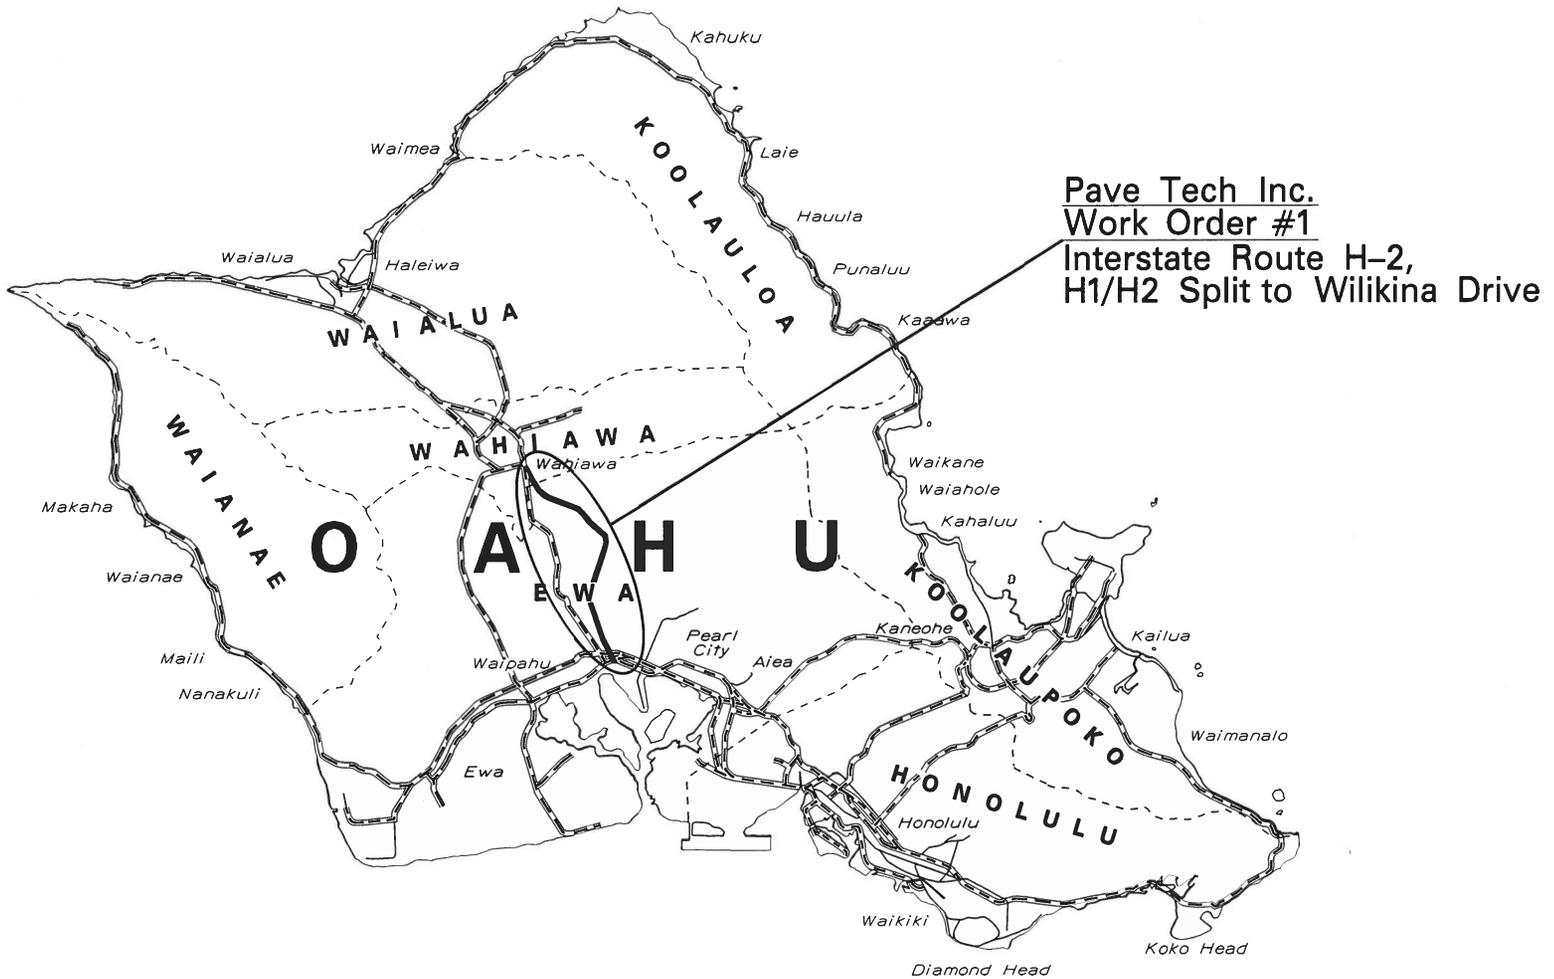

SCALE IN MILES

CHANGES MADE DURING CONSTRUCTION HAVE BEEN NOTED ON THESE PLANS AND CHECKED BY:

Samuel P. Romberg

RESIDENT ENGINEER

9/24/21

DATE

STATE OF HAWAII
DEPARTMENT OF TRANSPORTATION
HIGHWAYS DIVISION
**INSTALLATION OF ENHANCED
PAVEMENT MARKING AND NEW MILLED
RUMBLE STRIP AT VARIOUS LOCATIONS**
Federal-Aid Project No. HSIP-0300(155)

Island of Oahu - 2018