
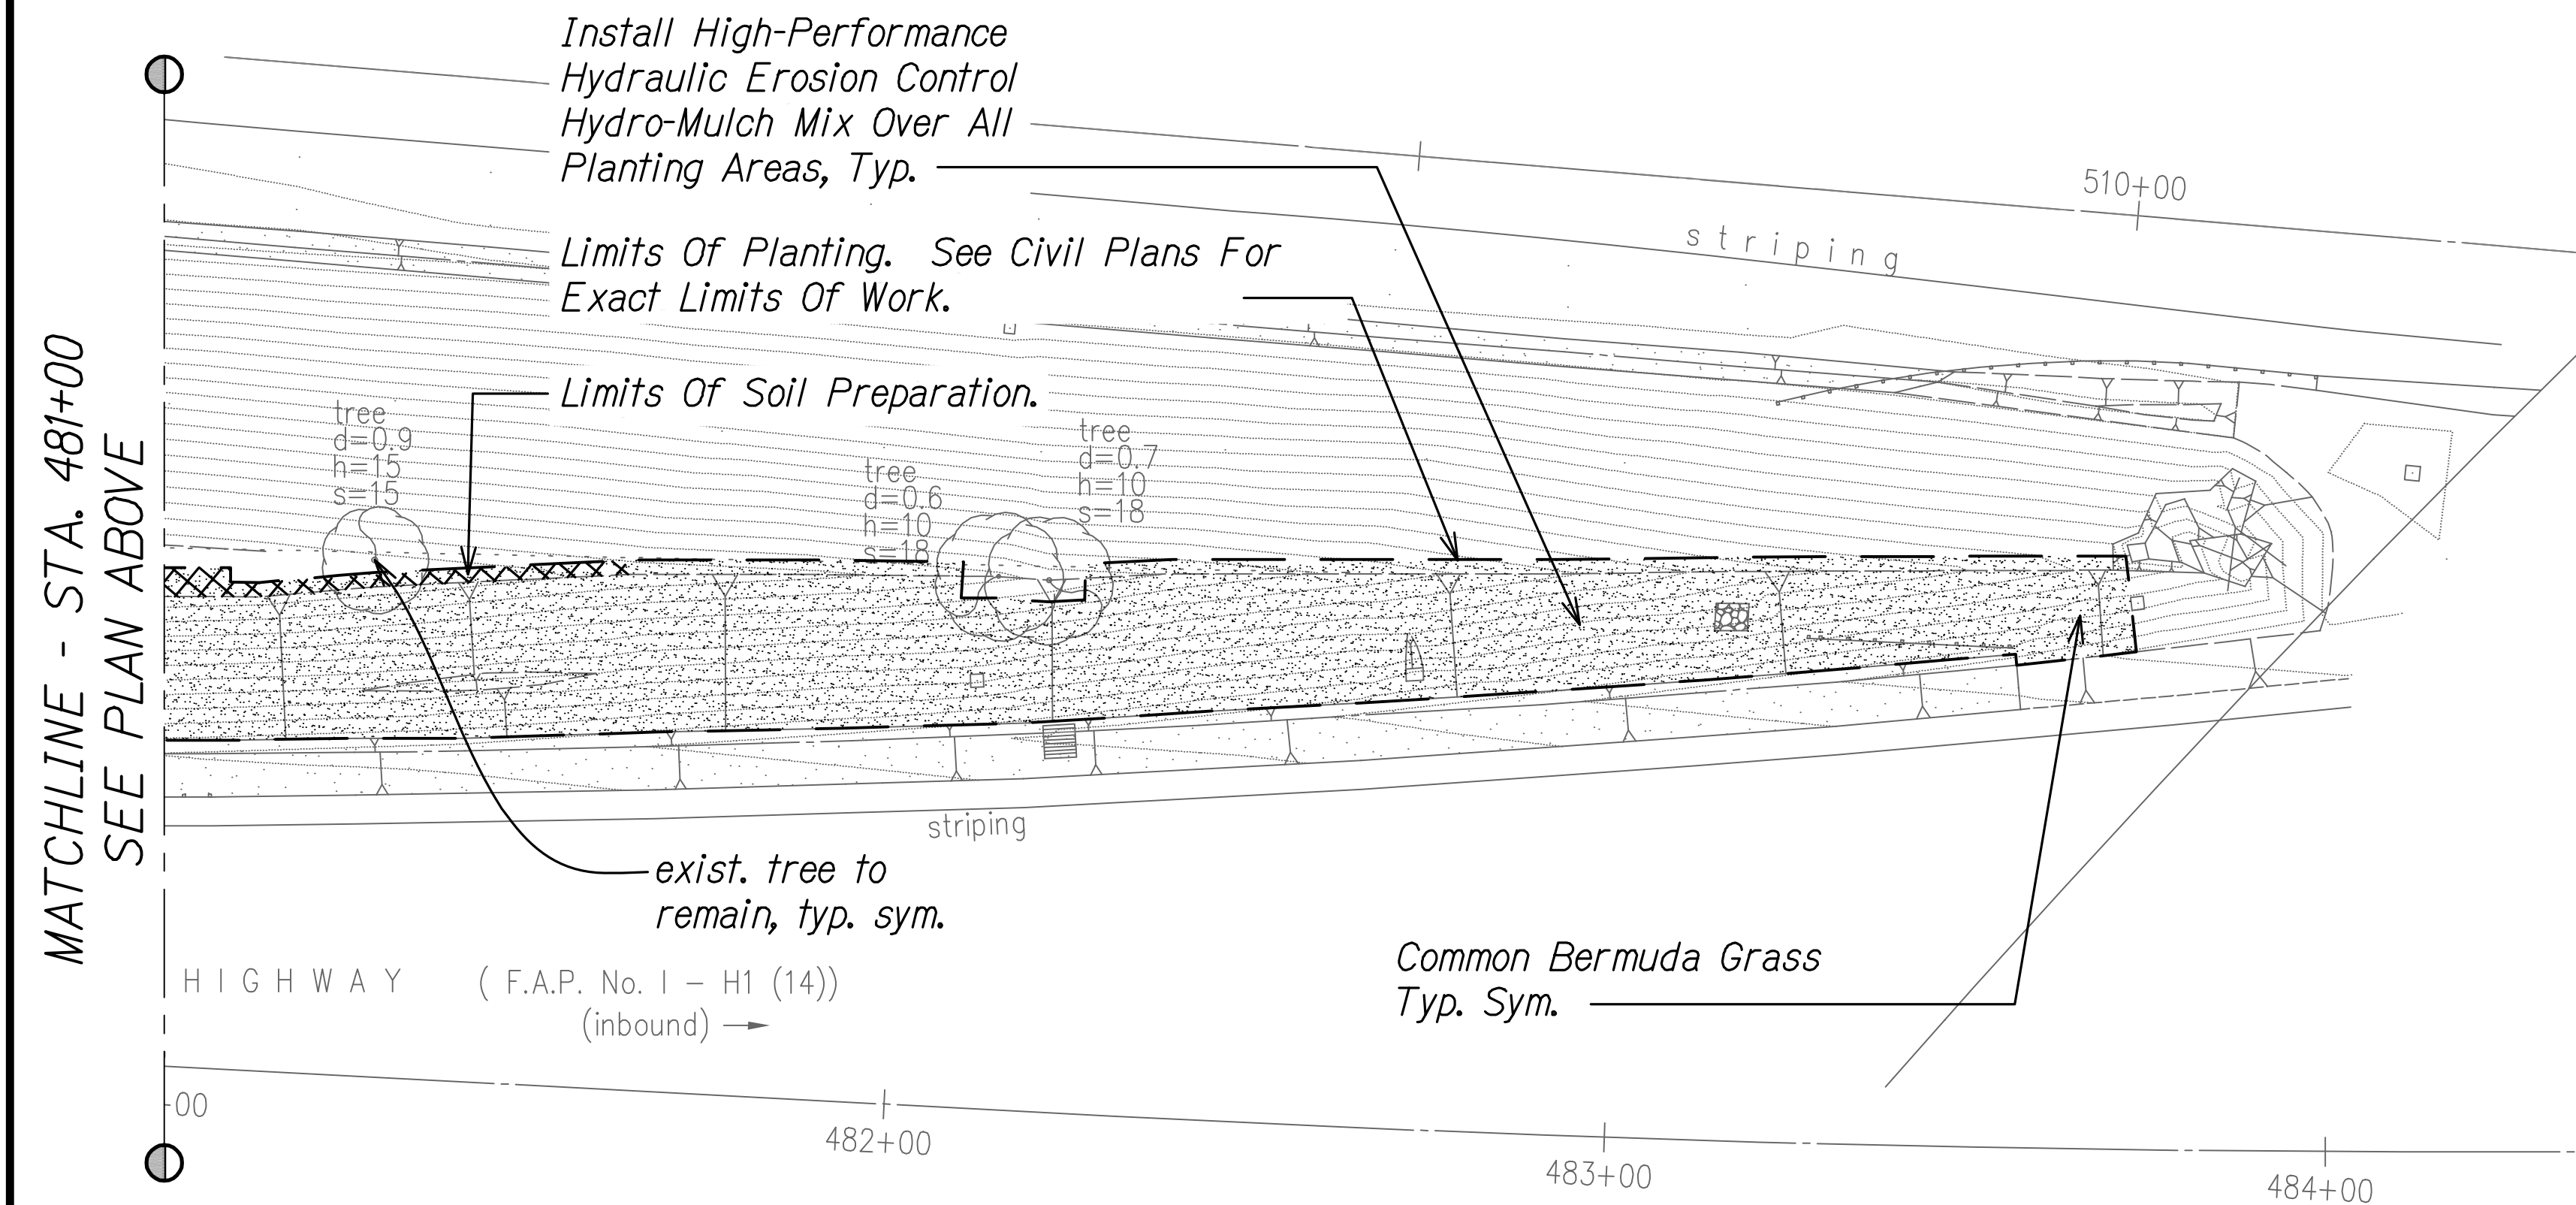


FED. ROAD DIST. NO.	STATE	PROJ. NO.	FISCAL YEAR	SHEET NO.	TOTAL SHEETS
HAWAII	HAW.	HWY-O-02-19	2020	C.O. 37S-1	48

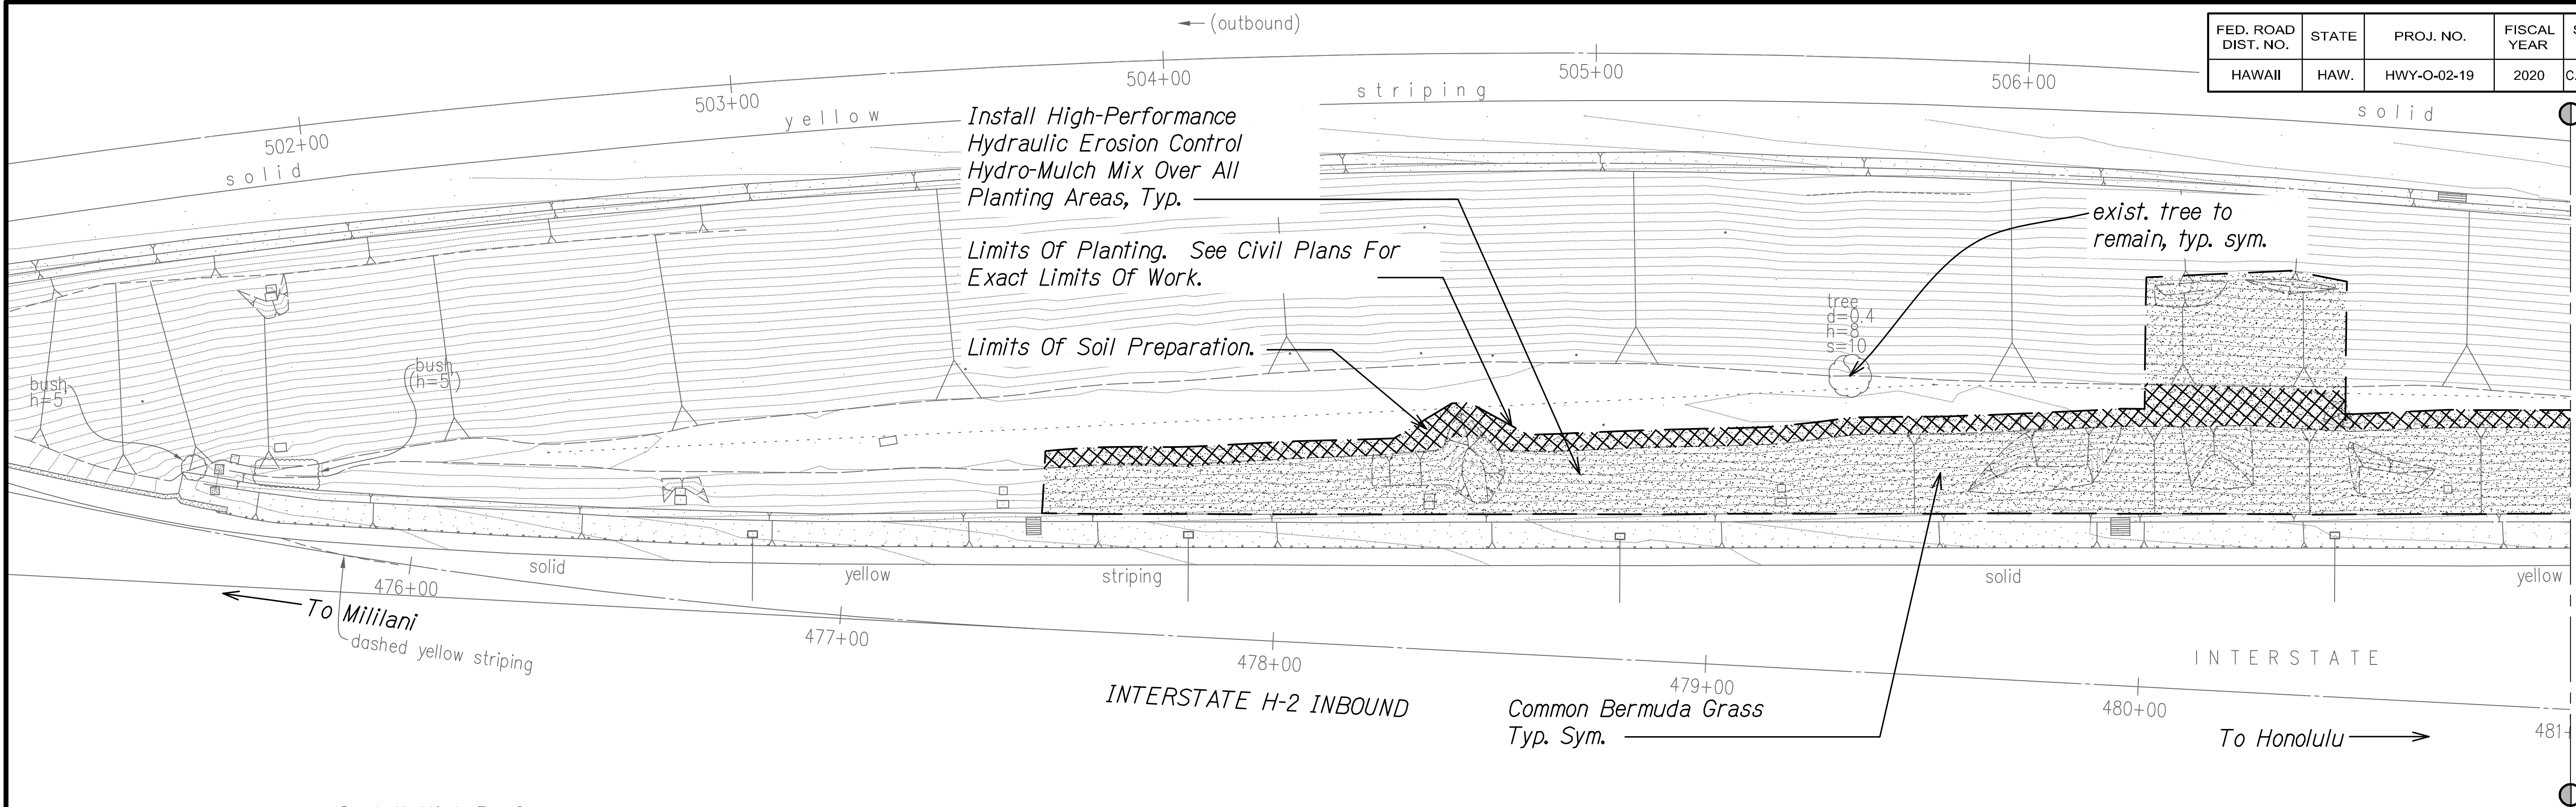

- Notes:**
1. Provide and incorporate soil amendments as recommended by the soil analysis report. Refer to Specification Section 618 - Soil Preparation for soil preparation procedures.
 2. Install high-performance hydraulic erosion control hydro-mulch mix over all planting areas. Refer to Specification Section 209 - Temporary Water Pollution, Dust, And Erosion Control for installation sequence of erosion control matting, hydro-mulch, and plantings.
 3. Contractor shall be responsible for weeding throughout the 9-month plant establishment period. Refer to Specification Section 641 - Hydro-Mulch Seeding.
 4. Refer to Civil drawings for erosion control matting plans and details. Install erosion control matting on disturbed areas per manufacturer's instructions and recommendations.

PLANT SCHEDULE PID 1501

HYDRO-MULCH SEEDING	BOTANICAL NAME	COMMON NAME	CONT
	<i>Cynodon dactylon</i>	Common Bermuda Grass	Seed

LANDSCAPE PLANTING PLAN PID 1501

Scale: 1" = 20'-0"

AS-BUILT DRAWINGS

This certifies that the dimensions and details shown on this sheet reflect the dimensions and details, and specifications as constructed in the field.

KAIKOR CONSTRUCTION COMPANY INC.

Steve Park

DATE: 7/21/2022

RUSSELL Y.J. CHUNG

LICENSED PROFESSIONAL LANDSCAPE ARCHITECT

No. 6076

HAWAII, U.S.A.

4/30/22

EXP. DATE

Russell Chung

This work was prepared by me or under my supervision.

2/19/21	Revised Matting and Planting Limits
DATE	REVISION
STATE OF HAWAII DEPARTMENT OF TRANSPORTATION HIGHWAYS DIVISION LANDSCAPE PLANTING PLAN PID 1501 EROSION CONTROL AND BEST MANAGEMENT PRACTICES FOR STORM WATER PERMIT COMPLIANCE, VARIOUS LOCATIONS ON OAHU Project No. HWY-O-02-19 Scale: 1" = 20'-0" Date: May 2020	
SHEET No. LP-02 OF 5 SHEETS	


"AS-BUILT"

C.O. 37S-1

Notes:

1. Provide and incorporate soil amendments as recommended by the soil analysis report. Refer to Specification Section 617 - Planting Soil for soil preparation procedures.
2. Install hydro-mulch seeding mix over all planting areas. Refer to Specification Section 209 - Temporary Water Pollution, Dust, And Erosion Control for installation sequence of erosion control matting, hydro-mulch, and plantings.
3. Contractor shall be responsible for weeding throughout the 9-month plant establishment period. Refer to Specification Section 641 - Hydro-Mulch Seeding.
4. Refer to Civil drawings for erosion control matting plans and details. Install erosion control matting on disturbed areas per manufacturer's instructions and recommendations.
5. Provide and install 4-inch layer of imported topsoil over all new planting areas.
6. Contractor shall repair damaged areas by re-grading to level condition, filling ruts and depressions with soil if required, and installing hydro-mulch seeding.

FED. ROAD DIST. NO.	STATE	PROJ. NO.	FISCAL YEAR	SHEET NO.	TOTAL SHEETS
HAWAII	HAW.	HWY-O-02-19	2020	38	48

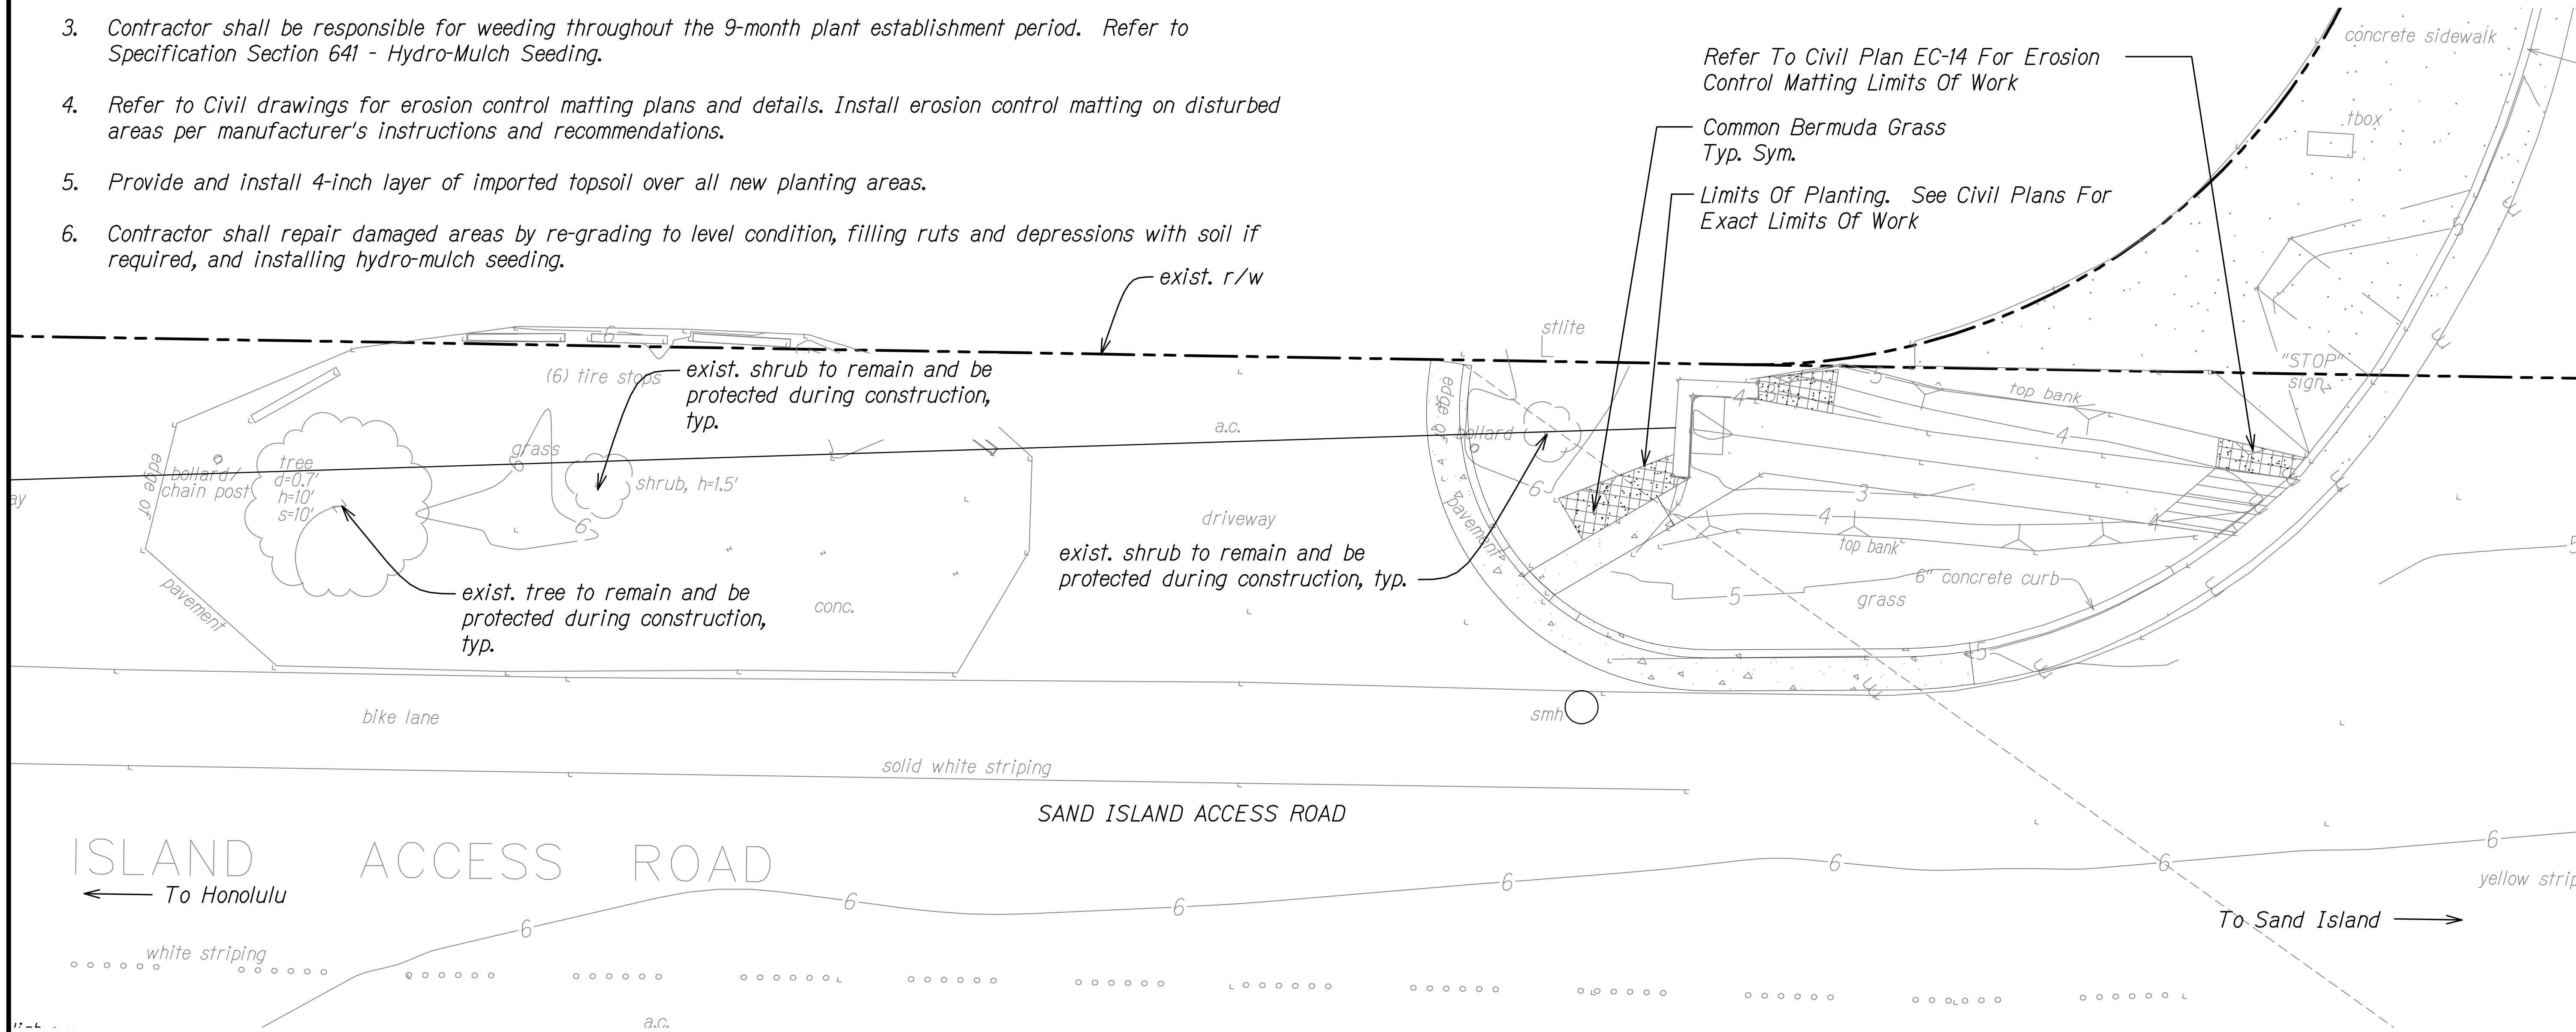

PLANT SCHEDULE PID 467

HYDRO-MULCH
SEEDING



BOTANICAL NAME



Cynodon dactylon

COMMON NAME

Common Bermuda Grass


CONT

Seed

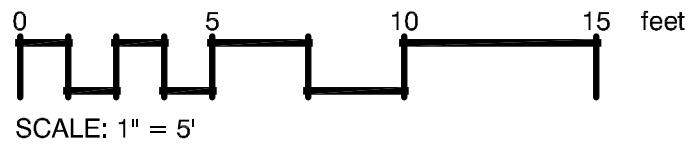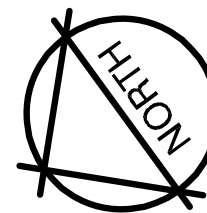

LANDSCAPE PLANTING PLAN PID 467

Scale: 1" = 5'-0"

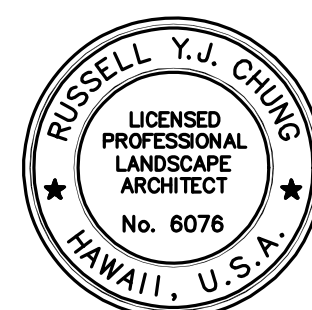

4/30/22
EXP. DATE
Russell Y.J. Chung
This work was prepared by
me or under my supervision.

STATE OF HAWAII
DEPARTMENT OF TRANSPORTATION
HIGHWAYS DIVISION

LANDSCAPE PLANTING PLAN

PID 467

EROSION CONTROL AND BEST MANAGEMENT PRACTICES FOR STORM
WATER PERMIT COMPLIANCE, VARIOUS LOCATIONS ON OAHU


Project No. HWY-O-02-19

Scale: 1" = 5'-0"



Date: May 2020

SHEET No. LP-03 OF 5 SHEETS

FED. ROAD DIST. NO.	STATE	PROJ. NO.	FISCAL YEAR	SHEET NO.	TOTAL SHEETS
HAWAII	HAW.	HWY-O-02-19	2020	39	48

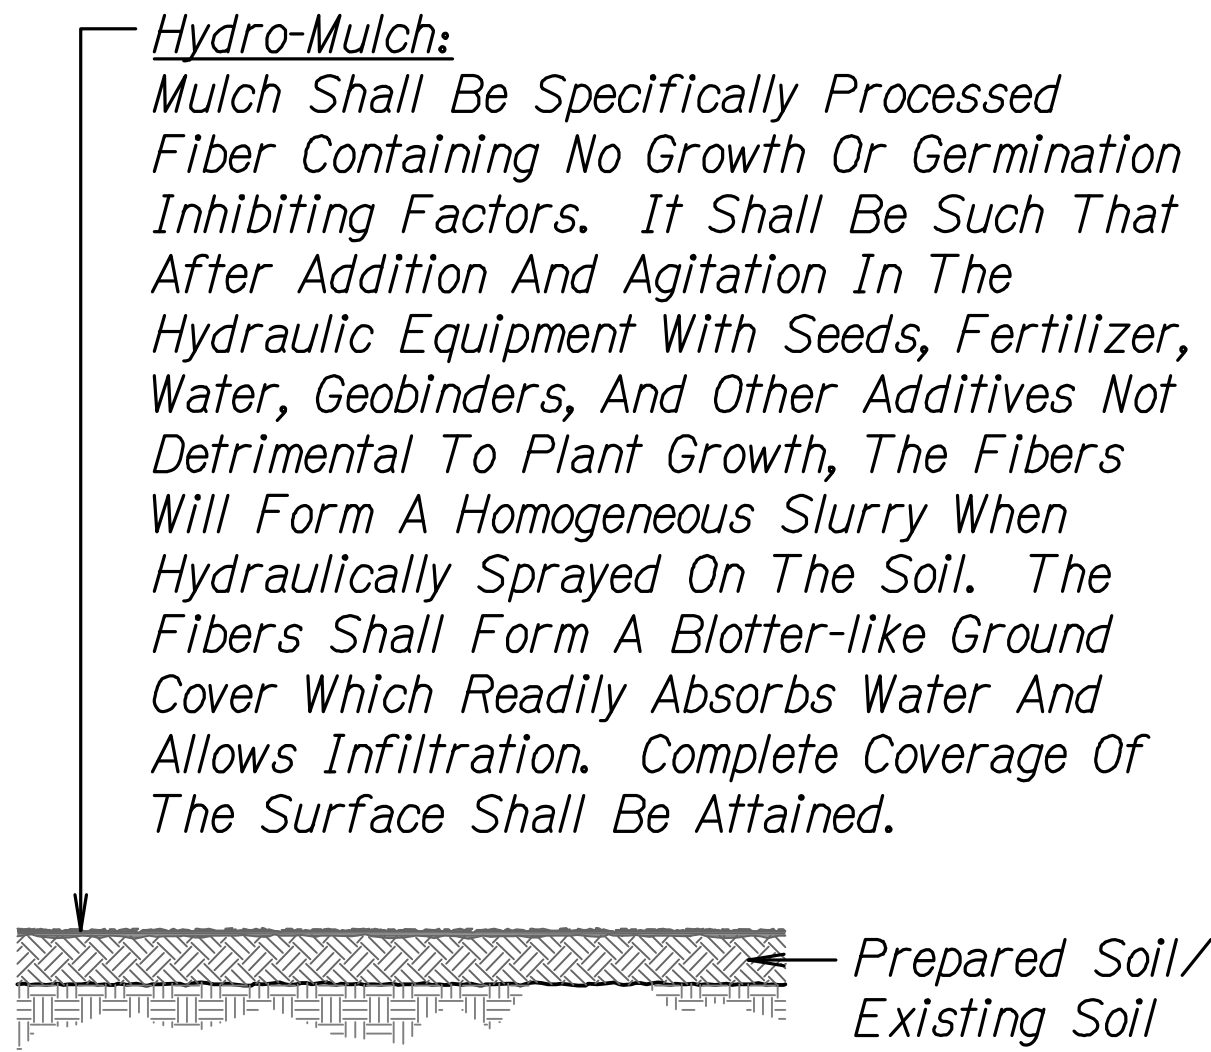

HYDRO-MULCHING DETAIL
Scale: Not to Scale

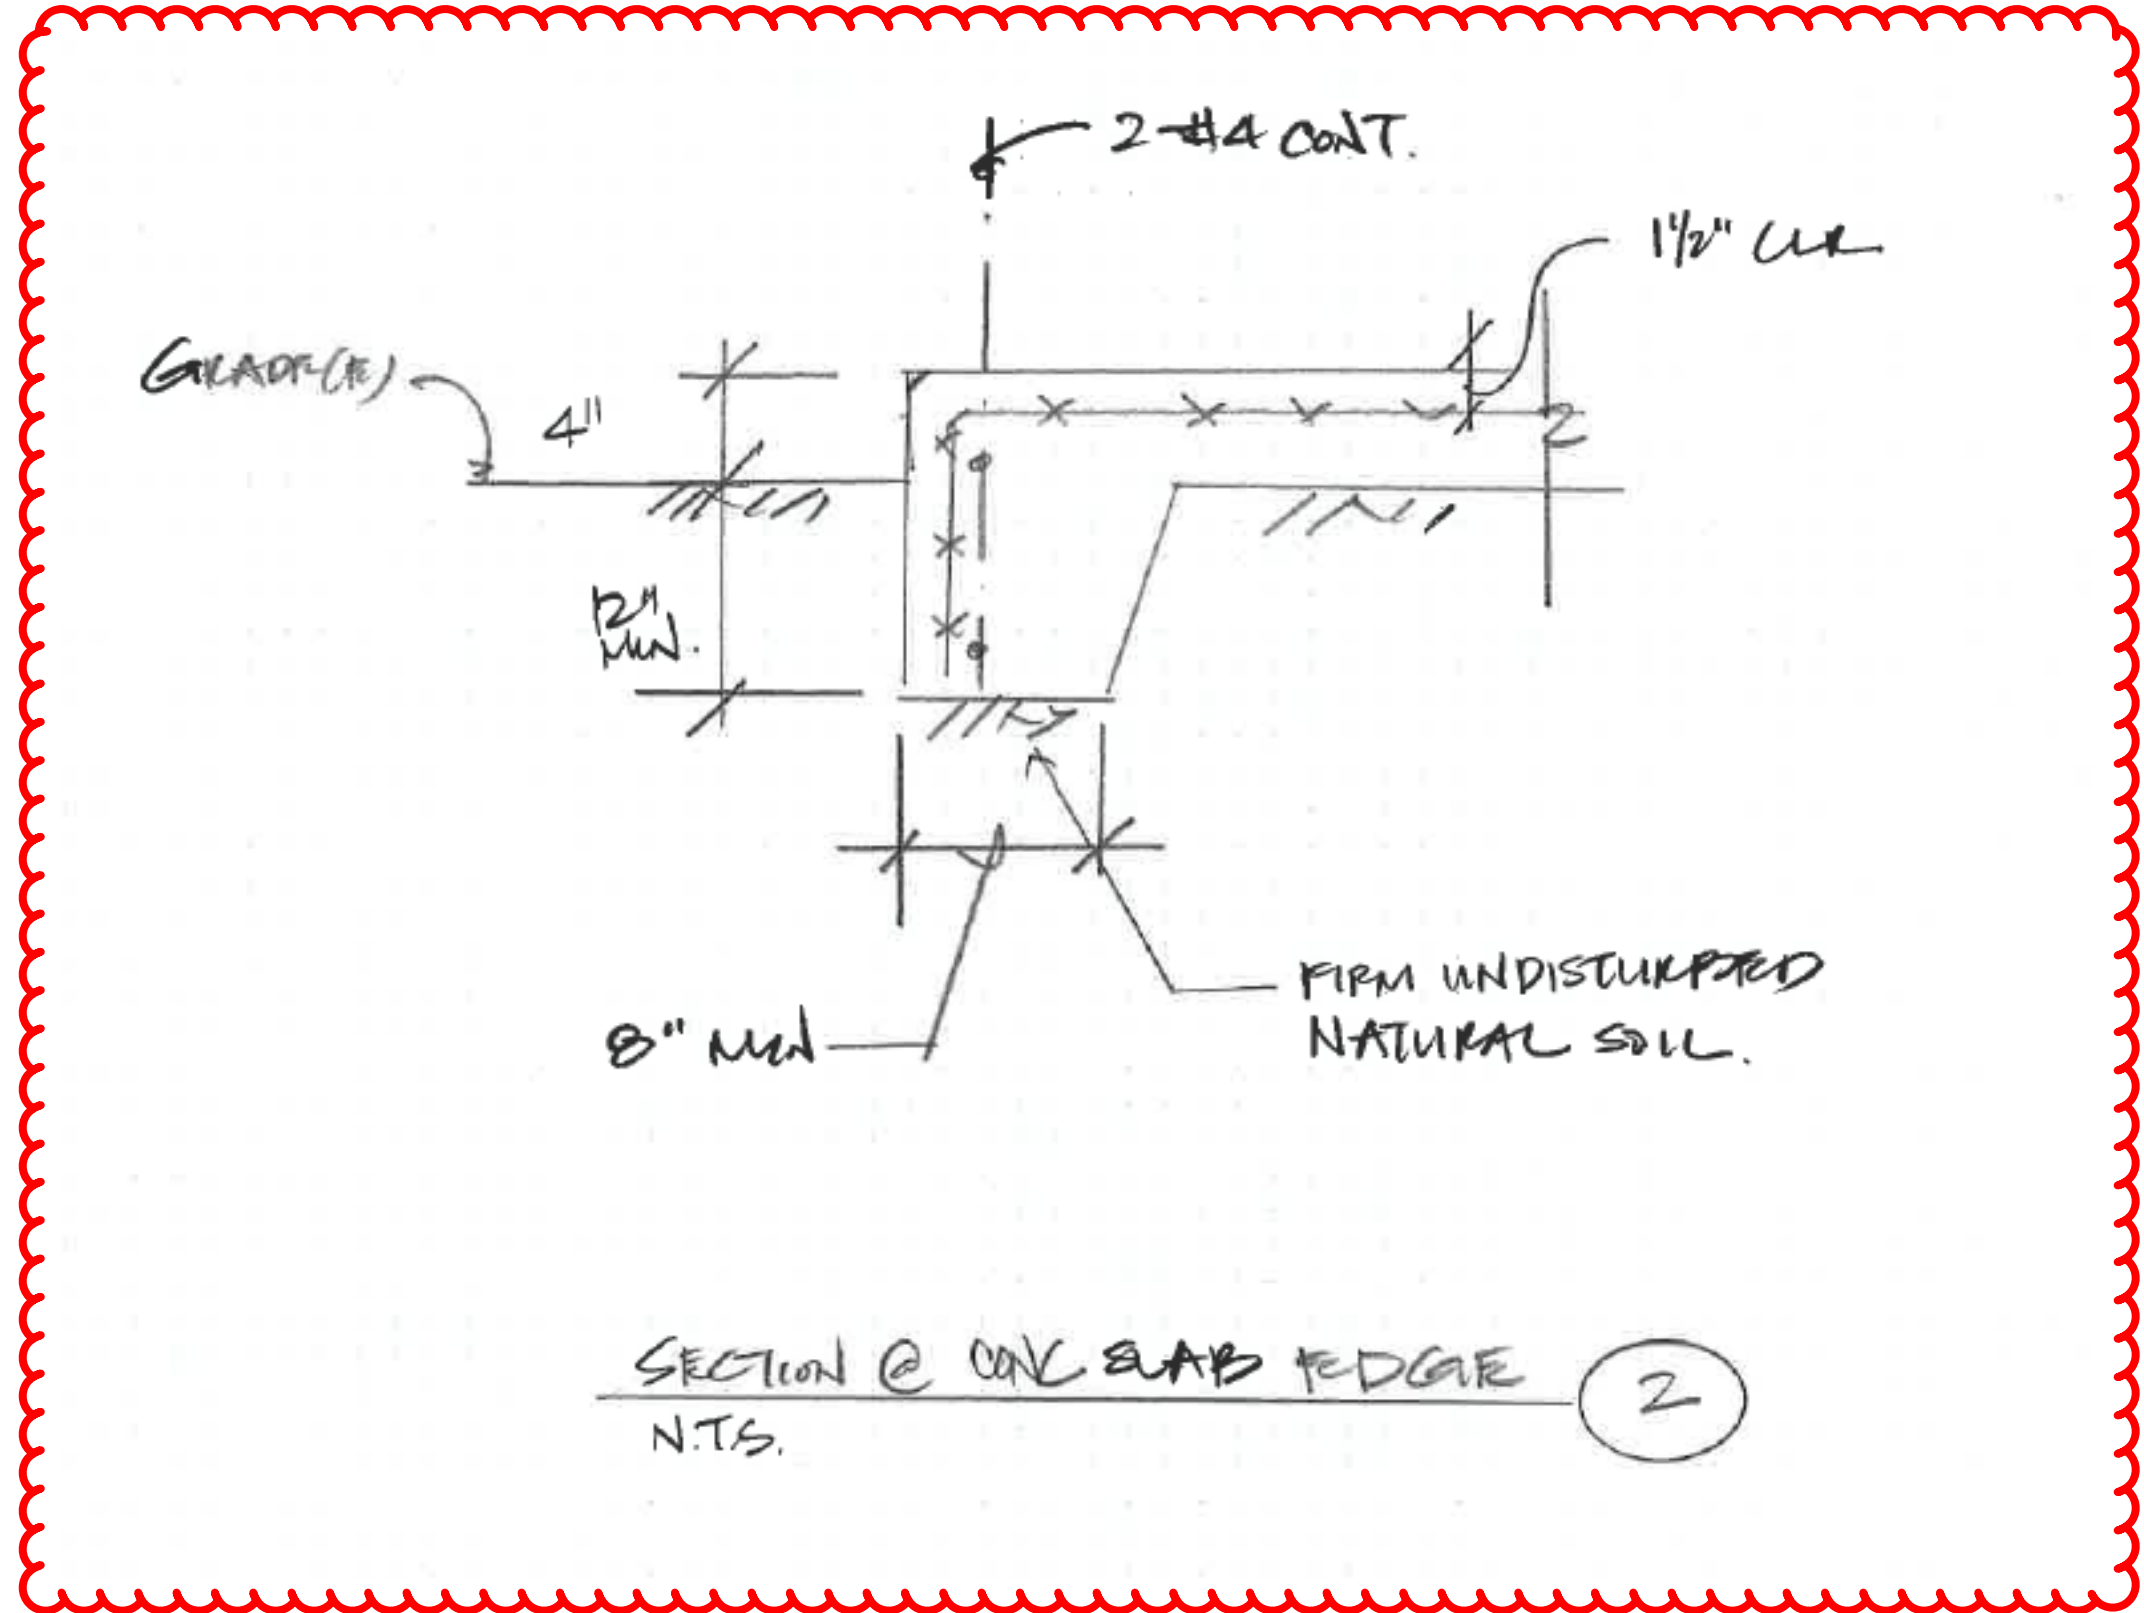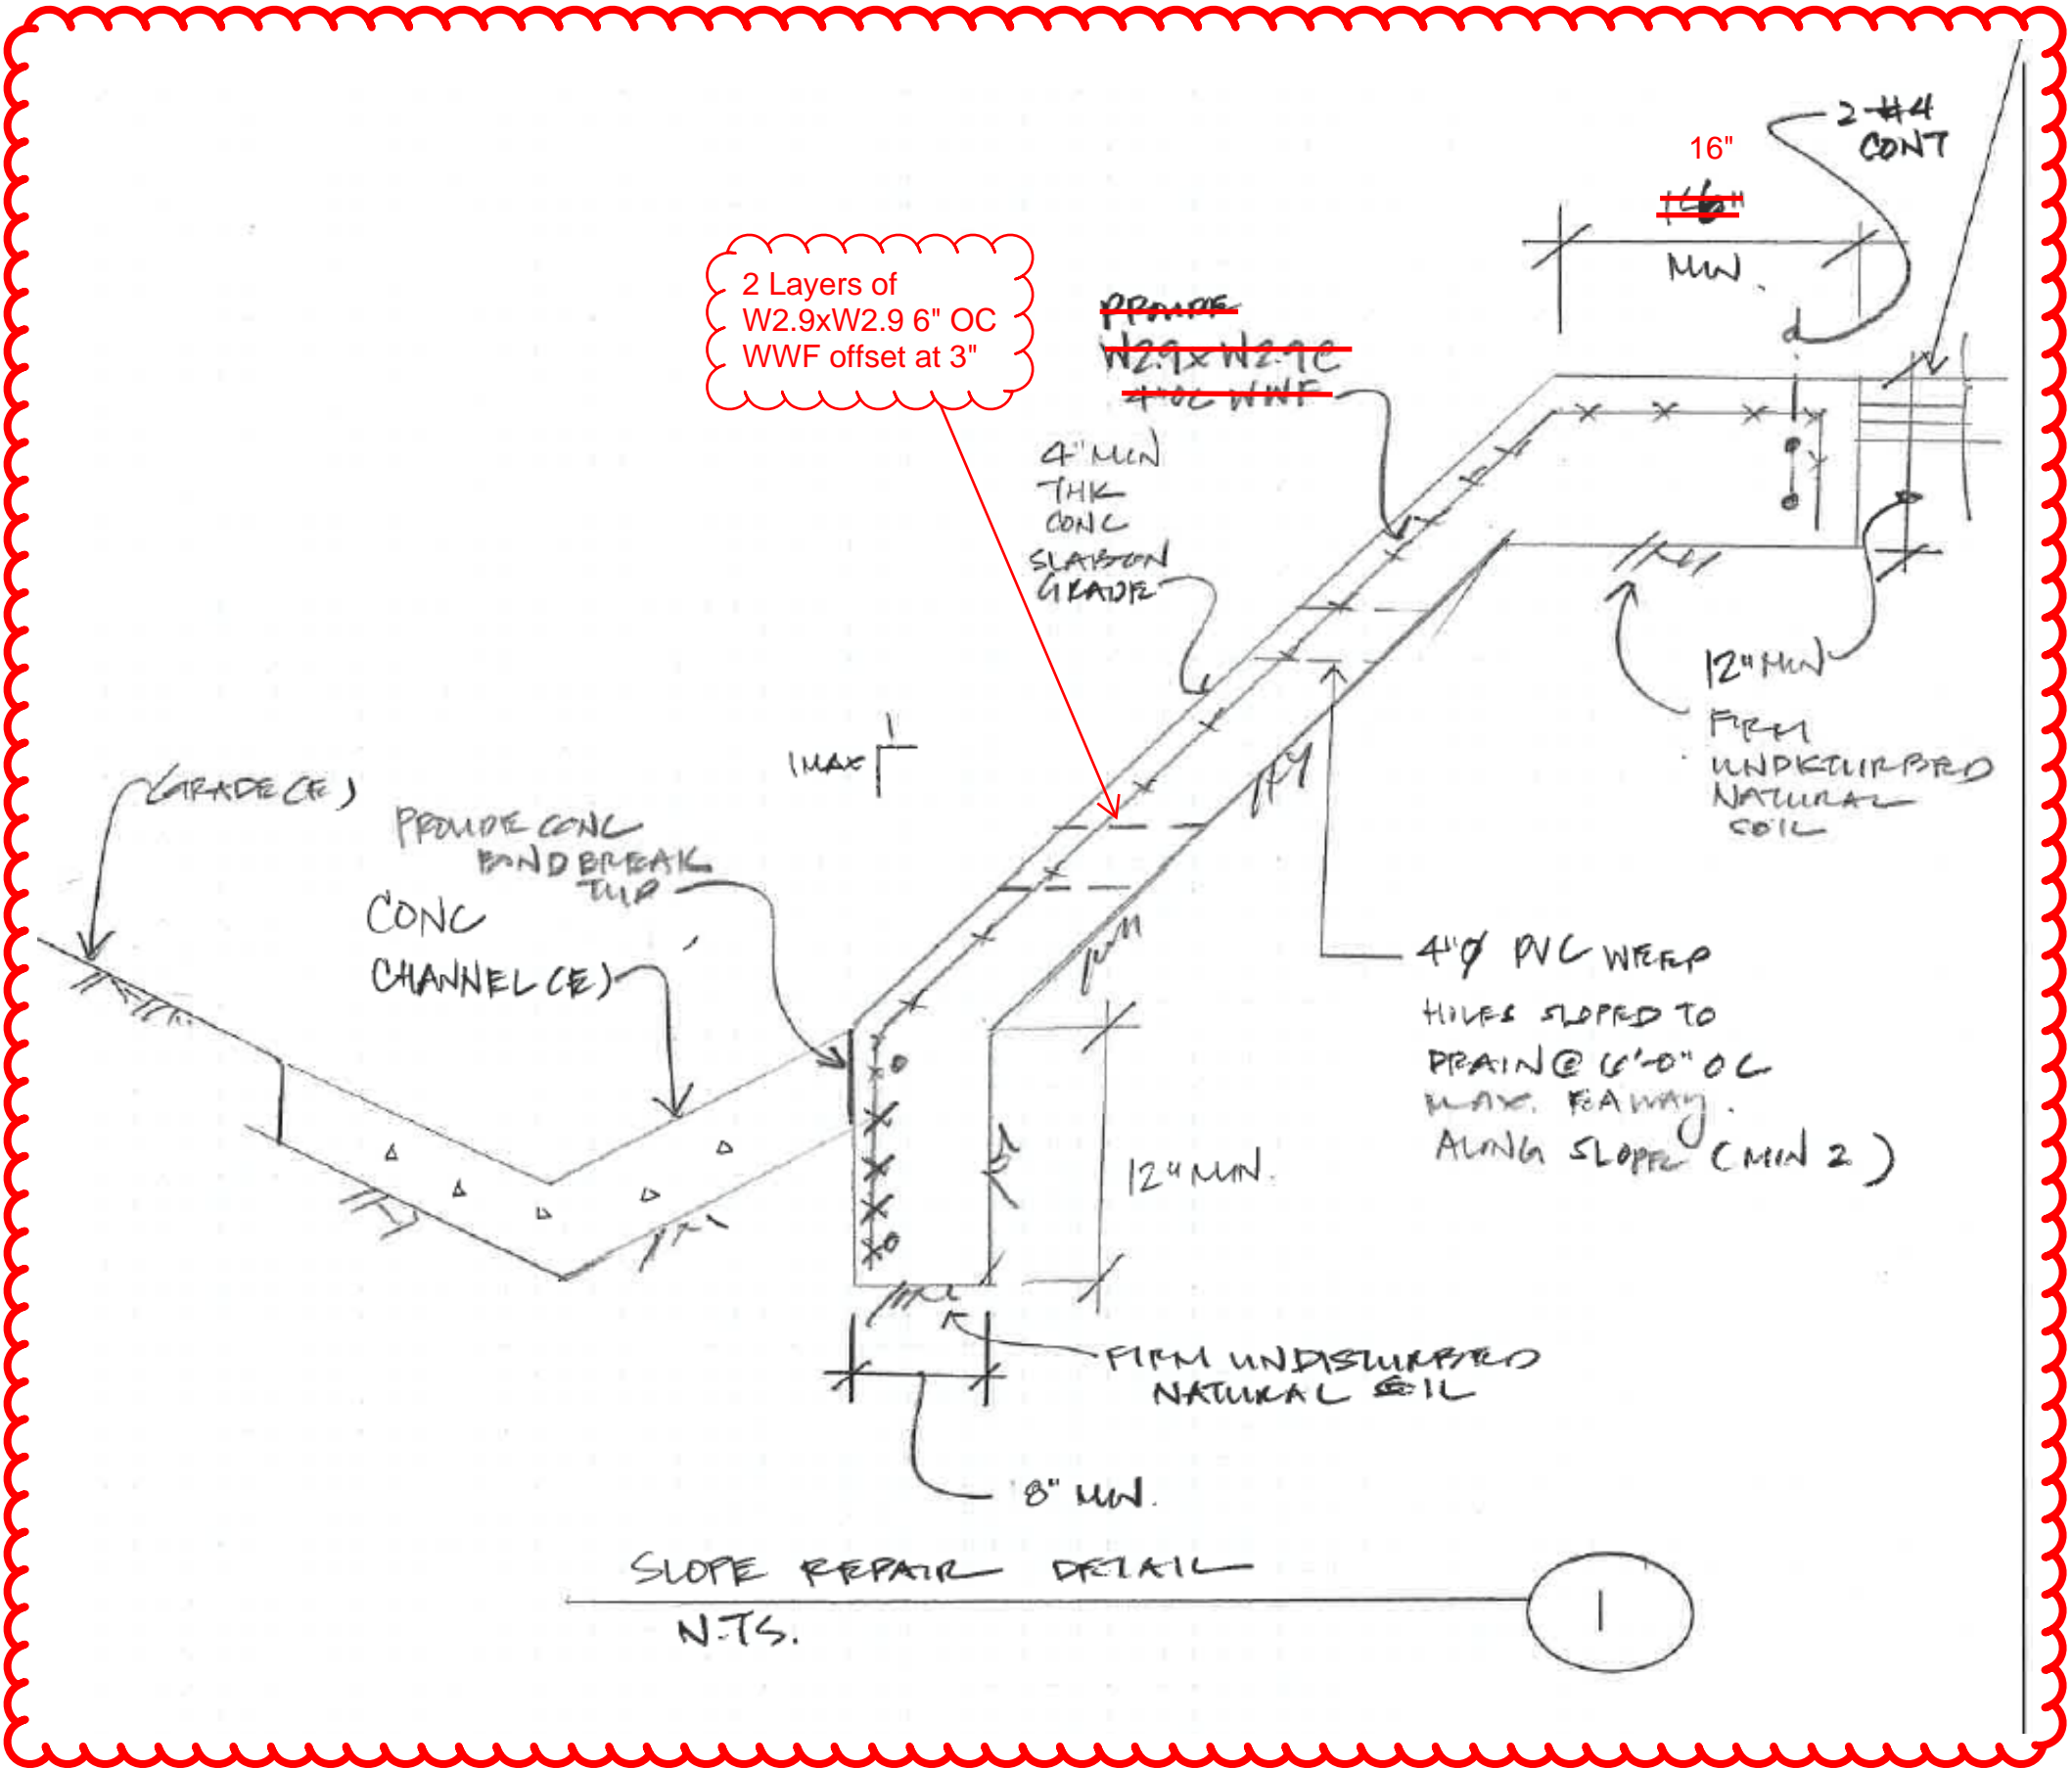


AS-BUILT DRAWINGS

This certifies that the dimensions and details shown on this sheet reflect the dimensions and details, and specifications as constructed in the field.

KAIKOR CONSTRUCTION COMPANY INC.

Stacey Park

DATE: 7/21/2022

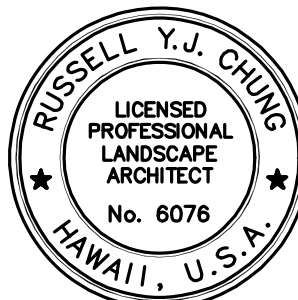

4/30/22
EXP. DATE
This work was prepared by me or under my supervision.

STATE OF HAWAII
DEPARTMENT OF TRANSPORTATION
HIGHWAYS DIVISION

LANDSCAPE
DETAILS


EROSION CONTROL AND BEST MANAGEMENT PRACTICES FOR STORM
WATER PERMIT COMPLIANCE, VARIOUS LOCATIONS ON OAHU
Project No. HWY-O-02-19
Scale: Not To Scale Date: May 2020

SHEET No. LP-04 OF 5 SHEETS


"AS-BUILT"

FED. ROAD DIST. NO.	STATE	PROJ. NO.	FISCAL YEAR	SHEET NO.	TOTAL SHEETS
HAWAII	HAW.	HWY-O-02-19	2020	C.O. 40	48

PLANT SCHEDULE PID 1501

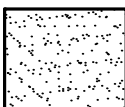HYDRO-MULCH SEEDING	QTY	BOTANICAL NAME	COMMON NAME	CONT	REMARKS
	15,650 SF 14,310 SF	Cynodon dactylon	Common Bermuda Grass	Seed	See Specs For Grass Seeding Rate

PLANT SCHEDULE PID 467

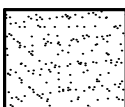HYDRO-MULCH SEEDING	QTY	BOTANICAL NAME	COMMON NAME	CONT	REMARKS
	63 SF 53 SF	Cynodon dactylon	Common Bermuda Grass	Seed	See Specs For Grass Seeding Rate

AS-BUILT DRAWINGS


This certifies that the dimensions and details shown on this sheet reflect the dimensions and details, and specifications as constructed in the field.

KAIKOR CONSTRUCTION COMPANY INC.

Stacey Park

DATE: 7/21/2022

2/19/21	Revised Planting Quantity
DATE	REVISION

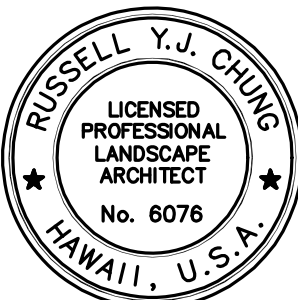

4/30/22
EXP. DATE
Y.J. Chung
This work was prepared by me or under my supervision.

STATE OF HAWAII
DEPARTMENT OF TRANSPORTATION
HIGHWAYS DIVISION
LANDSCAPE PLANT LIST
EROSION CONTROL AND BEST MANAGEMENT PRACTICES FOR STORM WATER PERMIT COMPLIANCE, VARIOUS LOCATIONS ON OAHU
Project No. HWY-O-02-19
Scale: Not To Scale Date: May 2020