


INDEX TO DRAWINGS	
SHEET NO.	DESCRIPTION
1	TITLE SHEET
2	STANDARD PLANS SUMMARY
3	LOCATION PLANS
4	GENERAL NOTES, LEGEND, AND ABBREVIATIONS
5	CONSTRUCTION NOTES
6-8	WATER POLLUTION AND EROSION CONTROL NOTES
9	WATER POLLUTION AND EROSION CONTROL DETAILS
10-13	UTILITY NOTES
14-35	EROSION CONTROL PLANS AND DETAILS ①
36-40	LANDSCAPING PLANS, DETAILS AND NOTES ②
41-43	TRAFFIC CONTROL NOTES AND LEGEND
44-48	TRAFFIC CONTROL PLANS

Sheet Nos. ① C.O. ADD 17S-1, C.O. ADD 22 THRU C.O. 28S-1; C.O. 32S-1, 35S-1 & S-2;
② C.O. 37S-1, are Supplementary Sheets to this Project. Total Sheet Count After "As-Built" Posting 60 Sheets.

LIMITACO CONSULTING GROUP
DESIGNED BY
HWY-OW
MANAGED BY
483-2569
PHONE
MARCH 2020
DATE

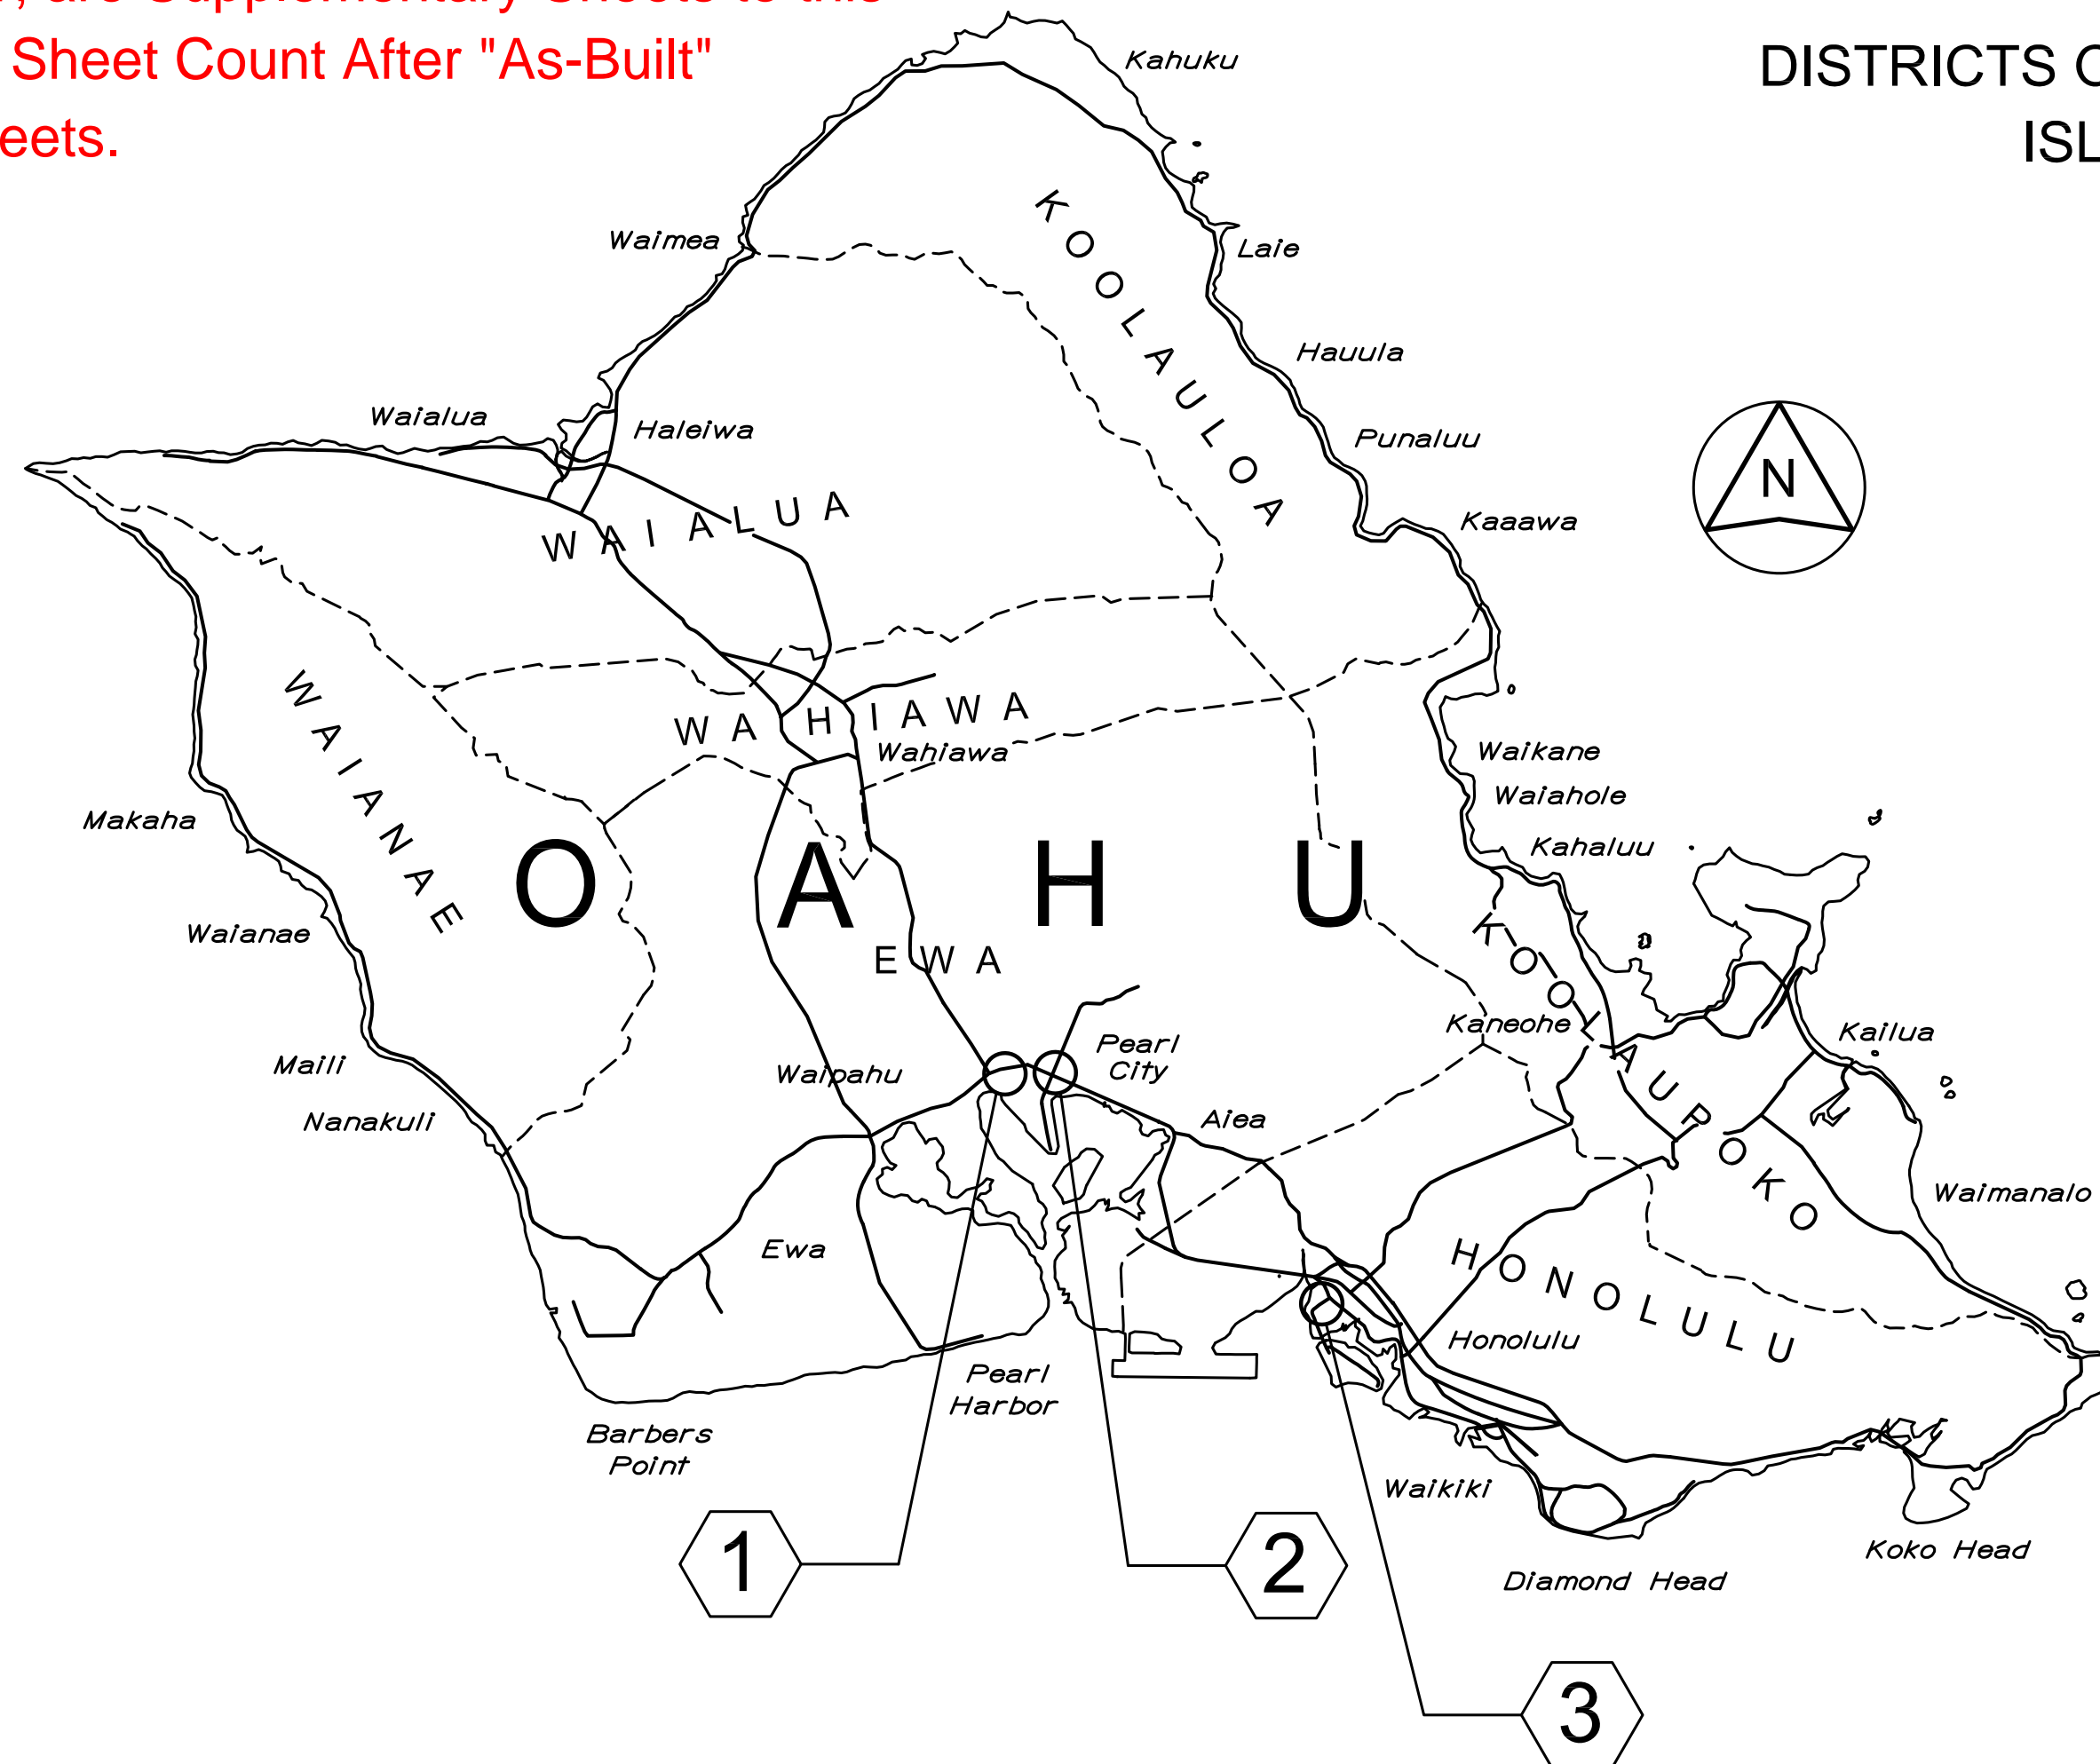



STATE OF HAWAII
DEPARTMENT OF TRANSPORTATION
HIGHWAYS DIVISION
HONOLULU, HAWAII
AS BUILT
PLANS FOR
EROSION CONTROL AND BEST
MANAGEMENT PRACTICES FOR STORM
WATER PERMIT COMPLIANCE
VARIOUS LOCATIONS ON OAHU
PROJECT NO. HWY-O-02-19
DISTRICTS OF EWA AND HONOLULU
ISLAND OF OAHU

- PROJECT SITES**
- ① LOCATION PLAN - PID 1501
INTERSTATE ROUTE H-1
BEGIN MILEPOST: 8.68
END MILEPOST: 8.73
 - ② LOCATION PLAN - PEARL CITY BASEYARD
INTERSTATE ROUTE H1
BEGIN MILEPOST: 9.97
END MILEPOST: 10.01
 - ③ LOCATION PLAN - PID 467
SAND ISLAND ACCESS ROAD 64
BEGIN MILEPOST: 2.23
END MILEPOST: 2.22

CHANGES MADE DURING CONSTRUCTION HAVE BEEN INCORPORATED ON THESE PLANS EXCEPT CHANGES IN THE ORIGINAL THEORETICAL QUANTITIES. FOR ACTUAL QUANTITIES, REFER TO PROJECT LEDGER AND/OR COMPUTATION BOOK.

[Signature]
Resident Engineer
7/29/22
Date

FED. ROAD DIST. NO.	STATE	PROJ. NO.	FISCAL YEAR	SHEET NO.	TOTAL SHEETS
HAWAII	HAW.	HWY-O-02-19	2020	1	48

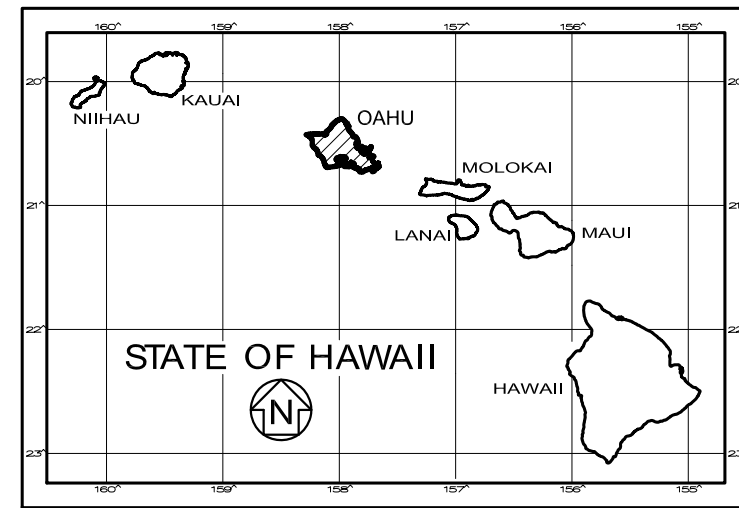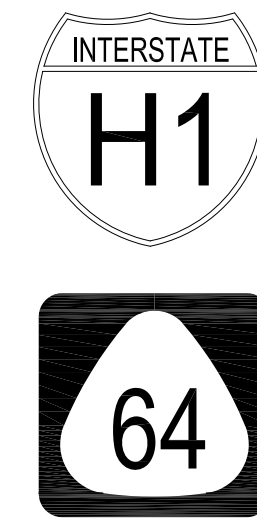

AS-BUILT DRAWINGS

This certifies that the dimensions and details shown on this sheet reflect the dimensions and details, and specifications as constructed in the field.

KAIKOR CONSTRUCTION COMPANY INC.
[Signature]
DATE: 7/21/2022

DEPARTMENT OF TRANSPORTATION STATE OF HAWAII	
APPROVED: <i>[Signature]</i>	04/15/20
DIR. OF TRANSPORTATION	DATE