

FED. ROAD DIST. NO.	STATE	PROJ. NO.	FISCAL YEAR	SHEET NO.	TOTAL SHEETS
HAWAII	HAW.	H3M-01-90M	1990	5	12

LEGEND

- Area Requiring Reconstruction of Weakened Pavement
- ⊙ lp

Street Lighting
- w—12"—

Existing Waterline
- ⊙wvb---

Existing Water Valve Box
- └─hthh---

Existing HTCO Handhole
- ⊙emh---


Existing Electric Manhole
- └─hehh---

Existing HECO Handhole

NOTE:

Adjust utility manhole/box frames and covers in the existing pavement to match new pavement grade, as necessary.

Provide smooth transition at crosswalk and HTCO mh by paving with A.C. Pav't Mix No. IV. This work shall be paid under A.C. Pav't Mix No. IV. New paving shall be flush with resurfaced pavement and HTCO mh and HE hh frame/cover and aggregate shoulder.

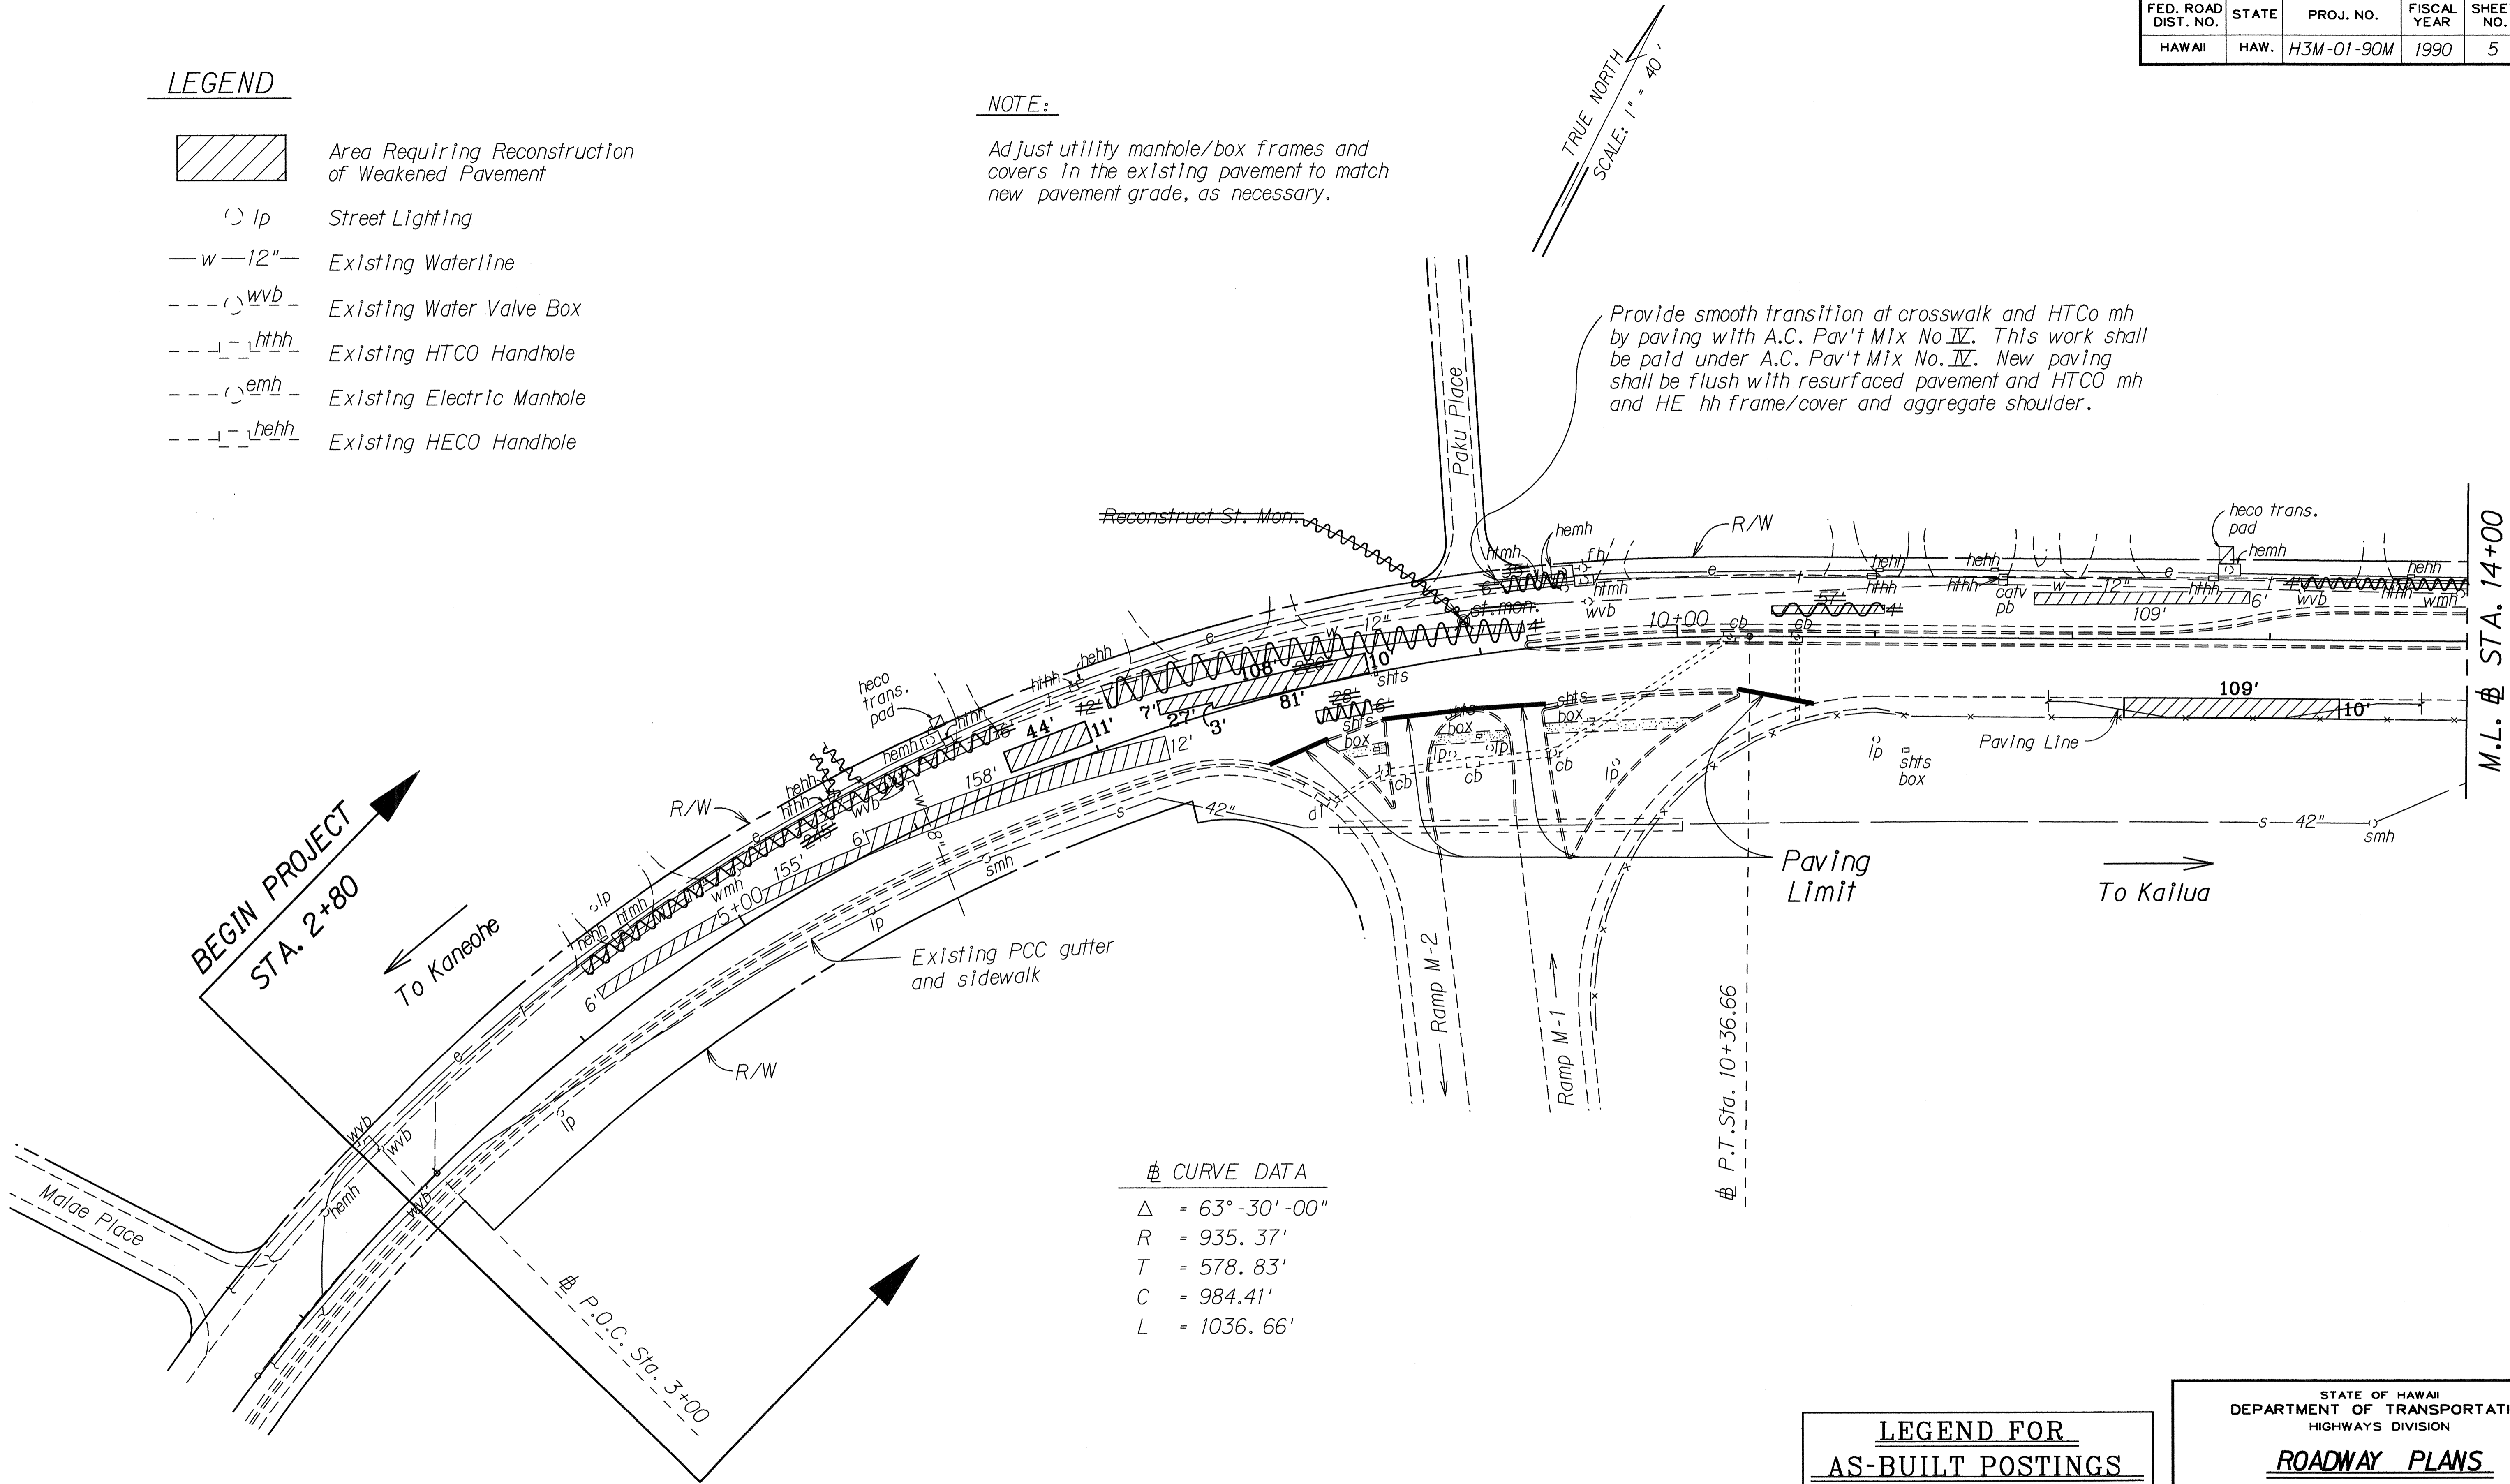

⊕ CURVE DATA

Δ	= 63°-30'-00"
R	= 935.37'
T	= 578.83'
C	= 984.41'
L	= 1036.66'

LEGEND FOR AS-BUILT POSTINGS

- ~~~~~

Squiggly line for as-built deletion
- 100.00

Double line for as-built deletion
- Roadway

Text for as-built posting

STATE OF HAWAII

DEPARTMENT OF TRANSPORTATION

HIGHWAYS DIVISION

ROADWAY PLANS

KANEOHE BAY DRIVE RESURF.

AT H-3 MOKAPU INTERCHANGE.

Malae Place to Molo Street

PROJ. NO. H3M-01-90M

Scale: As Shown

Date: Jan., 1990

SHEET No. 1 OF 2 SHEETS

SURVEY PLOTTED BY	DATE
DRAWN BY	12-29-91
TRACED BY	
CHECKED BY	
QUANTITIES BY	
CHECKED BY	
ORIGINAL PLAN	
NOTE BOOK	
ddxx	
N. Xdgn	

ORIGINAL PLAN	SURVEY PLOTTED BY _____ DATE _____
NOTE BOOK	DRAWN BY _____ *
	TRACED BY _____ *
	DESIGNED BY _____ *
	QUANTITIES BY _____ *
N <sub>4</sub> _____	CHECKED BY _____ *

*Adjust utility manhole/box frames and covers in the existing pavement to match new pavement grade, as necessary.*

TRUE NORTH  
SCALE: 1" = 40'

STA. 24+60


### *Paving Limit*

Cold Plane limit  
under overpass

M.L. # STA. 26+00

*To Kailua*

$$\begin{aligned}\Delta &= 29^{\circ} - 30' - 00'' \\ R &= 1412.69' \\ T &= 371.93' \\ C &= 719.35' \\ L &= 727.36'\end{aligned}$$

	Squiggly line for as-built deletion
<del>100.00</del>	Double line for as-built deletion
Roadway	Text for as-built posting

KANEOHE BAY DRIVE RESURF.  
AT H-3 MOKAPU INTERCHANGE,  
Malae Place to Molo Street  
PROJ. NO. H3M-01-90M

Scale: As Shown      Date: Jan., 1990

SHEET No. 2 OF 2 SHEETS

6