


CURVE DATA			
	①	②	③
Δ	84°36'37"	148°09'23"	30°29'00"
R	140.00'	90.00'	400.00'
T	127.41'	315.49'	108.99'
Lc	206.74'	232.72'	212.81'

Sta. 7+40± Rt. to Sta. 7+97± Rt. "Pauoa Rd."
Construct 6' Wide Plain Concrete Sidewalk. Remove and Dispose Existing Sprinkler Heads and Feeder Lines Within the New Sidewalk Area.

Sta. 8+15± Rt. to Sta. 10+73± Rt. "Pauoa Rd."
Construct 6' Wide Plain Concrete Sidewalk. Remove and Dispose Existing Sprinkler Heads, Feeder Lines and Valves Within the New Sidewalk Area.

Sta. 10+27± Rt. to Sta. 10+72± Rt. "Pauoa Rd."
Construct 8" Wide Concrete Retaining Wall. Exact Limits To Be Determined In the Field.

FED. ROAD DIST. NO.	STATE	PROJ. NO.	FISCAL YEAR	SHEET NO.	TOTAL SHEETS
HAWAII	HAW.	7521A-01-92	1992	4	4

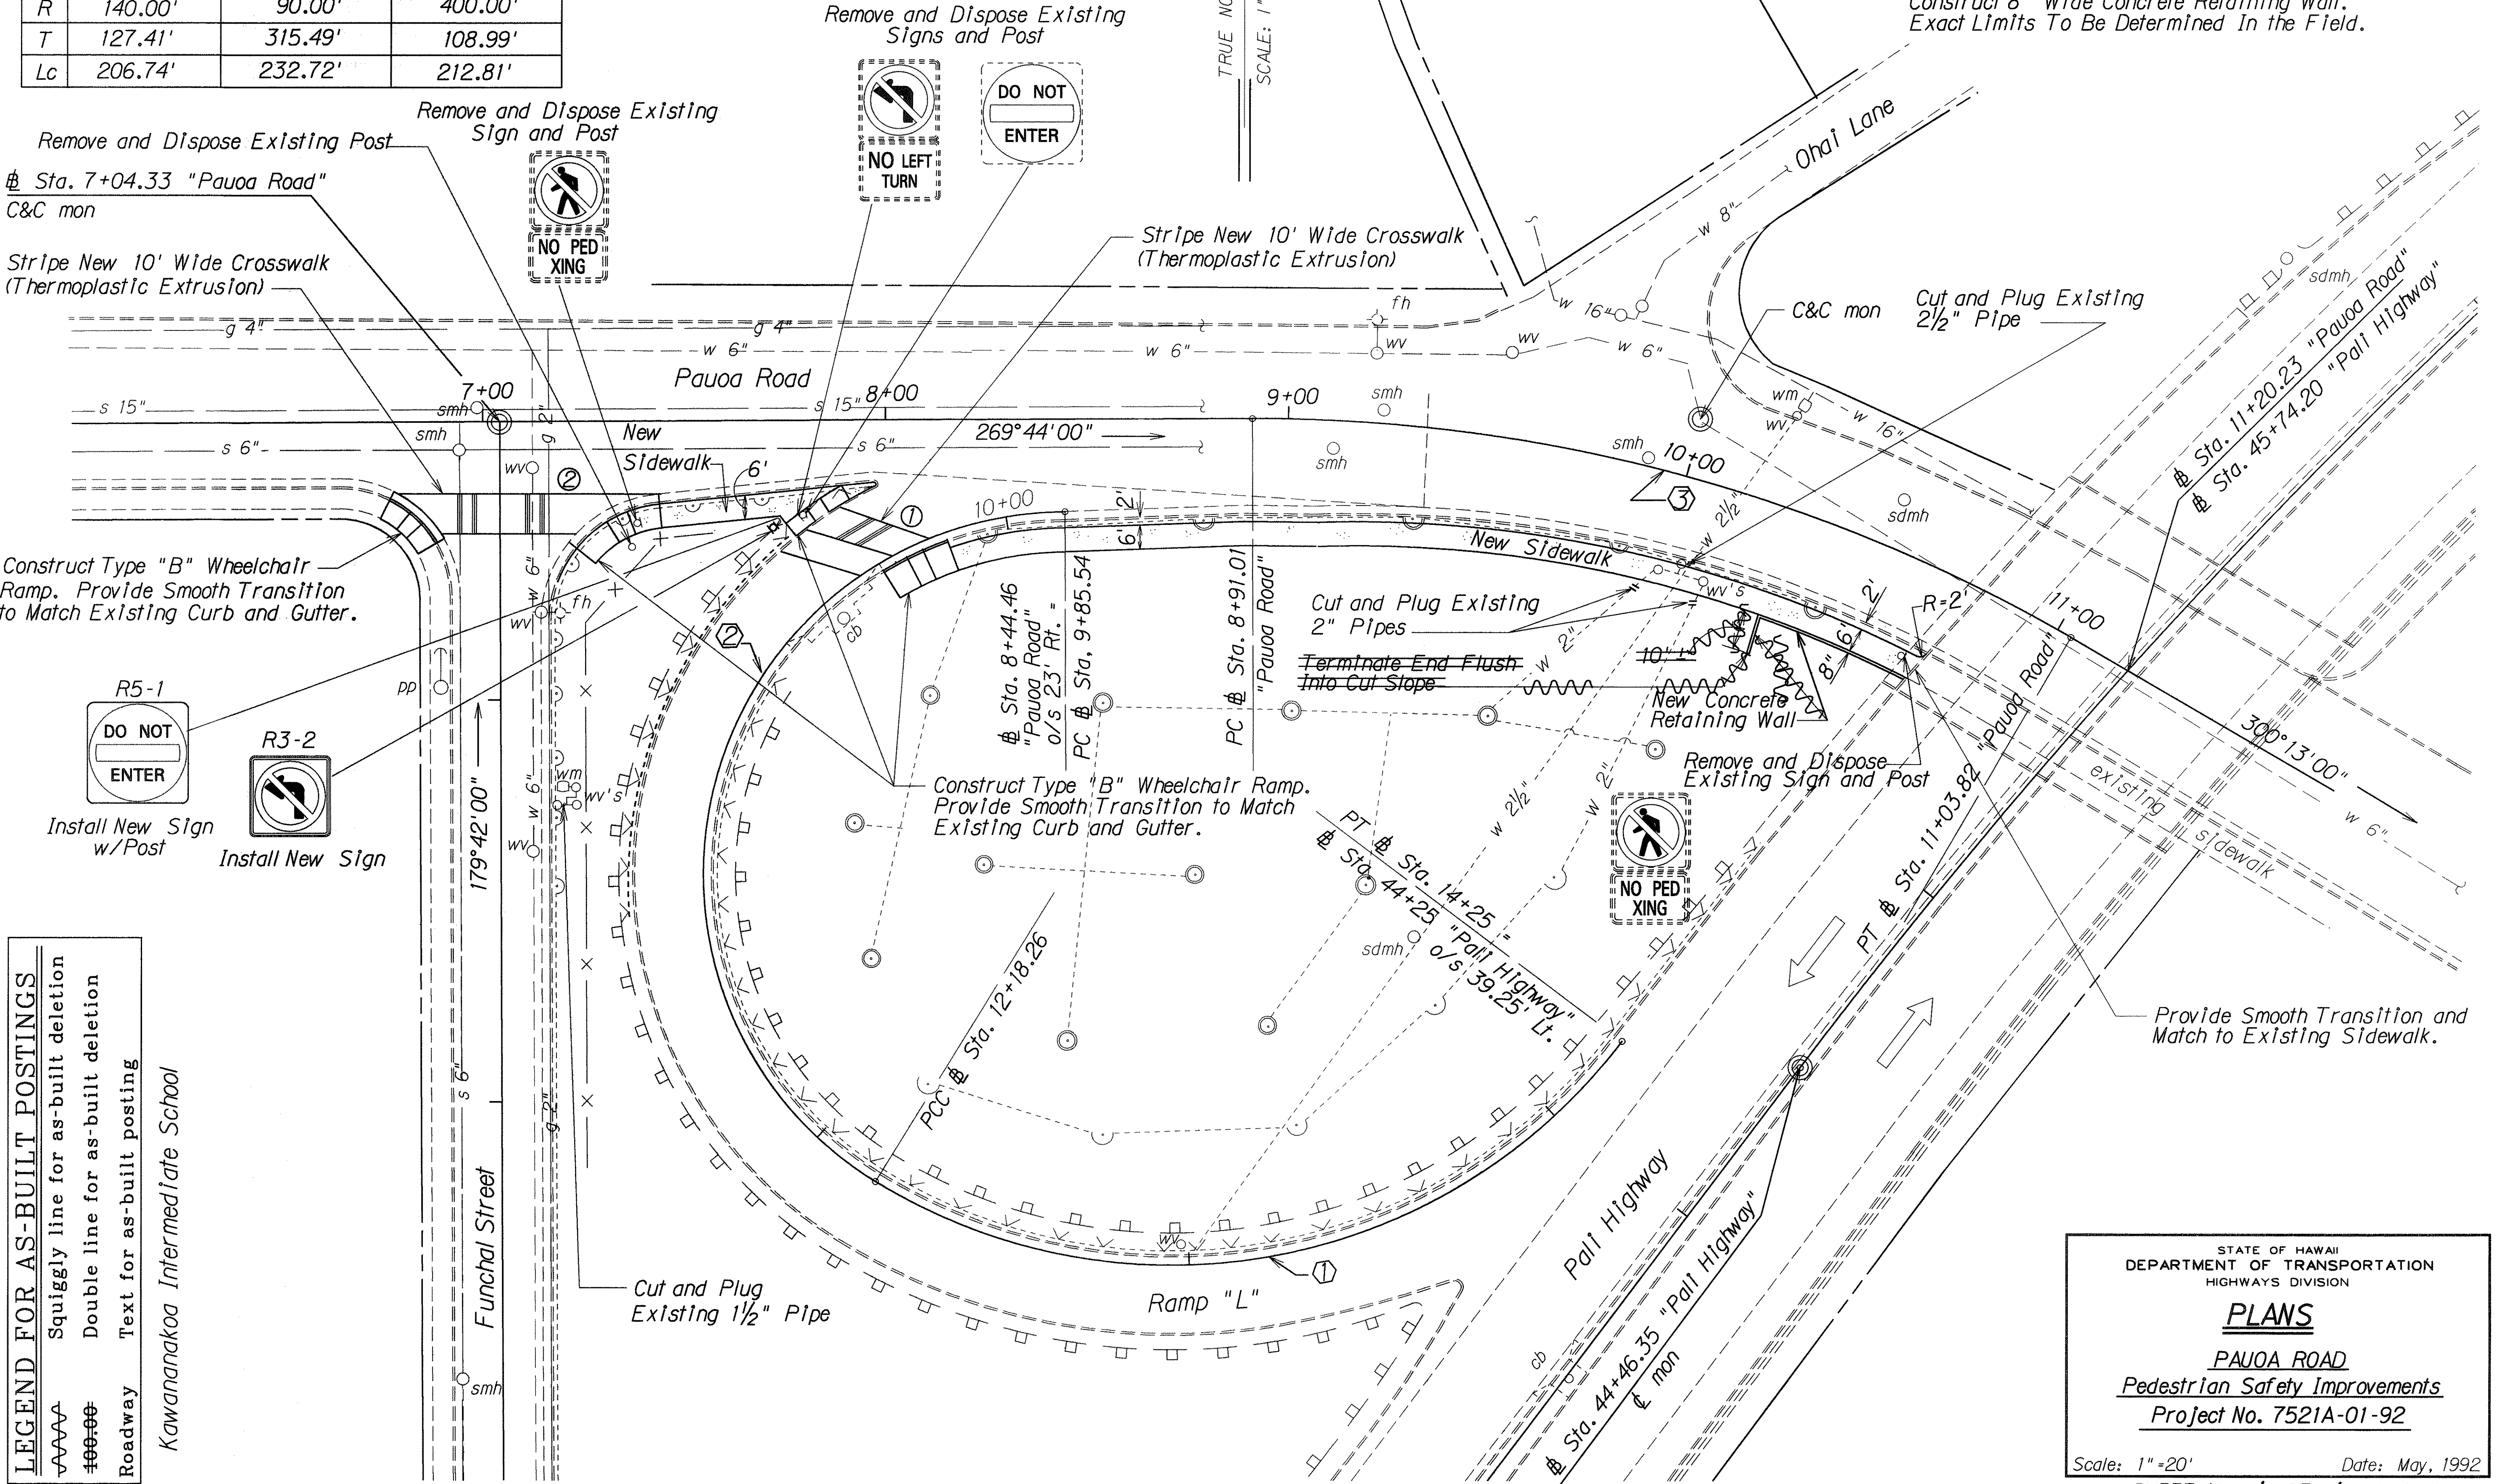

LEGEND FOR AS-BUILT POSTINGS

~~~~~ Squiggly line for as-built deletion

### Double line for as-built deletion

#### Roadway Text for as-built posting

Kawananakoa Intermediate School

STATE OF HAWAII  
DEPARTMENT OF TRANSPORTATION  
HIGHWAYS DIVISION

**PLANS**  
PAUOA ROAD  
Pedestrian Safety Improvements  
Project No. 7521A-01-92

Scale: 1" = 20'  
Date: May, 1992  
SHEET No. 1 OF 1 SHEETS