

INDEX TO DRAWINGS	
SHEET NO.	DESCRIPTION
1	TITLE SHEET
2	DETAILED INDEX
3	STANDARD PLANS SUMMARY
4 - 13	NOTES
14 - 19	LOCATION MAPS ①②③④⑤
20 - 31	DETAILS ⑥⑦
32 - 74	SITE & GRADING PLANS ⑧
75	TYPICAL TRAFFIC CONTROL PLANS



Plan Sht. Nos. ① Add. 14 S-1, ② C.O. Add. 19 S-1, ③ Add. 19 S-2, ④ C.O. Add. 19 S-3, ⑤ C.O. Add. 19 S-4, ⑥ Add. 21 S-1, ⑦ Add. 21 S-2, and ⑧ C.O. 74 S-1 are supplementary sheets to this project, added during Addendum & "AS-BUILT" postings.

TOTAL SHEET COUNT after Addendum & "AS-BUILT" postings is 83 sheets.

STATE OF HAWAII  
DEPARTMENT OF TRANSPORTATION  
HIGHWAYS DIVISION  
HONOLULU, HAWAII  
"AS-BUILT"  
PLANS FOR

ADA COMPLIANCE FOR EMERGENCY TELEPHONES  
AT VARIOUS LOCATIONS ON OAHU  
FEDERAL AID PROJECT NO. CMAQ-0300(100)  
DISTRICTS OF EWA, HONOLULU, KOOLAUPOKO AND WAIANAE  
ISLAND OF OAHU

FED. ROAD DIST. NO.	STATE	FED. AID PROJ. NO.	FISCAL YEAR	SHEET NO.	TOTAL SHEETS
HAWAII	HAW.	CMAQ-0300(100)	2004	1	75

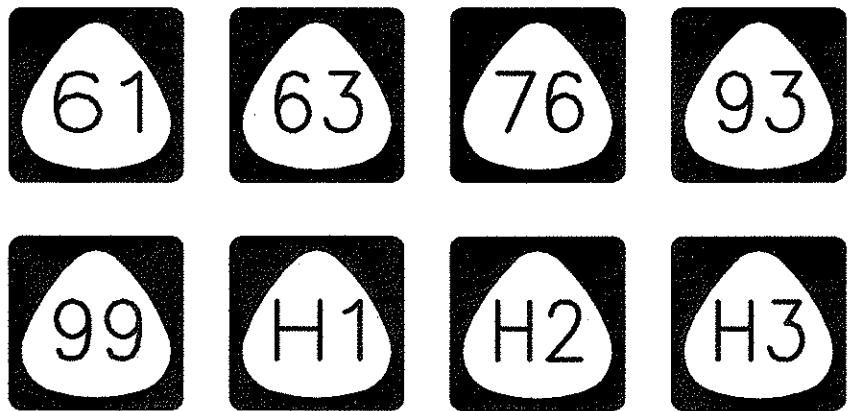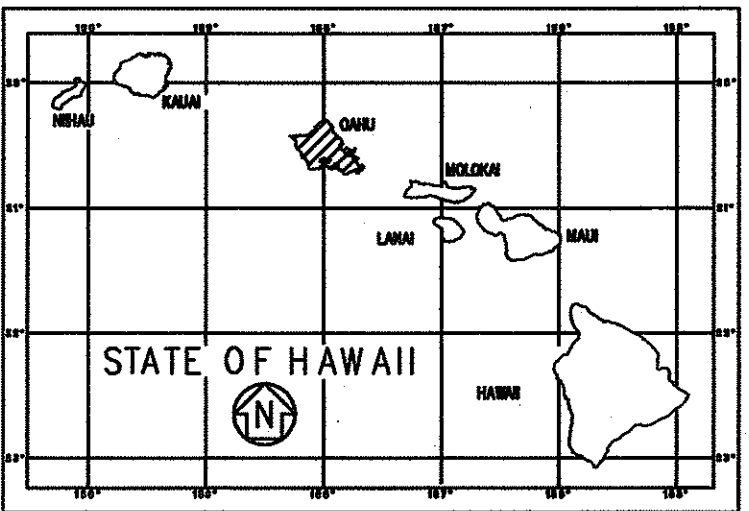


PROJECTS SITES

- ① FARRINGTON HIGHWAY - ROUTE 93  
EAST: MILE POST 0.05 TO MILE POST 7.95  
WEST: MILE POST 1.65 TO MILE POST 8.10  
NORTH: MILE POST 14.70  
SOUTH: MILE POST 9.35
- ② FORT WEAVER ROAD - ROUTE 76  
MILE POST 2.65 TO MILE POST 5.80
- ③ H-1 INTERSTATE HIGHWAY  
MILE POST 0.00 TO MILE POST 1.20
- ④ H-2 INTERSTATE HIGHWAY  
MILE POST 3.10 TO MILE POST 4.10
- ⑤ KAMEHAMEHA HIGHWAY - ROUTE 99  
MILE POST 14.8

- ⑥ H-3 INTERSTATE HIGHWAY  
MILE POST 0.00 TO MILE POST 11.20
- ⑦ LIKELIKE HIGHWAY - ROUTE 63  
NORTH: MILE POST 4.80 TO MILE POST 8.50  
SOUTH: MILE POST 4.10 TO MILE POST 8.30
- ⑧ PALI HIGHWAY - ROUTE 61  
MILE POST 3.70 TO MILE POST 8.70


CHANGES MADE DURING CONSTRUCTION HAVE BEEN INCORPORATED ON THESE PLANS EXCEPT CHANGES IN THE ORIGINAL THEORETICAL QUANTITIES. FOR ACTUAL QUANTITIES, REFER TO PROJECT LEDGER AND/OR COMPUTATION BOOK.

*Marion C.H. Justfield*  
RESIDENT ENGINEER  
1-04-2008  
DATE

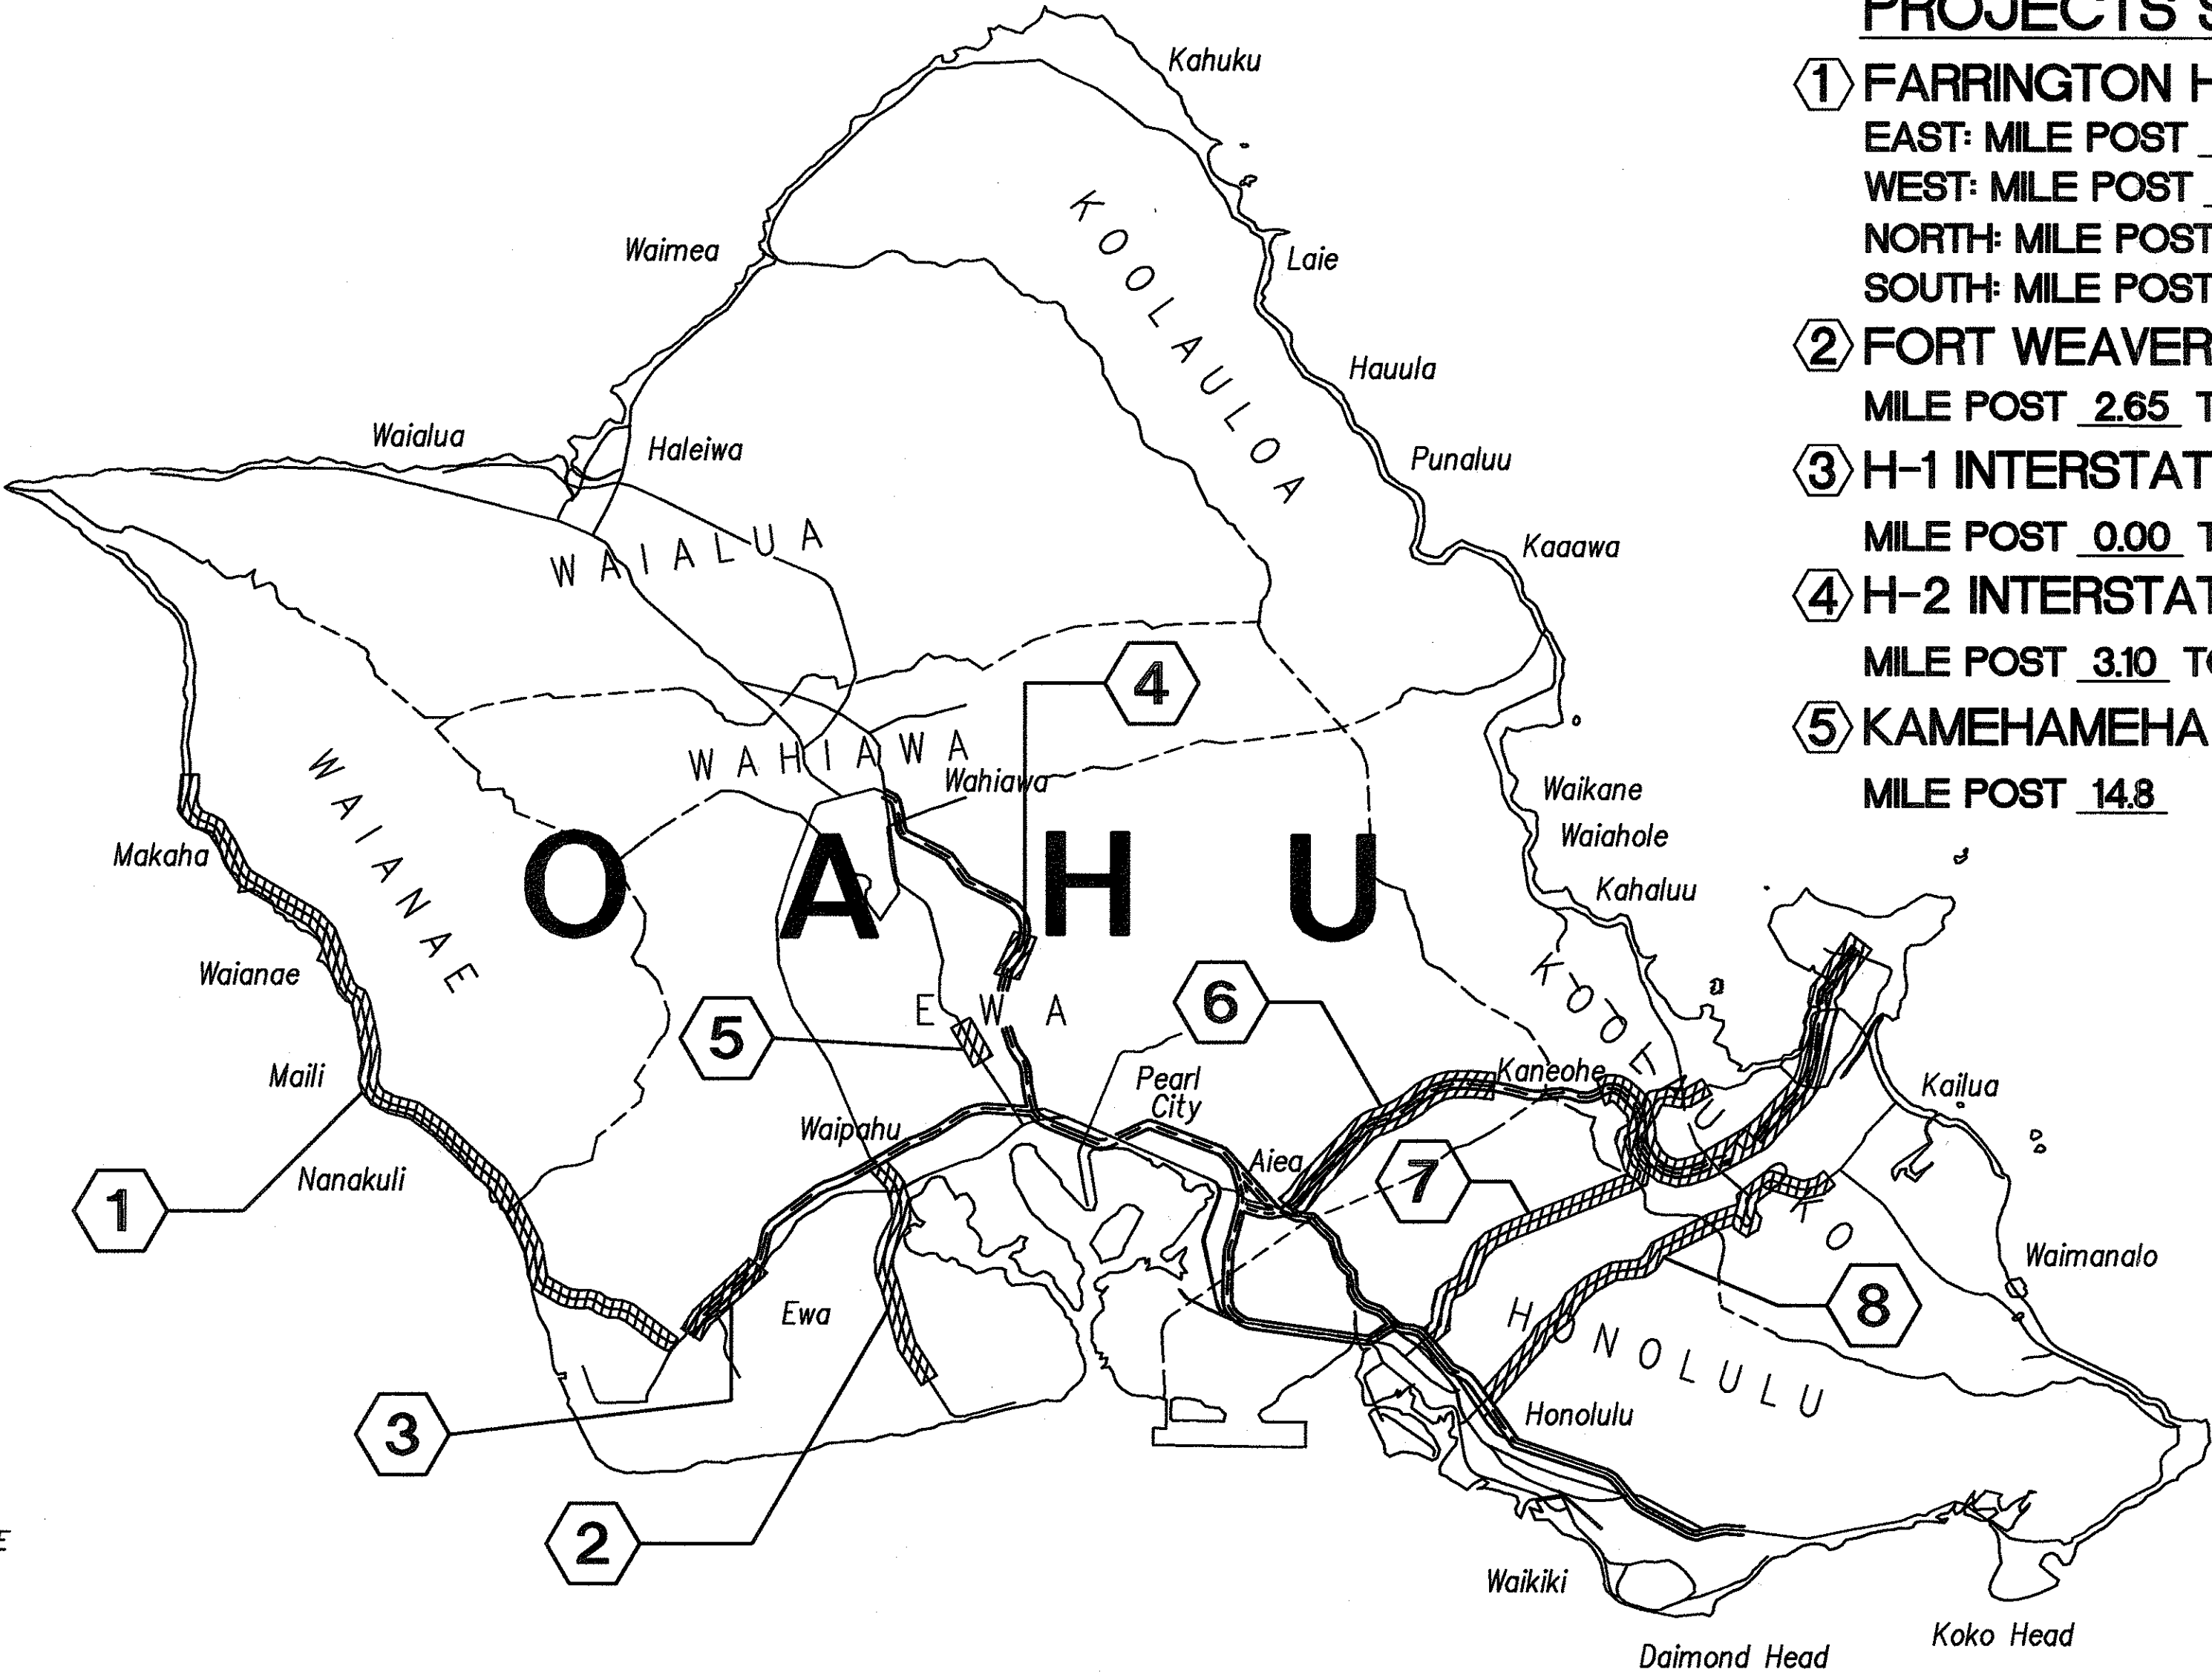

————— FEDERAL AID INTERSTATE PROJECTS PREVIOUSLY CONSTRUCTED OR UNDER CONSTRUCTION

/////// PROJECT SITE

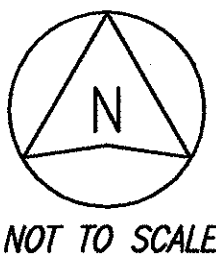

DEPARTMENT OF TRANSPORTATION STATE OF HAWAII	
APPROVED:	
<i>Debra M. Yamani</i> DIR. OF TRANSPORTATION	8-27-04 DATE